

# Harnett County Department of Public Health

PERMIT # SPD2410-0025

## Operation Permit

New Installation  Septic Tank  Nitrification Line  Repair  Expansion

PROPERTY LOCATION: 138 Travelers Way

SUBDIVISION Oakmont

LOT # 359

Name: (owner) Oakmont Holding

System Installer: Don Gaddy


Basement with plumbing:  Garage  Number of Bedrooms 4 (8 people)

Type of Water Supply:  Community  Public  Well Distance from well \_\_\_\_\_ feet

System Type: TYPE III G Types V and VI Systems expire in 5 years.

(In accordance with Table V a) Owner must contact Health Department 6 months prior to expiration for permit renewal.

This system has been installed in compliance with applicable North Carolina General Statutes, Rules for Sewage Treatment and Disposal, and all conditions of the Improvement Permit and Construction Authorization.

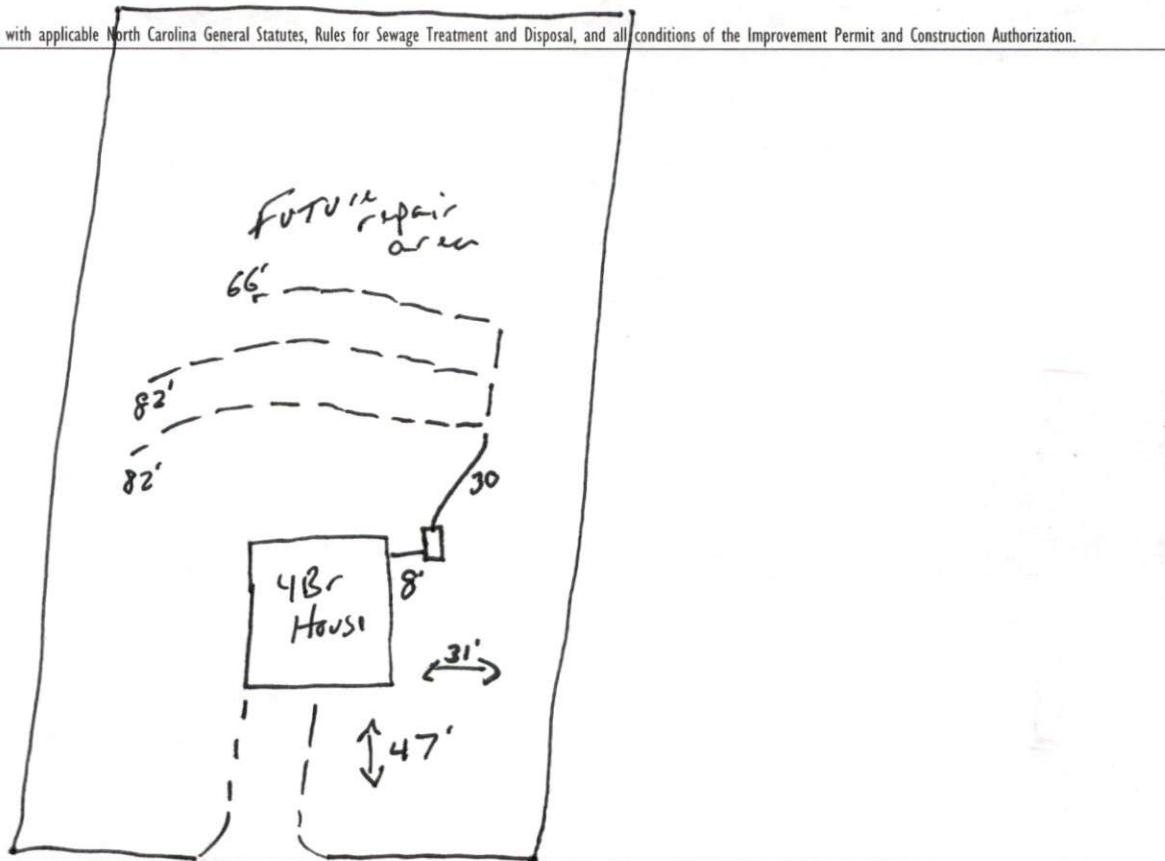

### PERMIT CONDITIONS:

I. Performance: System shall perform in accordance with Rule .1961.

II. Monitoring: As required by Rule .1961.

III. Maintenance: As required by Rule .1961. Other: \_\_\_\_\_  
Subsurface system operator required? Yes  No

If yes, see attached sheet for additional operation conditions, maintenance and reporting.

IV. Operation: \_\_\_\_\_

V. Other: \_\_\_\_\_

D-Box  Pump  Alarm  H2O Line  PWR Line

Following are the specifications for the sewage disposal system on the above captioned property.

Type of system:  Conventional  Other 25% reduction DQ4 Septic Tank: 1000 gallons Pump Tank: \_\_\_\_\_ gallons

Subsurface No. of exact length width of  
Drainage Field ditches 1 of each ditch 230 feet ditches 3 feet depth of  
French Drain Required: \_\_\_\_\_ Linear feet ditches 20 inches

Authorized State Agent

Mark R. REED


Date 10-27-25

Oakmont - Lot #359  
 "As Built Revision"  
 138 Travelers Way - Harnett County  
 Ascot Corporation, LLC  
 PIN# 0507-63-6550

\*At time of installation septic installer modified final installation as shown.  
 Modification is "Approved" by Alex Adams

\*Not a Survey  
 Sketched from a plot plan supplied by owner

System: Gravity to Serial distribution  
 Lines: 1-3 (230')  
 LTAR: 0.6  
 20" Max Trench Bottom  
 Accepted Status System  
 Repair: Gravity to D-Box  
 Lines: 4-6 (200')  
 LTAR: 0.6  
 18" Max Trench Bottom  
 Accepted Status System

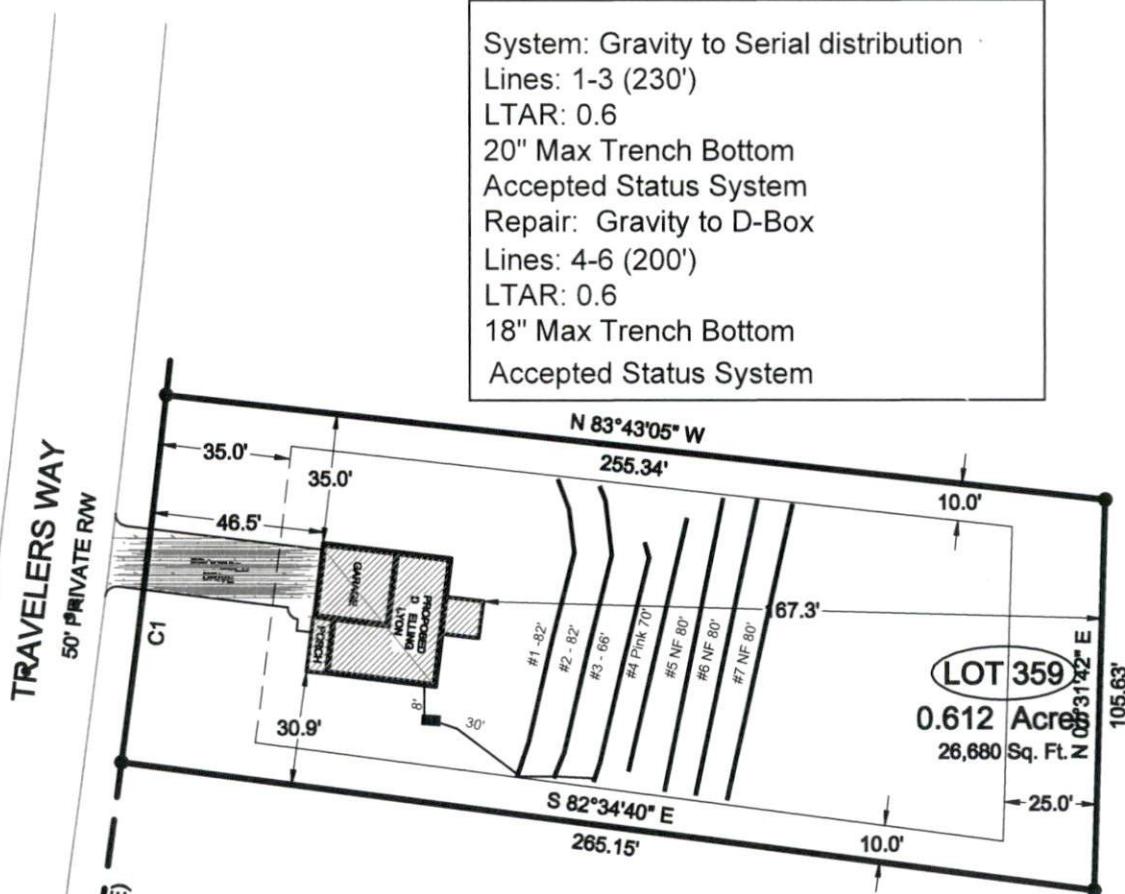

\*\*1000 Gallon Septic and Pump Tank  
 Tank and trenches to be located minimum of 10' from any property line and minimum of 5' from any building foundation.  
 \*Do Not Cut, Fill, or Alter Drainfield or Repair Area  
 \*Comply with all setbacks  
 \*Contact local health dept. and/or Alex Adams prior to or during installation with any questions or concerns.

Adams  
 Soil Consulting  
 919-414-6761  
 Job #1968  
 10-24-25

GRAPHIC SCALE  
 1" = 50'

