

Harnett County Department of Public Health

PERMIT # SFD2410-0026

Operation Permit

☒ New Installation ☒ Septic Tank ☒ Nitrification Line ☐ Repair ☐ Expansion

PROPERTY LOCATION: 158 Travelers Way (SR1116)

SUBDIVISION Oakmont Ph III B LOT # 358

Name: (owner) Oakmont Holding

System Installer: Don Gaddy


Basement with plumbing: ☐ Garage ☒ Number of Bedrooms 3 (6 people)

Type of Water Supply: ☐ Community ☒ Public ☐ Well Distance from well _____ feet

System Type: TYPE III 9 Types V and VI Systems expire in 5 years.

(In accordance with Table V a) Owner must contact Health Department 6 months prior to expiration for permit renewal.

This system has been installed in compliance with applicable North Carolina General Statutes, Rules for Sewage Treatment and Disposal, and all conditions of the Improvement Permit and Construction Authorization.

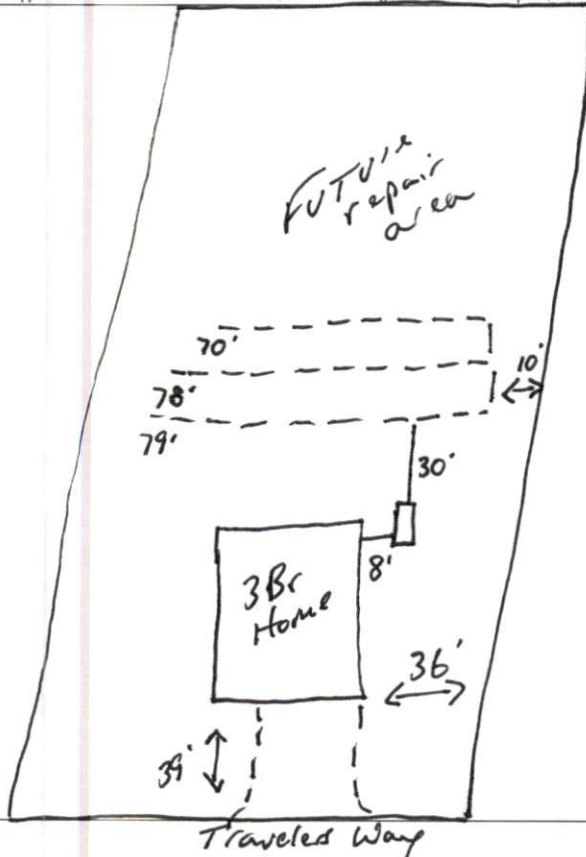

PERMIT CONDITIONS:

- I. Performance: System shall perform in accordance with Rule .1961.
- II. Monitoring: As required by Rule .1961.
- III. Maintenance: As required by Rule .1961. Other: _____
Subsurface system operator required? Yes ☐ No ☒
If yes, see attached sheet for additional operation conditions, maintenance and reporting.

- IV. Operation: _____
- V. Other: _____

☐ D-Box ☐ Pump ☐ Alarm ☐ H2O Line ☐ PWR Line

Following are the specifications for the sewage disposal system on the above captioned property.

Type of system: ☐ Conventional ☒ Other 25% reduction IGY Septic Tank: 1000 gallons Pump Tank: _____ gallons
Subsurface No. of exact length width of depth of
Drainage Field ditches 1 of each ditch 227 feet ditches 3 feet ditches 20 inches
French Drain Required: _____ Linear feet

Authorized State Agent


Moh W. NEH

Date 10-12-25

Oakmont - Lot #358
AS BUILT - APPROVED BY ALEX ADAMS
158 Travelers Way - Harnett County
Ascot Corporation, LLC
PIN# 0507-63-6660

*Not a Survey
Sketched from a plot plan supplied by owner

System: Gravity to D-Box
Lines: 1-3 (225)
LTAR: 0.6
20" Max Trench Bottom
Accepted Status System
Repair: Gravity to D-Box
Lines: 4-6 (200')
LTAR: 0.6
18" Max Trench Bottom
Accepted Status System

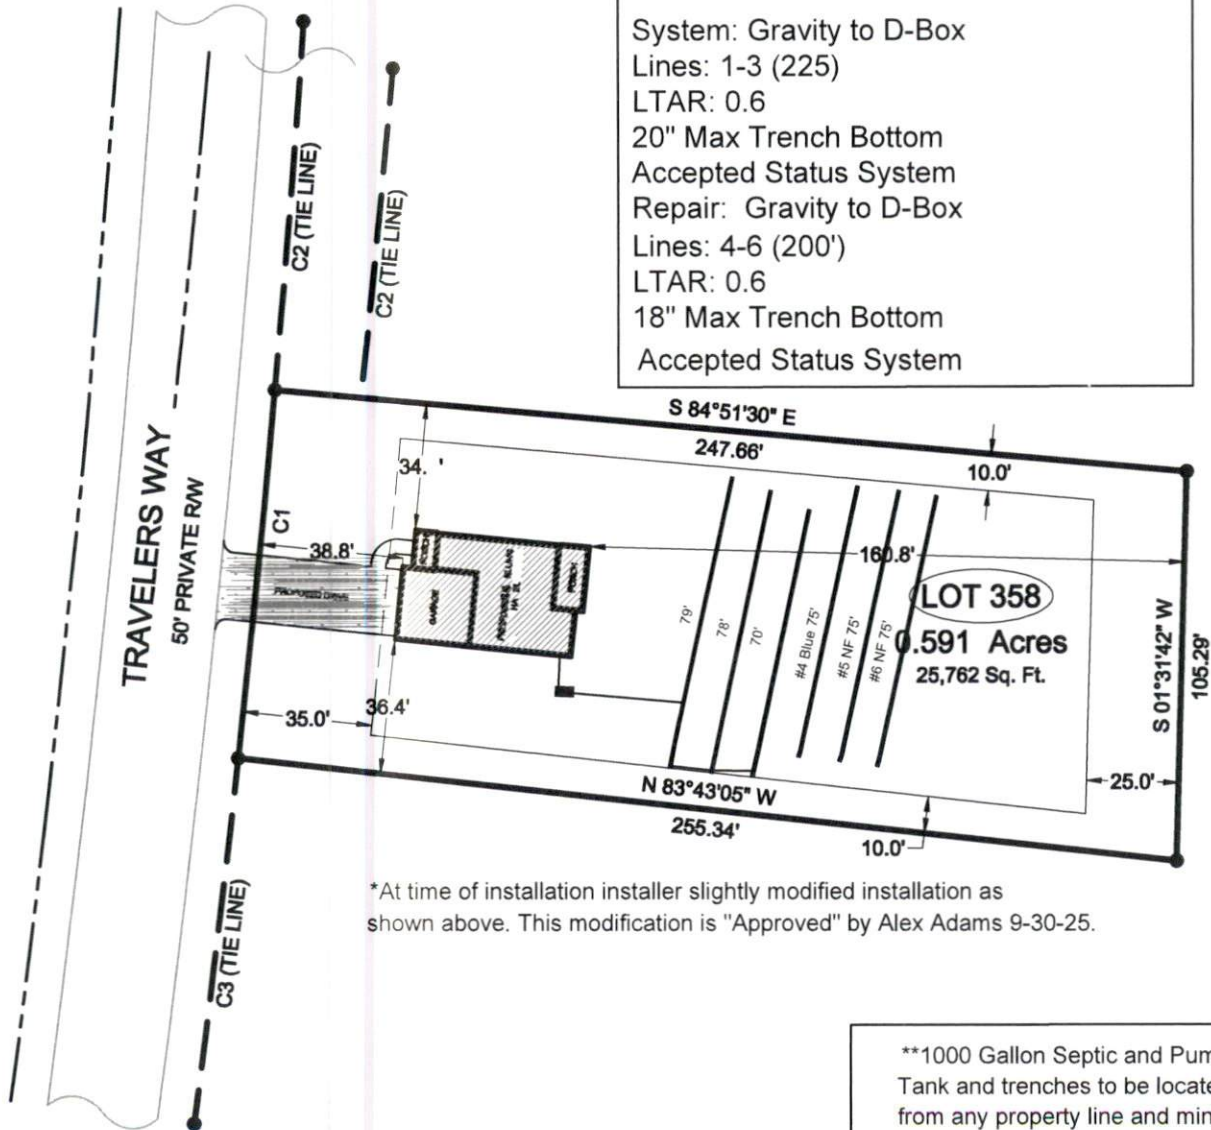

**1000 Gallon Septic and Pump Tank
Tank and trenches to be located minimum of 10'
from any property line and minimum of 5'
from any building foundation.
*Do Not Cut, Fill, or Alter Drainfield or Repair Area
*Comply with all setbacks
*Contact local health dept. and/or Alex Adams prior to
or during installation with any questions or concerns.

Adams
Soil Consulting
919-414-6761
Job #1968
9-30-25

GRAPHIC SCALE
1" = 50'

