

# The Cedar Springs

## GENERAL NOTES:

1. ALL KITCHEN AND UTILITY COUNTERTOPS ARE SHOWN AS 2'-0" WIDE UNLESS STATED OTHERWISE.
2. ALL BATHROOM LAVATORY COUNTERTOPS SHOWN AS 1'-10" WIDE.
3. ATTIC SPACES MUST PROVIDE 1 SQ. FT. VENTILATION PER 150 SQ. FT. OF AREA UNLESS OTHERWISE NOTED. (ATTIC'S R306)
4. ALL INTERIOR DIMENSIONS ARE FROM STUD FACE TO STUD FACE.
5. ALL INTERIOR WALL THICKNESS SHOWN AS 4" UNLESS NOTED OTHERWISE.
6. THE CONTRACTOR SHALL VERIFY ALL DIMENSIONS BEFORE COMMENCING WORK.
7. DRYER VENT MUST HAVE MAX LENGTH 25'
8. PURCHASER OF THIS PLAN ASSUMES LIABILITY FOR ANY MODIFICATIONS MADE TO THE LAYOUT OF THIS PLAN.
9. ALL WOOD FRAMING SHALL BE NO. 2 GRADE - SOUTHERN PINE LUMBER. ALL CEILING JOISTS SPANS ARE BASED ON TABLE R602.3.1 (2) OF THE IRC. 2021 AND ARE DESIGNED FOR ATTICS WITH LIMITED STORAGE. (REFER TO FOUNDATION SHEET FOR SPANS)
10. RE: SEC. 308 GLAZING IN HAZARDOUS LOCATIONS 4 TEMPERED GLASS FOR WINDOWS THAT ARE WITHIN 24" OF THE DOOR IN THE CLOSED POSITION, PROVIDING THE WINDOW IS LESS THAN 60" ABOVE THE FLOOR. (R308 IRC. 2021)
11. MASONRY VENEER SHALL BE ANCHORED TO THE SUPPORTING WALL WITH CORROSION-RESISTANT METAL TIES SPACED NOT MORE THAN 32" ON CENTER HORIZONTALLY AND 24" VERTICALLY AND SHALL SUPPORT NOT MORE THAN 2.61 SQ. FEET OF WALL PER SECTION R103.8.41 IF APPLICABLE
12. VENT HOOD IN KITCHEN MUST VENT TO THE OUTSIDE. MICROWAVE HOODS MUST VENT TO THE OUTSIDE WHERE APPLICABLE.

## WIND ZONE NOTES

1. VERIFY WINDOW CODE REQUIREMENTS AT EACH BUILDING LOCATION, AND INSTALL WINDOWS AS PER CODE. REQUIREMENTS WILL VARY FROM DOUBLE INSULATED VINYL TO IMPACT RESISTANT DOUBLE INSULATED VINYL WINDOWS.
2. ALL WINDOWS SHALL COMPLY WITH THE GOVERNING IRC/IBC. WINDOWS SHALL BE SELECTED BASED UPON THE COMPONENT AND GLAZING DESIGN PRESSURES.
3. CONTRACTOR RESPONSIBLE FOR ANCHORAGE OF BOTTOM PLATE AND WALL STUDS TO FOUNDATION IN COMPLIANCE WITH THE GOVERNING EDITION OF IRC/IBC 1603.

## HEADER SPANS FOR LOAD BEARING WALLS:

- SINGLE STORY:
- 2 PLY 2"x6" 4'-2" MAX
  - 2 PLY 2"x8" 5'-4" MAX
  - 2 PLY 2"x10" 7'-6" MAX
- 2 STORY:
- 2 PLY 2"x6" 3'x1" MAX
  - 2 PLY 2"x8" 4'x6" MAX
  - 2 PLY 2"x10" 6'x2" MAX

REFER TO IRC R602.1 (1) AND (2) FOR ADDITIONAL HEADER AND GIRDER SPANS

## NOTE:

ROOF OVERHANG ON NEW CONSTRUCTION TYPICAL 12" FROM FACE OF STUD UNLESS OTHERWISE NOTED.

GENERAL CONTRACTOR TO PROVIDE ADEQUATE ROOF VENTILATION BUILDING SYSTEMS PER IRC CODE (SECTION R806). SYSTEMS TO BE USED TO MEET ROOF VENTILATION REQUIREMENTS ARE AS FOLLOWS: CONTINUOUS RIDGE VENTS, POWER VENTS, BOX VENTS, AND GABLE/DORMER VENTS WHEN APPROVED BY OWNER.

SOFFIT VENTS TO BE USED ONLY IN ACCORDANCE W/ IRC CODE (SECTION R302 AND TABLE R302.1) TO ACCOMMODATE APPROPRIATE FIRE SEPARATION DISTANCES.

## GENERAL MATERIALS:

1. EXTERIOR WALLS:
  - REINFORCED CEMENTITIOUS SIDING
  - "TY VEK" BUILDING WRAP
  - 1/2" O.S.B. SHEATHING
  - R-19 BATT INSULATION
2. INTERIOR WALLS:
  - 2x4 STUDS @ 1'-4" O.C.
  - 1/2" GYPSUM BOARD INTERIOR
3. CEILING:
  - 2x Trusses @ 2'0" o.c.
  - R38 INSULATION
  - 1/2" GYPSUM BOARD
4. ROOF SYSTEM:
  - 30 YEAR FIBERGLASS SHINGLES
  - 1/2" O.S.B. OR CDX PLYWOOD
  - ~~STANDING SEAM METAL ROOF~~
  - \*BELT ROOF TRUSSES (CONFIRM W/ LOCAL CODE)

NOTE: ALL ROOFING PRODUCTS, MATERIALS AND INSTALLATION SHALL COMPLY WITH THE REQUIREMENTS UNLESS CHANGED BY GENERAL CONTRACTOR AT OWN DISCRETION.

## PROTECTION AGAINST TERMITES:

1. SUBTERRANEAN TERMITES CONTROL IN AREAS FAVORABLE TO TERMITE DAMAGE METHODS OF PROTECTION SHALL BE BY CHEMICAL SOIL TREATMENT, PRESSURE-TREATED WOOD, NATURALLY TERMITE RESISTANT WOOD OR PHYSICAL BARRIERS (SUCH AS METAL OR PLASTIC TERMITES SHIELDS), OR ANY COMBINATION OF THESE METHODS.
2. CHEMICAL SOIL TREATMENT: THE CONCENTRATION, RATE OF APPLICATION AND TREATMENT METHOD OF THE TERMITICIDE LABEL.
3. PRESSURE-TREATED AND NATURALLY RESISTANT WOOD: HEARTWOOD OF REDWOOD AND EASTERN RED CEDAR SHALL BE CONSIDERED TERMITE RESISTANT. PRESSURE-TREATED WOOD AND NATURALLY TERMITE RESISTANT WOOD SHALL NOT BE USED AS A PHYSICAL BARRIER UNLESS A BARRIER CAN BE INSPECTED FOR ANY TERMITES SHELTER TUBES AROUND THE INSIDE AND OUTSIDE EDGES AND JOINTS OF A BARRIER.
4. FIELD TREATMENT: FIELD CUT ENDS, NOTCHES, AND DRILLED HOLES OF PRESSURE-TREATED WOOD SHALL BE RETREATED IN THE FIELD ACCORDING TO AUPA M4.

## WINDOW EGRESS NOTES

1. R310.1 - MEANS OF EGRESS. DWELLINGS SHALL BE PROVIDED WITH A MEANS OF EGRESS IN ACCORDANCE WITH THIS SECTION. THE MEANS OF EGRESS SHALL PROVIDE A CONTINUOUS AND UNOBSTRUCTED PATH OF VERTICAL AND HORIZONTAL EGRESS TRAVEL FROM ALL PORTIONS OF THE DWELLING TO THE REQUIRED EGRESS DOOR WITHOUT REQUIRING TRAVEL THROUGH A GARAGE. THE REQUIRED EGRESS DOOR SHALL OPEN DIRECTLY INTO A PUBLIC WAY OR TO A YARD OR COURT THAT OPENS TO A PUBLIC WAY.
2. R310.2.1 - MINIMUM OPENING AREA. EMERGENCY AND ESCAPE RESCUE OPENINGS SHALL HAVE A NET CLEAR OPENING OF NOT LESS THAN 5.7 SQUARE FEET (0.530 M<sup>2</sup>). THE NET CLEAR OPENING DIMENSIONS REQUIRED BY THIS SECTION SHALL BE OBTAINED BY THE NORMAL OPERATION OF THE EMERGENCY ESCAPE AND RESCUE OPENING FROM THE INSIDE. THE NET CLEAR HEIGHT OPENING SHALL BE NOT LESS THAN 24 INCHES (610 MM) AND THE NET CLEAR WIDTH SHALL BE NOT LESS THAN 20 INCHES (508 MM). EXCEPTION: GRADE FLOOR OR BELOW GRADE OPENINGS SHALL HAVE A NET CLEAR OPENING OF NOT LESS THAN 5 SQUARE FEET (0.465 M<sup>2</sup>).
3. R310.2.3 - WINDOW SILL HEIGHT. WHERE A WINDOW IS PROVIDED AS THE EMERGENCY ESCAPE AND RESCUE OPENING, IT SHALL HAVE A SILL HEIGHT OF NOT MORE THAN 44 INCHES (1118 MM) ABOVE THE FLOOR, WHERE THE SILL HEIGHT IS BELOW GRADE, IT SHALL BE PROVIDED WITH A WINDOW WELL IN ACCORDANCE WITH SECTION R310.4.1.
4. R310.4.1 - WINDOW WELLS. THE HORIZONTAL AREA OF THE WINDOW WELL SHALL BE NOT LESS THAN 9 SQUARE FEET (0.83 M<sup>2</sup>) WITH A HORIZONTAL PROJECTION AND WIDTH OF NOT LESS THAN 36 INCHES (914 MM). THE AREA OF THE WINDOW WELL SHALL ALLOW THE EMERGENCY ESCAPE AND RESCUE OPENING TO BE FULLY OPENED. EXCEPTION: THE LADDER OR STEPS PROVIDED BY SECTION R310.4.2 - SHALL BE PERMITTED TO ENCR OACH NOT MORE THAN 6 INCHES (152 MM) INTO THE REQUIRED DIMENSIONS OF THE WINDOW WELL.
5. R310.4.2 - LADDER AND STEPS. WINDOW WELLS WITH A VERTICAL DEPTH GREATER THAN 44 INCHES (1118 MM) SHALL BE EQUIPPED WITH A PERMANENTLY AFFIXED LADDER OR STEPS USABLE WITH THE WINDOW IN THE FULLY OPEN POSITION. LADDERS OR STEPS REQUIRED BY THIS SECTION SHALL NOT BE REQUIRED TO COMPLY WITH SECTION R310.1 LADDERS OR RUNGS SHALL HAVE AN INSIDE WIDTH OF NOT LESS THAN 12 INCHES (305 MM). SHALL PROJECT NOT LESS THAN 3 INCHES (76 MM) FROM THE WALL AND SHALL BE SPACED NOT MORE THAN 18 INCHES (457 MM) ON CENTER VERTICALLY FOR THE FULL HEIGHT OF THE WINDOW WELL.
6. R312.2 - WINDOW FALL PROTECTION. WINDOW FALL PROTECTION SHALL BE PROVIDED IN ACCORDANCE WITH SECTIONS R312.1 AND R312.2.2.
7. R312.2.1 - WINDOW OPENING HEIGHT. IN DWELLING UNITS, WHERE THE TOP OF THE SILL OF AN OPERABLE WINDOW OPENING IS LOCATED LESS THAN 24 INCHES (610 MM) ABOVE THE FINISHED FLOOR AND GREATER THAN 12 INCHES (305 MM) ABOVE THE FINISHED FLOOR OR OTHER SURFACE BELOW ON THE EXTERIOR OF THE BUILDING, THE OPERABLE WINDOW SHALL COMPLY WITH ONE OF THE FOLLOWING:
  1. OPERABLE WINDOW OPENINGS WILL NOT ALLOW A 4-INCH-DIAMETER (102 MM) SPHERE TO PASS THROUGH THE OPENING WHERE THE OPENINGS ARE IN THEIR LARGEST OPENED POSITION.
  2. OPERABLE WINDOWS ARE PROVIDED WITH WINDOW FALL PREVENTION DEVICES THAT COMPLY WITH ASTM F2090.
8. R312.2.2 - EMERGENCY ESCAPE AND RESCUE OPENINGS. WINDOW OPENING CONTROL DEVICES SHALL COMPLY WITH ASTM F 2090. THE WINDOW OPENING CONTROL DEVICE, AFTER OPERATION TO RELEASE THE CONTROL DEVICE, ALLOWING THE WINDOW TO FULLY OPEN, SHALL NOT REDUCE THE NET CLEAR OPENING AREA OF THE WINDOW INTO LESS THAN THE AREA REQUIRED BY SECTIONS R310.2.1 AND R310.2.2.

## CODE DISCLAIMER:

1. THESE PLANS WERE DESIGNED TO MEET IRC 2021 AT THE TIME OF THEIR CREATION AND MORE SPECIFICALLY THE MINIMAL LOCAL CODES OF THE SOUTH LOUISIANA AREA. IT IS HIGHLY RECOMMENDED THAT THESE PLANS BE REVIEWED BY A LOCAL STRUCTURAL ENGINEER PRIOR TO CONSTRUCTION.
2. BEAMS AND FLOOR JOISTS ARE NOT SIZED DUE TO THE MANY GEOGRAPHIC LOCATIONS THESE PLANS ARE SOLD. THESE ITEMS SHALL BE SIZED BY A LOCAL ENGINEER OR MANUFACTURER.
3. ALL CEILING & FLOOR JOISTS (IF CONVENTIONAL FRAMING) SHOULD BE SIZED USING THE LATEST VERSION OF THE IRC OR APPLICABLE CODES AT SITE TO MEET THE LOCAL REQUIREMENTS SUCH AS SNOW LOADS AND OTHER FACTORS. THE CEILING JOIST SIZES LABELED (IF PRESENT) WERE SIZED USING THE 2021 IRC AT THE TIME OF THEIR CREATION. THEY MUST BE VERIFIED AND MODIFIED AS REQUIRED TO MEET THE LATEST EDITION OF THE (IRC) INTERNATIONAL RESIDENTIAL CODE.
4. ALL FOUNDATION AND FOOTING DETAILS SHALL BE REVIEWED AND APPROVED BY A LOCAL ENGINEER.
5. CONTRACTOR SHALL PROVIDE ALL HIGH WIND STRAPPING AND ANCHOR BOLTS AS REQUIRED BY THE LOCAL CODE REQUIREMENTS AND THE LATEST VERSION OF THE IRC.

MADDEN HOME DESIGN, LLC NOT BEING AN ARCHITECTURAL OR ENGINEERING FIRM ASSUMES NO LIABILITY FOR STRUCTURAL, OR ARCHITECTURAL DESIGN. INTEGRITY, EVERY EFFORT HAS BEEN MADE TO INSURE ALL DIMENSIONS ARE CORRECT AND ENVIRONMENTAL REQUIREMENTS HAVE BEEN OCCURRED. IT IS THE SOLE RESPONSIBILITY OF THE CONTRACTOR AND/OR OBTAINER AT HIS OWN EXPENSE AND NOT THE RESPONSIBILITY OF THE DRAFTING SERVICE. THE FIELD VERIFICATION OF DIMENSIONS AND COMPLIANCE WITH ALL APPLICABLE LOCAL, STATE AND FEDERAL RESIDENTIAL CODES 2021.

RESIDENCE OF  
**LARRY GODWIN JR.**  
MELISSA R. GODWIN

MADDEN HOME DESIGN  
8375 Rushing Road  
Denham Springs, Louisiana  
70726  
Phone: (225) 791-2912

Project No: CEDAR SPRINGS  
W. BONUS  
DATE: SEPTEMBER 3, 2024  
DRAWN BY: Steven Madden  
DESIGNED BY: Steven Madden

COPYRIGHT NOTE: © These Plans Are Subject To Federal Copyright Laws And Are To Be Used For The Lot Number And Subdivision Indicated In This Title Block Only. Use On Any Other Site Is Prohibited.


© COPYRIGHT 2022

Sheet Title  
**COVER SHEET**

Sheet:  
A0.0

□ Preliminary Dwg.  
□ Bidding Doc.  
□ Construction Doc.



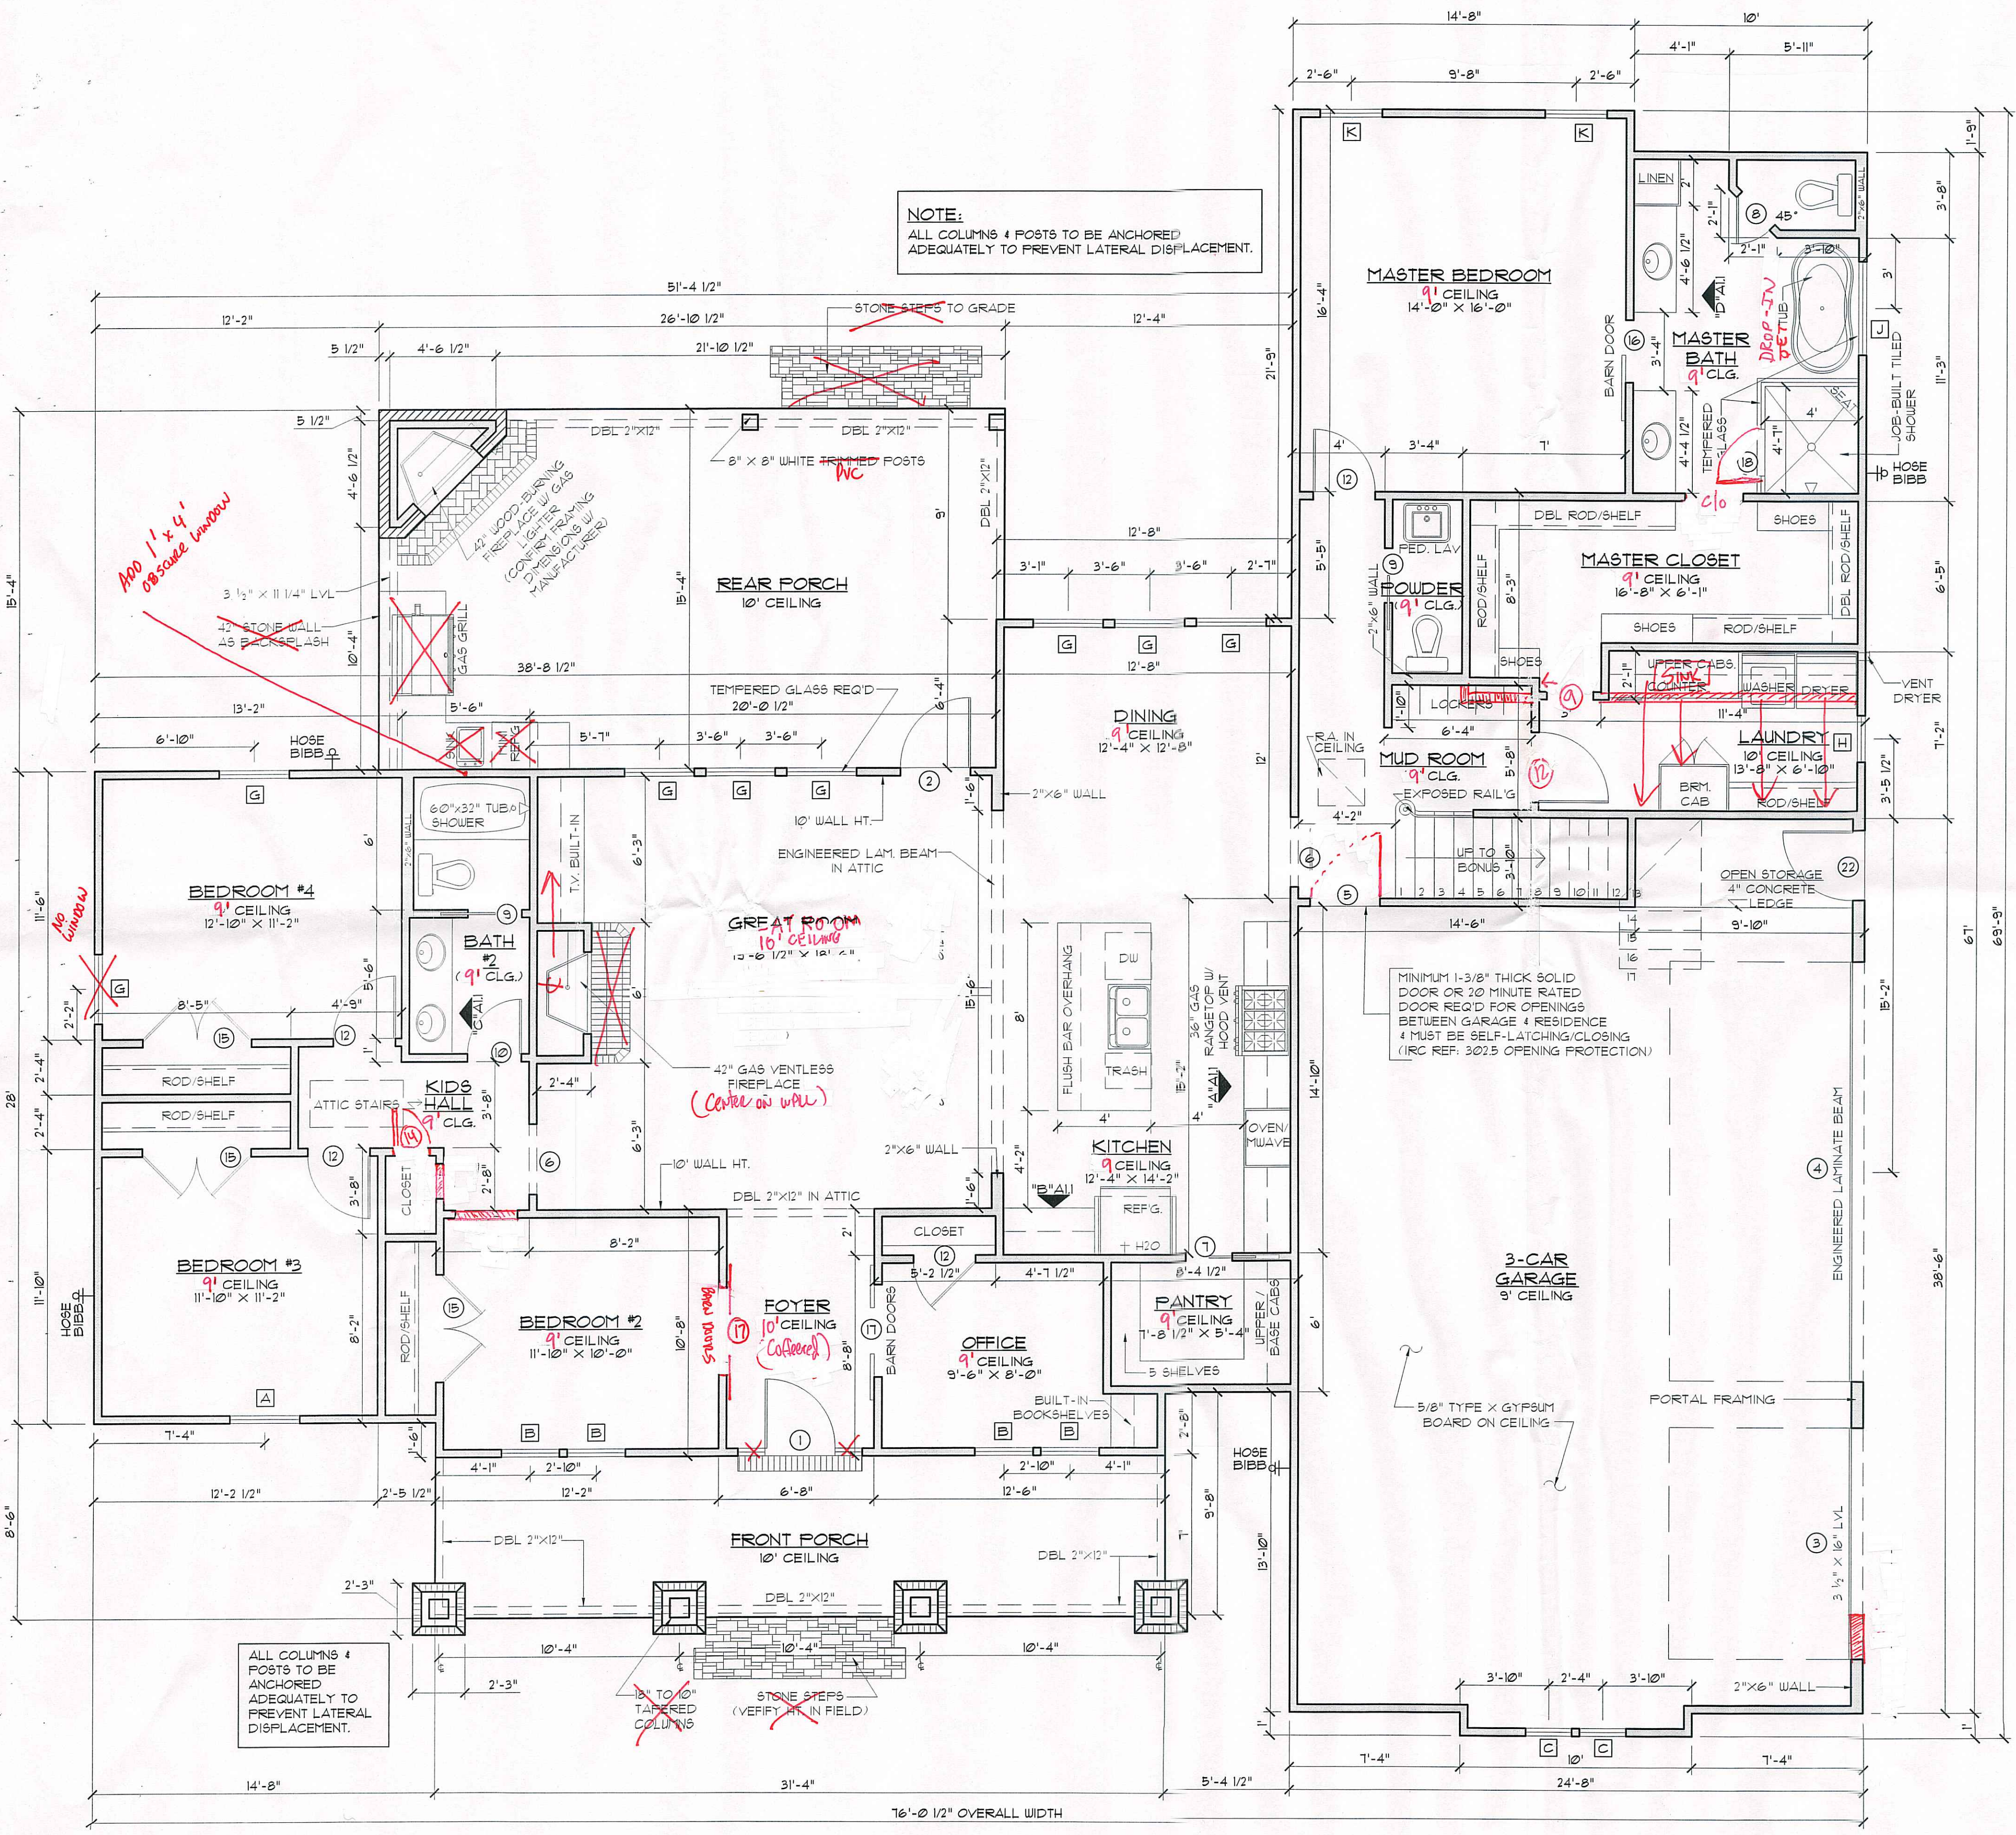

### DOOR SCHEDULE


MARK	SIZE	DESCRIPTION	QTY.
1	3'0" x 8'0"	CRAFTSMAN 6 LITE SOLID WOOD DOOR W/ 12-SHELF LIGHTS	1
2	3'0" x 8'0"	EXTERIOR 4 LITE FULL FRENCH WOOD DOOR	1
3	8'0" x 8'0"	O.H. METAL CARRIAGE-STYLE GARAGE DOOR W/ LITES & OPENER	1
4	18'0" x 8'0"	O.H. METAL CARRIAGE-STYLE GARAGE DOOR W/ LITES & OPENER	1
5	3'0" x 6'8"	EXTERIOR HORIZONTAL 6 PANEL METAL DOOR	1
6	3'0" x 8'0"	CASED OPENING	2
7	2'0" x 8'0"	INTERIOR HORIZONTAL 6 PANEL H.C. MASONITE FOCKET DOOR	1
8	2'0" x 6'8"	INTERIOR HORIZONTAL 6 PANEL H.C. MASONITE DOOR	2
9	2'4" x 6'8"	INTERIOR HORIZONTAL 6 PANEL H.C. MASONITE FOCKET DOOR	2
10	2'4" x 6'8"	INTERIOR HORIZONTAL 6 PANEL H.C. MASONITE DOOR	1
11	2'6" x 6'8"	INTERIOR HORIZONTAL 6 PANEL H.C. MASONITE DOOR	1
12	2'8" x 6'8"	INTERIOR HORIZONTAL 6 PANEL H.C. MASONITE DOOR	5
13	3'0" x 6'8"	INTERIOR HORIZONTAL 6 PANEL H.C. MASONITE DOOR	1
14	1'6" x 6'8"	INTERIOR HORIZONTAL 6 PANEL H.C. MASONITE DOOR	1
15	DBL 2'4" x 6'8"	INTERIOR HORIZONTAL 6 PANEL H.C. MASONITE DOORS	3 PAIR
16	2'8" x 6'8"	INTERIOR BARN DOOR - OWNER SELECT	1
17	DBL 2'0" x 8'0"	INTERIOR BARN DOORS - OWNER SELECT	1 PAIR
18	2'0" x 6'0"	TEMPERED FRAMELESS GLASS SHOWER DOOR	1
19	2'8" x 6'8"	INTERIOR HORIZONTAL 6 PANEL H.C. MASONITE DOOR	1
20	2'4" x 6'8"	SOLID CORE MASONITE ATTIC ACCESS DOOR	1
21	2'4" x 6'8"	INTERIOR HORIZONTAL 6 PANEL H.C. MASONITE DOOR	2
22	3'0" x 6'8"	EXTERIOR 4 LITE 3/4 FRENCH METAL DOOR	1

### WINDOW SCHEDULE

*No grids*

MARK	OPENING SIZE	DESCRIPTION	QTY.
A	3'0" x 6'0"	VINYL SINGLE HUNG WINDOW INSULATED	1
B	2'6" x 6'0"	VINYL SINGLE HUNG WINDOW INSULATED	4
C	2'0" x 4'0"	VINYL SINGLE HUNG WINDOW INSULATED	2
D	2'0" x 4'0"	VINYL FIXED WINDOW INSULATED (SEE SHEET A2.0)	1
E	2'0" x 3'6"	VINYL FIXED WINDOW INSULATED (SEE SHEET A2.0)	2
F	2'0" x 5'0"	VINYL SINGLE HUNG WINDOW INSULATED	3
G	3'0" x 6'0"	VINYL SINGLE HUNG WINDOW INSULATED	8
H	2'0" x 4'0"	VINYL FIXED WINDOW INSULATED	1
J	4'0" x 4'0"	VINYL FT WINDOW INSULATED	1
K	2'8" x 6'0"	VINYL SINGLE HUNG WINDOW INSULATED	2

**IMPORTANT NOTE:**  
ALL EGRESS OR RESCUE WINDOWS FROM SLEEPING ROOMS MUST HAVE A MINIMUM NET CLEAR OPENING OF 5.7 SQUARE FEET. GRADE FLOOR WINDOWS MAY HAVE A MINIMUM NET CLEAR OPENING OF 5 SQUARE FEET. THE MINIMUM NET CLEAR OPENING HEIGHT SHALL BE 24". THE MINIMUM NET CLEAR OPENING WIDTH SHALL BE 20". MAXIMUM SILL HEIGHT - 44" AFF.

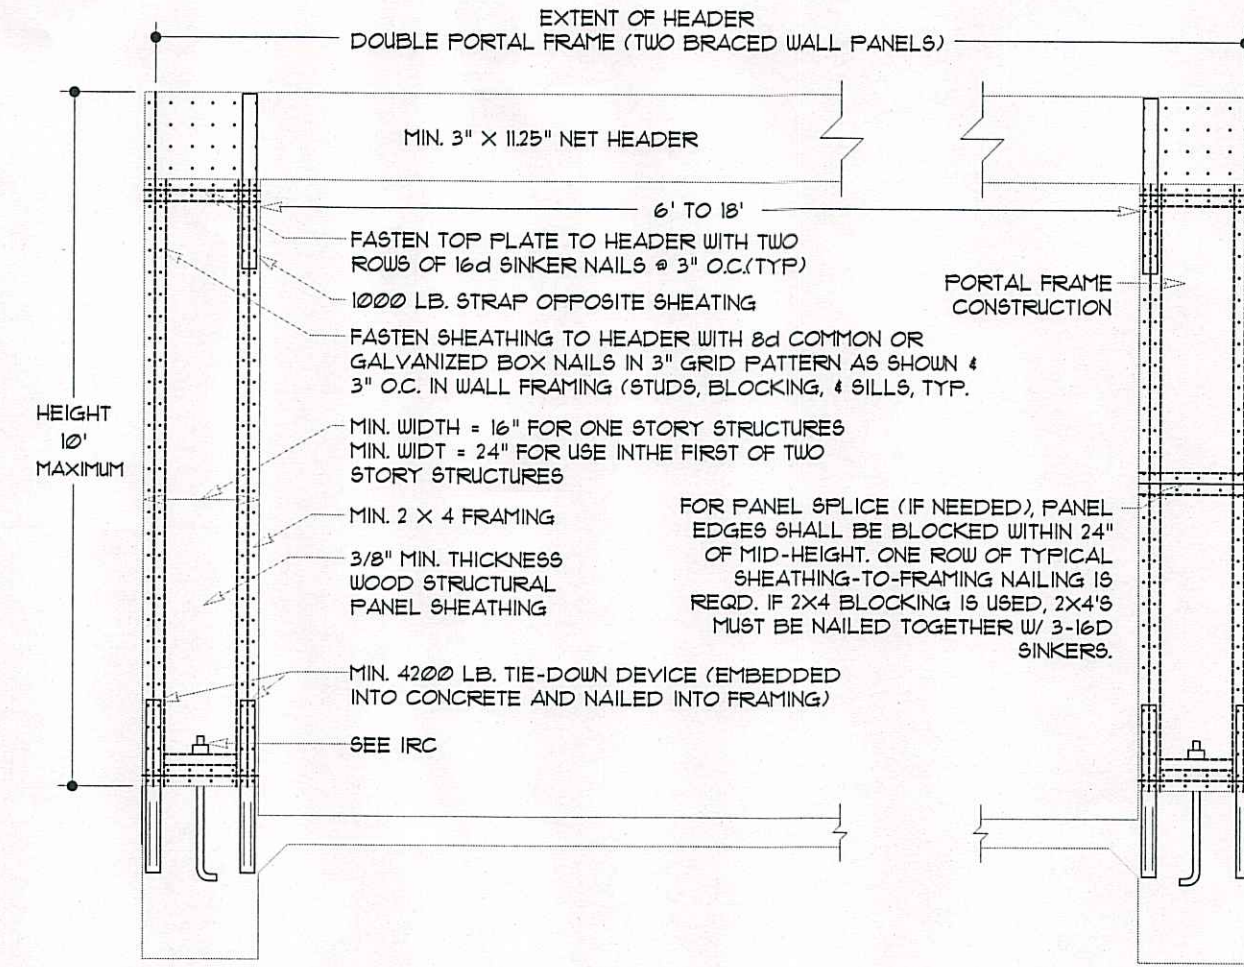

**GARAGE PORTAL DETAIL**  
NOT TO SCALE

### SQUARE FOOTAGE

MAIN LIVING	2352
BONUS ROOM	454
FRONT PORCH	218
REAR PORCH	410
GARAGE	896
TOTAL LIVING SQ. FT.	2846
TOTAL SQ. FT.	4371

**FLOOR PLAN**  
SCALE: 1/4" = 1'-0"

CONTRACTOR TO LOCATE WATER HEATER & A/C UNITS ON SITE

MADDEN HOME DESIGN, LLC NOT BEING AN ARCHITECTURAL OR ENGINEERING FIRM ASSUMES NO LIABILITY FOR STRUCTURAL OR ARCHITECTURAL DESIGN INTEGRITY. EVERY EFFORT HAS BEEN MADE TO INSURE ALL DIMENSIONS ARE CORRECT AND ENVIRONMENTAL REGULATIONS HAVE BEEN OBTAINED AT THE TIME OF COMMISSION. MADDEN HOME DESIGN, LLC DOES NOT ASSUME RESPONSIBILITY OF THE CONTRACTOR AND/OR OMISSION AT HIS OWN EXPENSE AND NOT THE RESPONSIBILITY OF THE DRAFTING SERVICE. CONTRACTOR IS RESPONSIBLE FOR VERIFICATION OF DIMENSIONS IN THE FIELD AND SHALL BUILD HOME IN ACCORDANCE WITH THE INTERNATIONAL RESIDENTIAL CODE 2021.

RESIDENCE OF  
**LARRY GODWIN JR.**  
*Melissa P. Godwin*

**MADDEN** HOME DESIGN  
8375 Rushing Road  
Denham Springs, Louisiana 70726  
Phone: (225) 791-2912


**A B D**

Project No.: CEDAR SPRINGS W. BONUS  
DATE: SEPTEMBER 3, 2024  
DRAWN BY: Steven Madden  
DESIGNED BY: Steven Madden  
COPYRIGHT NOTE: © These Plans Are Subject To Federal Copyright Laws And Are To Be Used For The Lot Number And Subdivision Indicated In This Title Block Only. Use On Any Other Site Is Prohibited.  
© COPYRIGHT 2024


Sheet Title  
**FLOOR PLAN**  
Sheet:  
**A1.0**

□ Preliminary Dwg.  
□ Bidding Doc.  
□ Construction Doc.




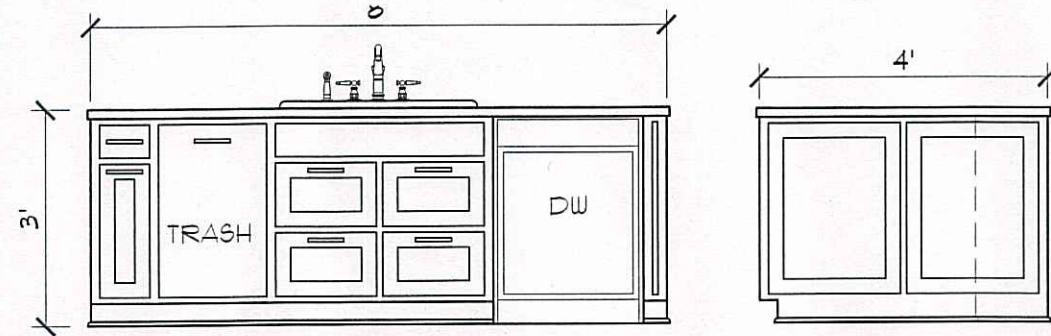


**ISLAND ELEVATIONS**  
SCALE: 3/8" = 1'-0"

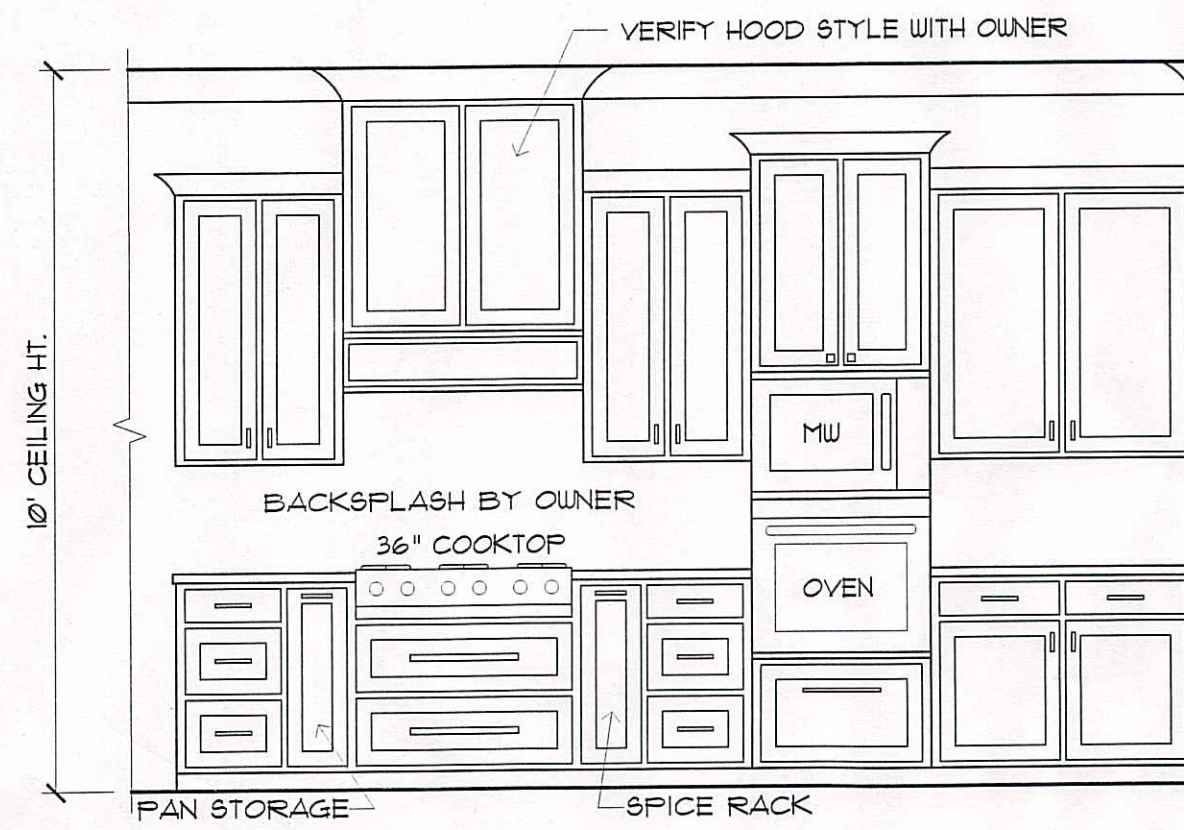


**A KITCHEN ELEVATION**  
SCALE: 3/8" = 1'-0"

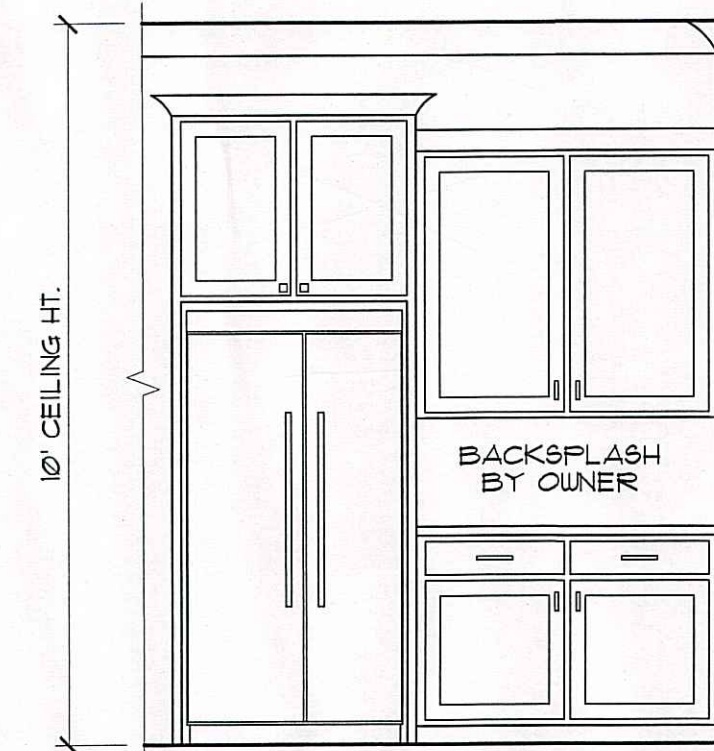


**B KITCHEN ELEVATION**  
SCALE: 3/8" = 1'-0"

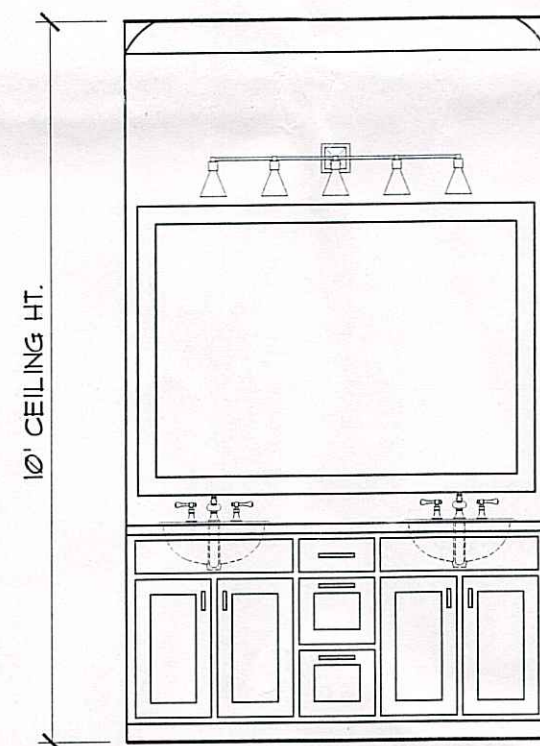


**C BATH #2 ELEV.**  
SCALE: 3/8" = 1'-0"

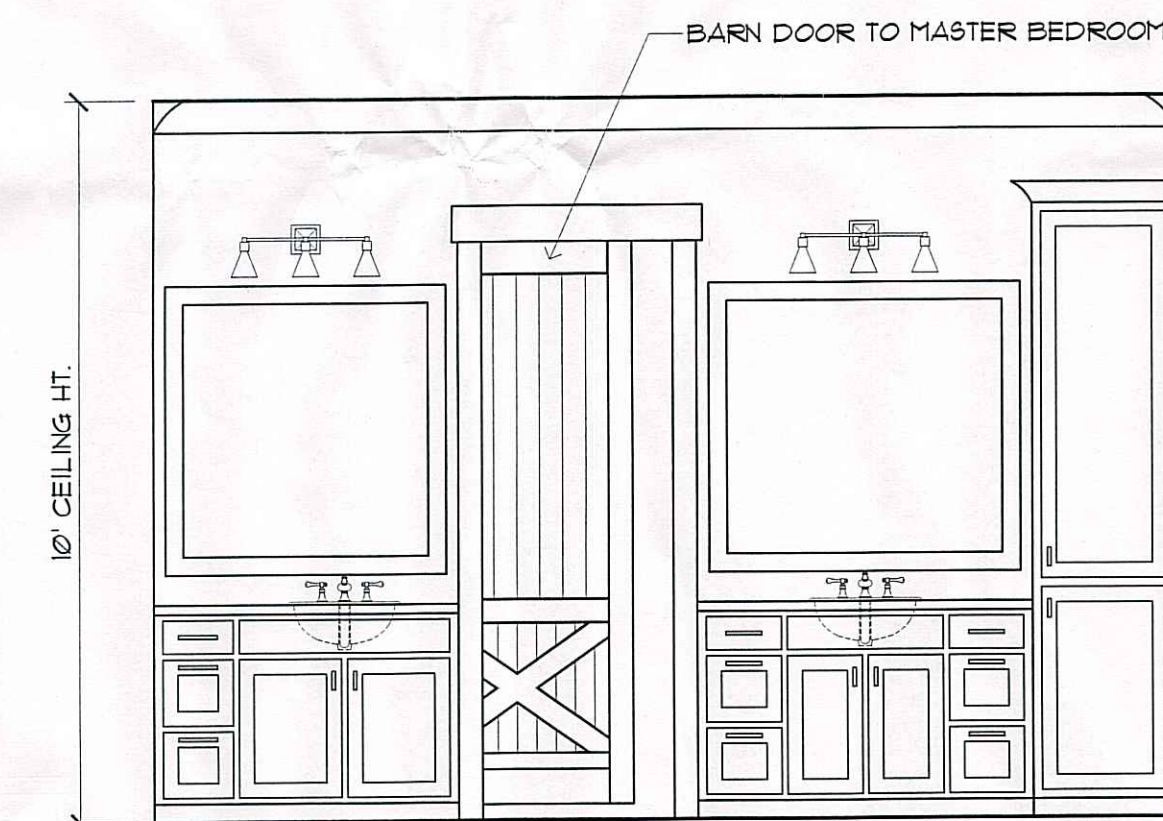


**D MASTER BATH ELEV.**  
SCALE: 3/8" = 1'-0"

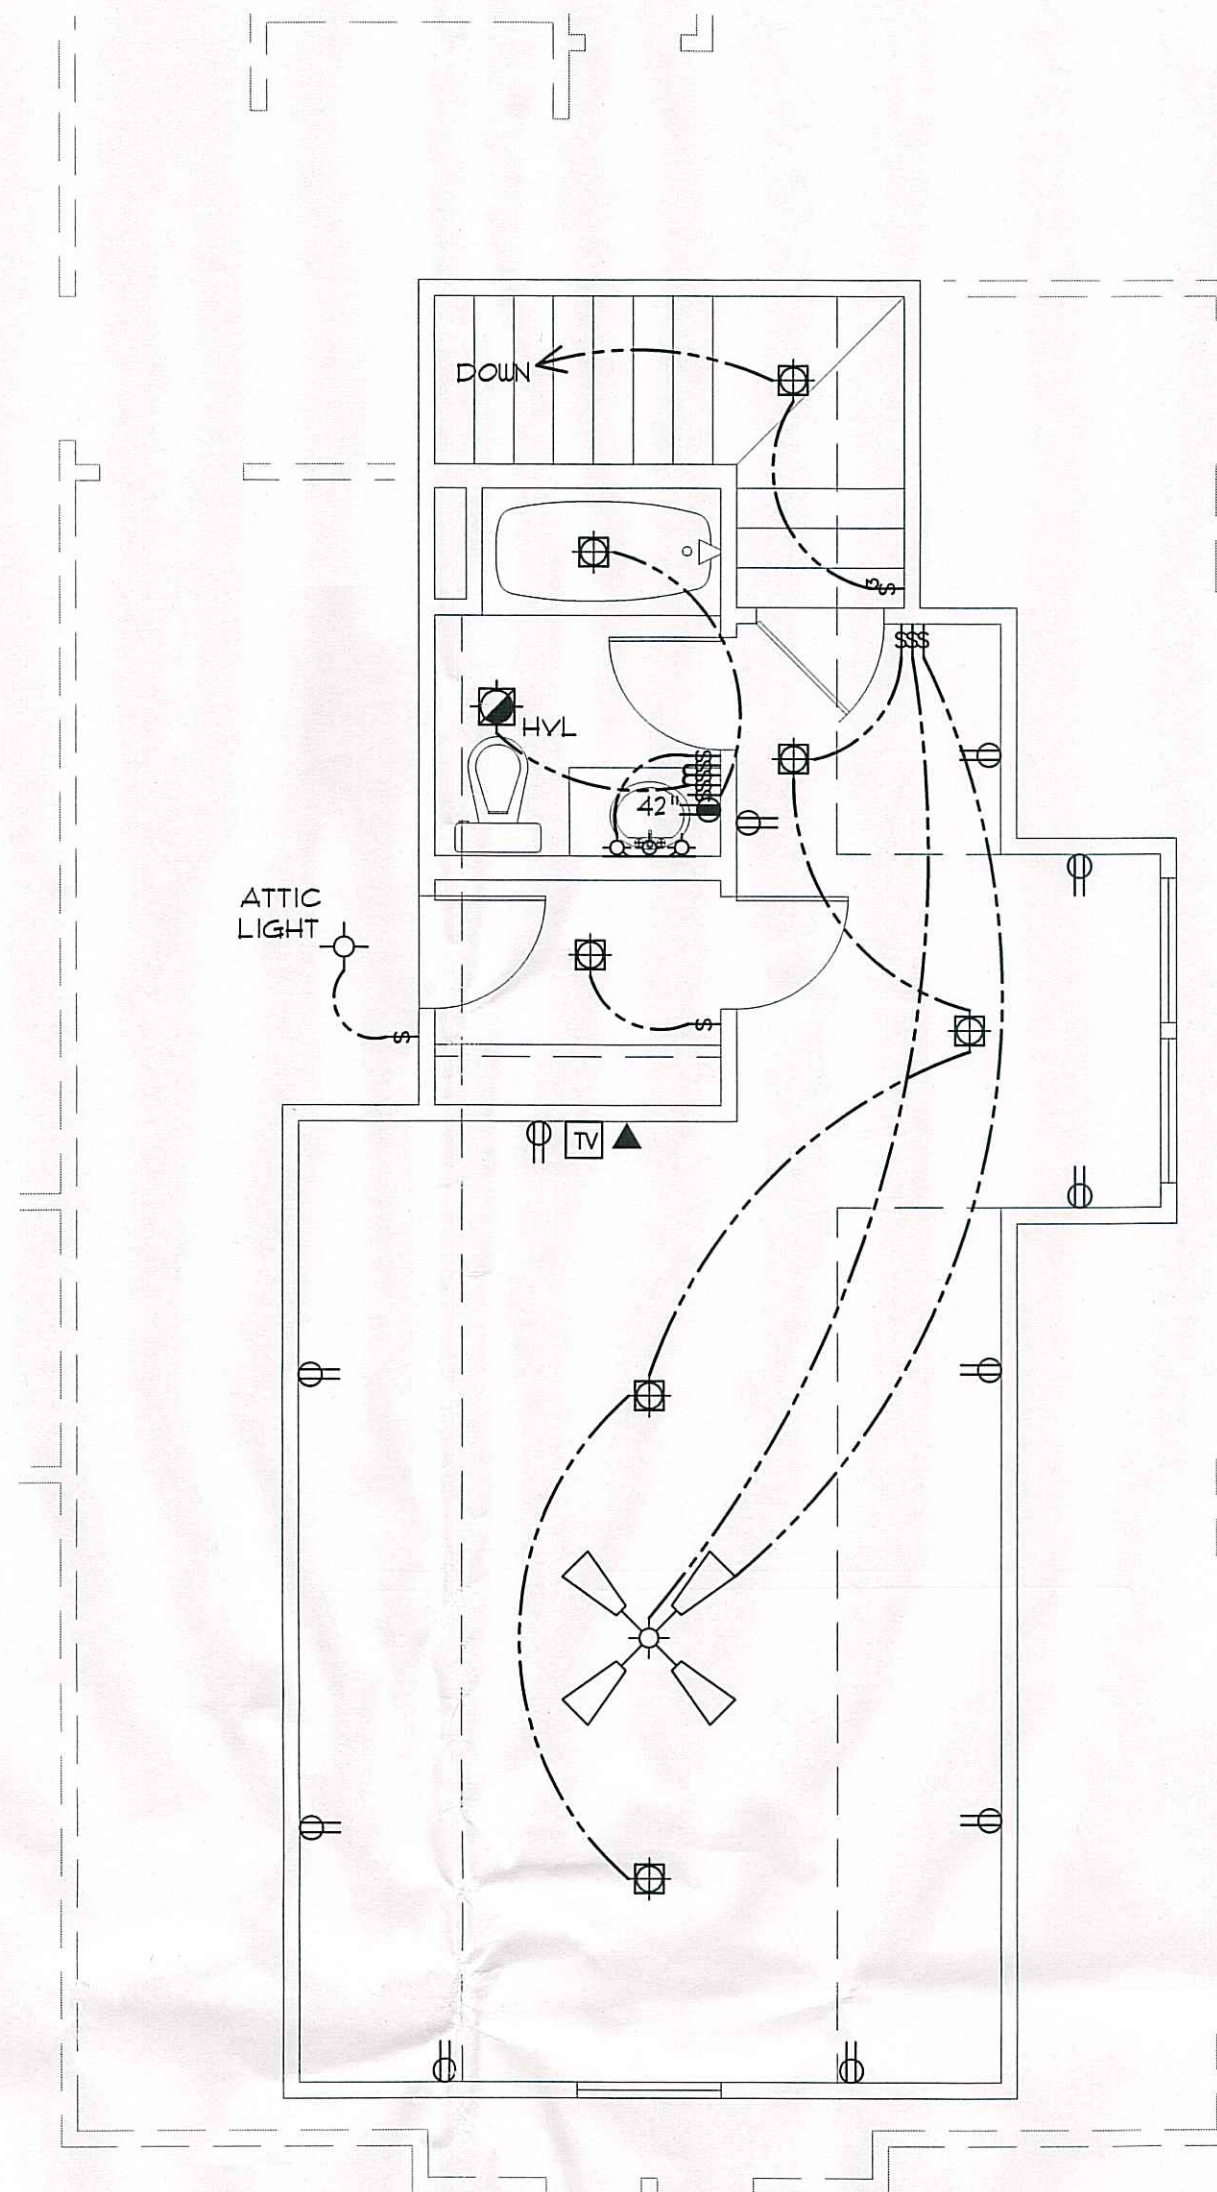


**BONUS ROOM ELECTRICAL PLAN**  
SCALE: 1/4" = 1'-0"

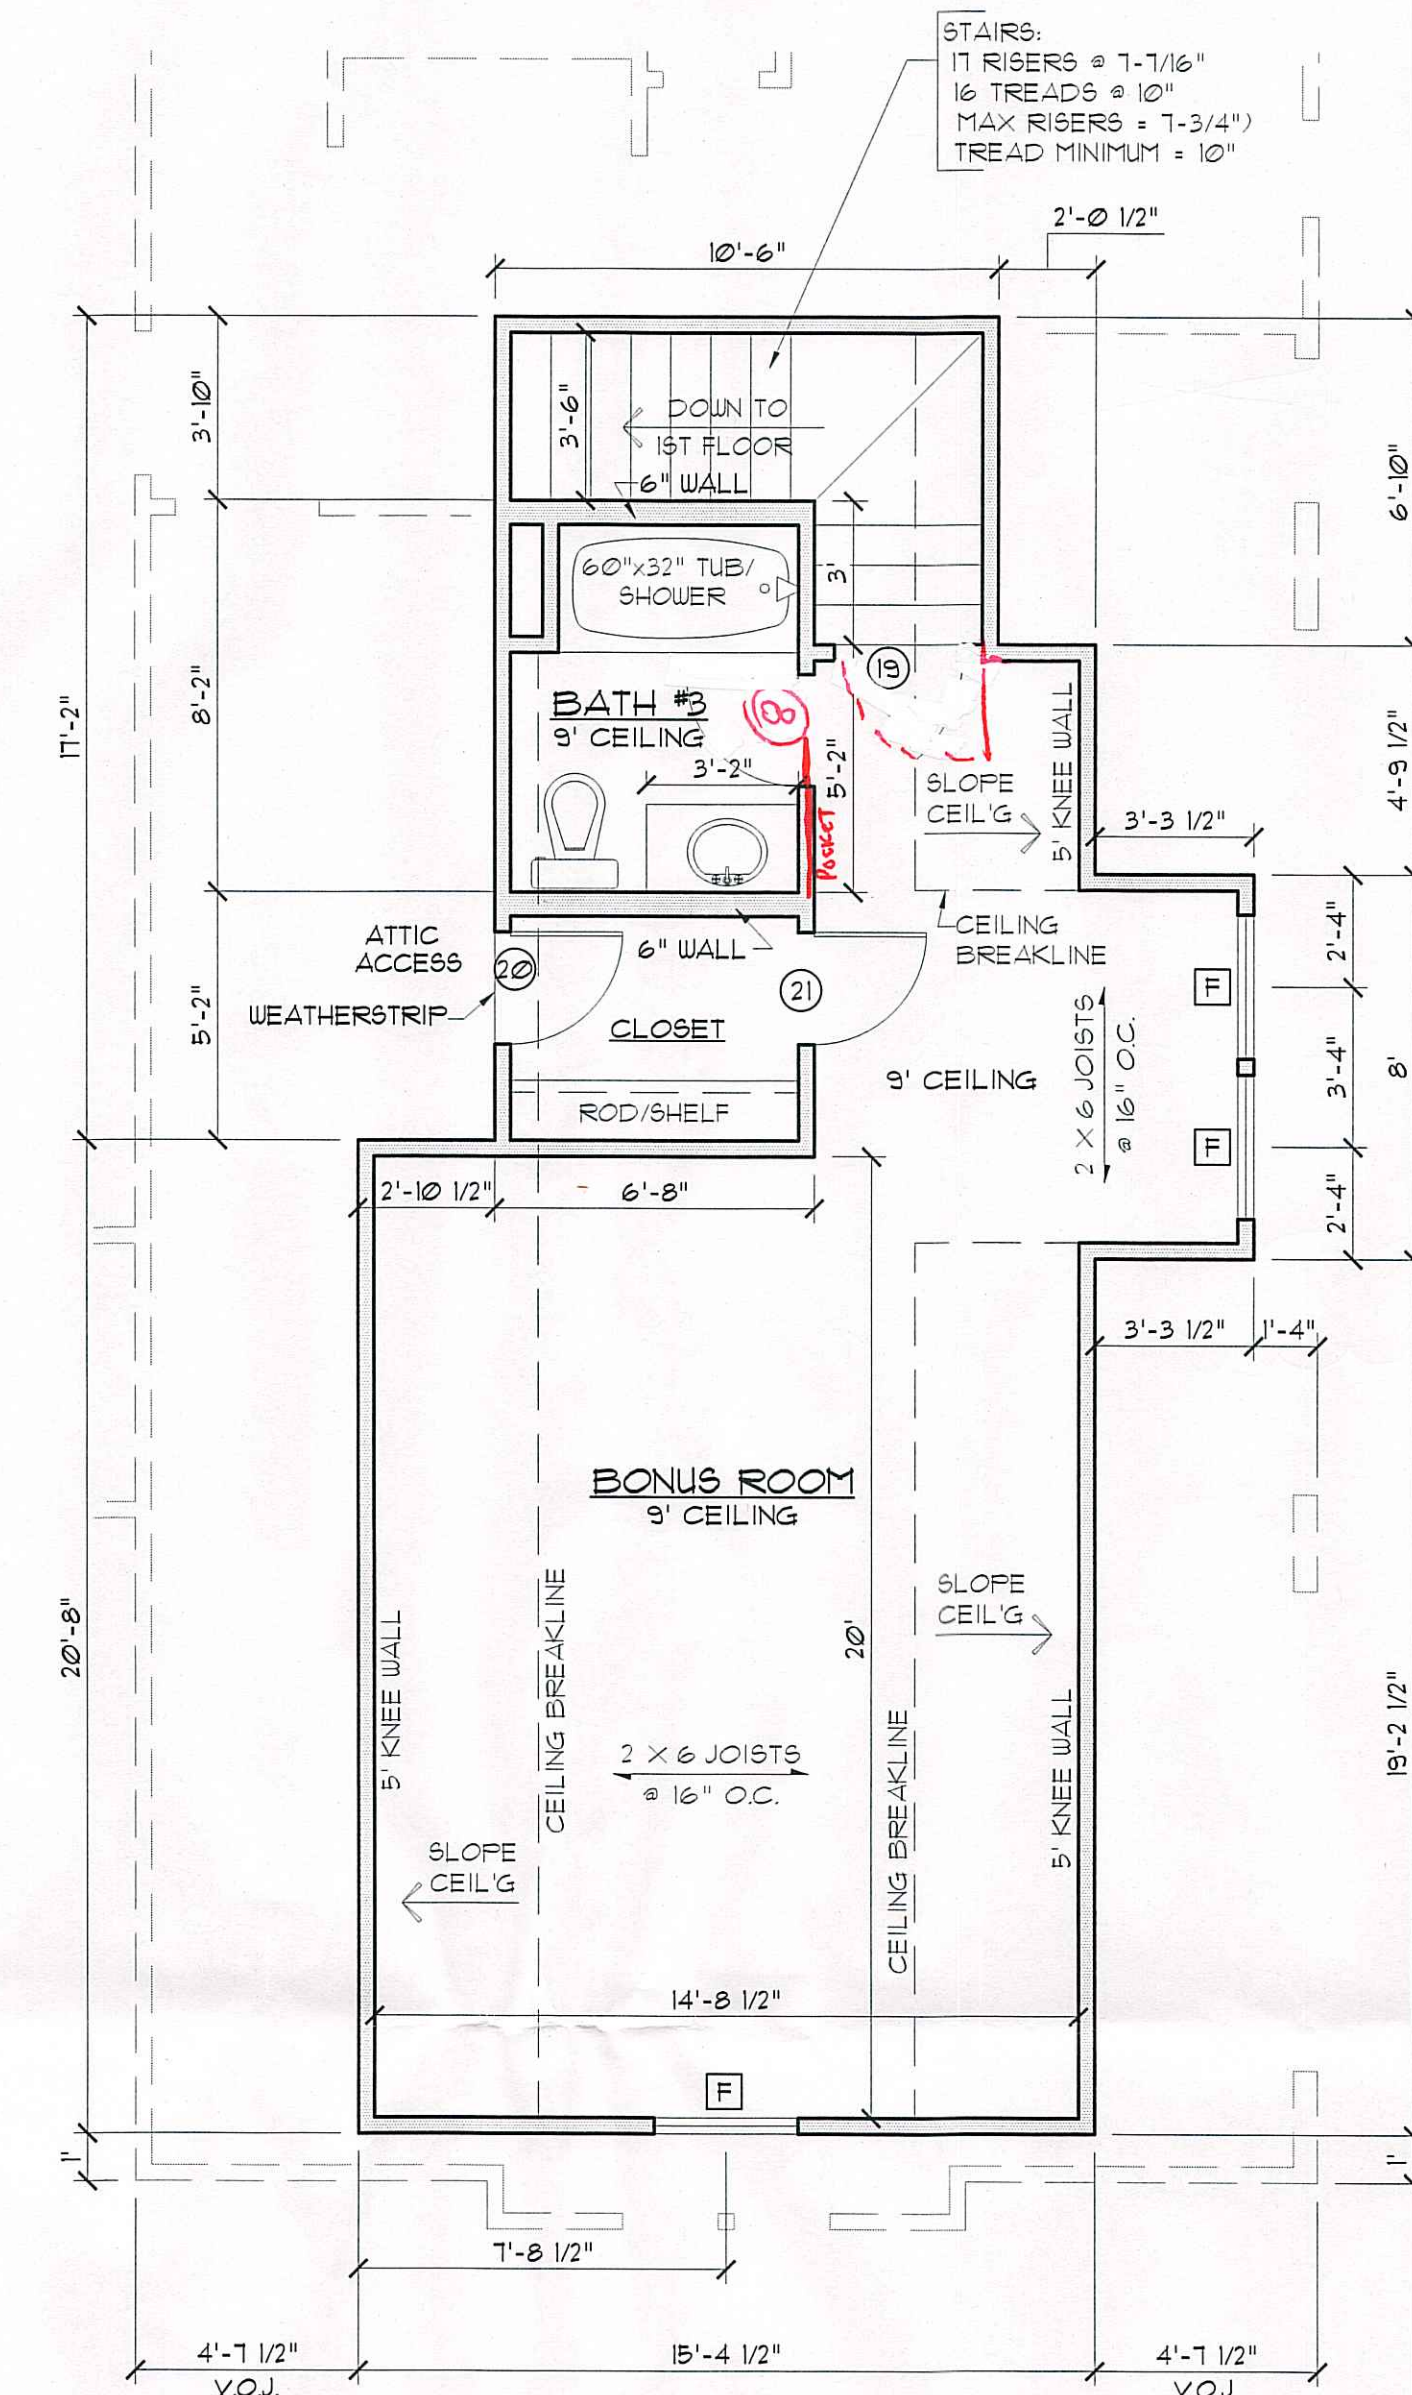

**BONUS ROOM FLOOR PLAN**  
SCALE: 1/4" = 1'-0"

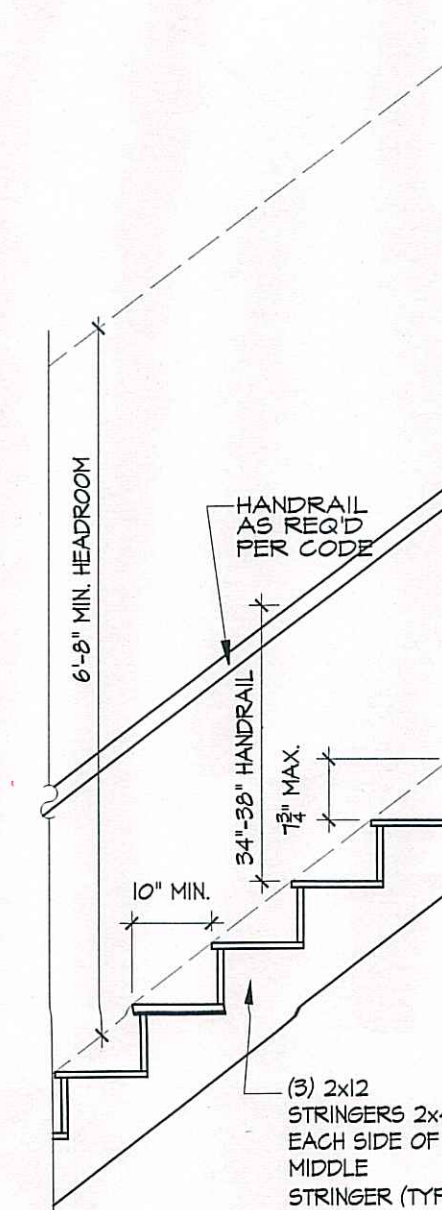

**STAIR RAILING DETAILS**  
SCALE: 1/2" = 1'-0"

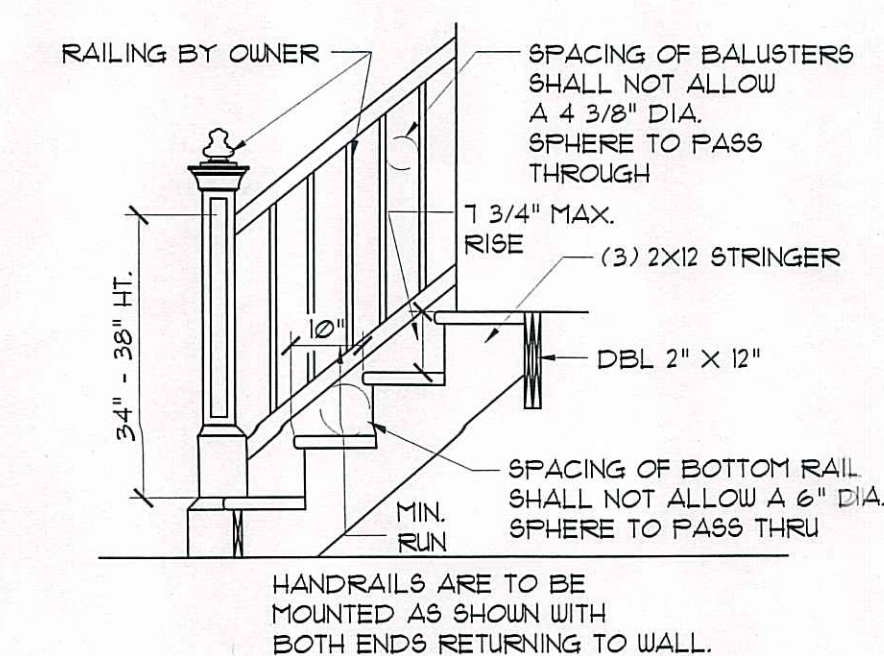

MADDEN HOME DESIGN, LLC NOT BEING AN ARCHITECTURAL OR ENGINEERING FIRM ASSUMES NO LIABILITY FOR STRUCTURAL OR ARCHITECTURAL DESIGN INTEGRITY. EVERY EFFORT HAS BEEN MADE TO ENSURE ALL DIMENSIONS ARE CORRECT. HOWEVER, ALL DIMENSIONS ARE SUBJECT TO BEING MET IF AN ERROR OR OMISSION DOES OCCUR. IT IS THE SOLE RESPONSIBILITY OF THE CONTRACTOR AND/OR OMISSION AT HIS OWN EXPENSE AND NOT THE RESPONSIBILITY OF THE ARCHITECT. CONTRACTOR IS RESPONSIBLE FOR VERIFYING ALL DIMENSIONS IN THE FIELD AND SHALL BUILD WORK IN ACCORDANCE WITH THE INTERNATIONAL RESIDENTIAL CODE 2021.

RESIDENCE OF  
**LARRY GODWIN JR.**  
MADDEN HOME DESIGN

Project  
**MADDEN HOME DESIGN**  
8375 Rushing Road  
Denham Springs, Louisiana  
70726  
Phone: (225) 791-2912

Project No.: CEDAR SPRINGS  
W. BONUS  
DATE: SEPTEMBER 3, 2024  
DRAWN BY: Steven Madden  
DESIGNED BY: Steven Madden

COPYRIGHT NOTE: © These Plans Are Subject To Federal Copyright Laws And Are To Be Used For The Lot Number And Subdivision Indicated In This Title Block. Only Use On Any Other Site Is Prohibited.

© COPYRIGHT 2024



Sheet Title  
**BONUS ROOM & INT. ELEVATIONS**

Sheet:  
□ Preliminary Dwg.  
□ Bidding Doc.  
□ Construction Doc.



**A1.1**



**ATTIC VENTILATION:**  
 THE TOTAL NET FREE VENTILATING AREA SHALL NOT BE LESS THAN 1/30 OF THE AREA OF THE SPACE VENTILATED EXCEPT THAT A REDUCTION OF THE TOTAL AREA TO 1/300 IS PERMITTED PROVIDED THAT AT LEAST 50% AND NOT MORE THAN 80% OF THE REQUIRED VENTILATING AREA IS PROVIDED BY VENTILATORS LOCATED IN THE UPPER PORTION OF THE SPACE TO BE VENTILATED AT LEAST 3 FEET ABOVE THE EAVE OR CORNICE VENTS WITH THE BALANCE OF THE REQUIRED VENTILATION PROVIDED BY EAVE OR CORNICE VENTS. THE ATTIC VENTILATION SHALL BE SUFFICIENT TO PROVIDE THE REQUIRED VOLUME OF COMBUSTION AIR (AS PER SEC. R308 OF THE I.R.C.)

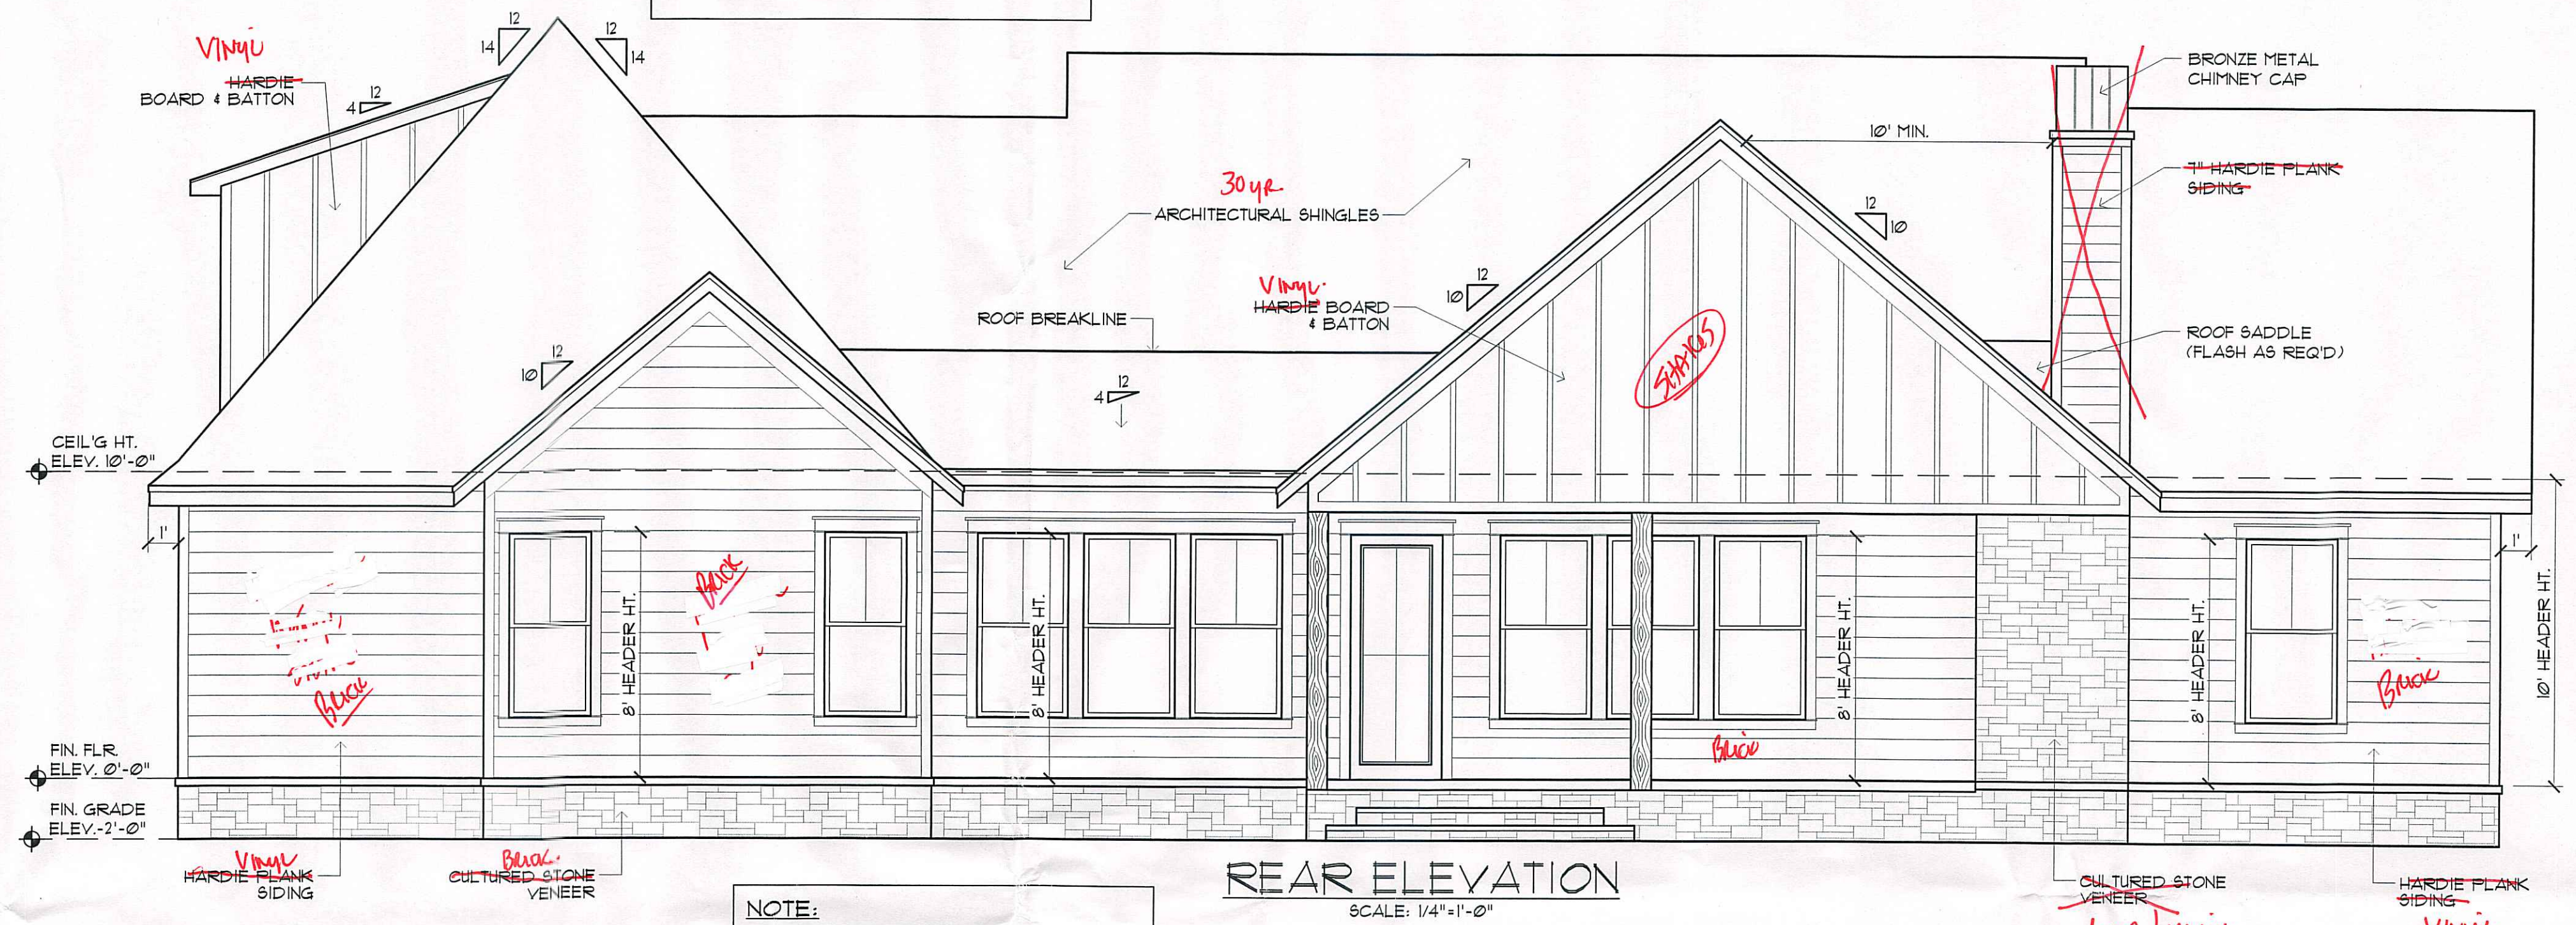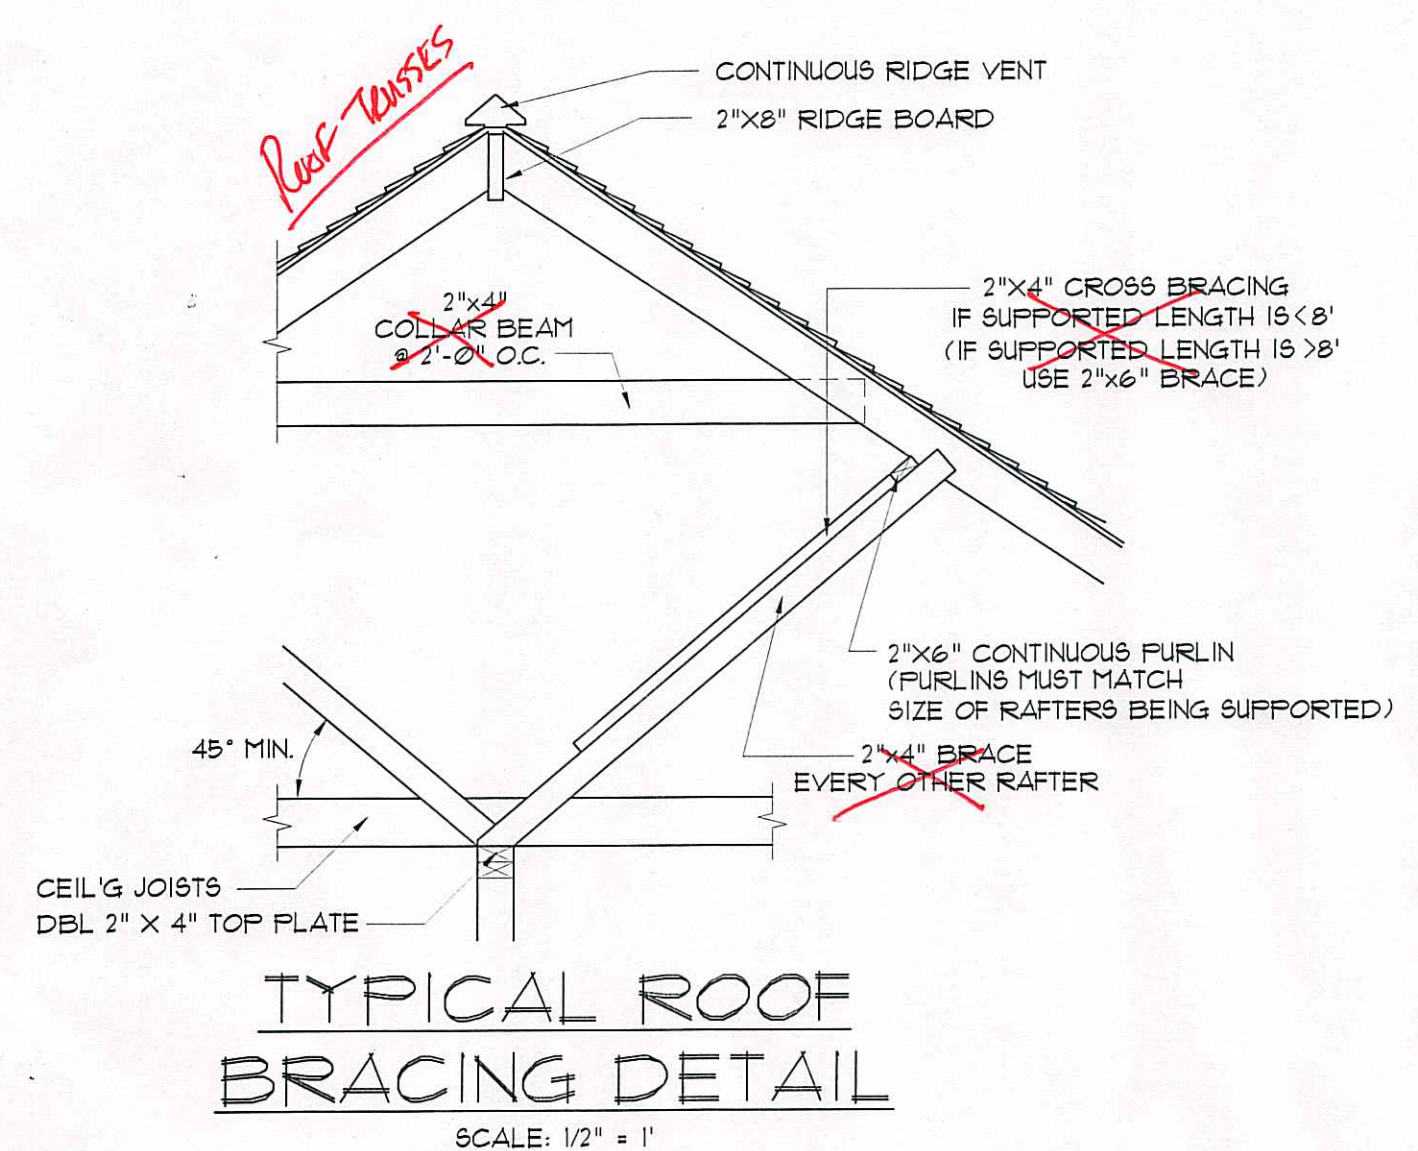

**NOTE:**  
 MAINTAIN MIN. 6" CLEARANCE BETWEEN BOTTOM OF BRICK OR SIDING AND TOP OF FINAL GRADING AND SCODDING - TYPICAL ALL AROUND STRUCTURE

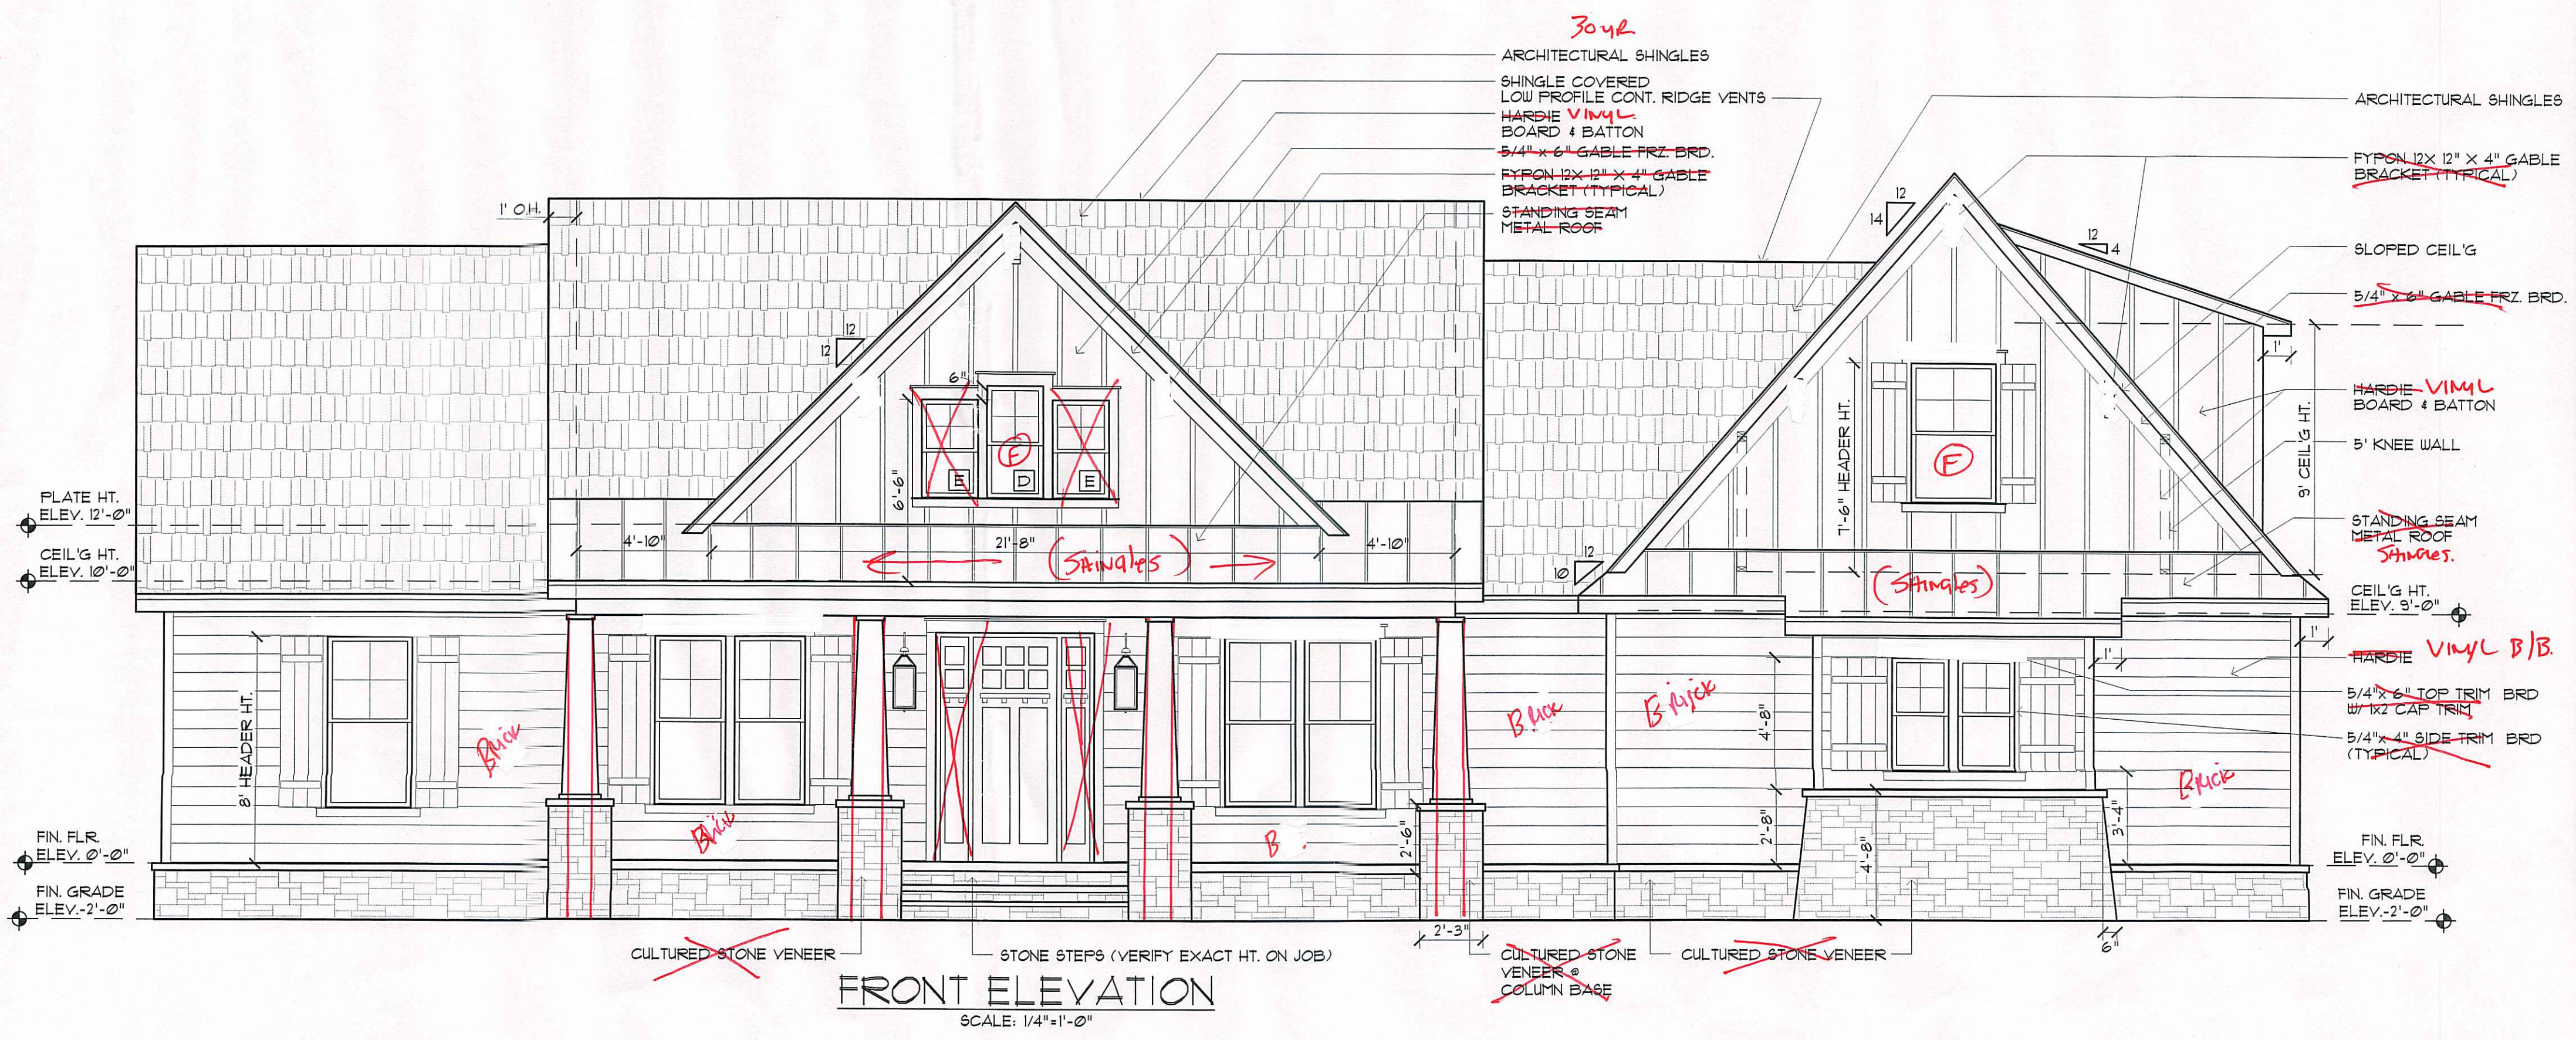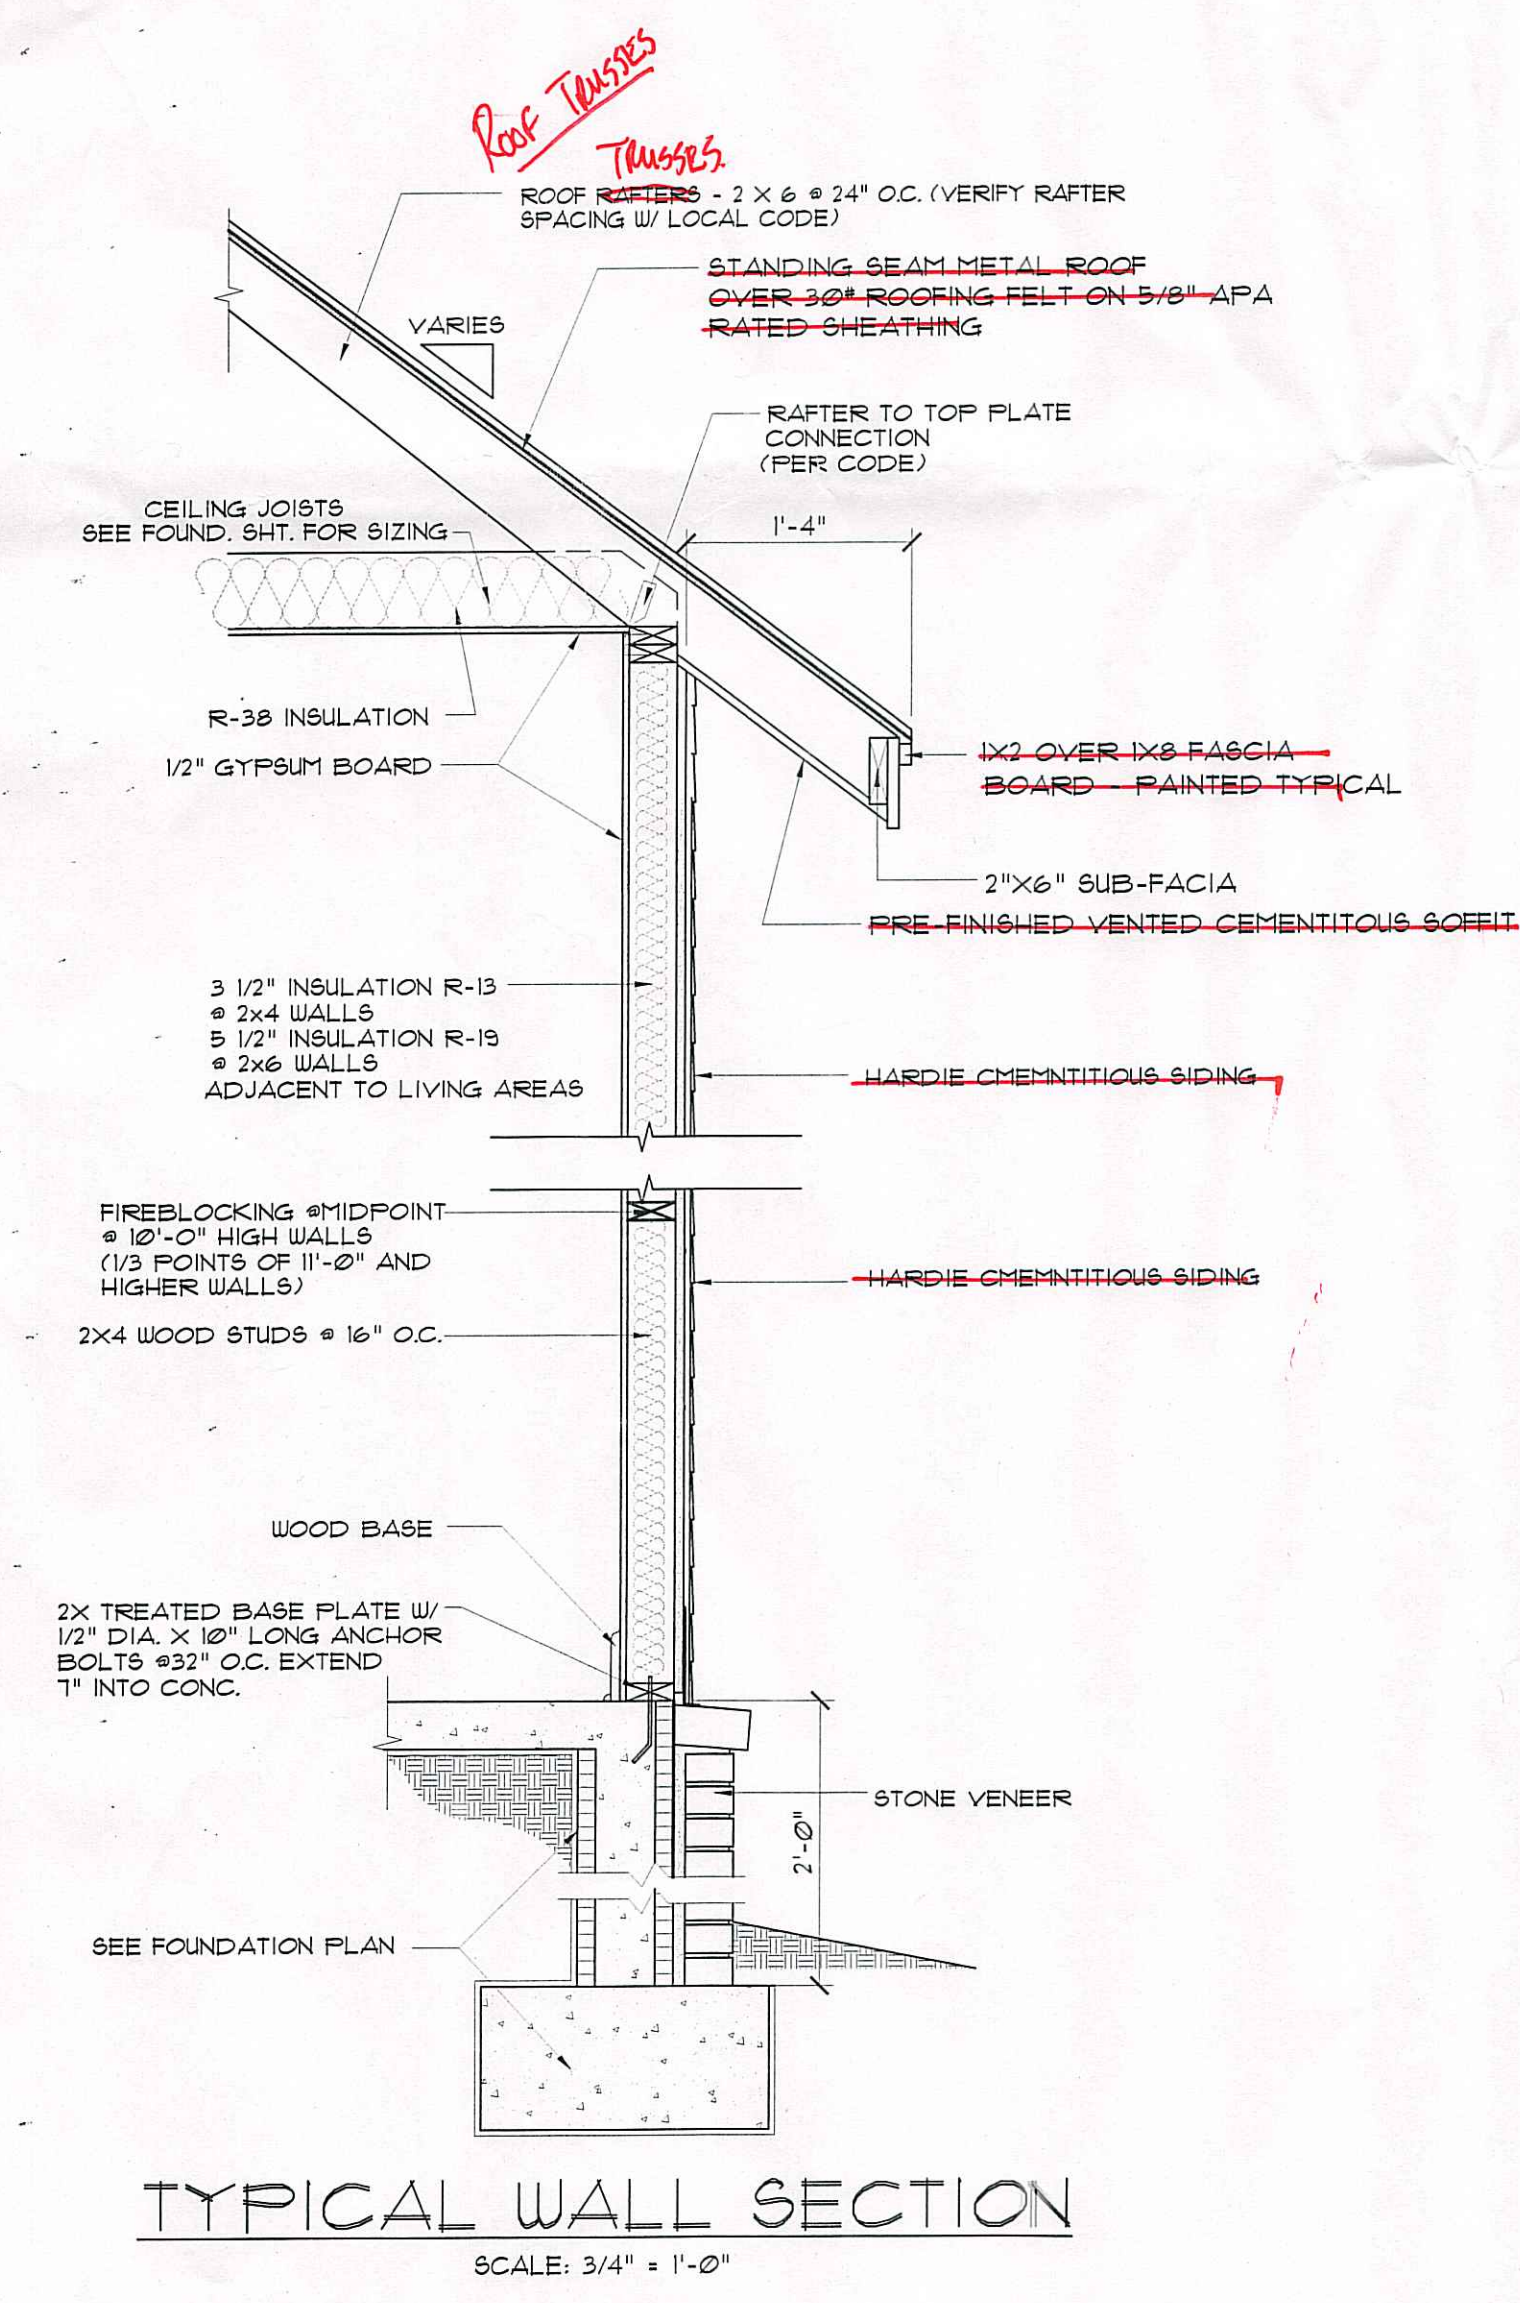

MADDEN HOME DESIGN LLC NOT BEING AN ARCHITECTURAL FIRM ASSUMES NO LIABILITY FOR STRUCTURAL OR ARCHITECTURAL DESIGN INTEGRITY. EVERY EFFORT HAS BEEN MADE TO INSURE ALL DIMENSIONS ARE CORRECT AND ENVIRONMENTAL REGULATIONS HAVE BEEN MET. IF AN ERROR OR OMISSION DOES OCCUR IT IS THE SOLE RESPONSIBILITY OF THE CONTRACTOR AND/OR ARCHITECT AT HIS OWN RISK AND NOT THE RESPONSIBILITY OF THE DRAFTING SERVICE. CONTRACTOR IS RESPONSIBLE FOR VERIFICATION OF DIMENSIONS IN THE FIELD AND SHALL BUILD HOME IN ACCORDANCE WITH THE INTERNATIONAL RESIDENTIAL CODE 2021.



RESIDENCE OF  
**LARRY GODWIN JR.**  
 Melissa Godwin

Project  
**MADDEN** HOME DESIGN  
 8375 Rushing Road  
 Denham Springs, Louisiana 70726  
 Phone: (225) 791-2912



Project No.: CEDAR SPRINGS  
 W. BONUS  
 DATE: SEPTEMBER 3, 2024  
 DRAWN BY: Steven Madden  
 DESIGNED BY: Steven Madden  
 COPYRIGHT NOTE: © These Plans Are Subject To Federal Copyright Laws And Are To Be Used For The Lot Number And Subdivision Indicated In This Title Block Only. Use On Any Other Site Is Prohibited.  
 © COPYRIGHT 2024  
 Sheet Title  
**FRONT & REAR ELEVATIONS**

Sheet:  
 Preliminary Dwg.  
 Bidding Doc.  
 Construction Doc.  
**A2.0**



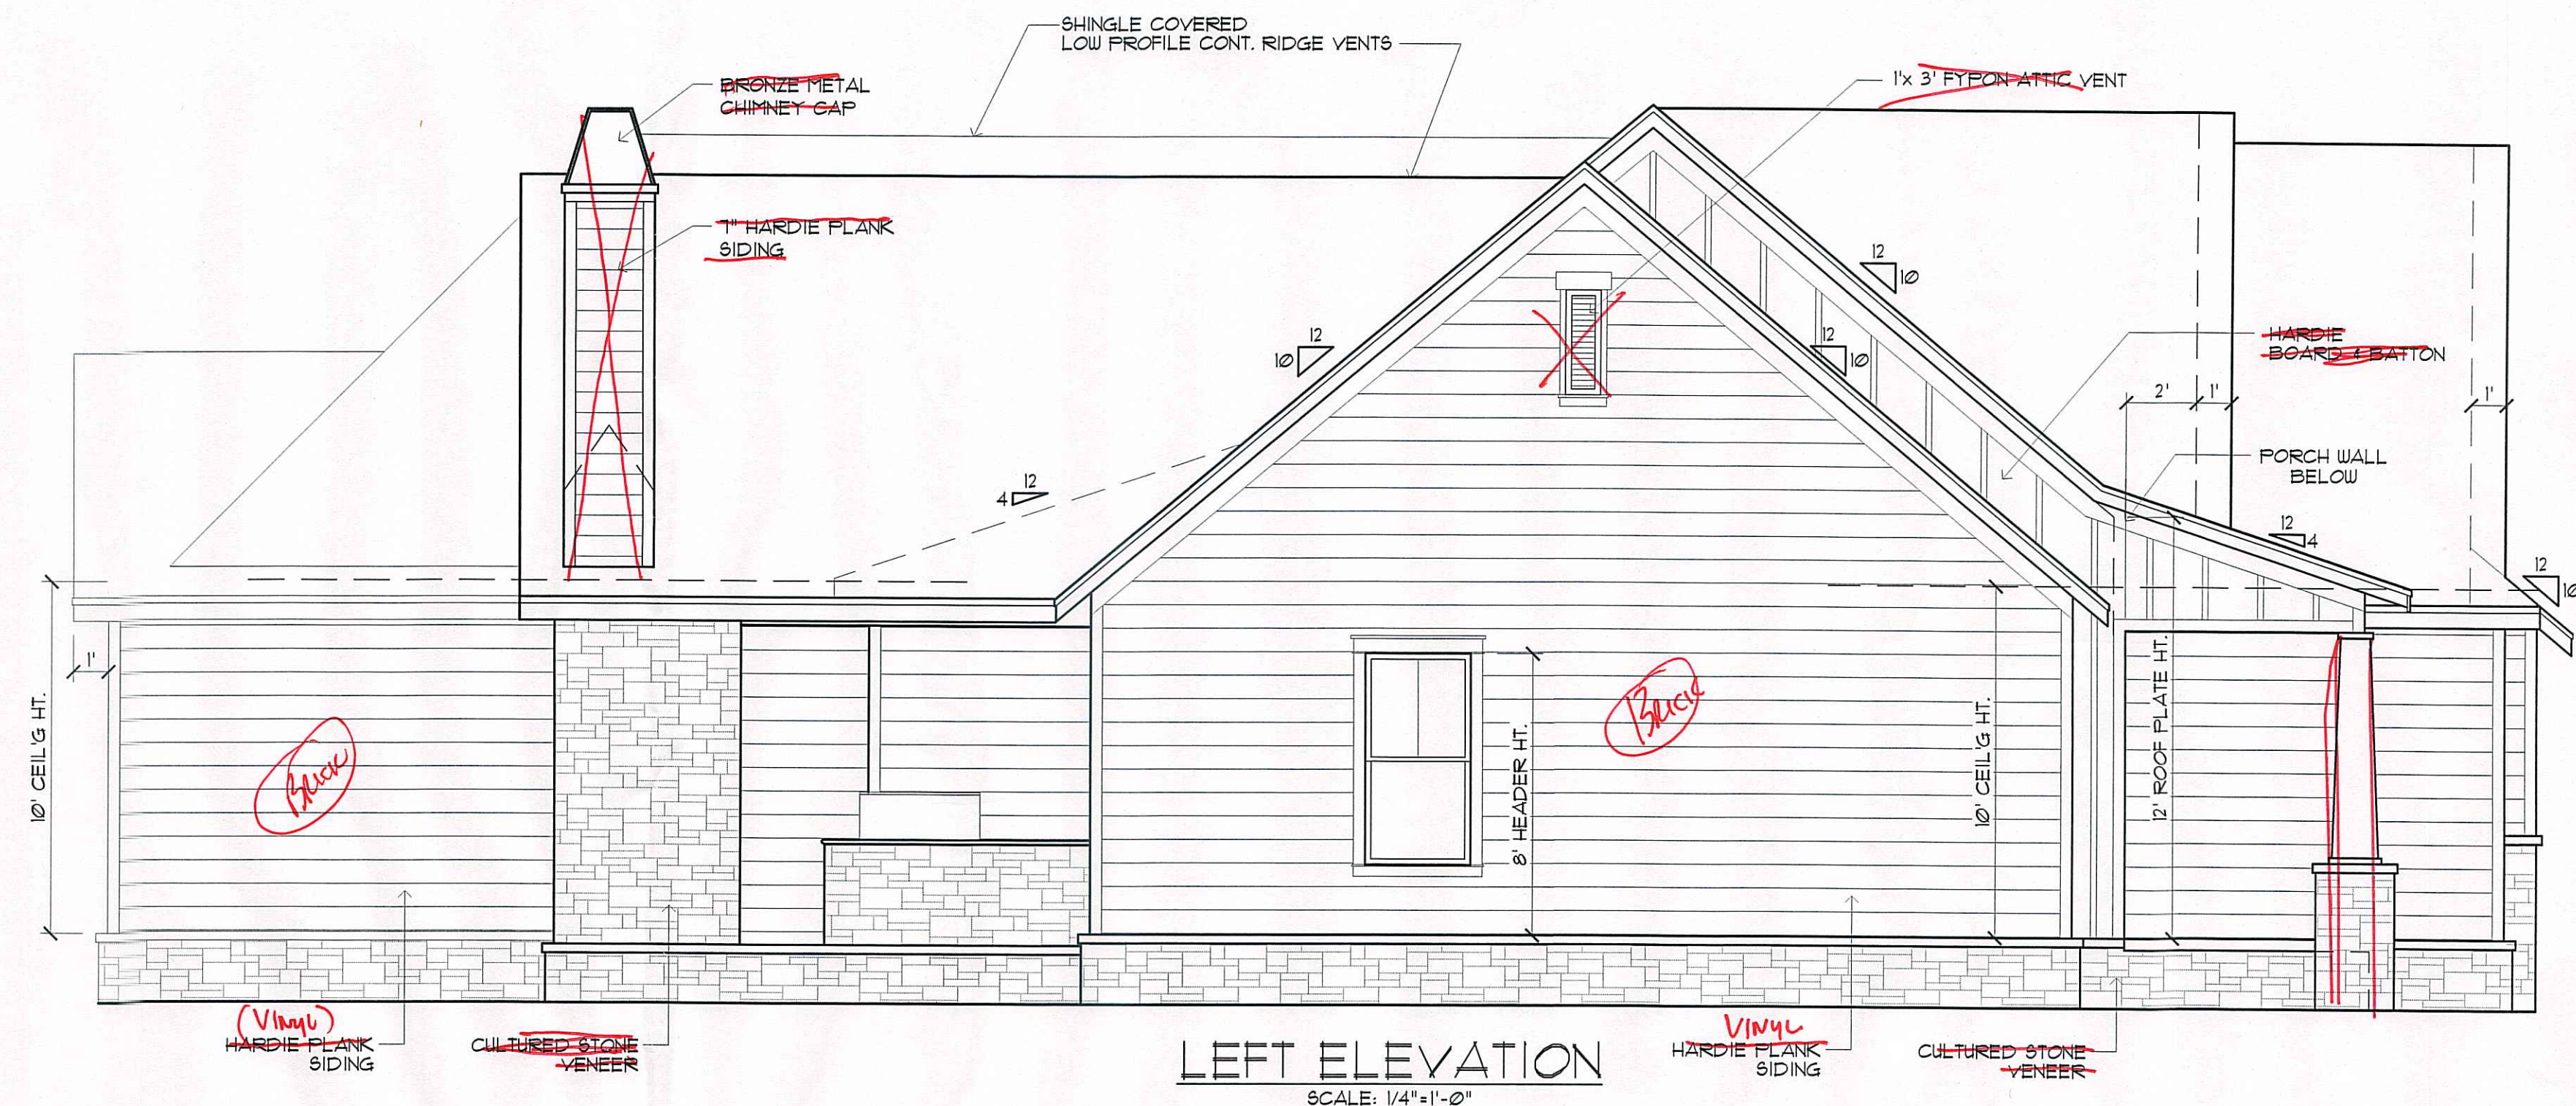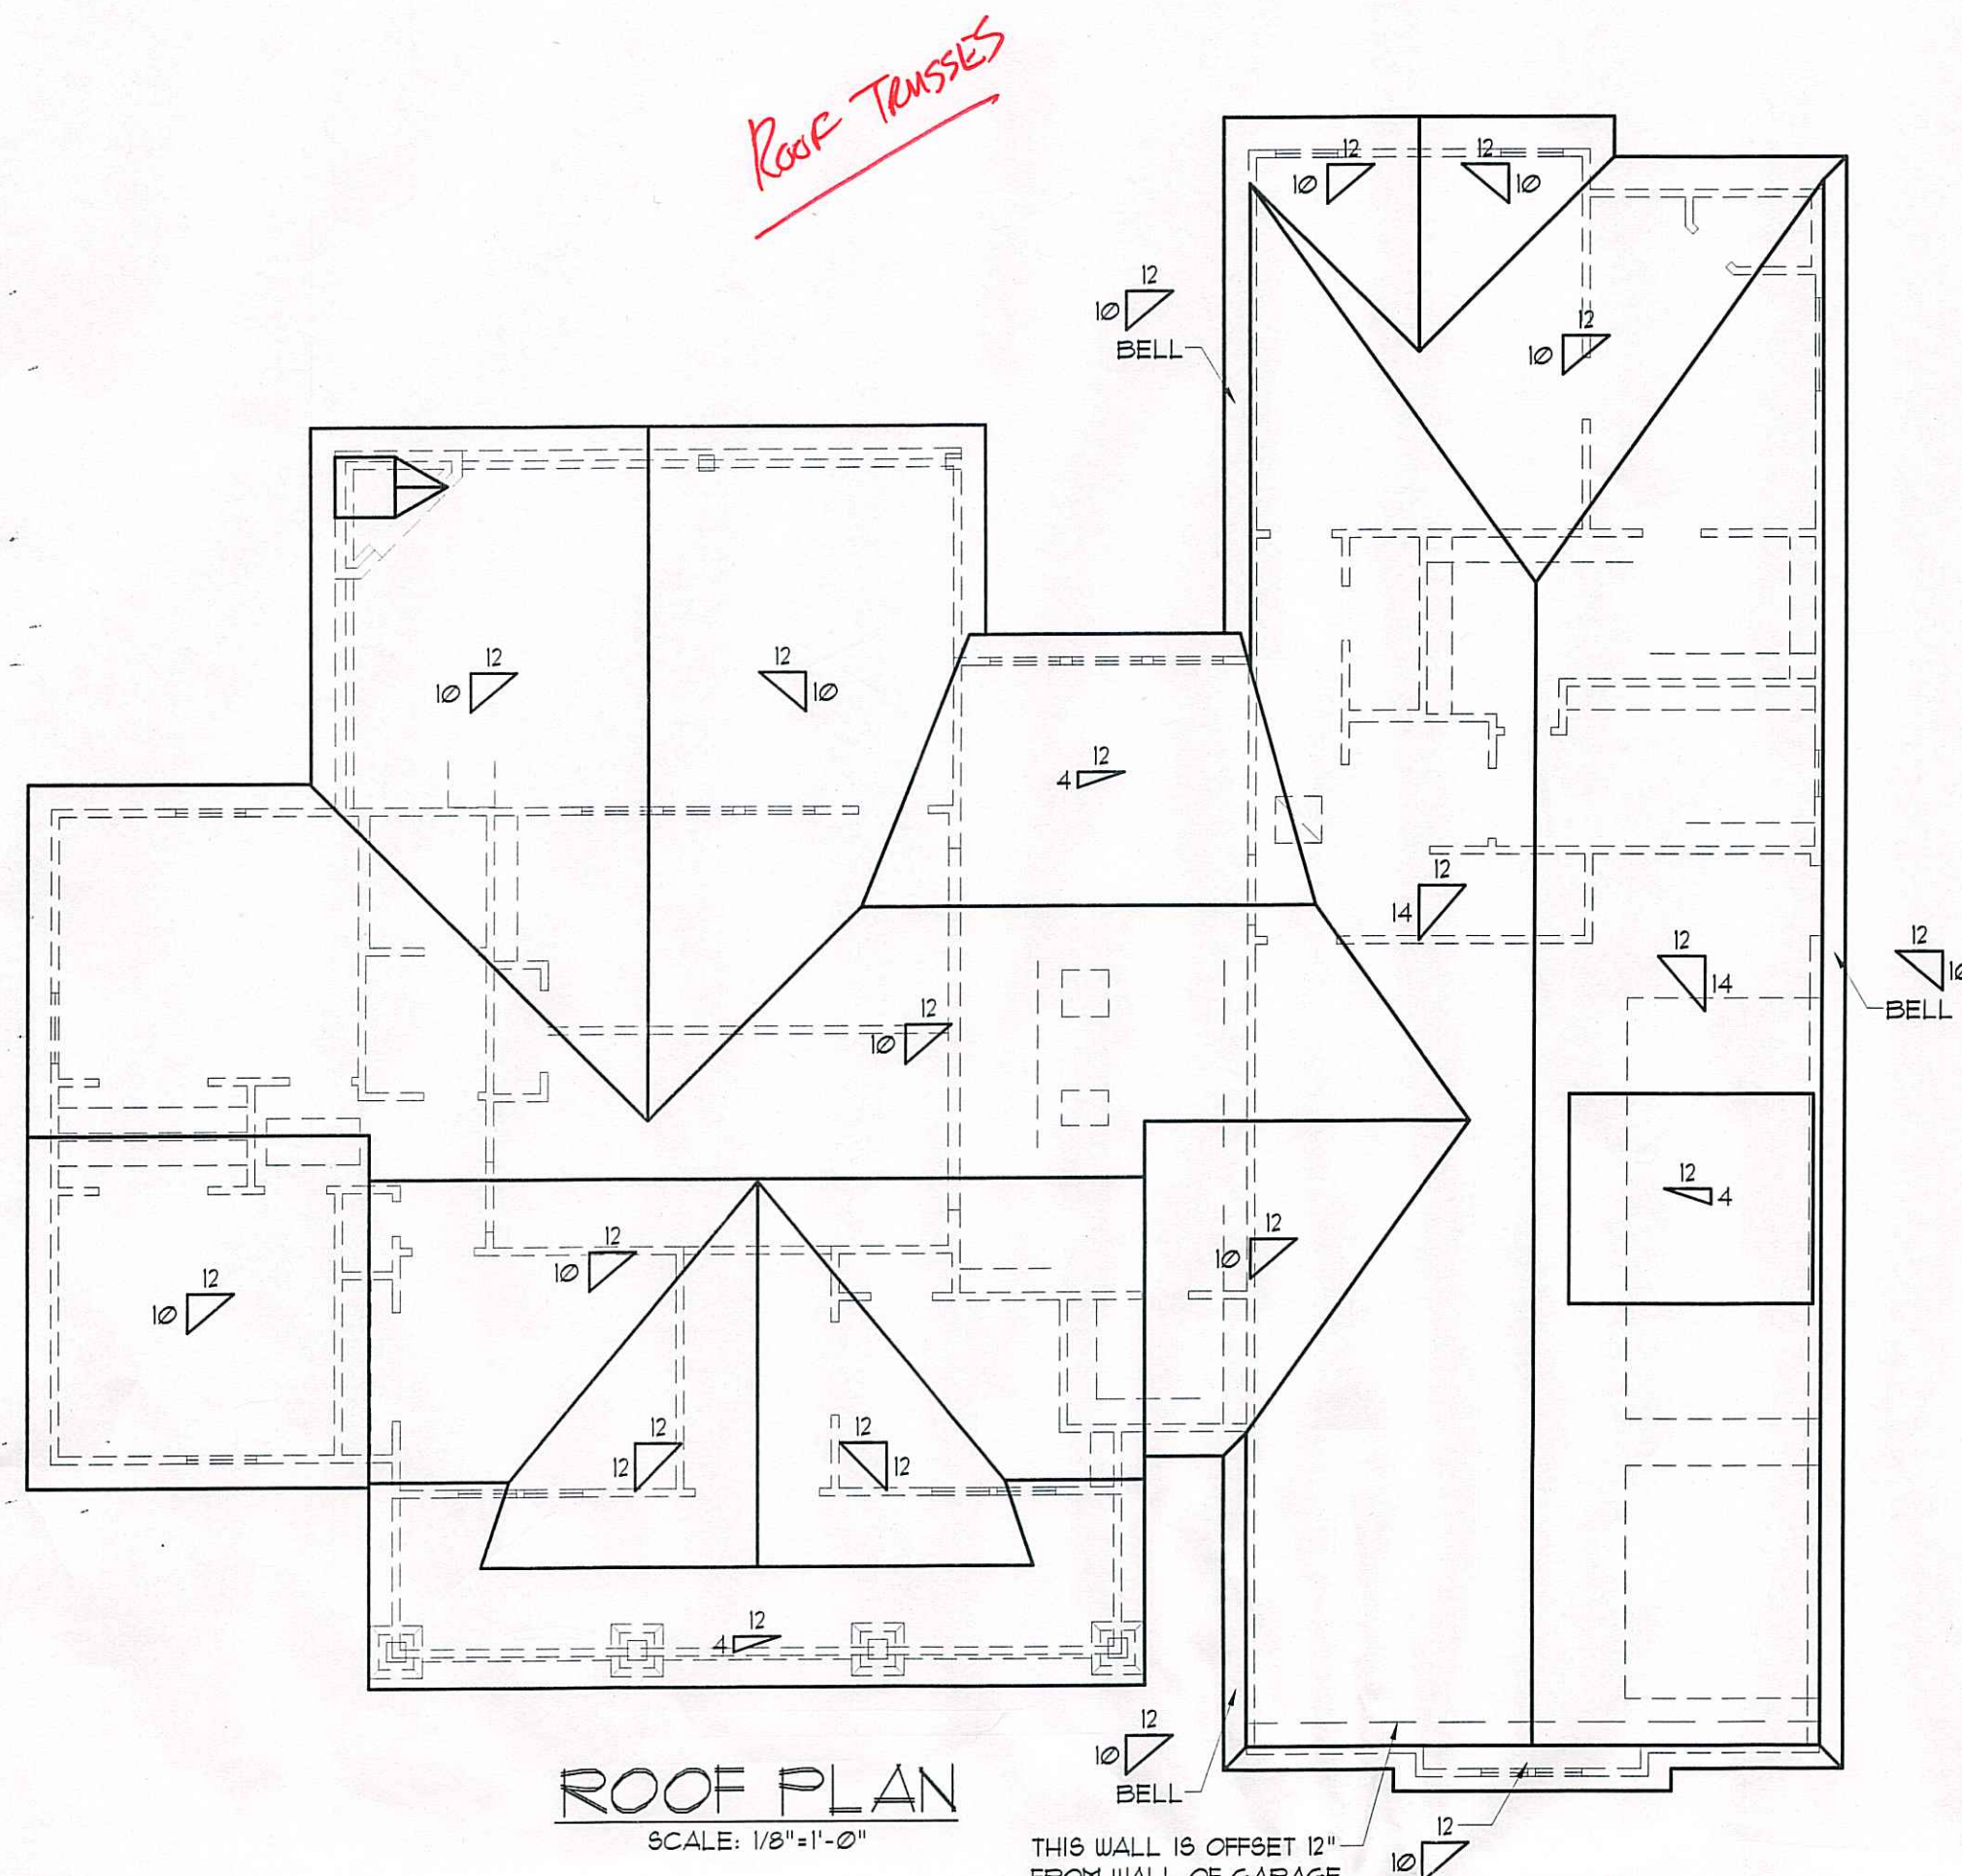

**NOTE:**  
MAINTAIN MIN. 6" CLEARANCE BETWEEN BOTTOM OF BRICK OR SIDING AND TOP OF FINAL GRADING AND SODDING - TYPICAL ALL AROUND STRUCTURE

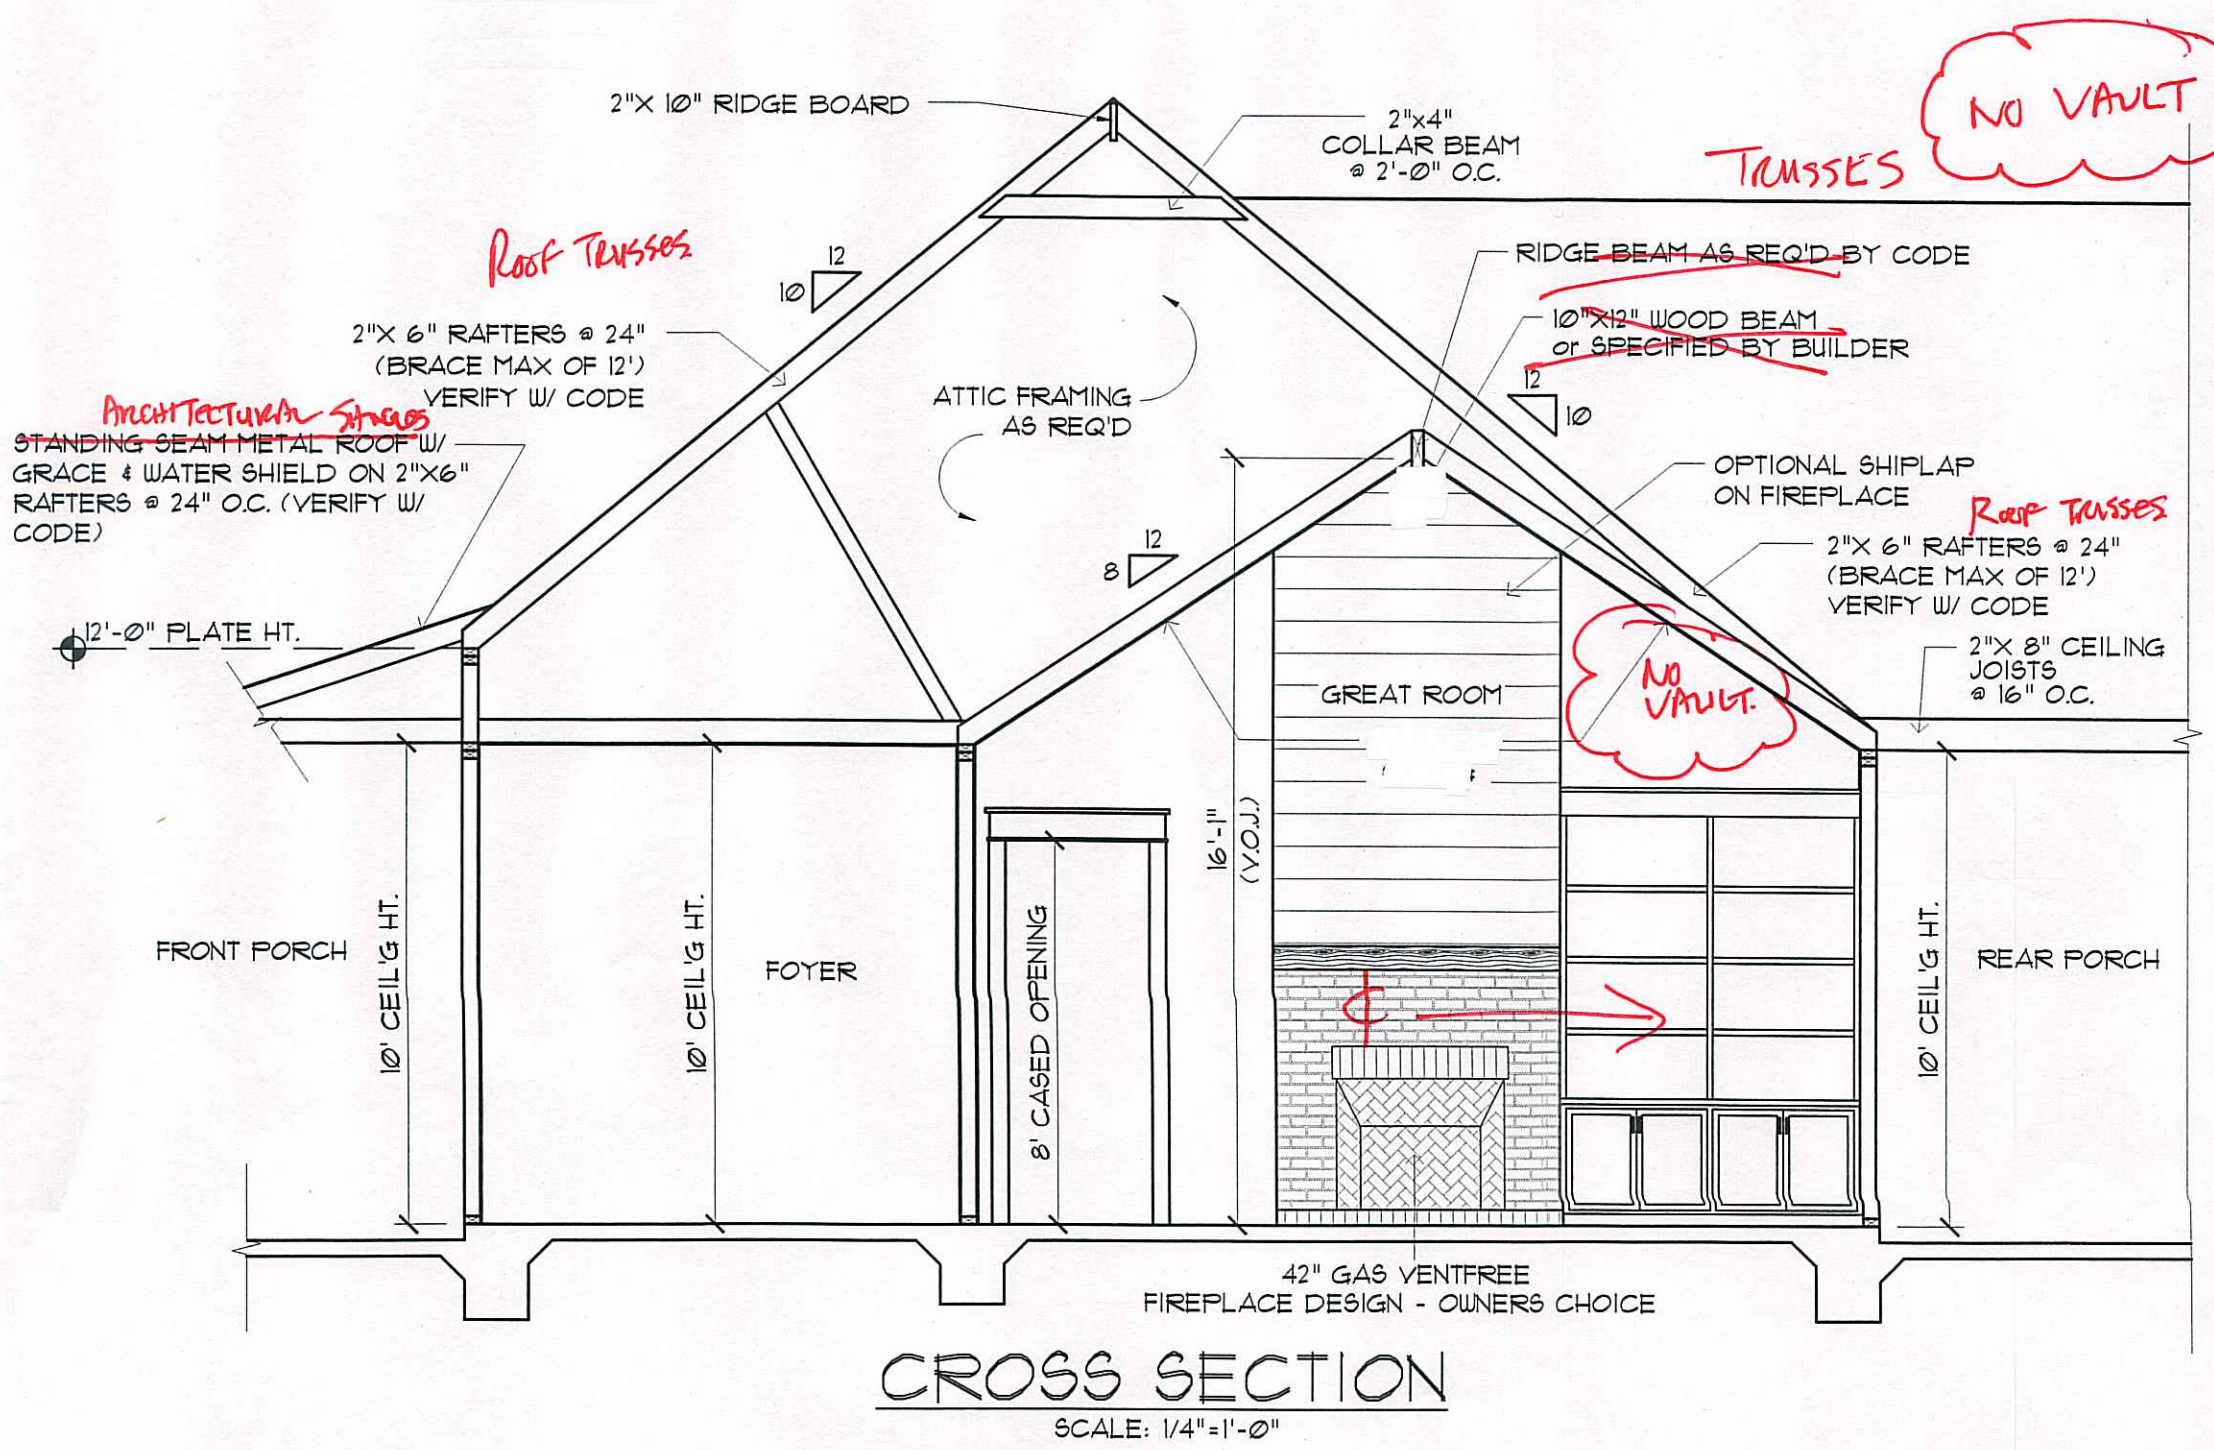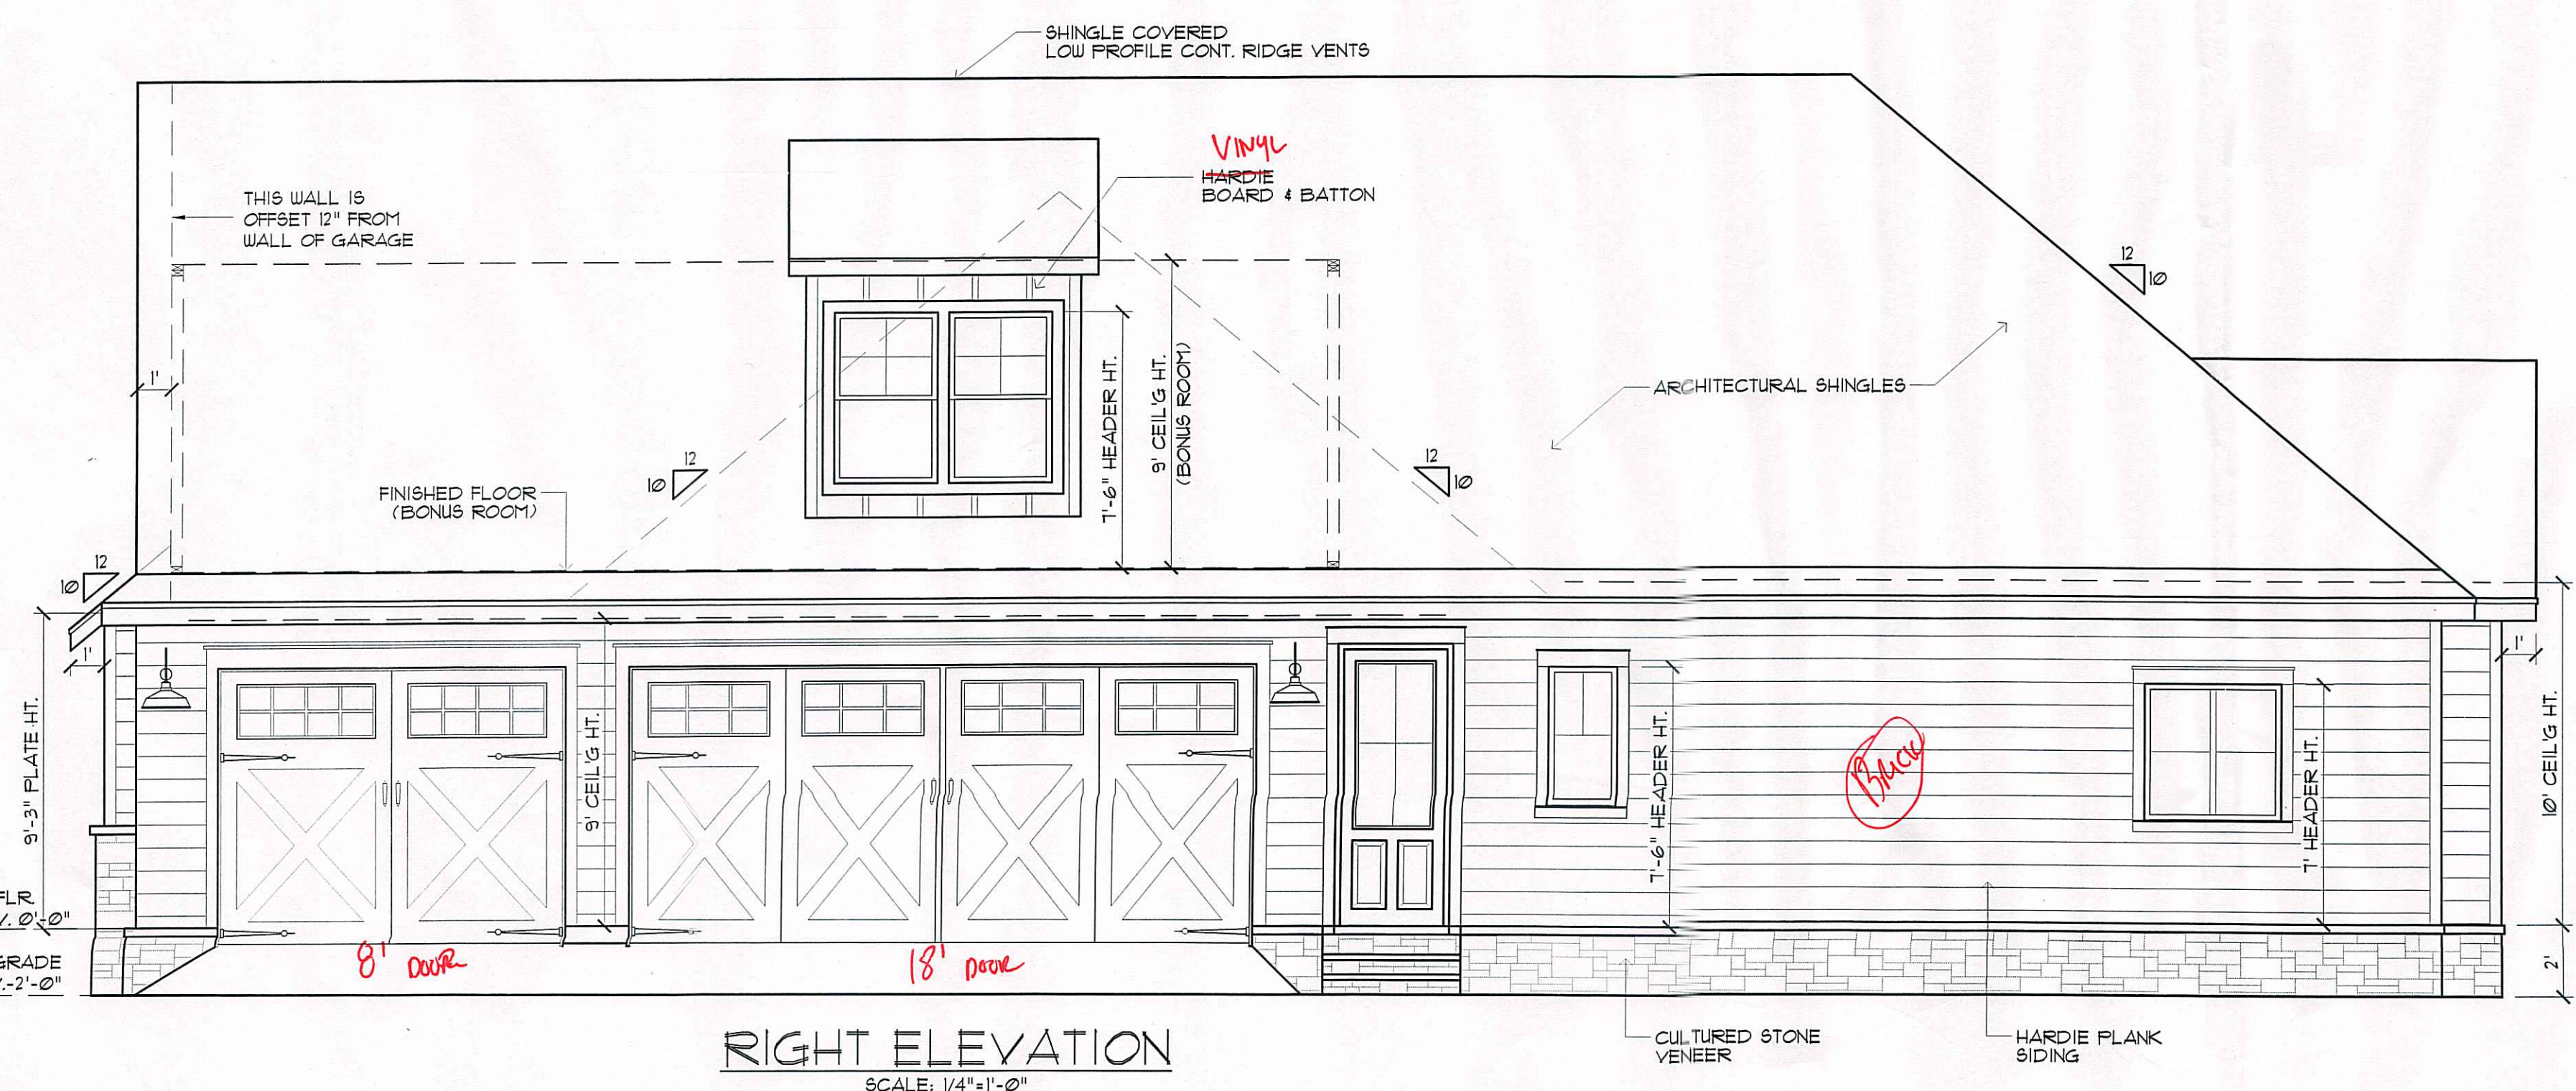


MADDEN HOME DESIGN, LLC NOT BEING AN ARCHITECTURAL OR ENGINEERING FIRM ASSUMES NO LIABILITY FOR STRUCTURAL OR ARCHITECTURAL DESIGN INTEGRITY. EVERY EFFORT HAS BEEN MADE TO INSURE ALL DIMENSIONS ARE CORRECT AND ENVIRONMENTAL REGULATIONS HAVE BEEN MET. AN ERROR OF OMISSION AND/OR OMISSION AT HIS OWN RISK AND NOT THE RESPONSIBILITY OF THE DRAFTING SERVICE. CONTRACTOR IS RESPONSIBLE FOR VERIFICATION OF DIMENSIONS IN THE FIELD AND SHALL BUILD HOME IN ACCORDANCE WITH THE INTERNATIONAL RESIDENTIAL CODE 2021.

RESIDENCE OF  
**LARRY GODWIN JR.**  
Melissa Godwin


Project  
**MADDEN HOME DESIGN**  
8375 Rushing Road  
Denham Springs, Louisiana 70726  
Phone: (225) 791-2912

Project No.: CEDAR SPRINGS W. BONUS  
DATE: SEPTEMBER 3, 2024  
DRAWN BY: Steven Madden  
DESIGNED BY: Steven Madden  
COPYRIGHT NOTE: © These Plans Are Subject To Federal Copyright Law And Are To Be Used For The Lot Number And Subdivision Indicated In This Title Block Only. Use On Any Other Site Is Prohibited.  
© COPYRIGHT 9099  
Sheet Title  
**ELEVATIONS & CROSS SECT**  
Sheet:  
**A3.0**




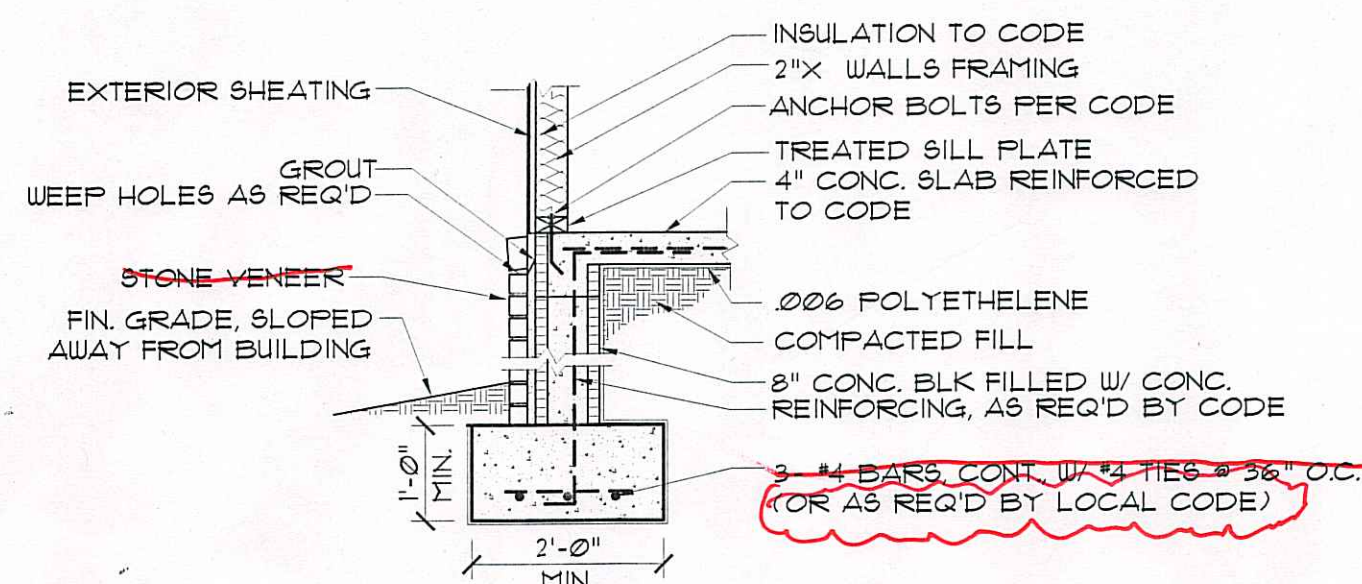


**1 EXTERIOR FOOTING**  
SCALE: NTS

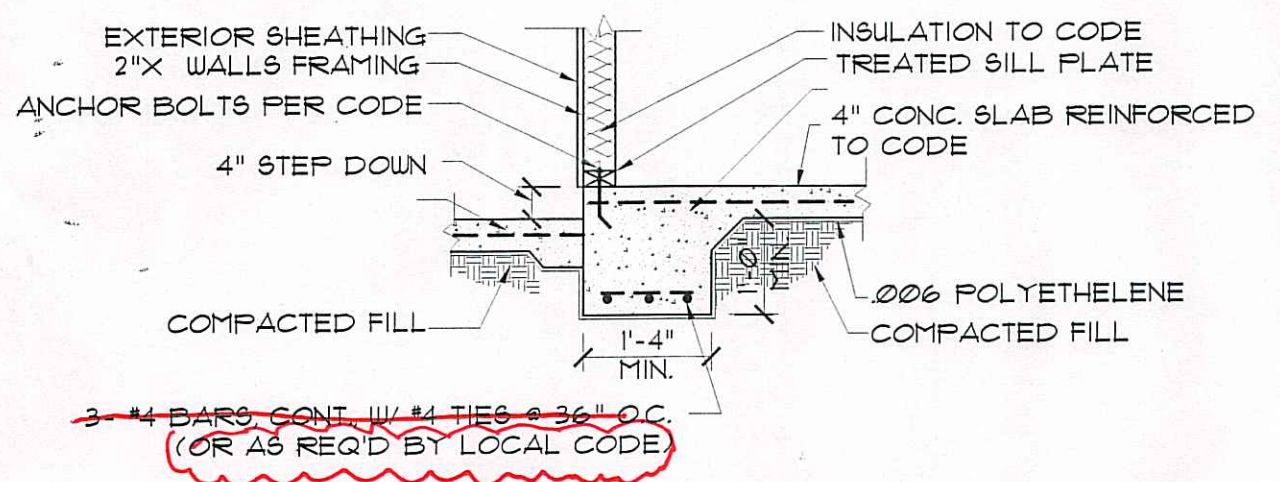


**2 PORCH FOOTING**  
SCALE: NTS

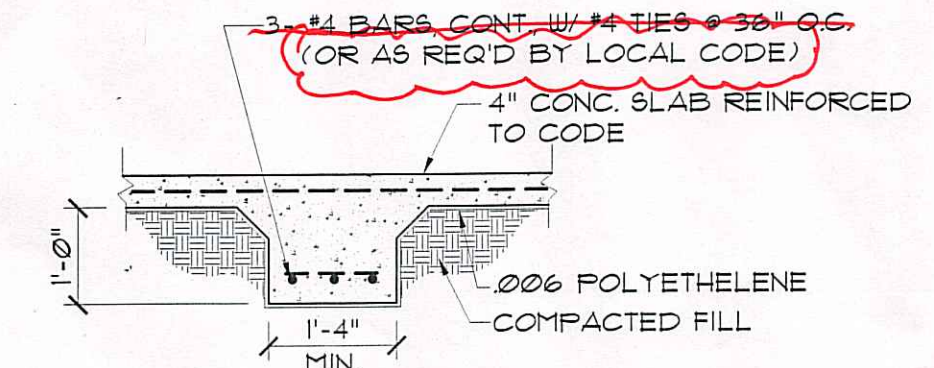

**3 INTERIOR FOOTING**  
SCALE: NTS

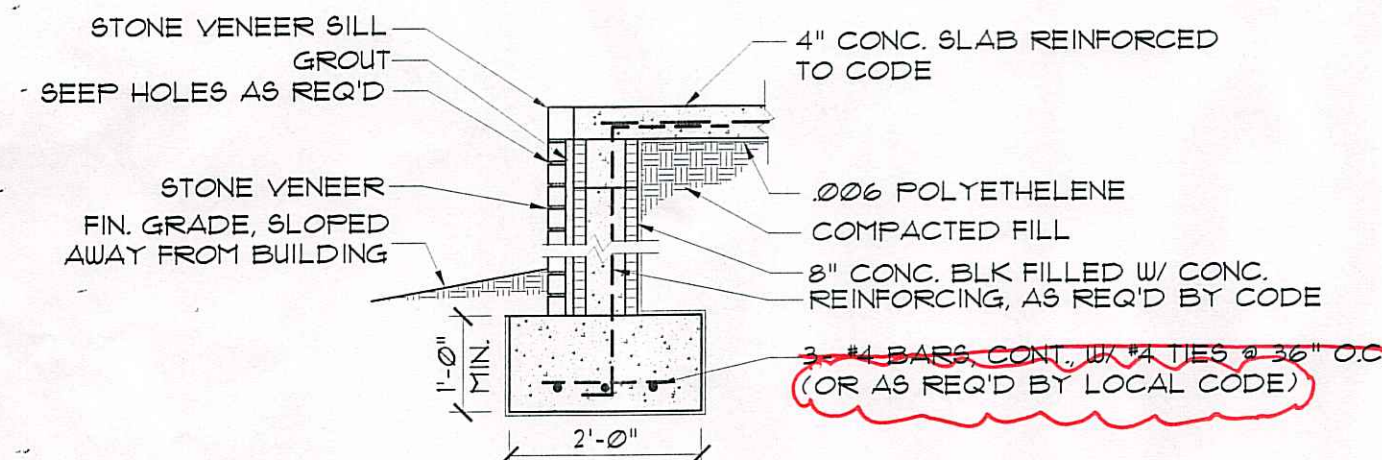


**4 BRICK BAND PORCH FOOTING**  
SCALE: NTS

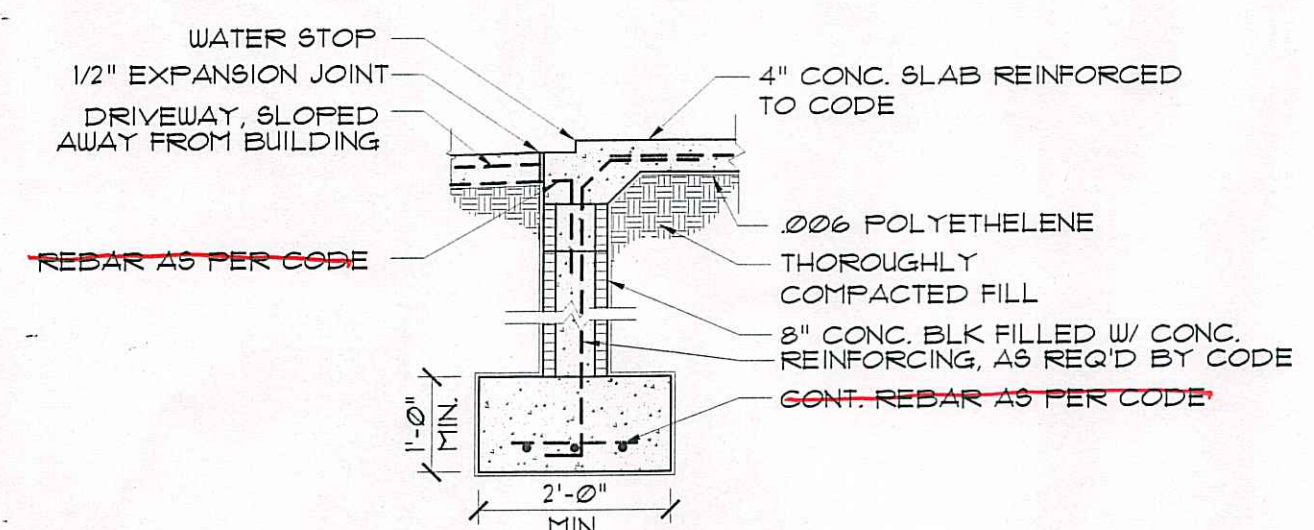

**5 GARAGE FOOTING @ DRIVEWAY**  
SCALE: NTS

**NOTE:**  
MADDEN HOME DESIGN IS NOT AN ENGINEER AND RECOMMENDS THAT A PROFESSIONAL ENGINEER BE CONSULTED FOR YOUR SPECIFIC LOT AS THE DESIGNER HAS NOT BEEN PROVIDED ANY INFORMATION BY THE CLIENT REGARDING THE BEARING CAPACITY OF THE SOILS FOR THIS LOT AND ASSUMES NO RESPONSIBILITY FOR THE STRUCTURAL PERFORMANCE OF THIS DESIGN.

**NOTE:**  
ALL EXTERIOR GRADE BEAMS TO EXTEND BELOW UNDISTURBED SOIL A MINIMUM OF 12".

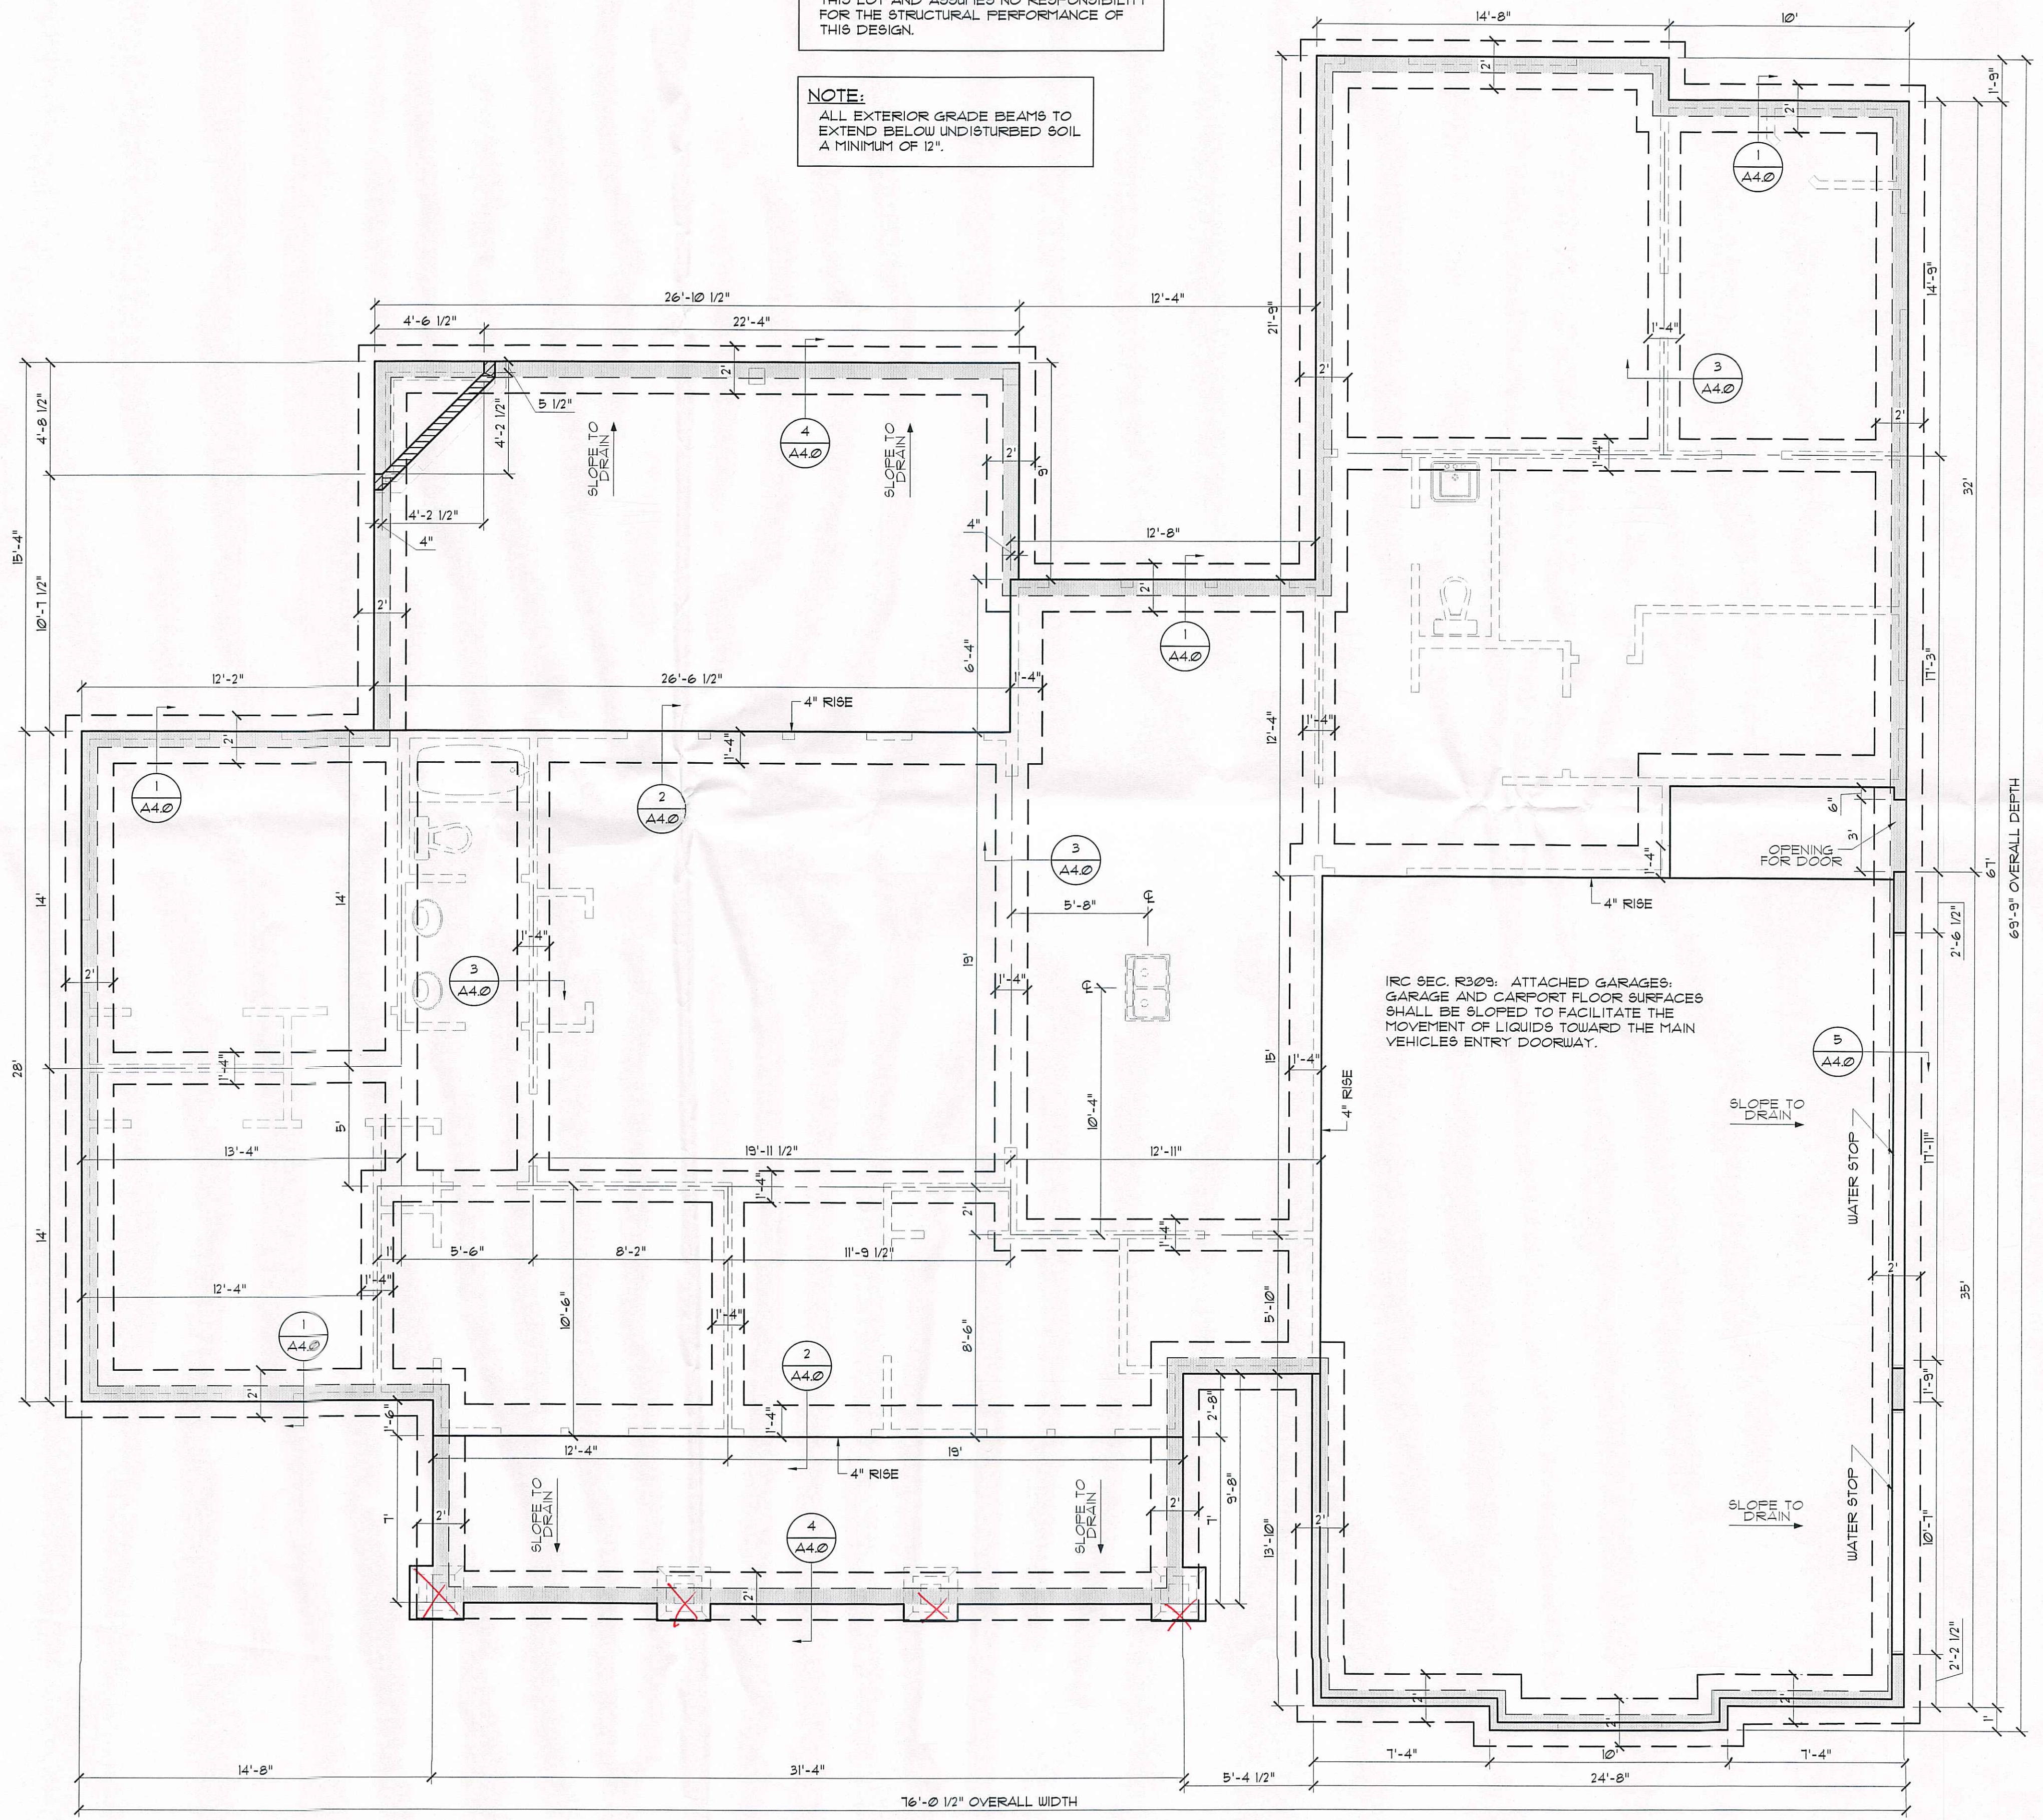

IRC SEC. R309. ATTACHED GARAGES, GARAGE AND CARPORT FLOOR SURFACES SHALL BE SLOPED TO FACILITATE THE MOVEMENT OF LIQUIDS TOWARD THE MAIN VEHICLES ENTRY DOORWAY.

**FOUNDATION PLAN**  
SCALE: 1/4" = 1'-0"

MADDEN HOME DESIGN, LLC NOT BEING AN ARCHITECTURAL OR ENGINEERING FIRM OR ARCHITECTURAL OR ENGINEERING FIRM, EVERY EFFORT HAS BEEN MADE TO INSURE ALL DIMENSIONS ARE CORRECT AND ENVIRONMENTAL REGULATIONS HAVE BEEN MET. IF AN ERROR OR OMISSION DOES OCCUR, IT IS THE SOLE RESPONSIBILITY OF THE CONTRACTOR AND NOT DESIGNER AT HIS OWN EXPENSE AND THE DESIGNER SHALL BE RESPONSIBLE FOR VERIFYING DIMENSIONS IN THE FIELD AND SHALL BUILD HOME IN ACCORDANCE WITH THE INTERNATIONAL RESIDENTIAL CODE 2021.

RESIDENCE OF  
**LARRY GODWIN JR.**  
McLuister Godwin

Project

**MADDEN HOME DESIGN**  
8375 Rushing Road  
Denham Springs, Louisiana  
70726  
Phone: (225) 791-2912

**A B D**

Project No.: CEDAR SPRINGS  
W. BONUS  
DATE: SEPTEMBER 3, 2024  
DRAWN BY: Steven Madden  
DESIGNED BY: Steven Madden

**COPYRIGHT NOTE:** © These Plans Are Subject To Federal Copyright Laws And Are To Be Used For The Lot Number And Subdivision Indicated In This Title Block Only. Use On Any Other Site Is Prohibited.

© COPYRIGHT 2022  
Sheet Title  
**FOUNDATION PLAN**

Sheet:  
**A4.0**  
□ Preliminary Dwg.  
□ Bidding Doc.  
□ Construction Doc.




CEILING JOIST SPANS		
CEILING JOIST SPANS FOR SOUTHERN PINE SPECIES (UNINHABITABLE ATTIC WITHOUT STORAGE, LIVE LOAD = 20 PSF, L.A. = 240) DEAD LOAD = 10 PSF		
*IF HABITABLE ATTIC SPACE OR STORAGE IS DESIRED, REFER TO INTERNATIONAL RESIDENTIAL CODE SPAN TABLES		
SIZE	SPACING (INCHES)	VISUALLY GRADED #2 SOUTHERN PINE (MAXIMUM CEILING JOIST SPAN) (FT.-IN.)
2"x4"	12.0	9-3
	16.0	8-0
	19.2	7-4
	24.0	6-7
2"x6"	12.0	13-11
	16.0	12-0
	19.2	11-0
	24.0	9-10
2"x8"	12.0	17-7
	16.0	15-3
	19.2	13-11
	24.0	12-6
2"x10"	12.0	20-11
	16.0	18-1
	19.2	16-6
	24.0	14-9

NOTE: THE ABOVE TABLE IS BASED ON THE IRC TABLE R802.5.1 (2)

RAFTER SPANS		
RAFTER SPANS FOR SOUTHERN PINE SPECIES (LIVE LOAD = 20 PSF, L.A. = 240) DEAD LOAD = 10 PSF		
SIZE	SPACING (INCHES)	SPANS (MAXIMUM RAFTER SPANS BETWEEN BRACING) (FT.-IN.)
2"x6"	12.0	12-11
	16.0	11-2
	19.2	10-2
	24.0	9-2
2"x8"	12.0	16-4
	16.0	14-2
	19.2	12-11
	24.0	11-7
2"x10"	12.0	19-5
	16.0	16-10
	19.2	15-4
	24.0	13-9
2"x12"	12.0	22-10
	16.0	19-10
	19.2	18-1
	24.0	16-2

NOTE: THE ABOVE TABLE IS BASED ON THE IRC TABLE R802.4.1 (3)

ENGINEERED ROOF TRUSSES

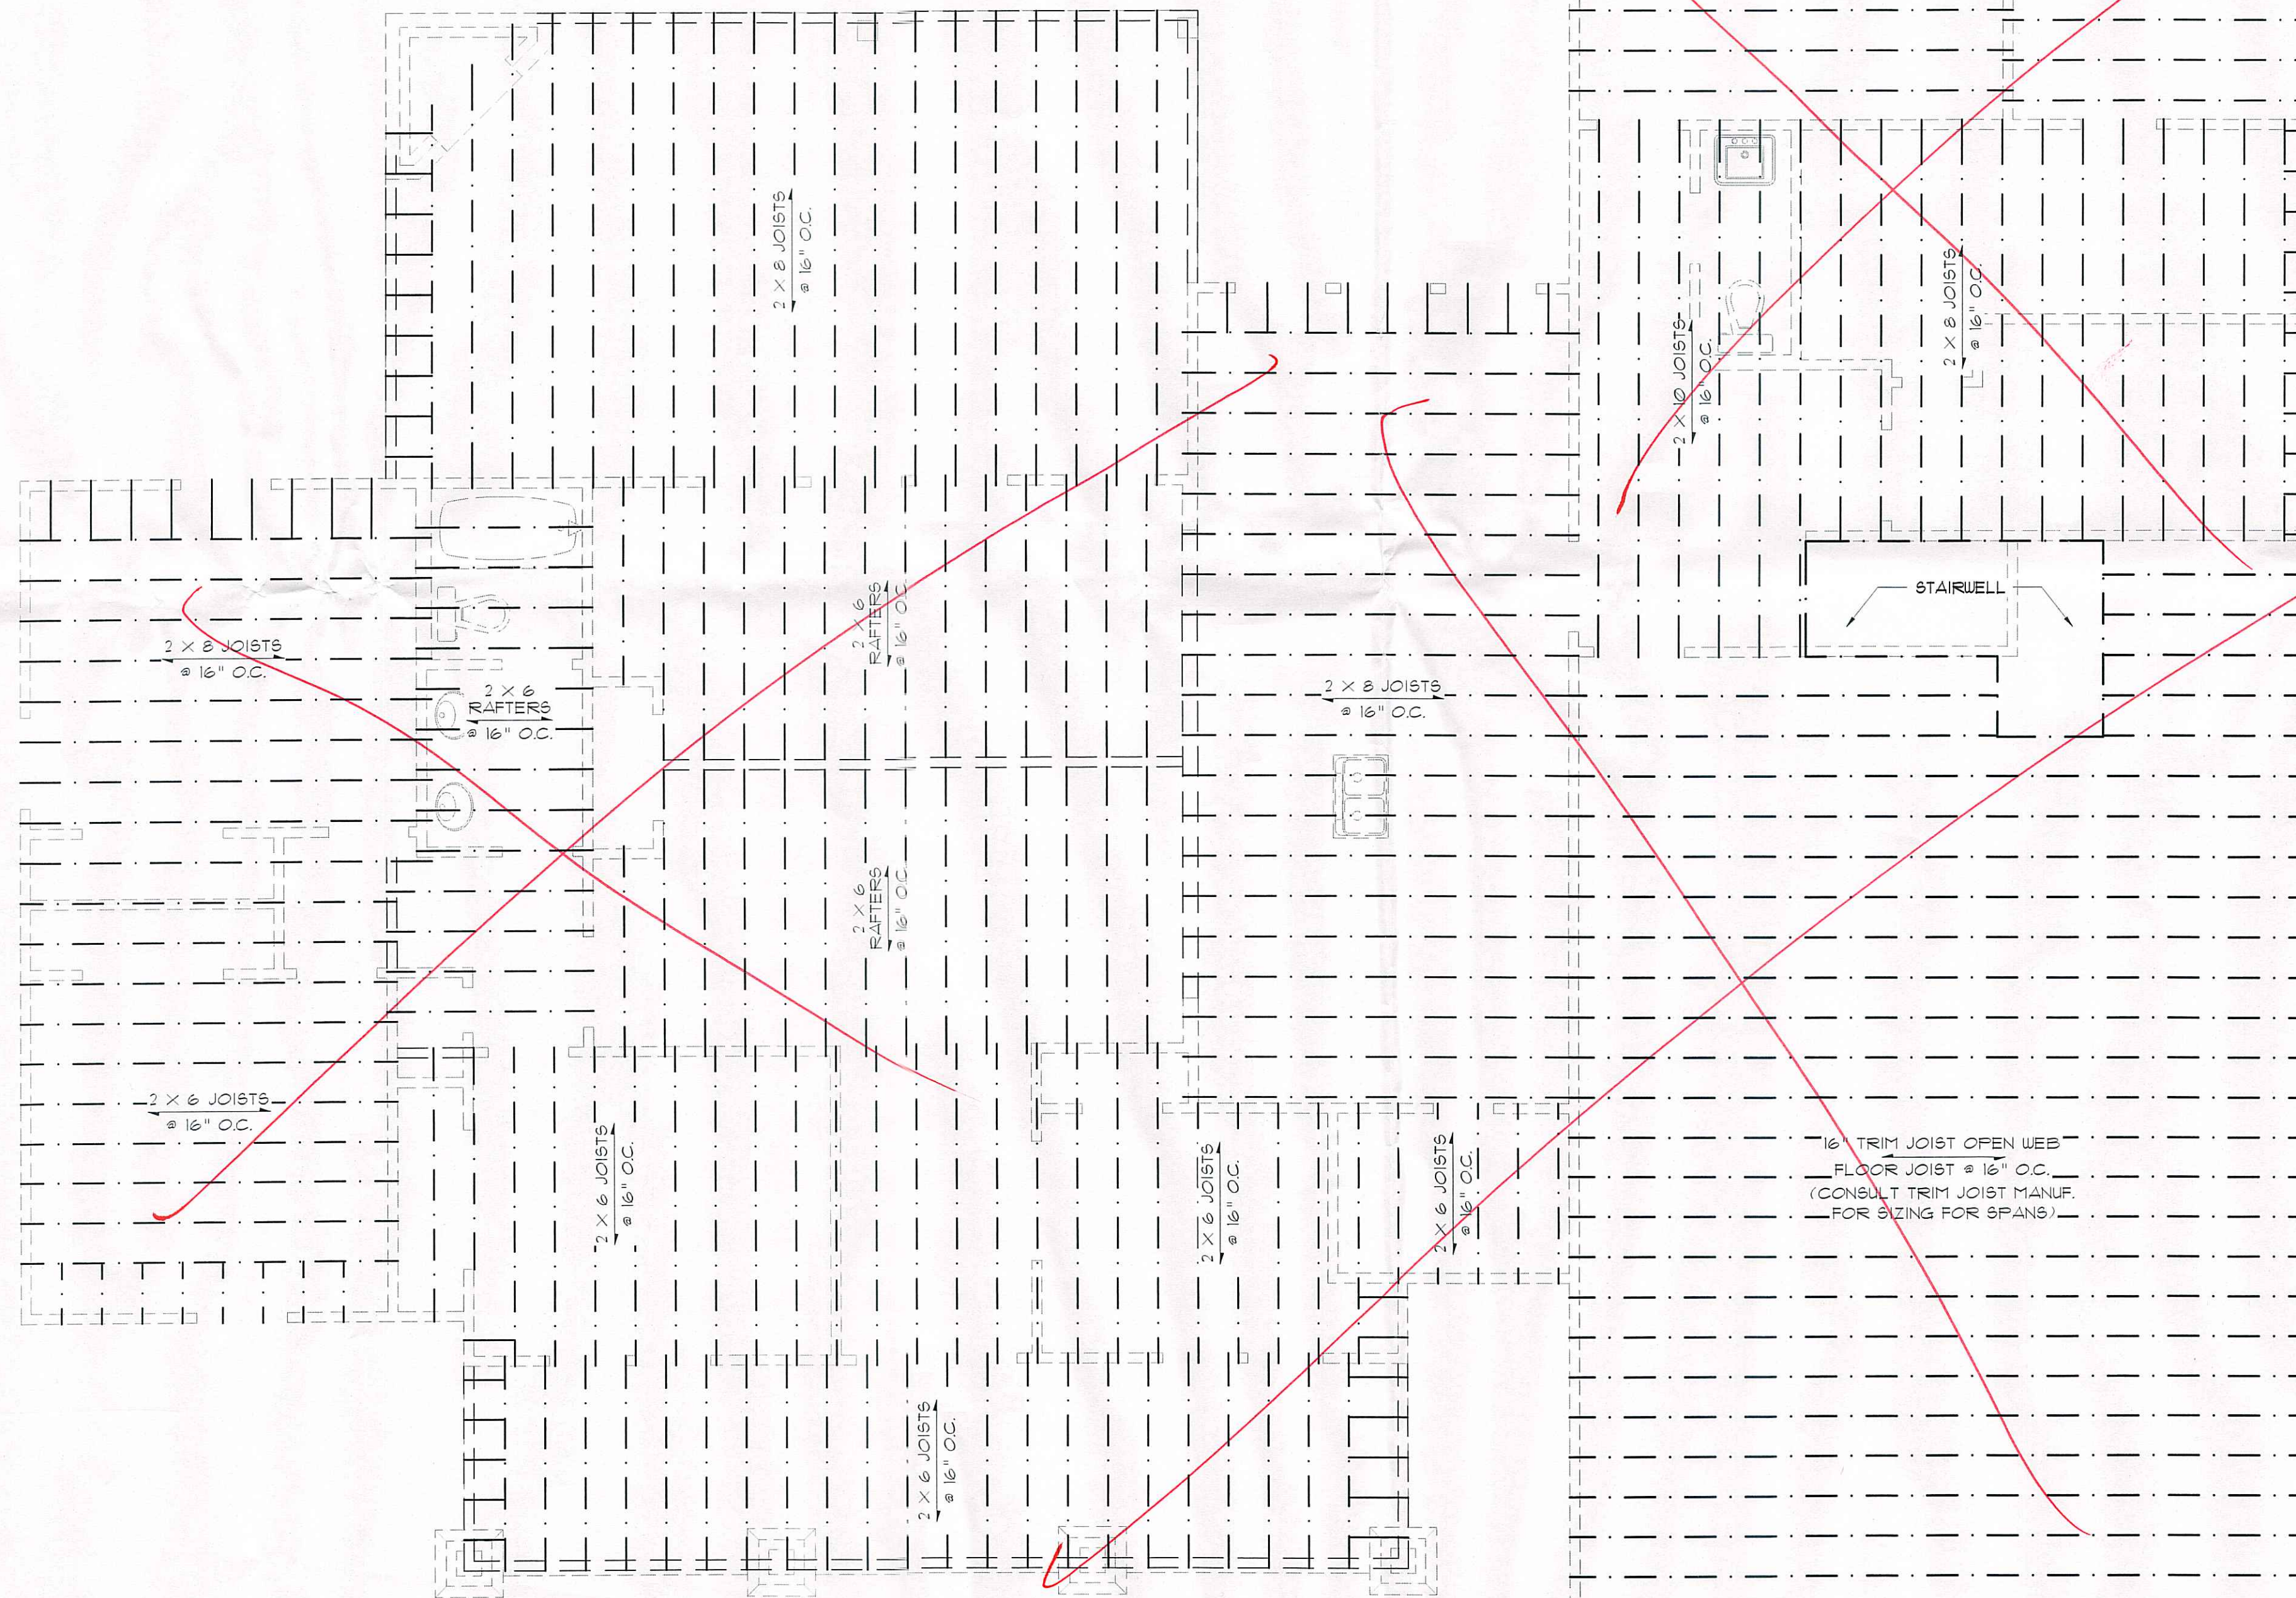

JOISTS FRAMING PLAN  
SCALE: 1/4" = 1'-0"

**CEILING JOIST & RAFTER NOTE:**  
CEILING JOISTS & RAFTERS ARE SELECTED BASED ON SOUTHERN YELLOW PINE.  
IF ANOTHER SPECIES OF WOOD IS USED THE JOISTS MUST BE RE-SELECTED, AND IT IS THE BUILDER OR CONTRACTOR'S RESPONSIBILITY TO RECALCULATE JOIST & RAFTER SIZES TO ENSURE PROPER CONSTRUCTION OF THE HOME.

**GENERAL FRAMING NOTES:**  
THE FOLLOWING NOTES ARE SUGGESTED MINIMUM REQUIREMENTS ONLY. DUE TO A VARIANCE OF CODES PER REGION, PLEASE REFER AND COMPLY WITH ALL YOUR LOCAL CODES. CONSULT WITH LOCAL ENGINEERS FOR ALL STRUCTURAL REQUIREMENTS.

- PROVIDE FURLINS AT MID HEIGHT OF ALL WALLS.
- ALL JOIST AND RAFTERS SHALL BE ALIGNED OVER STUDS BELOW.
- ALL HEADERS SHALL BE 2-2X10'S WITH 1" PLYWOOD FLITCH PLATE UNLESS OTHERWISE NOTED.
- PROVIDE 1X4 CROSS BRACING AT MIDPOINT OF SPAN OR 8'-0" O.C. MAXIMUM IN ALL FLOORS.
- ALL EXTERIOR CORNERS (INSIDE AND OUTSIDE CORNERS) SHALL BE BRACED WITH 1" CDX PLYWOOD. NAILING SCHEDULE SHALL BE BD COMMONS AT 4" O.C. AT ALL EDGES AND BD COMMONS AT 12" O.C. AT ALL INTERMEDIATE STUDS. (OPTION-APPROVED DIAGONAL CORNER BRACES BOTH DIRECTIONS AT ALL CORNERS).
- ALL COLUMNS OR SOLID FRAMES SHALL EXTEND DOWN THRU ALL LEVELS AND TERMINATE AT THE BOTTOM FLOOR AND BE SUPPORTED BY THICKENED SLAB, GRADE BEAM, OR FOOTING DESIGNED TO CARRY LOAD.
- PROVIDE DOUBLE 2X6 STRONGBACK AT MIDSPAN FOR CEILING JOISTS WITH SPAN GREATER THAN 10'-0".
- PROVIDE COLLAR TIES AT UPPER 1/3 OF VERTICAL DISTANCE BETWEEN RIDGE BOARD AND CEILING JOISTS AT 4'-0" O.C. MAXIMUM.
- HIP, VALLEY RAFTERS, AND RIDGE BOARDS SHALL BE ONE "2X" SIZE LARGER THAN RAFTERS.
- ROOF DECKING SHALL BE 1" CDX PLYWOOD MINIMUM.
- WHERE FIRE ENGINEERED FLOOR AND ROOF TRUSSES ARE USED, TRUSS MANUFACTURER MUST PROVIDE SHOP DRAWINGS WHICH BEAR SEAL OF REGISTERED ENGINEER IN STATE IN WHICH WORK IS TO BE PERFORMED.
- ALL SOLID FRAMING, COLUMNS, BEAMS, ETC. TO BE DESIGNED BY LOCAL STRUCTURAL ENGINEER AND MEET ALL LOCAL CALLS.
- ALL FRAMED WALL DIMENSIONS ARE BASED ON 2X4 STUDS UNLESS OTHERWISE NOTED.
- COLUMNS SHALL BE ADEQUATELY ANCHORED TO SLAB TO PREVENT LATERAL DISPLACEMENT PER IRC R401.3.
- SITE-ASSEMBLED HEADERS AND GIRDERS TO BE SIZED PER IRC TABLE R602.1(1) AND (2).
- HEADERS AND GIRDERS WHOSE SPAN EXCEEDS THOSE LISTED IN IRC TABLE R602.1(1) AND (2) ARE TO BE ENGINEERED BEAMS TO BE SIZED BY A QUALIFIED PARTY.
- WALLS ADJACENT TO GARAGE DOOR OPENING TO BE BRACED TO THE MINIMUM LENGTHS LISTED IN IRC R602.10.3 VIA SHEATHING OR AN ALTERNATIVE METHOD OF RESISTING SHEAR AS DESIGNED BY A QUALIFIED ENGINEER.
- ROOF AND FLOOR SHEATHING TO COMPLY WITH SPAN CHART R602.11 (1)

MADDEN HOME DESIGN, LLC NOT BEING AN ARCHITECTURAL OR ENGINEERING FIRM ASSUMES NO LIABILITY FOR STRUCTURAL OR ARCHITECTURAL DESIGN INTEGRITY. EVERY EFFORT HAS BEEN MADE TO INSURE ALL DIMENSIONS ARE CORRECT AND ENVIRONMENTAL REGULATIONS HAVE BEEN MET. IF AN ERROR OR OMISSION OCCURS, THE CONTRACTOR OR SUBCONTRACTOR AND/OR OMISSION AT HIS OWN EXPENSE AND NOT THE RESPONSIBILITY OF THE DRAFTING SERVICE. CONTRACTOR IS RESPONSIBLE FOR VERIFICATION OF DIMENSIONS IN THE FIELD AND SHALL BUILD HOME IN ACCORDANCE WITH THE INTERNATIONAL RESIDENTIAL CODE 2021.

RESIDENCE OF  
**LARRY GODWIN JR.**  
Mc11554 Godwin

Project  
**MADDEN HOME DESIGN**  
8375 Rushing Road  
Denham Springs, Louisiana 70726  
Phone: (225) 791-2912

**A B D**

Project No.: CEDAR SPRINGS  
W. BONUS  
DATE: SEPTEMBER 3, 2024  
DRAWN BY: Steven Madden  
DESIGNED BY: Steven Madden


COPYRIGHT NOTE: © These Plans Are Subject To Federal Copyright Laws And Are To Be Used For The Lot Number And Subdivision Indicated In This Title Block Only. Use On Any Other Site Is Prohibited.

© COPYRIGHT 2022  
Sheet Title  
**JOIST FRAMING PLAN**

Sheet:  
□ Preliminary Dwg.  
□ Bidding Doc.  
□ Construction Doc.

**A5.0**



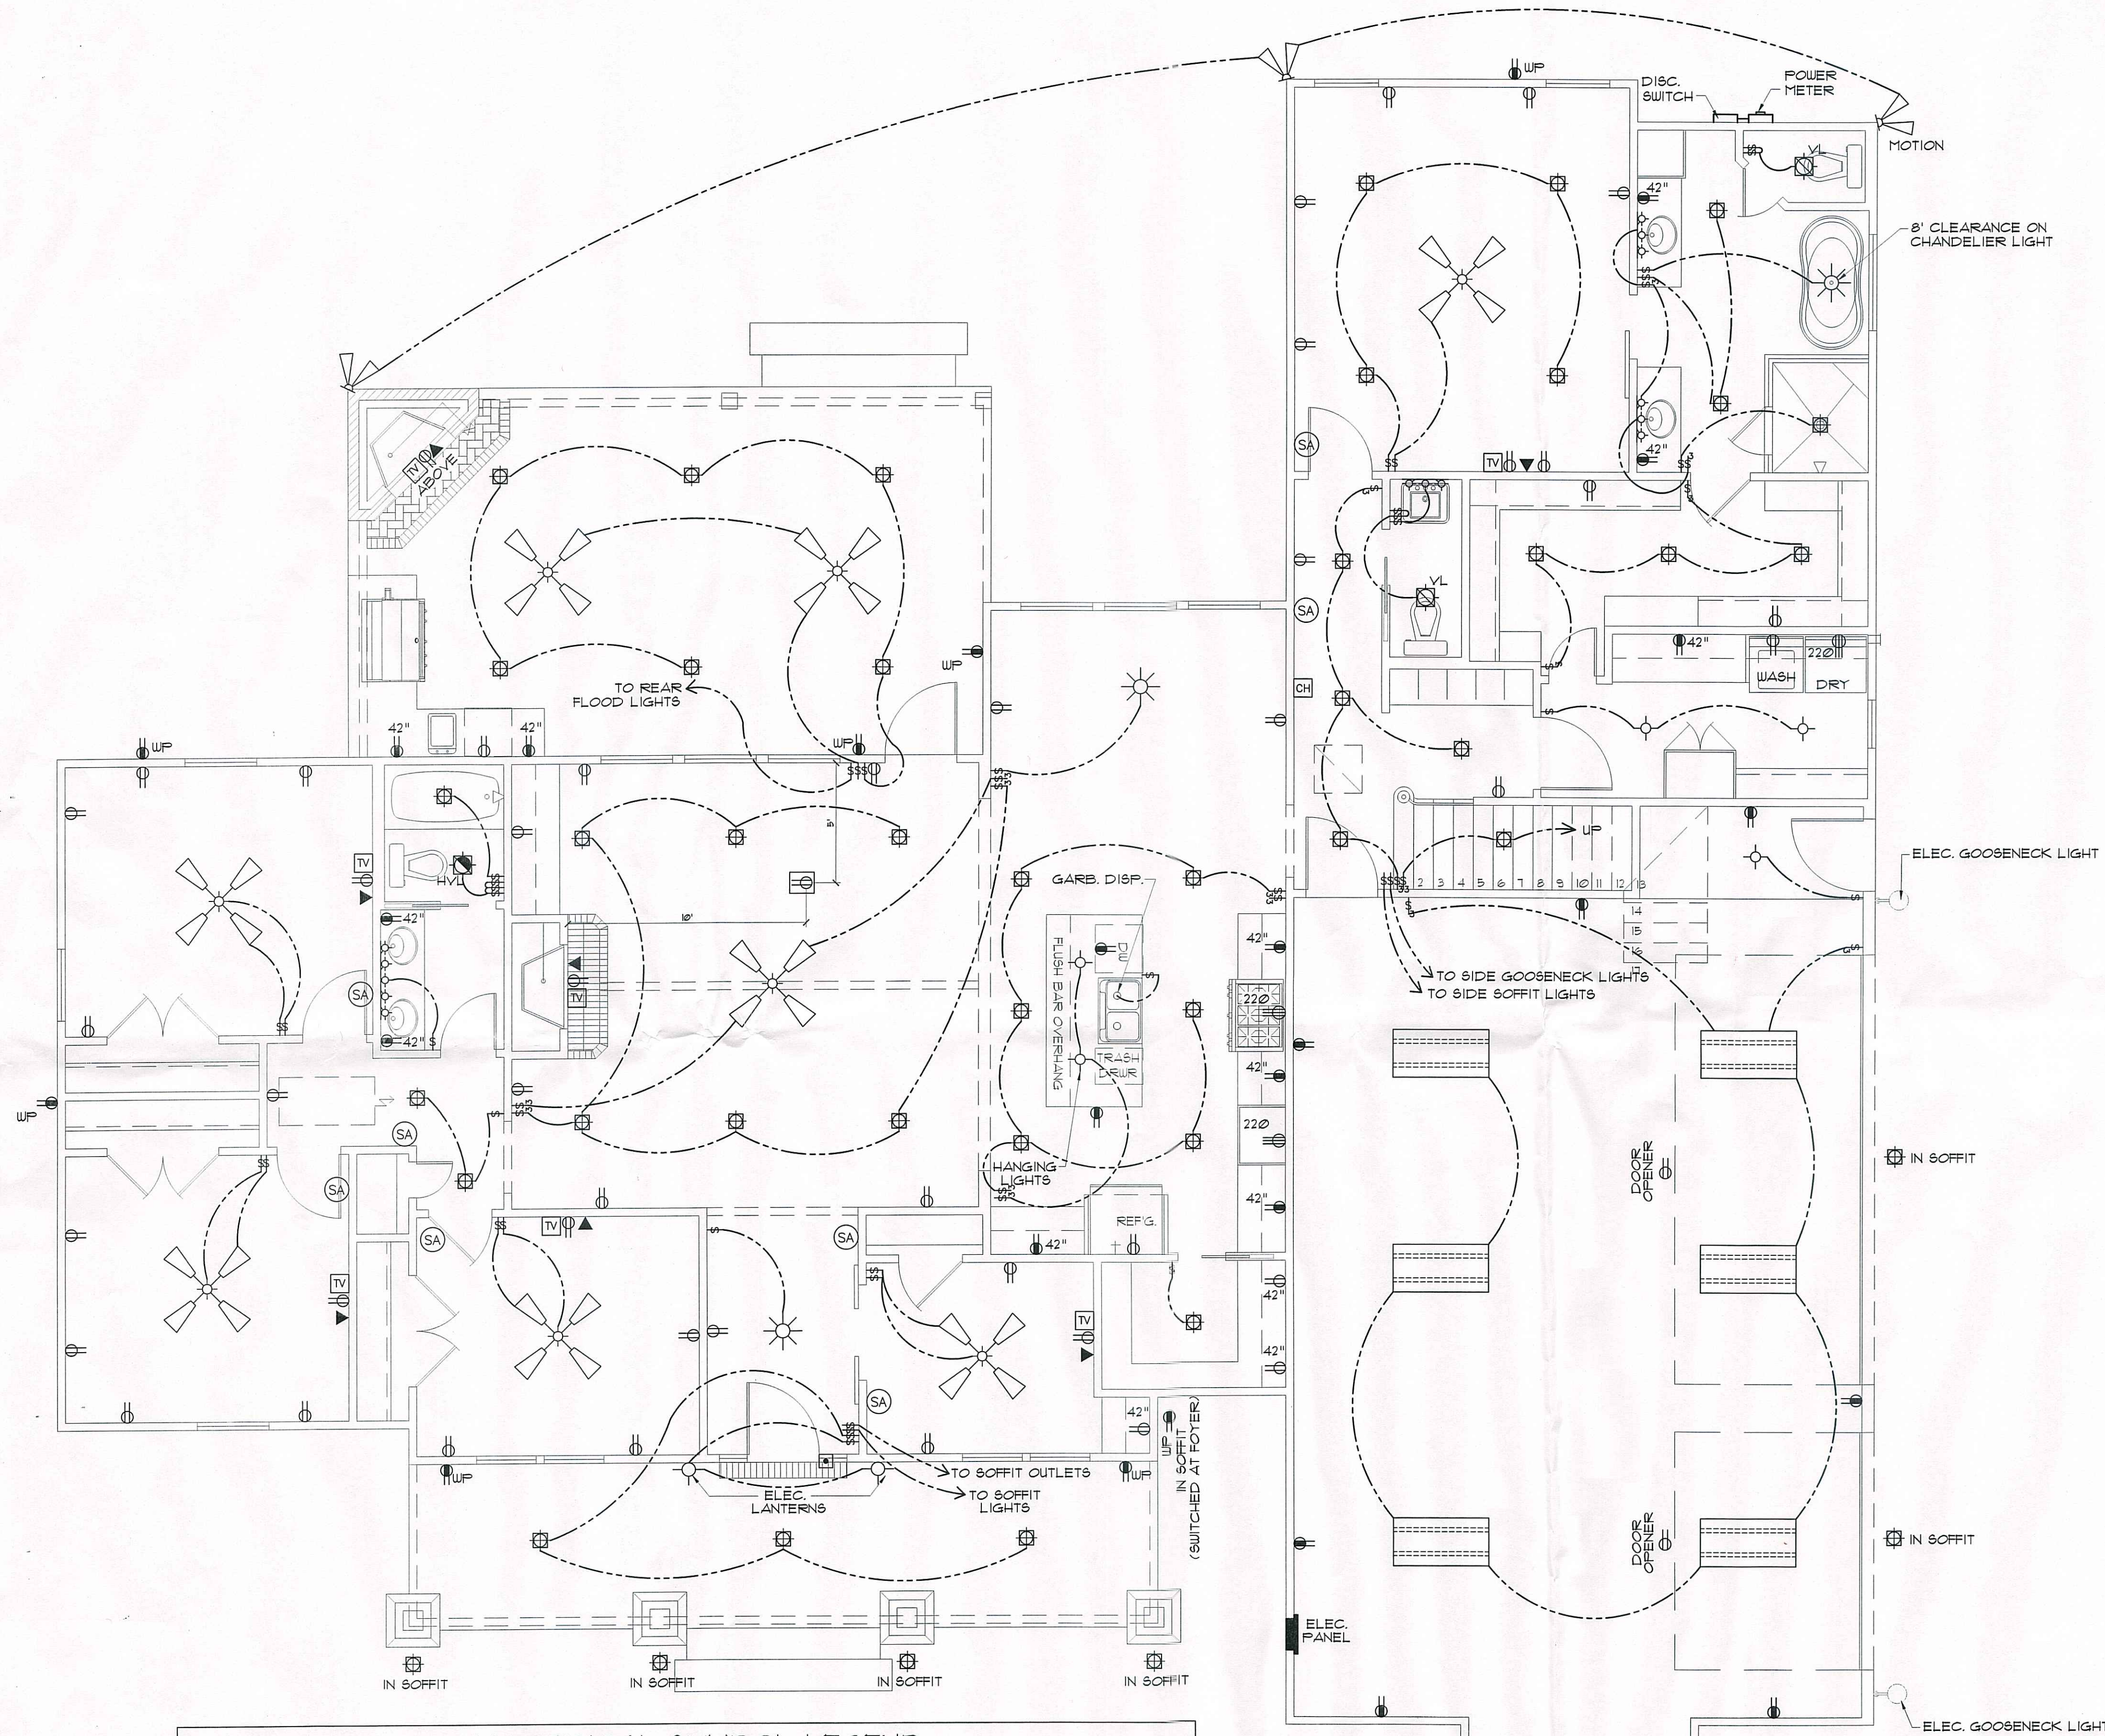

**IRC 2021 ELECTRICAL BUILDING CODE NOTES:**

- E3302.9 LAUNDRY AREAS - 125 VOLT THROUGH 250 VOLT RECEPTACLES INSTALLED IN LAUNDRY AREAS AND SUPPLIED BY SINGLE-PHASE BRANCH CIRCUITS RATED 150 VOLTS OR LESS TO GROUND SHALL HAVE GROUND-FAULT CIRCUIT-INTERRUPTER PROTECTION FOR PERSONNEL. (NEC 210.8(A)(12))
- E3302.11 KITCHEN DISHWASHER BRANCH CIRCUIT - GROUND-FAULT CIRCUIT-INTERRUPTER PROTECTION SHALL BE PROVIDED FOR OUTLETS SUPPLIED BY BRANCH CIRCUITS RATED 150 VOLTS OR LESS TO GROUND THAT SUPPLY DISHWASHERS IN DWELLING UNIT LOCATIONS. (NEC 422.5(A))
- E3601.8 EMERGENCY DISCONNECTS - FOR ONE AND TWO FAMILY DWELLING UNITS, ALL SERVICE CONDUCTORS SHALL TERMINATE IN DISCONNECTING MEANS HAVING A SHORT-CIRCUIT CURRENT RATING EQUAL TO OR GREATER THAN THE AVAILABLE FAULT CURRENT, INSTALLED IN A READILY ACCESSIBLE OUTDOOR LOCATION. IF MORE THAN ONE DISCONNECT IS PROVIDED, THEY SHALL BE GROUPED. EACH DISCONNECT SHALL BE ONE OF THE FOLLOWING:
  1. SERVICE DISCONNECTS MARKED AS FOLLOWS: "EMERGENCY DISCONNECT, SERVICE DISCONNECT"
  2. METER DISCONNECT SWITCHES THAT HAVE A SHORT-CIRCUIT CURRENT RATING EQUAL TO OR GREATER THAN THE AVAILABLE FAULT CURRENT AND ALL METAL HOUSINGS AND SERVICE ENCLOSURES ARE GROUNDED IN ACCORDANCE WITH SECTION E300.1 AND BONDED IN ACCORDANCE WITH SECTION 360.3. A METER DISCONNECT SWITCH SHALL BE CAPABLE OF INTERRUPTING THE LOAD SERVED AND SHALL BE MARKED AS FOLLOWS: "EMERGENCY DISCONNECT, METER DISCONNECT, NOT SERVICE EQUIPMENT"
  3. OTHER LISTED DISCONNECT SWITCHES OR CIRCUIT BREAKERS ON THE SUPPLY SIDE OF EACH SERVICE DISCONNECT THAT ARE SUITABLE FOR USE AS SERVICE EQUIPMENT AND MARKED AS FOLLOWS: "EMERGENCY DISCONNECT, NOT SERVICE EQUIPMENT"
- E3606.5 SURGE PROTECTION - ALL SERVICES SUPPLYING ONE AND TWO FAMILY DWELLING UNITS SHALL BE PROVIDED WITH A SURGE-PROTECTIVE DEVICE (SPD) INSTALLED IN ACCORDANCE WITH SECTIONS E3606.5.1 THROUGH E3606.5.3
- E3606.5.1 LOCATION - THE SPD SHALL BE AN INTEGRAL PART OF THE SERVICE EQUIPMENT OR SHALL BE LOCATED IMMEDIATELY ADJACENT THERETO. EXCEPTION, THE SPD SHALL NOT BE REQUIRED TO BE LOCATED IN THE SERVICE EQUIPMENT IF LOCATED AT EACH NEXT LEVEL DISTRIBUTION EQUIPMENT DOWNSTREAM TOWARD THE LOAD.
- E3606.5.2 TYPE - THE SPD SHALL BE A TYPE 1 OR TYPE 2 SPD.

**PRE-WIRE FOR THE FOLLOWING:**

- TELEPHONE (ONE INCOMING LINE)
- CABLE VISION (ONE OUTLET PER ROOM MINIMUM)
- SECURITY SYSTEM - COORDINATE W/ OWNER
- COORDINATE ELECTRICAL SYSTEM WITH MECHANICAL CONTRACTOR
- ALL WIRING TO BE COPPER MIN. 12/2 W/ GROUND
- VERIFY LOCATION OF FLOOR OUTLETS IN FAMILY ROOM
- PROVIDE 110V OUTLET FOR GARBAGE DISPOSAL UNDER KITCHEN SINK
- PROVIDE 110V OUTLET FOR WHIRLPOOL TUB MOTOR UNDER WHIRLPOOL TUB IN MASTER BATH IF APPLICABLE
- PROVIDE 220V OUTLET FOR CLOTHES DRYER
- COORDINATE SURROUND SYSTEM W/ OWNER

**ELECTRICAL NOTES:**

- MAIN FEED INTO HOUSE TO BE TRENCHED UNDERGROUND FROM SUPPLY POLE TO METER THEN MAIN DISCONNECT OUTSIDE.
- ALL SMOKE DETECTORS TO BE ELECTRIC POWERED WITH BATTERY BACKUP AND WIRED TO SET ALL ALARMS OFF IF ONE IS TRIPPED.
- ALL EXTERIOR, KITCHEN, AND BATH OUTLETS TO BE GROUND FAULT CIRCUIT INTERRUPTER EQUIPPED AND ON A SEPARATE CIRCUIT.
- ELECTRICAL DISCONNECTS ARE TO BE AT A/C UNIT, CONDENSING UNIT, AND WATER HEATER.
- HEAT VENT LIGHTS ARE TO BE ON A SEPARATE CIRCUIT.
- OUTLETS, INCLUDING PHONE AND CABLE, MAY BE ADDED OR CHANGED UPON OWNER'S REQUEST.
- ELECTRICAL CONTRACTOR TO VERIFY EQUIPMENT TYPE AND SIZE.
- INSTALL LIGHTS IN ATTIC SPACE W/ SWITCH AT FOOT OF DISP. STAIRS
- ELECTRICAL SERVICE TO BE A 42 CIRCUIT 200 AMP MAIN LOCATED IN THE GARAGE.
- A SUB-PANEL MAY NEED TO BE ADDED FOR ENOUGH CIRCUITS.
- HOUSE TO BE WIRED FOR A SECURITY SYSTEM.
- ALL KITCHEN OUTLETS ARE TO BE GFI EXCEPT APPLIANCE OUTLETS NOT EASILY ACCESSIBLE.
- ARC FAULT BREAKERS ARE TO BE USED IN ALL BEDROOMS.
- IF GAS FIRED APPLIANCES ARE USED IN HOME, CARBON MONOXIDE ALARMS ARE NEEDED (IRC R315).

TV	CABLE OUTLET	□	ELEC. DOOR BELL	□	LED RECESSED LIGHT
▼	TELEPHONE/ ETHERNET OUTLET	CH	DOORBELL CHIME	□	LIGHT FIXTURE - LED
⊕	RECEPTACLE, 15A, 125V, 2 POLE 3 WIRE, GROUNDED, DUPLEX	⊕	DIMMER SWITCH	SA	SMOKE ALARM - 110V ELEC. W/ CARBON MONOXIDE DETECTOR
⊕	FLOOR DUPLEX RECEPTACLE	⊕	LIGHT FIXTURE, LED CEILING MOUNTED	⊕	VANITY LIGHT
⊕	GROUND-FAULT-CIRCUIT-INTERLUPT RECEPTACLE-USE SQUARE D QUICK GUARD FOR WP LOCATIONS	⊕	LIGHT FIXTURE, LED EXTERIOR FLOODS	⊕	HEAT/VENT/LIGHT
220	RECEPTACLE, 50A, 220V, 2 POLE 3 WIRE, GROUNDED	⊕	CEILING FAN W/ LIGHT- PROVIDE SEPERATE SWITCHES FOR F & L	⊕	VENT/LIGHT ONLY
⊕	TOGGLE SWITCH, SINGLE POLE, 15A	⊕	LIGHT FIXTURE - CHANDELIER W/ LED BULBS	⊕	VENT/LIGHT RECESSED CAN
⊕	TOGGLE SWITCH, 3 WAY, 15A	⊕		⊕	SCONCE LIGHT
⊕	BRONZE UP LIGHTS (NUVO 6" LANDSCAPE)	⊕		⊕	WALL MOUNT ELECTRIC LANTERN

**ELECTRICAL PLAN**  
SCALE: 1/4" = 1'-0"

MADDEN HOME DESIGN, LLC NOT BEING AN ARCHITECTURAL OR ENGINEERING FIRM ASSUMES NO LIABILITY FOR STRUCTURAL, OR ARCHITECTURAL DESIGN, INTEGRITY, OR SAFETY. EVERY EFFORT HAS BEEN MADE TO PREPARE THESE PLANS TO BE CORRECT AND COMPLETE. HOWEVER, THE CONTRACTOR SHALL BE RESPONSIBLE FOR VERIFYING ALL CONDITIONS IN THE FIELD AND SHALL BUILD HEREIN ACCORDANCE WITH THE INTERNATIONAL RESIDENTIAL CODE 2021.

RESIDENCE OF  
**LARRY GODWIN JR.**  
Melissa Godwin

**MADDEN HOME DESIGN**  
8375 Rushing Road  
Denham Springs, Louisiana  
70726  
Phone: (225) 791-2912

**A B D**

Project No.: CEDAR SPRINGS  
W. BONUS

DATE: SEPTEMBER 3, 2024

DRAWN BY: Steven Madden

DESIGNED BY: Steven Madden

COPYRIGHT NOTE: © These Plans Are Subject To Federal Copyright Laws And Are To Be Used For The Lot Number And Subdivision Indicated In This Title Block Only. Use On Any Other Site Is Prohibited.

© COPYRIGHT 2024

Sheet Title  
**ELECTRICAL PLAN**

□ Preliminary Dwg.  
□ Bidding Doc.  
□ Construction Doc.

Sheet:  
**E1.0**