
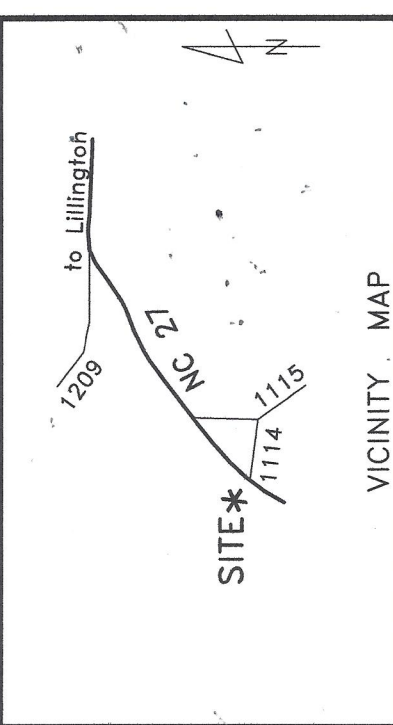


FEMA FLOOD HAZARD STATEMENT
 The subject property shown on this plat is located within the FEMA "Zone X" (Minimal Flood Risk) Area as shown on FIRM Number: 3710958600J
 Effective date: 10/3/2006

- LEGEND:**
- Subject Boundary Line
 - Adjoining Boundary Line
 - R/W Right-of-Way Line
 - C/L Centerline
 - Minimum Building Line (MBL)
 - Survey tie lines
 - ▲ CP Calculated Point
 - ERB Existing Re-Bar
 - ECS Existing Cotton Spindle
 - BG/AG Below/Above Grade

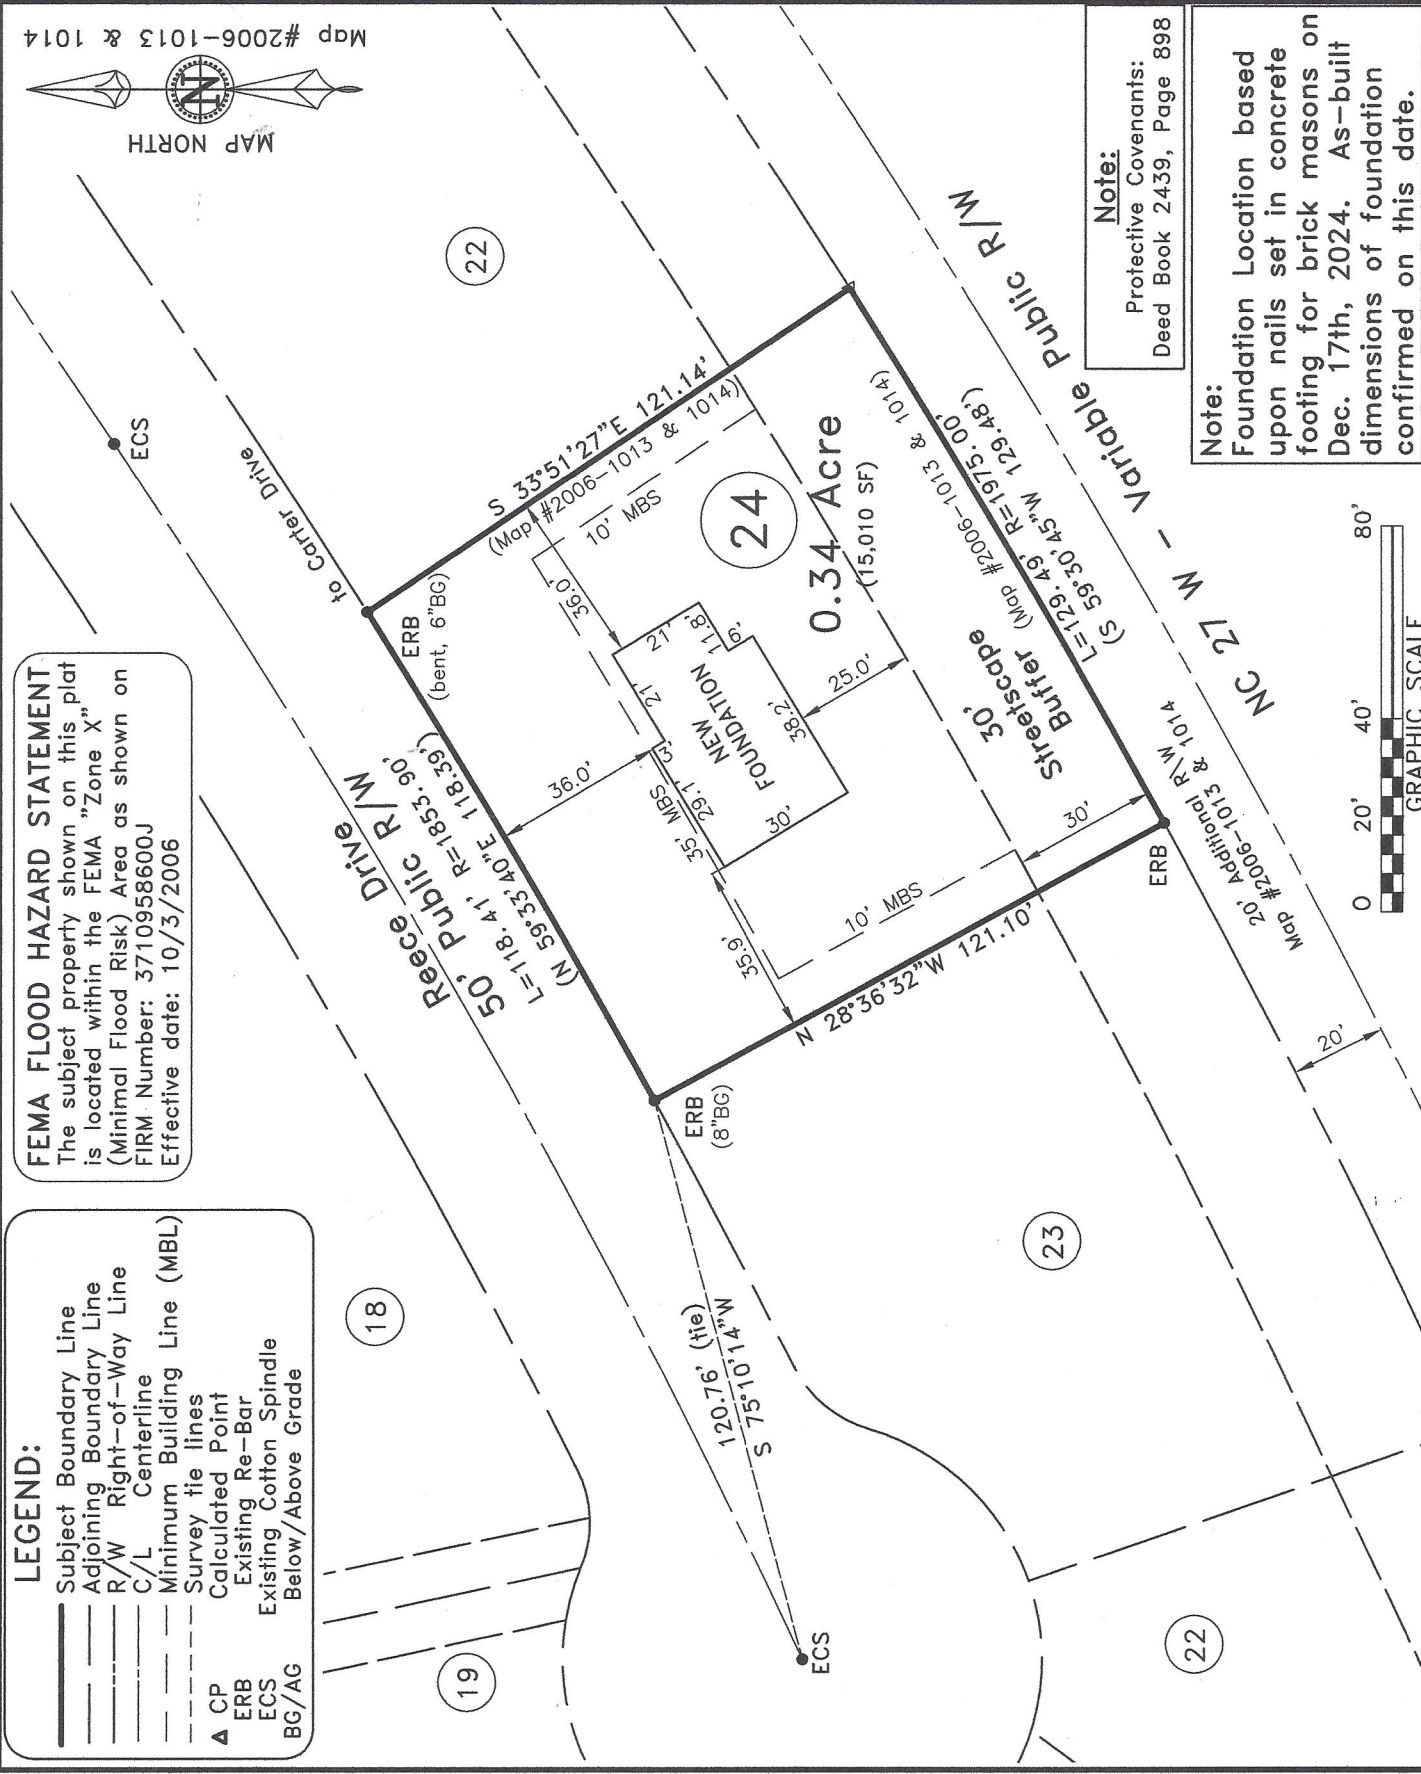

Signature Home Builders, Inc.
 Owners: John Michael & Heather Hayes Williams
 Barbecue Township Harnett County
 Scale: 1" = 40' Date: 2/14/2025

Surveyed & Mapped By
STREAMLINE LAND SURVEYING, Inc.
 NC FIRM C-1898
 870 NC 55 W, Coats, N.C. 27521
 Phone: 910-897-7715

I hereby certify that the foundation location shown hereon is correct in relation to property lines of record.

NOTE: The purpose of this survey is to locate the newly constructed foundation. Other features, fixtures, encumbrances and indications of use may be revealed by a complete site survey.

NOT FOR RECORDATION

Note:
 Protective Covenants:
 Deed Book 2439, Page 898

Note:
 Foundation Location based upon nails set in concrete footing for brick masons on Dec. 17th, 2024. As-built dimensions of foundation confirmed on this date.

