
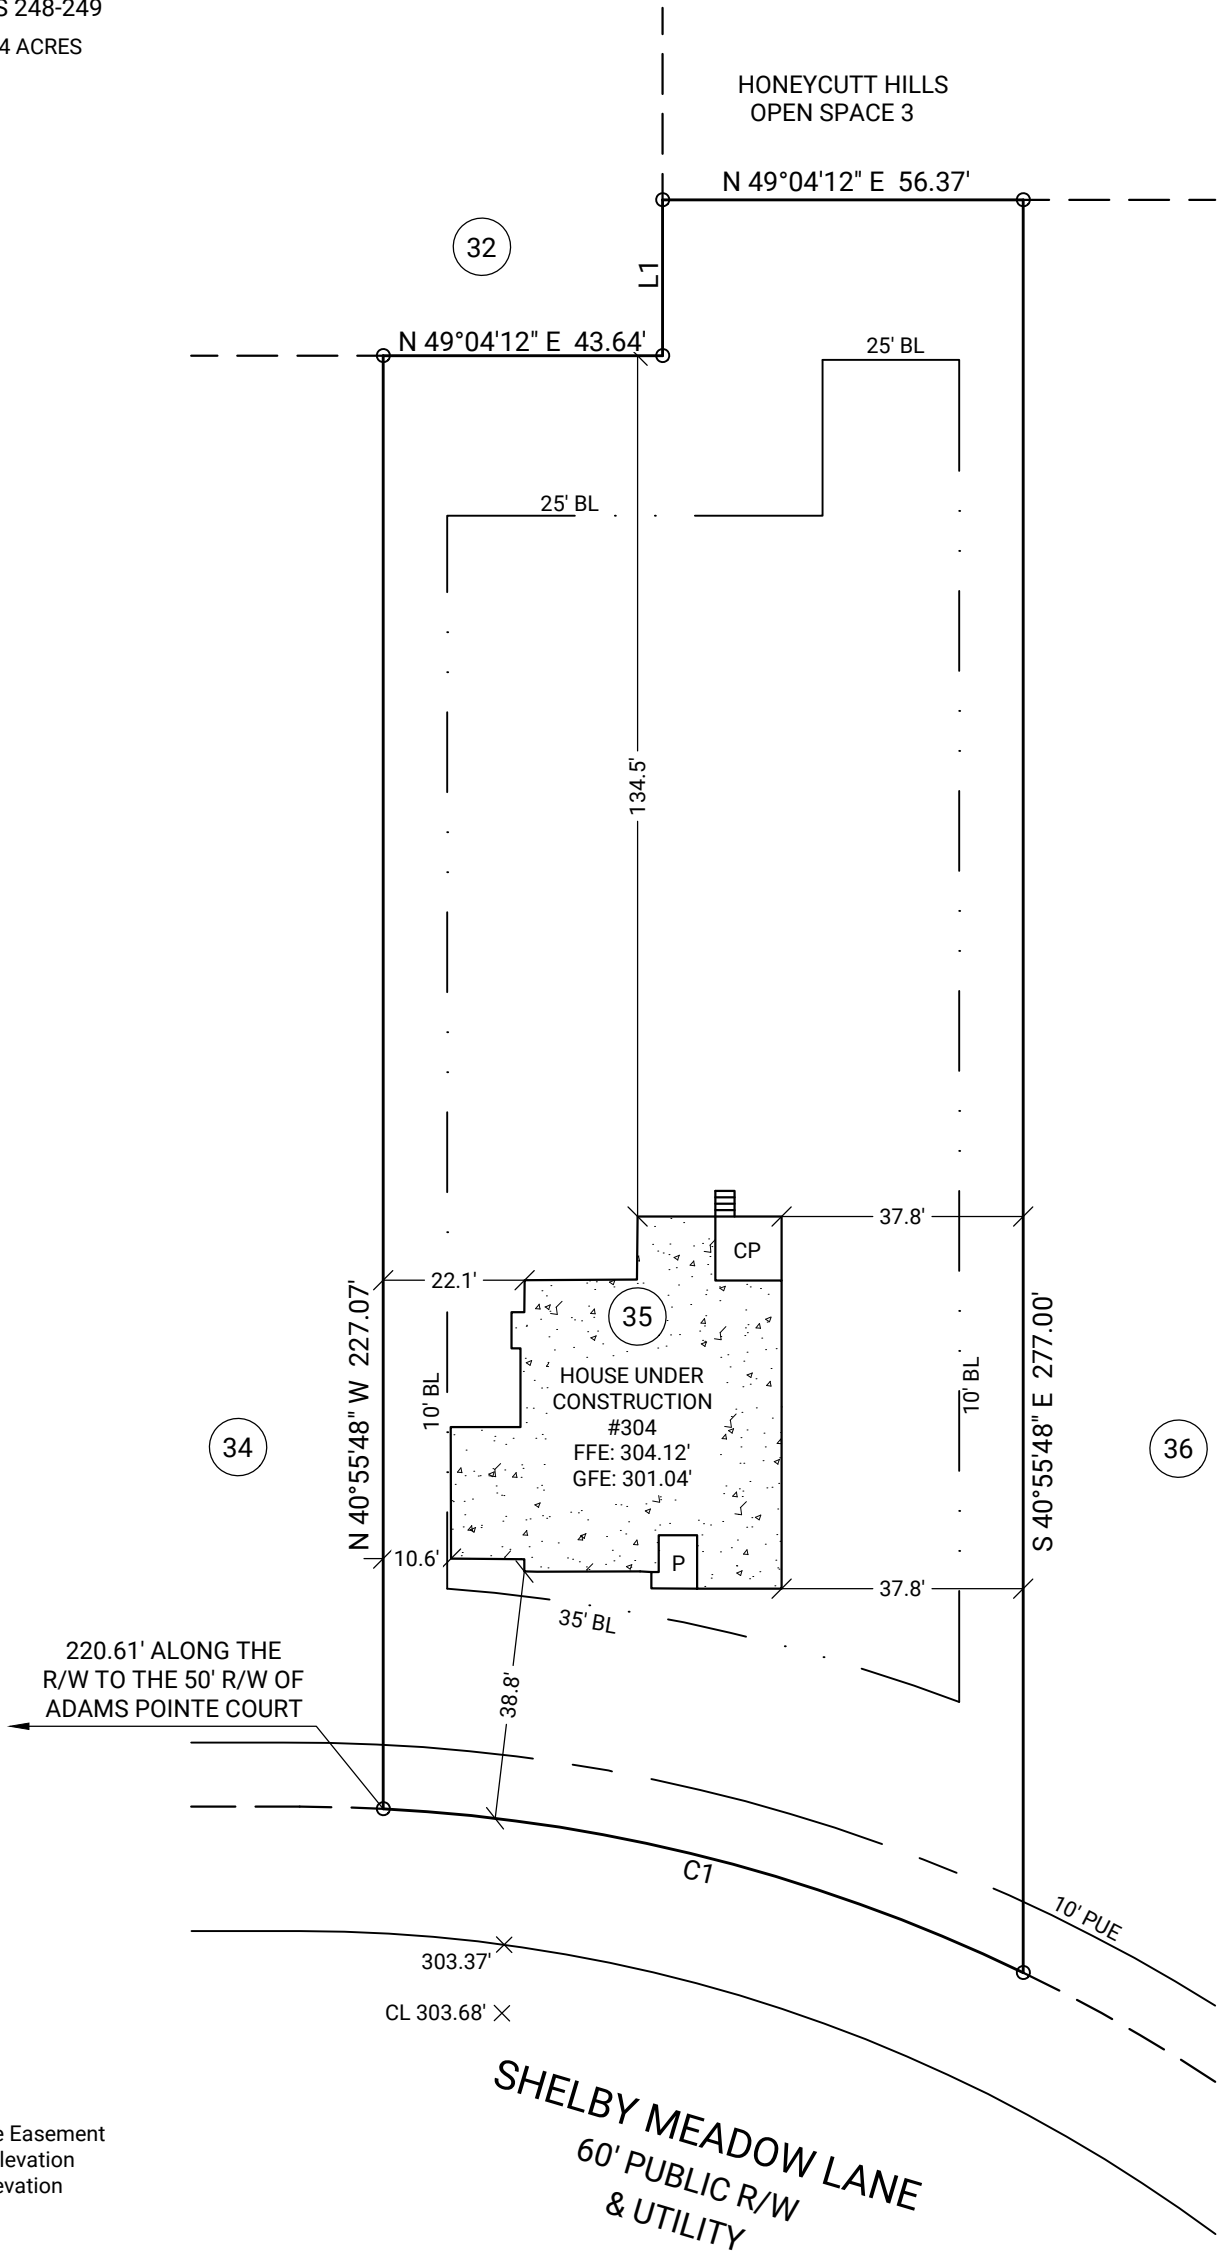
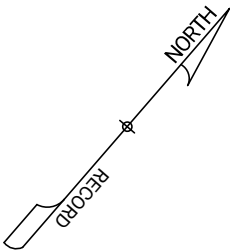


ADDRESS: 304 SHELBY MEADOW LANE
MAP BOOK 2023, PG'S 248-249
AREA: 25,002 S.F. ~ 0.574 ACRES

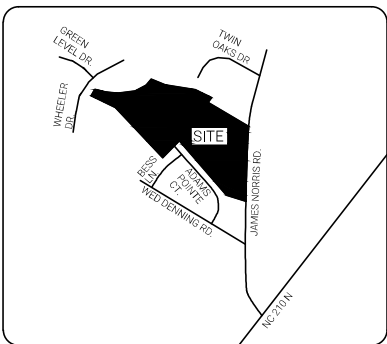

LEGEND

- BL Building Line
PDE Private Drainage Easement
FFE Finished Floor Elevation
GFE Garage Floor Elevation
A/C Air Conditioning
R/W Right of Way
P Porch
PAT Patio
PUE Public Utility Easement
GBL Garage Building Line
CP Covered Patio
PROP Proposed
N/F Now or Formerly
DE Drainage Easement
PIN Parcel Identification Number
CL Center Line
CONC Concrete
RBF Rebar Found
RBS Rebar Set

Line	Bearing	Distance		
L1	N 40°55'48" W	24.35'		
Curve	Radius	Length	Chord	Chord Bearing
C1	260.00'	103.91'	103.22'	S 63°25'19" W

I, David J. Baggett, PLS certify that this plat was drawn under my direction or supervision on the property shown and the boundaries and improvements, if any, are shown hereon. Boundaries not surveyed are shown as broken lines from information found in the referenced book(s) and page(s). this plat meets the standards of practice for land surveying in North Carolina, Title 21, Chapter 56, Rule 1600 and the error of closure does not exceed one foot per 10,000+ feet of the perimeter, nor 20 seconds times the square root of the number of angles turned. Witness my original signature, registration number and seal, this 13th day of March, 2025 AD.

GENERAL NOTES: All matters of title are excepted. This Map or Plat is subject to any additional easements or restrictions of record. Contact utility contractor for location prior to construction (if applicable). This plat is for exclusive use by client. Use by third parties is at their own risk. Dimensions from house to property lines should not be used to establish fences. This plat has been calculated for closure and is found to be accurate within one foot in 10,000+ feet. The field data upon which this plat is based has a closure precision of one foot in 10,000+ feet and an angular error of 7 seconds per angle point and was adjusted using the compass rule. Equipment used: Leica TS13 Robotic Total Station.

SUB: Honeycutt Hills
LOT: 35
Angier, Harnett County, North Carolina

FOUNDATION LOCATION FOR:

DRB


DRB GROUP OF NORTH CAROLINA, LLC.

PLAT DATE: 03/13/2025
FIELD WORK DATE: 03/11/2025
20250207163 DRB_RAL FC: JB



C+C BUILDING SOLUTIONS
A NORTH CAROLINA SUBSIDIARY OF CARTER + CLARK

Corporate Headquarters:
1735 North Brown Road, Suite 400
Lawrenceville, GA 30043
866.637.1048
FIRM LICENSE: F-1461

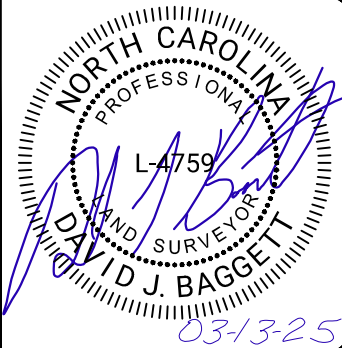

REVISION CHART

1	11/09/24	SITE PLAN
2	11/14/24	HOUSE MOVE
3	03/13/25	FOUNDATION LOCATION
4	00/00/24	---
5	00/00/24	---
6	00/00/24	---
7	00/00/24	---
8	00/00/24	---
9	00/00/24	---