

Harnett County Department of Public Health

PERMIT # SFD 2412-0041

Operation Permit

New Installation Septic Tank Nitrification Line Repair Expansion

PROPERTY LOCATION: 310 Travelers Way

SUBDIVISION Oakmont Ph III B

LOT # 250

Name: (owner) Oakmont Holdings

System Installer: Don Goddy


Basement with plumbing: Garage Number of Bedrooms 4 (8 people)

Type of Water Supply: Community Public Well Distance from well _____ feet

System Type: Type III B Types V and VI Systems expire in 5 years.

(In accordance with Table V a) Owner must contact Health Department 6 months prior to expiration for permit renewal.

This system has been installed in compliance with applicable North Carolina General Statutes, Rules for Sewage Treatment and Disposal, and all conditions of the Improvement Permit and Construction Authorization.

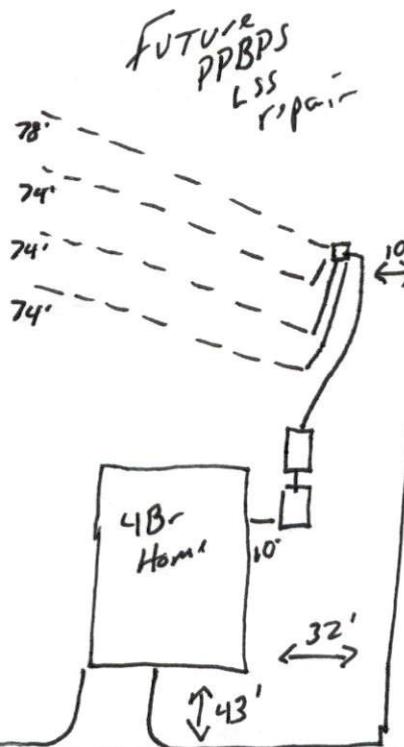

PERMIT CONDITIONS:

I. Performance: System shall perform in accordance with Rule .1961.

II. Monitoring: As required by Rule .1961.

III. Maintenance: As required by Rule .1961. Other: _____

Subsurface system operator required? Yes No

If yes, see attached sheet for additional operation conditions, maintenance and reporting.

IV. Operation: _____

V. Other: _____

Manfield D-Box Pump Alarm H2O Line PWR Line

Following are the specifications for the sewage disposal system on the above captioned property.

Type of system: Conventional Other 25% reduction in Qy Septic Tank: 1000 gallons Pump Tank: 1000 gallons

Subsurface No. of exact length width of depth of
Drainage Field ditches 1 of each ditch 300 feet ditches 3 feet ditches 20 inches

French Drain Required: _____ Linear feet

Authorized State Agent

Date 11-7-25


Oakmont - Lot #350
4-Bedroom Septic Design
310 Travelers Way - Harnett County
Ascot Corporation, LLC
PIN# 0507-64-6491

***As Built Revision - Approved by Alex Adams**

*Not a Survey

Sketched from a plot plan supplied by owner

System: Pressure Manifold
Lines: 1-4 (296')
LTAR: 0.4
20" Max Trench Bottom
Accepted Status System
Repair: Pressure Manifold
Lines: 5-7 (225')
LTAR: 0.4
20" Max Trench Bottom
Accepted Status System

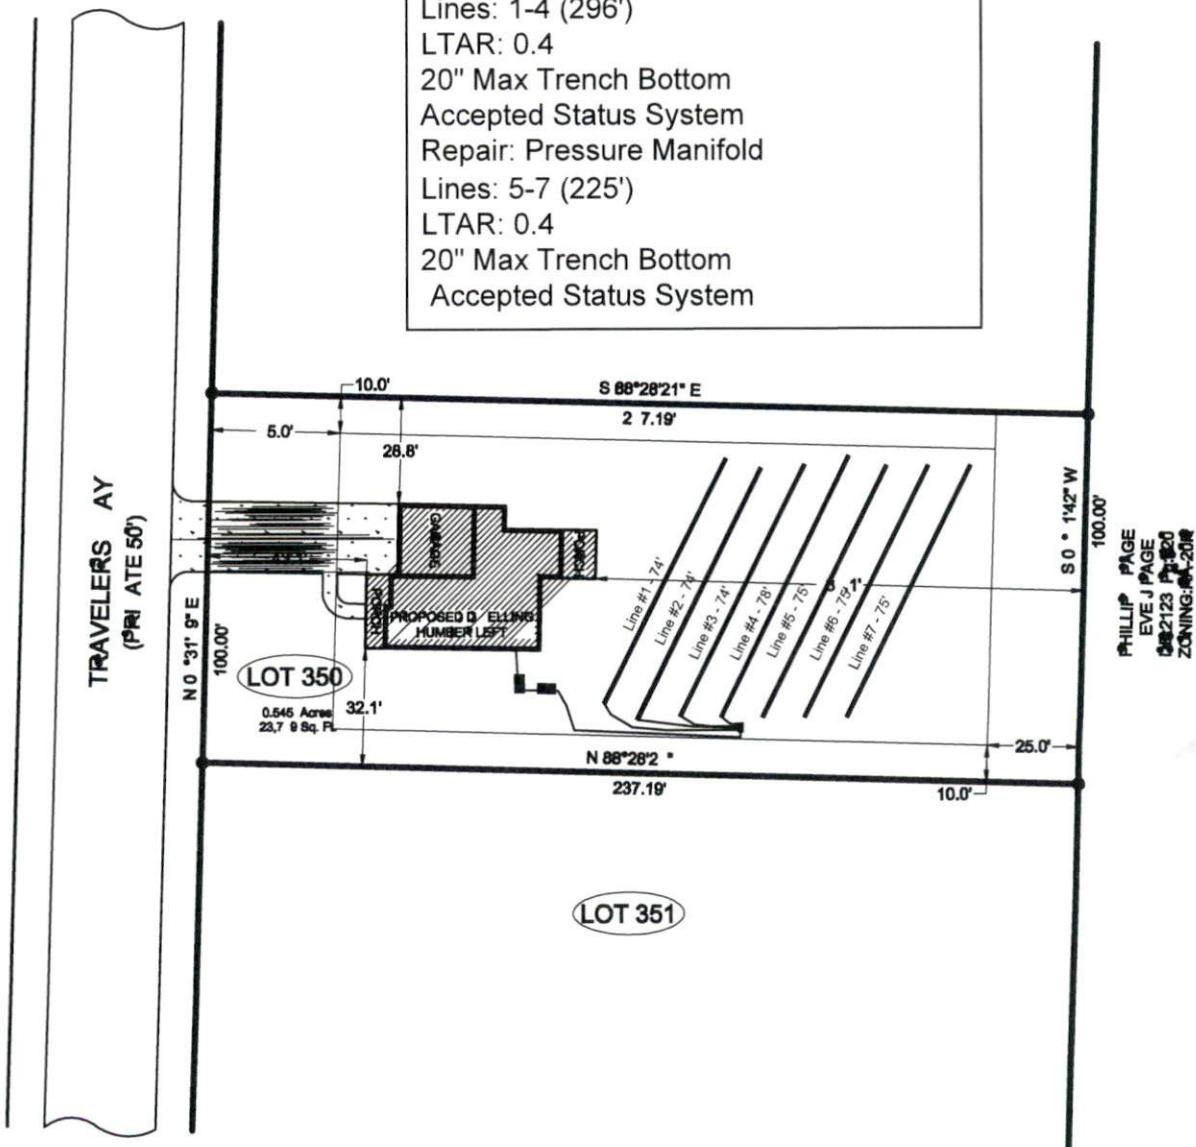

Adams
 Soil Consulting
 919-414-6761
 Job #1968