


214 Deodora Cedar Pointe Lot 10 System Detail "As Built"



0' 30'

1 inch = 30'

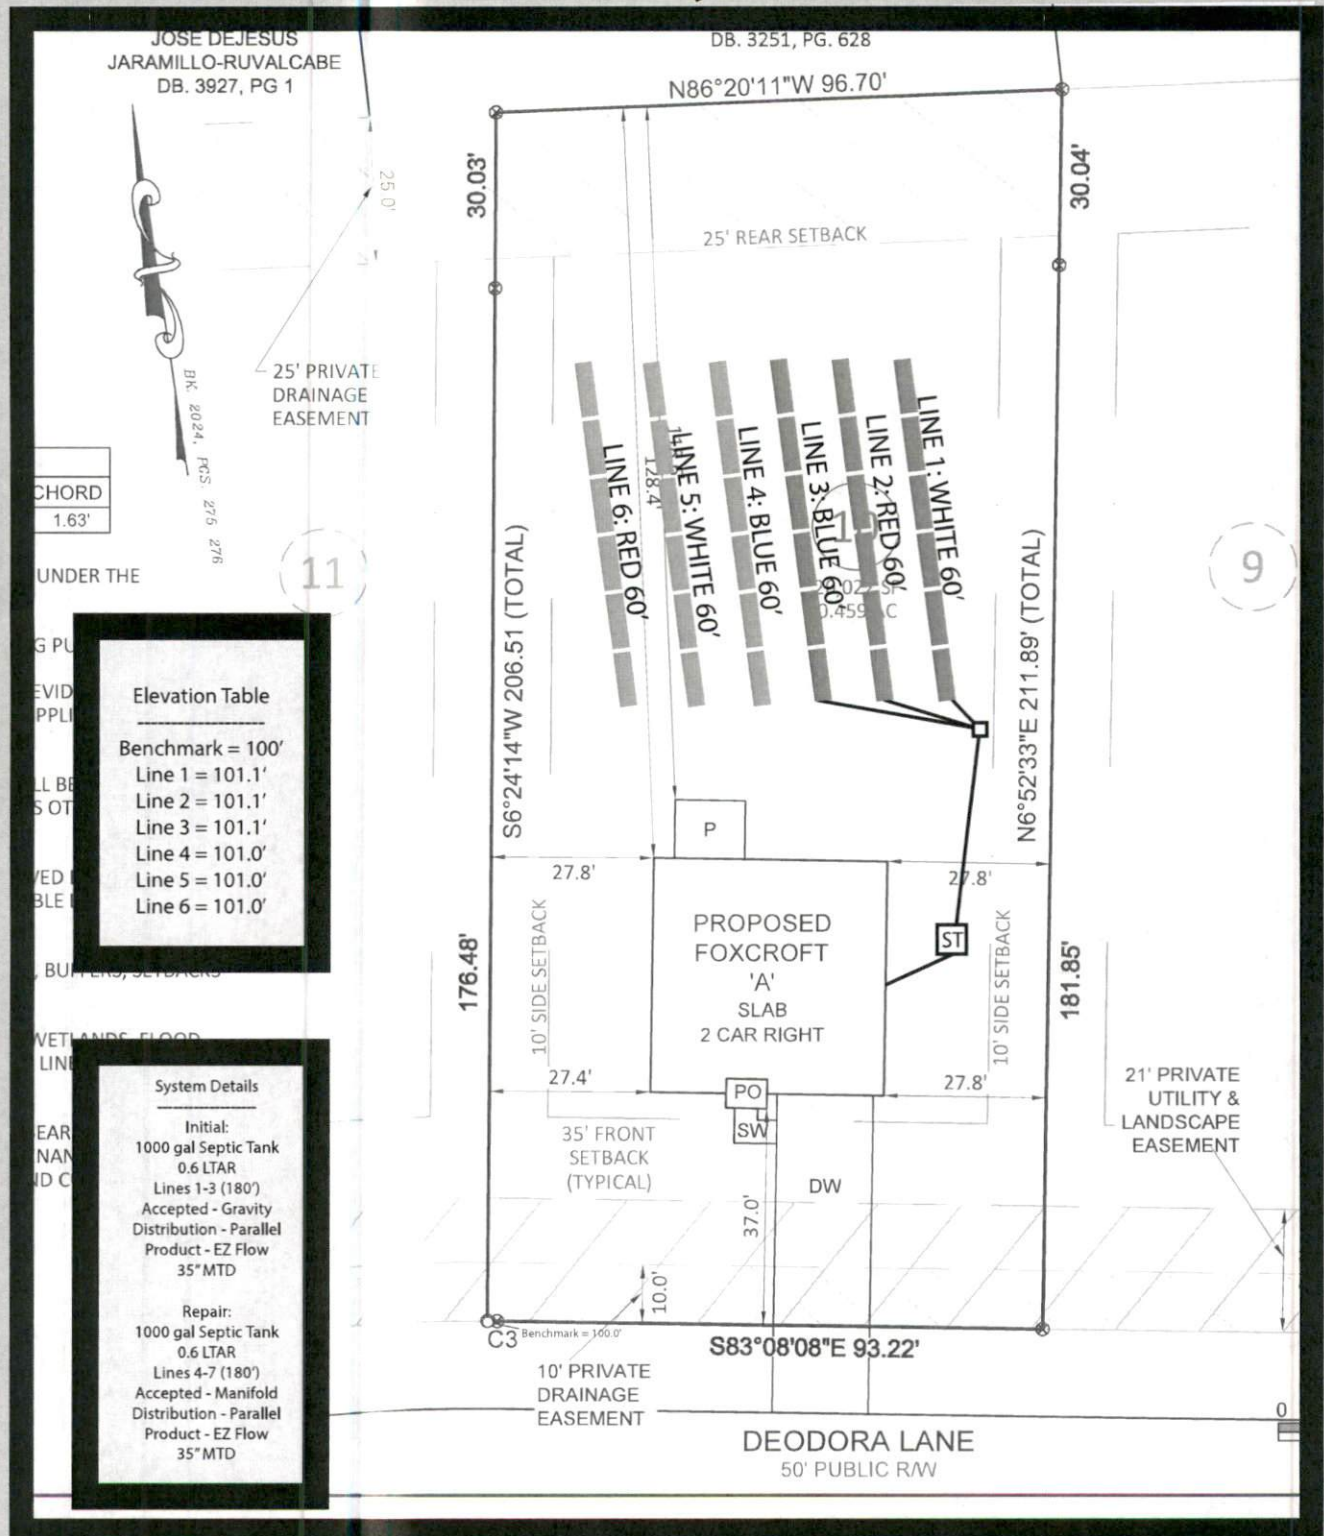

Legend

Initial

Repair

