


MUNGO HOMES

SCALE 1"=50'

LINE TABLE		
LINE	BEARING	DISTANCE
L-1	S 10°36'23" W	65.00'
L-2	N 78°07'59" E	50.00'

REVISION ON MAY 15, 2025 WAS
TO ADD DECK TO THE FOUNDATION.

CAMBRIDGE
RESERVE PH.1
P.B. 2025, PG. 7

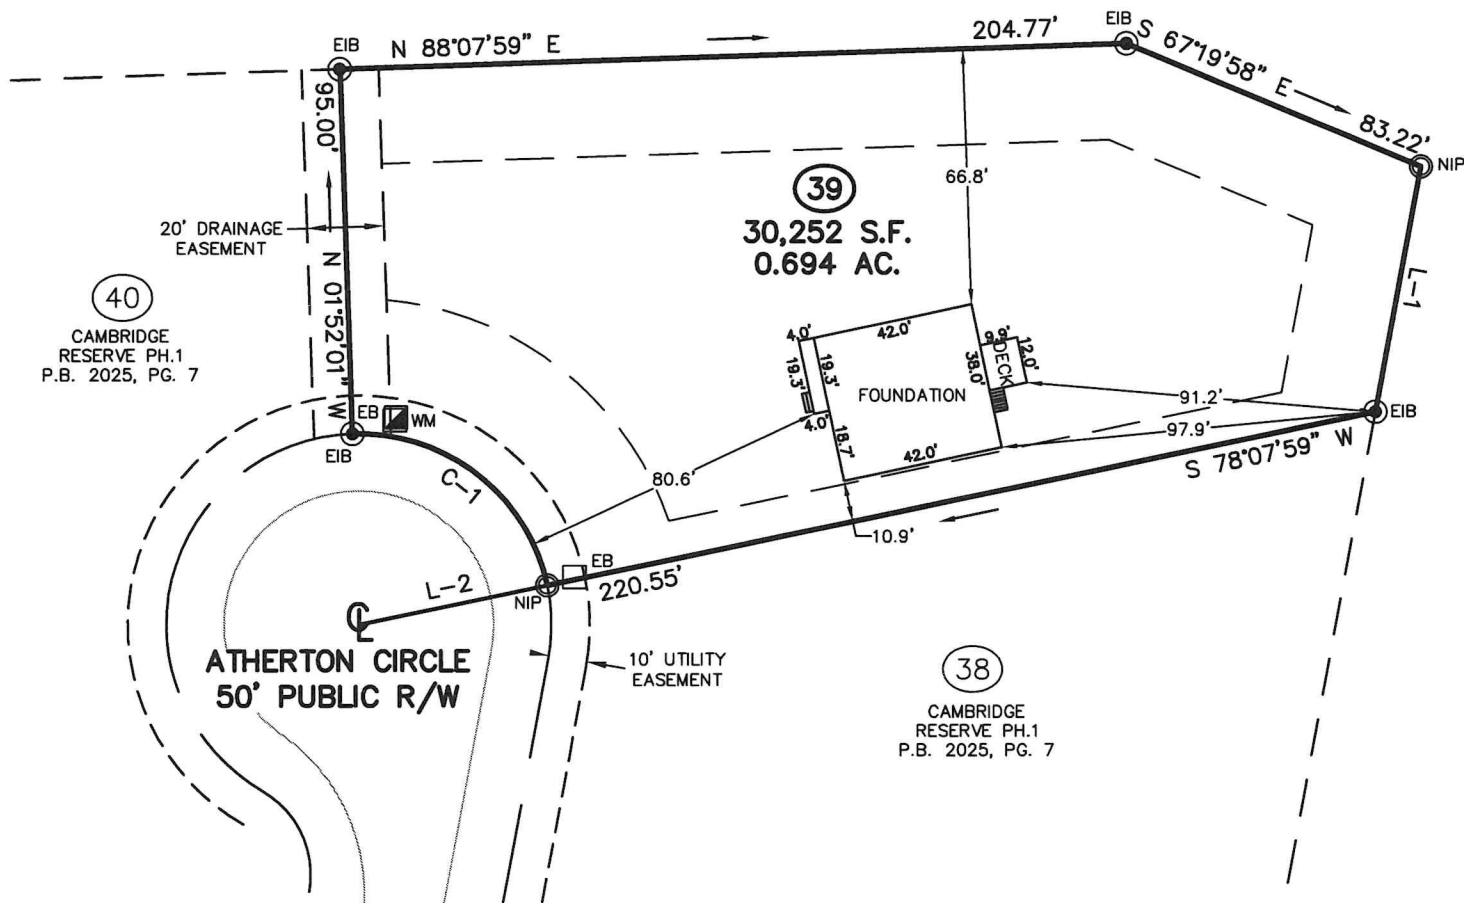

CURVE TABLE				
CURVE	ARC LENGTH	RADIUS	CHORD LENGTH	CHORD BEARING
C-1	69.81'	50.00'	64.28'	N 51°52'01" W



CMP

333 S. White Street
Post Office Box 1253
Wake Forest, N.C. 27588
(919)556-3148

I DECLARE THAT THIS SURVEY COMPLIES WITH THE NORTH CAROLINA STANDARDS OF PRACTICE FOR SURVEYING, (SECTION 1600) FOR CLASS A SURVEYS AND THAT THE CALCULATED RATIO OF PRECISION BEFORE ADJUSTMENTS IS 1:10,000+. FURTHERMORE, PROPERTY CORNERS SHOWN ARE PRIMARY CONTROL MONUMENTATION FOR THE RE-ESTABLISHMENT OF PROPERTY CORNERS IN THE ABSENCE OF GRID MONUMENTS AND OTHER SUBDIVISION PROPERTY CORNERS. THIS SURVEY IS NOT TO BE RECORDED WITHOUT THE WRITTEN AUTHORIZATION OF THE SURVEYOR.

PROFESSIONAL LAND SURVEYOR L-3835

