

Harnett County Department of Public Health

PERMIT # SFD 2501-0121

Operation Permit

☒ New Installation ☒ Septic Tank ☒ Nitrification Line ☐ Repair ☐ Expansion

PROPERTY LOCATION: 91 Priming Way, Angier

Name: (owner) David son Homes

SUBDIVISION Tobacco

LOT # 75

System Installer: Genes Beckhoe

Basement with plumbing: ☐ Garage ☒ Number of Bedrooms 3


Type of Water Supply: ☐ Community ☒ Public ☐ Well Distance from well _____ feet

System Type: 25% Reduction Type III(b) 62-Flow Types V and VI Systems expire in 5 years.

(In accordance with Table V a) man: 601d

Owner must contact Health Department 6 months prior to expiration for permit renewal.

This system has been installed in compliance with applicable North Carolina General Statutes, Rules for Sewage Treatment and Disposal, and all conditions of the Improvement Permit and Construction Authorization.

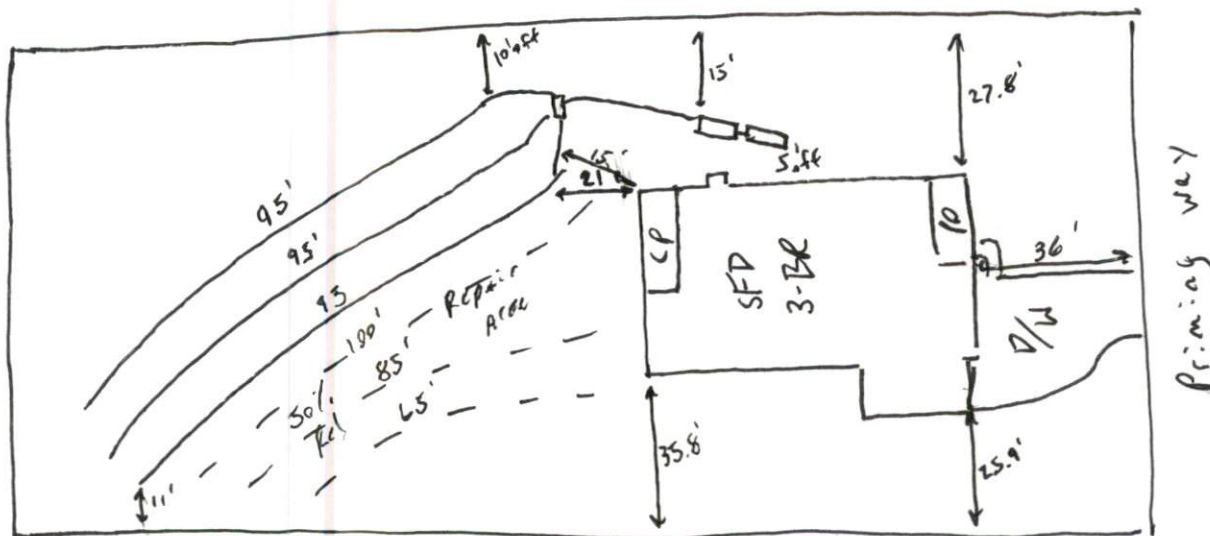

~~* Needs pump + Alarm For Final~~

~~* Needs LSS Revision~~

PERMIT CONDITIONS:

I. Performance: System shall perform in accordance with Rule .1961.

II. Monitoring: As required by Rule .1961.

III. Maintenance: As required by Rule .1961. Other: _____

Subsurface system operator required? Yes ☐ No ☐

If yes, see attached sheet for additional operation conditions, maintenance and reporting.

IV. Operation: _____

V. Other: _____

☐ D-Box ☐ Pump ☐ Alarm ☐ H20Line ☐ PWR Line

Following are the specifications for the sewage disposal system on the above captioned property.

Type of system: ☐ Conventional ☒ Other Type III(b) 62-Flow Septic Tank: 1,000 gallons Pump Tank: 1,000 gallons

Subsurface No. of 3 exact length 95' width of 3' depth of 20''
Drainage Field ditches of each ditch feet ditches feet ditches inches


French Drain Required: _____ Linear feet

Authorized State Agent REHS


Date 7-8-25

Tobacco Road
Lot 75
3 BR
Harnett County

*As Built Revision - Approved by Alex Adams

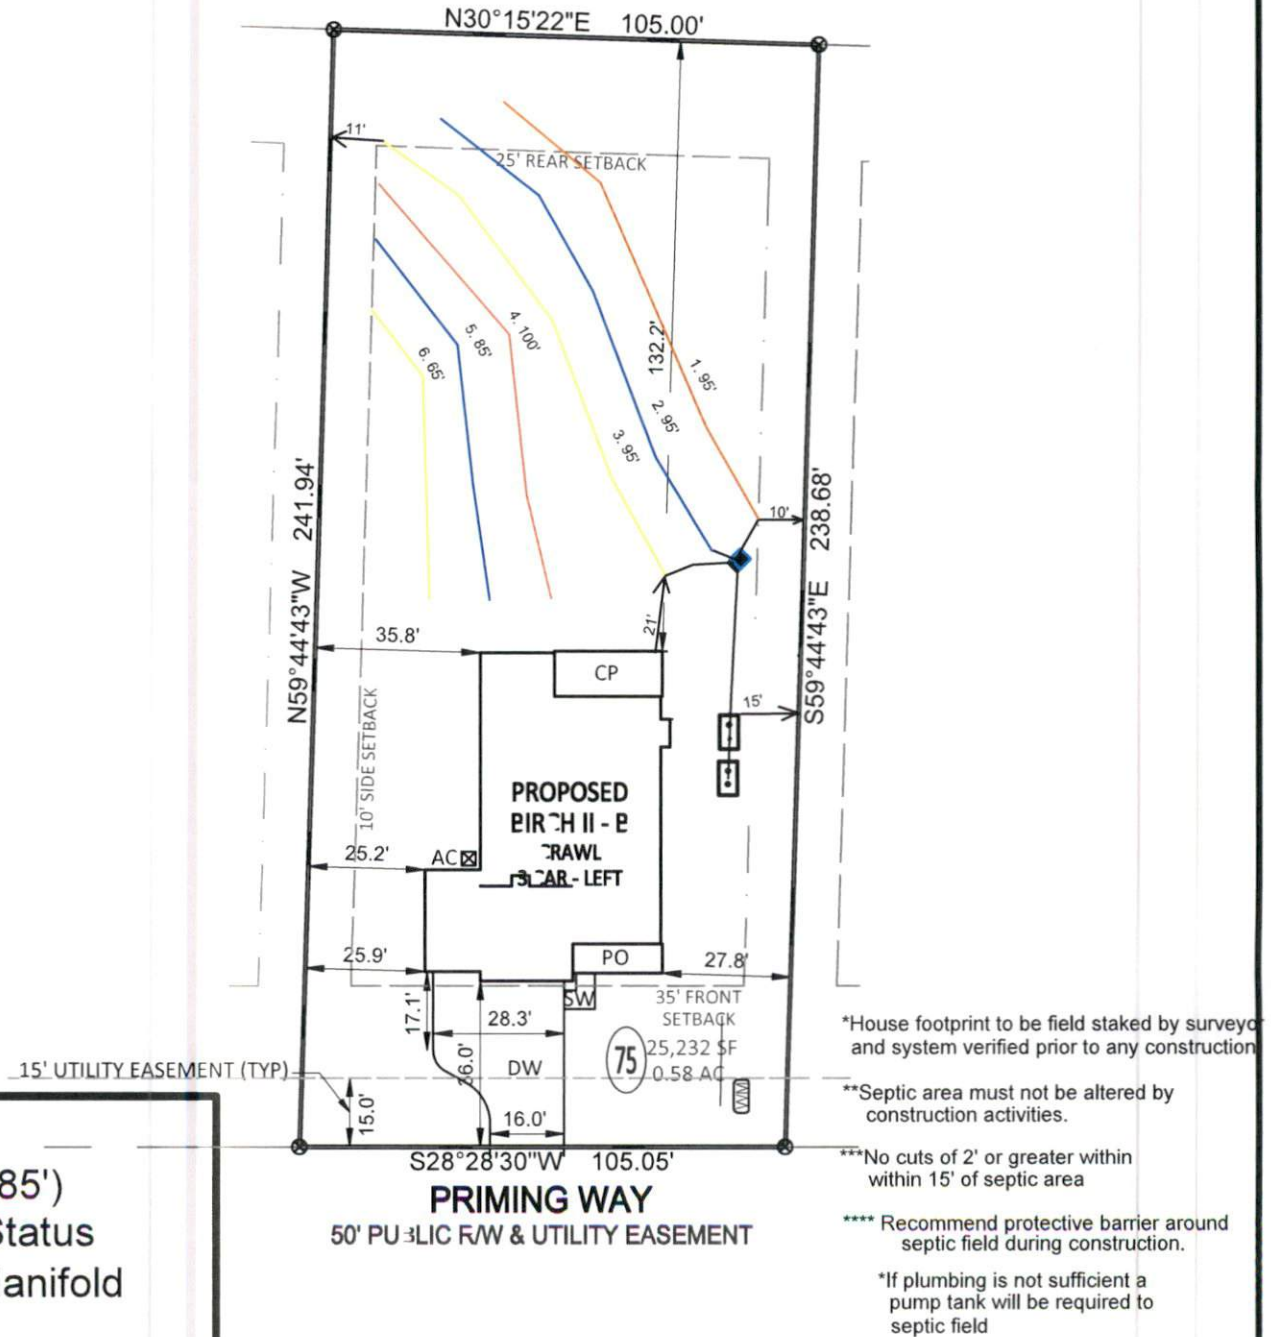

INITIAL:
Lines 1-3 285')
Accepted Status
Pressure Manifold
REPAIR:
Lines 4-6 (255')
PPBPS
Pressure Manifold

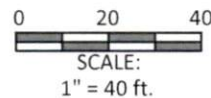

Adams
Soil Consulting
919-414-6761