

Harnett County Department of Public Health

PERMIT # SFD 2502-0001

Operation Permit

☒ New Installation ☒ Septic Tank ☒ Nitrification Line ☐ Repair ☐ Expansion

PROPERTY LOCATION: 230 Deadora Ln

Name: (owner) SDH Raleigh

SUBDIVISION Cedar Pointe

LOT # 11

System Installer: A+R

Basement with plumbing: ☐ Garage ☒ Number of Bedrooms 4 (8 people)


Type of Water Supply: ☐ Community ☒ Public ☐ Well Distance from well _____ feet

System Type: TYPE III Types V and VI Systems expire in 5 years.

(In accordance with Table V a)

Owner must contact Health Department 6 months prior to expiration for permit renewal.

This system has been installed in compliance with applicable North Carolina General Statutes, Rules for Sewage Treatment and Disposal, and all conditions of the Improvement Permit and Construction Authorization.

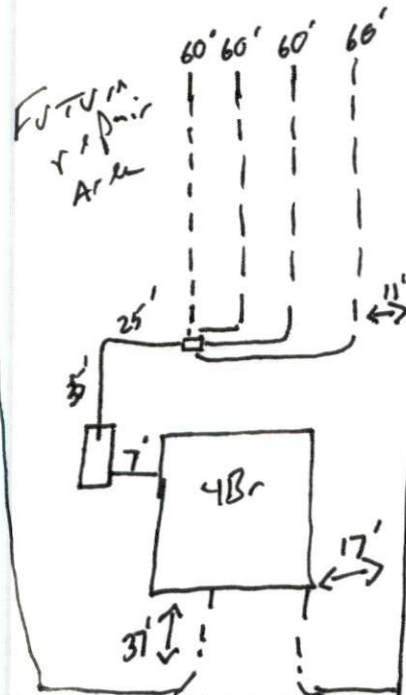

PERMIT CONDITIONS:

I. Performance: System shall perform in accordance with Rule .1961.

II. Monitoring: As required by Rule .1961.

III. Maintenance: As required by Rule .1961. Other: _____

Subsurface system operator required? Yes ☐ No ☐

If yes, see attached sheet for additional operation conditions, maintenance and reporting.

IV. Operation: _____

V. Other: _____

☐ D-Box ☐ Pump ☐ Alarm ☐ H2O Line ☐ PWR Line

Following are the specifications for the sewage disposal system on the above captioned property.

Type of system: ☐ Conventional ☒ Other 25% reduction E2Flow Septic Tank: _____ gallons Pump Tank: _____ gallons


Subsurface No. of exact length width of depth of
Drainage Field ditches 4 of each ditch 60 feet ditches 3 feet ditches 35 inches

French Drain Required: _____ Linear feet

Authorized State Agent [Signature] REH

Date 4-22-25

Cedar Pointe Lot 11 "As Built"

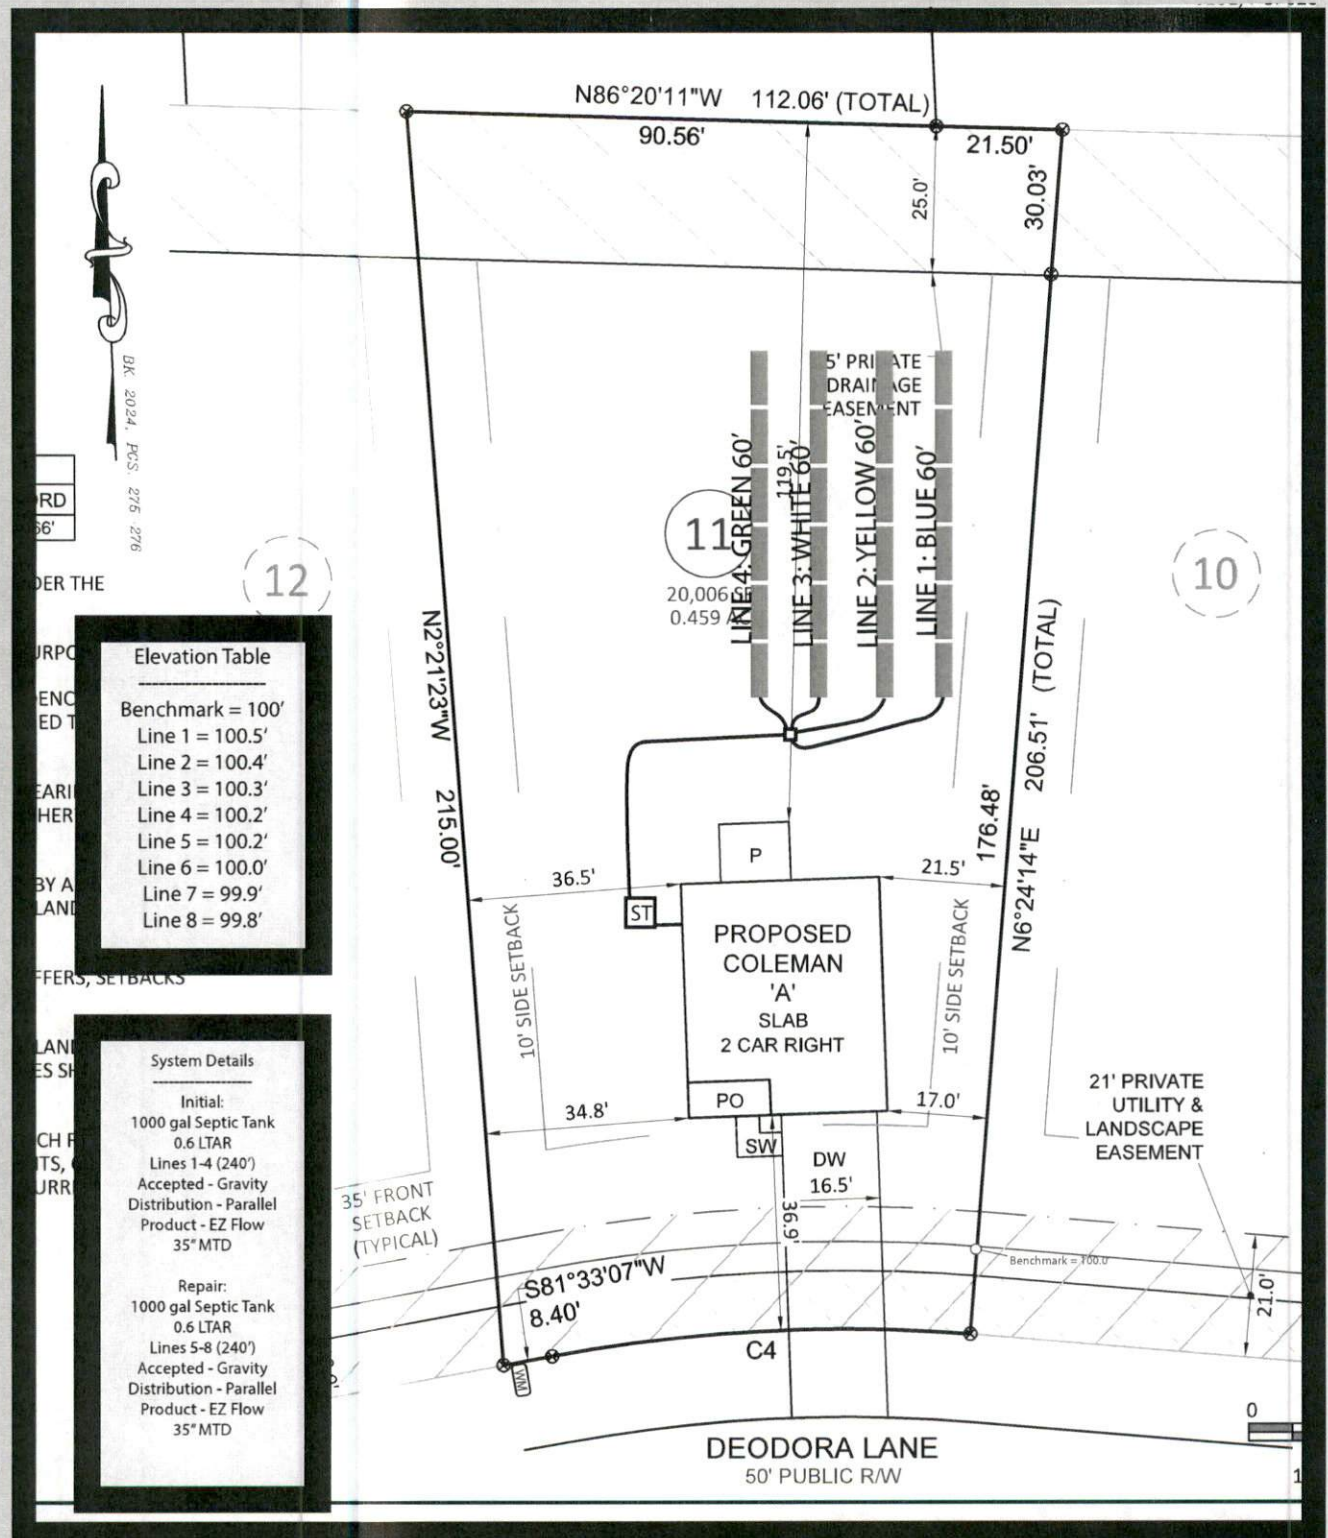

0' 30'
1 inch = 30'



Legend

Initial
Repair

