


AS-BUILT IMPROVEMENTS FOR
MATTAMY HOMES

75 STUART GROVE ROAD
LOT 9, FOX FIELD FARM
UPPER LITTLE RIVER TOWNSHIP, HARNETT COUNTY, NORTH CAROLINA

NUM	RADIUS	ARC	DELTA	CHORD BRG	CHORD
C1	255.00'	100.65'	22'36"56"	N 57°14'25" W	100.00'

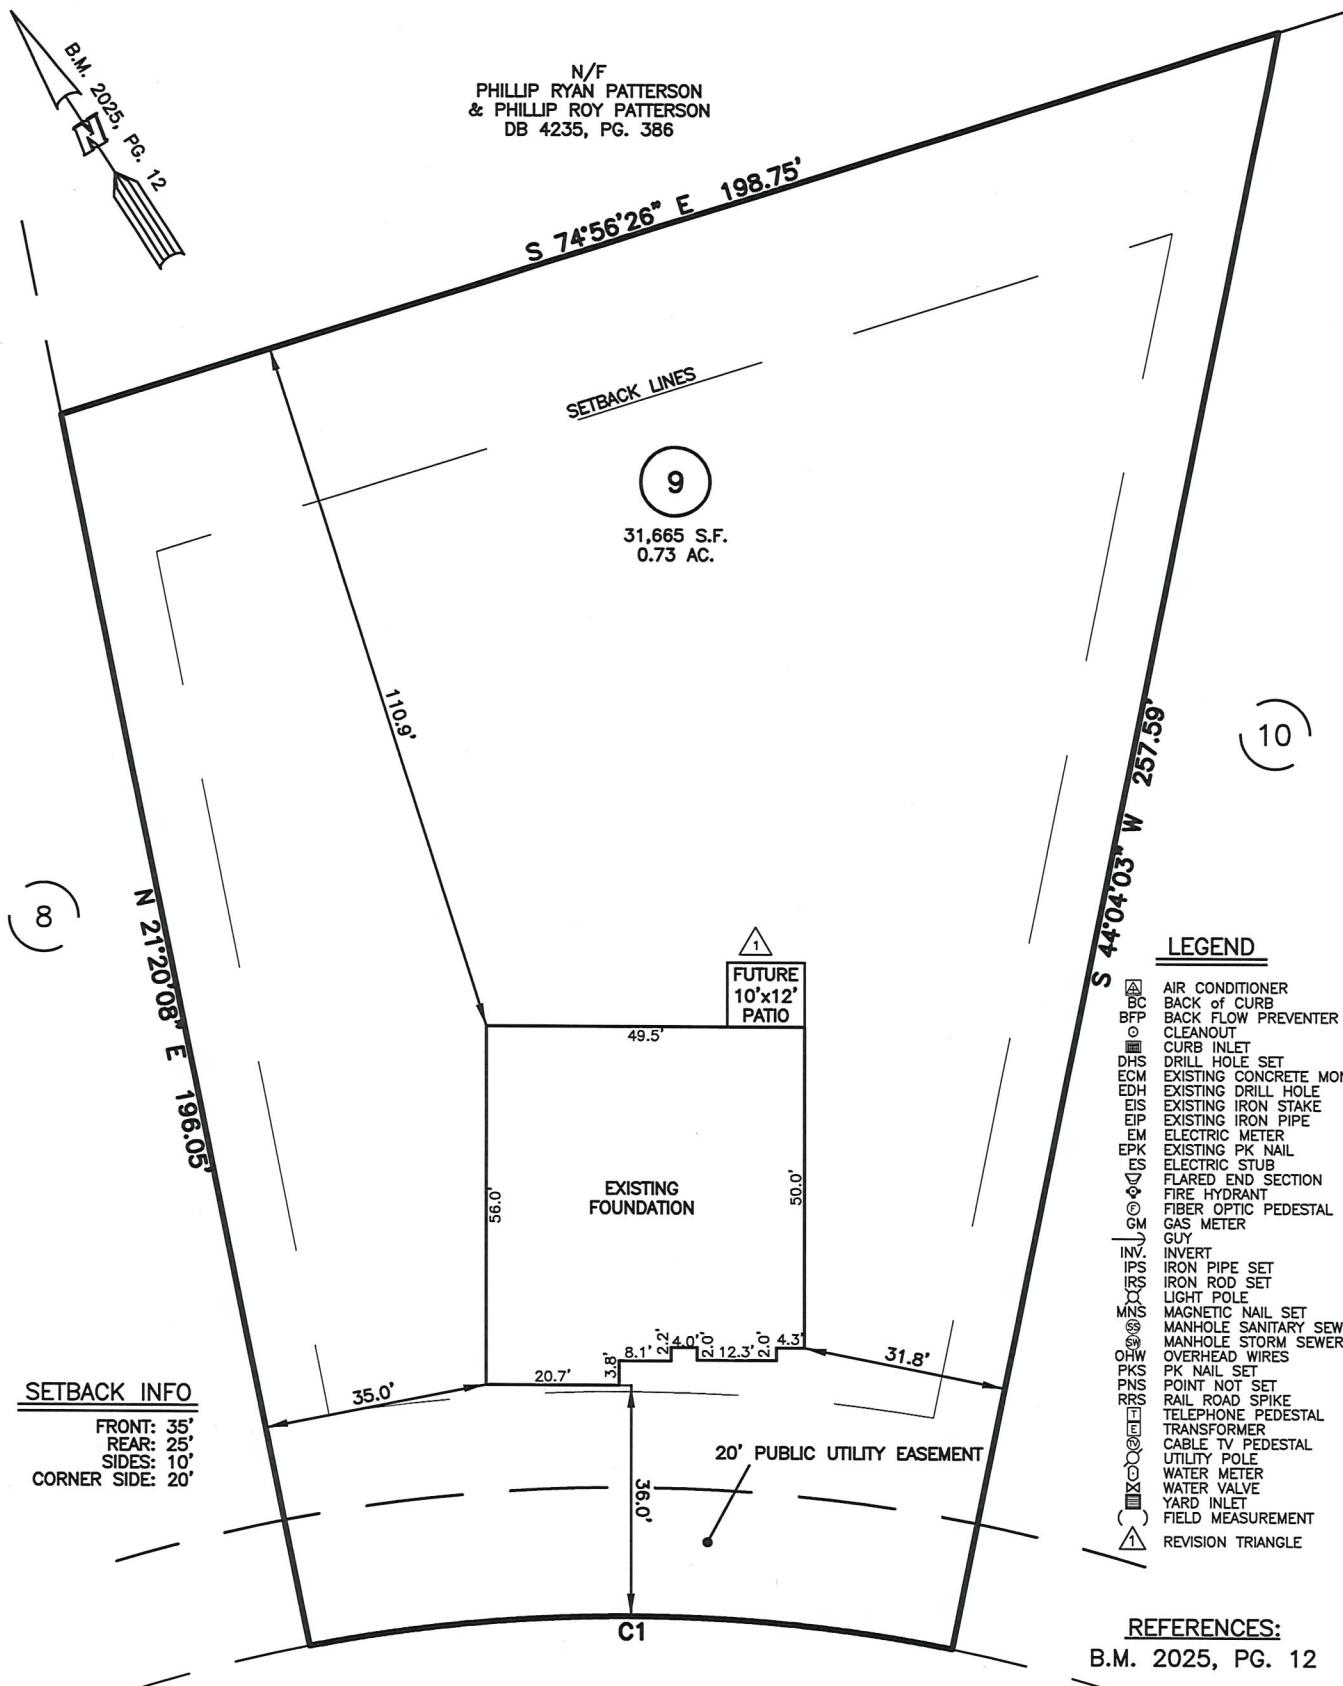

WAKE COUNTY, NORTH CAROLINA

I CERTIFY THAT THIS MAP WAS DRAWN UNDER MY SUPERVISION FROM FIELDWORK DONE UNDER MY SUPERVISION; THAT THE IMPROVEMENTS LIE FULLY UPON THE LOT UNLESS OTHERWISE SHOWN AND THAT THE PROPERTY SHOWN IS AN EXISTING PARCEL OR PARCELS OF LAND.

Charles R. Piratzky
CHARLES R. PIRATZKY, P.S.
L-2813 DATE 11-7-25
CHARLES R. PIRATZKY
LAND SURVEYOR
SEAL

THIS AS-BUILT IS
FOR CODE COMPLIANCE.
NOT FOR SALES OR
CONVEYANCE

REV1: NOV. 07, 2025
DATE: NOV. 04, 2025

RWK, PA
ENGINEERING ~ SURVEYING
CORPORATE LICENSE: C-1771
101 W. MAIN ST., SUITE 202
GARNER, NC 27529
PHONE (919) 779-4854
FAX (919) 779-4056
O:\FieldLoc\ffff 6 & 9.fdn.txt