
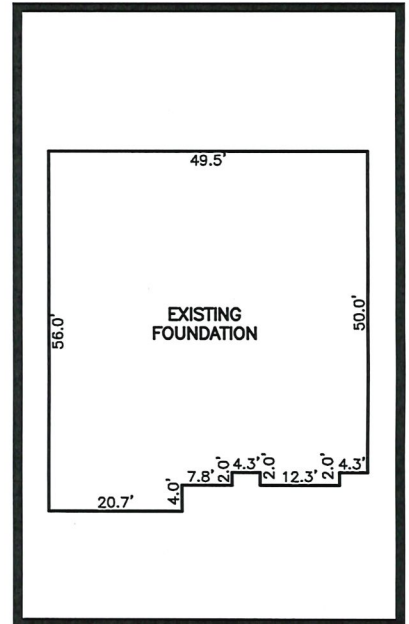


AS-BUILT IMPROVEMENTS FOR
MATTAMY HOMES
144 THOMAS STORE DRIVE
LOT 58, FOX FIELD FARM
UPPER LITTLE RIVER TOWNSHIP, HARNETT COUNTY, NORTH CAROLINA

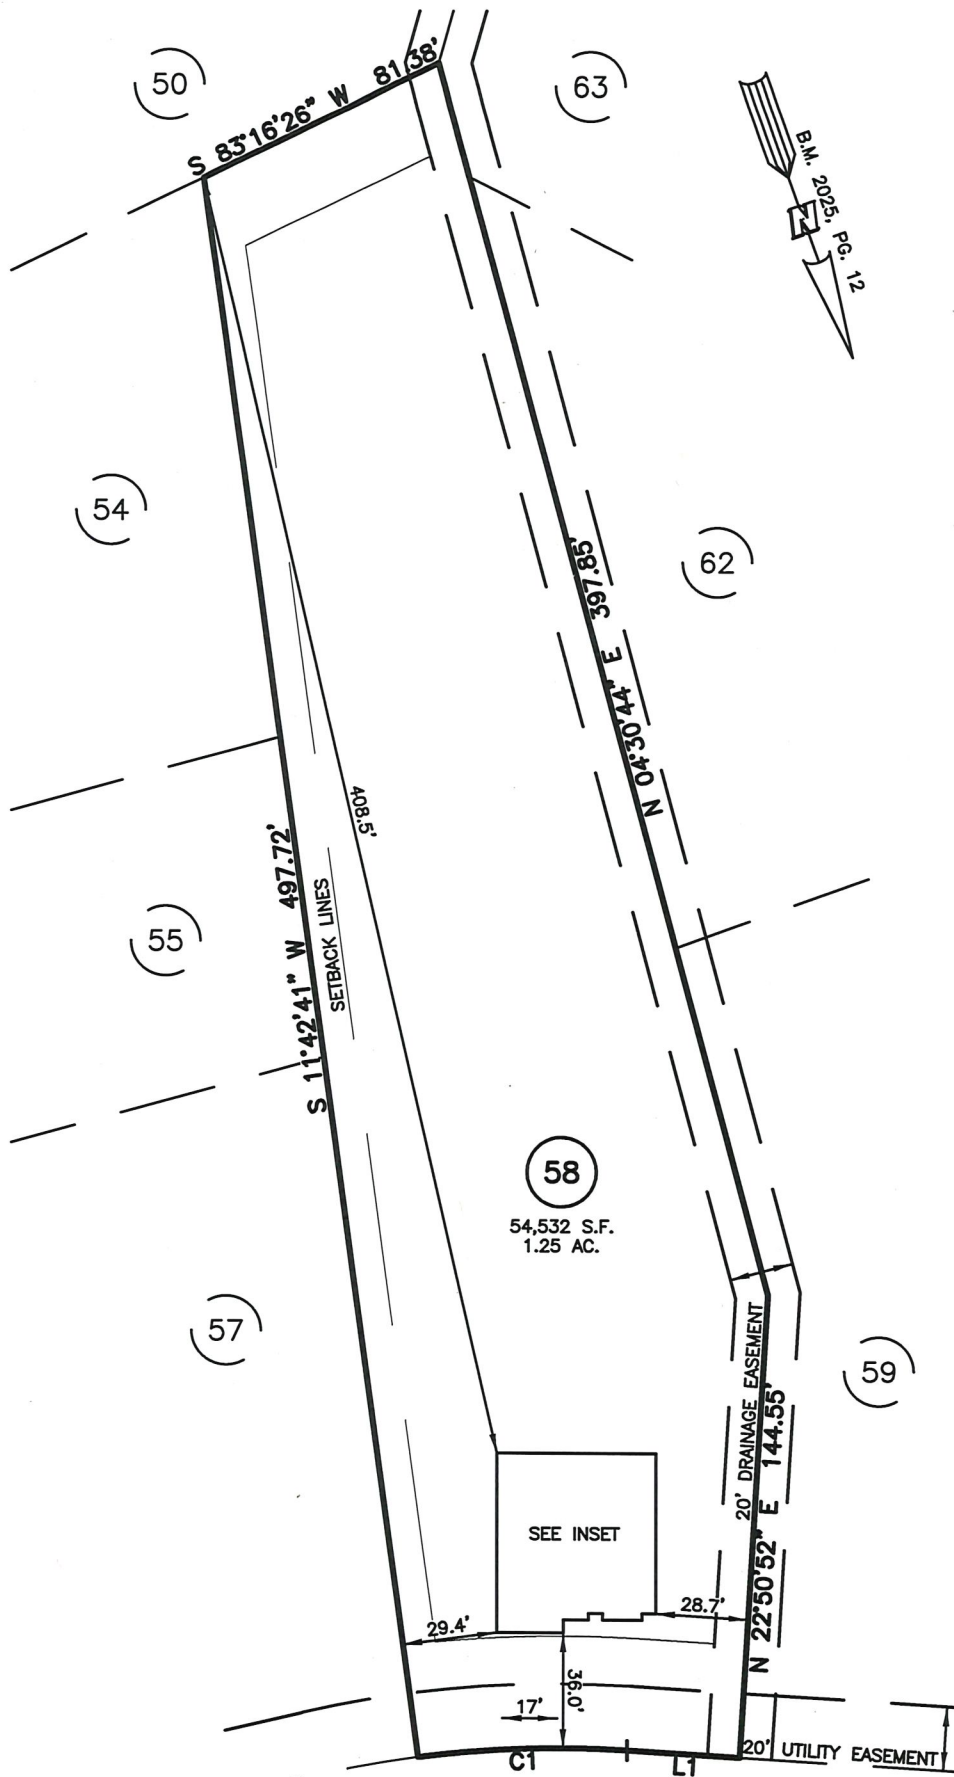

INSET SCALE: 1"=30"

LEGEND

- AIR CONDITIONER
- BC BACK OF CURB
- BFP BACK FLOW PREVENTER
- CLEANOUT
- CURB INLET
- DHS DRILL HOLE SET
- ECM EXISTING CONCRETE MONUMENT
- EDH EXISTING DRILL HOLE
- EIS EXISTING IRON STAKE
- EIP EXISTING IRON PIPE
- EM ELECTRIC METER
- EPK EXISTING PK NAIL
- ES ELECTRIC STUB
- FLARED END SECTION
- FIRE HYDRANT
- FIBER OPTIC PEDESTAL
- GAS METER
- GUY
- INV. INVERT
- IPS IRON PIPE SET
- IRS IRON ROD SET
- LIGHT POLE
- MNS MAGNETIC NAIL SET
- MANHOLE SANITARY SEWER
- MANHOLE STORM SEWER
- OVERHEAD WIRES
- PKS PK NAIL SET
- PNS POINT NOT SET
- RRS RAIL ROAD SPIKE
- TELEPHONE PEDESTAL
- TRANSFORMER
- CABLE TV PEDESTAL
- UTILITY POLE
- WATER METER
- WATER VALVE
- YARD INLET
- FIELD MEASUREMENT
- REVISION TRIANGLE

THIS AS-BUILT IS
FOR CODE COMPLIANCE.
NOT FOR SALES OR
CONVEYANCE

SETBACK INFO

FRONT: 35'
REAR: 25'
SIDES: 10'
CORNER SIDE: 20'

REFERENCES:

B.M. 2025, PG. 12

LINE	BEARING	DISTANCE
L1	S 67°09'08" E	35.10'

NUM	RADIUS	ARC	DELTA	CHORD BRG	CHORD
C1	335.00'	65.11'	11°08'11"	S 72°43'13" E	65.01'

WAKE COUNTY, NORTH CAROLINA

THOMAS STORE DRIVE
50' PUBLIC R/W

I CERTIFY THAT THIS MAP WAS DRAWN UNDER MY
SUPERVISION FROM FIELDWORK DONE UNDER
MY SUPERVISION; THAT THE IMPROVEMENTS LIE
FULLY UPON THE LOT UNLESS OTHERWISE SHOWN
AND THAT THE PROPERTY SHOWN IS AN EXISTING
PARCEL OR PARCELS OF LAND.

CHARLES R. PIRATZKY, P.E.
LAND SURVEYOR
5-8-25
DATE

DATE: MAY 5, 2025

Q:\FieldLoc\FFFM58\FDN.txt

RWK, PA
ENGINEERING ~ SURVEYING
CORPORATE LICENSE: C-1771
101 W. MAIN ST., SUITE 202
GARNER, NC 27529
PHONE (919) 779-4854
FAX (919) 779-4056

Q:\FOX FIELD FARM\FFFM58\FFFM58.DWG