




ADDRESS: 311 ALDEN WAY

PLAT BOOK 2024, PG'S 506-510

PIN #:0693-00-9995.000

AREA: 37,112 S.F. ~ 0.852 ACRES

Line	Distance	Bearing
L1	65.10'	N 26°33'54" E
L2	29.55'	S 55°07'46" E
L3	49.81'	S 83°25'46" E

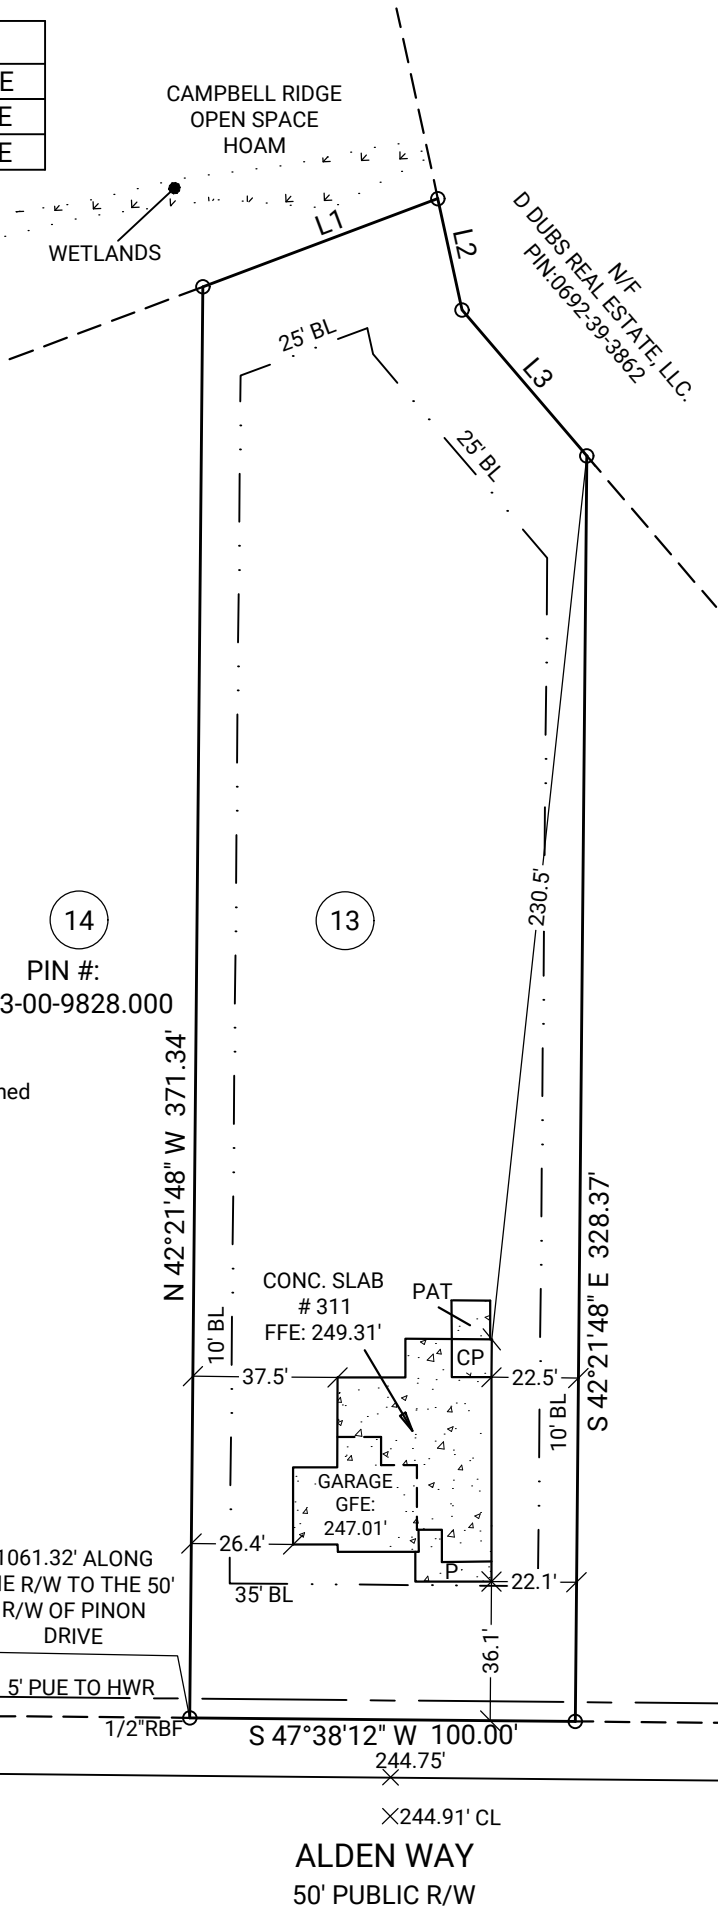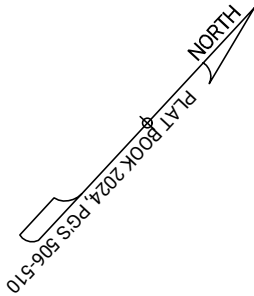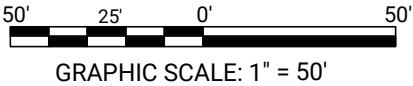

LEGEND:

- BL Building Line
- GFE Garage Floor Elevation
- FFE Finished Floor Elevation
- DE Drainage Easement
- PRDE Private Drainage Easement
- PUE Permanent Utility Easement
- SP Screen Porch
- PAE Public Access Easement
- HOAM Homeowner Association Maintained
- HRW Harnett Regional Water
- CB Catch Basin
- POR Porch
- DK Deck
- PAT Patio
- FH Fire Hydrant
- LP Light Pole
- WM Water Meter
- P Porch
- CP Covered Porch
- ST Septic Tank
- SP Screened Porch
- PROF Proposed
- CL Center Line
- PD Proposed Drive
- N/F Now or Formerly
- A/C Air Conditioning
- R/W Right of Way
- PIN Parcel Identification Number
- TBD To Be Determined
- (P) Platted
- (M) Measured
- NTS Not to Scale
- [P.999] Proposed Grade
- 999 Existing Grade
- [Hatched Box] Front Grassed Area

PIN #:
0693-00-9828.000

PIN #:
0693-11-1031.000

I, David J. Baggett, PLS certify that this plat was drawn under my direction or supervision on the property shown and the boundaries and improvements, if any, are shown hereon. Boundaries not surveyed are shown as broken lines from information found in the referenced book(s) and page(s). this plat meets the standards of practice for land surveying in North Carolina, Title 21, Chapter 56, Rule 1600 and the error of closure does not exceed one foot per 10,000+ feet of the perimeter, nor 20 seconds times the square root of the number of angles turned. Witness my original signature, registration number and seal, this 10th day of June, 2025 AD.

GENERAL NOTES: All matters of title are excepted. This Map or Plat is subject to any additional easements or restrictions of record. Contact utility contractor for location prior to construction (if applicable). This plat is for exclusive use by client. Use by third parties is at their own risk. Dimensions from house to property lines should not be used to establish fences. This plat has been calculated for closure and is found to be accurate within one foot in 10,000+ feet. The field data upon which this plat is based has a closure precision of one foot in 10,000+ feet and an angular error of 7 seconds per angle point and was adjusted using the compass rule. Equipment used: Leica TS13 Robotic Total Station.

BUILDING SETBACKS:

Front: 35'
Rear: 25'
Side: 10'
Corner: 20'

SUB: Campbell Ridge
LOT: 13
Angier, Harnett County, North Carolina

FOUNDATION LOCATION FOR:

DRB DAN RYAN HOMES

PLAT DATE: 06/10/2025
FIELD WORK DATE: 06/08/2025
20250508603 DRB_RAL FC: JH



C+C BUILDING SOLUTIONS
A NORTH CAROLINA SUBSIDIARY OF CARTER + CLARK

Corporate Headquarters:
1735 North Brown Road, Suite 400
Lawrenceville, GA 30043
866.637.1048
FIRM LICENSE: F-1461

