

[illegible]

[illegible]

FIELD & REDLINE NOTES

PRIMARY BATH VANITY/DRAWER OPTION

HALL BATH DOUBLE SINK OPTION

PRIMARY BATH OPTION #1

PRIMARY BATH OPTION #2

GOURMET KITCHEN OPTION


*See page 10 for fireplace and extended breakfast nook

2 SECOND FLOOR PLAN
1/4" = 1'-0" (NO BONUS ROOM)





1 FIRST FLOOR PLAN
1/4" = 1'-0"

F:\Caviness and Cates\CC 2136\Design Center\CC 2136 GL 24 COMPLETE SET 10-4-22.dwg, 1/25/2023 8:08:05 AM, 1:1


FIELD & REDLINE NOTES

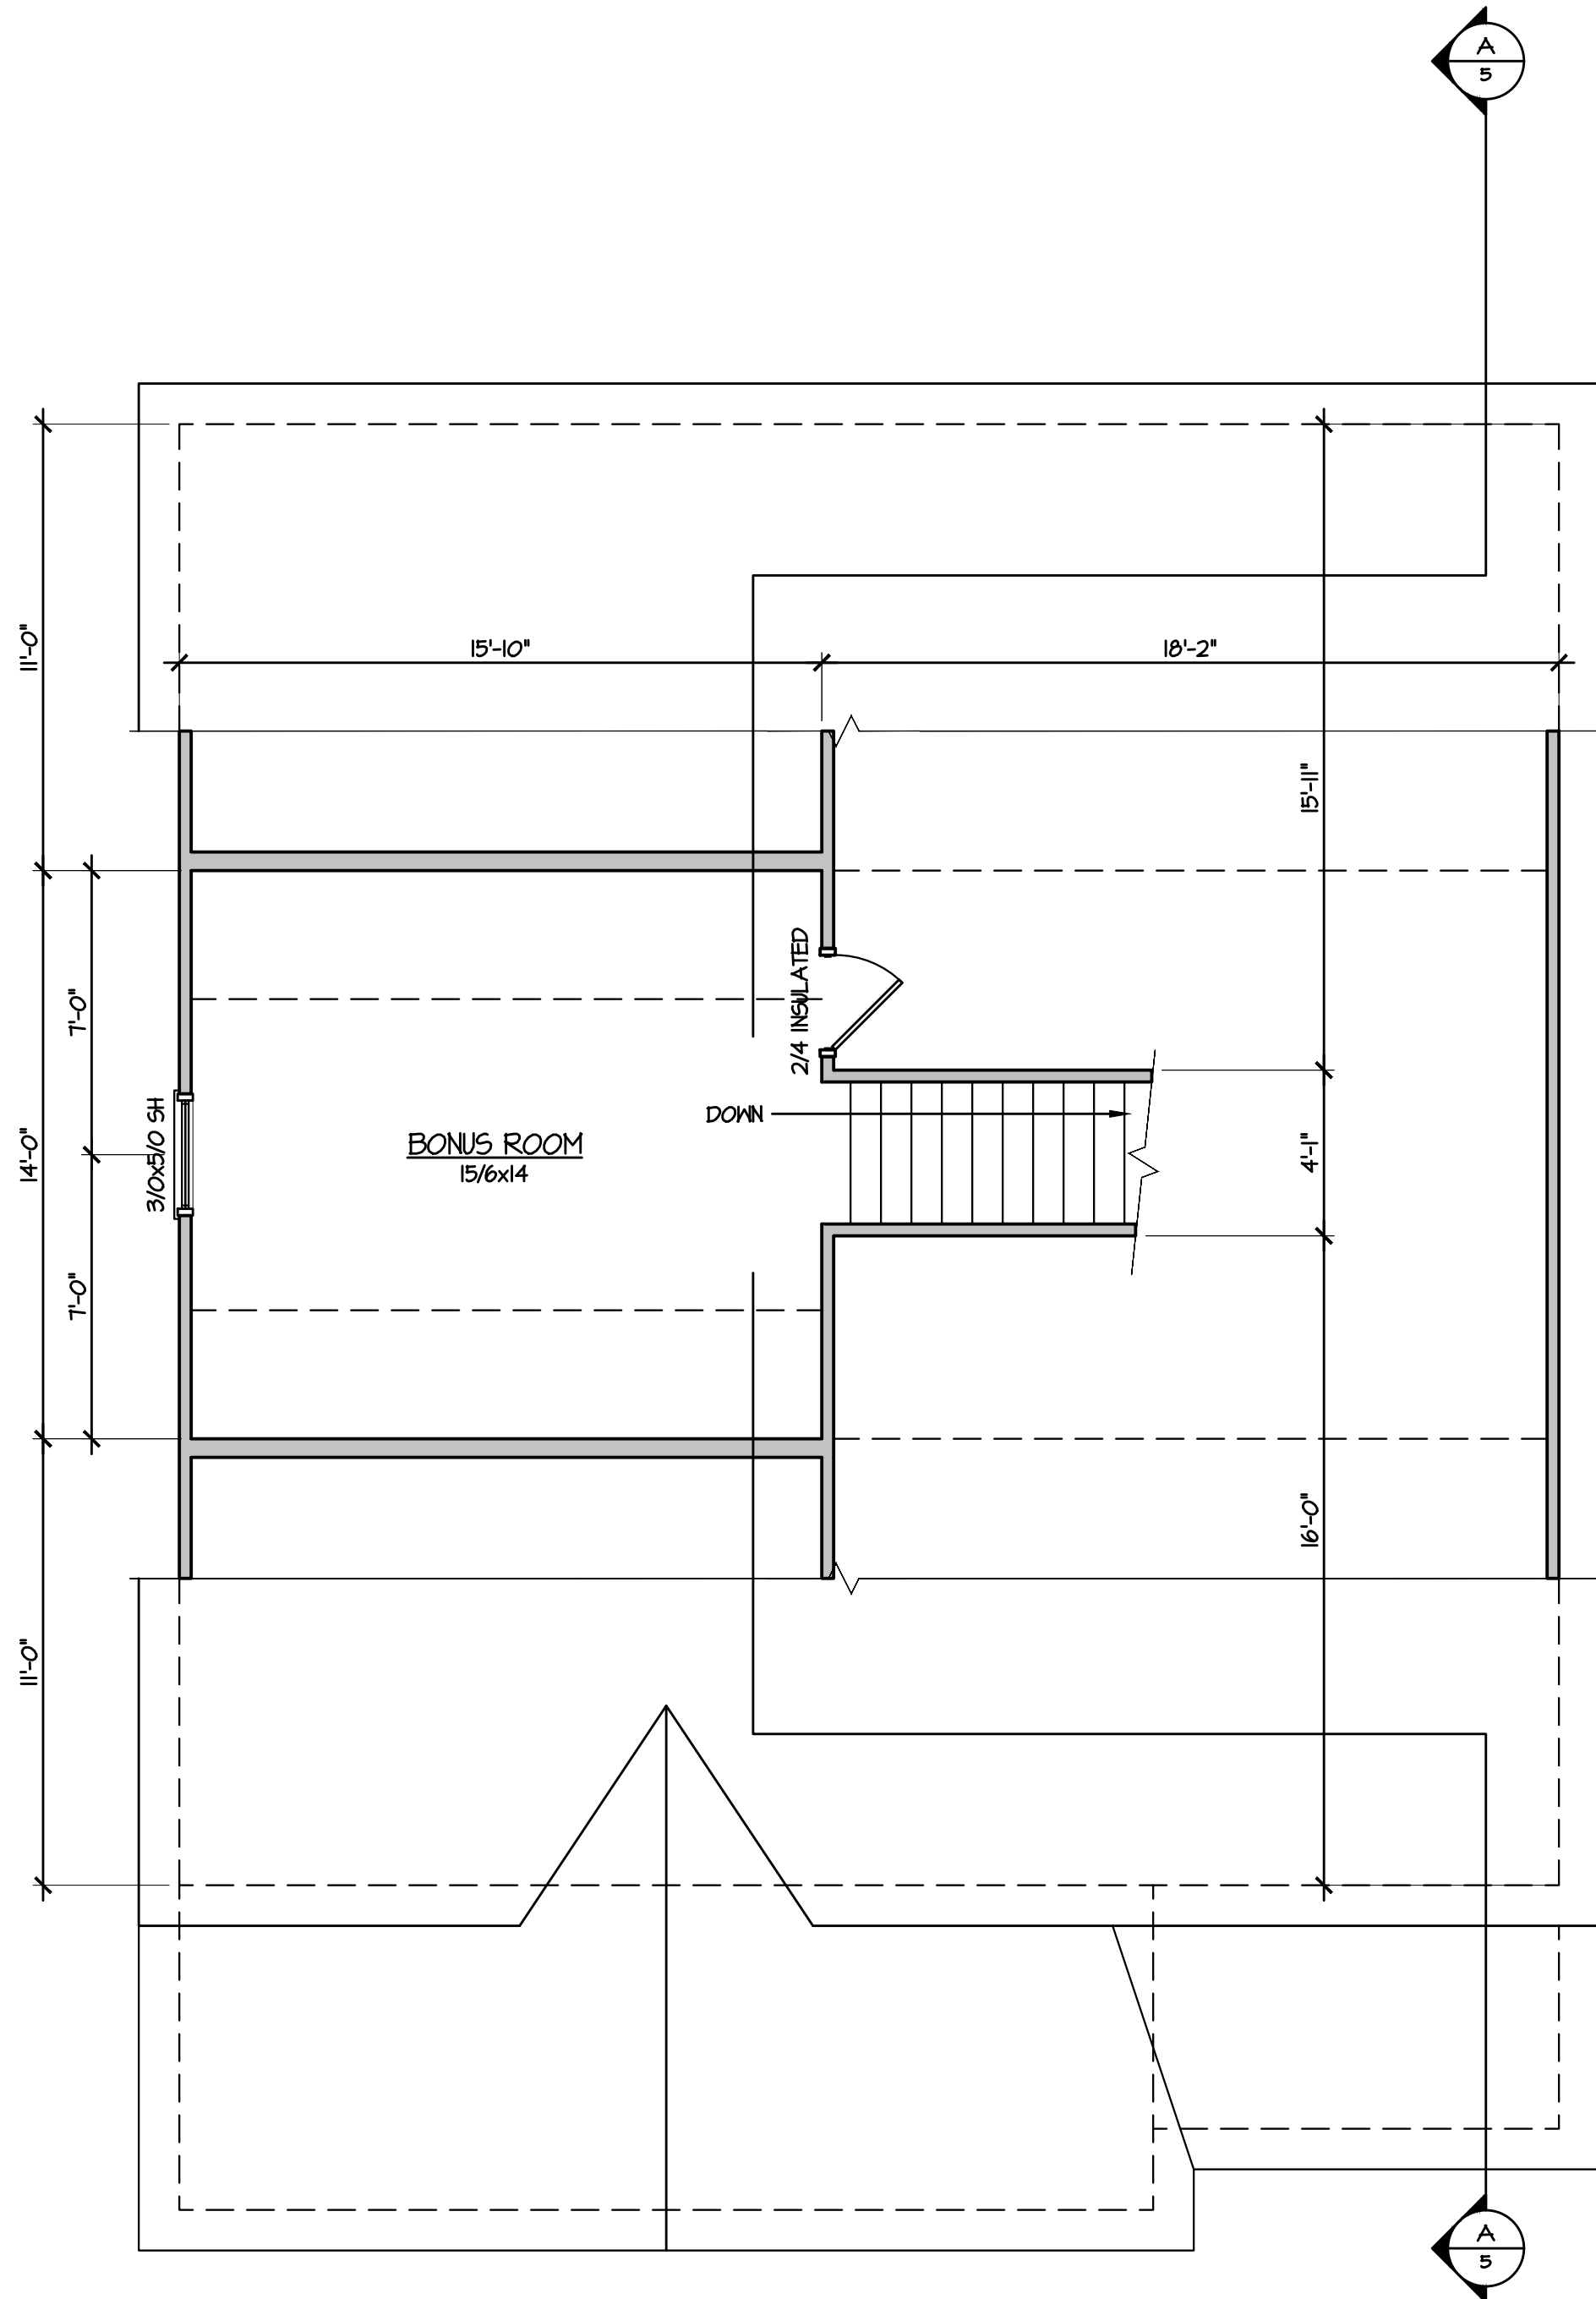

2 OPTIONAL BONUS ROOM
1/4" = 1'-0" **YES**

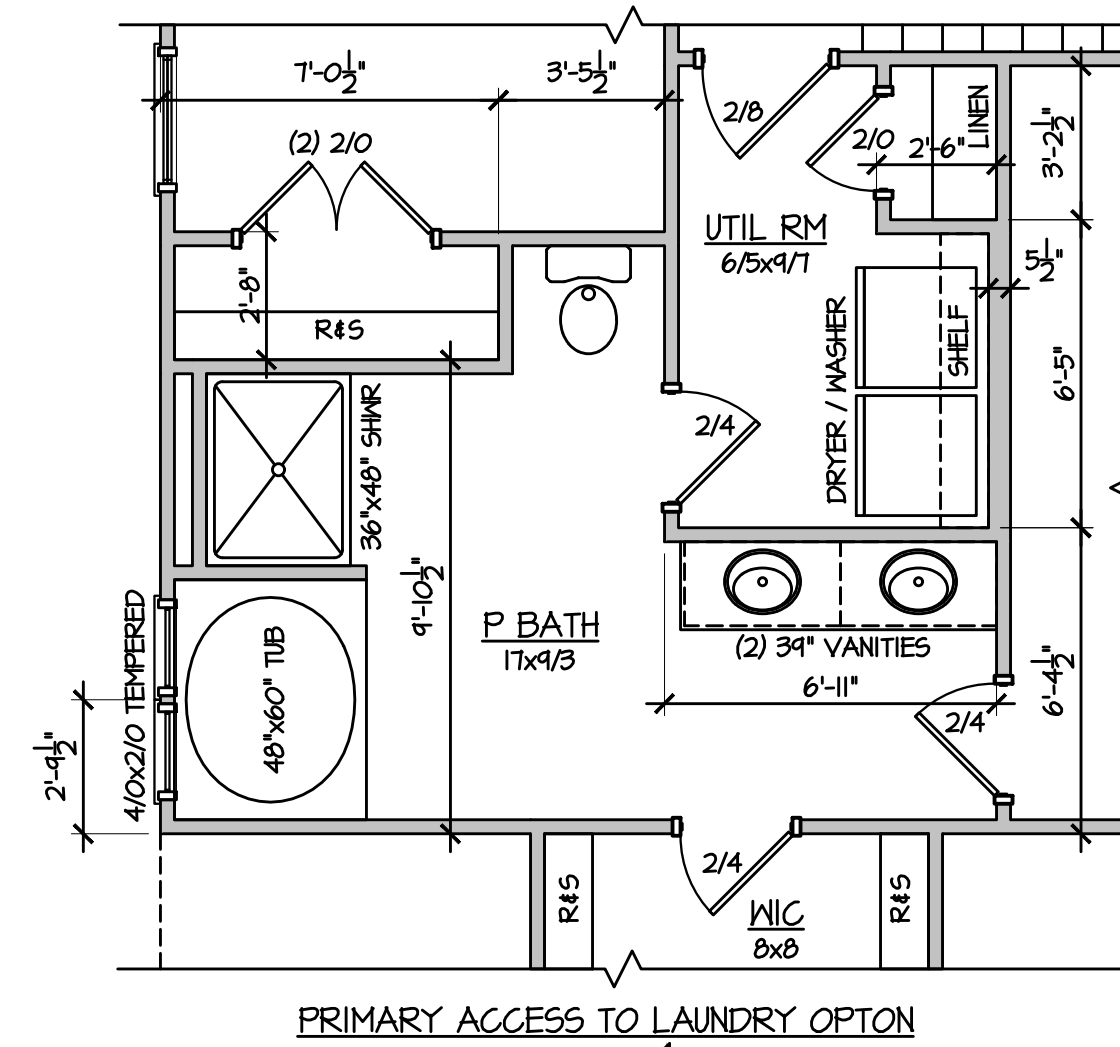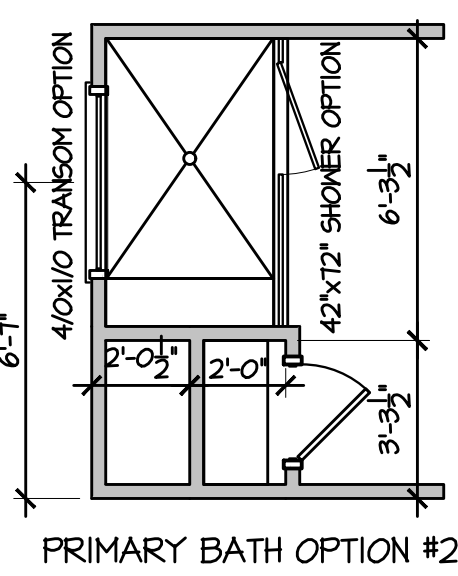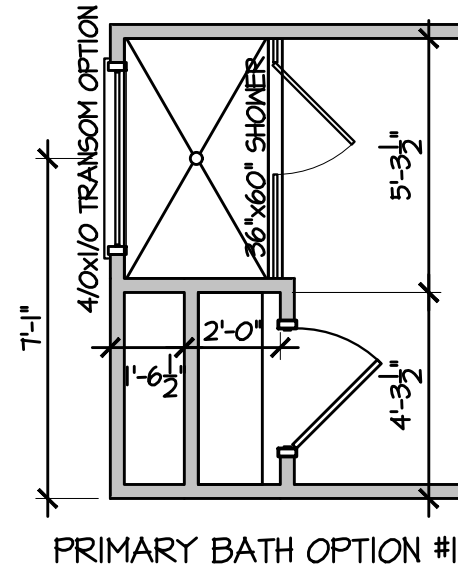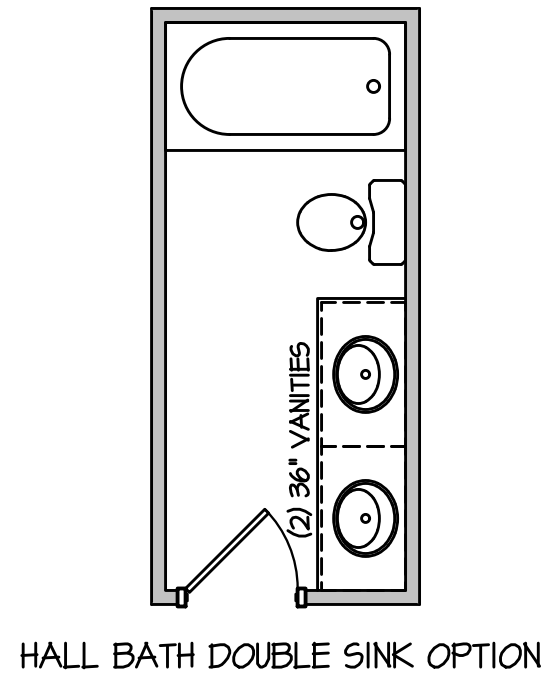

PRIMARY ACCESS TO LAUNDRY OPTION

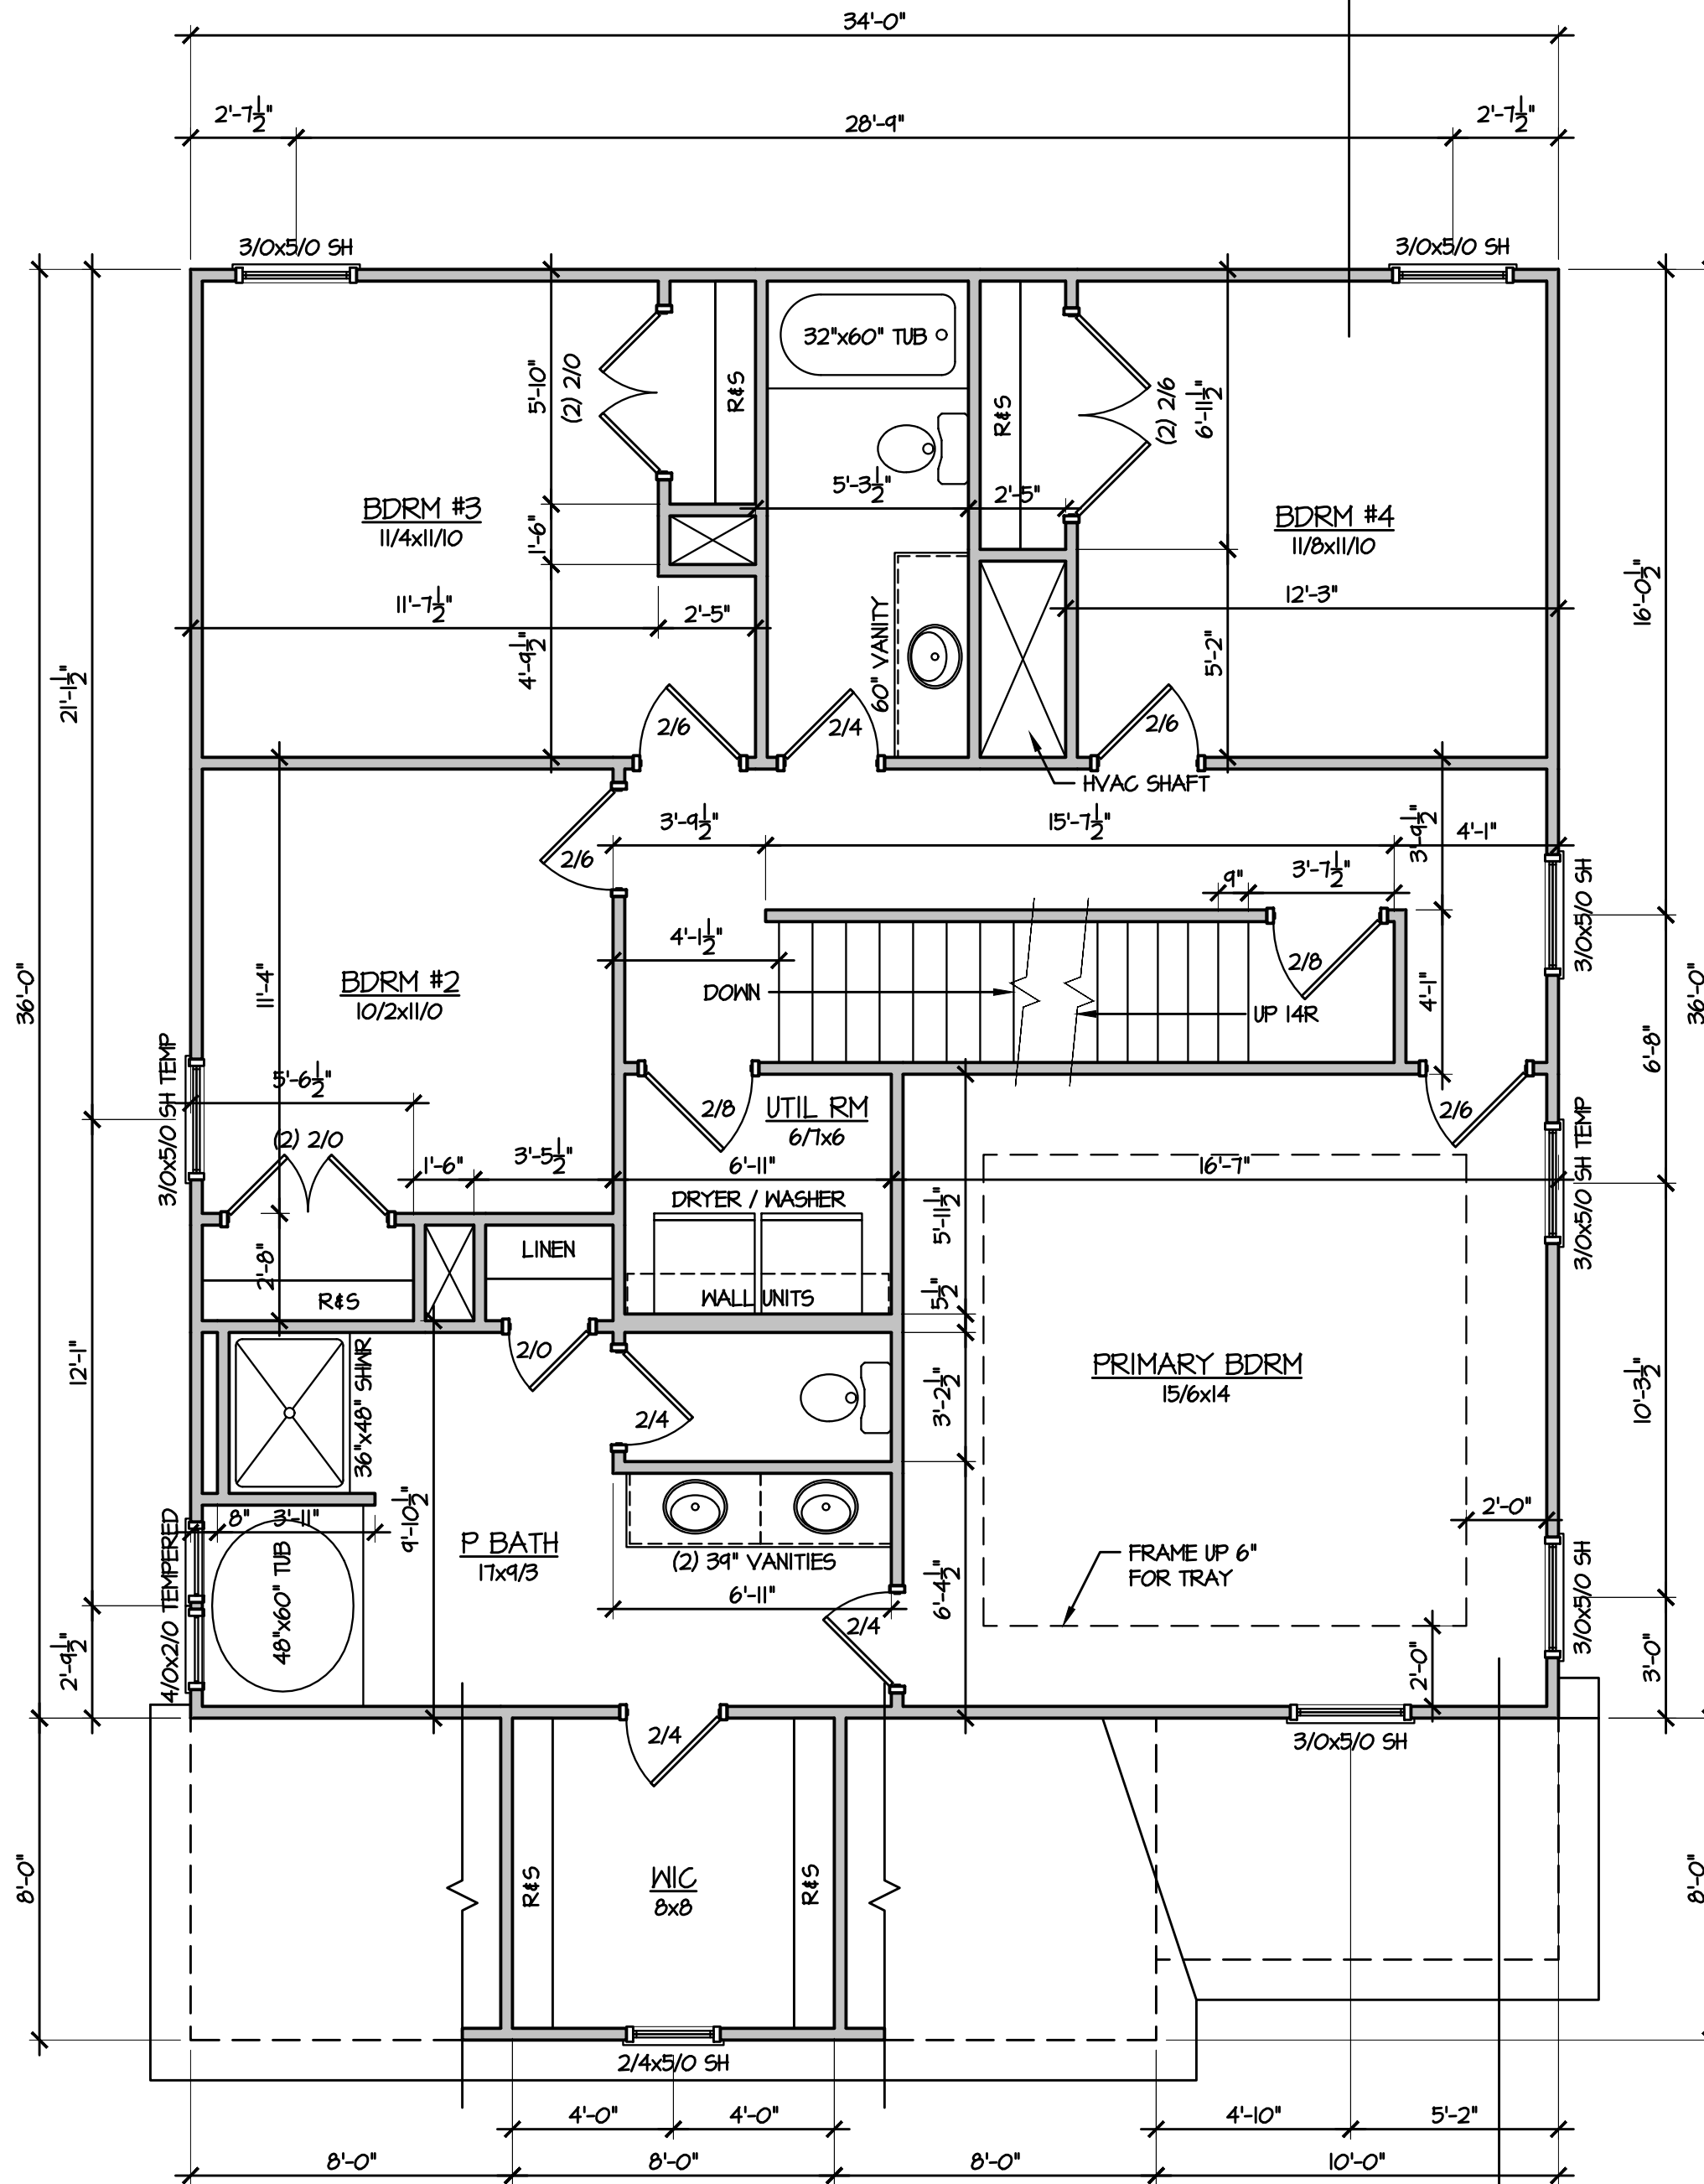

1 SECOND FLOOR PLAN
1/4" = 1'-0" (WITH BONUS ROOM OPTION)



© 2019 Caviness & Cates

639 Executive Place
Suite 400
Fayetteville, NC 28305
Office: 910-481-0503
Sales: 910-240-4210
Fax: 910-481-0585



TODD TUCKER 34 - 156
FORTIFIED-WISE™
PROFESSIONAL
910-824-1474

THE BAILEY
SECOND FLOOR PLAN WITH
BONUS ROOM OPTION




PLAN NO. 2424

DATE: APRIL 2019

REVISIONS:

SHEET NO. 4

FIELD & REDLINE NOTES

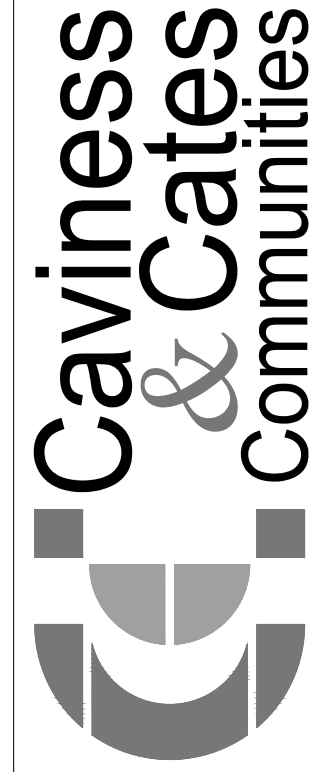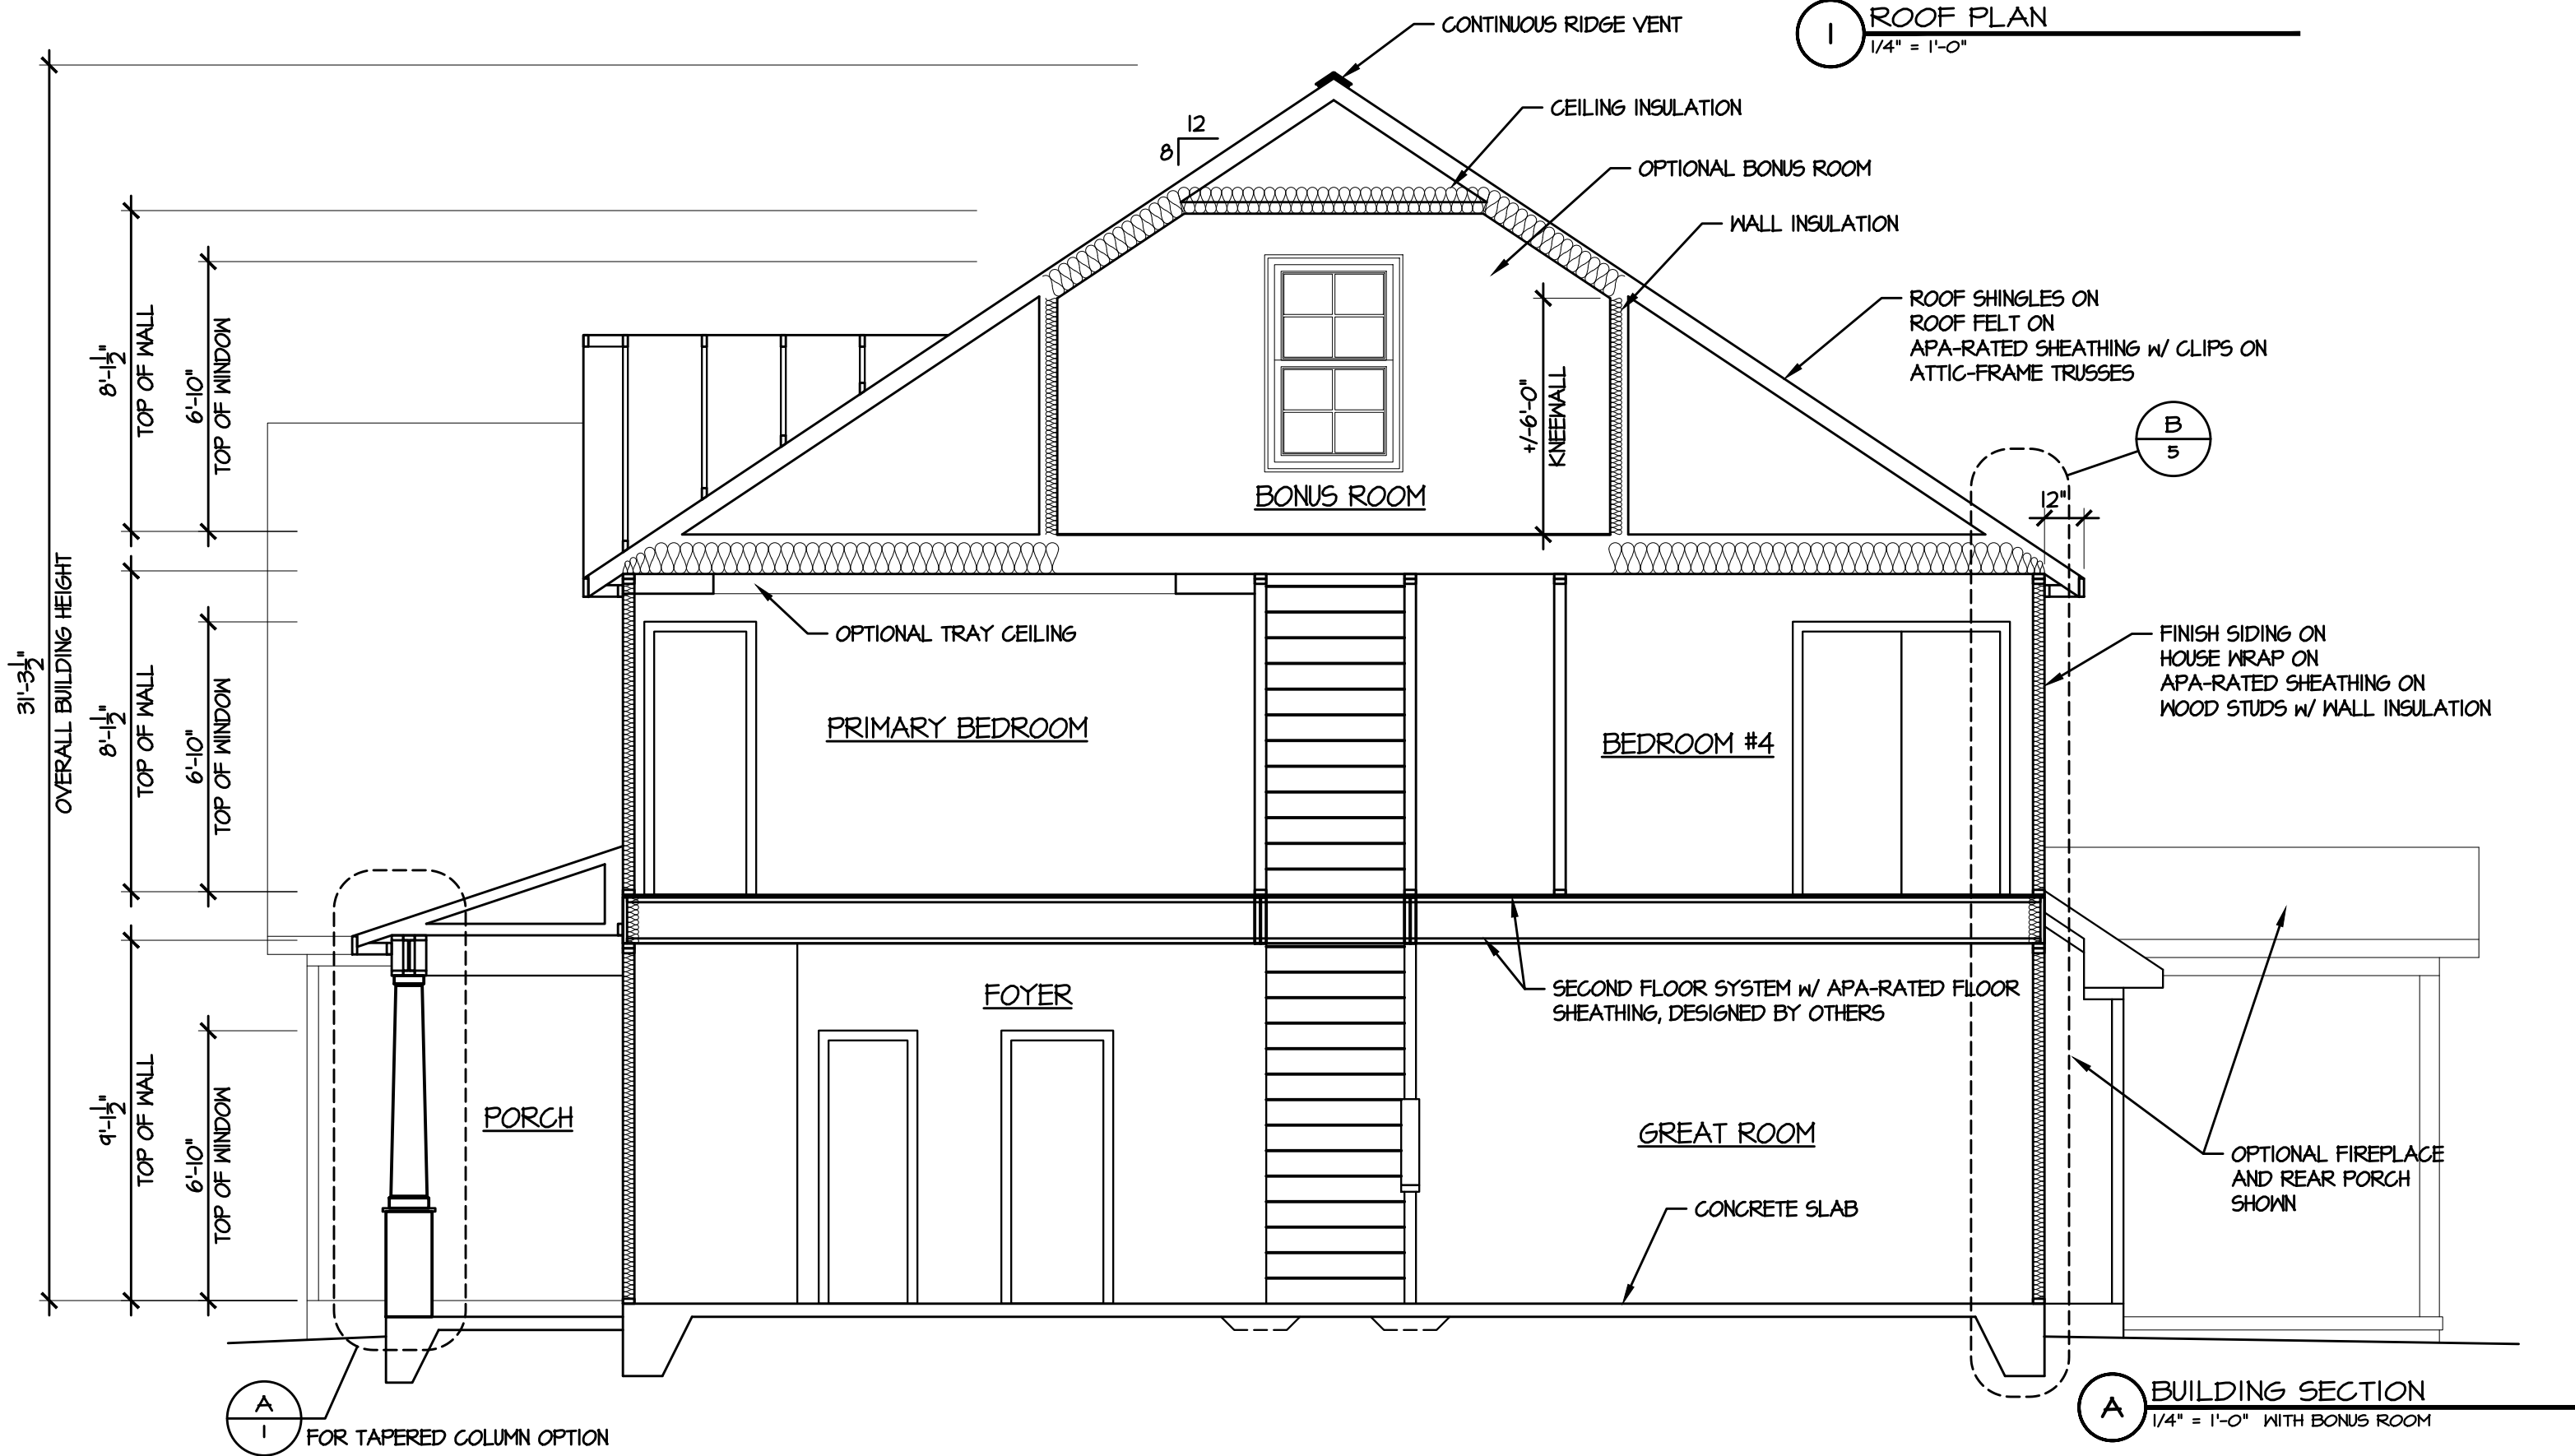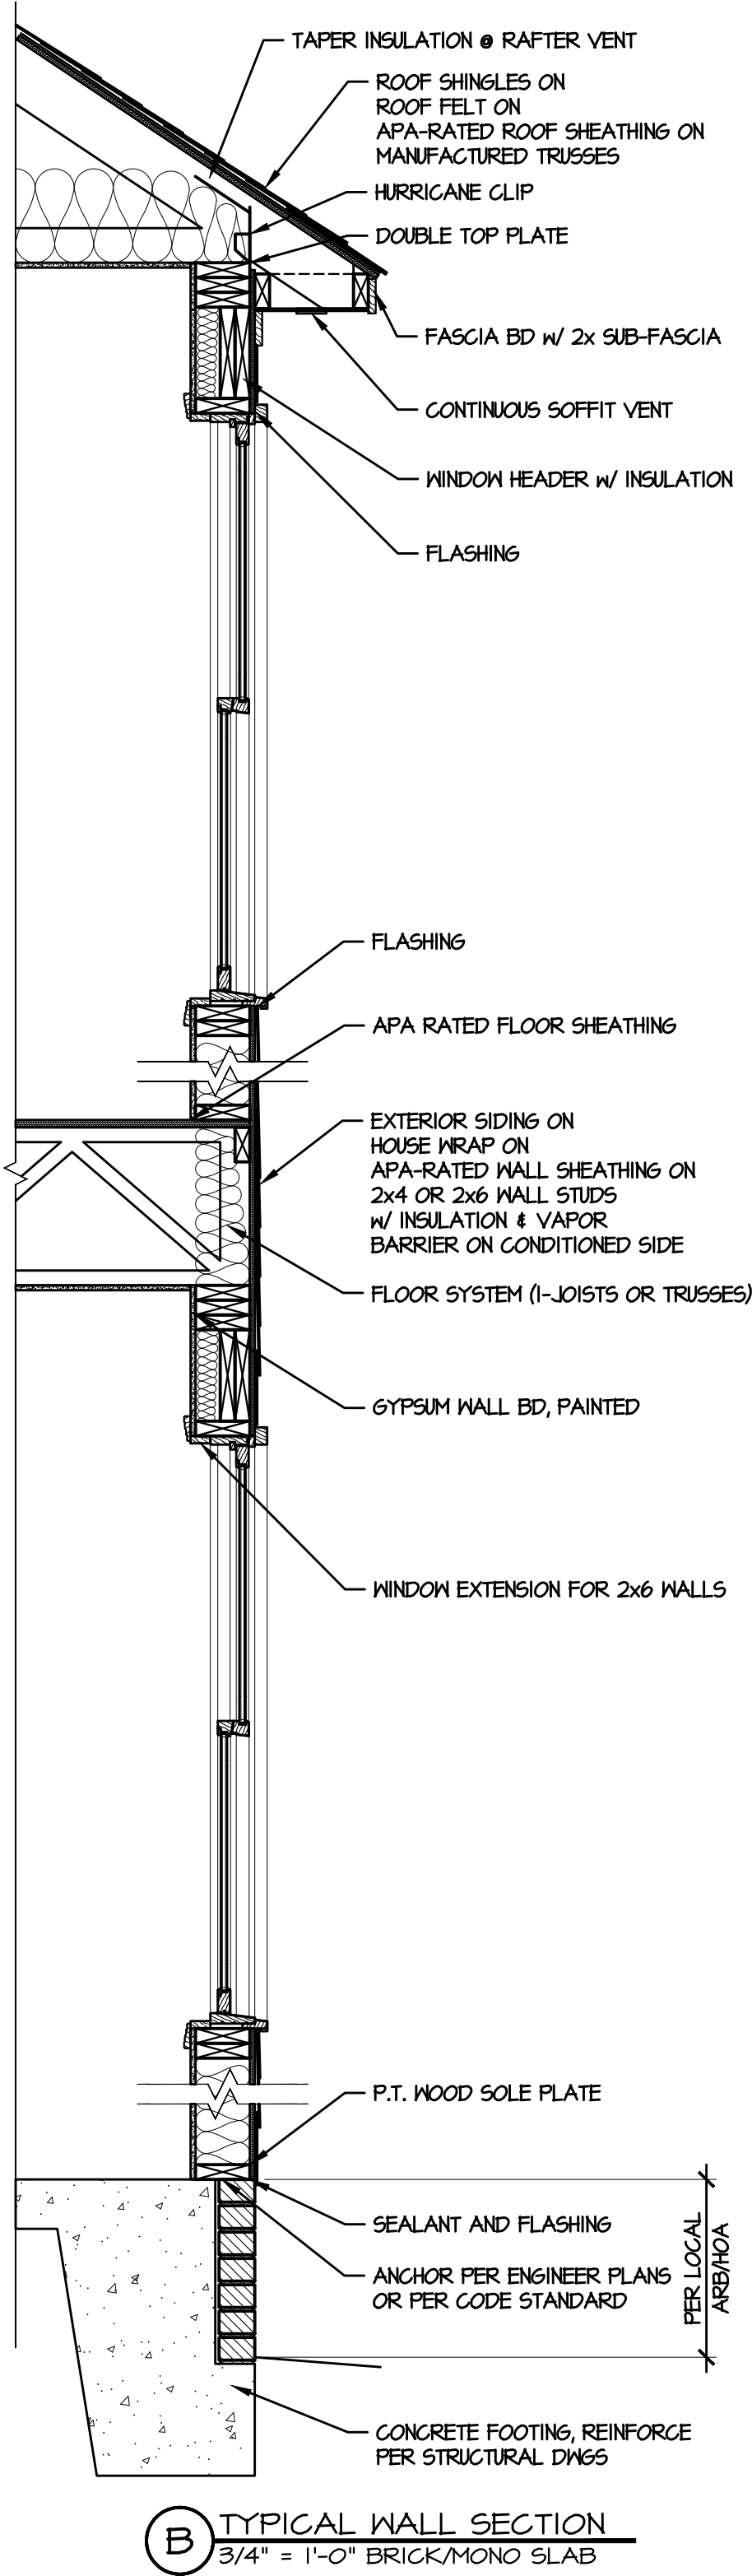

© 2019 Caviness & Cates

639 Executive Place
Suite 400
Fayetteville, NC 28305
Office: 910-481-0503
Sales: 910-240-4210
Fax: 910-481-0585



TODD TUCKER 34 - 156
FORTIFIED-WISE™
PROFESSIONAL
910-824-1474

PLAN NAME:
THE BAILEY

SHEET TITLE:
ROOF PLAN / SECTIONS




PLAN NO:
2424
CC 2136

DATE:
APRIL 2019

REVISIONS:	




SHEET NO:
5

F:\Caviness and Cates\CC 2136\Design Center\CC 2136 GL 24 COMPLETE SET 10-4-22.dwg, 1/25/2023 8:08:09 AM, 1:1

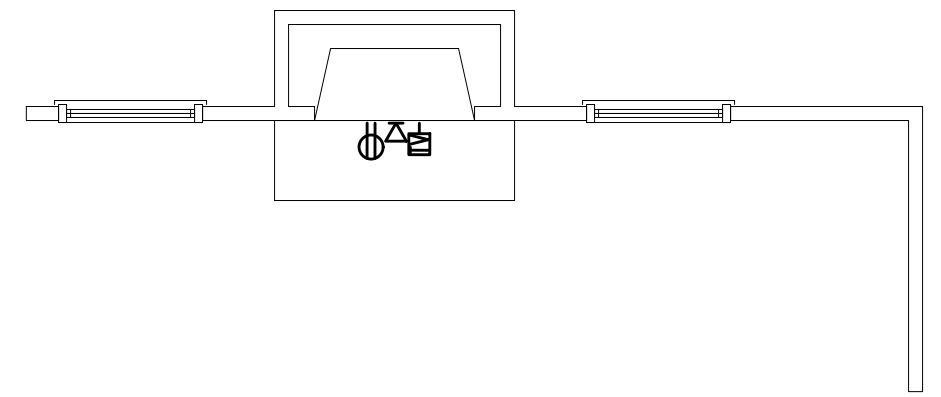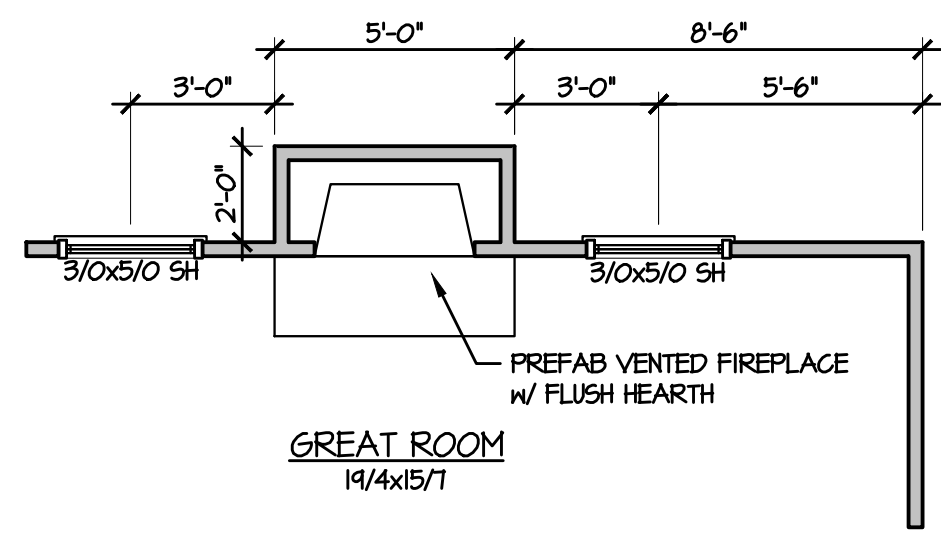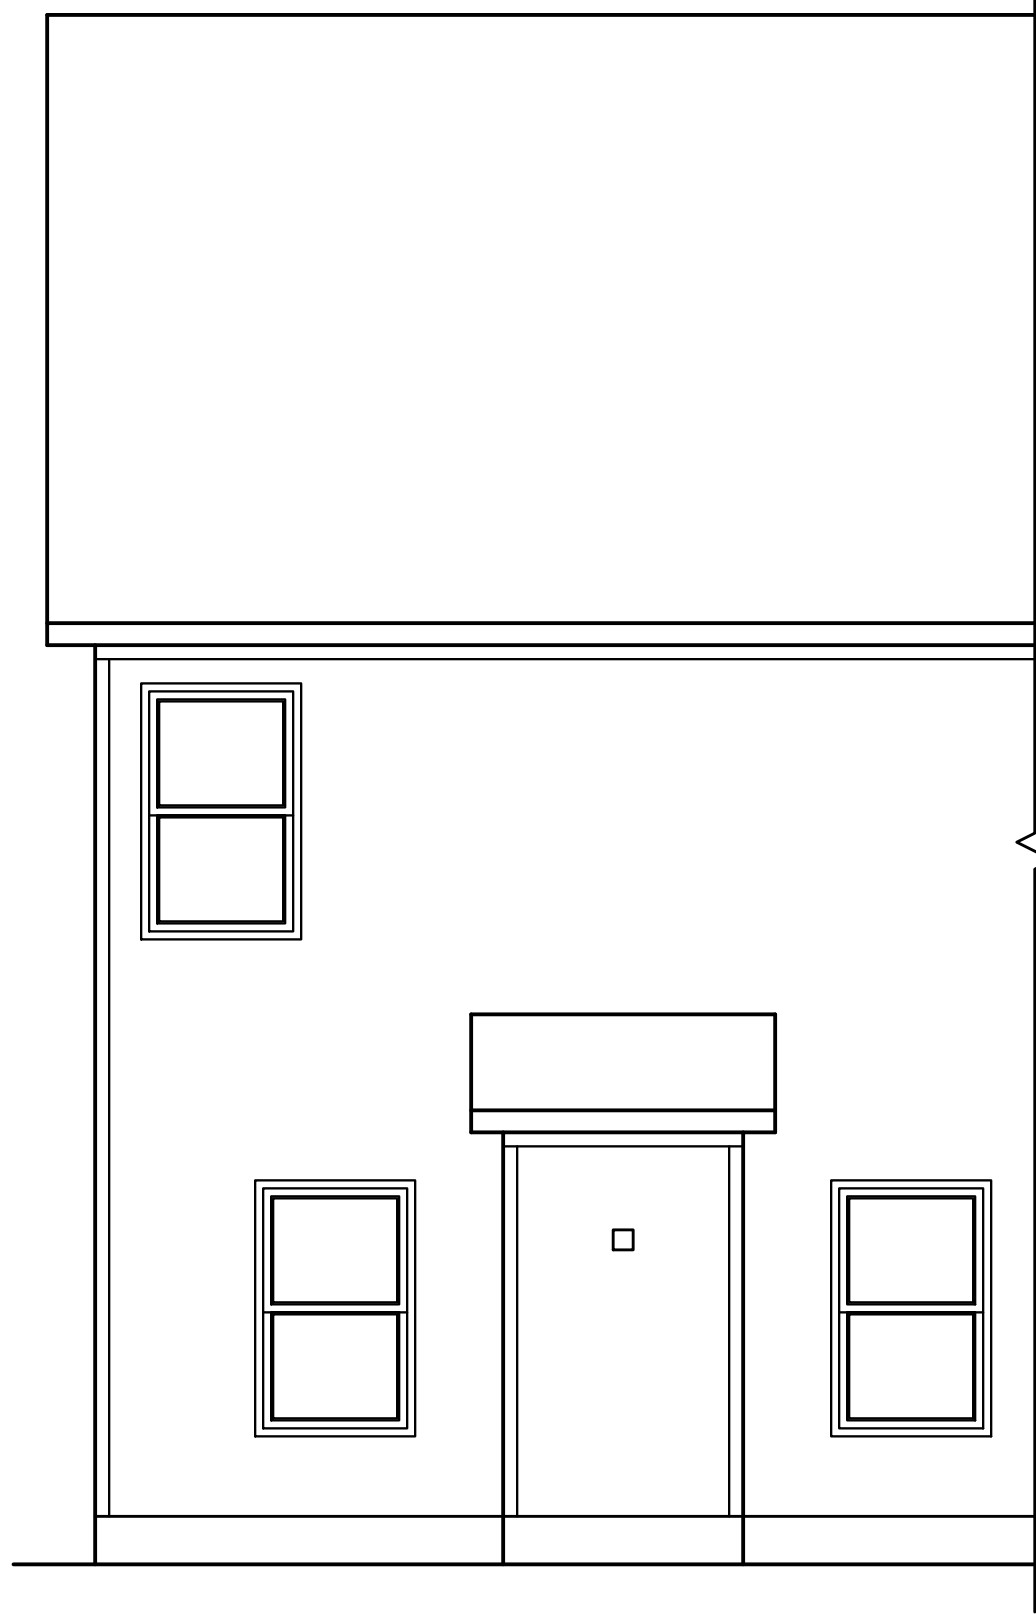




YES

3 FIRE PLACE OPTION
1/4" = 1'-0"

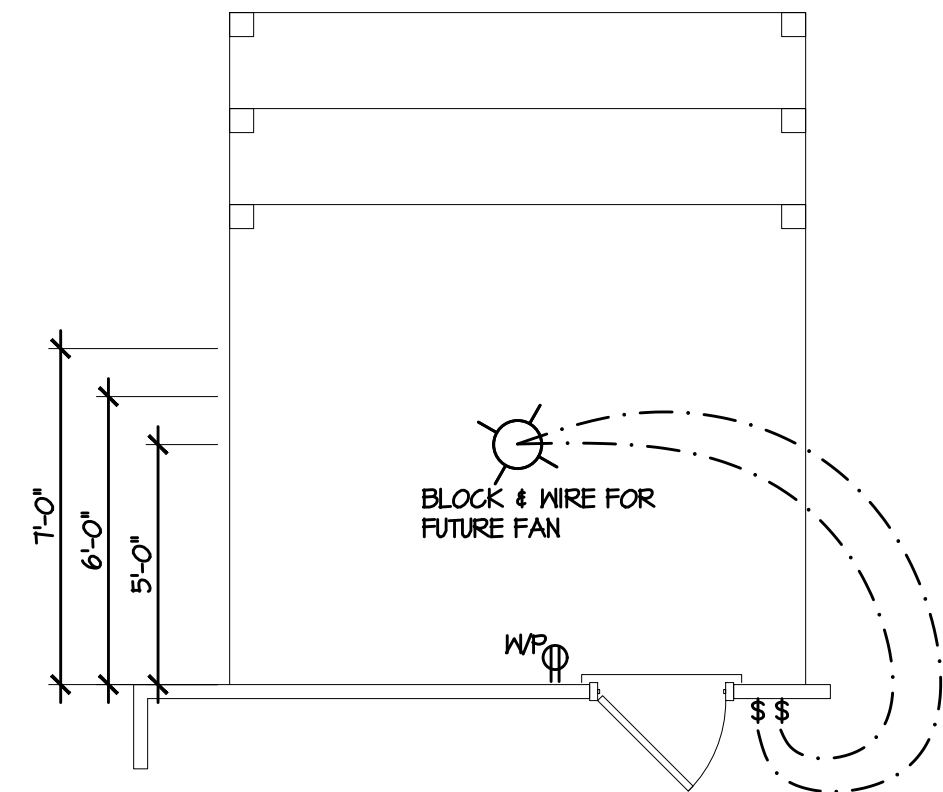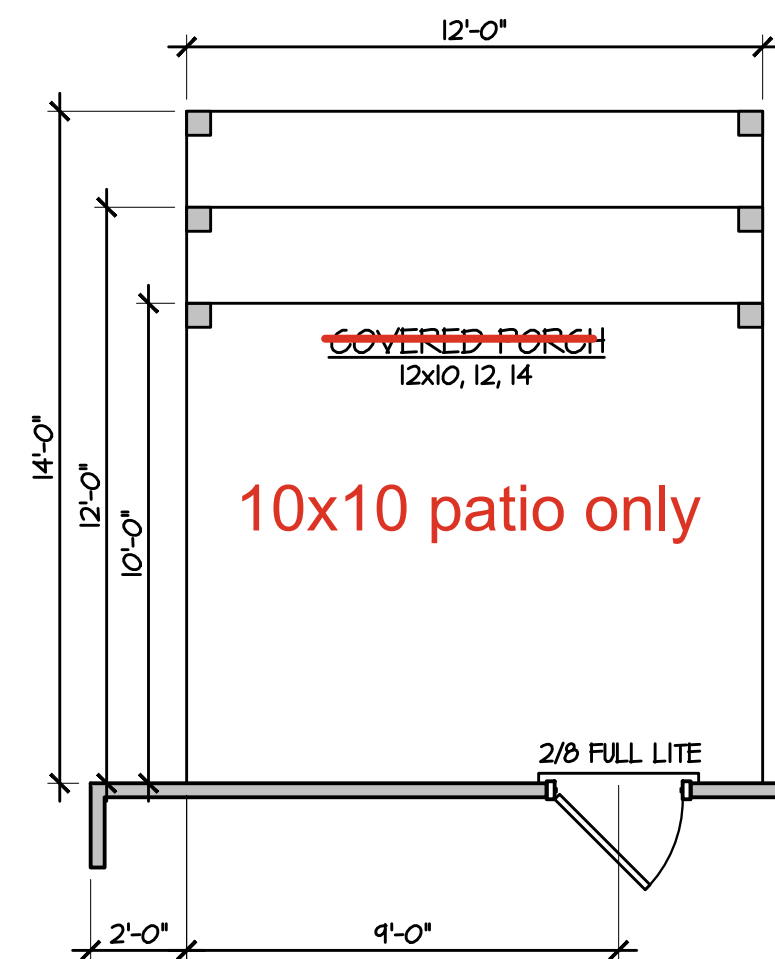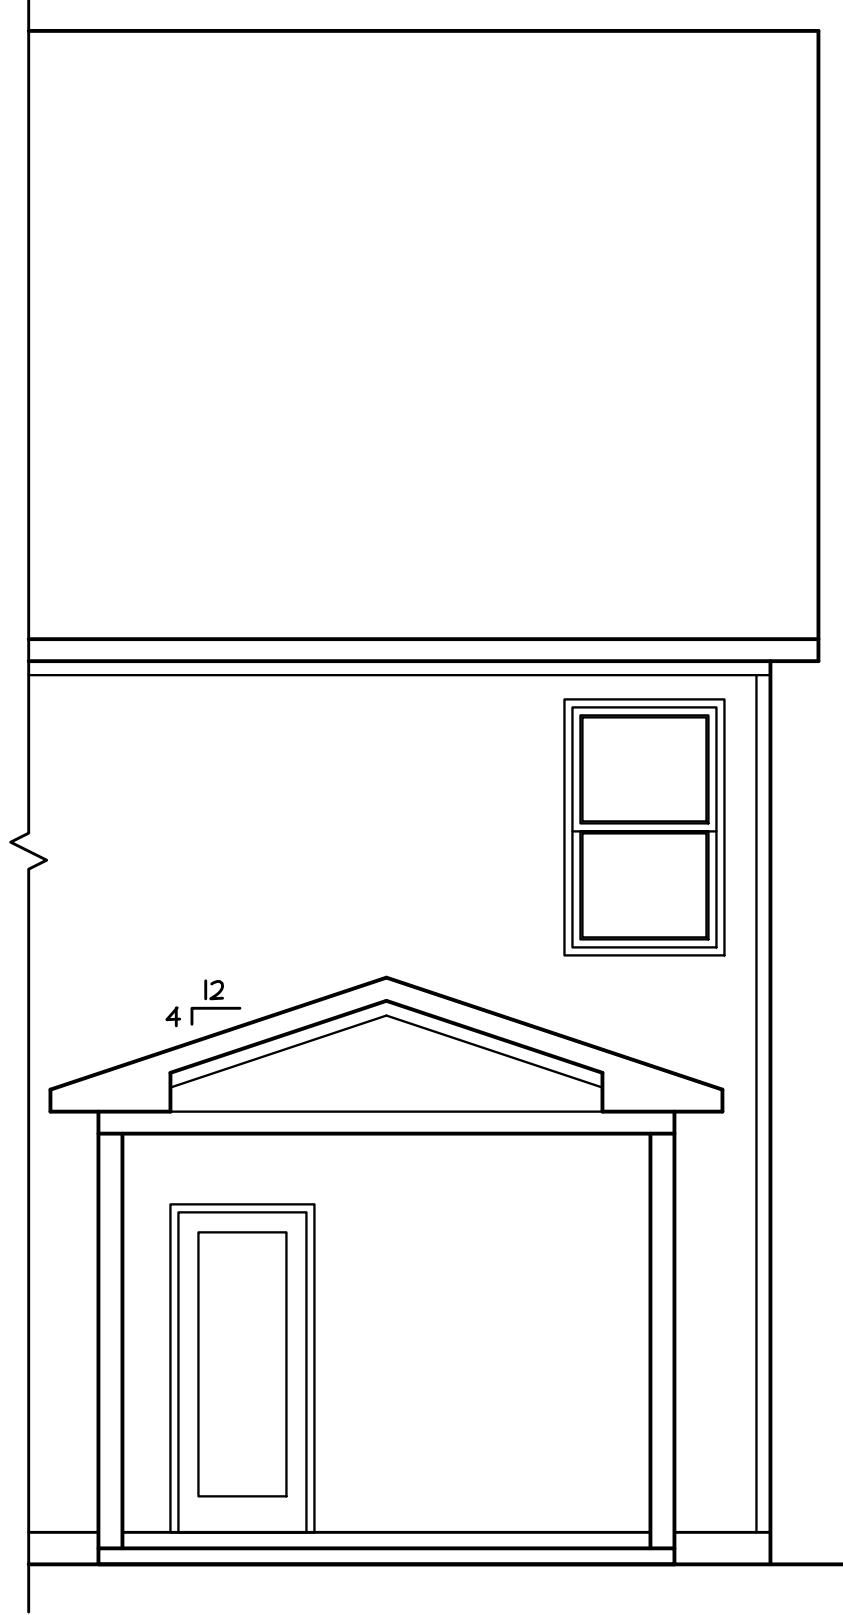

10x10 patio only

2 ~~REAR PORCH OPTIONS~~
1/4" = 1'-0"

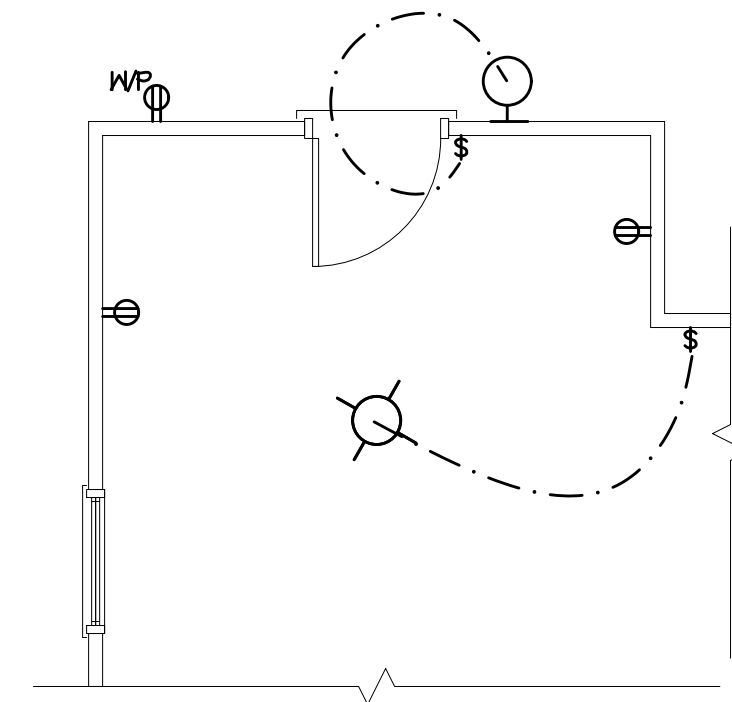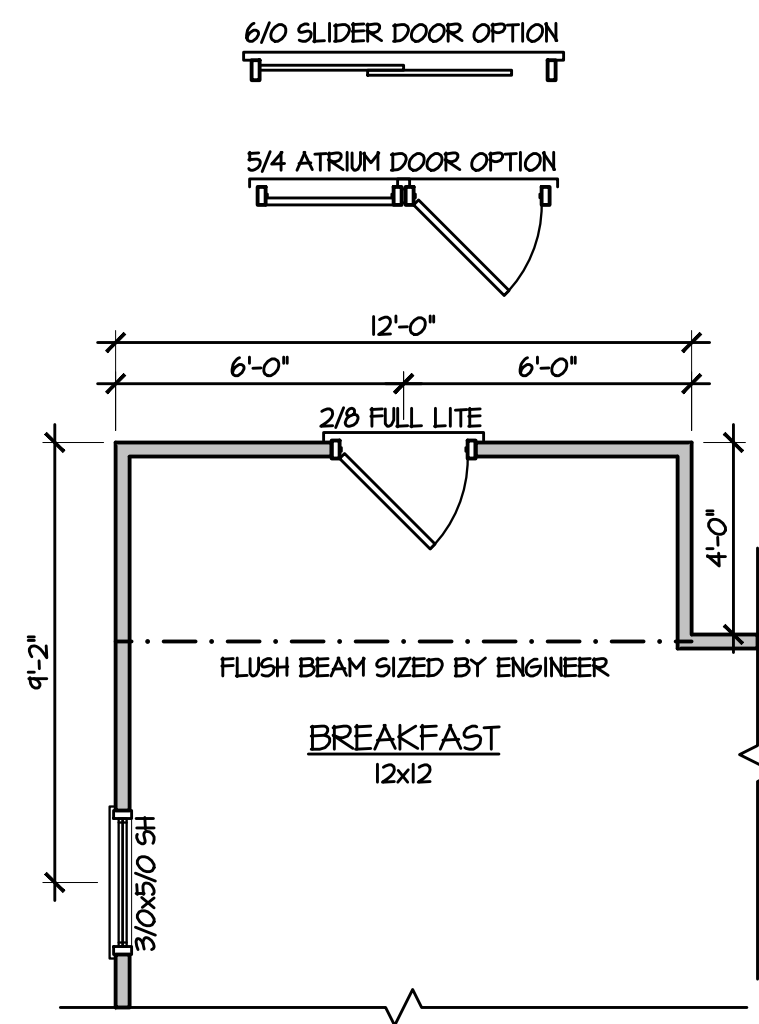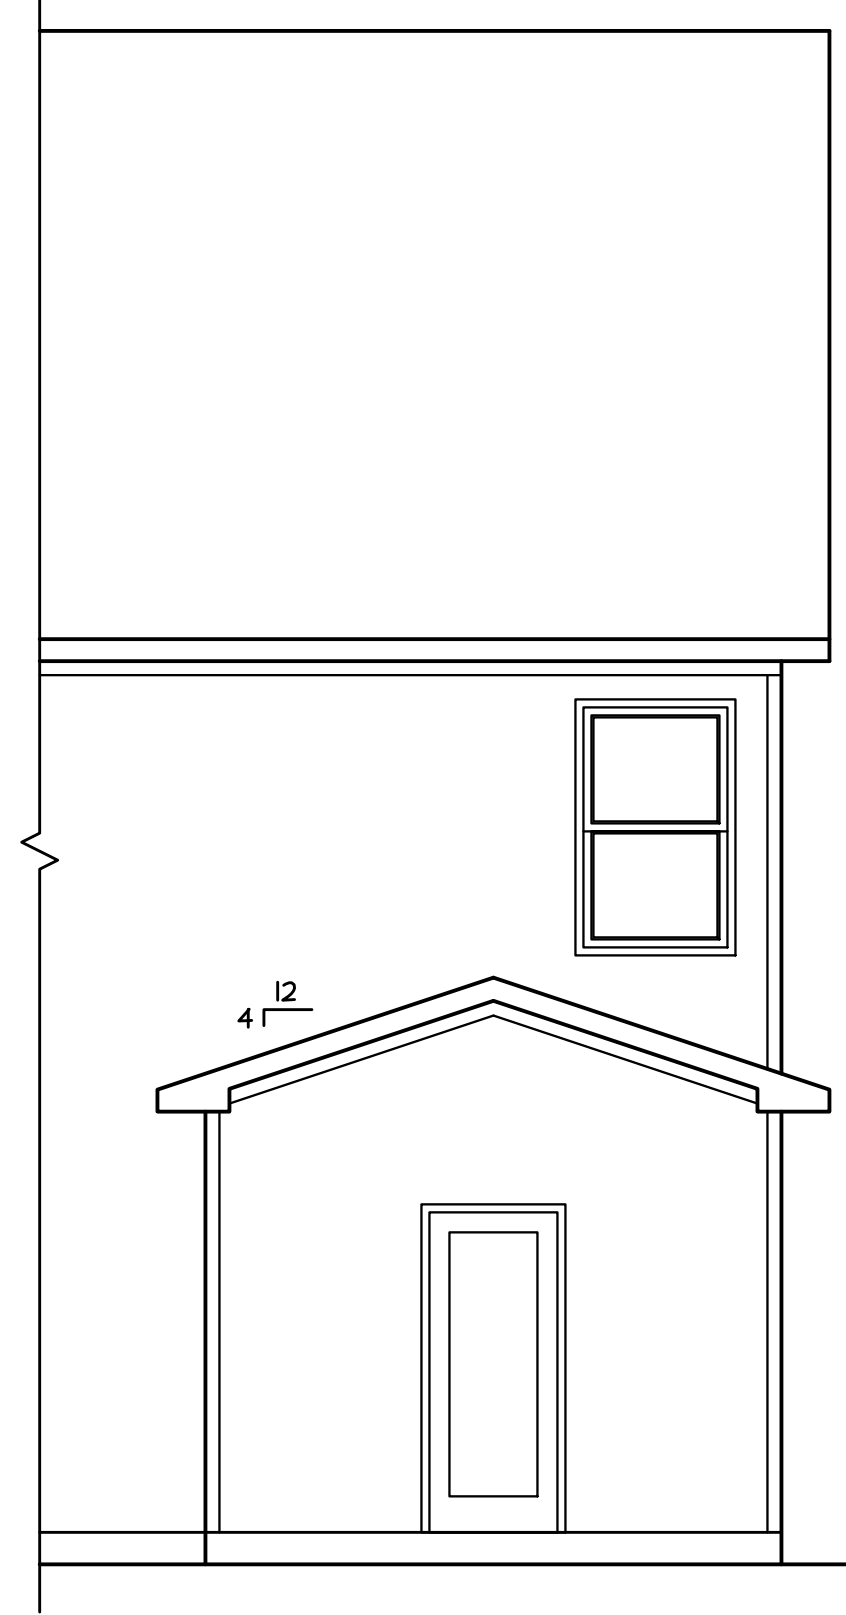



YES

1 EXTENDED BREAKFAST OPTION
1/4" = 1'-0"



© 2019 Caviness & Cates

639 Executive Place
Suite 400
Fayetteville, NC 28305
Office: 910-481-0503
Sales: 910-240-4210
Fax: 910-481-0585

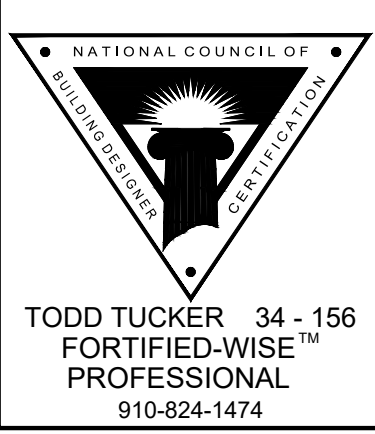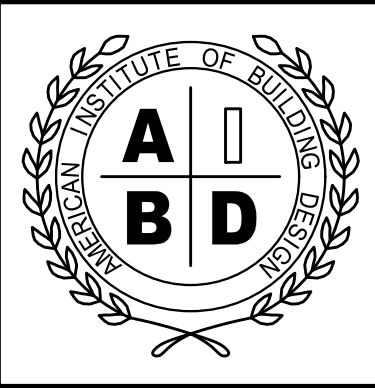

PLAN NAME:
THE BAILEY

SHEET TITLE:
STRUCTURAL OPTIONS

PLAN NO: **2424**
CC-2136

DATE:
APRIL 2019

REVISIONS:	

SHEET NO:
10