

Harnett County Department of Public Health

PERMIT # SFD 2503-0177

Operation Permit

☒ New Installation ☒ Septic Tank ☒ Nitrification Line ☐ Repair ☐ Expansion

PROPERTY LOCATION: 477 Beacon Hill Rd

Name: (owner) New Home Inc SUBDIVISION Duncans Creek LOT # 29

System Installer: D. Medlin


Basement with plumbing: ☐ Garage ☒ Number of Bedrooms 3 (6 people)

Type of Water Supply: ☐ Community ☒ Public ☐ Well Distance from well _____ feet

System Type: TYPE III S Types V and VI Systems expire in 5 years.

(In accordance with Table V a) Owner must contact Health Department 6 months prior to expiration for permit renewal.

This system has been installed in compliance with applicable North Carolina General Statutes, Rules for Sewage Treatment and Disposal, and all conditions of the Improvement Permit and Construction Authorization.

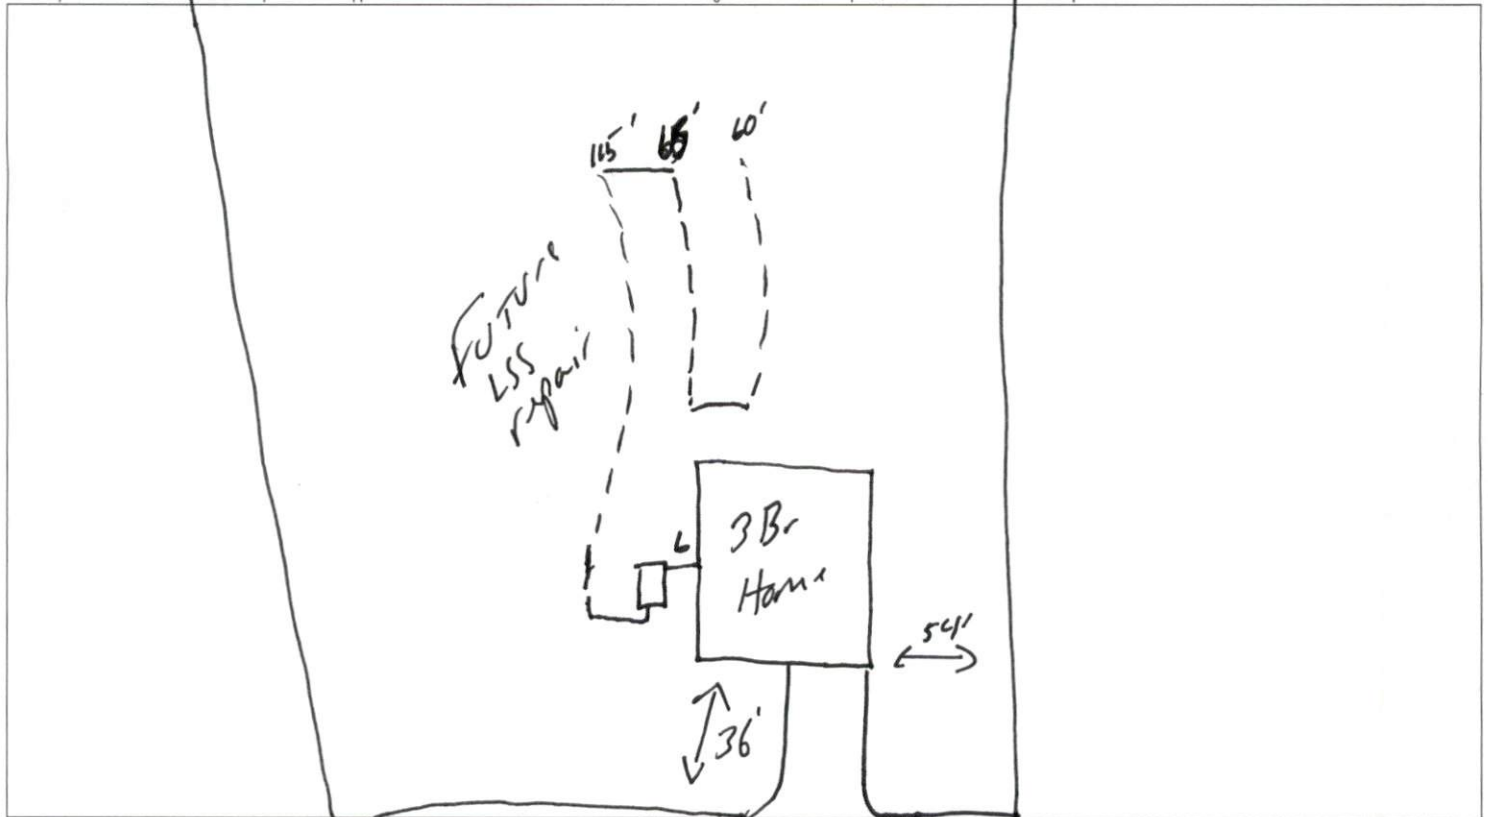

PERMIT CONDITIONS:

I. Performance: System shall perform in accordance with Rule .1961.

II. Monitoring: As required by Rule .1961.

III. Maintenance: As required by Rule .1961. Other: _____

Subsurface system operator required? Yes ☐ No ☒

If yes, see attached sheet for additional operation conditions, maintenance and reporting.

IV. Operation: _____

V. Other: _____

☐ D-Box ☐ Pump ☐ Alarm ☐ H2O Line ☐ PWR Line

Following are the specifications for the sewage disposal system on the above captioned property.

Type of system: ☐ Conventional ☒ Other 25% reduction E2 Flow Septic Tank: _____ gallons Pump Tank: _____ gallons

Subsurface No. of _____ exact length _____ width of _____ depth of _____
Drainage Field ditches 1 of each ditch 230 feet ditches 3 feet ditches 26 inches

French Drain Required: _____ Linear feet

Authorized State Agent

M. H. P. H. S.

Date 10-15-25


Duncans Creek- Lot #29
"As Built" Revision - Approved by "Alex Adams"
477 Beacon Hill Rd - Lillington, NC
New Home, Inc
Harnett County PIN: 0630-22-8929

*Not a Survey
Sketched from a plot plan supplied by owner

*At the time of installation due to vegetation clearing limitations the installer slightly altered the installation from the original septic design. This modification is "approved" by Alex Adams 10-14-25.

System: Gravity to Serial Dist.
Lines: 1-3 (240' total)
0.5 LTAR
24" Max Trench Bottom
Accepted Status System
Repair: Gravity to D-Box
Lines: 3-5 (240')
0.5 LTAR
24" Max Trench Bottom
Accepted Status System

**1000 Gallon Septic and Pump Tank
Tank and trenches to be located minimum of 10'
from any property line and minimum of 5'
from any building foundation.
*Do Not Cut, Fill, or Alter Drainfield or Repair Area
*Comply with all setbacks
*Contact local health dept. and/or Alex Adams prior to
or during installation with any questions or concerns.

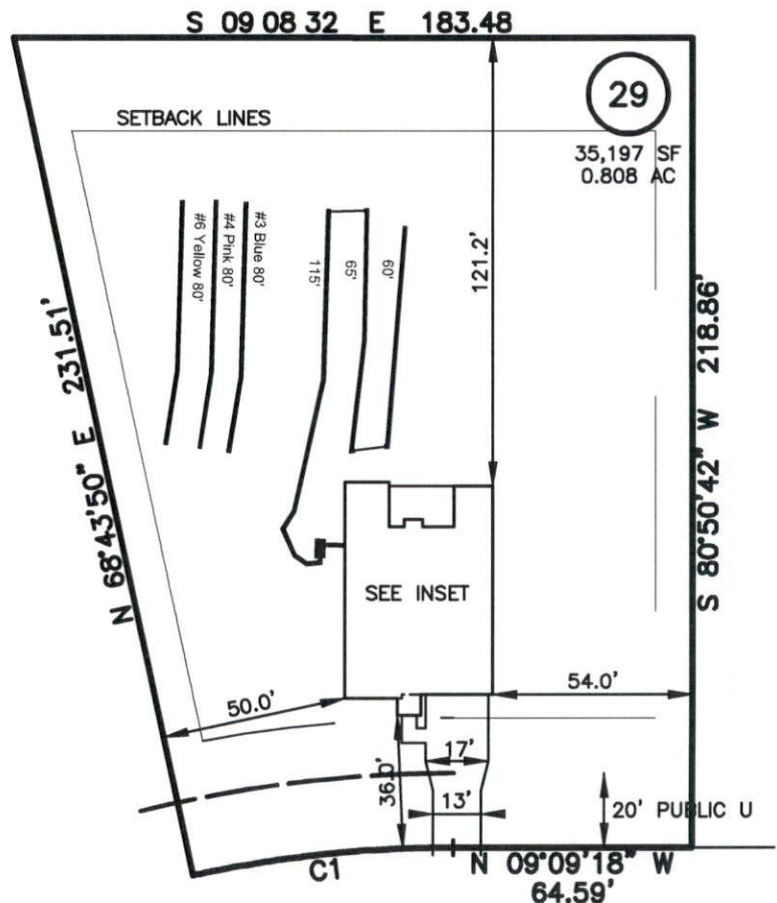

BEACON HILL ROAD
50' PUBLIC R/W

Adams
Soil Consulting
919-414-6761
Job #1769

GRAPHIC SCALE
1" = 50'

