



B Square Footages:

1st Floor	1089
2nd Floor	1430
Garage	393
Front Porch	80
2nd Floor Deck Option	400
2nd Floor Garage Option	220

2519

37 CBR

Russell B

Genesis Series
V.03.03.00.00

GARAGE LEFT

Features:

Rev By:
CJA AW EB

Drawn By: AM

Date: 12/2/2024

A1



FRONT ELEVATION

3/16" = 1'-0"

~~SEE SHEET AA-1 FOR STONE
& BRICK WATER TABLE
OPTIONS~~

9FT CEILING OPTION NOTES:

1. Fascia heights from 1st Flr of main house increase 12in. Fascia heights from 2nd Flr of main house remain the same.
2. Fascia/beam/column heights at Front and Rear Porches remain the same (regardless of fascia @ main house.)
3. Roof pitch at porch may change. Follow notes at elevations.
4. Window heights and sizes remain the same.


9FT CEILING OPTION NOTES:

- 1. Fascia heights from 1st Flr of main house increase 12in.
Fascia heights from 2nd Flr of main house remain the same.
- 2. Fascia/beam/column heights at Front and Rear Porches remain the same (regardless of fascia @ main house.)
- 3. Roof pitch at porch may change. Follow notes at elevations.
- 4. Window heights and sizes remain the same.




REAR ELEVATION

1/8" = 1'-0"

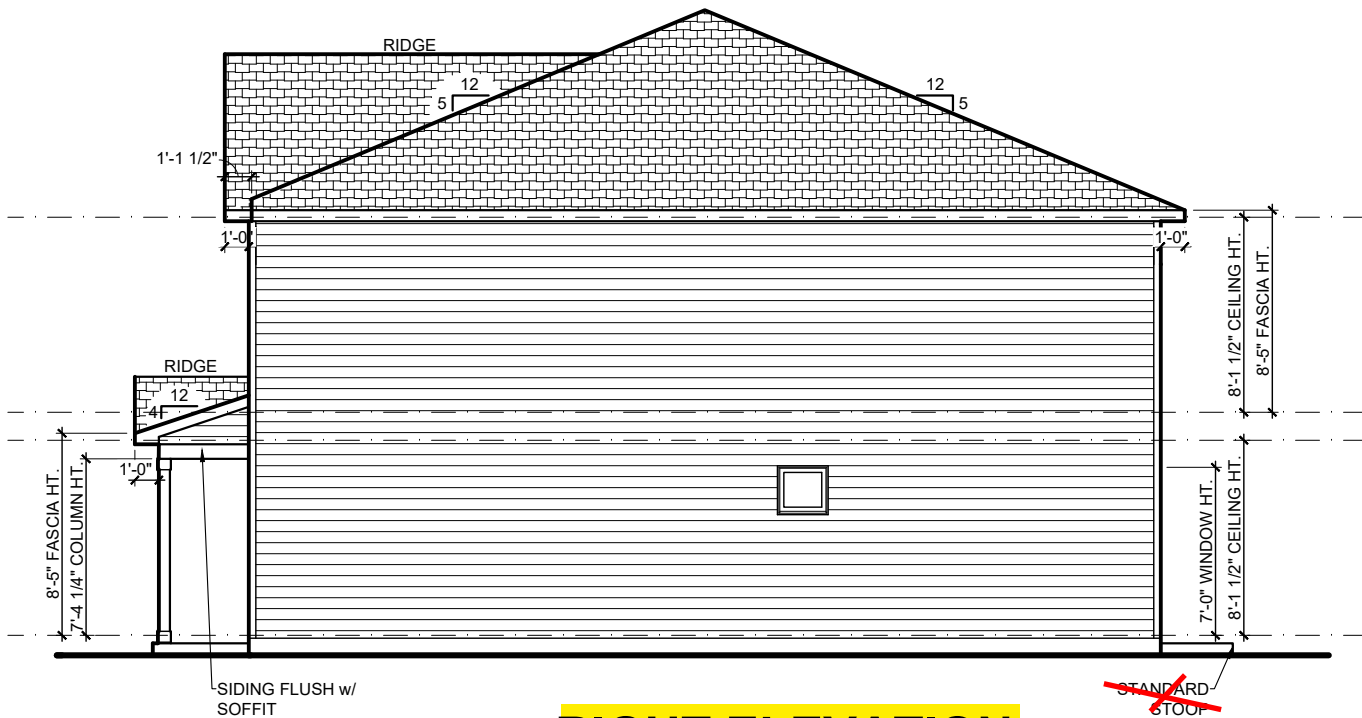

RIGHT ELEVATION

1/8" = 1'-0"

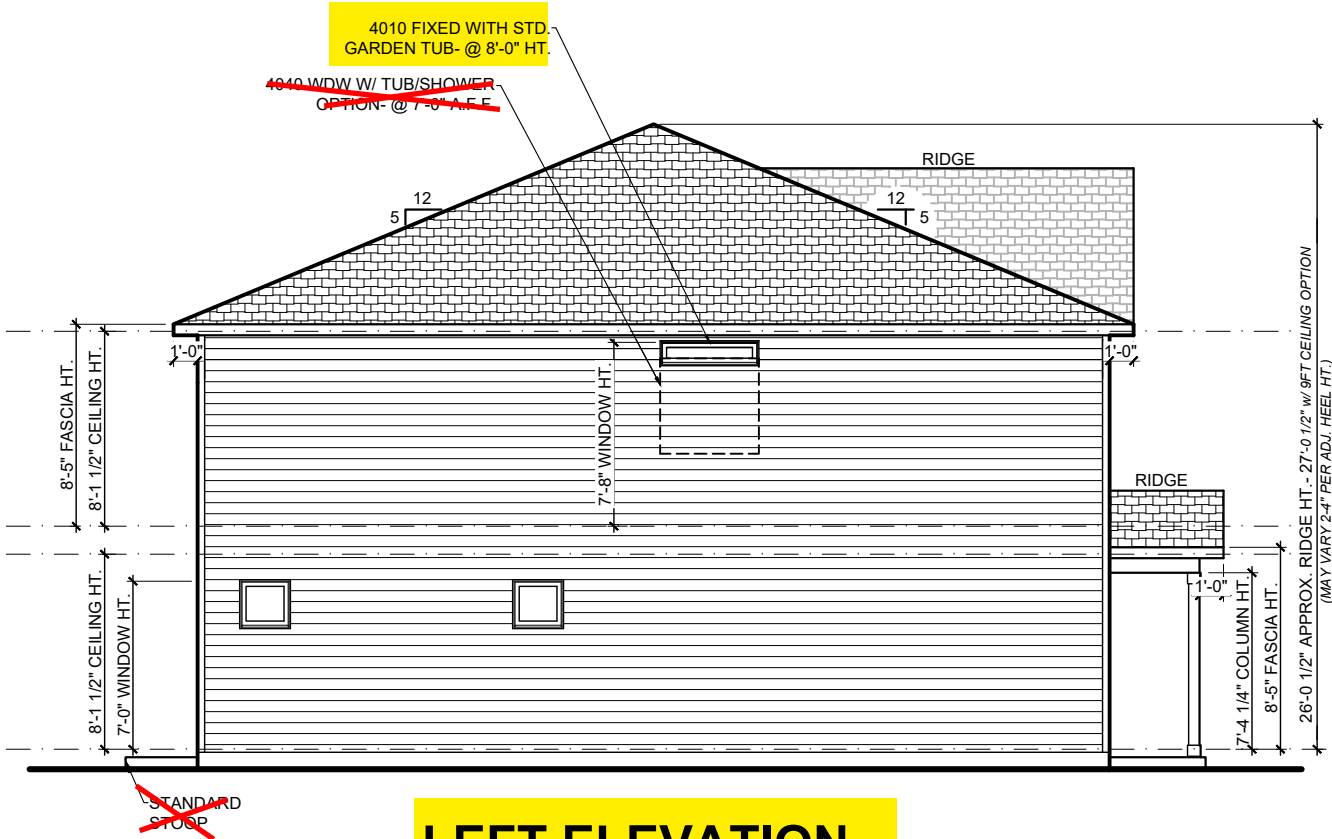

LEFT ELEVATION

1/8" = 1'-0"



B Square Footages:

1st Floor.....	1089
2nd Floor.....	1430
Alternate 2nd Floor.....	1434
Garage.....	393
Front Porch.....	80
Covered Porch Option.....	120
3rd Car Garage Option.....	220

Russell B

Genesis Series
V.03.03.00.00


GARAGE LEFT

Features:


Drawn By: AM
Rev By: CJA /AW EB

Date: 12/2/2024

A2

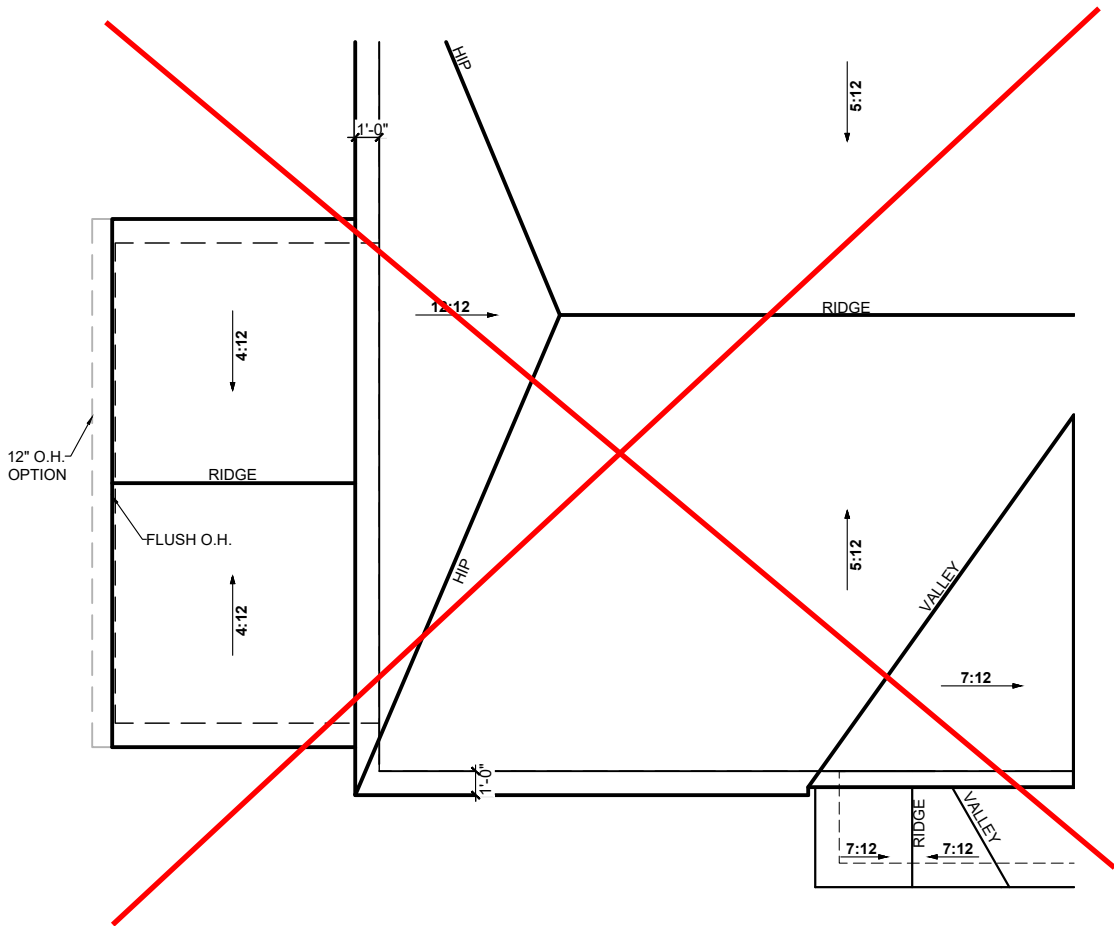

3rd Car Garage Option
1/8" = 1'-0"

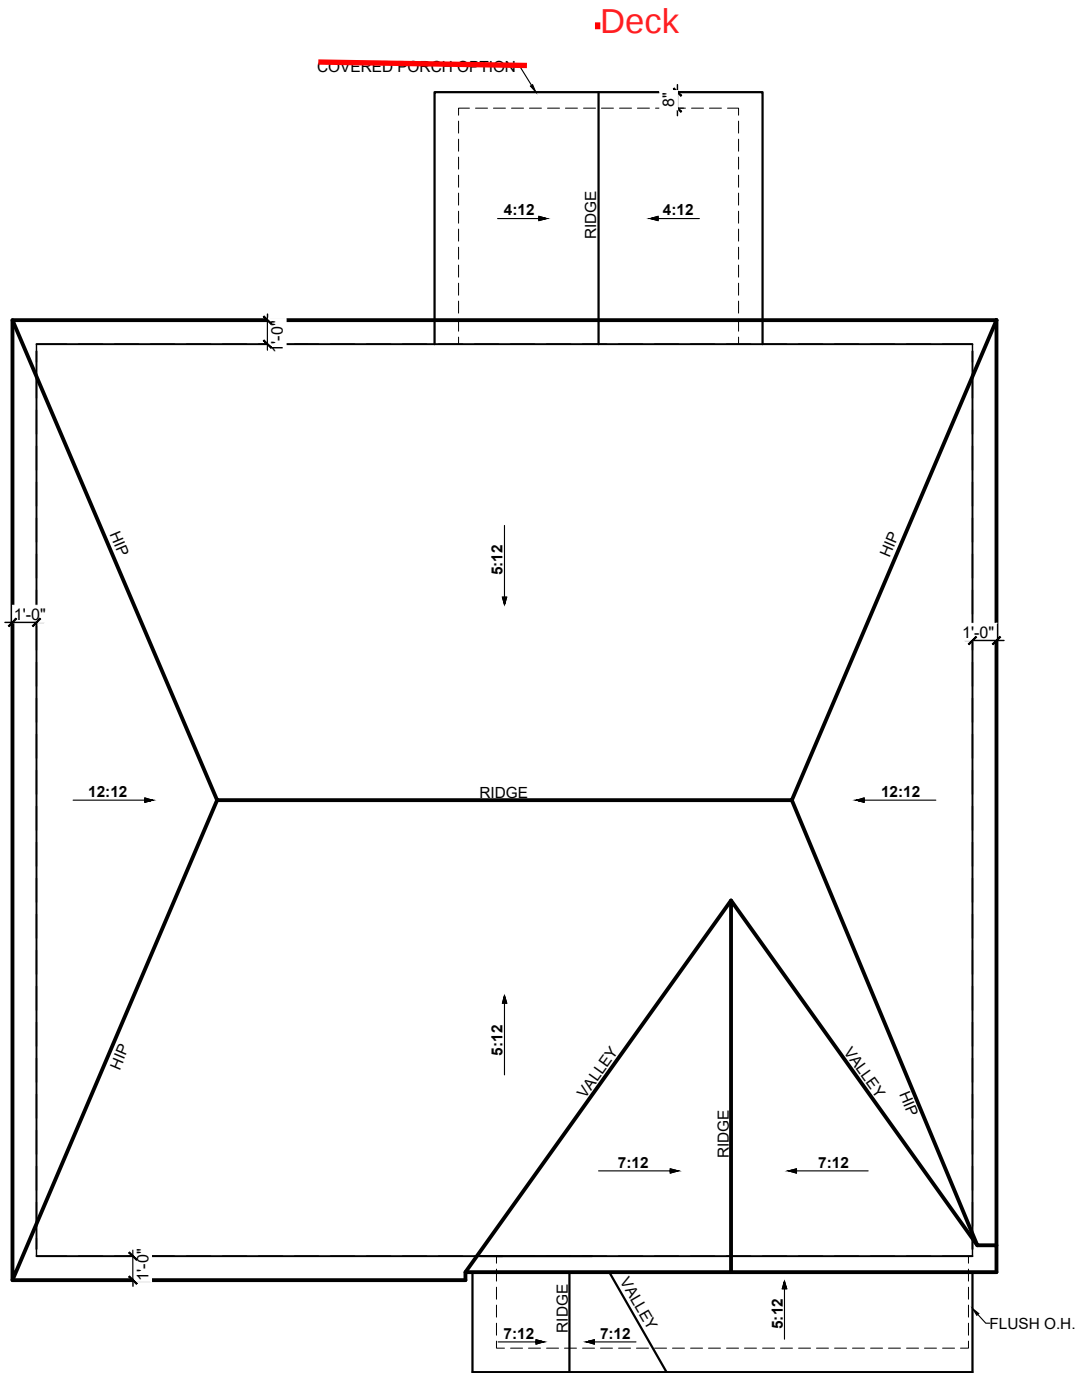

ROOF PLAN
1/8" = 1'-0"

- NOTES:
1. ALL OVERHANGS ARE 1'-0" U.N.O.
 2. ROOF PLANS *DO NOT* INCLUDE FULL BRICK OPTIONS.
 3. ROOF PLANS ARE NOT INTENDED FOR CONSTRUCTION USE. *(INFORMATIONAL USE ONLY)*
 4. BE SURE TO CHECK OVERHANG INFORMATION AT PLAN WHEN CALCULATING SOFFIT INTAKE

ROOF INFORMATION SUMMARY

MAIN ROOF-

Base House:
Attic Square Footage.....1482 sf
Flat Soffit.....132 lf
Ridge.....36 lf

AREA(S) NOT AFFECTING MAIN ROOF-

Front Porch:
Attic Square Footage.....75 sf
Flat Soffit.....16 lf
Ridge.....3 lf
Roof to Wall Ridge.....14

Rear Covered Porch Option:
Attic Square Footage.....115 sf
Flat Soffit.....20 lf
Ridge.....9 lf



B Square Footages:

1st Floor.....	1089
2nd Floor.....	1430
Alternate 2nd Floor.....	1434
Garage.....	393
Front Porch.....	80
Covered Porch Option.....	120
3rd Car Garage Option.....	220

Russell B

Genesis Series
v.03.03.00.00

GARAGE LEFT


Features:

Rev By:
CJA AW EB




Drawn By: AM

Date: 12/2/2024

A-R 1

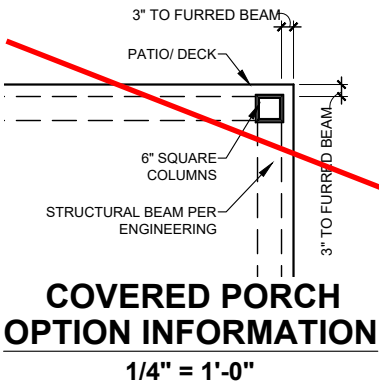


3-STUD PACK NOTE:
ALL FRAMING BETWEEN WINDOWS TO BE WRAPPED IN ICE & WATER SHIELD OR OTHER WEATHER RESISTANT BARRIER BEFORE WINDOWS ARE INSTALLED. MAINTAIN DRAINAGE PLAN FROM TOP TO BOTTOM WITH HOUSEWRAP - TYPICAL.

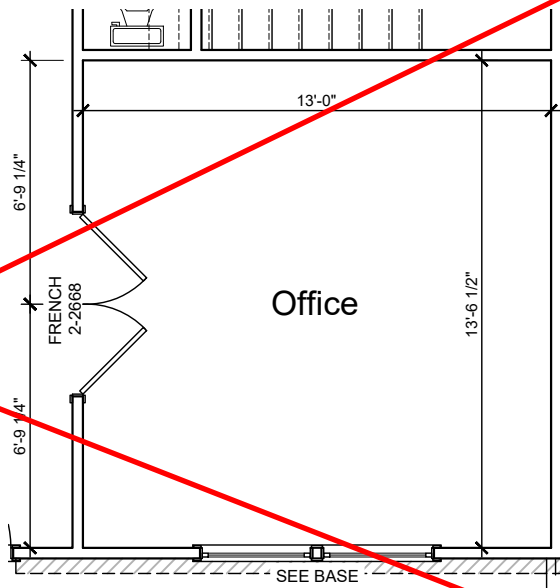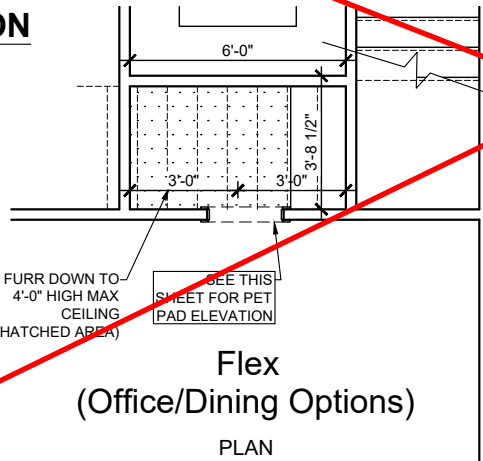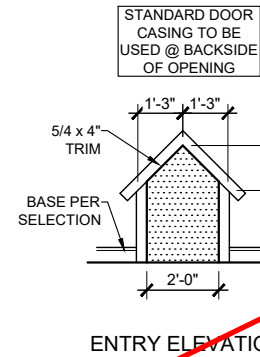

Pet Pad Option

10'X12'Deck

Office Option

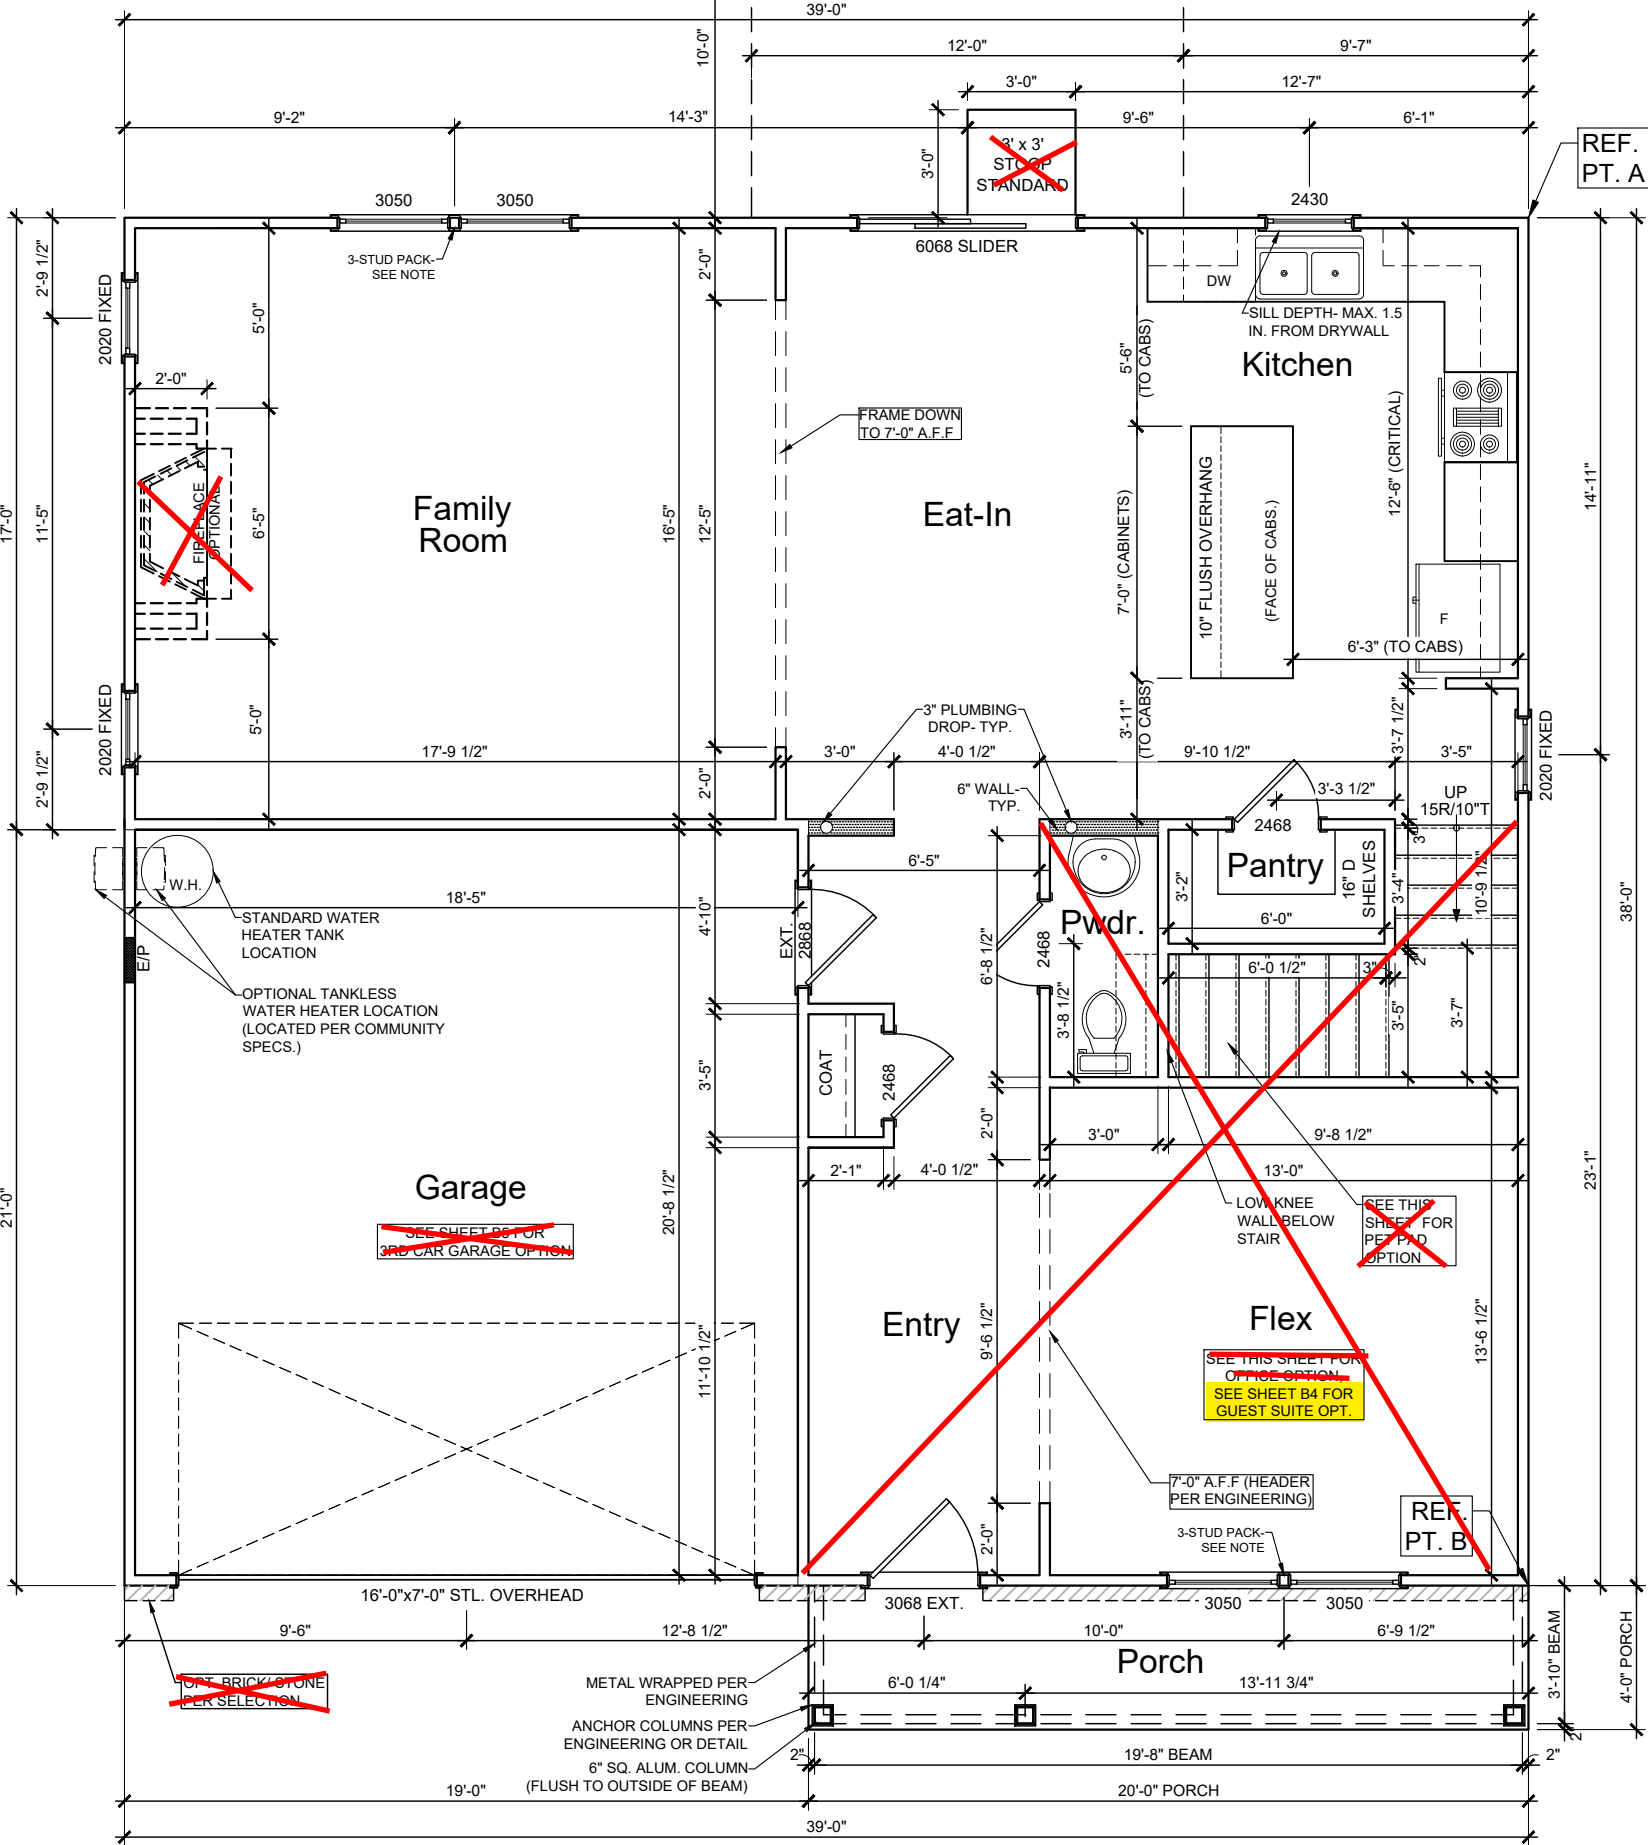

FIRST FLOOR

3/16" = 1'-0"

- NOTES:
1. SEE ENGINEERING FOR FRAMING PLANS.
 2. 8'-0" CEILING HEIGHTS @ 1ST FLOOR (9FT CLG. OPT.) U.N.O.
 3. 8'-0" CEILING HEIGHTS @ 2ND FLOOR U.N.O.
 4. WINDOW HEIGHTS VARY - FOLLOW ELEVATIONS CAREFULLY.
 5. ALL ANGLES ARE 45° UNLESS NOTED OTHERWISE.

B1

Features:

Drawn By: AM

Rev By: CJA AW EB

Date: 12/2/2024

Russell B

Genesis Series
v.03.03.00.00


GARAGE LEFT

1st Floor.....	1089
2nd Floor.....	1430
Alternate 2nd Floor.....	1434
Garage.....	393
Front Porch.....	80
Covered Porch Option.....	120
3rd Car Garage Option.....	220

B Square Footages:




3- STUD PACK NOTE:
ALL FRAMING BETWEEN WINDOWS TO BE WRAPPED IN ICE & WATER SHIELD OR OTHER WEATHER RESISTANT BARRIER BEFORE WINDOWS ARE INSTALLED. MAINTAIN DRAINAGE PLAN FROM TOP TO BOTTOM WITH HOUSEWRAP- TYPICAL.

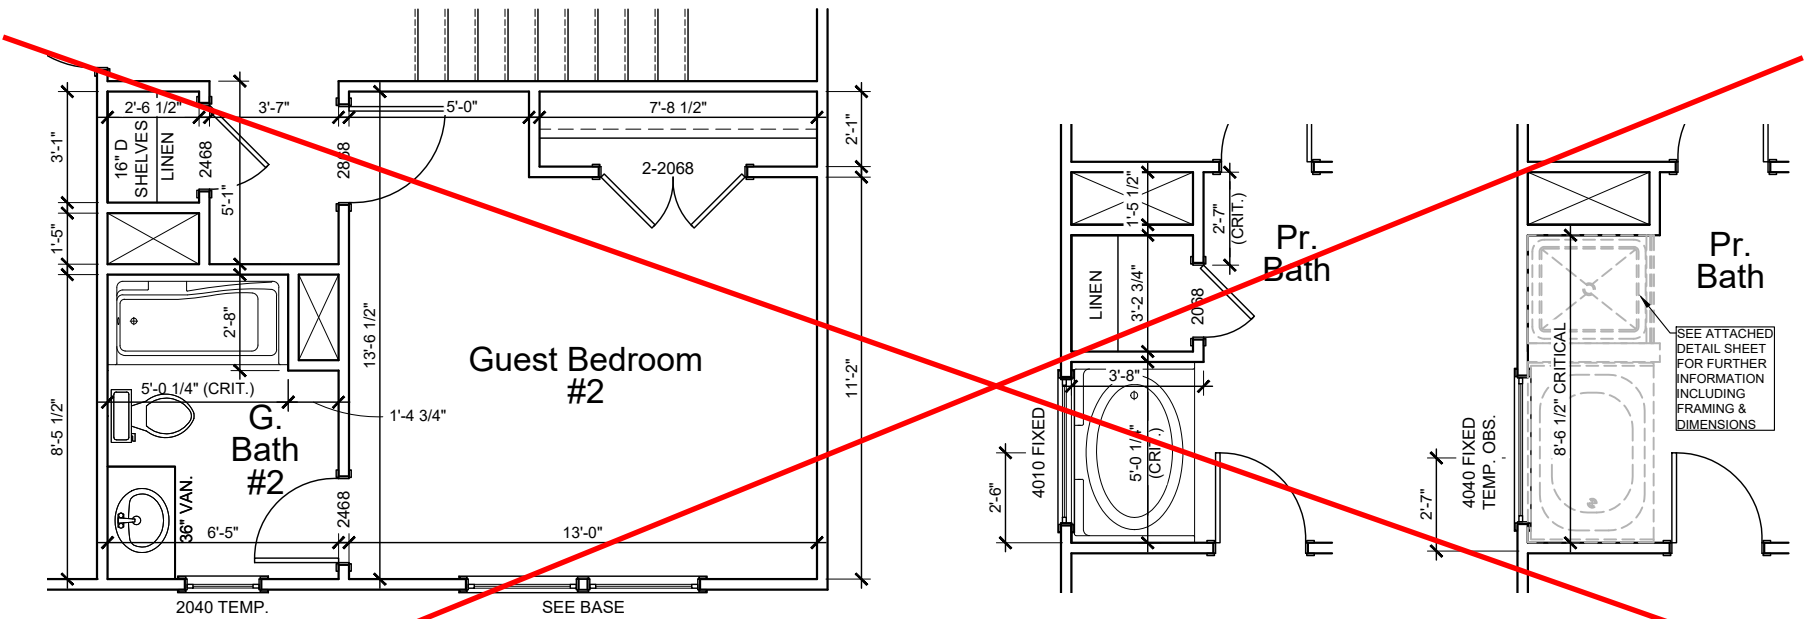

Guest Suite #2 Option
3/16" = 1'-0"
(*NOT AVAILABLE w/ ALT. 2ND FLOOR OPTIONS)

**42" Garden Tub w/
Shower Walls Opt.**
3/16" = 1'-0" @ PR. BATH

**Tub/ Shower
Option**
FOR ORIENTATION PURPOSES ONLY
@ PRIMARY BATH @ 2ND FLOOR

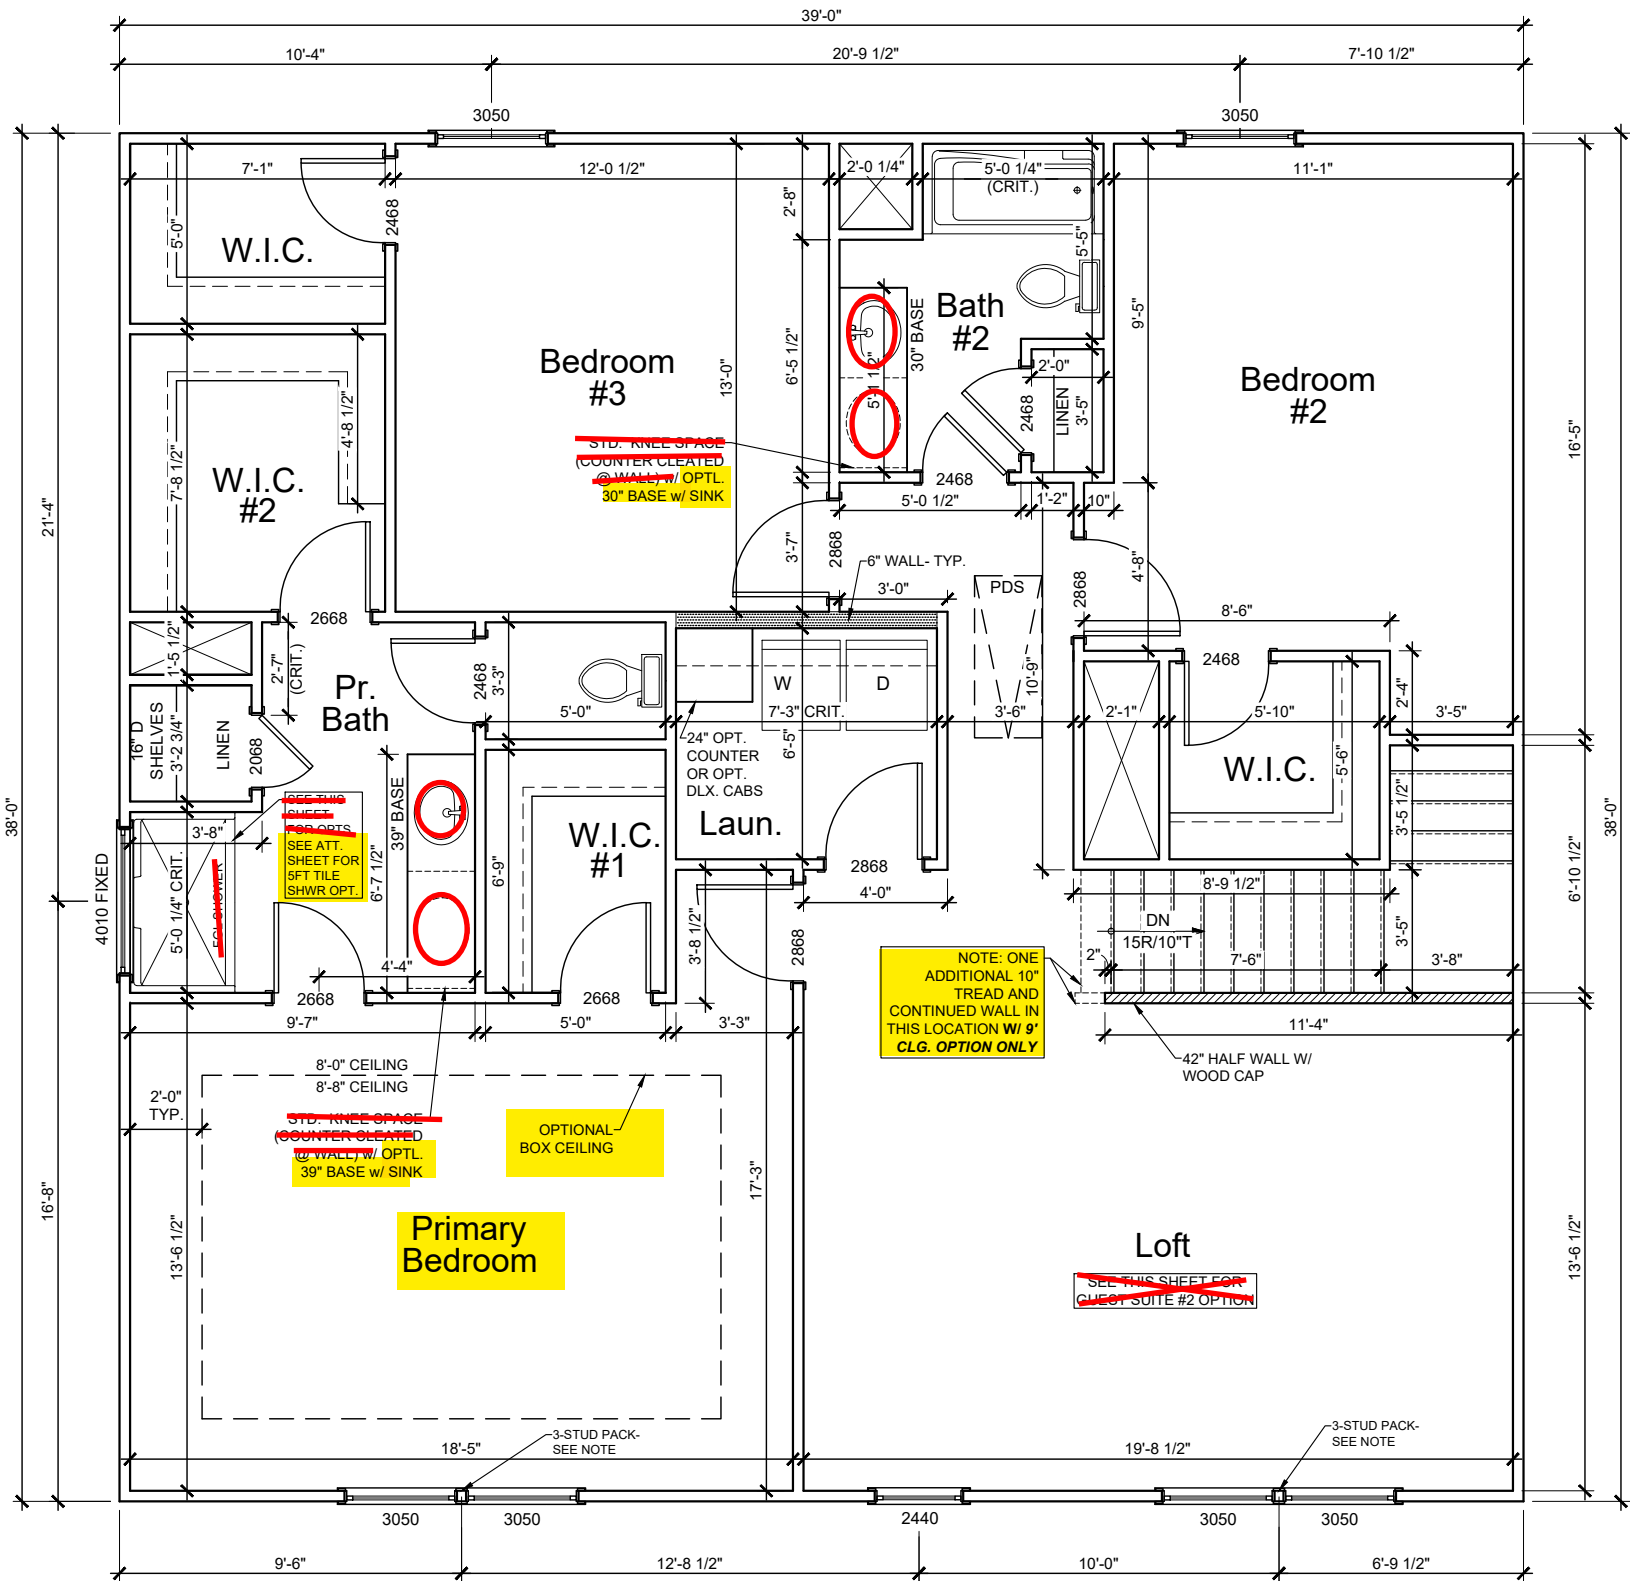

SECOND FLOOR
3/16" = 1'-0"

NOTES:
1. SEE ENGINEERING FOR FRAMING PLANS.
2. 8'-0" CEILING HEIGHTS @ 1ST FLOOR (9FT CLG. OPT.) U.N.O.
3. 8'-0" CEILING HEIGHTS @ 2ND FLOOR U.N.O.
4. WINDOW HEIGHTS VARY - FOLLOW ELEVATIONS CAREFULLY.
5. ALL ANGLES ARE 45° UNLESS NOTED OTHERWISE.

B2


Features:	
Drawn By: AM	Rev By: CJA AW EB
Date: 12/2/2024	

Russell B
Genesis Series
v.03.03.00.00
GARAGE LEFT

1st Floor.....	1089
2nd Floor.....	1430
Alternate 2nd Floor.....	1434
Garage.....	393
Front Porch.....	80
Covered Porch Option.....	120
3rd Car Garage Option.....	220


B Square Footages:



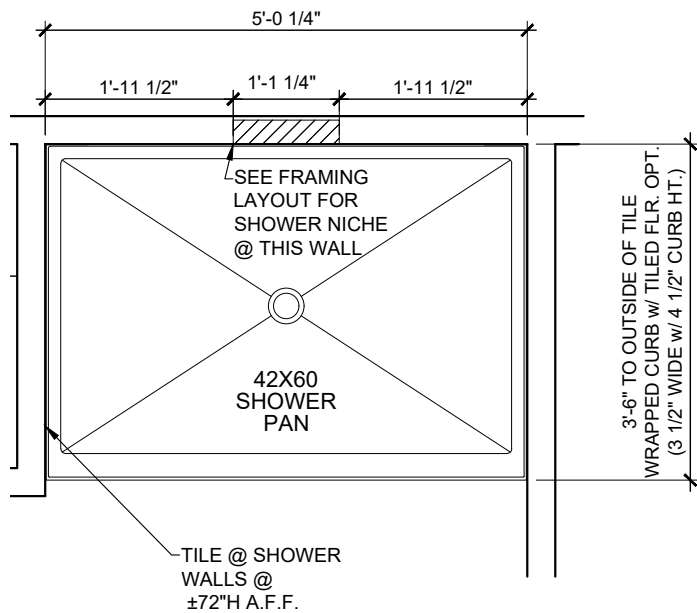


FLOOR PLAN
SCALE: 1/2" = 1'-0"


NOTE: THIS DETAIL IS NOT PLAN SPECIFIC, BUT SHOULD MATCH THE SHOWER ORIENTATION ON EACH PLAN SET.

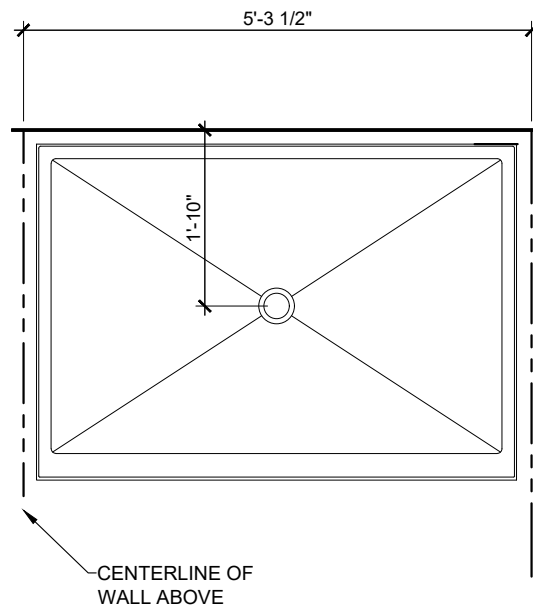

FOUNDATION INFORMATION
SCALE: 1/2" = 1'-0"

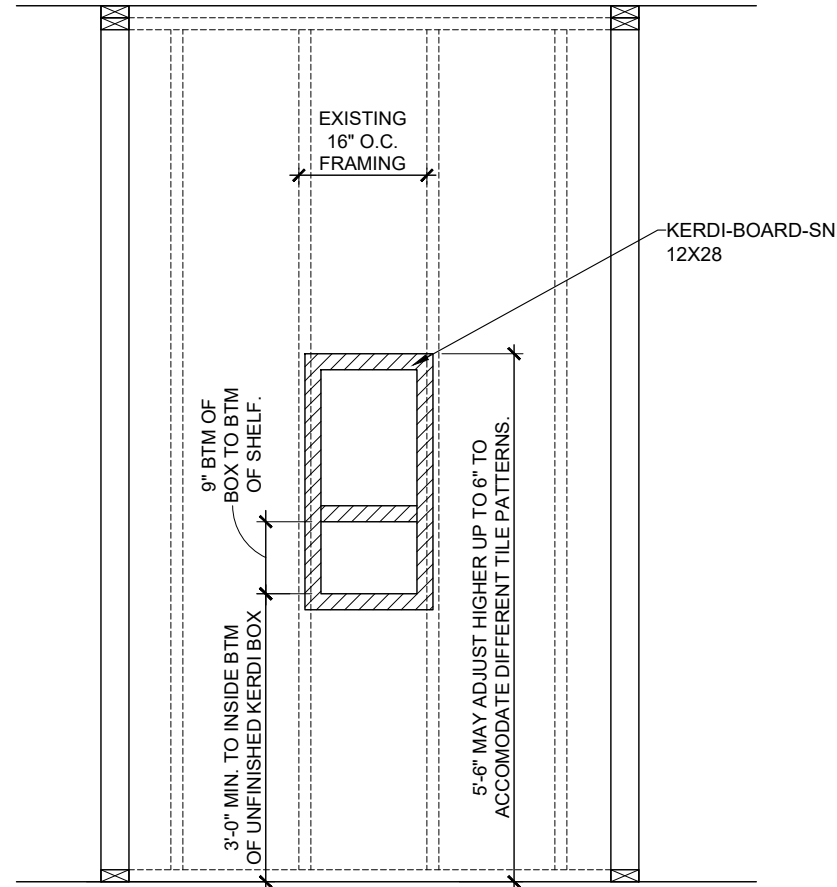


ELEVATION VIEW

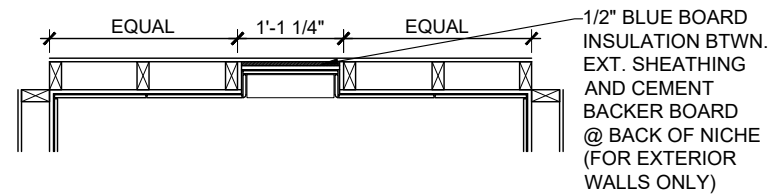

PLAN VIEW

KERDI SHOWER NICHE DETAIL
SCALE: 1/2" = 1'-0"

- NOTES:
- 1. SEE ENGINEERING FOR STRUCTURAL INFORMATION
 - 2. CONTROL JOINTS
 - PROVIDE CONTROL JOINTS AT ALL INSIDE CORNERS OF SLAB EDGES, AND OTHER LOCATIONS WHERE SLAB CRACKS ARE LIKELY TO DEVELOP.
 - JOINTS SHALL BE LOCATED @ 10'-0" O.C. (RECOMMENDED) OR 15'-0" O.C. (MAXIMUM).
 - JOINT GRID PATTERN SHALL BE AS CLOSE TO SQUARES AS POSSIBLE (1:1 RATIO), WITH A MAXIMUM OF 1:1.5 RATIO.
 - CONTROL JOINTS SHALL NOT BE INSTALLED IN STRUCTURAL SLABS.

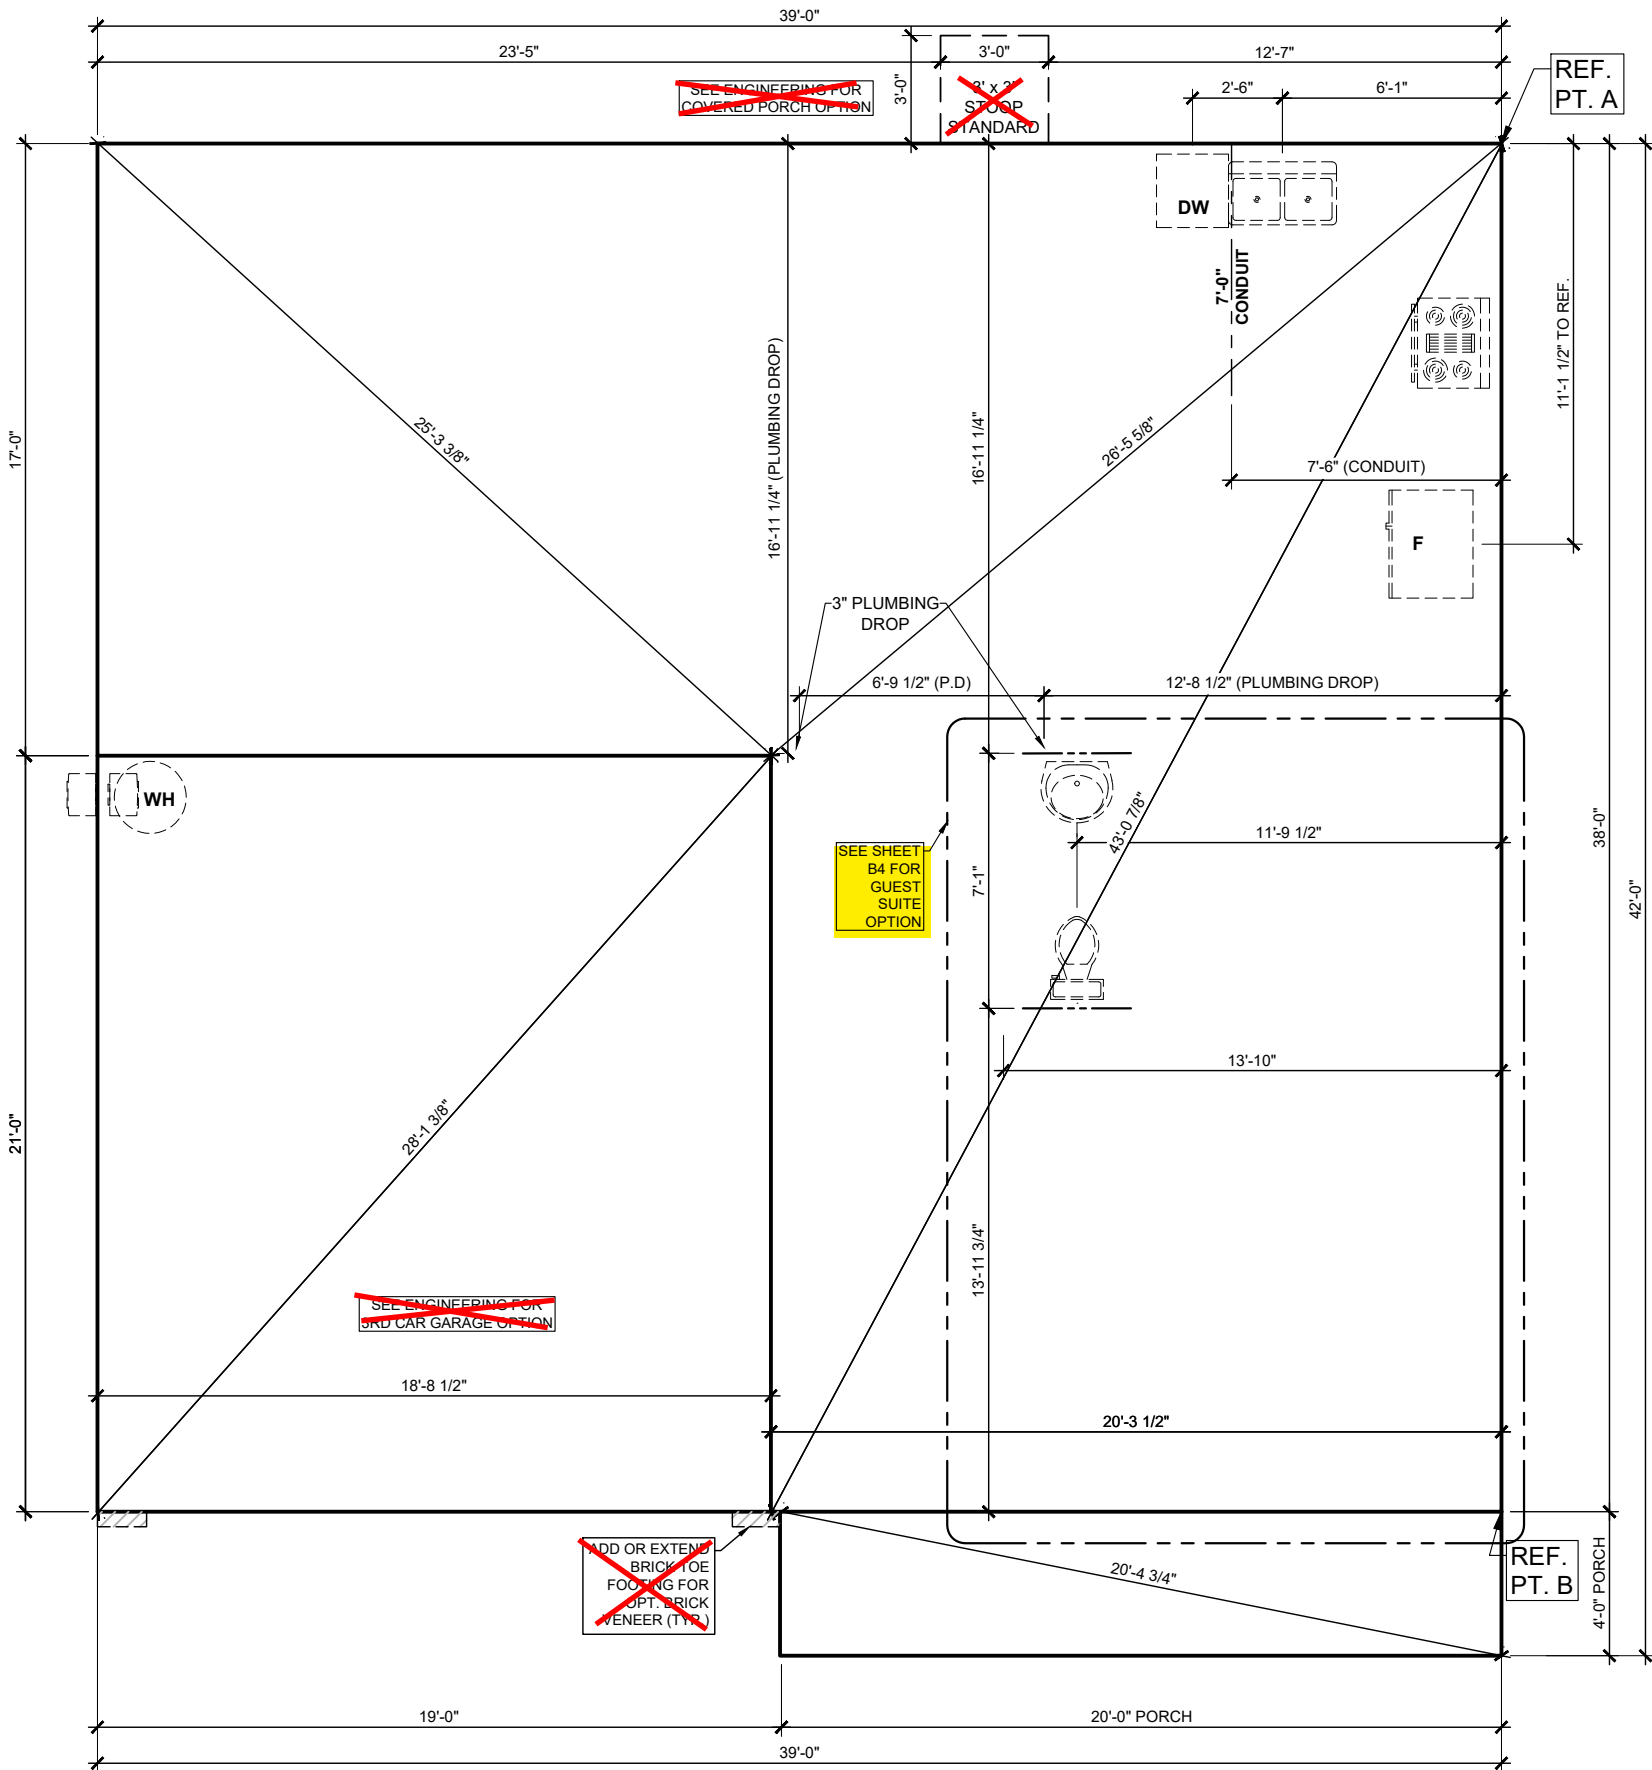

FOUNDATION INFORMATION SHEET
3/16" = 1'-0"

B3

Features:
FOUNDATION INFO. SHEET

Drawn By: AM
Date: 12/2/2024

Rev By:
CJA AW EB


Russell B
Genesis Series
v.03.03.00.00

GARAGE LEFT


1st Floor.....	1089
2nd Floor.....	1430
Alternate 2nd Floor.....	1434
Garage.....	393
Front Porch.....	80
Covered Porch Option.....	120
3rd Car Garage Option.....	220

B Square Footages:




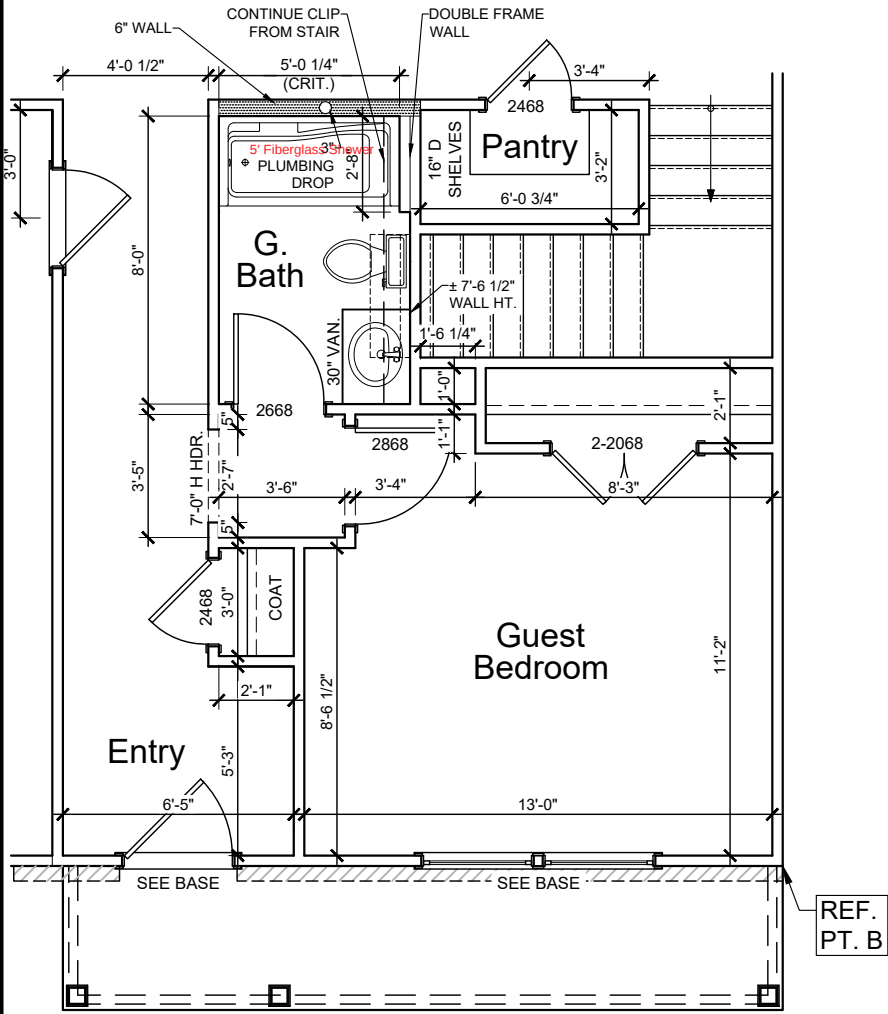

FLOOR PLAN
3/16" = 1'-0"

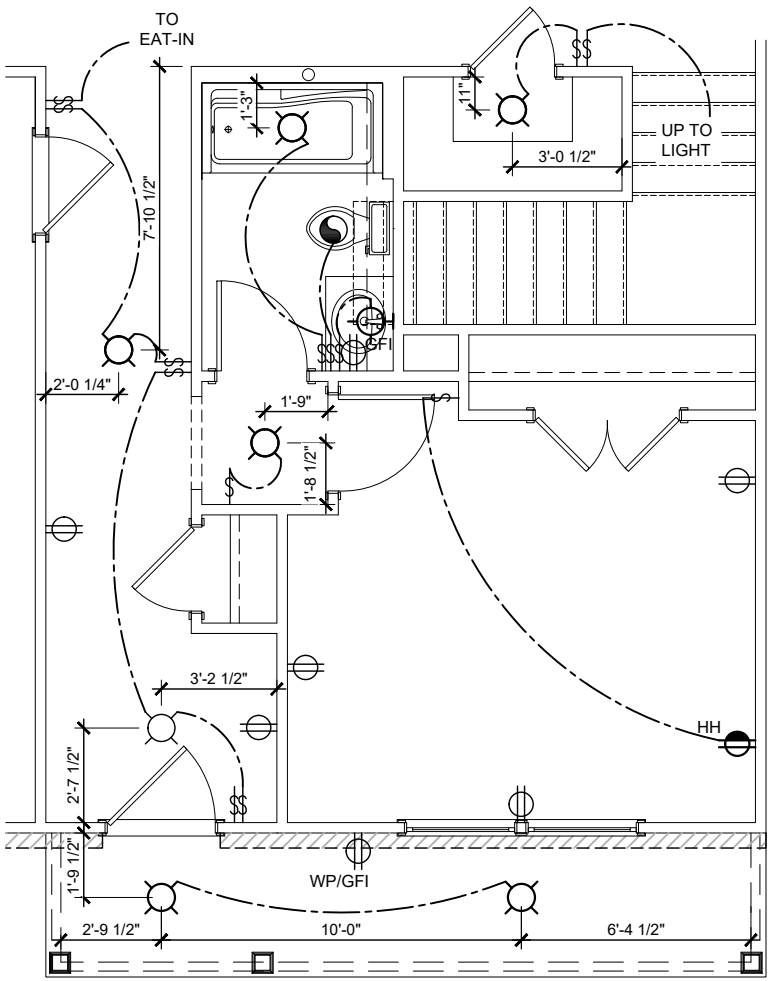

ELECTRICAL
3/16" = 1'-0"

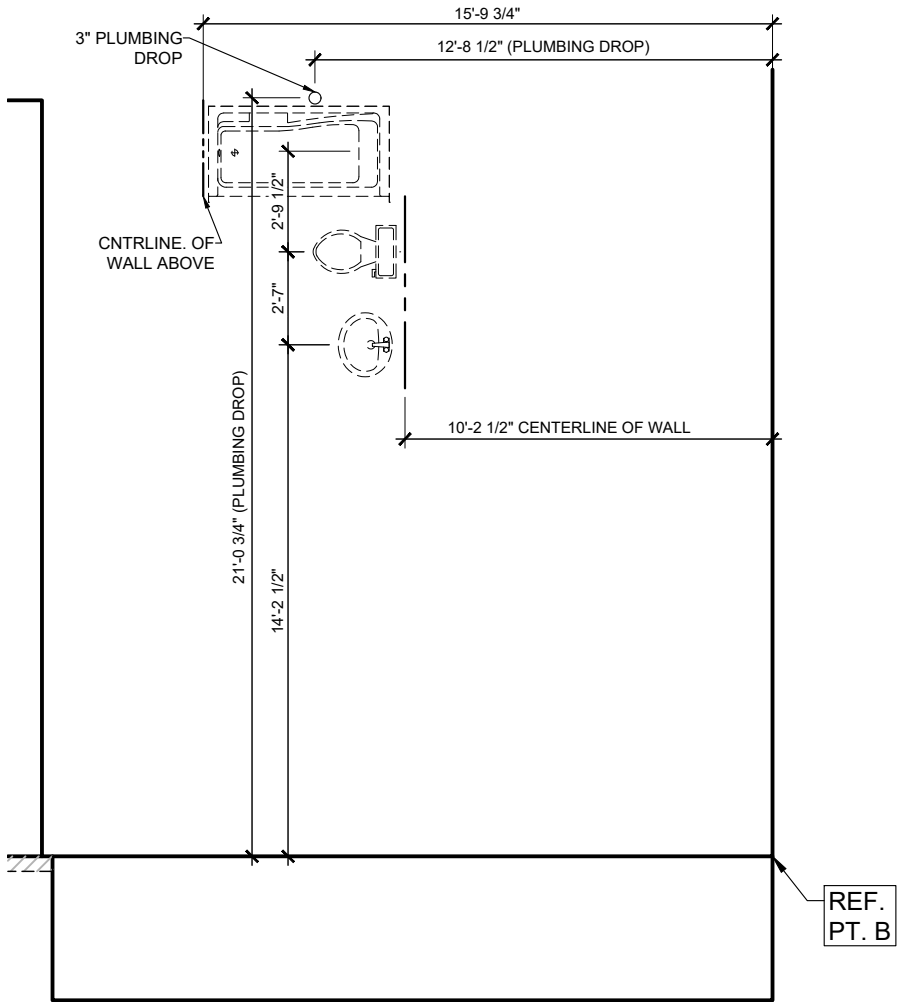

FOUNDATION INFORMATION
3/16" = 1'-0"

GUEST SUITE OPTION

- NOTES:
1. SEE ENGINEERING FOR FRAMING & FOUNDATION INFORMATION
2. 8 FT. CEILING HEIGHTS U.N.O.
3. WINDOW HEIGHTS VARY - FOLLOW ELEVATIONS CAREFULLY.
4. ALL ANGLES ARE 45° UNLESS NOTED OTHERWISE.

B4

Features:

Drawn By: AM

Rev By:
CJA AW EB

Date: 12/2/2024

Russell B


Genesis Series
v.03.03.00.00

GARAGE LEFT


1st Floor.....	1089
2nd Floor.....	1430
Alternate 2nd Floor.....	1434
Garage.....	393
Front Porch.....	80
Covered Porch Option.....	120
3rd Car Garage Option.....	220

B Square Footages:




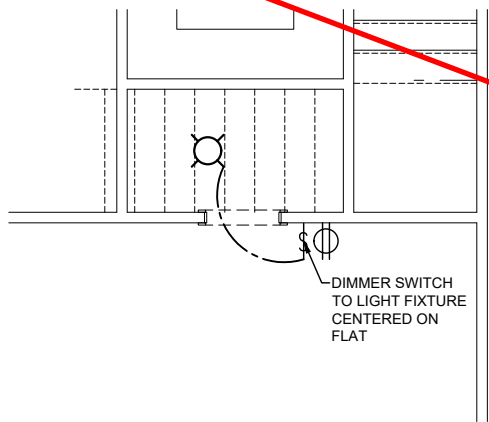

Pet Pad Option
FIRST FLOOR 3/16" = 1'-0"

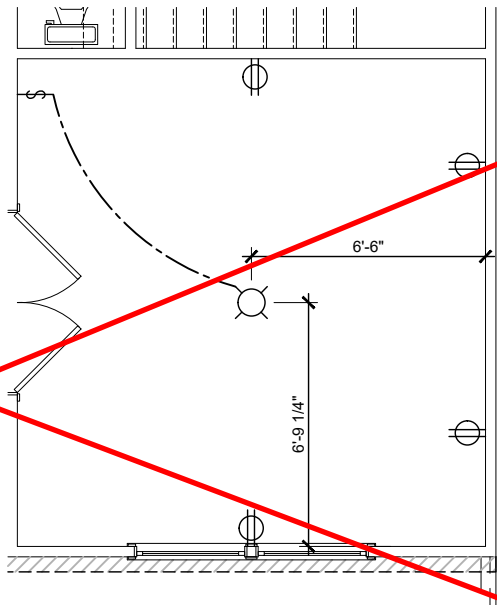

Office Option
3/16" = 1'-0"

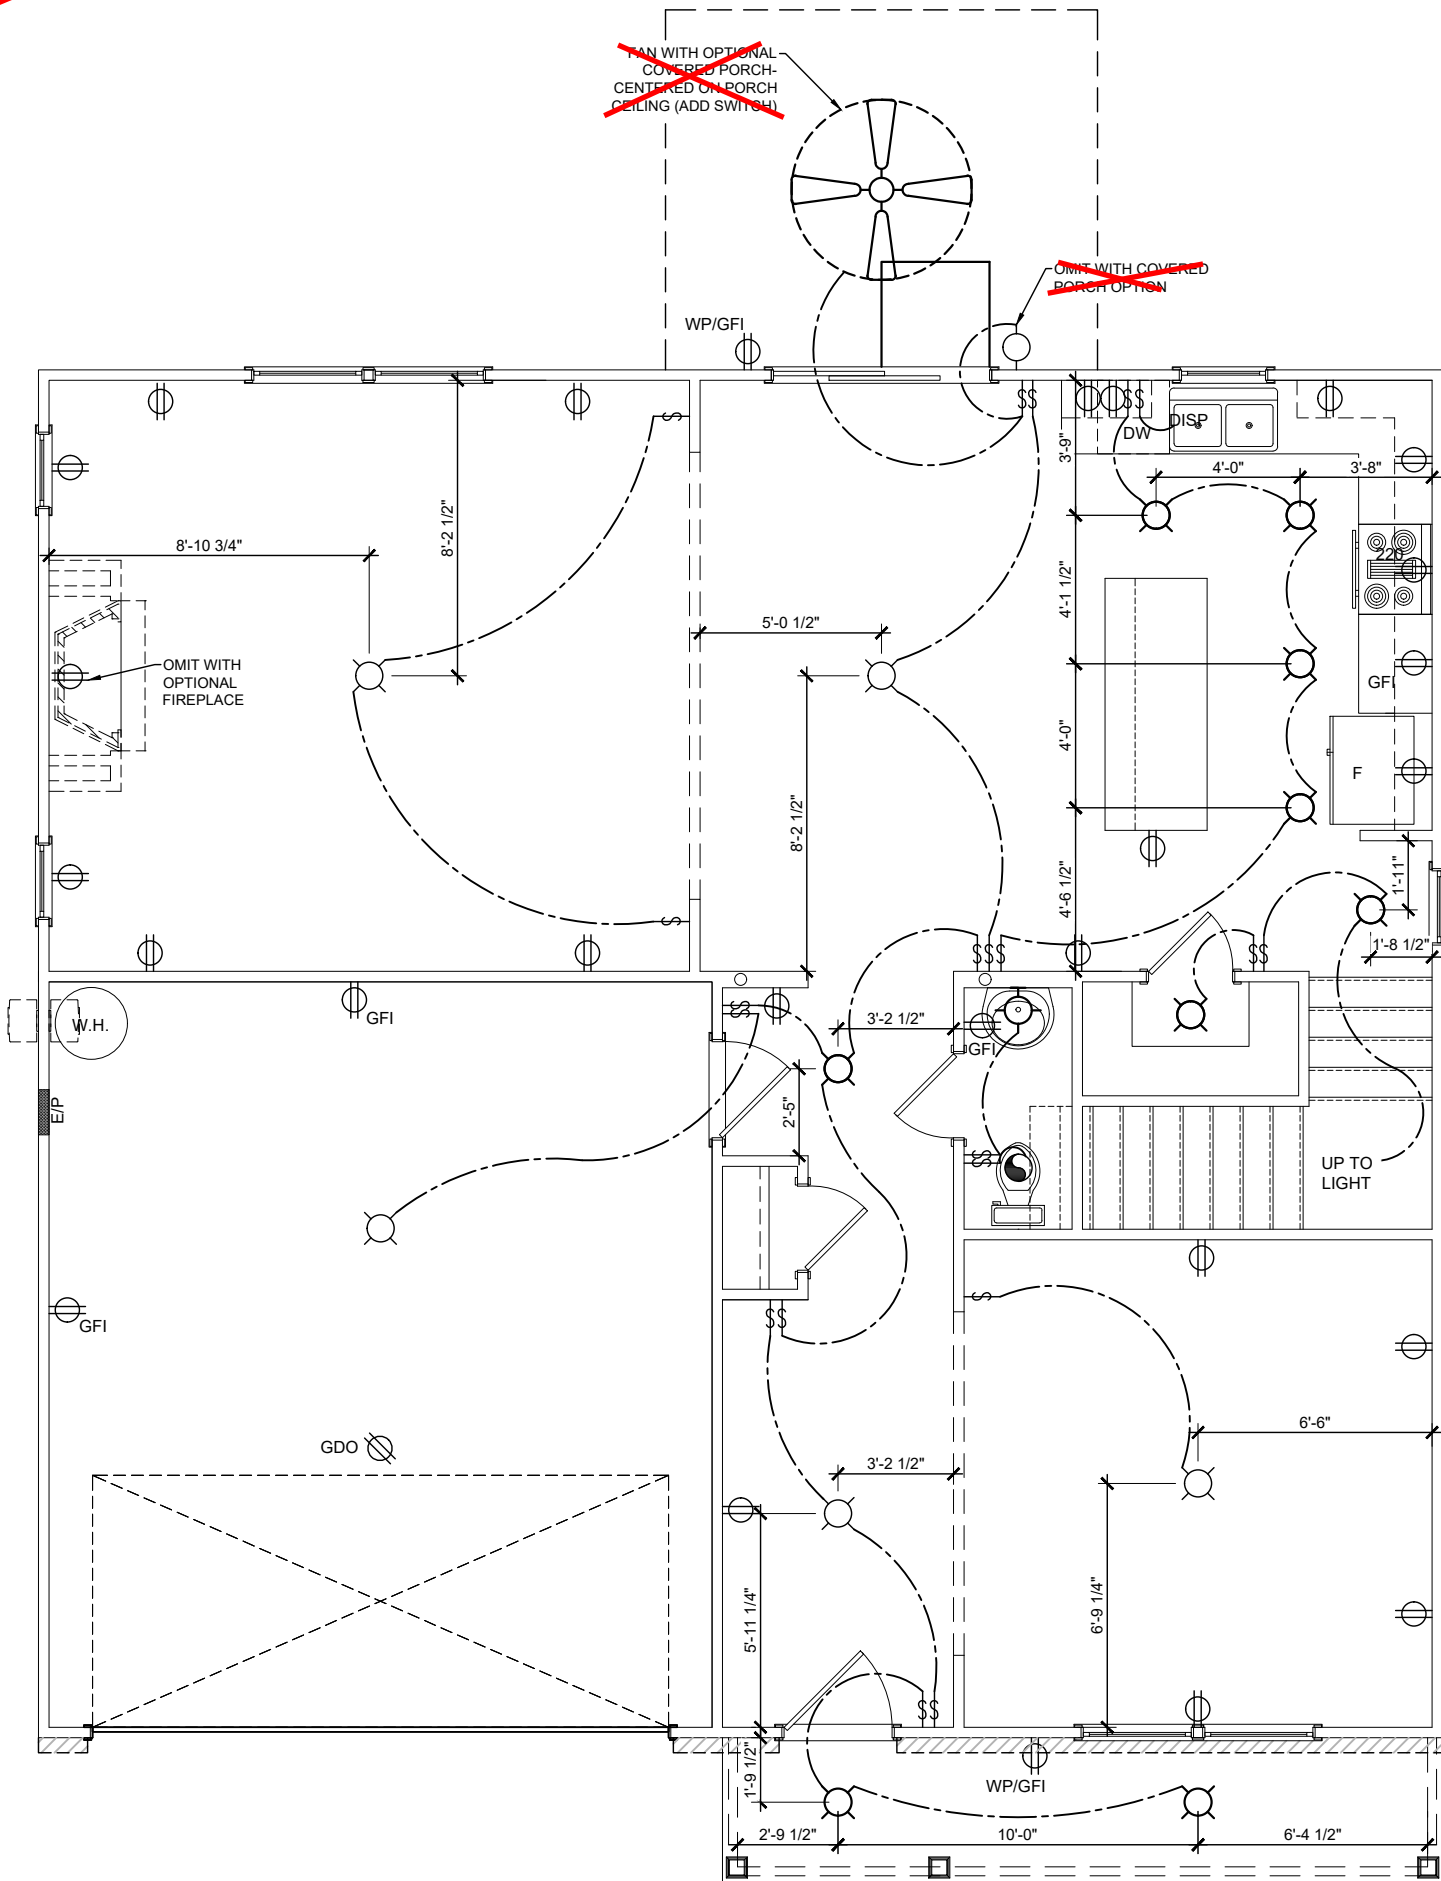

FIRST FLOOR - ELECTRICAL
3/16" = 1'-0"

E1


Features:	
Drawn By: AM	Rev By: CJA AW EB
Date: 12/2/2024	

Russell B
Genesis Series
v.03.03.00.00
GARAGE LEFT


1st Floor.....	1089
2nd Floor.....	1430
Alternate 2nd Floor.....	1434
Garage.....	393
Front Porch.....	80
Covered Porch Option.....	120
3rd Car Garage Option.....	220

B Square Footages:




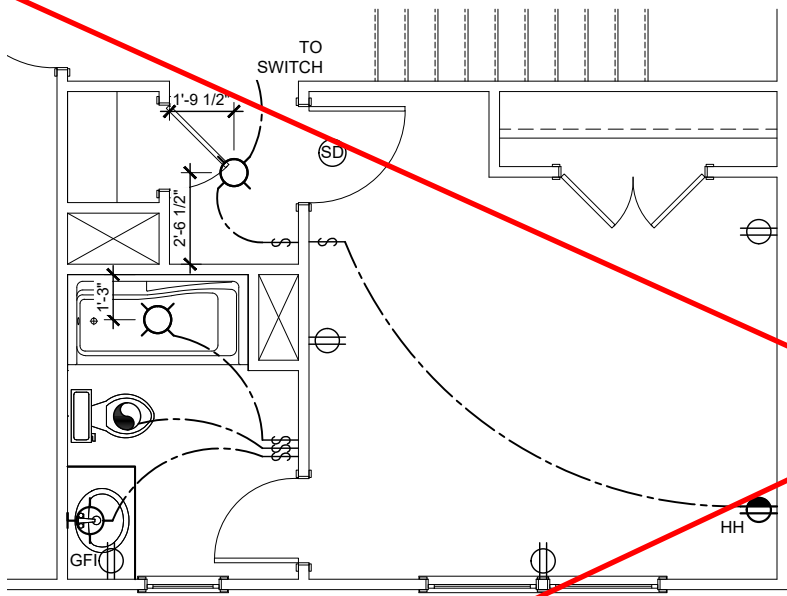


Guest Suite #2 Option
3/16" = 1'-0"
(*NOT AVAILABLE w/ ALT. 2ND FLOOR OPTIONS)

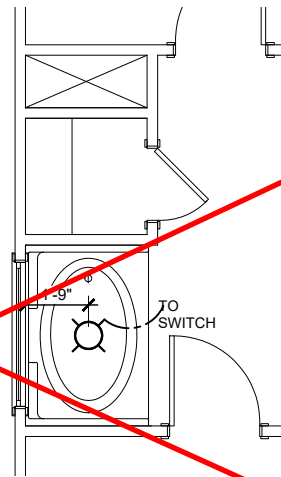

**42" Garden Tub w/
Shower Walls Opt.**
3/16" = 1'-0" @ PR. BATH

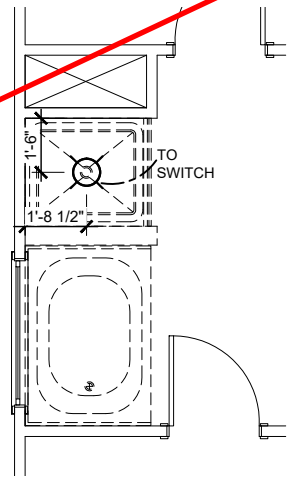

**Tub/ Shower
Option**
FOR ORIENTATION PURPOSES ONLY
@ PRIMARY BATH @ 2ND FLOOR

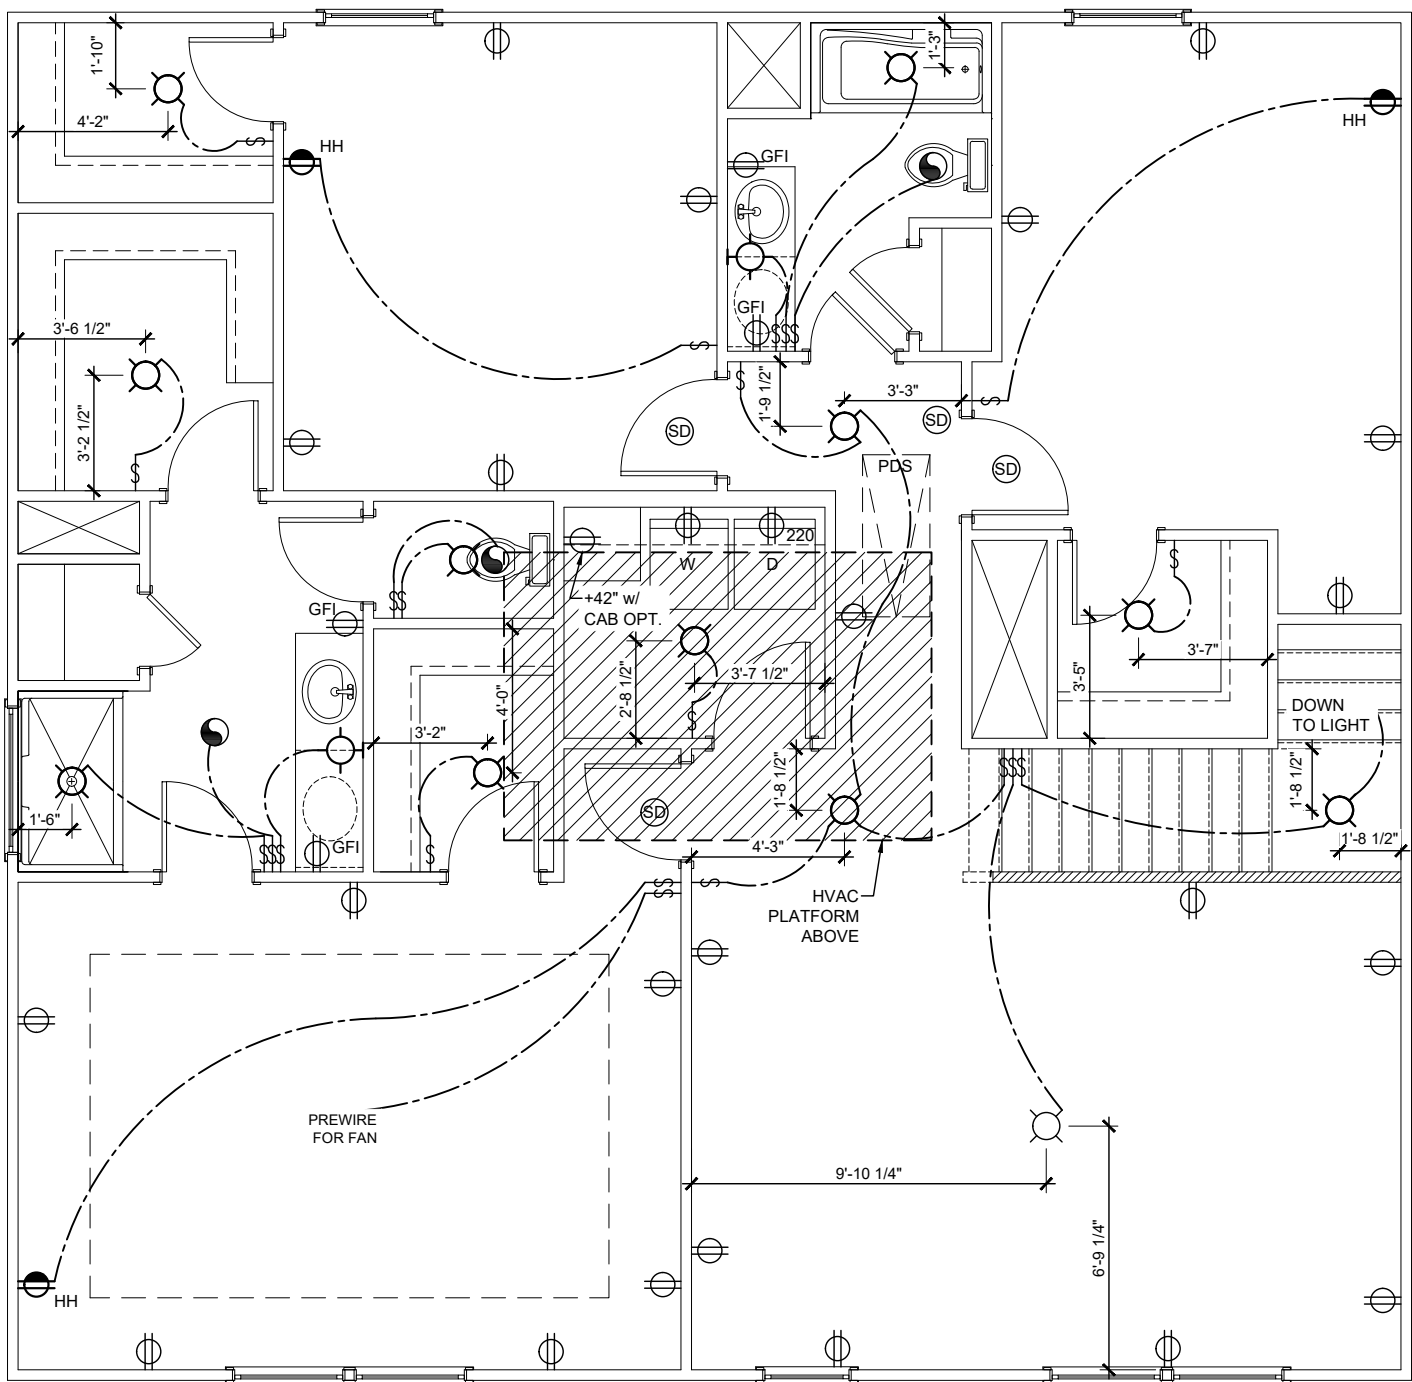

SECOND FLOOR - ELECTRICAL
3/16" = 1'-0"

E2

Features:

Drawn By: AM

Rev By:
CJA AW EB

Date: 12/2/2024

Russell B

Genesis Series
v.03.03.00.00

GARAGE LEFT

1st Floor.....	1089
2nd Floor.....	1430
Alternate 2nd Floor.....	1434
Garage.....	393
Front Porch.....	80
Covered Porch Option.....	120
3rd Car Garage Option.....	220

B Square Footages:



CONNECTION SPECIFICATIONS (TYP. U.N.O.)

DESCRIPTION OF BLDG. ELEMENT	3"x0.131" NAILS	3"x0.120" NAILS
JOIST TO SOLE PLATE	(3) TOENAILS SOLE PL. TO JOIST/RIM OR BLK'G NAILS @ 6" o.c.	(3) TOENAILS* NAILS @ 4" o.c.
STUD TO PLATE	(4) TOENAILS/ (3)END NAILS	(4) TOENAILS/ (4)END NAILS*
RIM TO TOP PLATE	TOENAILS @ 6" o.c.	TOENAILS @ 4" o.c.*
BLK'G, BTWN. JOISTS TO TOP PL.	(3) TOENAILS EA. END	(3) TOENAILS EA. END*
DOUBLE STUD	NAILS @ 16" o.c.	NAILS @ 16" o.c.
DOUBLE TOP PLATE	NAILS @ 12" o.c.	NAILS @ 8" o.c.
DOUBLE TOP PLATE LAP SPLICE	(12) NAILS IN LAPPED AREA (24" MIN.)	(15) NAILS IN LAPPED AREA (24" MIN.)
TOP PLATE LAP @ CORNERS & ADJACENT FULL-HEIGHT STUD TO END OF HEADER	(3) NAILS	(3) NAILS
ADJACENT FULL-HEIGHT STUD TO END OF HEADER	(4) NAILS	(4) NAILS
RAFTER/TRUSS TO TOP PLATE	(4) TOENAILS + (1) SIMPSON H25T	(4) TOENAILS + (1) SIMPSON H25T
GAB. END TRUSS TO DBL. TOP PL. R.T. w/ HEEL HT. 9 1/4" TO 12"	TOENAILS @ 8" o.c. 2x10 BLK EVERY 3RD BAY FASTENED TO DBL. TOP PLATE w/ TOENAILS @ 6" o.c.	TOENAILS @ 6" o.c. 2x10 BLK EVERY 3RD BAY FASTENED TO DBL. TOP PLATE w/ TOENAILS @ 4" o.c.
R.T. w/ HEEL HT. 12" TO 16"	2x12 BLK EVERY 3RD BAY FASTENED TO DBL. TOP PLATE w/ TOENAILS @ 6" o.c.	2x12 BLK EVERY 3RD BAY FASTENED TO DBL. TOP PLATE w/ TOENAILS @ 4" o.c.
R.T. w/ HEEL HT. UP TO 24"	LAP WALL SHTG. w/ DBL. TOP PL. & INSTALL ON TRUSS VERT. - FASTEN w/ NAILS @ 6" o.c.	LAP WALL SHTG. w/ DBL. TOP PL. & INSTALL ON TRUSS VERT. - FASTEN w/ NAILS @ 6" o.c.*
R.T. w/ HEEL HT. 24" TO 48"	LAP WALL SHTG. w/ DBL. TOP PL. & INSTALL ON TRUSS VERT. - FASTEN w/ NAILS @ 6" o.c. PROVIDE 2x BLK @ EA. BAY AT TOP OF HEEL	LAP WALL SHTG. w/ DBL. TOP PL. & INSTALL ON TRUSS VERT. - FASTEN w/ NAILS @ 6" o.c. PROVIDE 2x BLK @ EA. BAY AT TOP OF HEEL*
WALL TO FOUNDATION	WALL SHTG. LAP w/ SILL PL. & FASTENED PER SHEAR WALL FASTENING SPEC.	

* 2 1/2"x0.113 IS AN ACCEPTABLE ALTERNATIVE TO A 3"x0.120", SAME SPACING OR NUMBER OF NAILS.
ONLY ACCEPTABLE WHERE * ARE SHOWN

VENEER LINTEL SCHEDULE

SPAN (MAX)	HEIGHT OF VENEER ABOVE LINTEL	STEEL ANGLE SIZE
3'-0"	20 FT. MAX	L3"x3"x 1/4"
6'-0"	3 FT. MAX	L3"x3"x 1/4"
	12 FT. MAX	L4"x3"x 1/4"
8'-0"	20 FT. MAX	L5"x3 1/2"x 3/8"
	3 FT. MAX	L4"x4"x 1/4" *
12'-0"	12 FT. MAX	L5"x3 1/2"x 3/8"
	16 FT. MAX	L6"x3 1/2"x 3/8"
9'-6"	12 FT. MAX	L6"x3 1/2"x 3/8"
16'-0"	2 FT. MAX	L7"x4"x 1/2" **
	3 FT. MAX	L8"x4"x 1/2" **

ALL LINTELS:
- SHALL SUPPORT 2 3/8" - 3 1/2" VENEER w/ 40 psf
MAXIMUM WEIGHT.
-> 16" SHALL HAVE 4" MIN. BEARING
-> 16" SHALL HAVE 8" MIN. BEARING
-> 16" SHALL NOT BE FASTENED BACK TO HEADER.
-> 16" SHALL BE FASTENED BACK TO WOOD HEADER
IN WALL @ 48" o.c. w/ 1/2" DIA. x 3 1/2" LONG LAG
SCREWS IN 2" LONG VERTICALLY SLOTTED HOLES.
- MAX VENEER HT. APPLIES TO ANY PORTION OF
BRICK OVER THE OPENING.
- ALL LINTELS SHALL BE LONG LEG VERTICAL.
- WHEN SUPPORTING VENEER < 3" WIDE THE EXTERIOR
TOE OF THE HORIZONTAL LEG MAY BE CUT IN THE
FIELD TO BE 3 1/2" WIDE OVER THE BEARING
LENGTH ONLY. THIS IS TO ALLOW FOR MORTAR
JOINT FINISHING.
- SEE STRUCTURAL PLANS FOR ANY LINTEL
CONDITION NOT ENCOMPASSED BY THE ABOVE
PARAMETERS. FOR ANY LINTEL FASTENED BACK
TO BEAM, FASTENERS SHALL MAINTAIN A 2 1/2"
(MINIMUM) CLEAR DISTANCE FROM BOT. OF BEAM.
** FOR QUEEN VENEER USE L4x3 1/4".
*** FOR 3/4" VENEER ONLY. SEE PLAN FOR VENEER
SUPPORT IF VENEER < 3/2" THICK.

NON-BEARING HEADER SCHEDULE

SPAN	2x4 NON-BEARING PARTITION WALL	2x6 NON-BEARING PARTITION WALL
UP TO 3'-0"	(1)2x4 FLAT	(1)2x6 FLAT
UP TO 6'-0"	(2)2x4	(3)2x4
UP TO 8'-0"	(2)2x6	(3)2x6
UP TO 12'-0"	(2)2x10	(2)2x10

LEGEND

- INTERIOR BEARING WALL
- BEARING WALL ABOVE (B.W.A.) -AND/OR-
SHEAR WALL ABOVE (S.W.A.)
- BEAM / HEADER
- EXTENT OF OVERFRAMING (O.F.)
- EXTENT OF TILE OVER FLOOR
- EXTENT OF BRACING PANELS/SHEARWALL
w/ ADD'L CONNECTION REQUIREMENTS
- INDICATES HOLD-DOWN OR STRAP.
REFER TO SCHEDULE.
- METAL HANGER
- INDICATES POST ABOVE (P.A.) PROVIDE
SOLID BLOCKING UNDER POST OR JAMB
ABOVE.

MEANS & METHODS NOTES

THE STRUCTURE IS DESIGNED TO BE SELF SUPPORTING
AND STABLE AFTER THE BUILDING IS FINISHED AND
ALL PLAN, DETAIL, AND NOTE SPECIFICATIONS HAVE
BEEN COMPLETED. IT IS THE CONTRACTOR'S SOLE
RESPONSIBILITY TO DETERMINE THE ERECTION
PROCEDURES AND SEQUENCE TO INSURE THE SAFETY
OF THE BUILDING AND ITS COMPONENTS DURING
CONSTRUCTION. THIS INCLUDES, BUT IS NOT LIMITED TO,
THE ADDITION OF NECESSARY SHORING, SHEETING,
TEMPORARY BRACING, GUYS, AND TIE-DOWNS.
CONTRACTOR SHALL BE RESPONSIBLE FOR ALL
SHORING AND BRACING REQUIRED TO STABILIZE AND
PROTECT EXISTING AND ADJACENT STRUCTURES AND
SYSTEMS DURING COURSE OF DEMOLITION AND
CONSTRUCTION OF THE PROJECT.

STRUCTURAL DESIGN AND SPECIFICATIONS ASSUME
THAT ALL SUPPORTING AND NON-SUPPORTING ELEMENTS
IN CONTACT WITH FLOOR FRAMING ARE LEVEL,
INCLUDING, BUT NOT LIMITED TO; FOUNDATIONS, SLABS
ON GRADE, BEAMS, WALLS, AND NON-BEARING
ELEMENTS. IT IS THE CONTRACTOR'S RESPONSIBILITY
TO VERIFY LEVELNESS AND MAKE ADJUSTMENTS AS
NECESSARY, INCLUDING CONSIDERATION OF THOSE
AREAS THAT MAY BE WITHIN CONTRACTUAL, INDUSTRY,
OR WARRANTY TOLERANCES.

GENERAL STRUCTURAL NOTES

FOUNDATION

- DESIGN IS BASED ON 2018 NORTH CAROLINA STATE RESIDENTIAL
CODE.
- FOOTING DESIGN - 2,000 PSF ALLOWABLE SOIL BEARING
PRESSURE IS ASSUMED. BUILDER/CONTRACTOR MUST VERIFY.
- FASTEN 2x4/6 SILL PLATES TO CONC. FND WITH A MINIMUM OF 2
ANCHORS PER PLATE, 12" MAX. FROM PLATE ENDS - UTILIZING:
 - 1/2" DIA. ANCHOR BOLTS @ 6'-0" O.C. w/ 1" MIN. EMBEDMENT
OR SIMPSON MASA ANCHORS @ 6'-0" O.C.
 - SIMPSON STRONG-BOLT 2 WEDGE ANCHOR (STB2-50100
- 1/2" @ x 7") MAY BE USED IN PLACE OF ANCHOR BOLTS
@ INTERIOR THICKENED SLABS ONLY.
- ALL LUMBER EXPOSED TO WEATHER OR IN CONTACT w/ PERIMETER
FOUNDATION SHALL BE PRESERVATIVE TREATED SOUTHERN PINE #2.
- FOUNDATION WALLS & FOOTINGS SHALL BE PLAIN CONCRETE, U.N.O.
- CONCRETE DESIGN BASED ON ACI 318. CONCRETE SHALL ATTAIN THE
FOLLOWING MIN. COMPRESSIVE STRENGTHS IN 28 DAYS, U.N.O.:
F_c = FOUNDATION WALLS (SEE FOUNDATION DETAILS)
2,500 psi: FOOTINGS @ INTERIOR SLABS ON GRADE
3,000 psi: GARAGE & EXTERIOR SLABS ON GRADE
f_y = 60,000 psi
- TYPICAL REINFORCEMENT DETAILS: PROVIDE 3" MIN. CLEAR
COVER WHERE CAST AGAINST EARTH, 1 1/2" MIN. CLEAR COVER
AGAINST FORMS. LAP ALL REBAR 48 BAR DIAMETERS MIN. (24"
FOR #4 BARS) & BEND BARS AND LAP AT CORNERS. PROVIDE 6"
HOOK INTO SUPPORTING FOOTINGS WHEN FOOTINGS INTERSECT.
- ALL CONCRETE EXPOSED TO THE WEATHER SHALL NOT HAVE LESS
THAN 5% OR MORE THAN 1% AIR ENTRAINMENT.
- ALL FOOTINGS SHALL BEAR BELOW FROST LINE (TYP.) OR 12" MIN IN
REGIONS WHERE CODE FROST DEPTH IS NOT APPLICABLE. CONSULT
SOILS REPORT OR BUILDING DEPT. FOR MINIMUM DEPTH BELOW
GRADE.
- FOOTINGS AND SLABS ON GRADE SHALL BEAR ON VIRGIN SOIL
OR 95% COMPACTED FILL. (U.N.O.)
- PROVIDE CONTROL JOINTS AT ALL INSIDE CORNERS OF SLAB
EDGES, AND OTHER LOCATIONS WHERE SLAB CRACKS ARE LIKELY
TO DEVELOP.
 - JOINTS SHALL BE LOCATED @ 10'-0" O.C. (RECOMMENDED) OR
15'-0" O.C. (MAXIMUM)
 - JOINT GRID PATTERN SHALL BE AS CLOSE TO SQUARES AS
POSSIBLE (1:1 RATIO), WITH A MAXIMUM OF 1:1.5 RATIO
 - CONTROL JOINTS SHALL NOT BE INSTALLED IN STRUCTURAL
SLABS

- DIMENSIONS BY OTHERS, BUILDER TO VERIFY.
- BUILDER TO PROVIDE SUBTERRANEAN TERMITE PROTECTION
MEETING THE REQUIREMENTS OF R318 OR LOCAL CODE
REQUIREMENTS
- CRAWLSPACE/BASEMENT WALLS SHALL BE BRACED, PRIOR TO
BACKFILLING, BY EITHER ADEQUATE TEMPORARY BRACING OR
INSTALLATION OF FIRST FLOOR DECK.
- CRAWLSPACE/BASEMENT WALL DESIGN IS BASED ON BACKFILL
SOIL CLASSIFICATIONS OF GM, GP, SM, SP (30 pcft) OR GM, GC, SM,
SM-SC, ML (45 pcft). IF SC, ML-CL, OR CL (60 pcft) SOIL IS
ENCOUNTERED ON SITE, CONTACT MULHERN & KULP FOR FURTHER
EVALUATION OF FOUNDATION DESIGN.
- CONCRETE MASONRY UNITS (CMU) SHALL BE ASTM C40 WITH A MIN.
COMPRESSIVE STRENGTH OF 1900 psi (F_m=1500 psi). MORTAR SHALL
BE ASTM C210, TYPE S. CMU DESIGN PER TMS 402/602.
- CMU FOUNDATION WALLS SHALL HAVE 'DUR-O-WALL' HORIZONTAL
JOINT REINFORCEMENT (OR EQUAL) - 1 GA. MINIMUM @ 16" O.C.
- PROVIDE 2x8 x 16" LONG P.T. PLATE ON TOP OF ALL CRAWL SPACE
PIERS. TOP COURSE OF PIERS SHALL BE SOLID MASONRY OR
FILLED SOLID.
- PROVIDE 2x6 P.T. PLATE ON INTERIOR CRAWL SPACE WALLS,
FASTENED PER ANCHORAGE SPECIFICATION NOTED ABOVE.
- BASEMENT FOUNDATION WALL DESIGN BASED ON:
 - 9' OR 10' HEIGHT (SEE PLAN)
 - ACTUAL WALL WIDTHS ASSUMED FOR DESIGN,
NOMINAL WIDTHS SHALL NOT BE USED.
- PROVIDE (2) #5 BARS AROUND ALL SIDES OF OPENINGS IN
CONCRETE BSMT. FND. WALL WITH 2" CLEAR. REINFORCEMENT
SHALL EXTEND 12" PAST CORNER OF OPENING IN ALL DIRECTIONS.
 - FOR OPENINGS UP TO 36", PROVIDE MINIMUM 10" CONCRETE
DEPTH OVER OPENING OR (3)2x10 w/ (2)2x6 JACK STUDS, U.N.O.
 - LARGER OPENINGS SHALL BE PER PLAN.

EXTERIOR & SHEAR WALL
SHEATHING SPECIFICATIONS

THIS MODEL HAS BEEN DESIGNED TO RESIST
LATERAL FORCES RESULTING FROM:
115 MPH WIND IN 2018 NCSCB:RC
(115 MPH WIND SPEED IN ASCE 7-10
WIND MAP, PER NCSCB R301.2.1.1)
EXP. B @ SEISMIC CAT. A/B.
THE ENGINEERED DESIGN WAS COMPLETED PER
2015 IBC (SECTION 1604) & ASCE 7-10,
AS PERMITTED BY R301.1.3 OF THE 2018 NCSCB.

DESIGN WIND UPLIFT LOADS HAVE BEEN
CALCULATED UTILIZING ASCE 7-10 (ACCEPTED
ENGINEERING PRACTICE) AS ALLOWED PER 2018
NCSCB:RC SECTION R802.11.1.1. THIS MODEL HAS
BEEN DETAILED WHERE REQUIRED & ENGINEERED
TO RESIST THE WIND UPLIFT LOAD PATH PER
SECTIONS R602.3.5 & R802.11.

EXT. WALL SHEATHING SPECIFICATION

- 7/16" OSB OR 15/32" PLYWOOD: FASTEN SHEATHING w/ 2 3/8"x0.113 NAILS @ 6" O.C. AT
EDGES @ 12" O.C. IN THE PANEL FIELD. (TYP. U.N.O.)
- ALL SHEATHING PANELS SHALL BE ORIENTED
VERTICALLY (LONG DIRECTION PARALLEL TO STUDS)
AND INSTALLED FULL HEIGHT OF SHEAR WALL - OR-
2x HORIZONTAL BLOCKING SHALL BE PROVIDED TO
SUPPORT ALL UNSUPPORTED PANEL EDGES & EDGE
FASTENING.
- ALL EXT. WALLS SHALL BE CONTINUOUSLY SHEATHED
AND ARE CONSIDERED SHEAR WALLS.

3" O.C. EDGE NAILING

- AT DESIGNATED AREAS - FASTEN PANEL EDGES OF
WOOD STRUCTURAL WALL SHEATHING TO FRAMING w/
2 3/8" x 0.113" NAILS @ 3" O.C. NO STAPLE ALTERNATIVE
AVAILABLE AT THIS SPEC. ALL SHEATHING PANELS
SHALL BE ORIENTED VERTICALLY (LONG DIRECTION
PARALLEL TO STUDS) AND INSTALLED FULL HEIGHT OF
SHEAR WALL - OR - 2x HORIZONTAL BLOCKING
SHALL BE PROVIDED TO SUPPORT UNSUPPORTED
PANEL EDGES AND 3" O.C. EDGE FASTENING.

NOTES

- SEE CONNECTION SPECIFICATIONS CHART FOR
STANDARD SHEAR TRANSFER DETAILING. IF
ADDITIONAL CAPACITY IS REQUIRED BY DESIGN,
IT WILL BE SPECIFICALLY NOTED ON PLAN.
- REFER TO DETAIL SHEET.
- "NUMBERED" DETAILS ARE REFERENCED ON PLAN.
- DESIGN ASSUMES 16" O.C. MAX. STUD SPACING, U.N.O.
- DESIGN ASSUMES ALL INTERIOR SHEAR WALLS AND
EXTERIOR WALLS ARE CONTINUOUS SHEATHED ABOVE
AND BELOW OPENINGS.
- WHERE PANELS ARE APPLIED TO BOTH FACES OF
WALL, PANEL JOINTS SHALL BE OFFSET TO FALL ON
DIFFERENT FRAMING MEMBERS.
- ALL STRUCTURAL PANELS ARE TO BE DIRECTLY
APPLIED TO STUD FRAMING.
- PRE-MANUFACTURED PANELIZED WALLS:
FASTEN TOGETHER END STUDS OF WALL PANELS
SHEATHED w/ OSB OR PLYWOOD AS FOLLOWS:
P1 SHEAR PANELS - 3" x 0.120" NAILS @ 6" o.c.
P3 SHEAR PANELS - 3" x 0.120" NAILS @ 4" o.c.

INDICATES LOCATION AND EXTENT OF
SHEARWALL WHICH REQUIRES SHEATHING
AND/ OR FASTENING SPECIFICATIONS
BEYOND THAT OF STANDARD
CONSTRUCTION

GENERAL STRUCTURAL NOTES

FLOOR FRAMING

- TRUSSES SHALL BE DESIGNED BY MANUF. TO MEET OR EXCEED
L/480 LIVE LOAD DEFLECTION CRITERIA. (EXCLUDES
STONE/MARBLE OR NET BED CONSTRUCTED FLOORS - CONTACT
M&K FOR EXCLUDED FLOOR DESIGNS)
- PER THE GUIDELINES OF THE TILE COUNCIL OF NORTH AMERICA
(TCNA HANDBOOK), IT SHALL BE THE FLOOR FINISH INSTALLER'S
RESPONSIBILITY TO VERIFY THAT THE FINISHES TO BE INSTALLED
MATCH THE DESIGN CRITERIA NOTED ABOVE (UNDER 'DESIGN
LOADS').
- METAL HANGERS SHALL BE SPECIFIED BY MANUFACTURER, U.N.O.
- FLOOR SHEATHING SHALL BE 23/32" A.P.A. RATED 'STURD-I-FLOOR'
24" O.C., EXPOSURE 1 (OR APPROVED EQUAL) WITH TONGUE AND
GROOVE EDGES. FASTEN TO FRAMING MEMBERS w/ GLUE AND:
 - 2 1/2" x 0.131" NAILS @ 6" o.c. @ PANEL EDGES @ 12" o.c. FIELD.
 - 2 3/8" x 0.120" NAILS @ 4" O.C. @ PANEL EDGES @ 8" O.C. FIELD.
 - 2 3/8" x 0.113" NAILS @ 3" O.C. @ PANEL EDGES @ 6" O.C. IN FIELD.
- PROVIDE 1 1/4" RIM BOARD @ ALL DECK LEDGER LOCATIONS. SEE
PLANS OR DETAILS FOR LEDGER CONNECTION.

ROOF FRAMING

- ROOF SHEATHING SHALL BE 7/16" A.P.A. RATED SHEATHING 24/16
EXPOSURE 1 (OR APPROVED EQUAL). FASTEN TO FRAMING MEMBERS
- w/ 2 1/2" x 0.131" NAILS @ 6" O.C. @ PANEL EDGES @ 6" O.C. FIELD.
- w/ 2 3/8" x 0.120" NAILS @ 4" O.C. @ PANEL EDGES @ 6" O.C. FIELD.
- w/ 2 3/8" x 0.113" NAILS @ 3" O.C. @ PANEL EDGES @ 6" O.C. FIELD.
- WITHIN 48" OF ALL ROOF EDGES, RIDGES, & HIPS FASTEN ROOF
SHEATHING FIELDS PER EDGE NAILING SPEC.
- FASTEN EACH ROOF TRUSS TO TOP PLATE w/ SIMPSON H25A
HURRICANE CLIP (OR APPROVED EQUAL) @ ALL BEARING POINTS.
CLIPS MUST BE INSTALLED ON EXTERIOR FACE OF EXTERIOR WALLS
OR THE SAME SIDE AS THE SHEAR WALL SHEATHING.
- ALL ROOF GIRDER TRUSSES AND FLUSH BEAMS WITHIN THE ROOF
SYSTEM SHALL BE FASTENED TO THE DOUBLE TOP PLATES AND
POST SUPPORT w/ (2) SIMPSON H25A CLIPS OR APPR. EQUAL
(TYP. U.N.O. ON PLANS)
- TRUSS ALL VALLEY SETS. FASTEN TO TRUSS BELOW w/ SIMPSON
H25A TIES AT EACH END AND AT EACH TRUSS BETWEEN.
- METAL HANGERS SHALL BE SPECIFIED BY THE MANUFACTURER, U.N.O.
- ERECT AND INSTALL ROOF TRUSSES PER WTC & TP's BC51 I
"GUIDE TO GOOD PRACTICE FOR HANDLING, INSTALLING & BRACING
OF METAL PLATE CONNECTED WOOD TRUSSES."
- SUPPORT SHORT SPAN ROOF TRUSSES w/ 2x4 LEDGER FASTENED
TO FRAMING w/ (2) 3" x 0.120" NAILS @ 16" O.C. (UP TO 1' SPAN).

M&K - MAY 2017

ADDITIONAL NOTES FOR TRUSS
& I-JOIST MANUFACTURER

ROOF TRUSS, FLOOR TRUSS AND ENGINEERED JOISTS SHALL BE
DESIGNED TO MEET THE DIFFERENTIAL DEFLECTION CRITERIA BELOW,
UNLESS NOTED OTHERWISE ON PLAN.
TRUSSES/JOISTS SHALL BE DESIGNED SO THAT DIFFERENTIAL
DEFLECTION BETWEEN ADJACENT PARALLEL TRUSSES/JOISTS OR
GIRDER TRUSSES/FLUSH BEAMS DO NOT EXCEED THE FOLLOWING:
A. ROOF TRUSSES:
1/4" DEAD LOAD
B. FLOOR TRUSSES, ATTIC TRUSSES, & I-JOISTS:
1/8" DEAD LOAD
C. FLOOR TRUSSES & ATTIC TRUSSES ADJACENT TO FLOOR
FRAMING BY OTHERS:
LIMIT ABSOLUTE TRUSS DEFLECTION TO 3/16" DEAD LOAD.
(NOT DIFFERENTIAL DEFLECTION)

LIST OF ABBREVIATIONS

• B.F. • BM. • BOT. • BRG. • B.W.A. • CANT'D • CONC. • CONT. • DBL. • DIM. • D.J. • EA. • EQ. • EXT. • E/W. • F.T. • FND. • FTG. • G.T. • HD	BALLOON-FRAMED BEAM BOTTOM BEARING BEARING WALL ABOVE CANTILEVERED CONCRETE CONTINUOUS DOUBLE DIMENSION DECK JOISTS EACH EACH WAY EXTERIOR FLOOR TRUSS FOUNDATION FOOTING GIRDER TRUSS HOLDOWN	• HDR • INT. • J • J.T. • K • MANUF. • MAX. • MIN. • N.T.S • OPT. • P.A. • P.T. • PKT • REQ'D • R.T. • SCHED. • SIM. • STRUCT. • T.O.F. • TYP.	HEADER INTERIOR JACK STUD JACK TRUSS KING STUD MANUFACTURER MAXIMUM MINIMUM NOT TO SCALE OPTIONAL POST ABOVE PRESSURE TREATED POCKET REQUIRED ROOF TRUSS SCHEDULE SIMILAR STRUCTURAL TOP OF FOOTING TYPICAL
---	--	---	--

GENERAL STRUCTURAL NOTES

- DESIGN IS BASED ON 2018 NORTH CAROLINA STATE RESIDENTIAL
CODE.
- WOOD FRAME ENGINEERING IS BASED ON NDS, "NATIONAL DESIGN
SPECIFICATION FOR WOOD CONSTRUCTION" - LATEST EDITION.
- MODEL IS CONSIDERED AS "FULLY ENCLOSED". OPENING
PROTECTION PER BUILDER (MINIMUM STRUCTURAL PANELS PER
CODE)
- DESIGN LOADS:
ROOF LIVE = 20 PSF, DEAD = 17 PSF
ATTIC = 20 PSF AT HT. > 42"
LOAD DURATION FACTOR = 1.25
FLOOR LIVE = 40 PSF (30 PSF AT SLEEPING AREAS)
DEAD = 15 PSF (10 PSF T.C., 5 PSF B.C.) (TRUSSES)
= 10 PSF (1-JOISTS/SAWN)
(ADD'L 10 PSF AT TILE)
WIND S115 MPH, EXPOSURE B
SEISMIC DESIGN CATEGORY A/B


GENERAL FRAMING

- ALL TYP. NAIL FASTENER REQUIREMENTS ARE NOTED IN STANDARD
CONNECTIONS TABLE (IRC TABLE R602.3(1)) OR ON PLANS. ALL
NAILS SPECIFIED ARE MIN DIAMETER AND LENGTH REQUIRED FOR
CONNECTION. ALL HANGER NAILS SHALL BE INSTALLED PER
MANUFACTURER'S REQUIREMENTS FOR MAX CHARTED CAPACITY.
NOTE: HANGERS USE COMMON NAIL DIAMETERS NOT TYPICAL
FRAMING GUN NAILS.
- EXT. & INT. BRG./SHEAR WALLS SHALL BE 2x4 OR 2x6 (AS SHOWN ON
PLANS) @ 16" O.C. SFP/SP STUD GRADE LUMBER, OR BETTER, U.N.O.
 - WALLS OVER 12' TALL SHALL BE PER PLAN.
- ALL INTERIOR BEARING WALLS ARE ASSUMED TO BE SHEATHED w/
GYP WALL BOARD (ONE SIDE MIN) OR PROVIDE MID HT. BLOCKING.
- ALL HEADERS, BEAMS & OTHER STRUCTURAL MEMBERS SHALL BE
SPRUCE-PINE-FIR #2 (SFP) OR SOUTHERN PINE #2 (SP) LUMBER, OR
BETTER. SUPPORT ALL HEADERS/ BEAMS w/ (1)2x JACK STUD &
(1)2x KING STUD, MINIMUM.
 - THE NUMBER OF STUDS SPECIFIED AT A SUPPORT INDICATES THE
NUMBER OF JACK STUDS REQUIRED, U.N.O..
- ALL NON-BEARING INTERIOR STUD WALLS SHALL BE CONSTRUCTED
WITH 2x 'STUD' GRADE MEMBERS SPACED @ 16" O.C. (MAX. U.N.O.)
 - SEE 'NON-BEARING HEADER SCHEDULE' HEADER SIZES IN
NON-LOAD BEARING WALLS
- ALL FRAMING LUMBER SHALL BE DRIED TO 15% MC (KD-15).
- ENGINEERED LUMBER BEAMS TO MEET OR EXCEED THE FOLLOWING:
 - 'LVL' - Fb=2600 psi; Fv=285 psi; E=2.0x10⁶ psi
- ENGINEERED LUMBER POSTS TO MEET OR EXCEED THE FOLLOWING:
 - 'LVL' - Fb=2400 psi; FcII=2500 psi; E=1.8x10⁶ psi
- FOR 2 & 3 PLY BEAMS OF EQUAL 1 3/4" MAX. WIDTH, FASTEN PLIES
TOGETHER WITH 3 ROWS OF 3"x0.120" NAILS @ 8" O/C OR 2 ROWS
1/4"x3/4" SIMPSON SDS SCREWS (OR 3/4" TRUSLOK SCREWS) @ 16"
O/C. ALT. FASTENING SPEC FOR 3 PLY BEAMS ONLY: FASTEN PLIES
TOGETHER WITH 2 ROWS OF 1/2" DIA. THRU BOLTS @ 16" O.C. USE A
MINIMUM OF 4 ROWS (NAILS/SCREWS) OR 3 ROWS (BOLTS) FOR BEAM
DEPTH OF 14" OR GREATER. APPLY NAIL/SCREEN FASTENING AT
BOTH FACES FOR 3-PLY CONDITION. LOCATE TOP & BOTTOM
FASTENERS 2" FROM EDGE. SOLID 3 1/2" OR 5 1/4" BEAMS ARE
ACCEPTABLE. USE 2 ROWS OF NAILS FOR 2x6 & 2x8 MEMBERS.
- FOR 4 PLY BEAMS OF EQUAL 1 3/4" MAX. WIDTH, FASTEN PLIES
TOGETHER WITH 3 ROWS OF 1/4"x6" SIMPSON SDS SCREWS (OR 6 3/4"
TRUSLOK SCREWS) @ 16" O/C OR 2 ROWS OF 1/2" DIA. THRU BOLTS @
16" O.C. USE A MINIMUM OF 4 ROWS (SCREWS) OR 3 ROWS (BOLTS)
FOR BEAM DEPTHS OF 14" OR GREATER. APPLY SCREEN FASTENING
AT BOTH FACES (ONE SIDE ONLY FOR TRUSLOK SCREWS). LOCATE
TOP AND BOTTOM FASTENERS 2" FROM EDGE. A SOLID 1" BEAM IS
ACCEPTABLE.
- REFER TO IRC FASTENING SCHEDULE TABLE R602.3(1) FOR ALL
CONNECTIONS, TYP. U.N.O.
- FASTEN ALL METAL CONNECTORS (I.E. HANGERS, CLIPS, ETC) PER
MANUFACTURER'S SPECIFICATIONS FOR MAXIMUM TABLE LOAD
VALUE U.N.O.
- PROVIDE SOLID BLOCKING IN FLOOR SYSTEM UNDER ALL POSTS
CONTINUOUS TO FND/BEARING. BLOCKING TO MATCH POST ABOVE.
- CORROSION NOTES:
 - BUILDER RESPONSIBLE TO DETERMINE CORROSION-RESISTANCE
REQUIREMENTS AND COMPATIBILITY OF HARDWARE, FASTENERS
AND CONNECTORS FOR ENVIRONMENTAL EXPOSURE AND IN
CONTACT w/ PRESERVATIVE-TREATED WOOD OF ACTUAL FINAL
CONDITIONS AND SOURCED MATERIALS. CONTACT LUMBER &
HARDWARE SUPPLIERS TO COORD.
- BASEMENT INTERIOR BEARING WALLS & EXTERIOR WALK-OUT
BASEMENT WALLS SHALL BE 2x6 @ 16" O.C. SFP OR GYP, 'STUD'
GRADE OR BETTER.
- M&K SHALL NOT BE RESPONSIBLE FOR ANY ISSUES RESULTING FROM
OR RELATED TO ANY DELEGATED ENGINEERED COMPONENTS IF THE
OWNER DOES NOT SUBMIT THE COMPONENT SHOP DRAWINGS TO M&K
FOR A CONFORMANCE REVIEW PRIOR TO FABRICATION, DELIVERY,
OR INSTALLATION.

M&K - MAY 2017

2/20/24

seal:

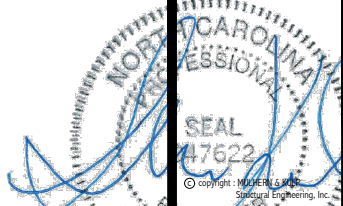

MULHERN+KULP
RESIDENTIAL STRUCTURAL ENGINEERING



M&K project number:

192-19039

project mgr:

SMK

drawn by:

NGG

issue date:

12-20-19

REVISIONS:

date:

initial:

ARCH: v.01.00.00.00



GENERAL STRUCTURAL NOTES

RUSSELL

WIND SPEED < 115 MPH NORTH CAROLINA

sheet:

SO.0

DIMENSIONS REFLECT FACE OF WALL STUDS ABOVE OR CENTERLINES OF CRAWLSPACE PIERS (REFER TO DETAILS FOR FOUNDATION WALL PLACEMENT RELATIVE TO WALL FRAMING ABOVE


FOUNDATION HARDWARE SCHEDULE
ELEVATION B

QTY	PRODUCT
15	SIMPSON STRONG BOLT 2 ANCHORS

HARDWARE NOTES:
- ALL NAIL HOLES FILLED
- ALL COUNTS ESTIMATED
- 15 ADDITIONAL STRONG BOLT 2 ANCHORS INCLUDED FOR MISSED ANCHOR BOLTS

"See Sheet SO1.1 for Opt. Wood Deck

See Sheet SO1.3 For Opt Guest

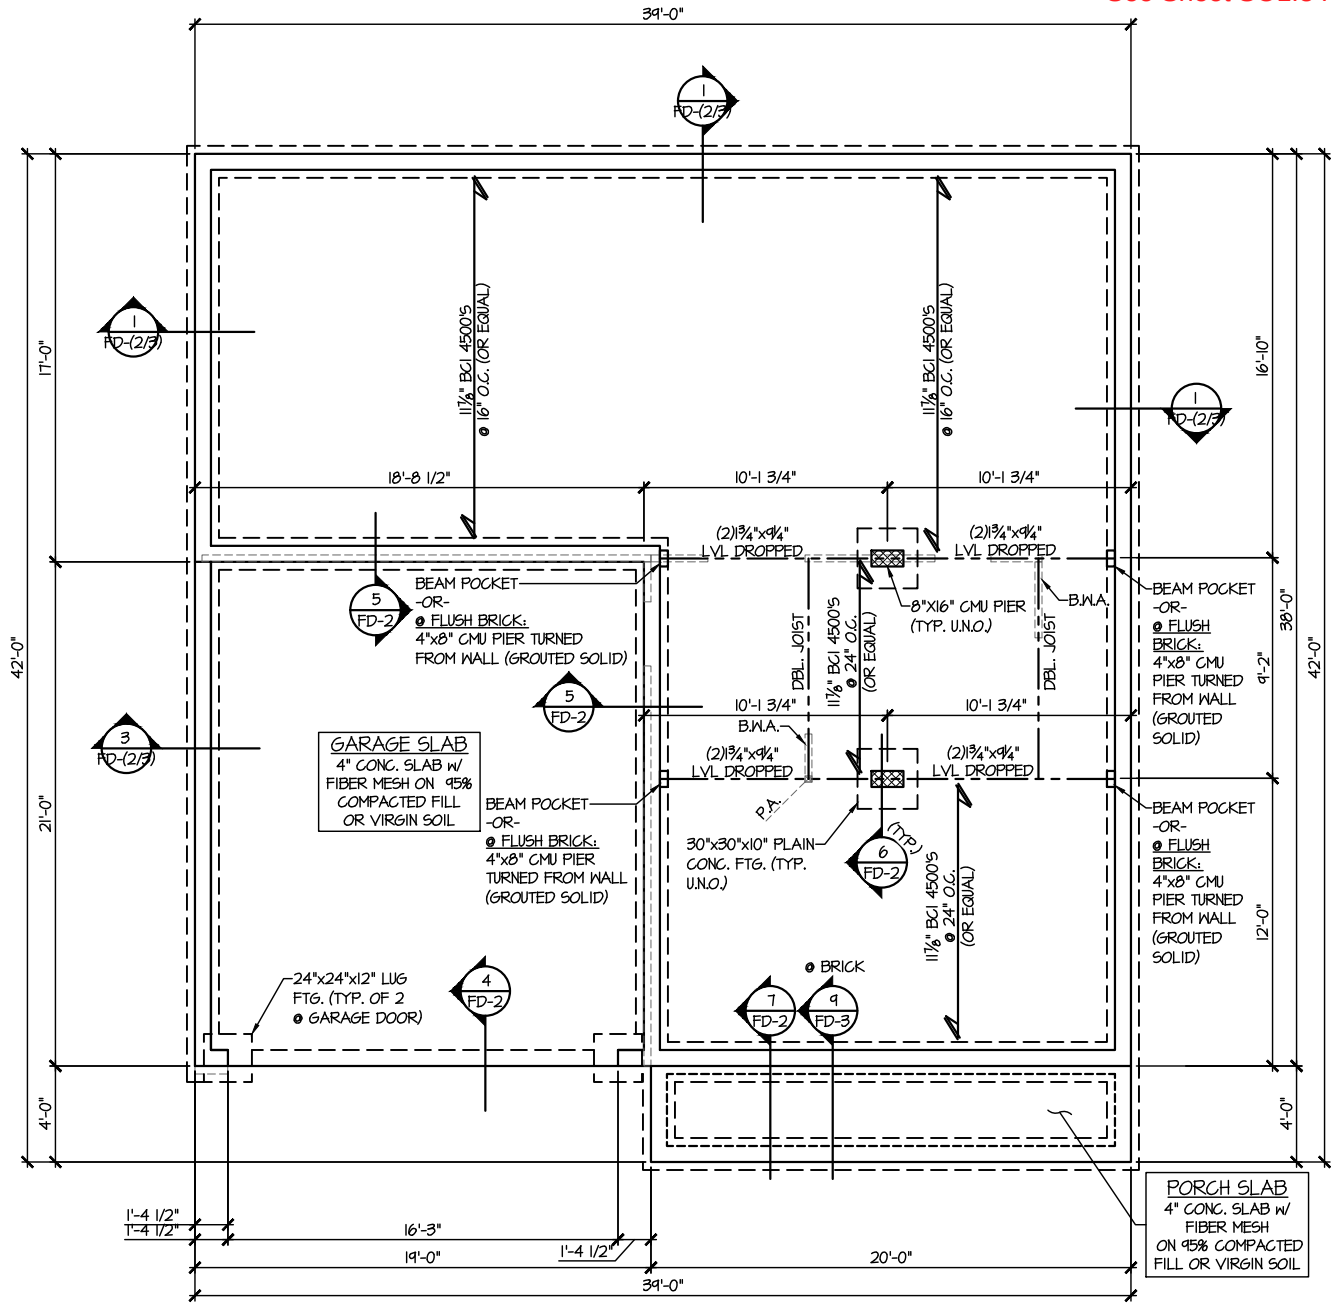

CRAWLSPACE FOUNDATION PLAN
SCALE: 1/8"=1'-0" ELEV. B

REFER TO S-0.0 FOR
TYPICAL STRUCTURAL NOTES
& SCHEDULES

SCI.1

CRAWLSPACE FOUNDATION PLAN
RUSSELL
ELEVATION B
WIND SPEED < 115 MPH NORTH CAROLINA



ARCH:01.00.00.00

date: initial:

REVISIONS:

project mgr: SMK
drawn by: NGG
issue date: 12-20-19


M&K project number:

192-19039




MULHERN+KULP
RESIDENTIAL STRUCTURAL ENGINEERING

300 Brookside Ave, Building 4 - Ambler, PA 19002
p.215-646-8001 • mulhern+kulp.com
NC License # C-3825

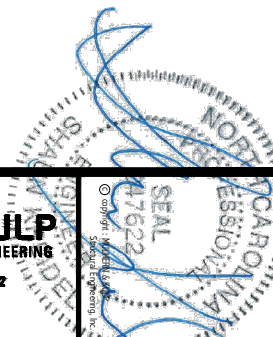

2/20/24

seal:

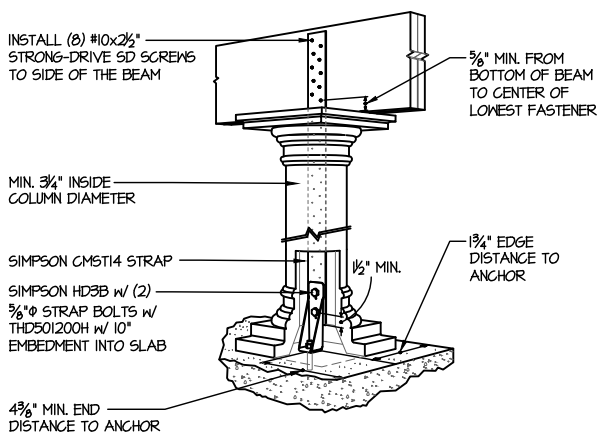


A HOLLOW STRUCTURAL COLUMN UPLIFT DETAIL
NOT TO SCALE - AS REQUIRED

2ND FLOOR HARDWARE SCHEDULE
ELEVATION B

QTY	PRODUCT
14	SIMPSON H2.5A CLIP
4	SIMPSON C516 (3/8\"/>

HARDWARE NOTES:
- ALL NAIL HOLES FILLED
- ALL COUNTS ESTIMATED
- HARDWARE COUNT DOES NOT INCLUDE TRUSS TO TRUSS CONNECTIONS

See Sheet SO1.3 For Opt Guest Suite

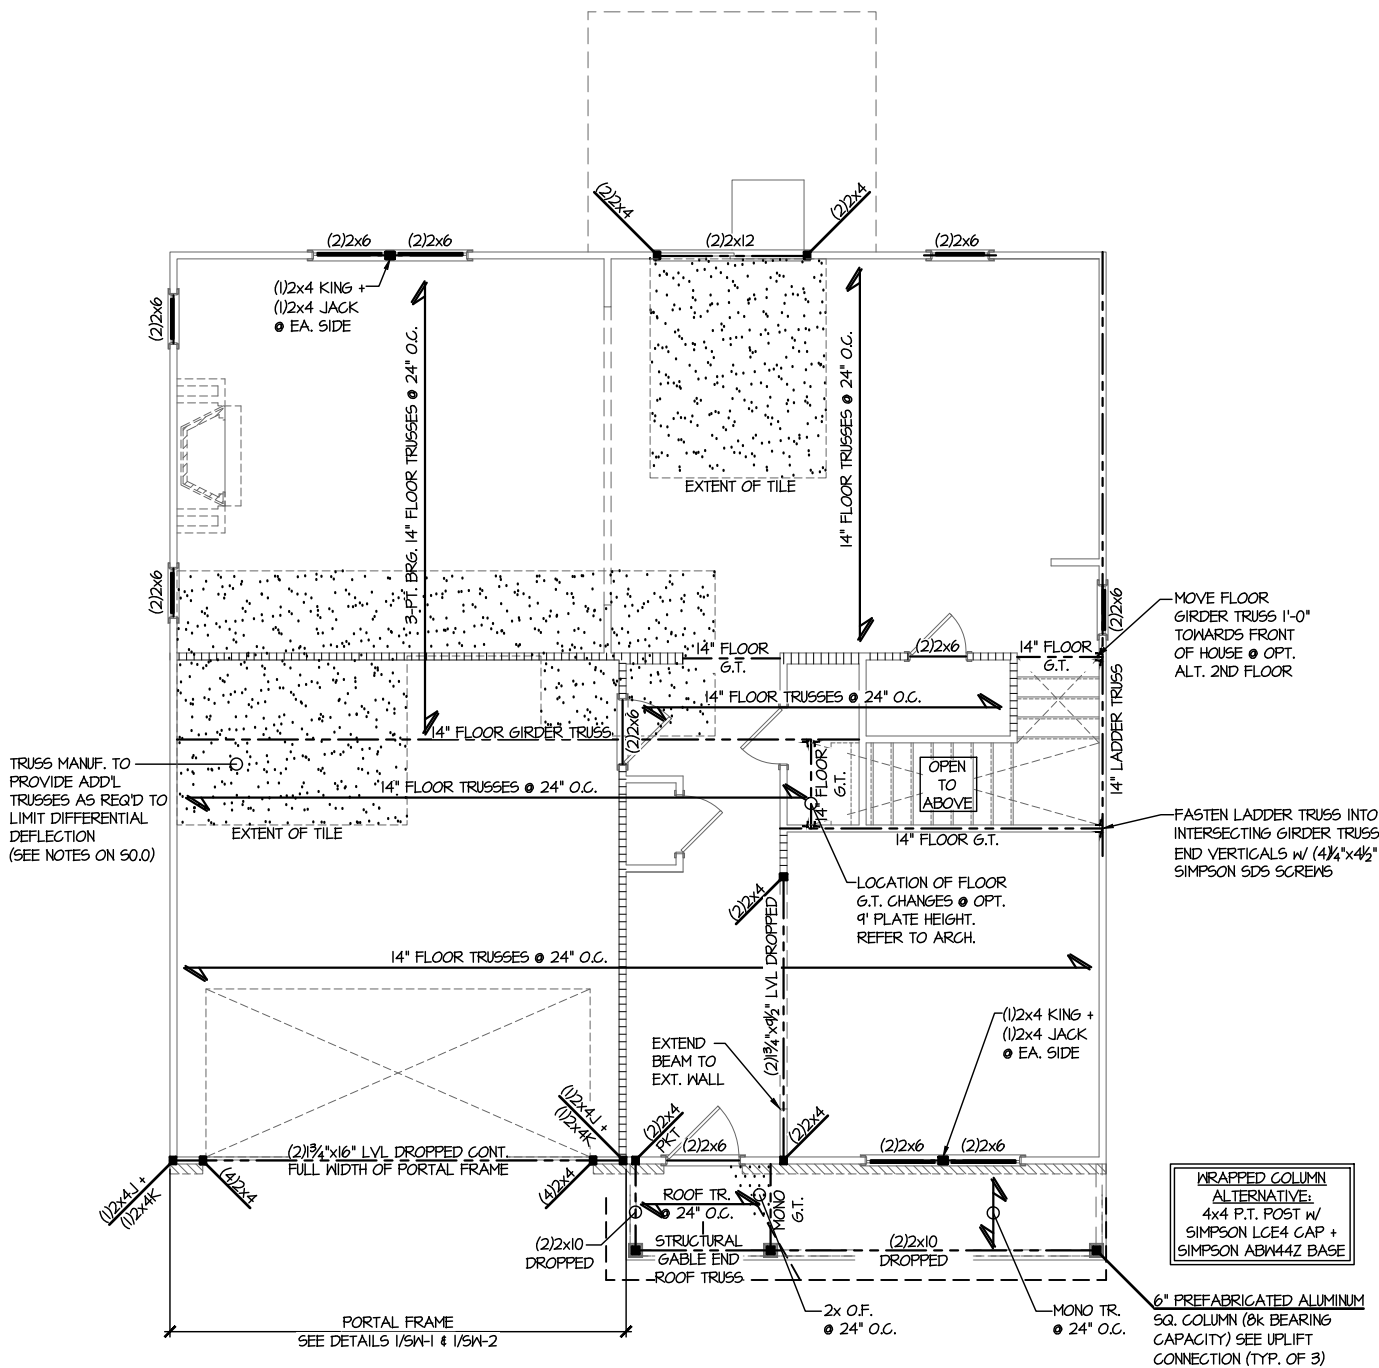

2ND FLOOR FRAMING PLAN

SCALE: 1/8\"/>

(1ST FLOOR WALLS SHOWN)

ELEV. B

PLAN DESIGNED FOR
8' -OR- 9' PLATE HEIGHT

REFER TO S-O.O FOR
TYPICAL STRUCTURAL NOTES
& SCHEDULES

S2.1

2ND FLOOR FRAMING PLAN
RUSSELL
ELEVATION B
WIND SPEED < 115 MPH NORTH CAROLINA



ARCH: 01.00.00.00

date: 12-20-19

initials: NGG

project mgr: SMK

drawn by: NGG

issue date: 12-20-19


revision: 192-19039



MULHERN+KULP
RESIDENTIAL STRUCTURAL ENGINEERING

300 Brookside Ave, Building 4 - Ambler, PA 19002
p 215-646-8001 - mulhern+kulp.com
NC License # C-3825


scale: 2/20/24

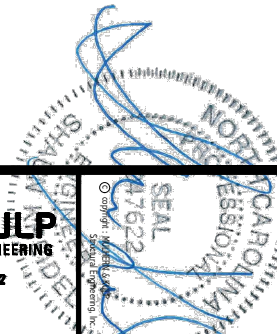

ROOF HARDWARE SCHEDULE
ELEVATION B


QTY	PRODUCT
142	SIMPSON H2.5A CLIP
2	SIMPSON CSI6 (24" STRAP)

HARDWARE NOTES:
- ALL NAIL HOLES FILLED
- ALL COUNTS ESTIMATED
- HARDWARE COUNT DOES NOT INCLUDE TRUSS TO TRUSS CONNECTIONS

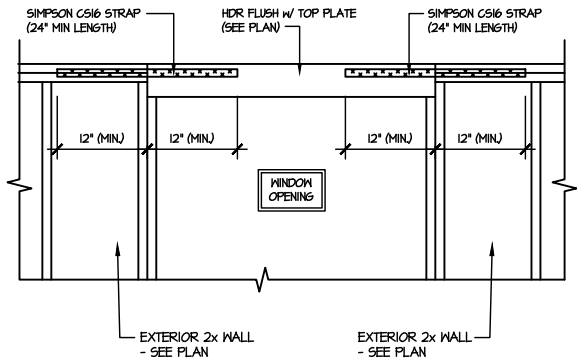

**SHEAR TRANSFER DETAIL
AT UPSET WINDOW**

A
SCALE: 3/8"=1'-0"

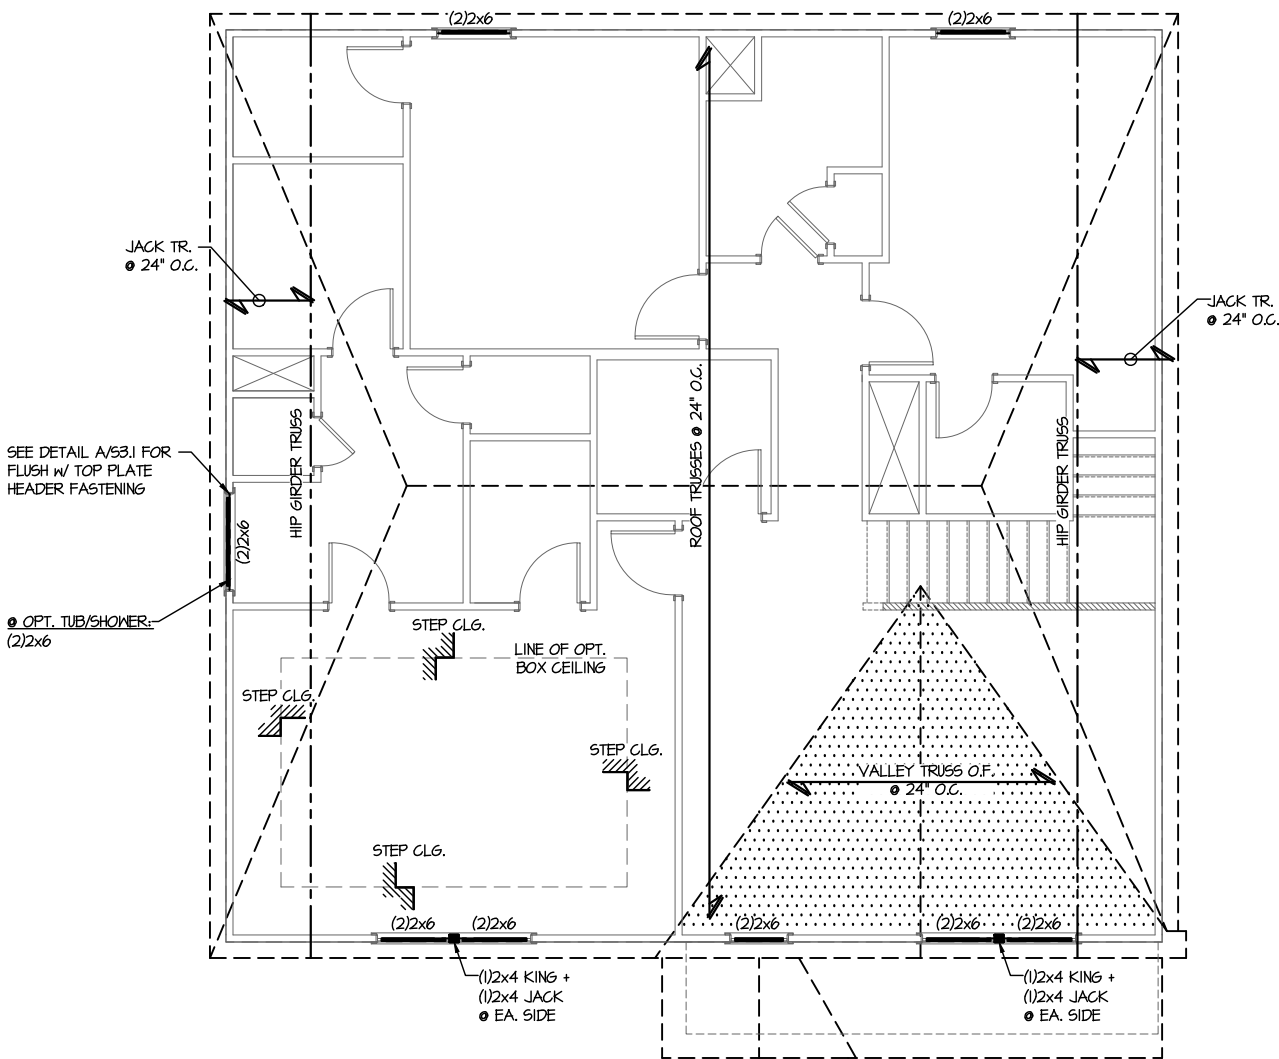

ROOF FRAMING PLAN

SCALE: 1/8"=1'-0"

ELEV. B

(2ND FLOOR WALLS SHOWN)

PLAN DESIGNED FOR
8' PLATE HEIGHT

REFER TO S-0.0 FOR
TYPICAL STRUCTURAL NOTES
& SCHEDULES

S3.1

ROOF FRAMING PLAN

RUSSELL
ELEVATION B

WIND SPEED < 115 MPH NORTH CAROLINA



ARCH:01.00.00.00

date: initial:

REVISIONS:

project mgr: SMK

drawn by: NGG

issue date: 12-20-19


W&K project number: 192-19039



MULHERN+KULP
RESIDENTIAL STRUCTURAL ENGINEERING


300 Brookside Ave, Building 4 - Ambler, PA 19002
p.215-646-8001 • email:mk@mulhernkulp.com

NC License # C-3825

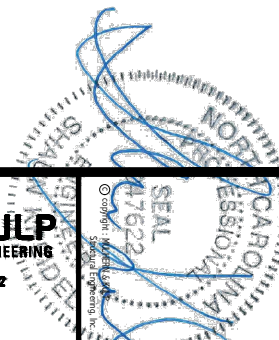


2/20/24

ADD'L HARDWARE SCHEDULE FOR OPT. WOOD DECK	
QTY	PRODUCT
24	SIMPSON U210 HANGER
3	SIMPSON LCE4 POST CAP
3	SIMPSON ABW44Z POST BASE
4	SIMPSON H3 CLIP
2	SIMPSON BC52-2/4 POST BASE

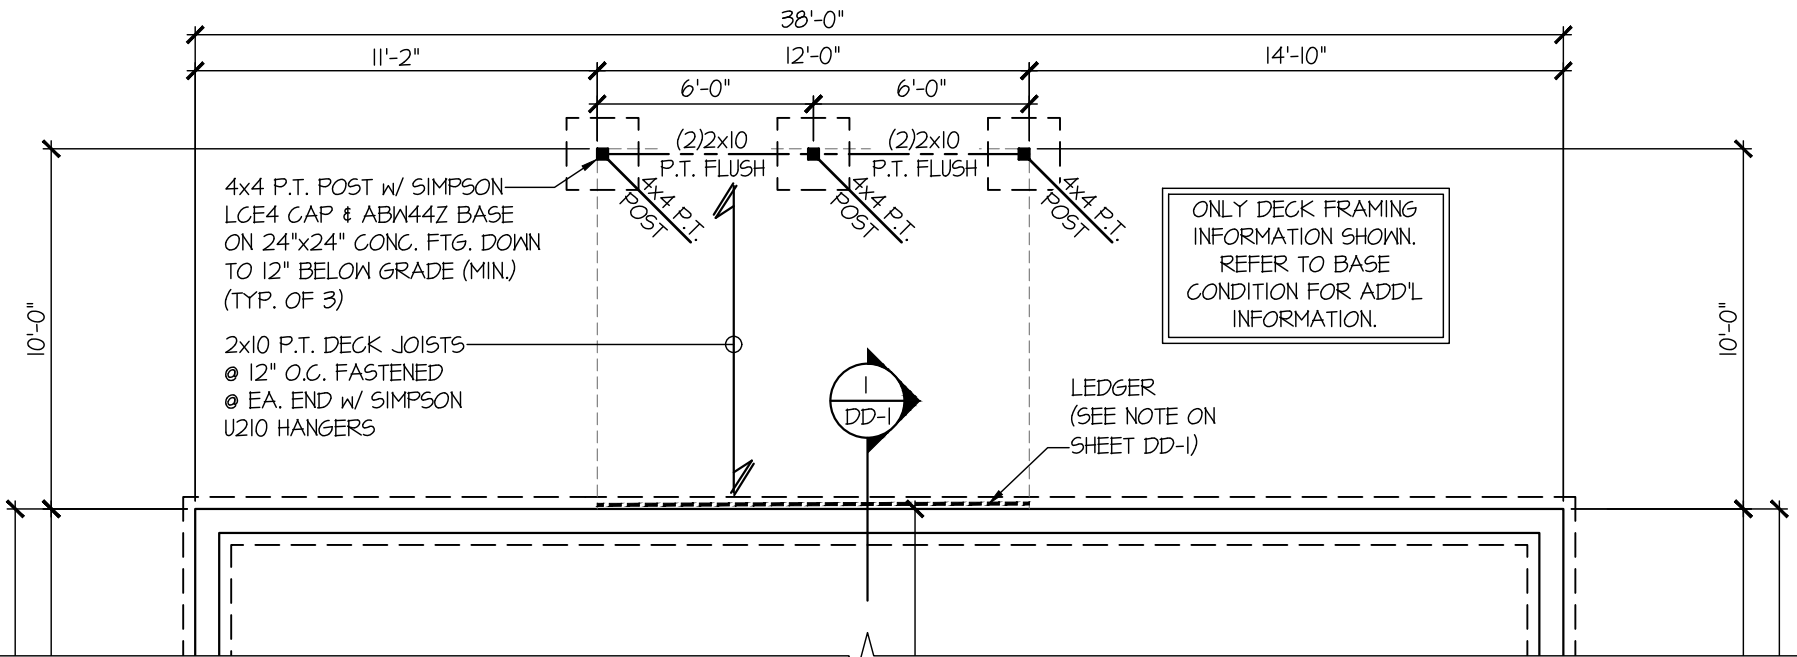


PARTIAL CRAWLSPACE FOUNDATION PLAN
OPT. WOOD DECK
SCALE: 3/16"=1'-0" ALL ELEV. SIM.

REFER TO S-0.0 FOR
TYPICAL STRUCTURAL NOTES
& SCHEDULES

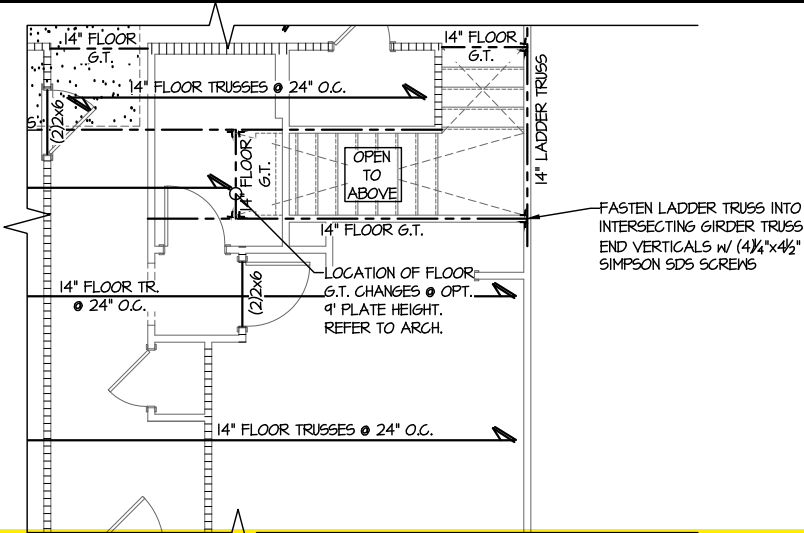


ADD'L HARDWARE SCHEDULE OPT. GUEST SUITE	
QTY	PRODUCT
-	NO ADD'L HARDWARE


**PARTIAL 2ND FLOOR FRAMING PLAN
OPT. GUEST SUITE**
SCALE: 1/8"=1'-0"
(1ST FLOOR WALLS SHOWN)
ALL ELEV. SIM.

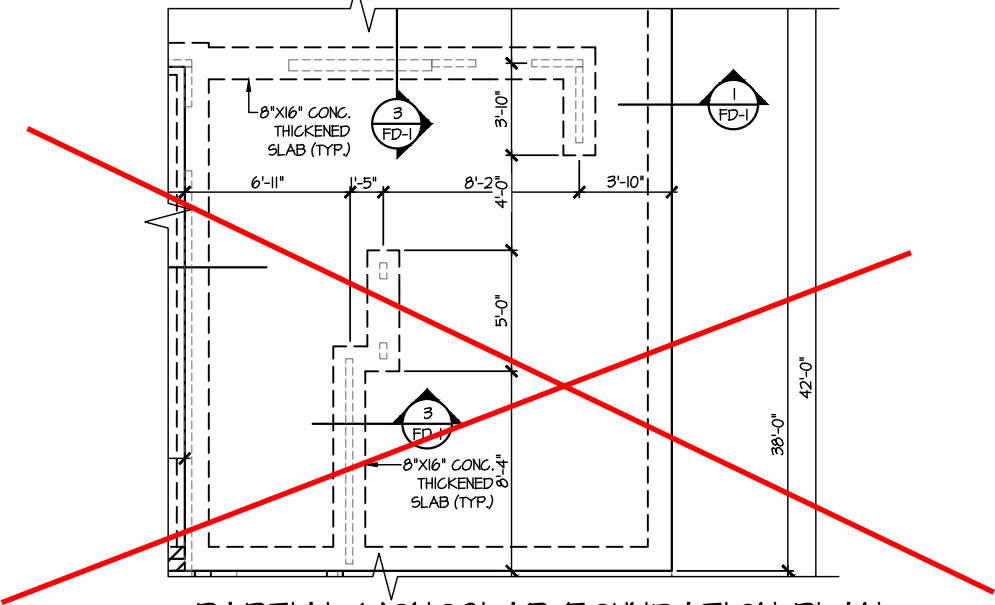

**PARTIAL MONOSLAB FOUNDATION PLAN
OPT. GUEST SUITE**
SCALE: 1/8"=1'-0"
ALL ELEV. SIM.

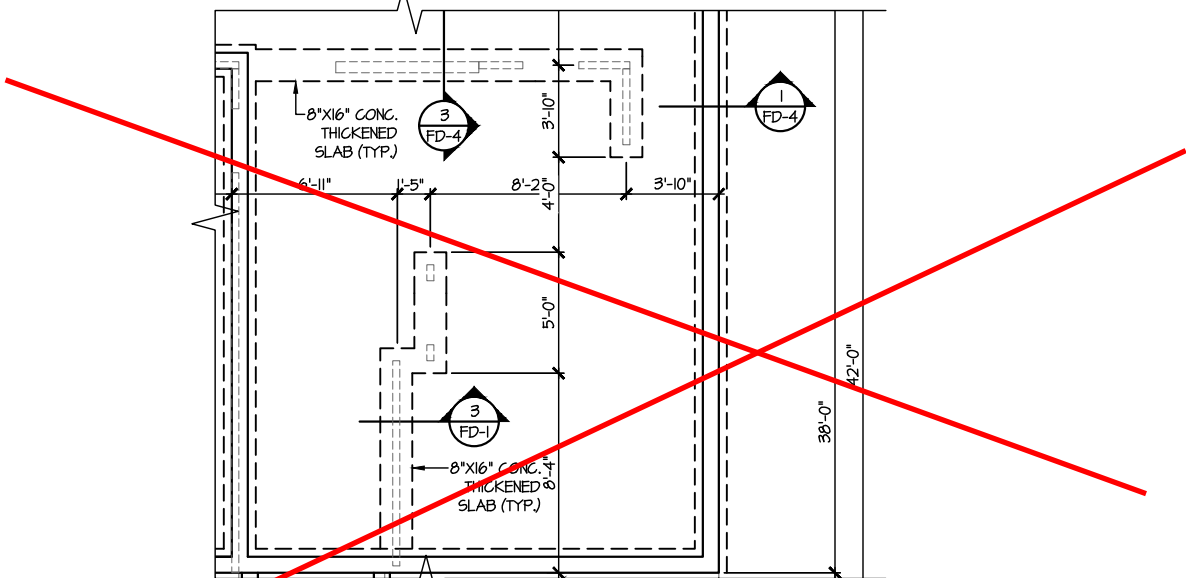


**PARTIAL RAISED SLAB FOUNDATION PLAN
OPT. GUEST SUITE**
SCALE: 1/8"=1'-0"
ALL ELEV. SIM.

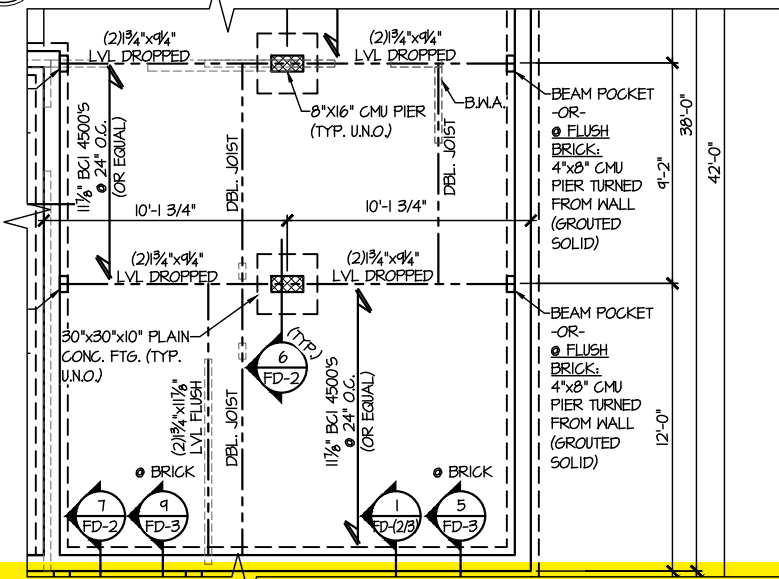

**PARTIAL CRAWLSPACE FOUNDATION PLAN
OPT. GUEST SUITE**
SCALE: 1/8"=1'-0"
ALL ELEV. SIM.

PLAN DESIGNED FOR
8' PLATE HEIGHT

REFER TO S-0.0 FOR
TYPICAL STRUCTURAL NOTES
& SCHEDULES

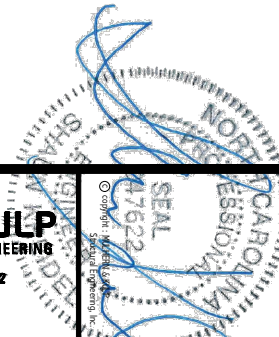



project mgr: SMK
drawn by: NGG
issue date: 12-20-19


ARCH: v.01.00.00.00





STRUCTURAL DETAILS
RUSSELL
WIND SPEED < 115 MPH NORTH CAROLINA

sheet

SW-1

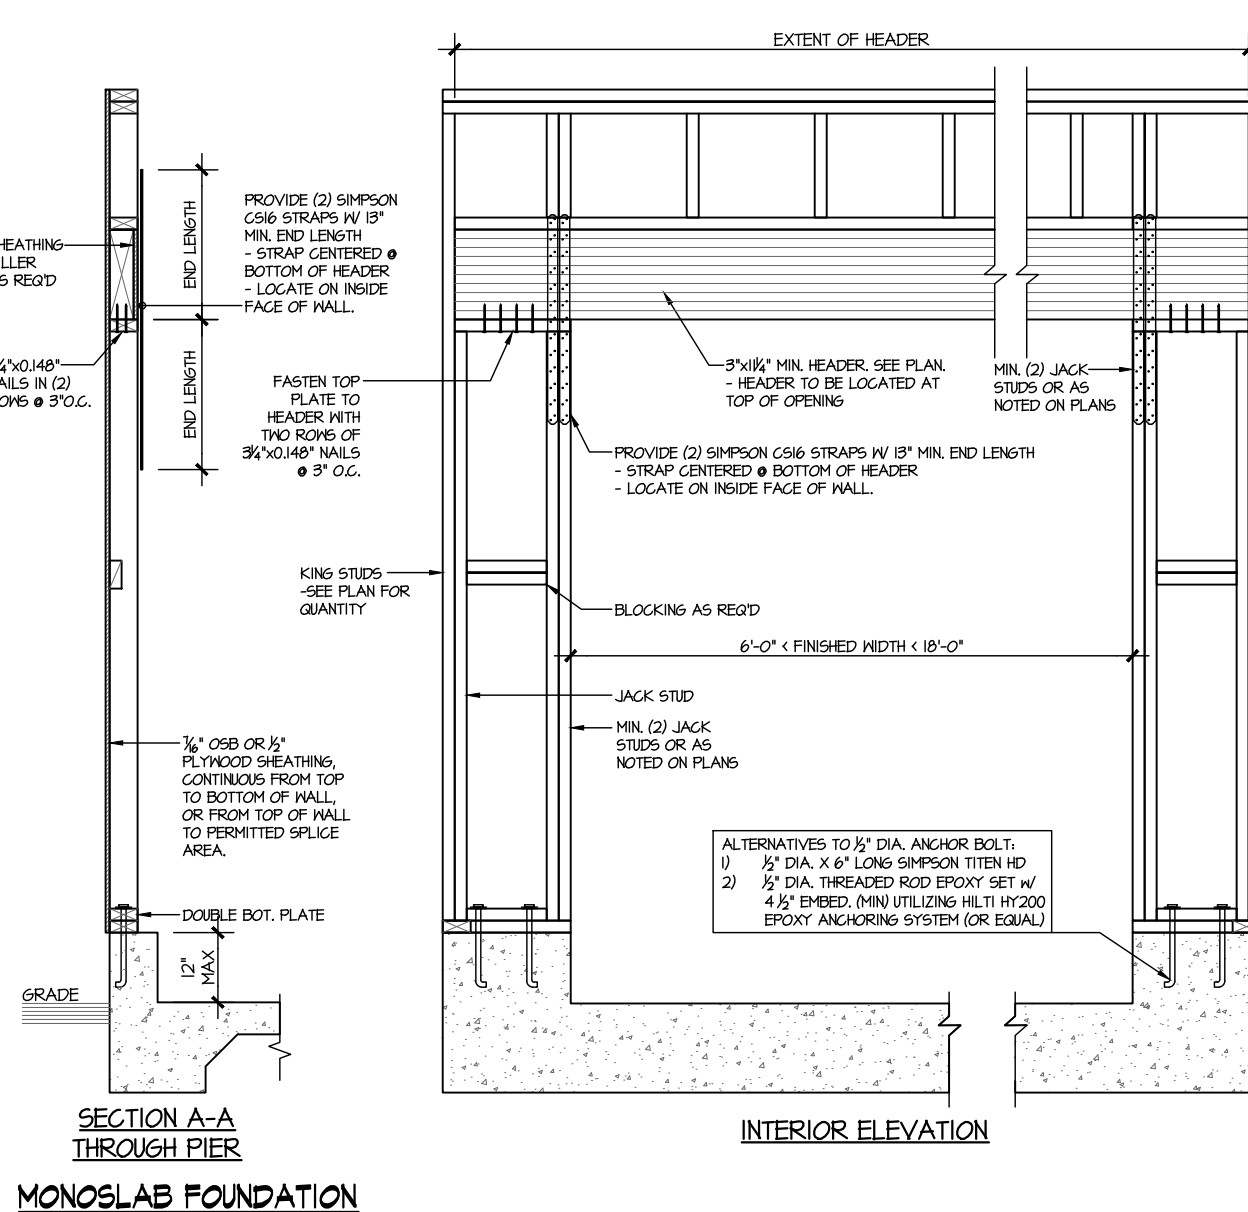


WALL FRAMING SPECIFICATION:
 ① 2x4 WALL: USE SP/SPF #2
 GRADE STUDS (OR BETTER)
 ② 2x6 WALL: USE SP/SPF #2
 GRADE STUDS (OR BETTER)

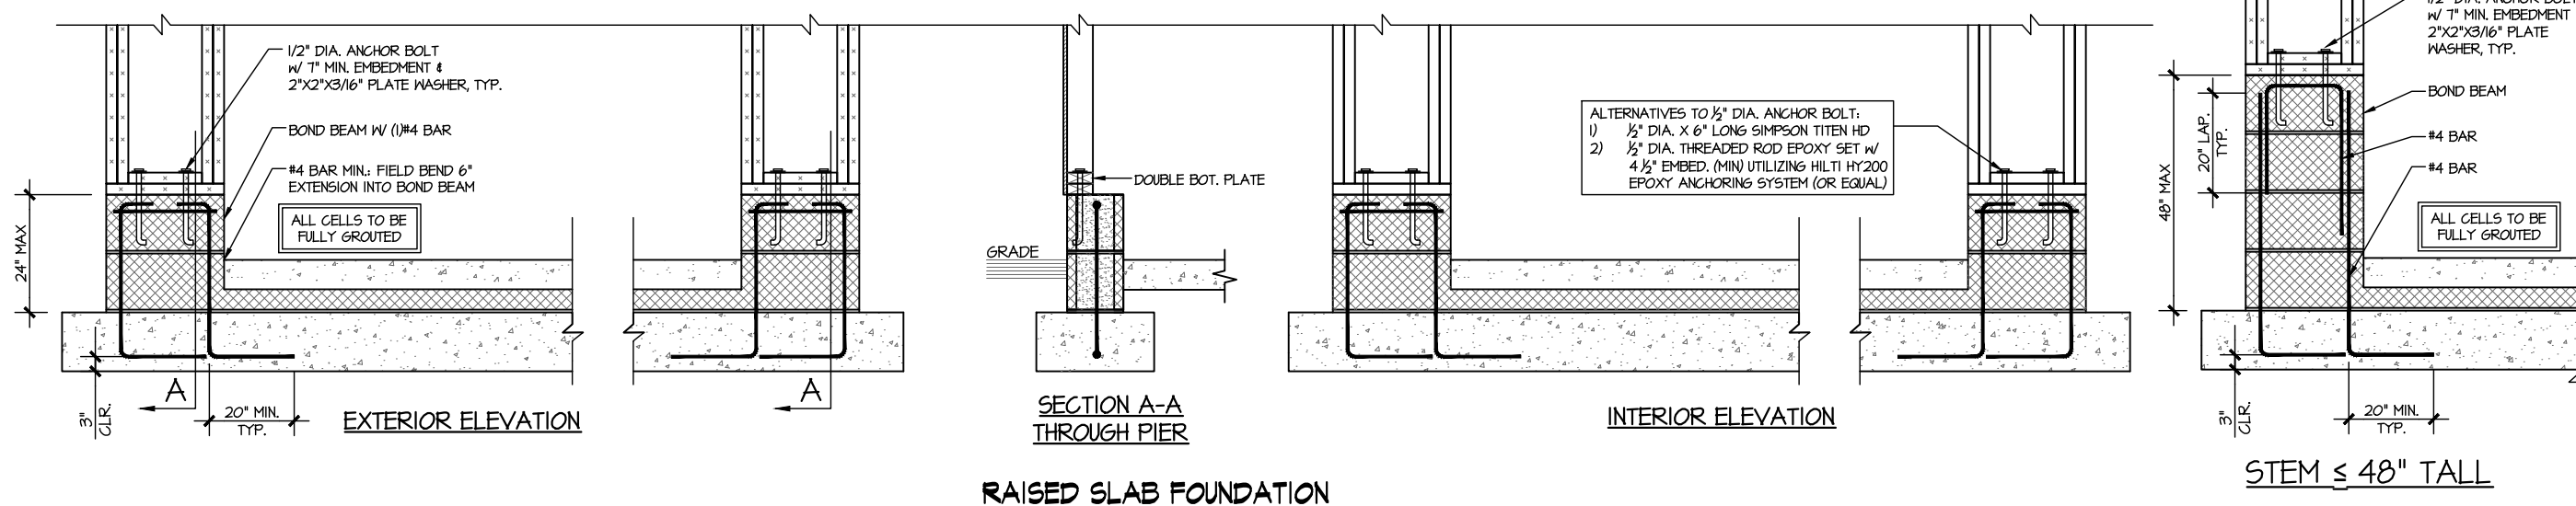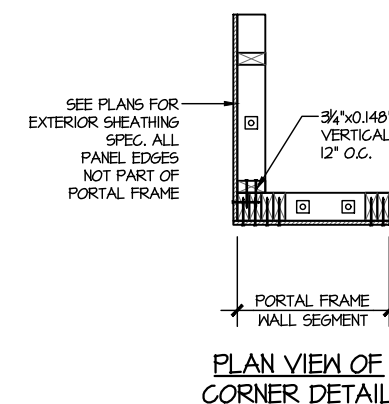

PORTAL FRAME DETAIL
SCALE: N.T.S.

**BOTH SIDES OF GARAGE DOOR
1 KING STUD & RETURN WALLS**

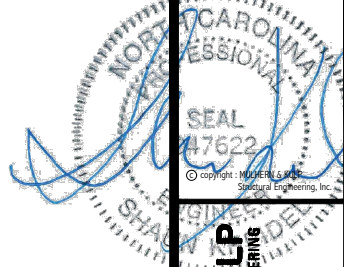

MULHERN+KULP
RESIDENTIAL STRUCTURAL ENGINEERING
300 Bluebird Ave. Building 4 - Asheville, PA 18002
P 715-246-0001 • mulhern+kulp.com
NC License # C-3825

M&K project number:
192-19039

project mgr: SMK
drawn by: NGG
issue date: 12-20-19

REVISIONS:
date: initial:


ARCH: v.01.00.00.00




STRUCTURAL DETAILS
RUSSELL
WIND SPEED < 115 MPH NORTH CAROLINA

sheet:


SW-2

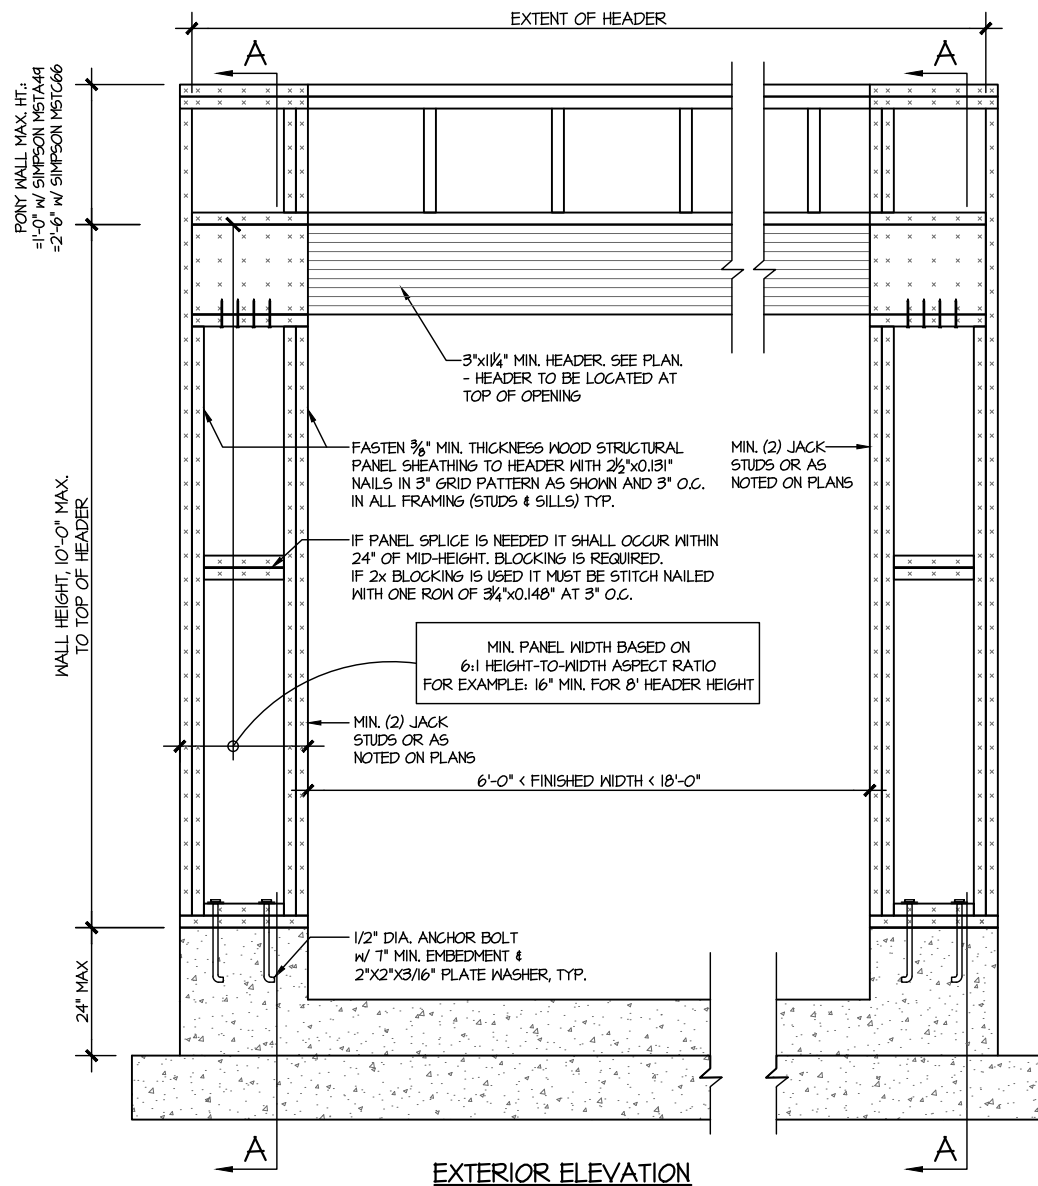



EXTERIOR ELEVATION

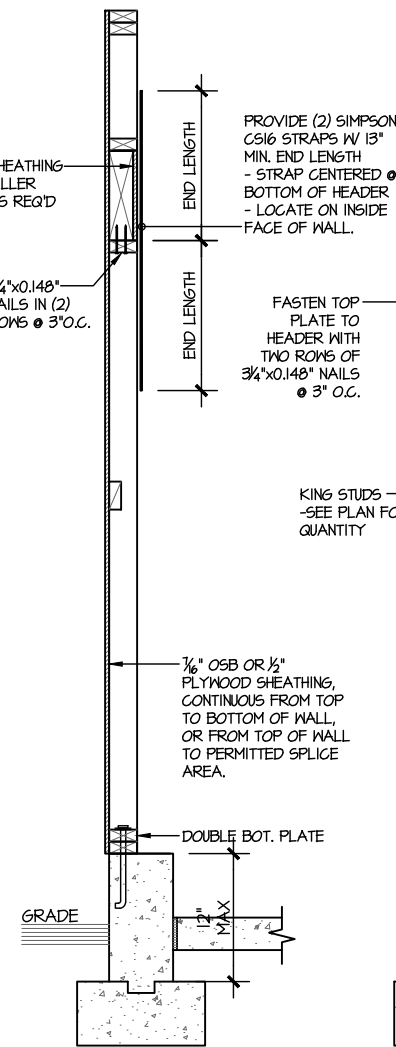


SECTION A-A
THROUGH PIER
BASEMENT FOUNDATION

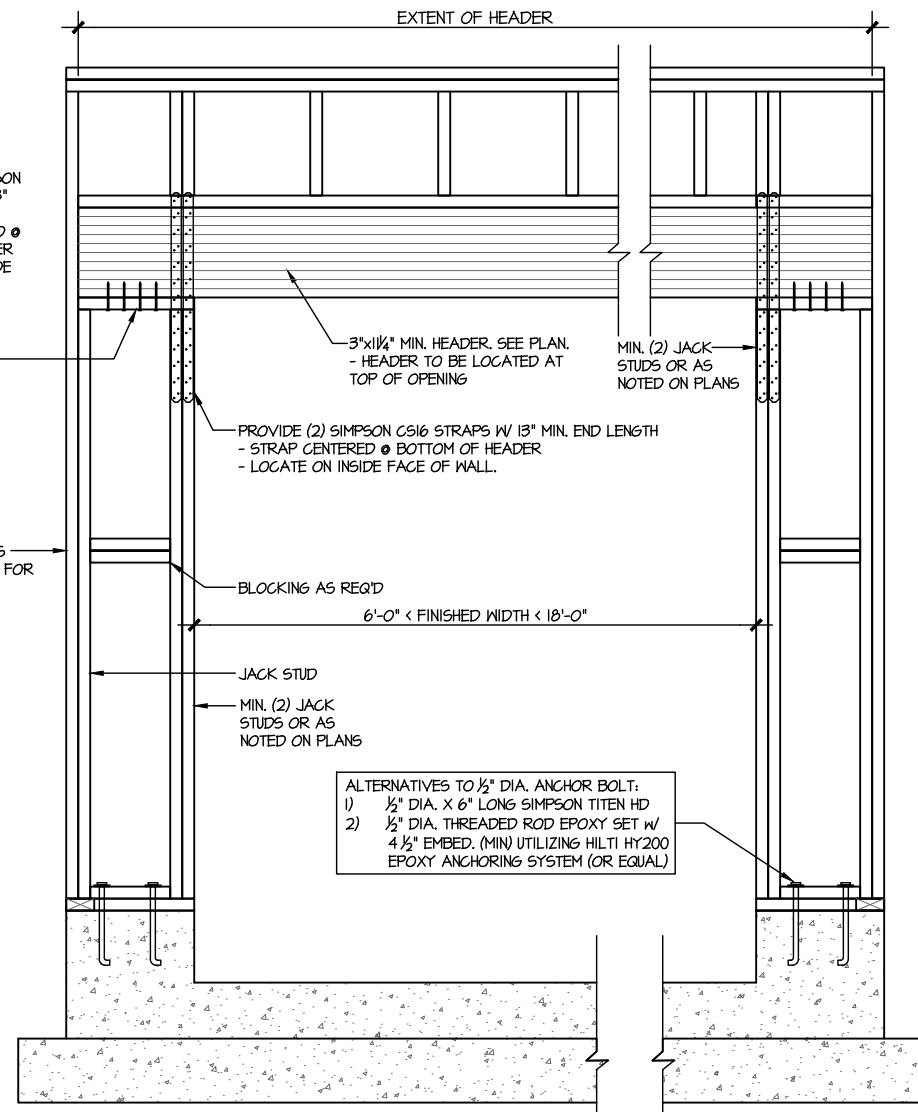

INTERIOR ELEVATION

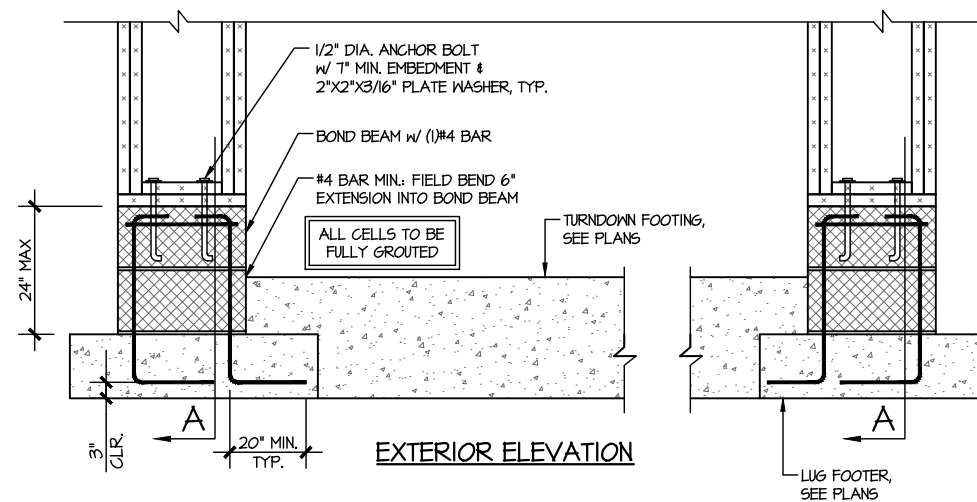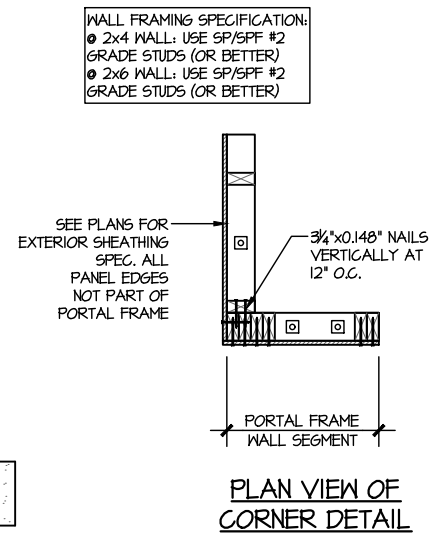


EXTERIOR ELEVATION

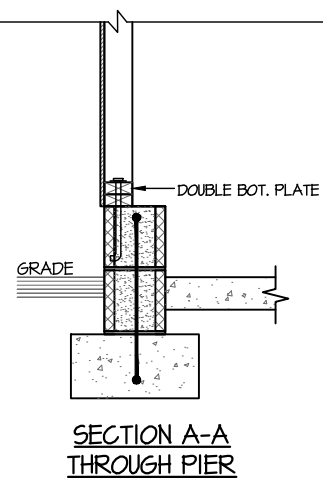


SECTION A-A
THROUGH PIER

CRAWLSPACE FOUNDATION

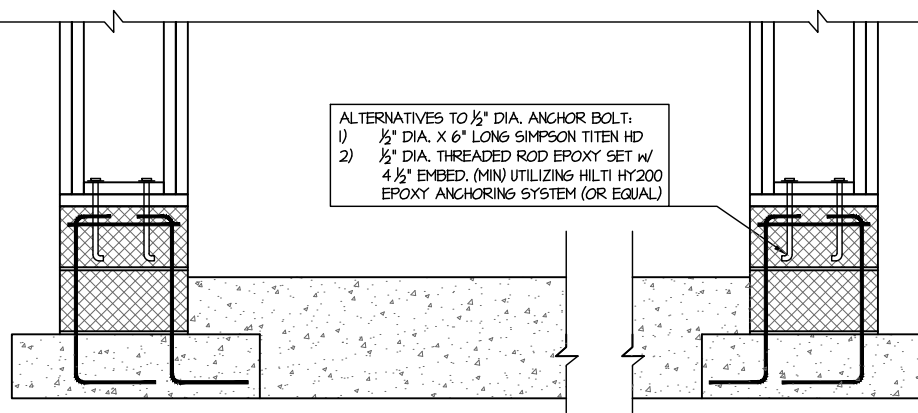

INTERIOR ELEVATION

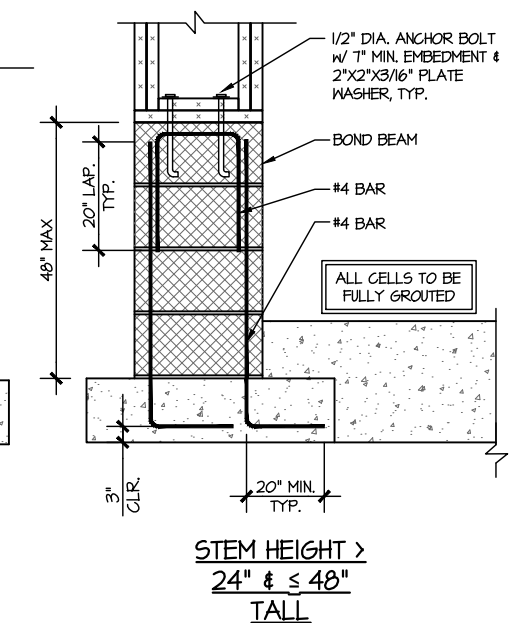


STEM HEIGHT >
24" & ≤ 48"
TALL




PORTAL FRAME DETAIL

SCALE: N.T.S.


BOTH SIDES OF GARAGE DOOR
1 KING STUD & RETURN WALLS

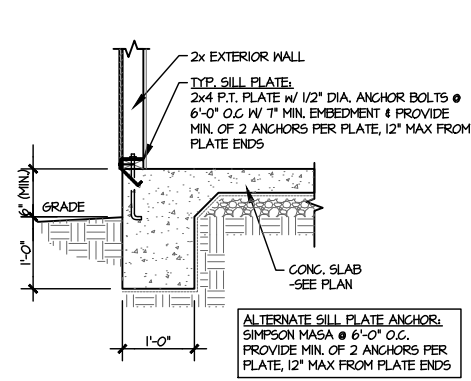


1 TYPICAL TURNDOWN @ EXT. WALL
SCALE: 3/8"=1'-0"

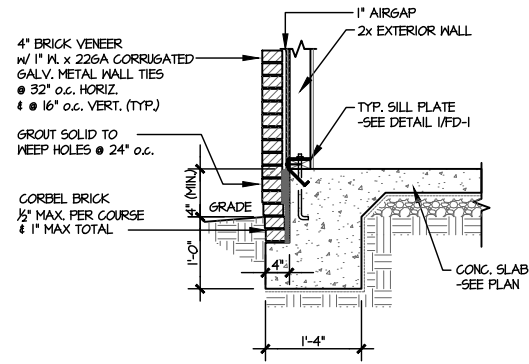


2 TYPICAL TURNDOWN @ EXT. WALL (BRICK)
SCALE: 3/8"=1'-0"

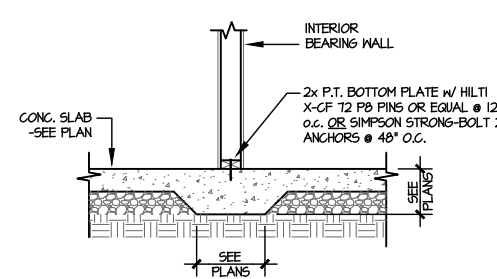


3 TYPICAL THICKENED SLAB @ INTERIOR BEARING WALL
SCALE: 3/8"=1'-0"

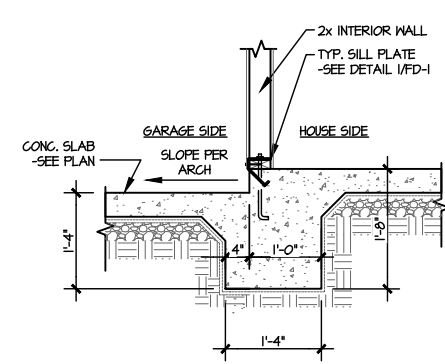


4 TYPICAL INT. FOOTING BETWEEN HOUSE & GARAGE
SCALE: 3/8"=1'-0"

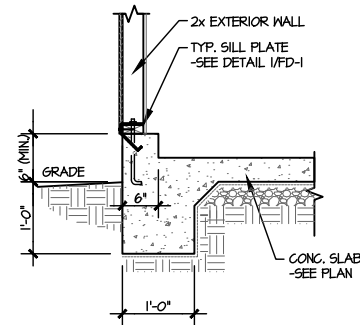


5 TYPICAL TURNDOWN @ EXT. GARAGE WALL
SCALE: 3/8"=1'-0"

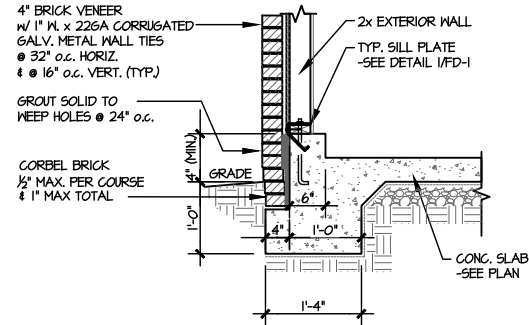


6 TYPICAL TURNDOWN @ EXT. GARAGE WALL (BRICK)
SCALE: 3/8"=1'-0"

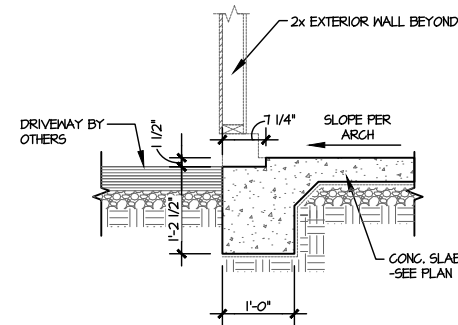


7 GARAGE OPENING
SCALE: 3/8"=1'-0"

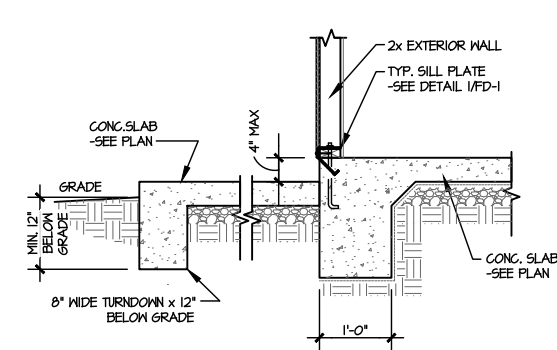


8 TYPICAL TURNDOWN @ PATIO/PORCH
SCALE: 3/8"=1'-0"

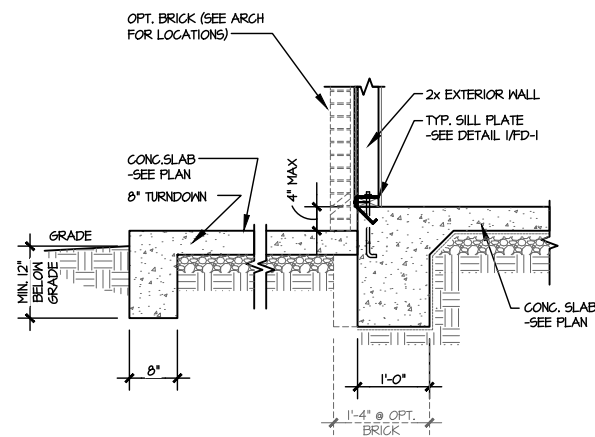


9 TYPICAL TURNDOWN @ PATIO/PORCH (BRICK)
SCALE: 3/8"=1'-0"

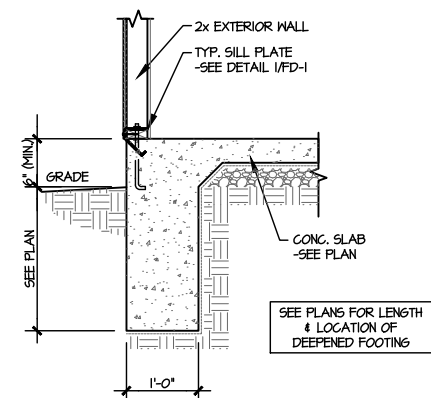


10 TYPICAL TURNDOWN W/ DEEPEMED FTG. @ EXT. WALL
SCALE: 3/8"=1'-0"

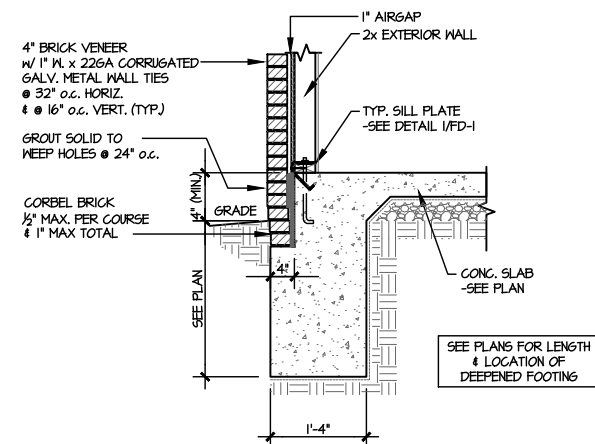

11 TYPICAL TURNDOWN @ EXT. WALL (BRICK)
SCALE: 3/8"=1'-0"

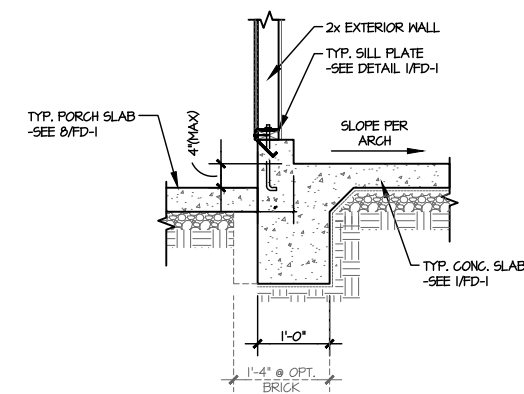

12 TYPICAL TURNDOWN @ COVERED PORCH/ATTACHED GARAGE
SCALE: 3/8"=1'-0"

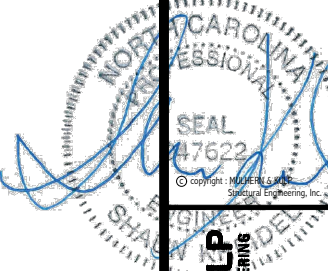

MULHERN+KULP
RESIDENTIAL STRUCTURAL ENGINEERING
300 Bluebell Ave. Building 4 - Asheville, PA 18002
P 715-246-0001 • mulhernkulp.com
NC License # C-3825

M&K project number:
192-19039
project mgr: SMK
drawn by: NGG
issue date: 12-20-19


REVISIONS:
date: initial:

ARCH: v.01.00.00.00



FOUNDATION DETAILS
RUSSELL
WIND SPEED < 115 MPH NORTH CAROLINA

sheet:
FD-1

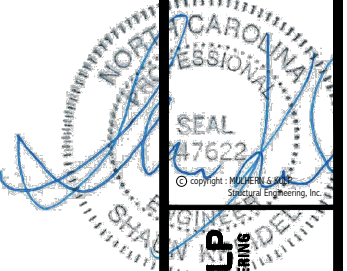

MULHERN+KULP
RESIDENTIAL STRUCTURAL ENGINEERING
300 Bluebirds Ave. Building 4 - Asheville, NC 28802
721.554.8811 • mulhern+kulp.com
NC License # C-3825




M&K project number: 192-19039
project mgr: SMK
drawn by: NGG
issue date: 12-20-19

REVISIONS:
date: initial:

ARCH: v.01.00.00.00




FOUNDATION DETAILS
RUSSELL
WIND SPEED < 115 MPH NORTH CAROLINA

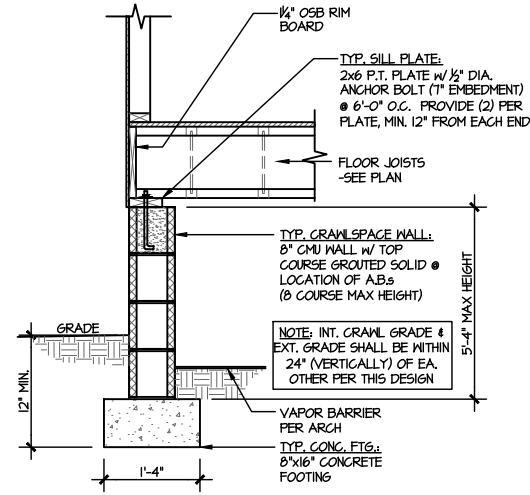


1 TYPICAL CRAWLSPACE FOUNDATION
SCALE: 3/8"=1'-0"


2 NOT USED
SCALE: 3/8"=1'-0"

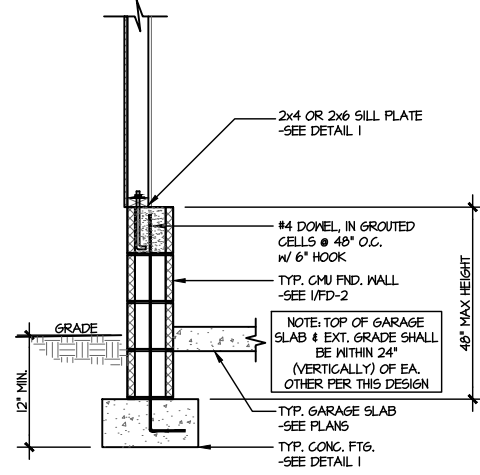


3 TYPICAL PERIMETER FOOTING @ EXTERIOR GARAGE WALL
SCALE: 3/8"=1'-0"

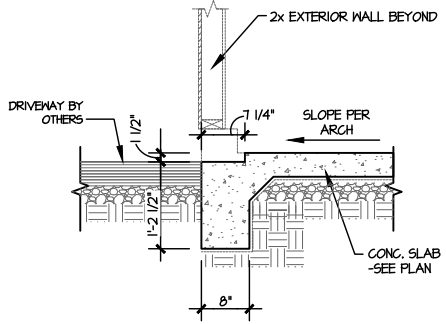


4 TYPICAL TURNDOWN FOOTING AT EXTERIOR GARAGE APRON
SCALE: 3/8"=1'-0"

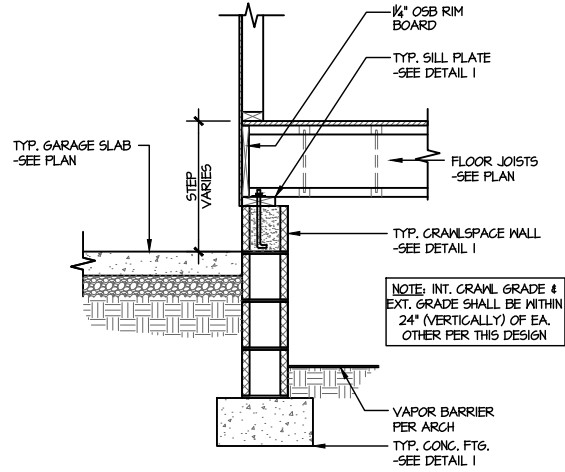


5 TYPICAL CRAWLSPACE FOUNDATION @ INTERIOR GARAGE WALL
SCALE: 3/8"=1'-0"

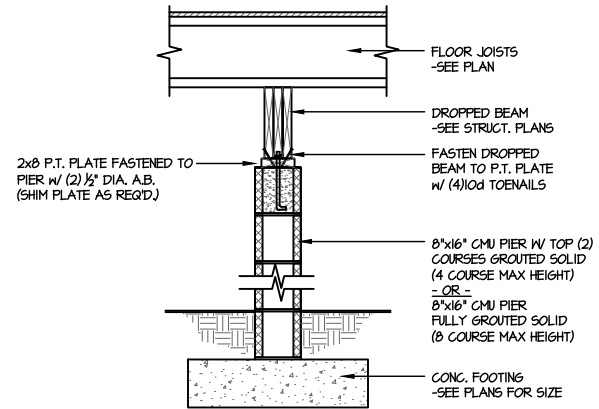


6 TYPICAL CRAWLSPACE FOUNDATION @ INTERIOR PIER
SCALE: 3/8"=1'-0"

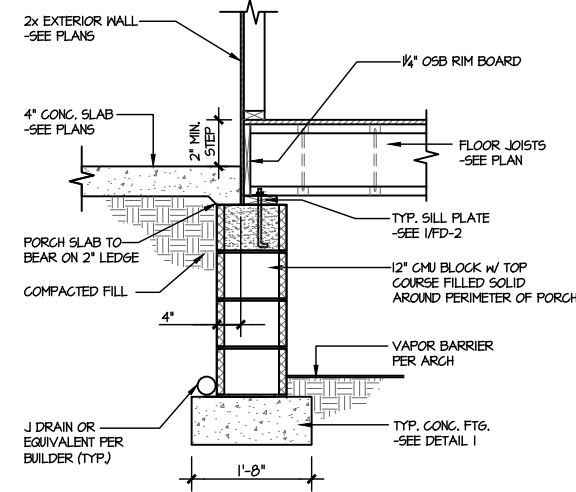


7 TYPICAL CRAWLSPACE FOUNDATION @ PORCH SLAB
SCALE: 3/8"=1'-0"

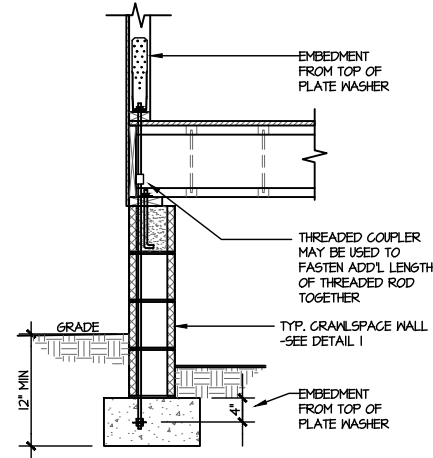


A TYPICAL CRAWLSPACE FOUNDATION HOLD-DOWN INSTALLATION
SCALE: 3/8"=1'-0"
w/ STONE VENEER OR SIDING

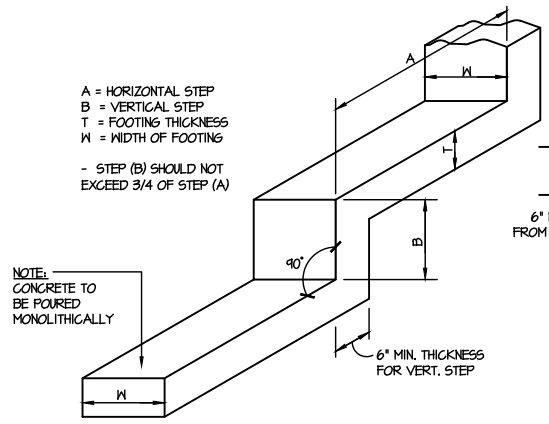

B TYPICAL STEPPED FOOTING DETAIL
SCALE: NTS

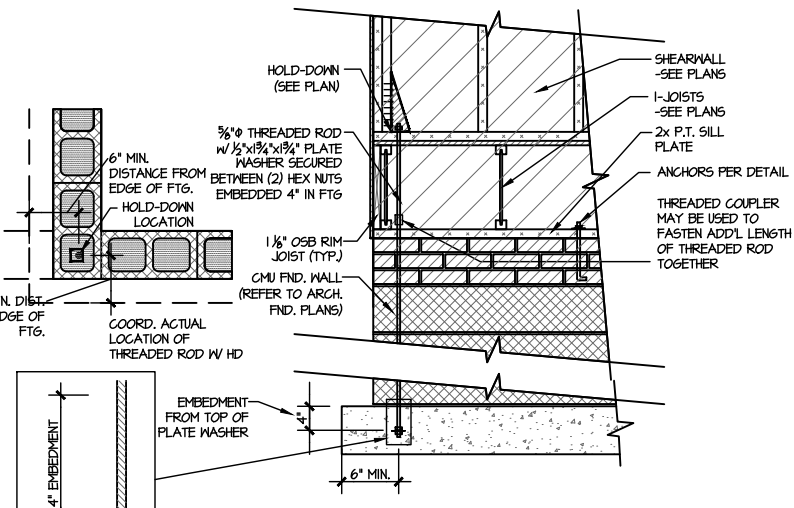


C TYPICAL CMU FOUNDATION HOLD-DOWN INSTALLATION
SCALE: 3/8"=1'-0"
(CORNER SHOWN - APPLICABLE TO ALL CONDITIONS)

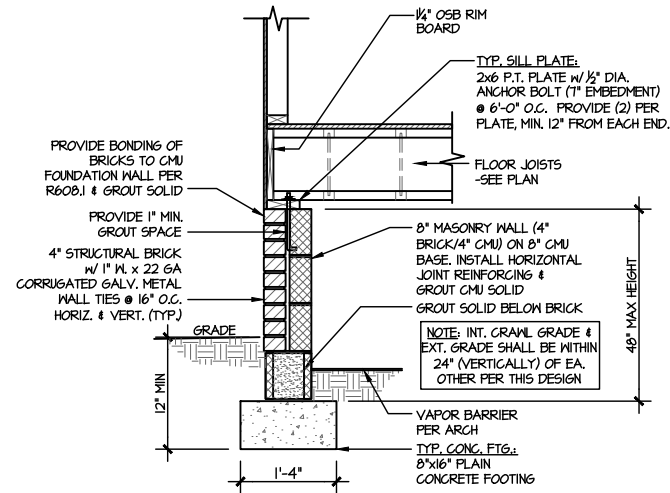


1 TYPICAL CRAWLSPACE FOUNDATION
SCALE: 3/8"=1'-0" W/ BRICK WATERTABLE

2 NOT USED
SCALE: 3/8"=1'-0"

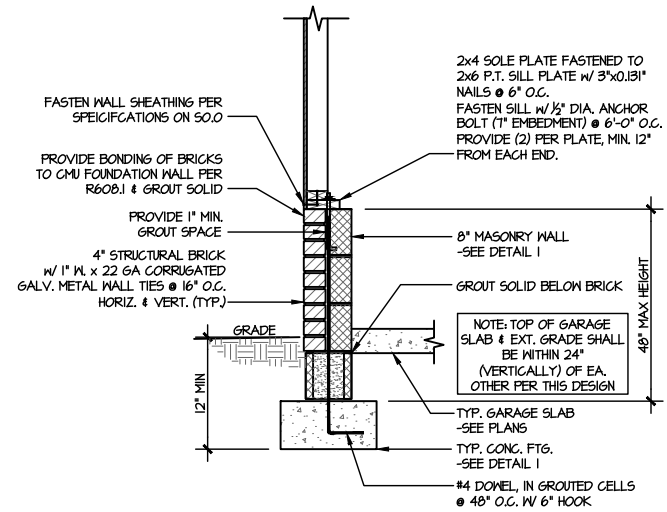


3 TYPICAL CRAWLSPACE FOUNDATION
@ EXTERIOR GARAGE WALL
SCALE: 3/8"=1'-0" W/ BRICK WATERTABLE

4 NOT USED
SCALE: 3/8"=1'-0"

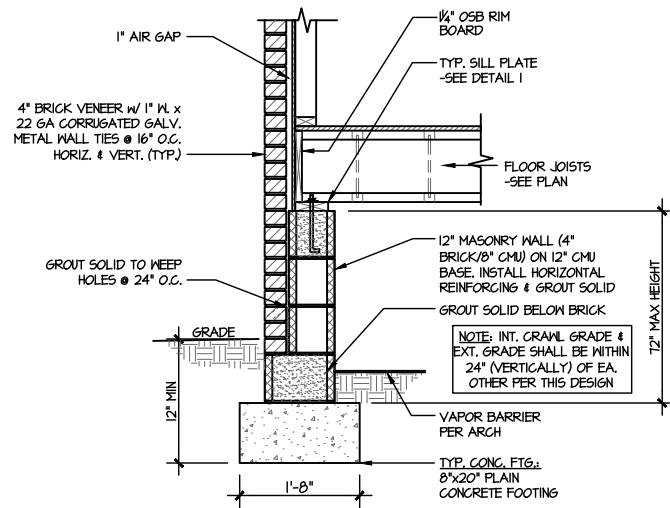


5 TYPICAL CRAWLSPACE FOUNDATION
SCALE: 3/8"=1'-0" W/ FULL BRICK VENEER

6 NOT USED
SCALE: 3/8"=1'-0"

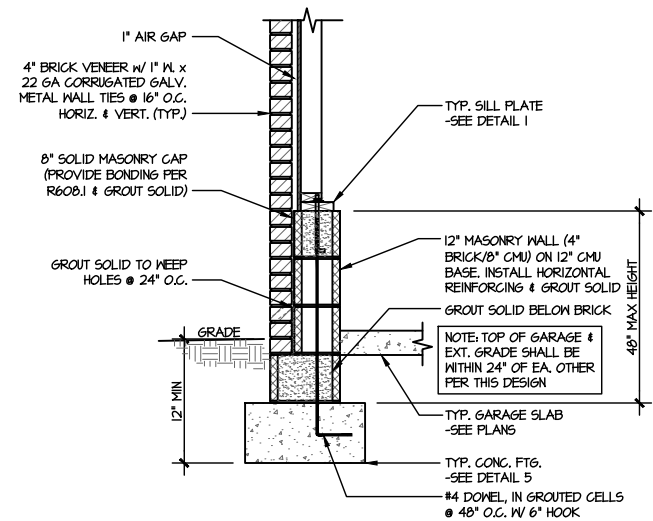


7 TYPICAL CRAWLSPACE FOUNDATION
@ EXTERIOR GARAGE WALL
SCALE: 3/8"=1'-0" W/ FULL BRICK VENEER


8 NOT USED
SCALE: 3/8"=1'-0"

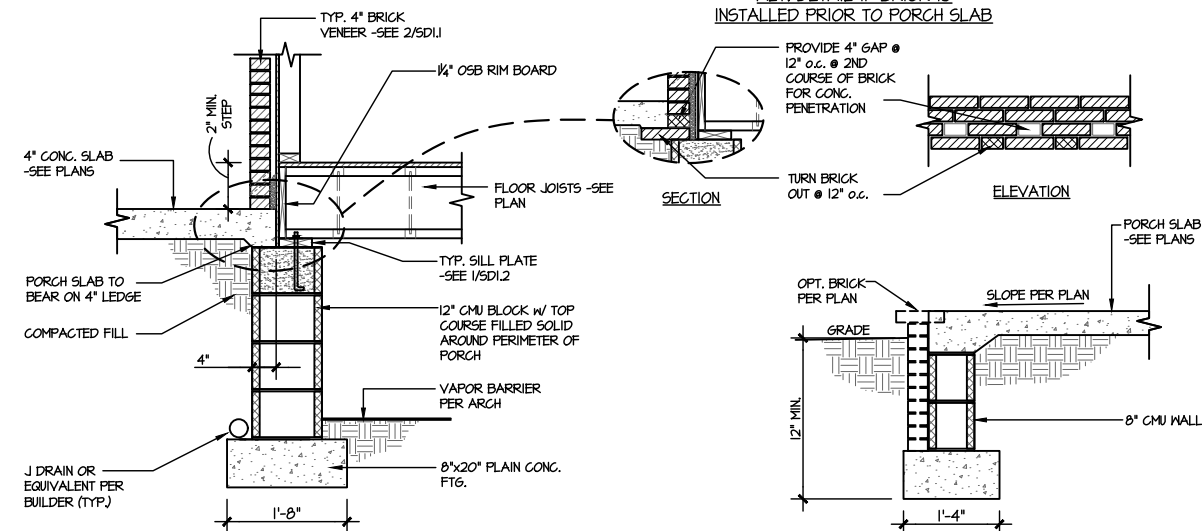


9 TYPICAL CRAWLSPACE FOUNDATION
@ PORCH/PATIO SLAB
SCALE: 3/8"=1'-0" W/ BRICK VENEER

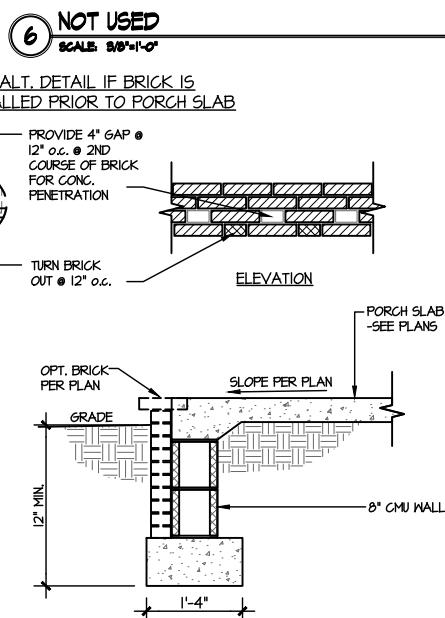

10 TYPICAL FOOTING @ PORCH SLAB
SCALE: 3/8"=1'-0"

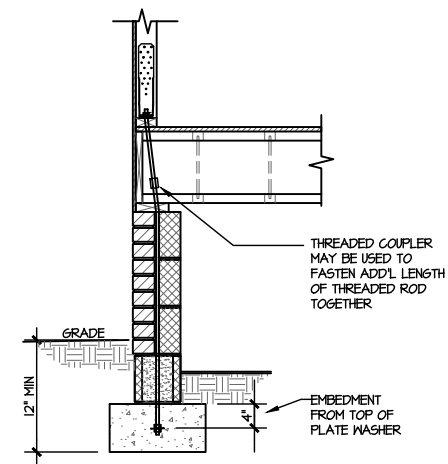

D TYPICAL CRAWLSPACE FOUNDATION
HOLD-DOWN INSTALLATION
SCALE: 3/8"=1'-0" W/ BRICK WATERTABLE

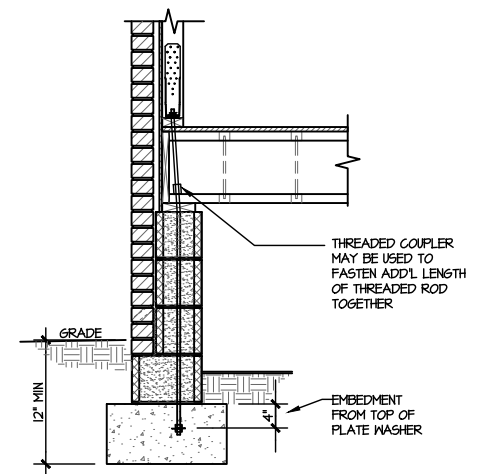

E TYPICAL CRAWLSPACE FOUNDATION
HOLD-DOWN INSTALLATION
SCALE: 3/8"=1'-0" W/ FULL BRICK VENEER



MULHERN+KULP
RESIDENTIAL STRUCTURAL ENGINEERING
300 Bluebirds Ave. Building 4 - Asheville, NC 28802
721.546.8001 • mulhern+kulp.com
NC License # C-3825



M&K project number:
192-19039
project mgr: SMK
drawn by: NGG
issue date: 12-20-19

REVISIONS:
date: initial:

ARCH: v.01.00.00.00



FOUNDATION DETAILS
RUSSELL
WIND SPEED < 115 MPH NORTH CAROLINA



MULHERN+KULP
RESIDENTIAL STRUCTURAL ENGINEERING
300 Bluebird Ave. Building 4 - Fenton, PA 15082
P 715-646-0011 • mulhern+kulp.com
NC License # C-3825




MS&K project number:
192-19039
project mgr: SMK
drawn by: NGG
issue date: 12-20-19

REVISIONS:
date: initial:


ARCH: v.01.00.00.00




FOUNDATION DETAILS
RUSSELL
WIND SPEED < 115 MPH NORTH CAROLINA

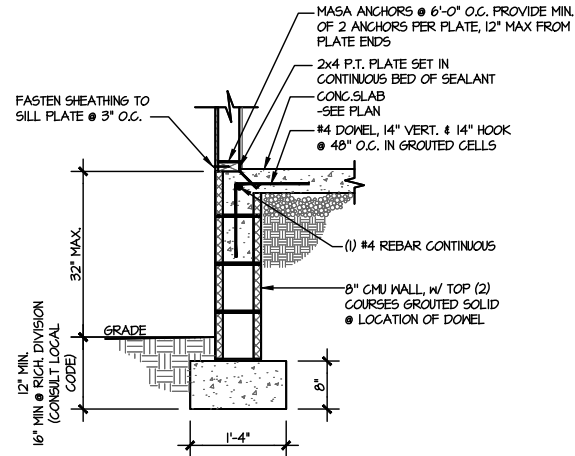


1 TYP EXT. FND WALL
SCALE: 3/8"=1'-0" RAISED SLAB CONDITION < 2'-6"

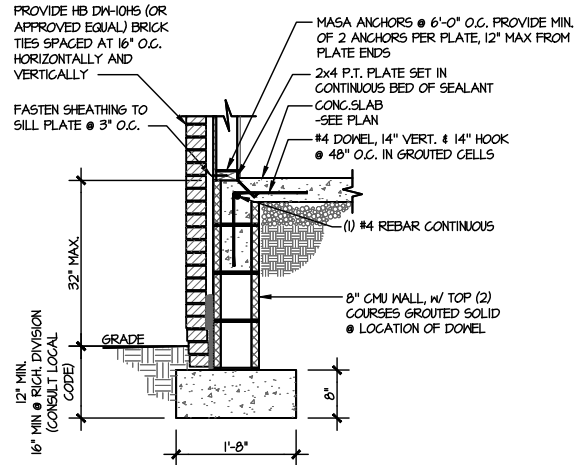


2 TYP EXT. FND WALL (BRICK)
SCALE: 3/8"=1'-0" RAISED SLAB CONDITION < 2'-6"

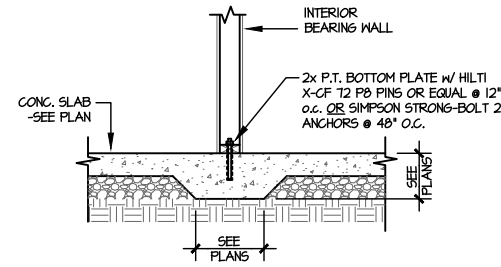


3 TYPICAL THICKENED SLAB @
INTERIOR BEARING WALL
SCALE: 3/8"=1'-0"

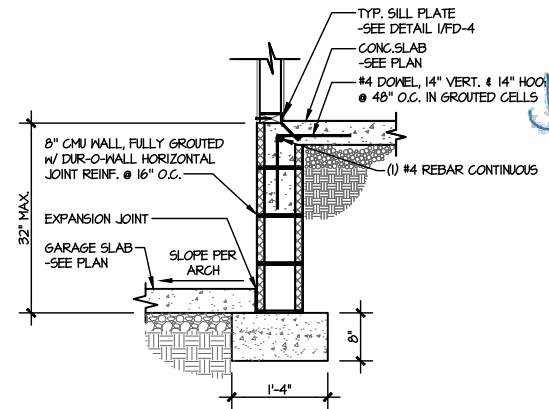


4 TYPICAL INT. FOOTING
BETWEEN HOUSE & GARAGE
SCALE: 3/8"=1'-0"

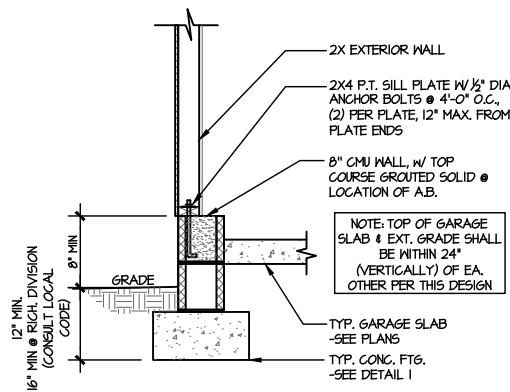


5 TYPICAL FOUNDATION
@ EXT. GARAGE WALL
SCALE: 3/8"=1'-0"

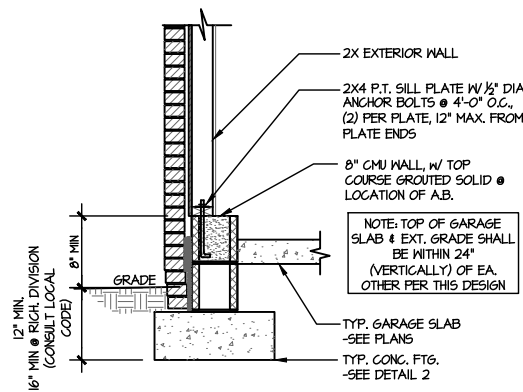


6 TYPICAL FOUNDATION
@ EXT. GARAGE WALL (BRICK)
SCALE: 3/8"=1'-0"

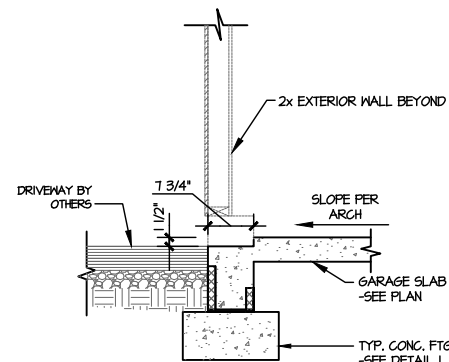


7 TYPICAL FOUNDATION
@ EXT. GARAGE WALL
SCALE: 3/8"=1'-0"

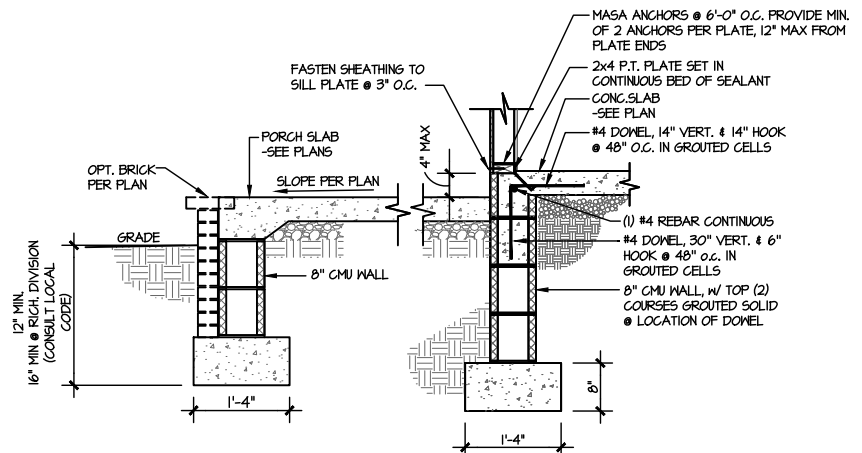


8 TYPICAL FOUNDATION @ PATIO/PORCH
SCALE: 3/8"=1'-0" RAISED SLAB CONDITION < 2'-6"

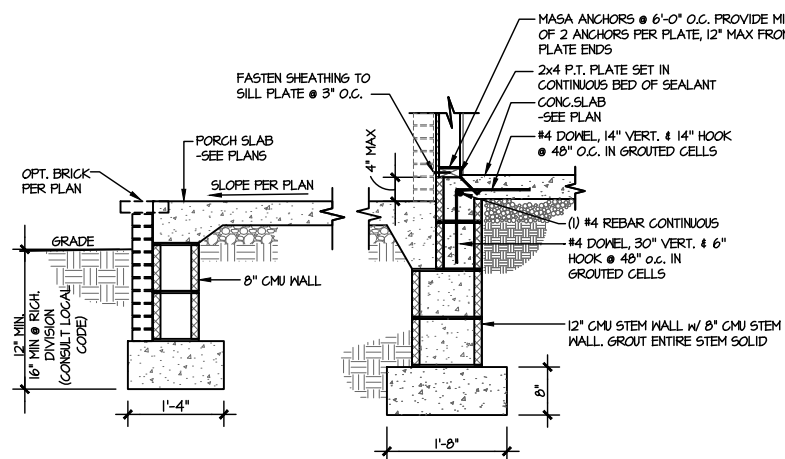


9 TYPICAL FOUNDATION @ PATIO/PORCH (BRICK)
SCALE: 3/8"=1'-0" RAISED SLAB CONDITION < 2'-6"

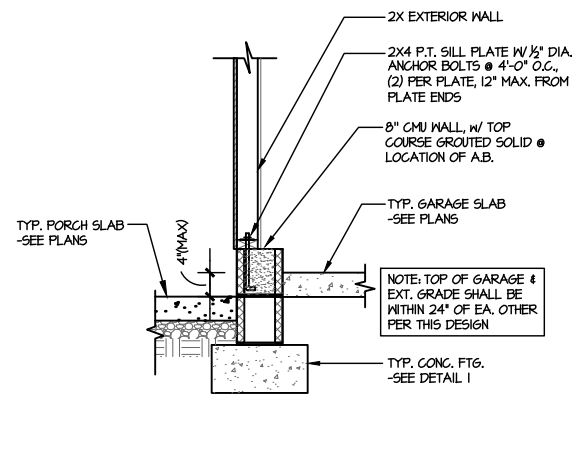

10 TYPICAL TURNDOWN @ COVERED
PORCH/ATTACHED GARAGE
SCALE: 3/8"=1'-0"

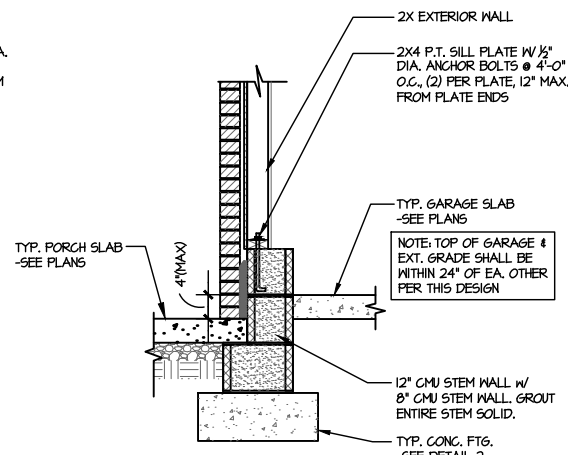

11 TYPICAL FOUNDATION @ COVERED
PORCH/ATTACHED GARAGE (BRICK)
SCALE: 3/8"=1'-0"

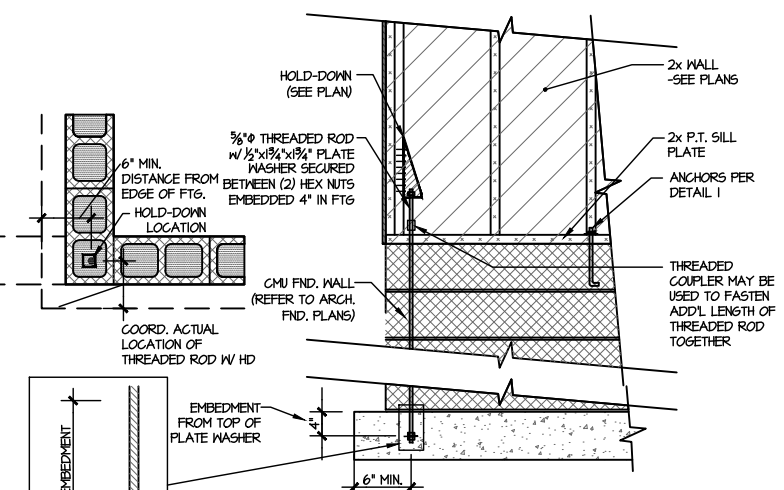

A TYPICAL CMU FOUNDATION
HOLD-DOWN INSTALLATION
SCALE: 3/8"=1'-0" (CORNER SHOWN - APPLICABLE TO ALL CONDITIONS)

- LEDGER TO END TRUSS:
 - FASTEN 2X LEDGER (MATCH D.J.) TO END TRUSS VERTICALS W/ (1) 1/2" DIA. THRU BOLT + (4) 3/8"x1.55" NAILS @ 16" O.C.
 - PACK OUT END TRUSS AS REQ'D FOR LEDGER FASTENING.
- LEDGER TO RIMBOARD/BLCKING:
 - FASTEN 2X LEDGER (MATCH D.J.) TO RIMBOARD/BLCKING W/ (1) 1/2" DIA. THRU BOLT + (4) 3/8"x1.55" NAILS @ 16" O.C.
- PROVIDE (2) BOLTS IN END (2) JOIST BAYS @ EACH END OF DECK
- INSTALL (1) SIMPSON HX CLIP ON LAST (2) DECK JOISTS @ EACH END OF DECK, CONNECTING SIDE OF JOIST TO TOP OF LEDGER (IRC R502.2.2)


- ALT. LEDGER SPEC:
 - FASTEN 2X10 LEDGER TO RIMBOARD W/ (2) 1/2" X 3/8" LONG SIMPSON SDS SCREWS @ 16" O.C.

• NOT APPLICABLE AT BRICK CONDITIONS



THIS IS A TRUSS PLACEMENT DIAGRAM (TPD) ONLY; NOT AN ENGINEERED DOCUMENT. Trusses are designed as individual building components to be incorporated into the building design at the specification of the building designer. See individual truss design drawings (TDD's) for each truss design identified on the TPD. The Contractor is responsible for the temporary bracing of the roof and floor system, and requirements for the permanent restraint/bracing of truss systems may be met by following the methods outlined in ANSI-TPI 1-2014 - 2.3.3. The design of the support structure including but not limited to headers, beams, walls, and columns is also the responsibility of the building designer. For general guidance regarding installation and bracing, consult "Building Component Safety Information" (BCSI) available from the SBC Association (www.sbcacomponents.com). It is the responsibility of the General Contractor to verify that the provided component layout matches the final intended construction plans, loading conditions, and use. If they do not, it is the responsibility of the General Contractor to notify UFP and provide plans containing the latest specifications and designs. UFP will not be responsible for plan changes by others after final approval of shop drawings, or for errors or modifications made on-site during construction. DO NOT CUT, NOTCH, DRILL, OR OTHERWISE "REPAIR" MANUFACTURED TRUSSES IN ANY WAY WITHOUT PRIOR WRITTEN AUTHORIZATION BY A LICENSED PROFESSIONAL DESIGNATED BY UFP. The Framing is responsible to verify all dimensions, including adjusting member spacing within tolerances to allow for the drop and rise of plumbing/HVAC, unless noted otherwise. Truss-to-wall connections, if shown, are for uplift only and do not consider lateral loads. All connectors on this project are to be installed per the connector manufacturer's specifications. All connectors shown that are not truss-to-truss are suggestions only and are to be verified by the Building Designer or Engineer of Record for suitability to this particular project. UFP accepts no responsibility for the specific application or suitability of any connector that is not truss-to-truss as they apply to this specific structure.

2ND FLOOR PLACEMENT PLAN

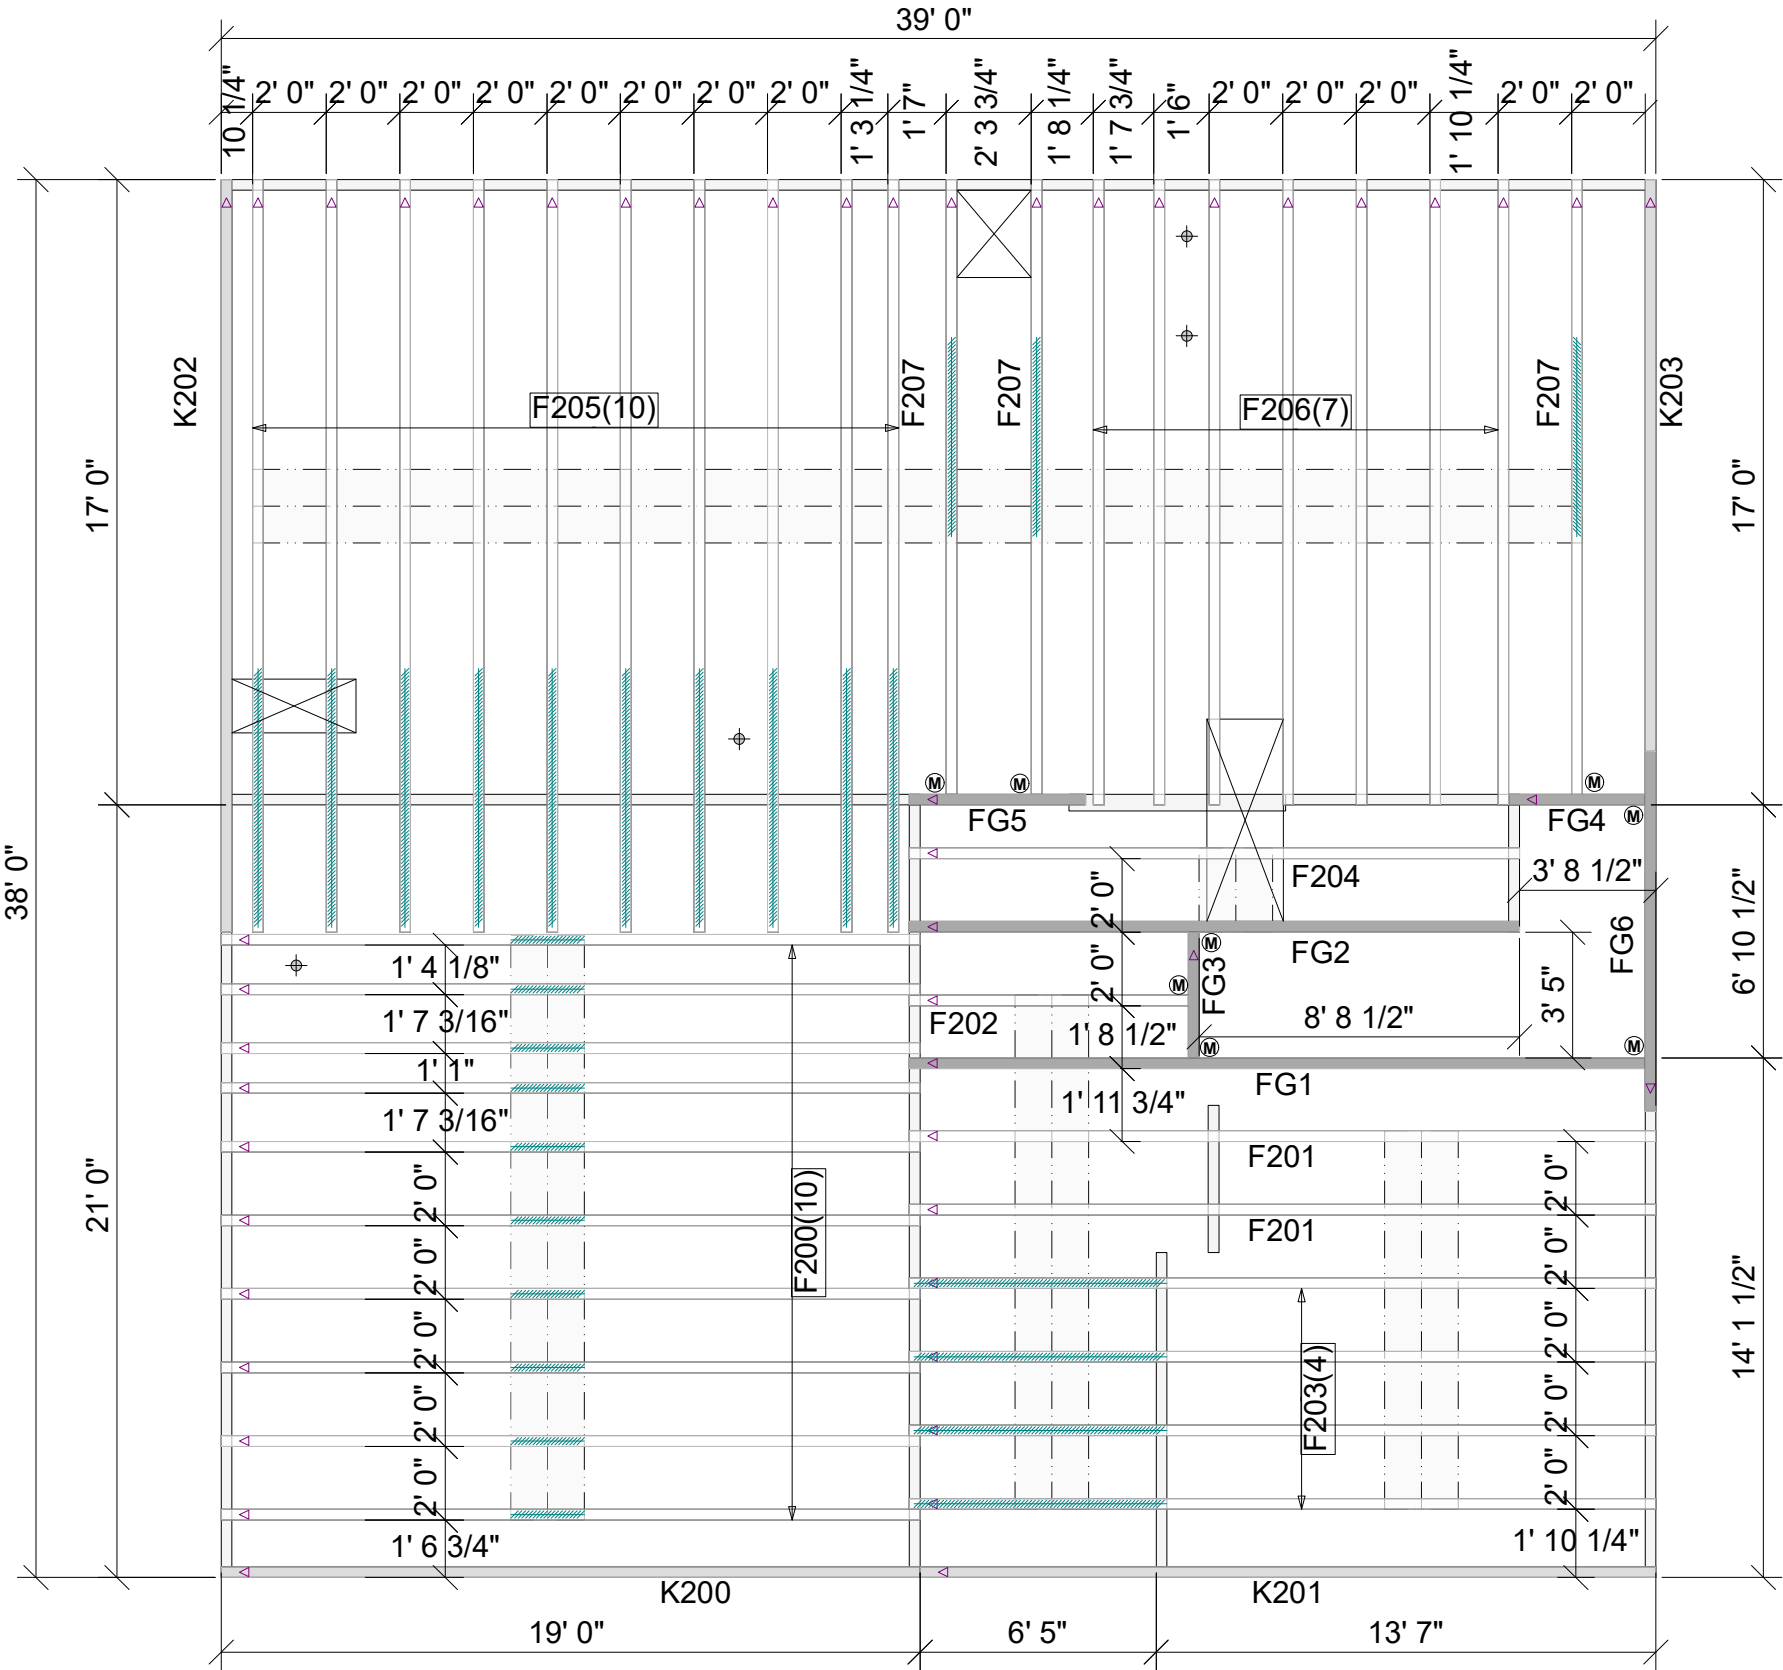

NOTE
F205 TRUSSES DESIGNED TO CANTILEVER
OVER REAR GARAGE WALL

Floor Hanger List		
MARK	TYPE	QTY
(M)	THA422	8

△ INDICATES LEFT END OF TRUSS SCALE: N.T.S

REVISIONS		DSN
DATE	DESCRIPTION	
-	-	-
-	-	-
DESIGNER	LJP
LAYOUT DATE	01/16/2025
ARCH DATE	-
STRUC DATE	-

JOB #: 25010936F2

RUSSELL B 2ND FLR	MUNGO HOMES
-------------------	-------------

This drawing is property of UFP Site Built, LLC. Any unauthorized use of this document without written permission is prohibited. UFP relinquishes ownership of delivered product upon delivery. Owner of product must obtain UFP's authorization prior to any alteration or modification of product. UFP will not be held responsible for any unauthorized modifications done or costs incurred without prior written authorization from UFP.

TRUSS TRAX

UPF CONSTRUCTION

Trustraupfp.com

UFP SITE BUILT

A UFP INDUSTRIES COMPANY

Burlington, NC

Chesapeake, VA

Clinton, NC

Conway, SC

Jefferson, GA

Starfield, NC

Locust, NC

Liberty, NC

Ooltewah, TN

Pearisburg, VA

Starfield, NC

Customer Service (800) 476-9356

THIS IS A TRUSS PLACEMENT DIAGRAM (TPD) ONLY; NOT AN ENGINEERED DOCUMENT. Trusses are designed as individual building components to be incorporated into the building design at the specification of the building designer. See individual truss design drawings (TDDs) for each truss design identified on the TPD. The Contractor is responsible for the temporary bracing of the roof and floor system, and requirements for the permanent restraint/bracing of truss systems may be met by following the methods outlined in ANSI-TPI 1-2014 - 2.3.3. The design of the support structure including but not limited to headers, beams, walls, and columns is also the responsibility of the building designer. For general guidance regarding installation and bracing, consult "Building Component Safety Information" (BCSI) available from the SBC Association (www.sbcacomponents.com). It is the responsibility of the General Contractor to verify that the provided component layout matches the final intended construction plans, loading conditions, and use. If they do not, it is the responsibility of the General Contractor to notify UFP and provide plans containing the latest specifications and designs. UFP will not be responsible for plan changes by others after final approval of shop drawings, or for errors or modifications made on-site during construction. DO NOT CUT, NOTCH, DRILL, OR OTHERWISE "REPAIR" MANUFACTURED TRUSSES IN ANY WAY WITHOUT PRIOR WRITTEN AUTHORIZATION BY A LICENSED PROFESSIONAL DESIGNATED BY UFP. The Framing is responsible to verify all dimensions, including adjusting member spacing within tolerances to allow for the drop and rise of plumbing/HVAC, unless noted otherwise. Truss-to-wall connections, if shown, are for uplift only and do not consider lateral loads. All connectors on this project are to be installed per the connector manufacturer's specifications. All connectors shown that are not truss-to-truss are suggestions only and are to be verified by the Building Designer or Engineer of Record for suitability to this particular project. UFP accepts no responsibility for the specific application or suitability of any connector that is not truss-to-truss as they apply to this specific structure.

ROOF PLACEMENT PLAN

