



### 9FT CEILING OPTION NOTES:

1. Fascia heights from 1st Flr of main house increase 12in.  
Fascia heights from 2nd Flr of main house remain the same.
2. Fascia/column heights at Front and Rear Porches  
remain the same (regardless of fascia @ main house.)
3. Roof pitch at porch may change. Follow notes at elevations.
4. Window heights and sizes remain the same.



B Square Footages:


935 ..... 301  
410 ..... 81  
120 ..... 220

**McDowell B**  
Genesis Series  
v.05.03.00.00

Features:  
Drawn By: ATW  
Rev By: oja  
am SH EB


Date: 12/2/2024

**A2**

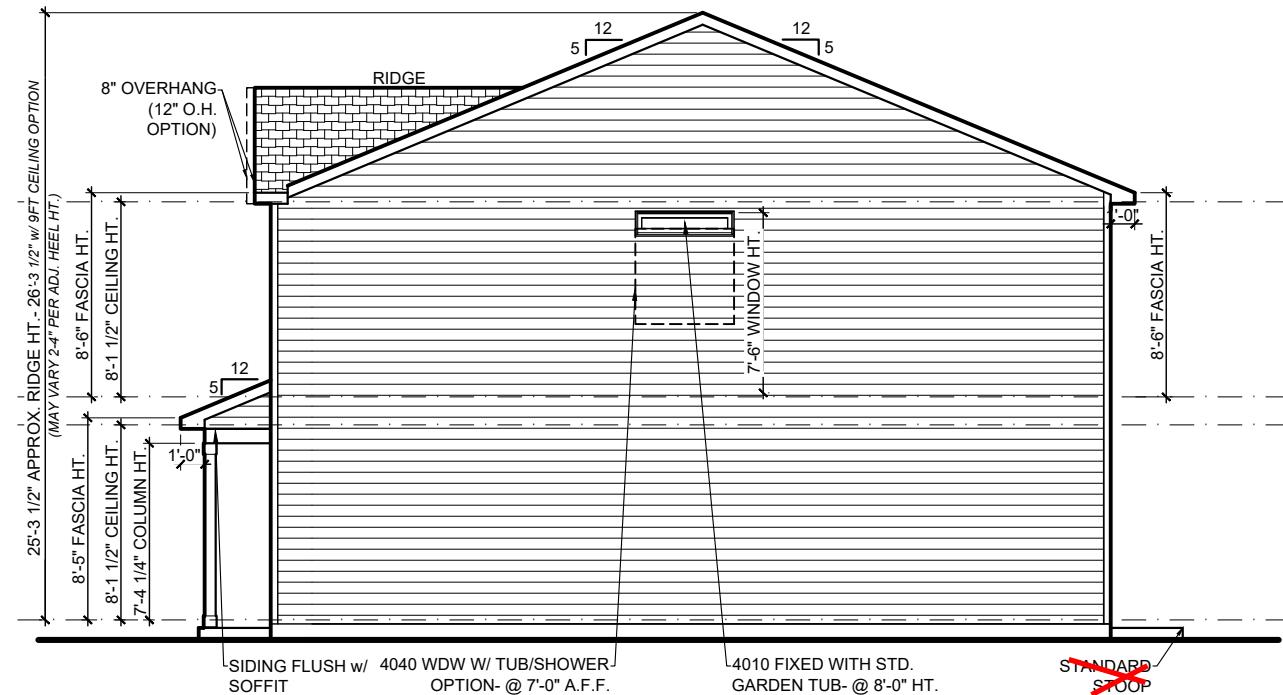


### RIGHT ELEVATION

1/8" = 1'-0"

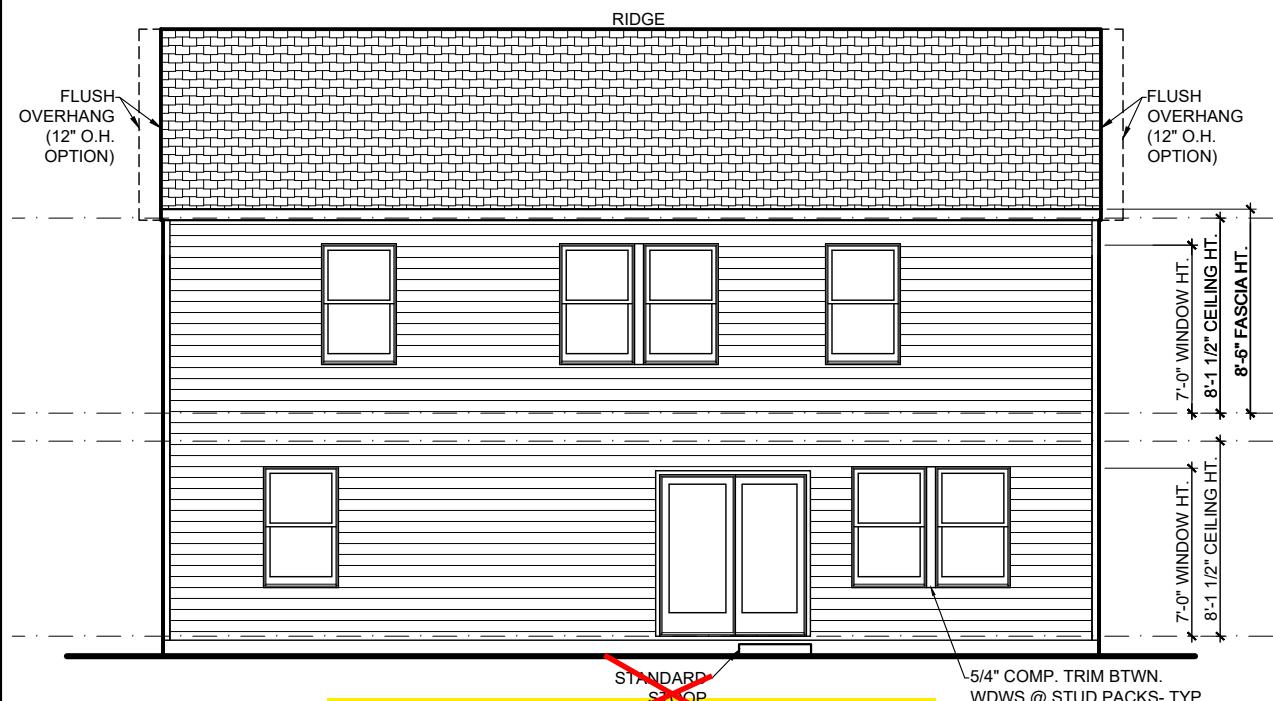

### REAR ELEVATION

1/8" = 1'-0"

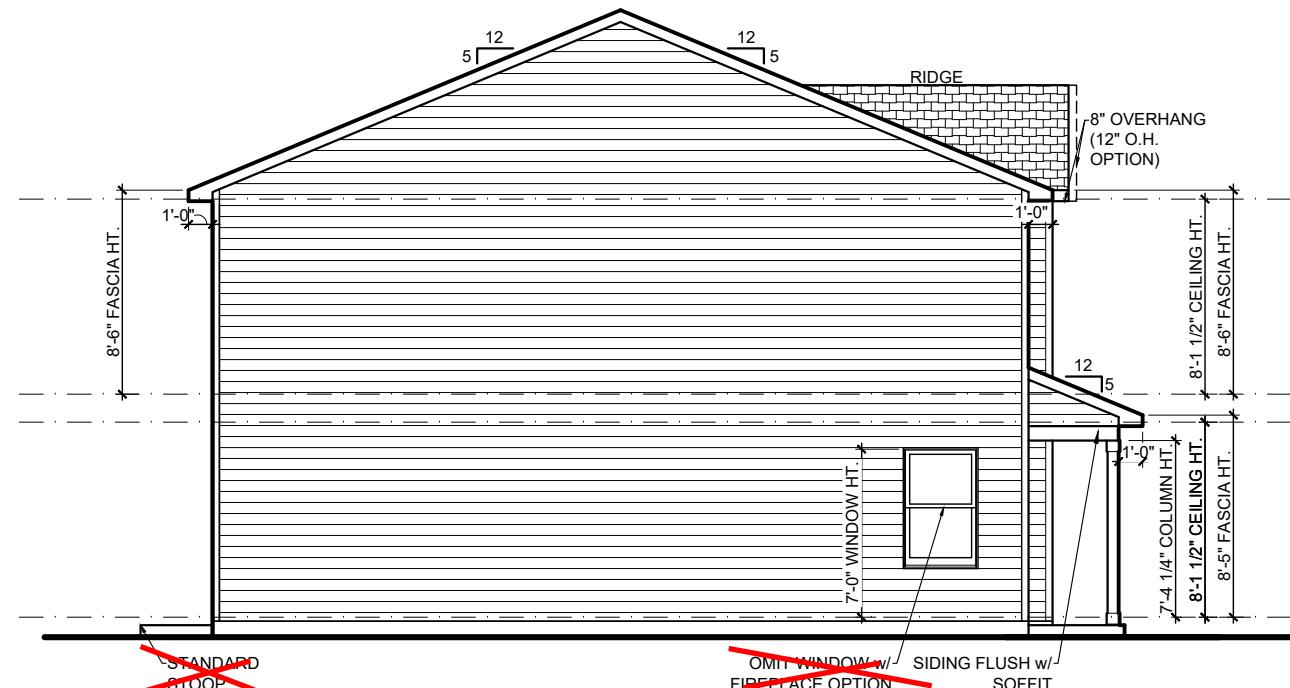

### LEFT ELEVATION

1/8" = 1'-0"




**NOTES:**  
 1. ALL OVERHANGS ARE 1'-0" U.N.O.  
 2. ROOF PLANS *DO NOT* INCLUDE FULL BRICK OPTIONS.  
 3. ROOF PLANS ARE NOT INTENDED FOR CONSTRUCTION USE.  
*(INFORMATIONAL USE ONLY)*  
 4. BE SURE TO CHECK OVERHANG INFORMATION AT PLAN  
 WHEN CALCULATING SOFFIT INTAKE

B Square Footages:

935  
 1301  
 410  
 81  
 120  
 220


**McDowell B**  
 Genesis Series  
 v.05.03.00.00

ROOF INFORMATION SUMMARY	
<b>MAIN ROOF-</b>	
<b>Base House:</b>	
Attic Square Footage.....	1345 sf
Flat Soffit.....	.59 lf
Ridge.....	.47 lf
<b>AREA(S) NOT AFFECTING MAIN ROOF-</b>	
<b>Front Porch:</b>	
Attic Square Footage.....	78 sf
Flat Soffit.....	.20 lf
Roof to Wall Ridge.....	.19 lf
<b>Rear Covered Porch Option:</b>	
Attic Square Footage.....	116 sf
Flat Soffit.....	.20 lf
Ridge.....	.9 lf
<b>3rd Car Garage Option :</b>	
Attic Square Footage.....	.220 sf
Flat Soffit.....	.22 lf
Ridge.....	.10 lf

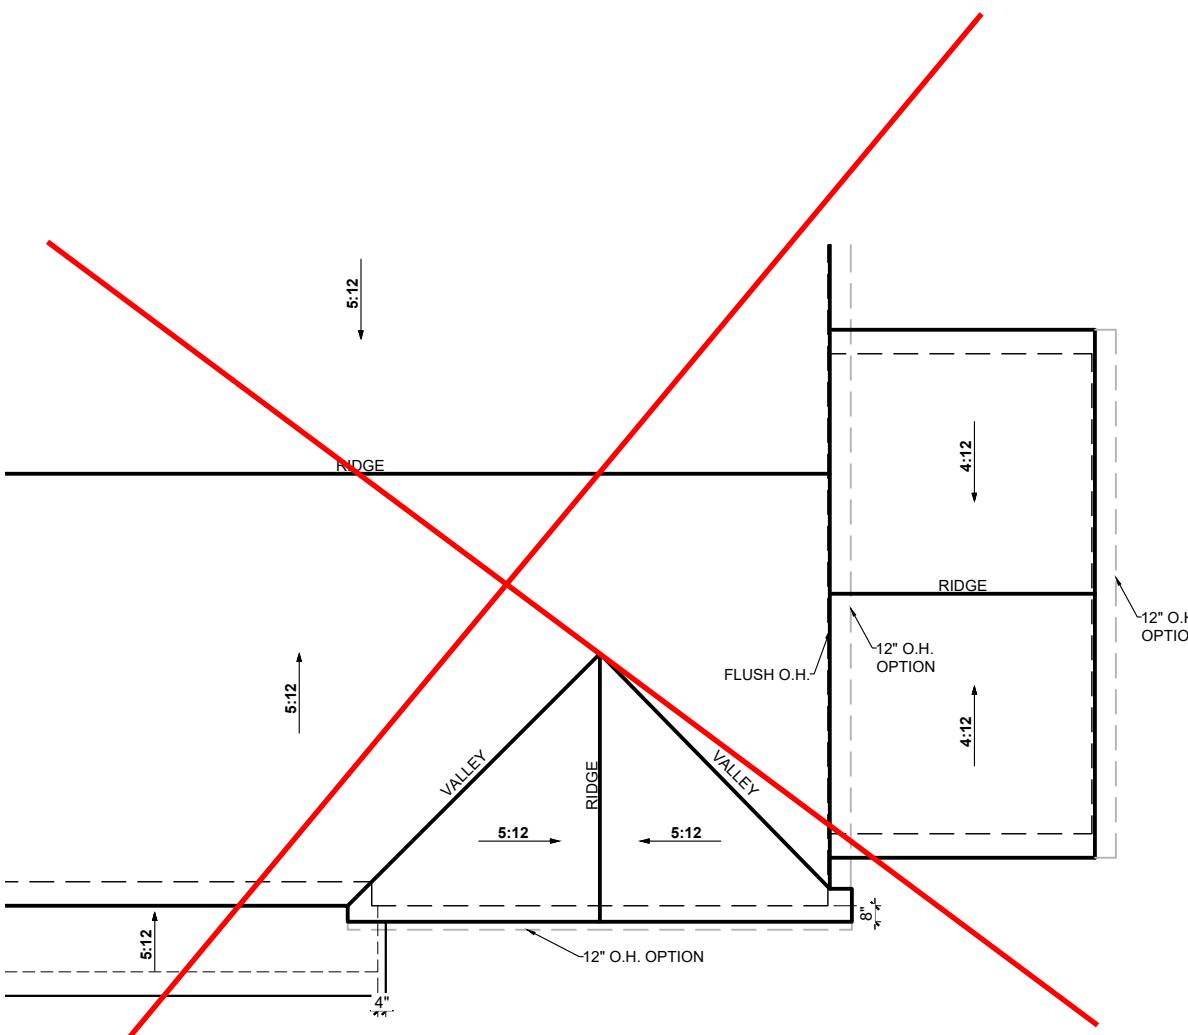

### 3-Car Garage Option

1/8" = 1'-0"

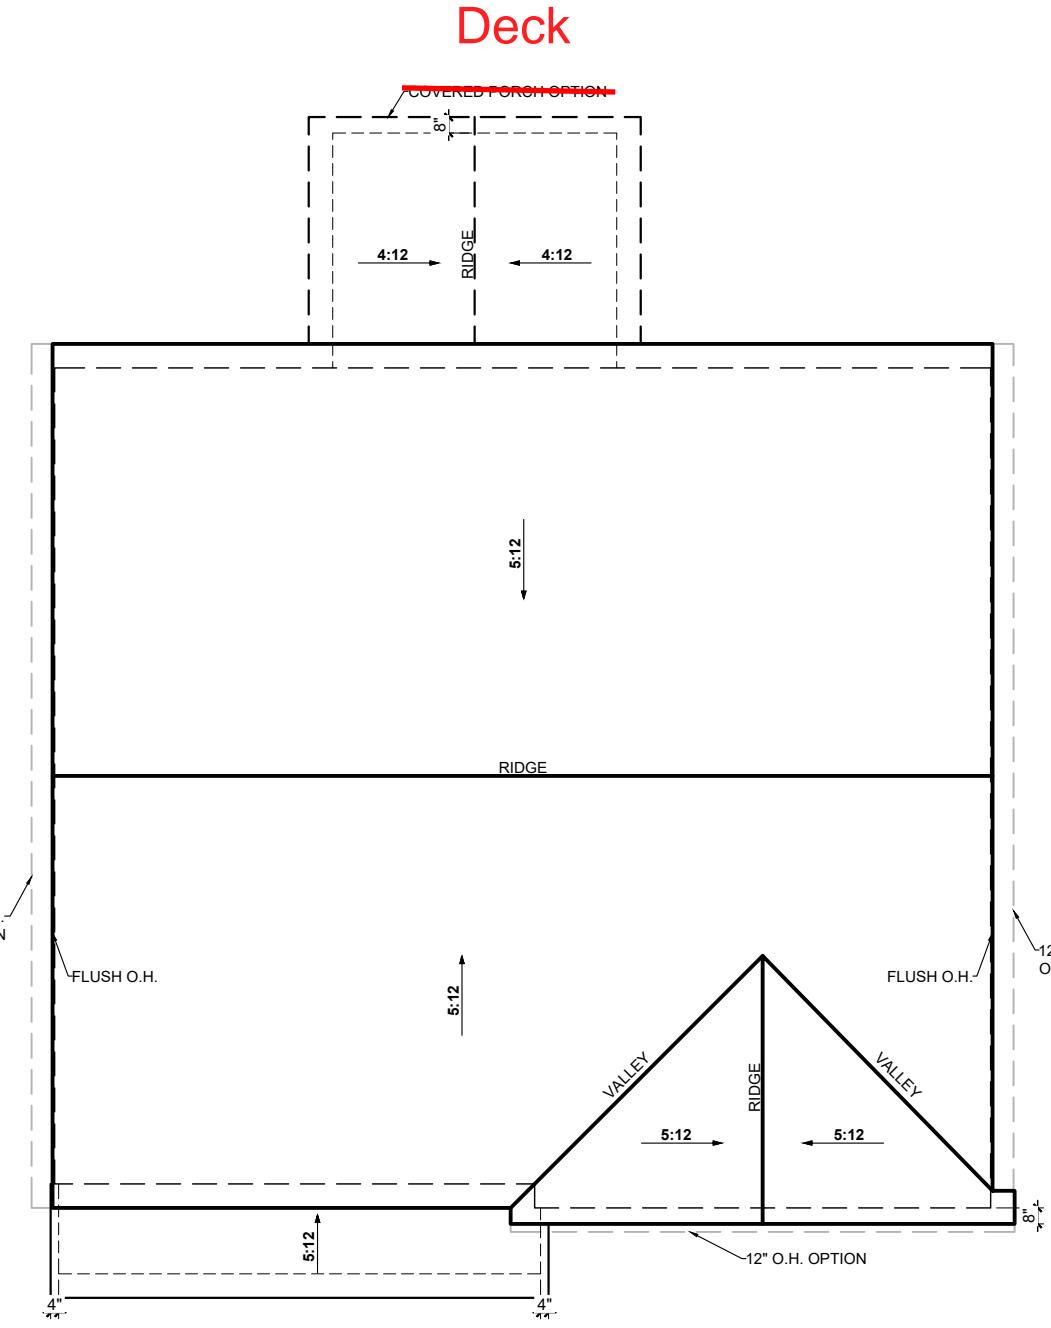


### ROOF PLAN

1/8" = 1'-0"

Features:	Rev By:ojia
Drawn By:ATW	am SH EB
Date: 12/2/2024	

**A-R 1**

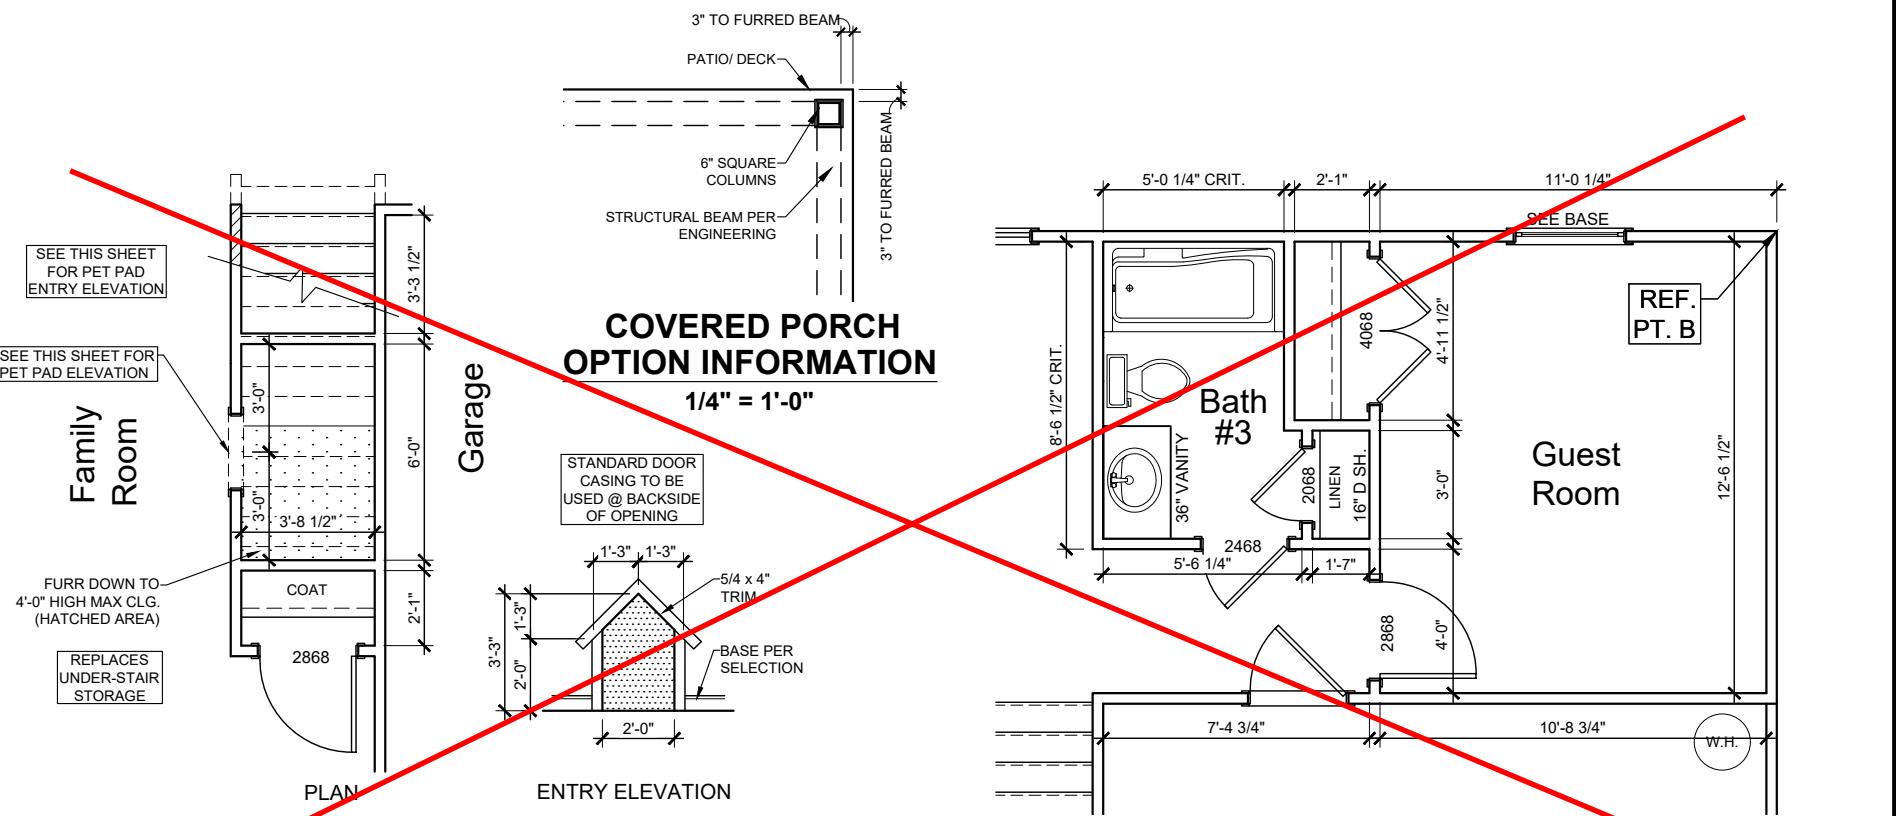

## ~~Pet Pad Option~~

~~3/16" = 1'-0"~~


## I.L.O. UNDER STAIR STO.

# Deck

## Guest Suite Option

$$\underline{3/16'' = 1'-0''}$$

I.L.O. FLEX

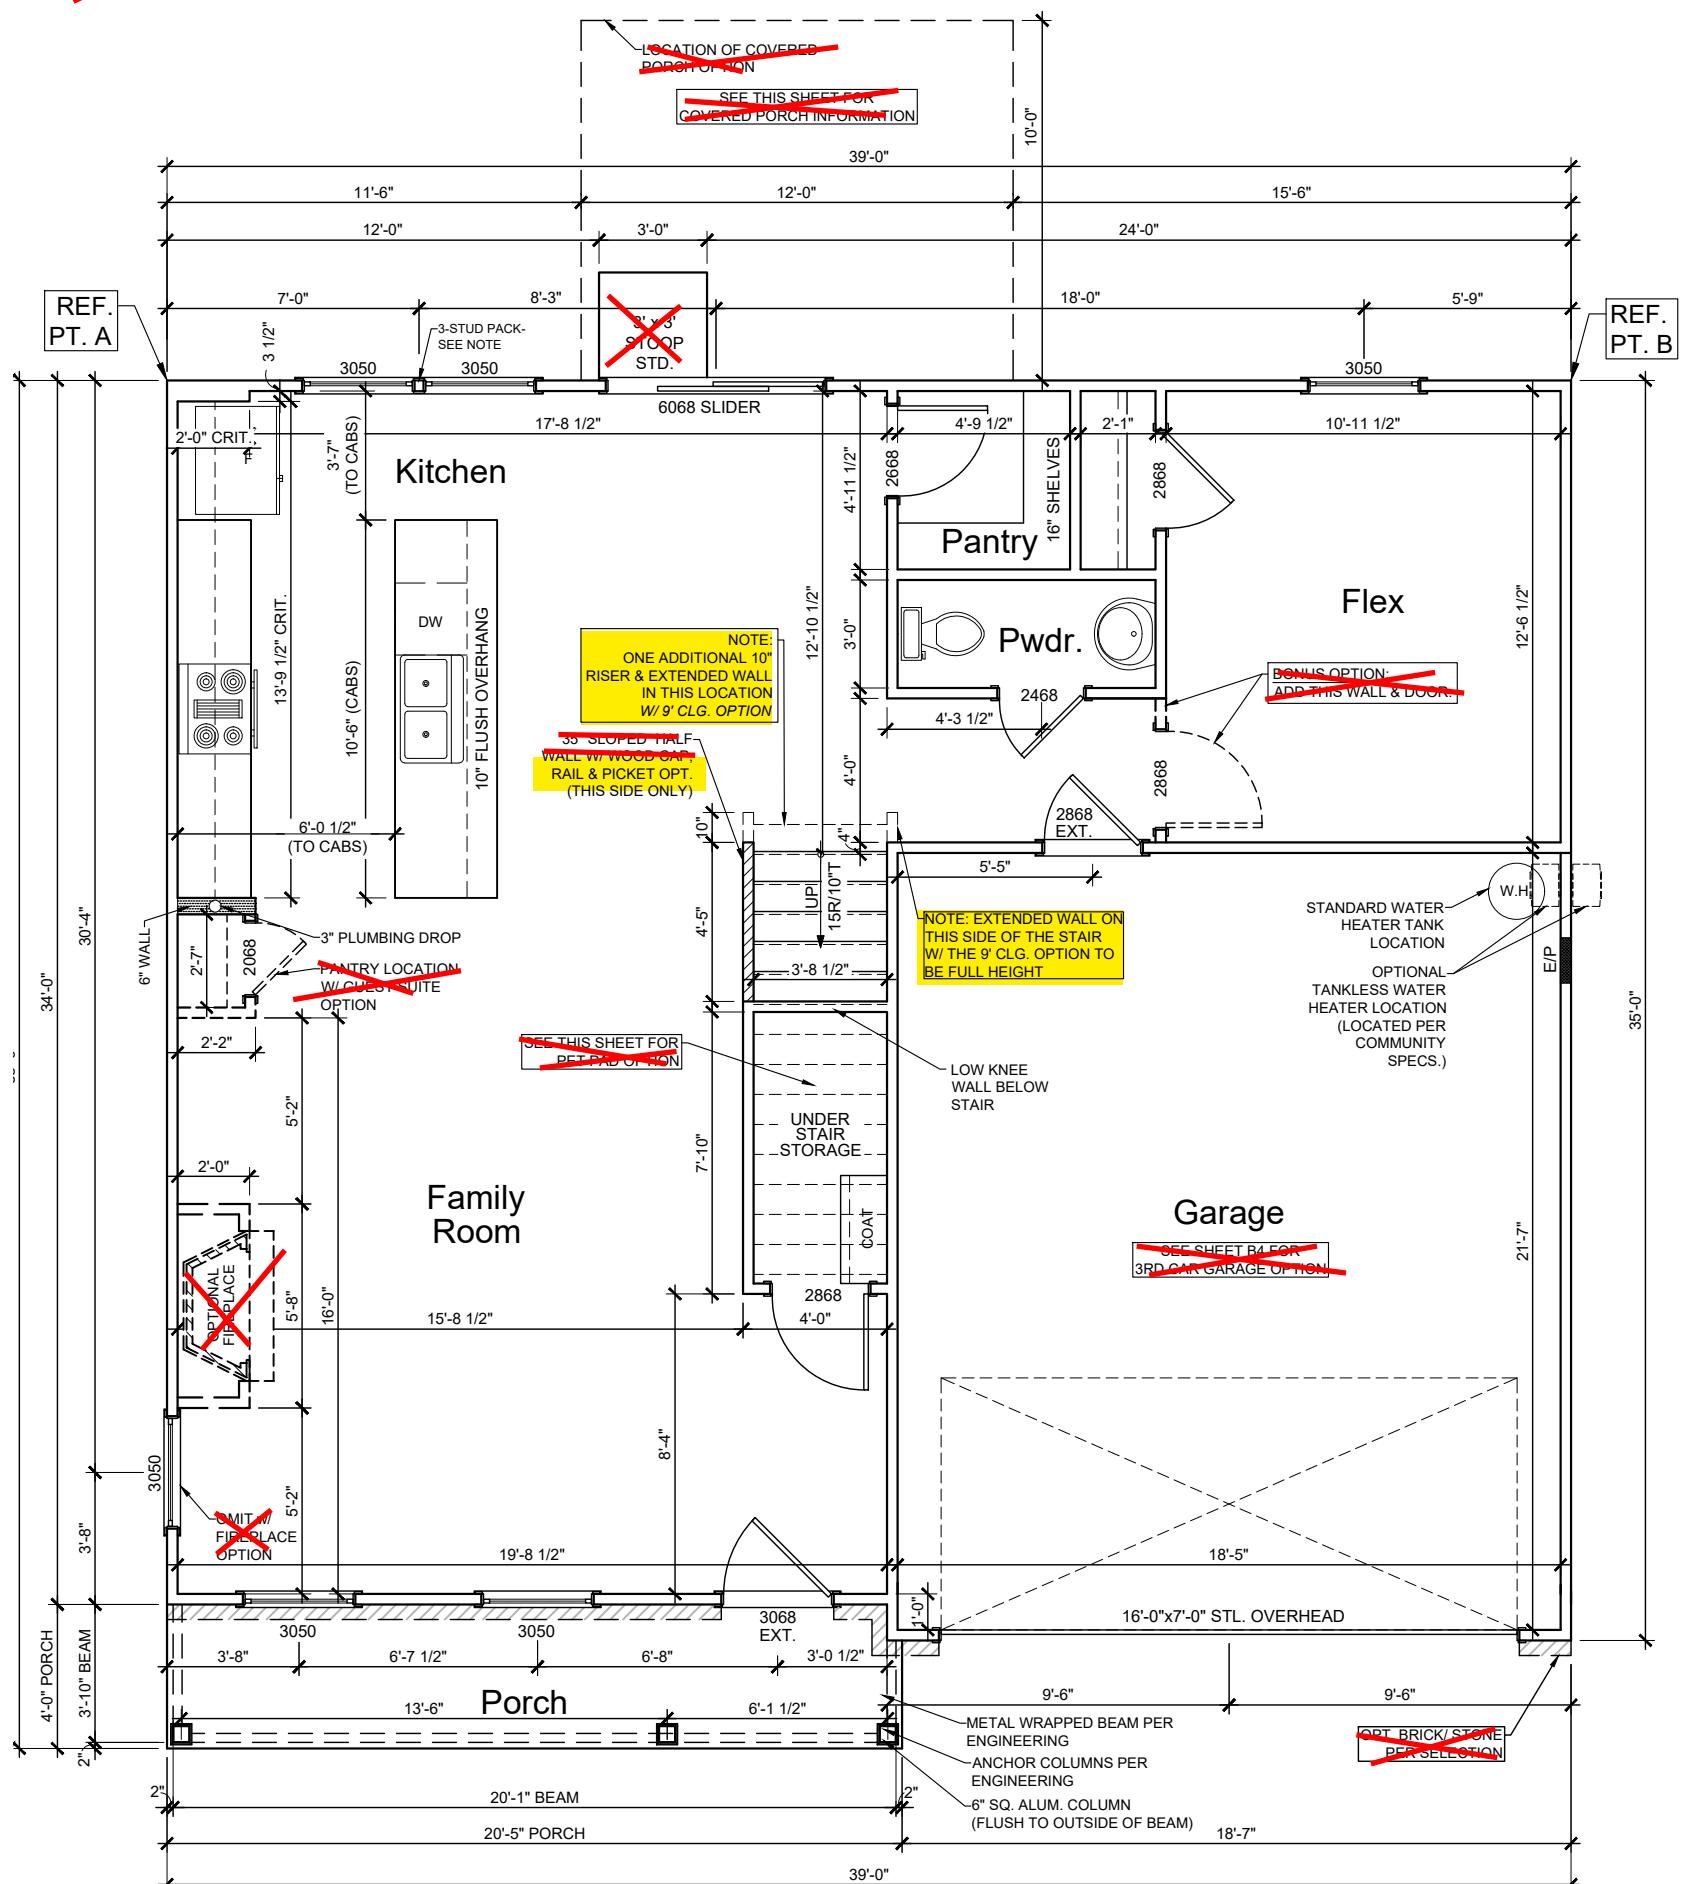

**NOTES:**

1. SEE ENGINEERING FOR FRAMING PLANS.
2. 8'-0" CEILING HEIGHTS @ 1ST FLOOR (9FT CLG. OPT.) U.N.O.
3. 8'-0" CEILING HEIGHTS @ 2ND FLOOR U.N.O.
4. WINDOW HEIGHTS VARY - FOLLOW ELEVATIONS CAREFULLY.
5. ALL ANGLES ARE 45° UNLESS NOTED OTHERWISE.

# **FIRST FLOOR**

**3- STUD PACK NOTE:**  
ALL FRAMING BETWEEN WINDOWS TO BE WRAPPED IN ICE & WATER SHIELD OR OTHER WEATHER RESISTANT BARRIER BEFORE WINDOWS ARE INSTALLED. MAINTAIN DRAINAGE PLAN FROM TOP TO BOTTOM WITH HOUSEWRAP- TYPICAL.

三

## Features:

Drawn By:ATW

# McDowell B


Genesis Series  
v.05.03.00.00

1st Floor.....	935
2nd Floor.....	1301
Garage.....	410
Front Porch.....	81
Covered Porch Option.....	120


## B Square Footages




3-STUD PACK NOTE:  
ALL FRAMING BETWEEN WINDOWS TO BE WRAPPED IN ICE &  
WATER SHIELD OR OTHER WEATHER RESISTANT BARRIER  
BEFORE WINDOWS ARE INSTALLED. MAINTAIN DRAINAGE  
PLAN FROM TOP TO BOTTOM WITH HOUSEWRAP- TYPICAL.

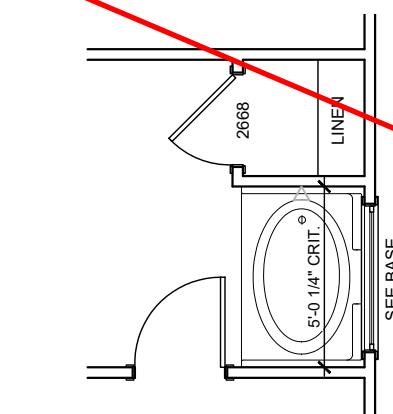

**42" Garden Tub w/  
Shower Walls Option**  
3/16" = 1'-0"  
@ PRIMARY BATH

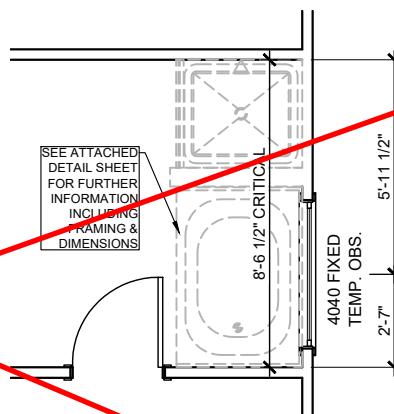

**Tub/ Shower Option**  
FOR ORIENTATION PURPOSES ONLY  
@ PRIMARY BATH @ 2ND FLOOR

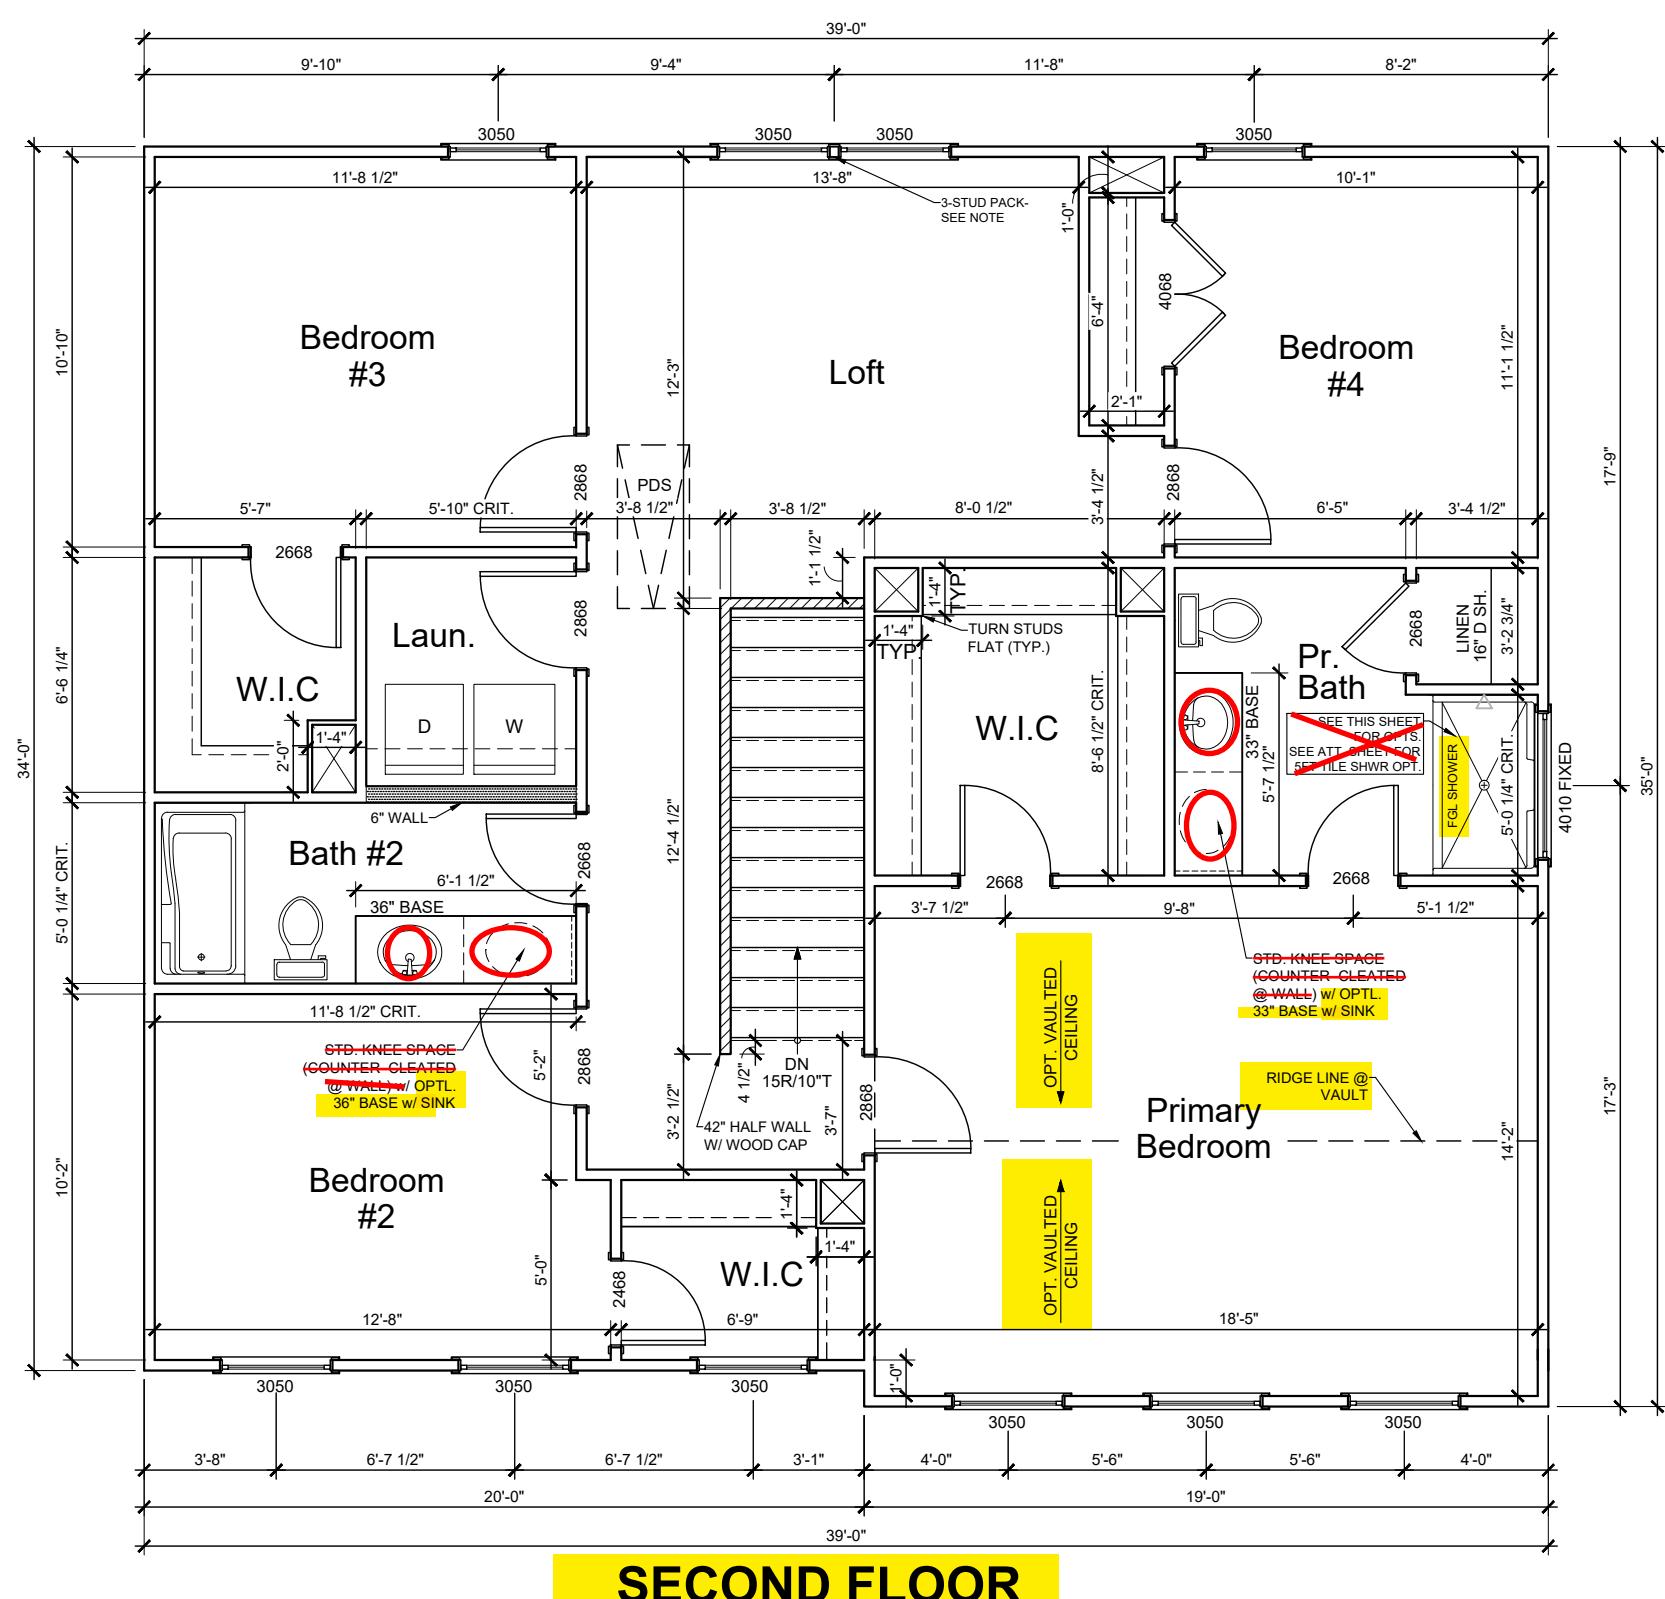

**B2**

Features:

Drawn By: ATW Rev By: cja am SH EB

Date: 5/16/2024


**McDowell B**  
Genesis Series  
v.05.03.00.00

1st Floor.....935  
2nd Floor.....1301  
Garage.....410  
Front Porch.....81  
Covered Porch Option.....120  
3rd Car Garage Option.....220


B Square Footage:



**NOTES:**  
 1. SEE ENGINEERING FOR STRUCTURAL INFORMATION  
 2. CONTROL JOINTS  
 • PROVIDE CONTROL JOINTS AT ALL INSIDE CORNERS OF SLAB EDGES, AND OTHER LOCATIONS WHERE SLAB CRACKS ARE LIKELY TO DEVELOP.  
 • JOINTS SHALL BE LOCATED @ 10'-0" O.C. (RECOMMENDED) OR 15'-0" O.C. (MAXIMUM).  
 • JOINT GRID PATTERN SHALL BE AS CLOSE TO SQUARES AS POSSIBLE (1:1 RATIO), WITH A MAXIMUM OF 1:1.5 RATIO.  
 • CONTROL JOINTS SHALL NOT BE INSTALLED IN STRUCTURAL SLABS.

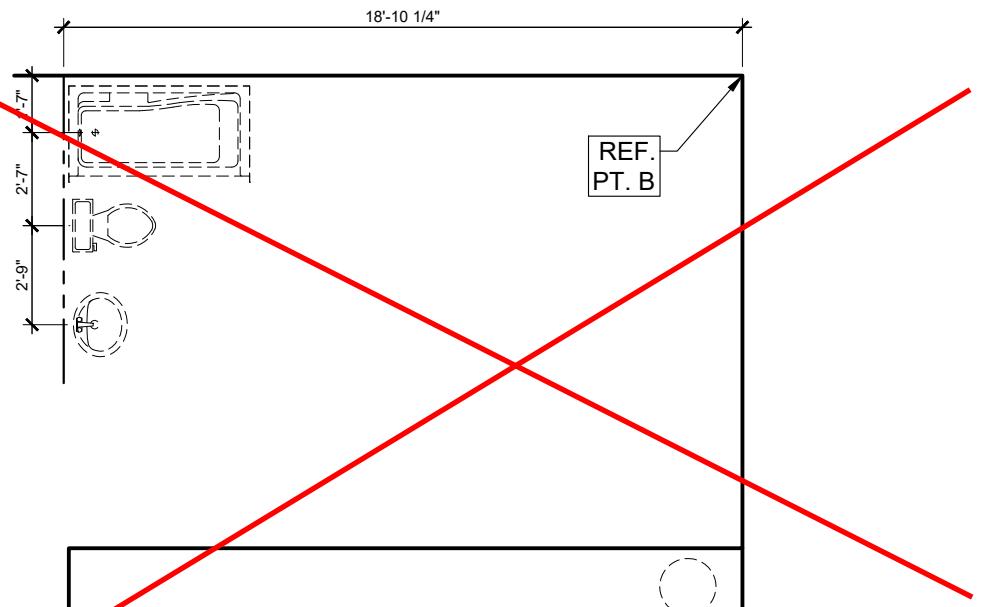

**Guest Suite Opt.**  
 $3/16" = 1'-0"$  I.L.O. FLEX

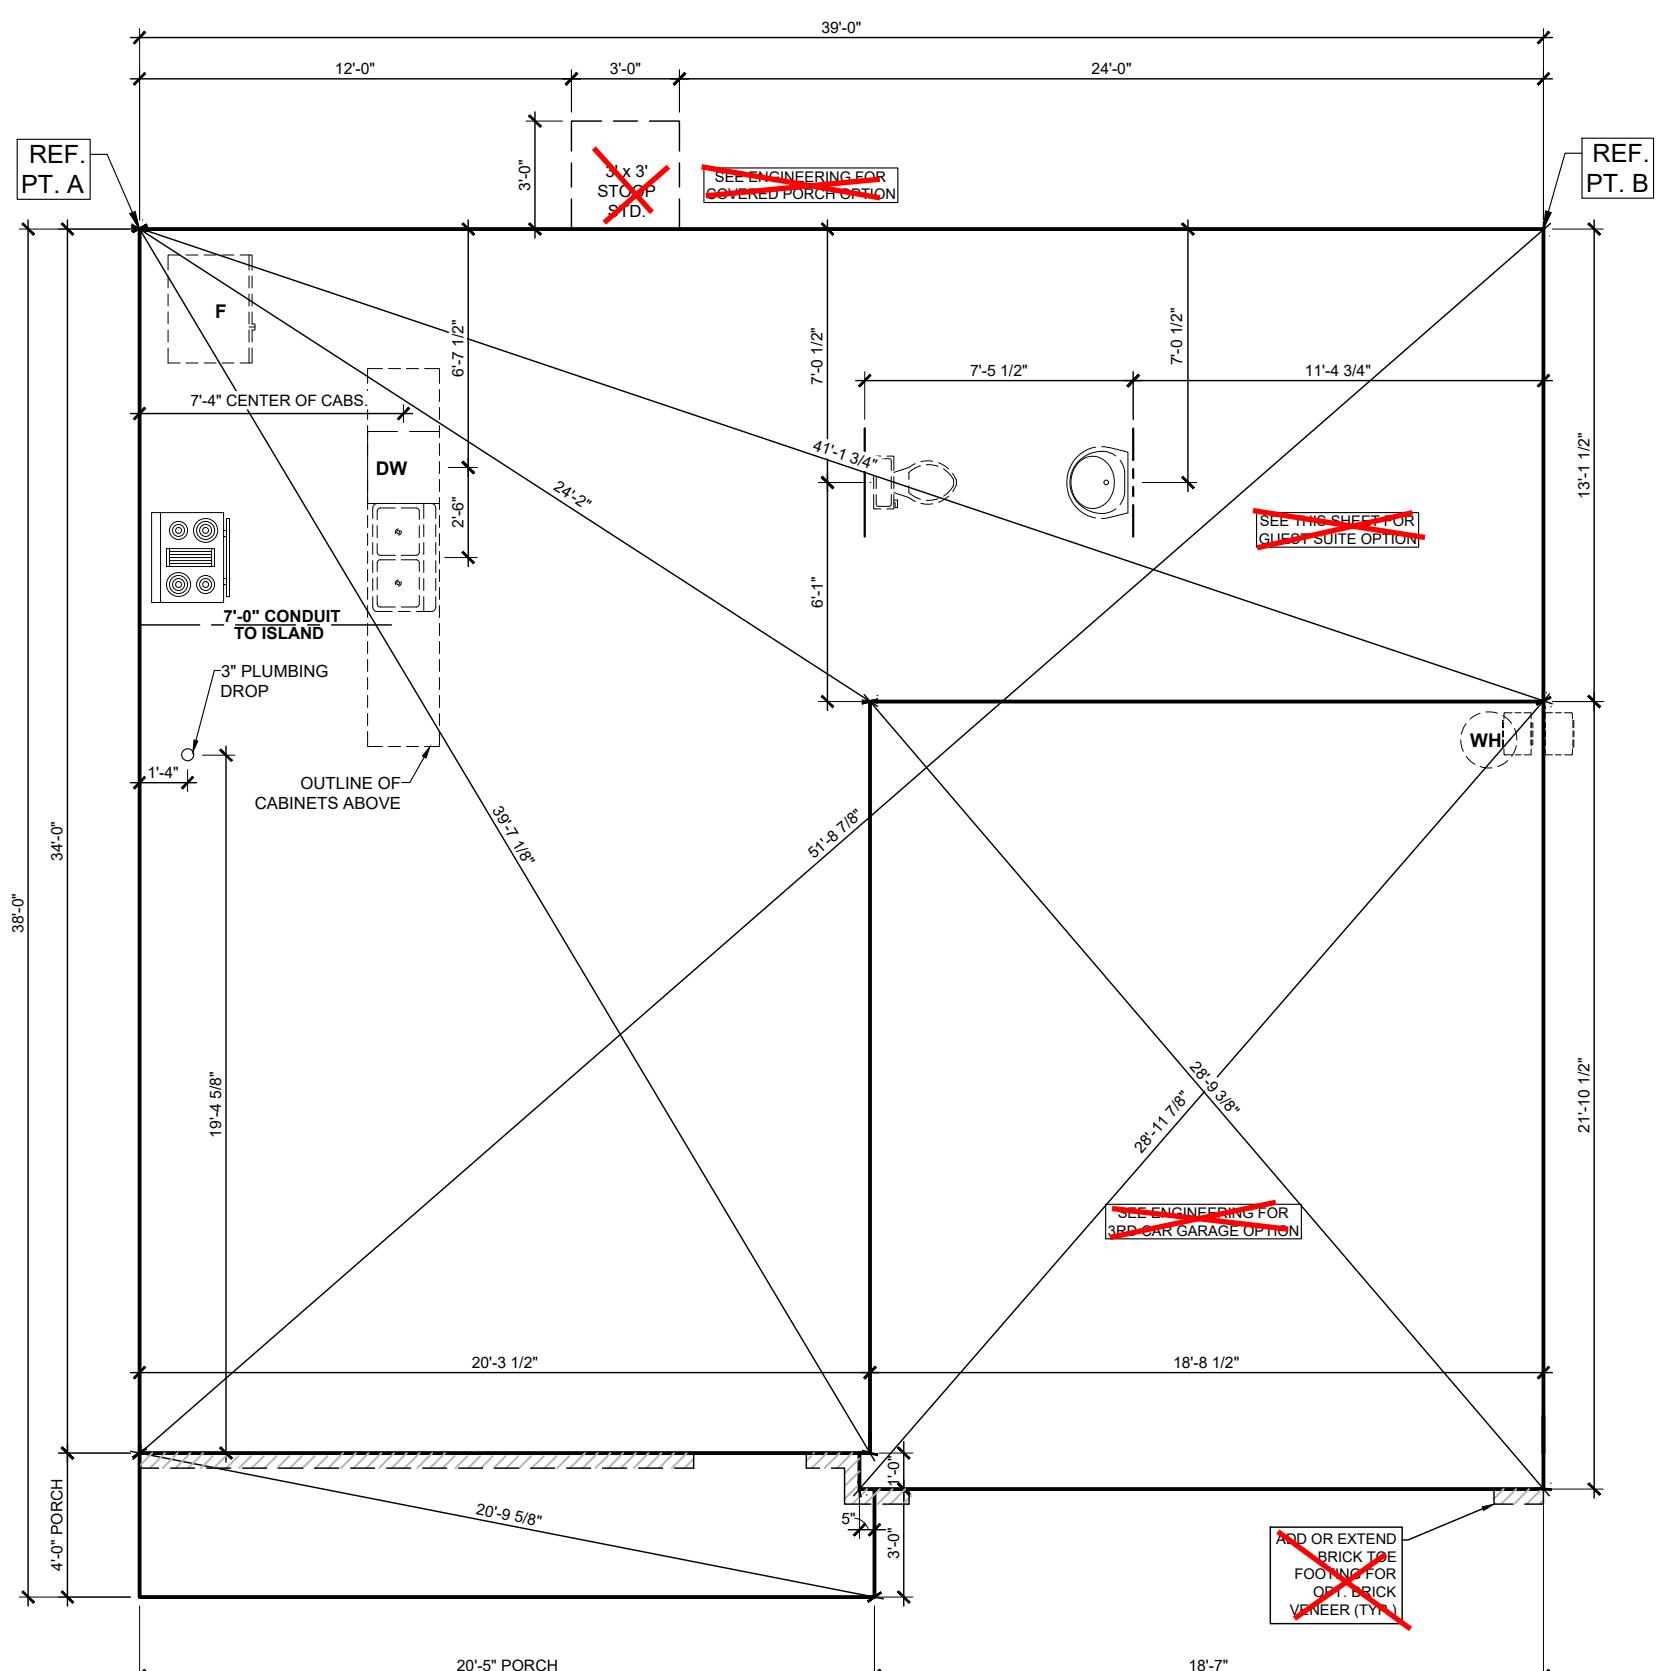

## FOUNDATION INFORMATION SHEET

$3/16" = 1'-0"$

**B3**

Features:  
**FOUNDATION INFO. SHEET**

Drawn By: ATW  
 Rev By: cja  
 am SH EB


Date: 12/2/2024

**McDowell B**  
 Genesis Series  
 v.05.03.00.00

1st Floor.....935  
 2nd Floor.....1301  
 Garage.....410  
 Front Porch.....81  
 Covered Porch Option.....120  
 3rd Car Garage Option.....220

B Square Footages:



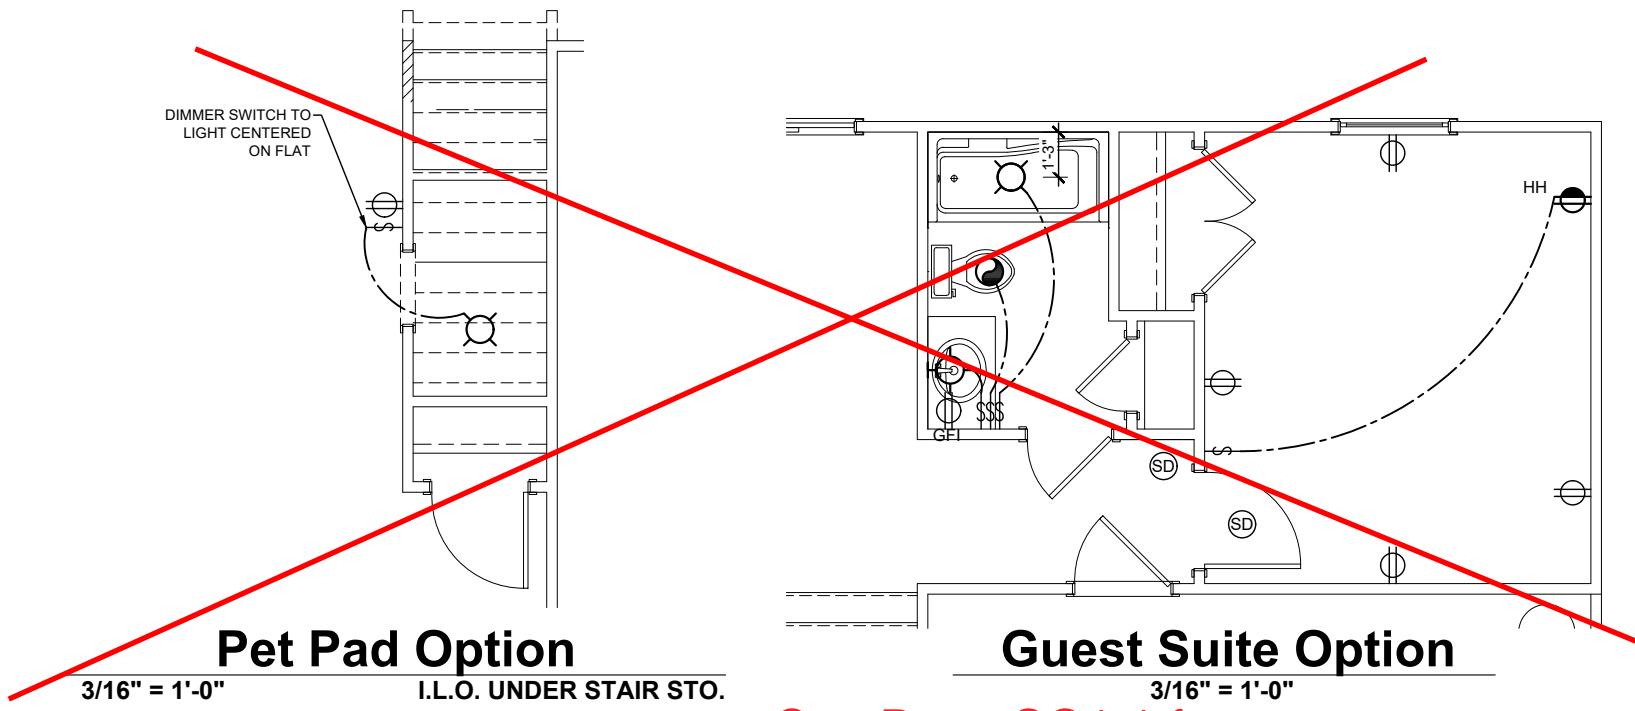


## Pet Pad Option

## Guest Suite Option

**3/16" = 1'-0"**

See Page SO1.1 for  
Opt. Wood Deck

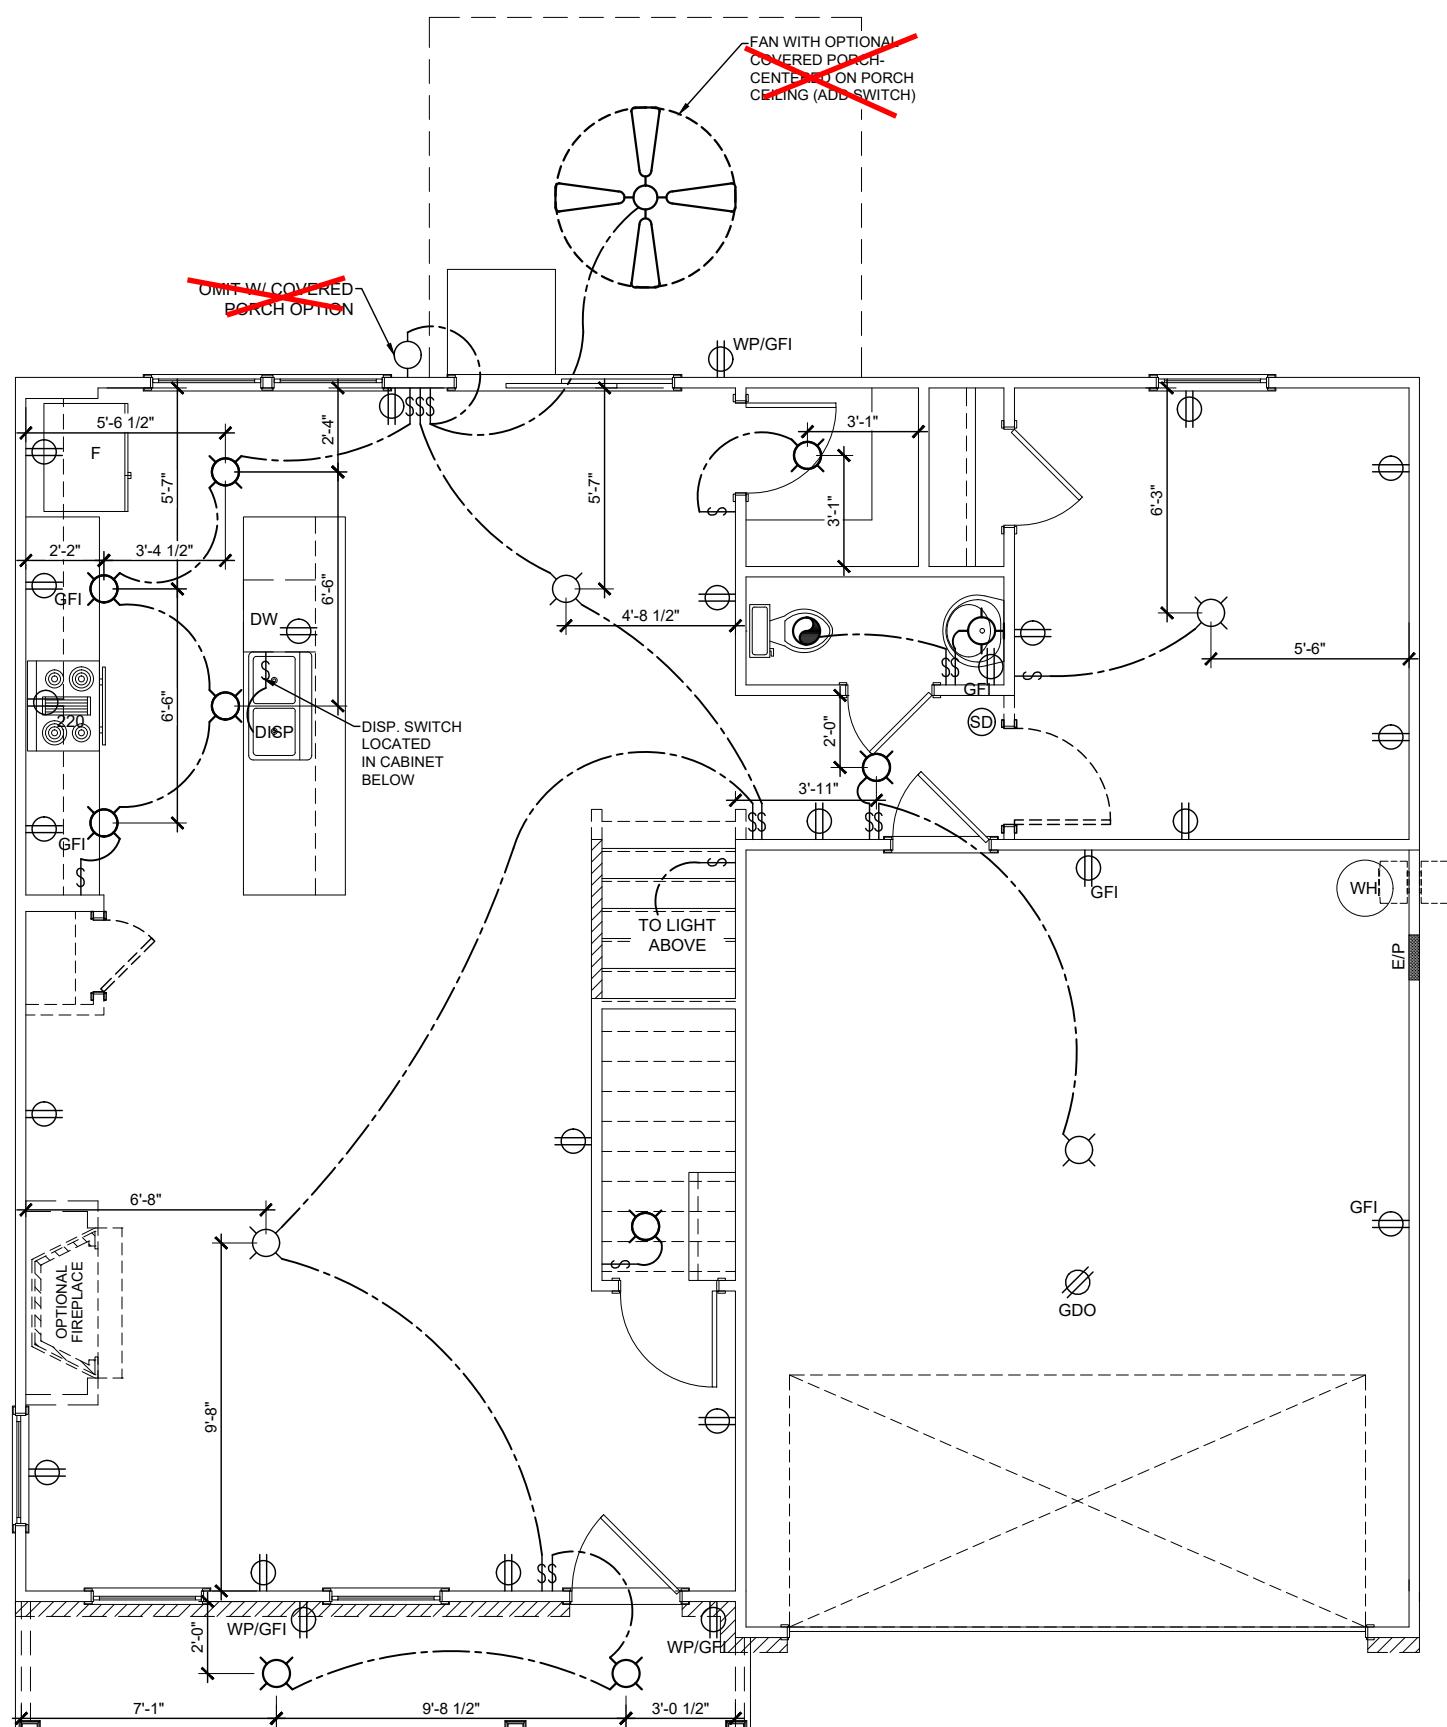

FIRST FLOOR - ELECTRICAL

**3/16" = 1'-0"**

四

---

Page 4

Drawn By:ATW

Date: 12/2/2024


# McDowell B

Genesis Series

1st Floor.....	935
2nd Floor.....	1301
Garage.....	410
Front Porch.....	81
Covered Porch Option.....	120
3rd Car Garage Option.....	220

B Square Footages:



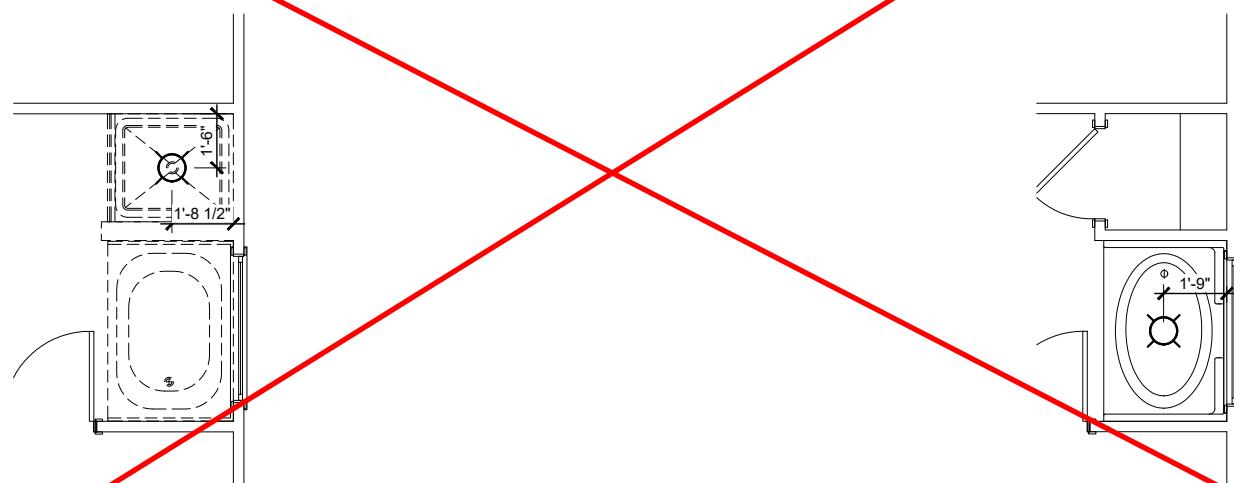


### ~~Tub/ Shower Option~~

FOR ORIENTATION PURPOSES ONLY  
@ PRIMARY BATH @ 2ND FLOOR

### ~~42" Garden Tub w/ Shower Walls Option~~

3/16" = 1'-0" @ PRIMARY BATH

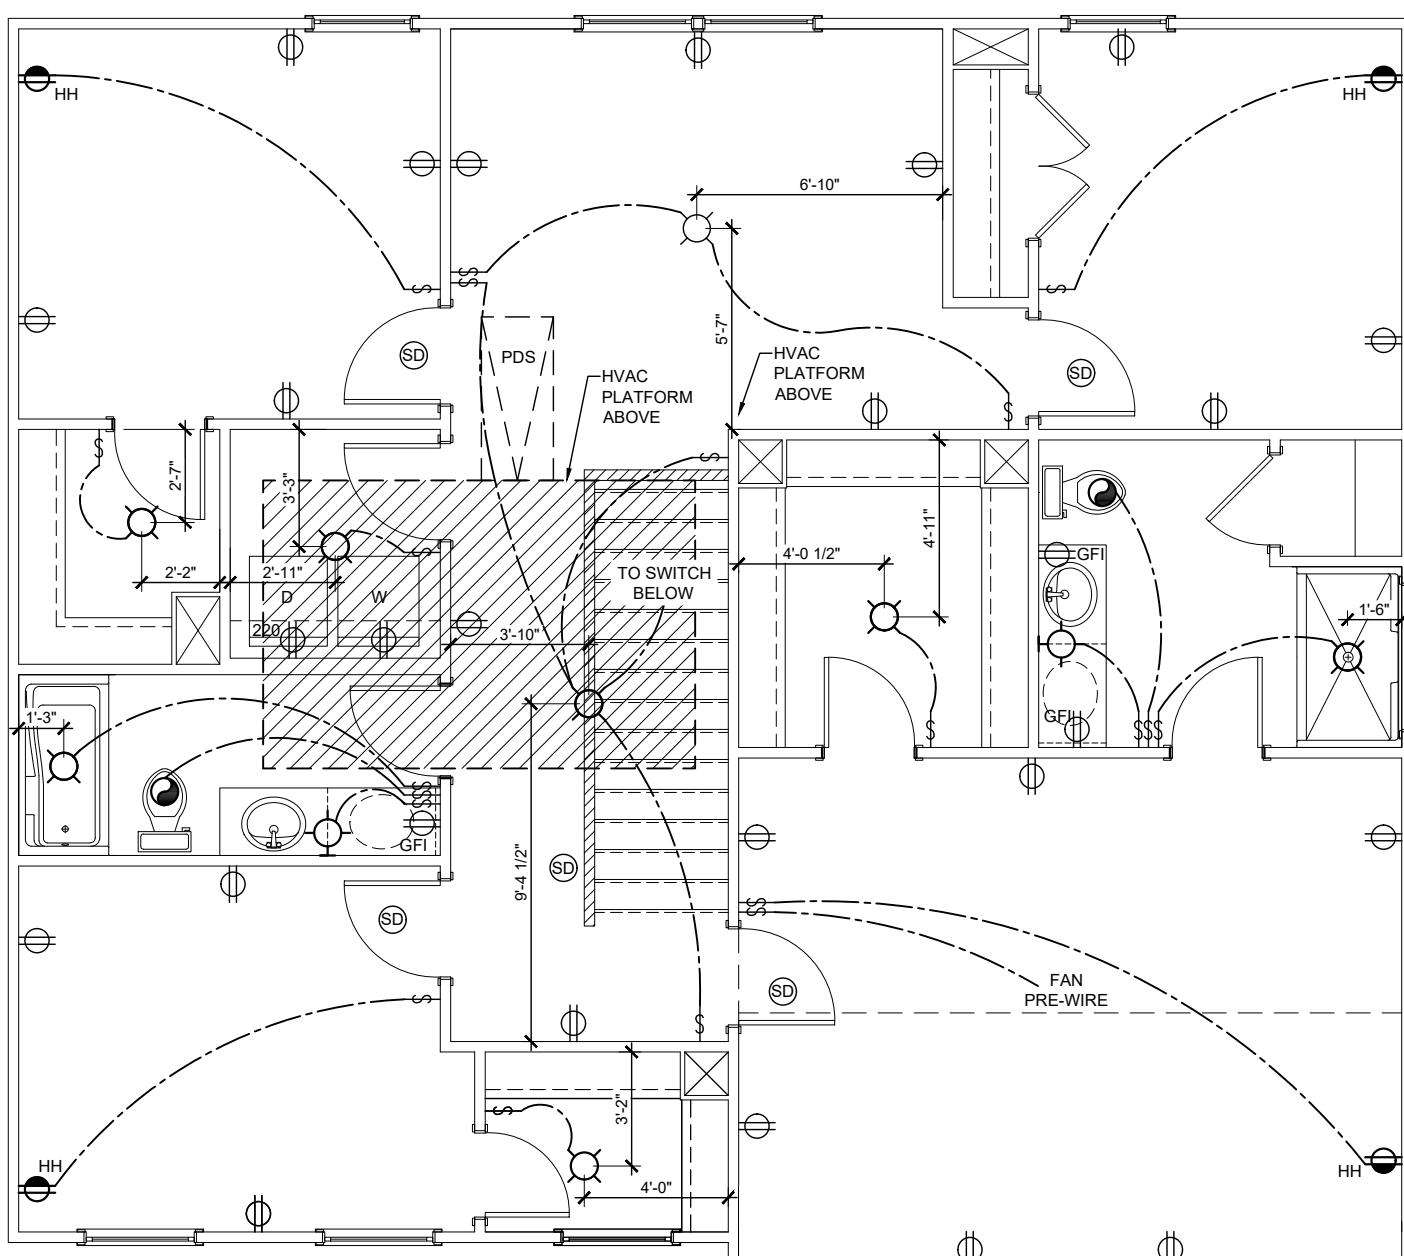

### SECOND FLOOR - ELECTRICAL

3/16" = 1'-0"

E2 Features:

Drawn By: ATW Rev By: cja  
am SH EB

Date: 12/2/2024

**McDowell B**

Genesis Series  
v.05.03.00.00

1st Floor.....935  
2nd Floor.....1301  
Garage.....410  
Front Porch.....81  
Covered Porch Option.....120  
3rd Car Garage Option.....220

B Square Footages:





M&K project number: 192-17012  
project mgr: SMK  
drawn by: MRG  
issue date: 03-24-22

REVISIONS:  
date: initial:  
date: v.02.01.00.00



GENERAL STRUCTURAL NOTES  
McDowell  
WIND SPEED < 115 MPH NORTH CAROLINA  
sheet: SO.0

## CONNECTION SPECIFICATIONS (TYP. U.N.O.)

DESCRIPTION OF BLDG. ELEMENT	3" x 0.131" NAILS	3" x 0.120" NAILS
JOIST TO SOLE PLATE	(3) TOENAILS	(3) TOENAILS*
SOLE PL. TO JOIST/RIM OR BLK's	NAILS • 6" O.C.	NAILS • 4" O.C.
STUD TO PLATE	(4) TOENAILS/ (3) END NAILS	(4) TOENAILS/ (4) END NAILS*
RIM TO TOP PLATE	TOENAILS • 6" O.C.	TOENAILS • 4" O.C.*
BLK's, BTWN. JOISTS TO TOP PL.	(3) TOENAILS EA. END	(3) TOENAILS EA. END*
DOUBLE STUD	NAILS • 16" O.C.	NAILS • 16" O.C.
DOUBLE TOP PLATE	NAILS • 12" O.C.	NAILS • 8" O.C.
DOUBLE TOP PLATE LAP SPLICE	(12) NAILS IN LAPPED AREA (24" MIN)	(15) NAILS IN LAPPED AREA (24" MIN)
TOP PLATE LAP & CORNERS & INTERSECTING WALLS	(3) NAILS	(3) NAILS
ADJACENT FULL-HEIGHT STUD TO END OF HEADER	(4) NAILS	(4) NAILS
RAFTER/TRUSS TO TOP PLATE	(4) TOENAILS + (1) SIMPSON H2.5T	(4) TOENAILS + (1) SIMPSON H2.5T
GAB. END TRUSS TO DBL. TOP PL.	TOENAILS • 8" O.C.	TOENAILS • 6" O.C.
R.T. W/ HEEL HT. 9 1/4" TO 12"	2x10 BLK EVERY 3RD BAY FASTENED TO DBL. TOP PLATE W/ TOENAILS • 6" O.C.	2x10 BLK EVERY 3RD BAY FASTENED TO DBL. TOP PLATE W/ TOENAILS • 4" O.C.
R.T. W/ HEEL HT. 12" TO 16"	2x12 BLK EVERY 3RD BAY FASTENED TO DBL. TOP PLATE W/ TOENAILS • 6" O.C.	2x12 BLK EVERY 3RD BAY FASTENED TO DBL. TOP PLATE W/ TOENAILS • 4" O.C.
R.T. W/ HEEL HT. UP TO 24"	LAP WALL SHTG. W/ DBL. TOP PL. & INSTALL ON TRUSS VERT. - FASTEN W/ NAILS • 6" O.C.*	LAP WALL SHTG. W/ DBL. TOP PL. & INSTALL ON TRUSS VERT. - FASTEN W/ NAILS • 6" O.C.*
R.T. W/ HEEL HT. 24" TO 48"	LAP WALL SHTG. W/ DBL. TOP PL. & INSTALL ON TRUSS VERT. - FASTEN W/ NAILS • 6" O.C. PROVIDE 2x BLK • EA. BAY AT TOP OF HEEL	LAP WALL SHTG. W/ DBL. TOP PL. & INSTALL ON TRUSS VERT. - FASTEN W/ NAILS • 6" O.C. PROVIDE 2x BLK • EA. BAY AT TOP OF HEEL
WALL TO FOUNDATION	WALL SHTG. LAP W/ SILL PL. & FASTENED PER SHEAR WALL FASTENING SPEC.	

\* 25" x 0.13 is an acceptable alternative to a 3" x 0.120", same spacing or number of nails. (ONLY ACCEPTABLE WHERE \* ARE SHOWN)

## VEEER LINTEL SCHEDULE

SPAN (MAX)	HEIGHT OF VENEER ABOVE LINTEL	STEEL ANGLE SIZE
3'-0"	20 FT. MAX	L3" x 3" x 1/4"
	3 FT. MAX	L3" x 3" x 1/4"
6'-0"	12 FT. MAX	L4" x 3" x 1/4"
	20 FT. MAX	L5" x 3" x 1/4"
8'-0"	3 FT. MAX	L4" x 4" x 1/4" *
	12 FT. MAX	L5" x 3" x 1/4" *
	16 FT. MAX	L6" x 3" x 1/4" *
9'-0"	12 FT. MAX	L6" x 3" x 1/4" *
	2 FT. MAX	L7" x 4" x 1/4" **
	3 FT. MAX	L8" x 4" x 1/4" **

ALL LINTELS:  
- SHALL SUPPORT 2 1/8" - 3 1/2" VENEER w/ 40 psf MAXIMUM WEIGHT.  
> 16' SHALL HAVE 4" MIN BEARING  
> 16' SHALL HAVE 8" MIN BEARING  
> 16' SHALL NOT BE FASTENED BACK TO HEADER.  
> 16' SHALL BE FASTENED BACK TO HOOD HEADER IN WALL @ 48" O.C. w/ 1/2" DIA. x 3 1/2" LONG LAG SCREWS IN 2" LONG VERTICALLY SLOTTED HOLES.  
- MAX. VENEER HT. APPLIES TO ANY PORTION OF BRICK OVER THE OPENING.  
- ALL LINTELS SHALL BE LONG LEG VERTICAL.  
- WHEN SUPPORTING VENEER < 3" NIDE THE EXTERIOR TOE OF THE HORIZONTAL LEG MAY BE CUT IN THE FIELD TO BE 3 1/4" NIDE OVER THE BEARING LENGTH ONLY. THIS IS TO ALLOW FOR MORTAR JOINT FINISHING.  
- SEE STRUCTURAL PLANS FOR ANY LINTEL CONDITION NOT ENCOMPASSED BY THE ABOVE PARAMETERS. FOR ANY LINTEL FASTENED BACK TO BEAM, FASTENERS SHALL MAINTAIN A 2 1/8" (MINIMUM) CLEAR DISTANCE FROM BOT. OF BEAM.  
\* FOR QUEEN VENEER USE L4 x 3 1/4".  
\*\* FOR 3 1/4" VENEER ONLY. SEE PLAN FOR VENEER SUPPORT IF VENEER < 3" THICK.

M&K STD. - MAY 2014

## NON-BEARING HEADER SCHEDULE

SPAN	2x4 NON-BEARING PARTITION WALL	2x6 NON-BEARING PARTITION WALL
UP TO 3'-0"	(1)2x4 FLAT	(1)2x6 FLAT
UP TO 6'-0"	(2)2x4	(3)2x4
UP TO 8'-0"	(2)2x6	(3)2x6
UP TO 12'-0"	(2)2x10	(2)2x10

## LEGEND

- INTERIOR BEARING WALL
- BEARING WALL ABOVE (B.W.A.) - AND/OR SHEAR WALL ABOVE (S.W.A.)
- BEAM / HEADER
- EXTENT OF OVERFRAMING (O.F.)
- EXTENT OF TILE OVER FLOOR
- EXTENT OF BRACING PANELS/SHEARWALL w/ ADDL CONNECTION REQUIREMENTS
- INDICATES HOLD-DOWN OR STRAP. REFER TO SCHEDULE.
- METAL HANGER
- INDICATES POST ABOVE (P.A.) PROVIDE SOLID BLOCKING UNDER POST OR JAMB ABOVE.
- INDICATES LOCATION AND EXTENT OF SHEARWALL WHICH REQUIRES SHEATHING AND/ OR FASTENING SPECIFICATIONS BEYOND THAT OF STANDARD CONSTRUCTION

## MEANS & METHODS NOTES

THE STRUCTURE IS DESIGNED TO BE SELF SUPPORTING AND STABLE AFTER THE BUILDING IS FINISHED AND ALL PLAN, DETAIL, AND NOTE SPECIFICATIONS HAVE BEEN COMPLETED. IT IS THE CONTRACTOR'S SOLE RESPONSIBILITY TO DETERMINE THE ERECTION PROCEDURES AND SEQUENCE TO INSURE THE SAFETY OF THE BUILDING AND ITS COMPONENTS DURING CONSTRUCTION. THIS INCLUDES, BUT IS NOT LIMITED TO, THE ADDITION OF NECESSARY SHORING, SHEETING, TEMPORARY BRACING, GUYS, AND TIE-DOWNS. CONTRACTOR SHALL BE RESPONSIBLE FOR ALL SHORING AND BRACING REQUIRED TO STABILIZE AND PROTECT EXISTING AND ADJACENT STRUCTURES AND SYSTEMS DURING COURSE OF DEMOLITION AND CONSTRUCTION OF THE PROJECT.

STRUCTURAL DESIGN AND SPECIFICATIONS ASSUME THAT ALL SUPPORTING AND NON-SUPPORTING ELEMENTS IN CONTACT WITH FLOOR FRAMING ARE LEVEL, INCLUDING, BUT NOT LIMITED TO, FOUNDATIONS, SLABS ON GRADE, BEAMS, WALLS, AND NON-BEARING ELEMENTS. IT IS THE CONTRACTOR'S RESPONSIBILITY TO VERIFY LEVELNESS AND MAKE ADJUSTMENTS AS NECESSARY, INCLUDING CONSIDERATION OF THOSE AREAS THAT MAY BE WITHIN CONTRACTUAL, INDUSTRY, OR WARRANTY TOLERANCES.

## GENERAL STRUCTURAL NOTES

### FOUNDATION

• DESIGN IS BASED ON 2018 NORTH CAROLINA STATE RESIDENTIAL CODE.

• FOOTING DESIGN - 2,000 PSF ALLOWABLE SOIL BEARING PRESSURE IS ASSUMED. BUILDER/CONTRACTOR MUST VERIFY.

• FASTEN 2x4/6 SILL PLATES TO CONC. FND. WITH A MINIMUM OF 2 ANCHORS PER PLATE, 12" MAX. FROM PLATE ENDS - UTILIZING:

• 1/2" DIA. ANCHOR BOLTS • 6'-0" O.C. W/ 7" MIN. EMBEDMENT OR SIMPSON MASA ANCHORS • 6"-0" O.C.

• SIMPSON STRONG-BOLT 2 WEDGE ANCHOR (STB2-50100 - 1/2" x 6" x 7") MAY BE USED IN PLACE OF ANCHOR BOLTS • INTERIOR THICKENED SLABS ONLY.

• ALL LUMBER EXPOSED TO WEATHER OR IN CONTACT W/ PERIMETER FOUNDATION SHALL BE PRESERVATIVE TREATED SOUTHERN PINE #2.

• FOUNDATION WALLS & FOOTINGS SHALL BE PLAIN CONCRETE, U.N.O.

• CONCRETE DESIGN BASED ON ACI 318. CONCRETE SHALL ATTAIN THE FOLLOWING MIN. COMPRESSIVE STRENGTHS IN 28 DAYS, U.N.O.: F'c = FOUNDATION WALLS (SEE FOUNDATION DETAILS)

2500 psi. FOOTINGS & INTERIOR SLABS ON GRADE

3000 psi. GARAGE & EXTERIOR SLABS ON GRADE

60,000 psi

• TYPICAL REINFORCEMENT DETAILS: PROVIDE 3" MIN. CLEAR COVER WHERE CAST AGAINST EARTH, 1 1/2" MIN. CLEAR COVER AGAINST FORMS. LAP ALL REBAR 48 BAR DIAMETERS MIN. (24" FOR #4 BARS) & BEND BARS AND LAP AT CORNERS. PROVIDE 6" HOOK INTO SUPPORTING FOOTINGS WHEN FOOTINGS INTERSECT.

• ALL CONCRETE EXPOSED TO THE WEATHER SHALL NOT HAVE LESS THAN 5% OR MORE THAN 1% AIR ENTRAINMENT.

• ALL FOOTINGS SHALL BEAR BELOW FROST LINE (TYP.) OR 12" MIN IN REGIONS WHERE CODE FROST DEPTH IS NOT APPLICABLE. CONSULT SOILS REPORT OR BUILDING DEPT. FOR MINIMUM DEPTH BELOW GRADE.

• FOOTINGS AND SLABS ON GRADE SHALL BEAR ON VIRGIN SOIL OR 45% COMPAKTED FILL. (U.N.O.)

• PROVIDE CONTROL JOINTS AT ALL INSIDE CORNERS OF SLAB EDGES, AND OTHER LOCATIONS WHERE SLAB CRACKS ARE LIKELY TO DEVELOP.

• JOINTS SHALL BE LOCATED • 10'-0" O.C. (RECOMMENDED) OR 15'-0" O.C. (MAXIMUM)

• JOINT GRID PATTERN SHALL BE AS CLOSE TO SQUARES AS POSSIBLE (1:1 RATIO), WITH A MAXIMUM OF 1:1.5 RATIO

• CONTROL JOINTS SHALL NOT BE INSTALLED IN STRUCTURAL SLABS

• DIMENSIONS BY OTHERS, BUILDER TO VERIFY.

• BUILDER TO PROVIDE SUBTERRANEAN TERMITE PROTECTION MEETING THE REQUIREMENTS OF R318 OR LOCAL CODE REQUIREMENTS

• CRAWLSPACE/BASEMENT WALLS SHALL BE BRACED, PRIOR TO BACKFILLING, BY EITHER ADEQUATE TEMPORARY BRACING OR INSTALLATION OF FIRST FLOOR DECK.

• CRAWLSPACE/BASEMENT WALL DESIGN IS BASED ON BACKFILL SOIL CLASSIFICATIONS OF GW, GP, SM, SP (30 psf) OR GM, GC, SM, SG, ML (45 psf). IF SC, ML-CL, OR CL (60 psf) SOIL IS ENCOUNTERED ON SITE, CONTACT MULHERN & KULP FOR FURTHER EVALUATION OF FOUNDATION DESIGN.

• CONCRETE MASONRY UNITS (CMU) SHALL BE ASTM C90 WITH A MIN. COMPRESSIVE STRENGTH OF 1900 psi (F'm=1500 psi). MORTAR SHALL BE ASTM C270, TYPE S. CMU DESIGN PER TMS 402/602.

• CMU FOUNDATION WALLS SHALL HAVE 'DUR-O-WALL' HORIZONTAL JOINT REINFORCEMENT (OR EQUAL) - 9 GA. MINIMUM • 16" O.C.

• PROVIDE 2x8 x 16" LONG P.T. PLATE ON TOP OF ALL CRAWL SPACE PIERS. TOP COURSE OF PIERS SHALL BE SOLID MASONRY OR FILLED SOLID.

• PROVIDE 2x6 P.T. PLATE ON INTERIOR CRAWL SPACE WALLS, FASTENED PER ANCHORAGE SPECIFICATION NOTED ABOVE.

• BASEMENT FOUNDATION WALL DESIGN BASED ON:

• 9' OR 10' HEIGHT (SEE PLAN)

• ACTUAL WALL WIDTHS ASSUMED FOR DESIGN, NOMINAL WIDTHS SHALL NOT BE USED.

• PROVIDE (2) #5 BARS AROUND ALL SIDES OF OPENINGS IN CONCRETE BSMT. FND. WALL WITH 2" CLEAR. REINFORCEMENT SHALL EXTEND 12" PAST CORNER OF OPENING IN ALL DIRECTIONS.

• FOR OPENINGS UP TO 36", PROVIDE MINIMUM 10" CONCRETE DEPTH OVER OPENING OR (3)2x10 w/ (2)2x6 JACK STUDS, 16" O.C.

• LARGER OPENINGS SHALL BE PER PLAN.

M&K - MAY 2017

## EXTERIOR & SHEAR WALL SHEATHING SPECIFICATIONS

### GENERAL

THIS MODEL HAS BEEN DESIGNED TO RESIST LATERAL FORCES RESULTING FROM:

115 MPH WIND IN 2018 NCSBC:RC

(115 MPH WIND SPEED IN ASCE 7-10 WIND MAP, PER NCSBC R301.2.1.1)

EXP. B & SEISMIC CAT. A/B.

THE ENGINEERED DESIGN WAS COMPLETED PER 2015 IBC (SECTION 1604) & ASCE 7-10, AS PERMITTED BY R301.3 OF THE 2018 NCSBC.

DESIGN WIND UPLIFT LOADS HAVE BEEN

CALCULATED UTILIZING ASCE 7-10 (ACCEPTED ENGINEERING PRACTICE) AS ALLOWED PER 2018 NCSBC, RC SECTION R302.1.1.1. THIS MODEL HAS BEEN DETAILED WHERE REQUIRED & ENGINEERED TO RESIST THE WIND UPLIFT LOAD PATH PER

SECTIONS R602.3.5 & R802.11.

### EXT. WALL SHEATHING SPECIFICATION

1/16" OSB OR 15/32" PLYWOOD:

FASTEN SHEATHING W/ 2 1/2" x 0.131" NAILS • 6" O.C. AT EDGES & • 12" O.C. IN THE PANEL FIELD. (TYP. U.N.O.)

• ALL SHEATHING PANELS SHALL BE ORIENTED VERTICALLY (LONG DIRECTION PARALLEL TO STUDS) AND INSTALLED FULL HEIGHT OF SHEAR WALL - OR-2X HORIZONTAL BLOCKING SHALL BE PROVIDED TO SUPPORT ALL UNSUPPORTED PANEL EDGES & EDGE FASTENING.


• WITHIN 48" OF ALL ROOF EDGES, RIDGES, & HIPS FASTEN ROOF SHEATHING FIELDS PER EDGE NAILING SPEC.

• FASTEN

DIMENSIONS REFLECT FACE OF WALL STUDS ABOVE OR CENTERLINES OF CRAWLSPACE PIERS (REFER TO DETAILS FOR FOUNDATION WALL PLACEMENT RELATIVE TO WALL FRAMING ABOVE)

FOUNDATION HARDWARE SCHEDULE ELEVATION B

QTY	PRODUCT
15	SIMPSON STRONG-BOLT 2
HARDWARE NOTES:	
<ul style="list-style-type: none"> <li>- ALL NAIL HOLES FILLED</li> <li>- ALL COUNTS ESTIMATED</li> <li>- 15 ADDITIONAL STRONG-BOLT 2 ANCHORS INCLUDED FOR MISSED ANCHOR BOLTS</li> </ul>	

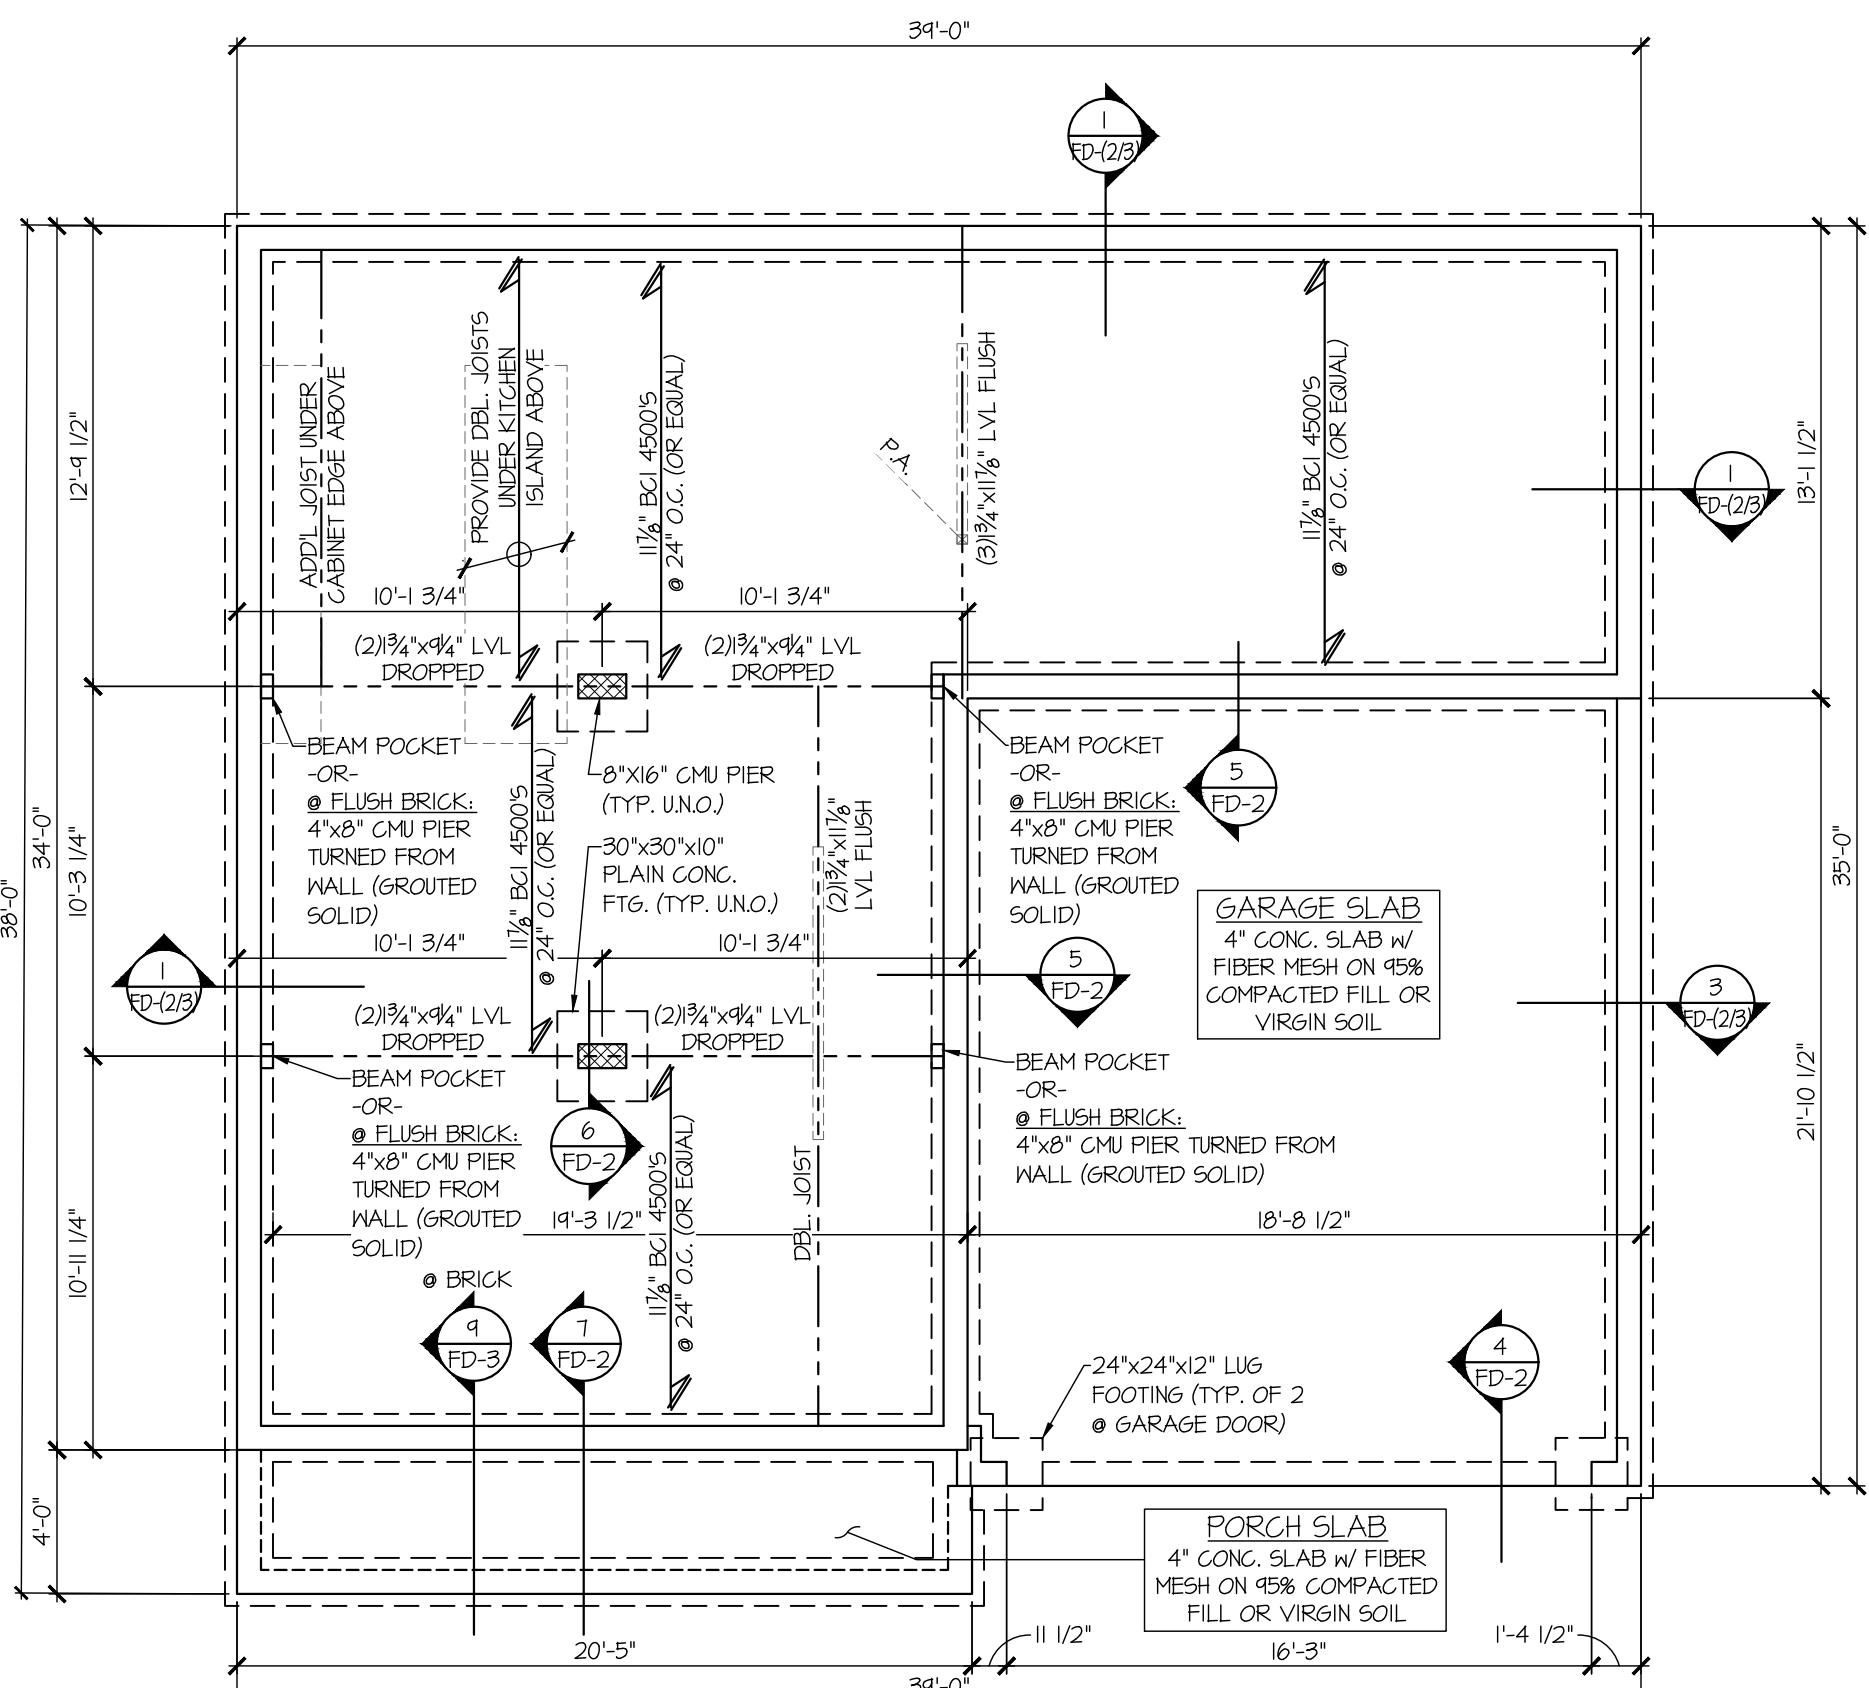

CRAWLSPACE SLAB FOUNDATION PLAN

SCALE: 3/16"=1'-0"

ELEV. B

REFER TO S-0.0 FOR  
TYPICAL STRUCTURAL NOTES  
& SCHEDULES

SC1.1

CRAWLSPACE FOUNDATION PLAN  
McDOWELL  
ELEVATION B  
WIND SPEED < 115 MPH NORTH CAROLINA




ARCH-NW-02.01.0000

project mgr:  
drawn by:  
issue date:  
REVISIONS:  
date:  
initial:

192-17012  
SMK  
MRG  
03-24-22




MULHERN + KULP  
RESIDENTIAL STRUCTURAL ENGINEERING  
300 Brookside Ave, Building 4 • Amherst, PA 14222  
p 218-645-8007 • [mulhernkulp.com](http://mulhernkulp.com)  
NC License # C-3825

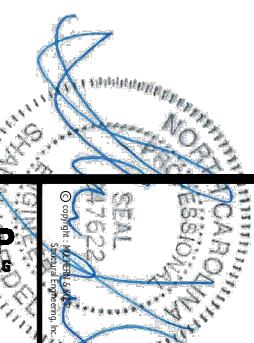

2/19/24


2ND FLOOR HARDWARE SCHEDULE ELEVATION B	
QTY	PRODUCT
13	SIMPSON H2.5A CLIP
3	SIMPSON HD3B HOLDOWN
3	SIMPSON CMST14 STRAP
HARDWARE NOTES:	
- ALL NAIL HOLES FILLED	
- ALL COUNTS ESTIMATED	
- HARDWARE COUNT DOES NOT INCLUDE	
TRUSS TO TRUSS CONNECTIONS	

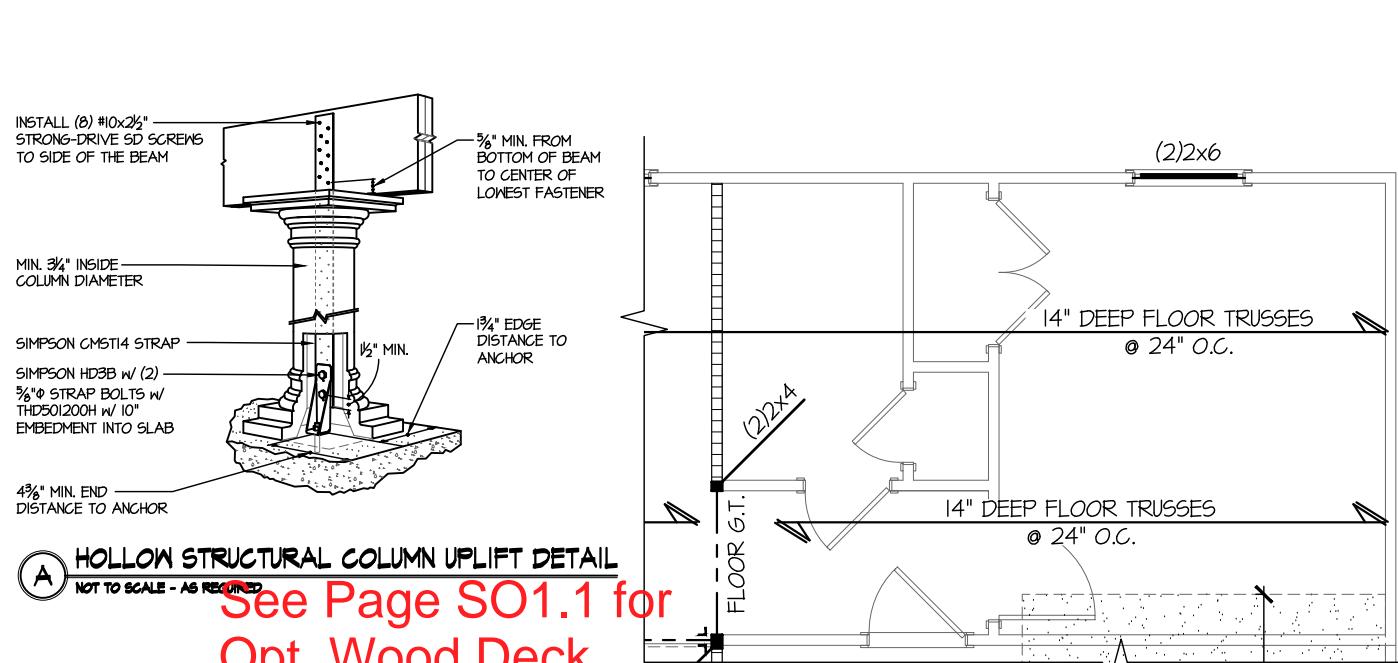

**See Page SO1.1 for  
Opt. Wood Deck**

**PARTIAL 2ND FLR PLAN  
OPT. GUEST SUITE**

**2** SCALE: 3/16"=1'-0"  
(1ST FLOOR WALLS SHOWN)

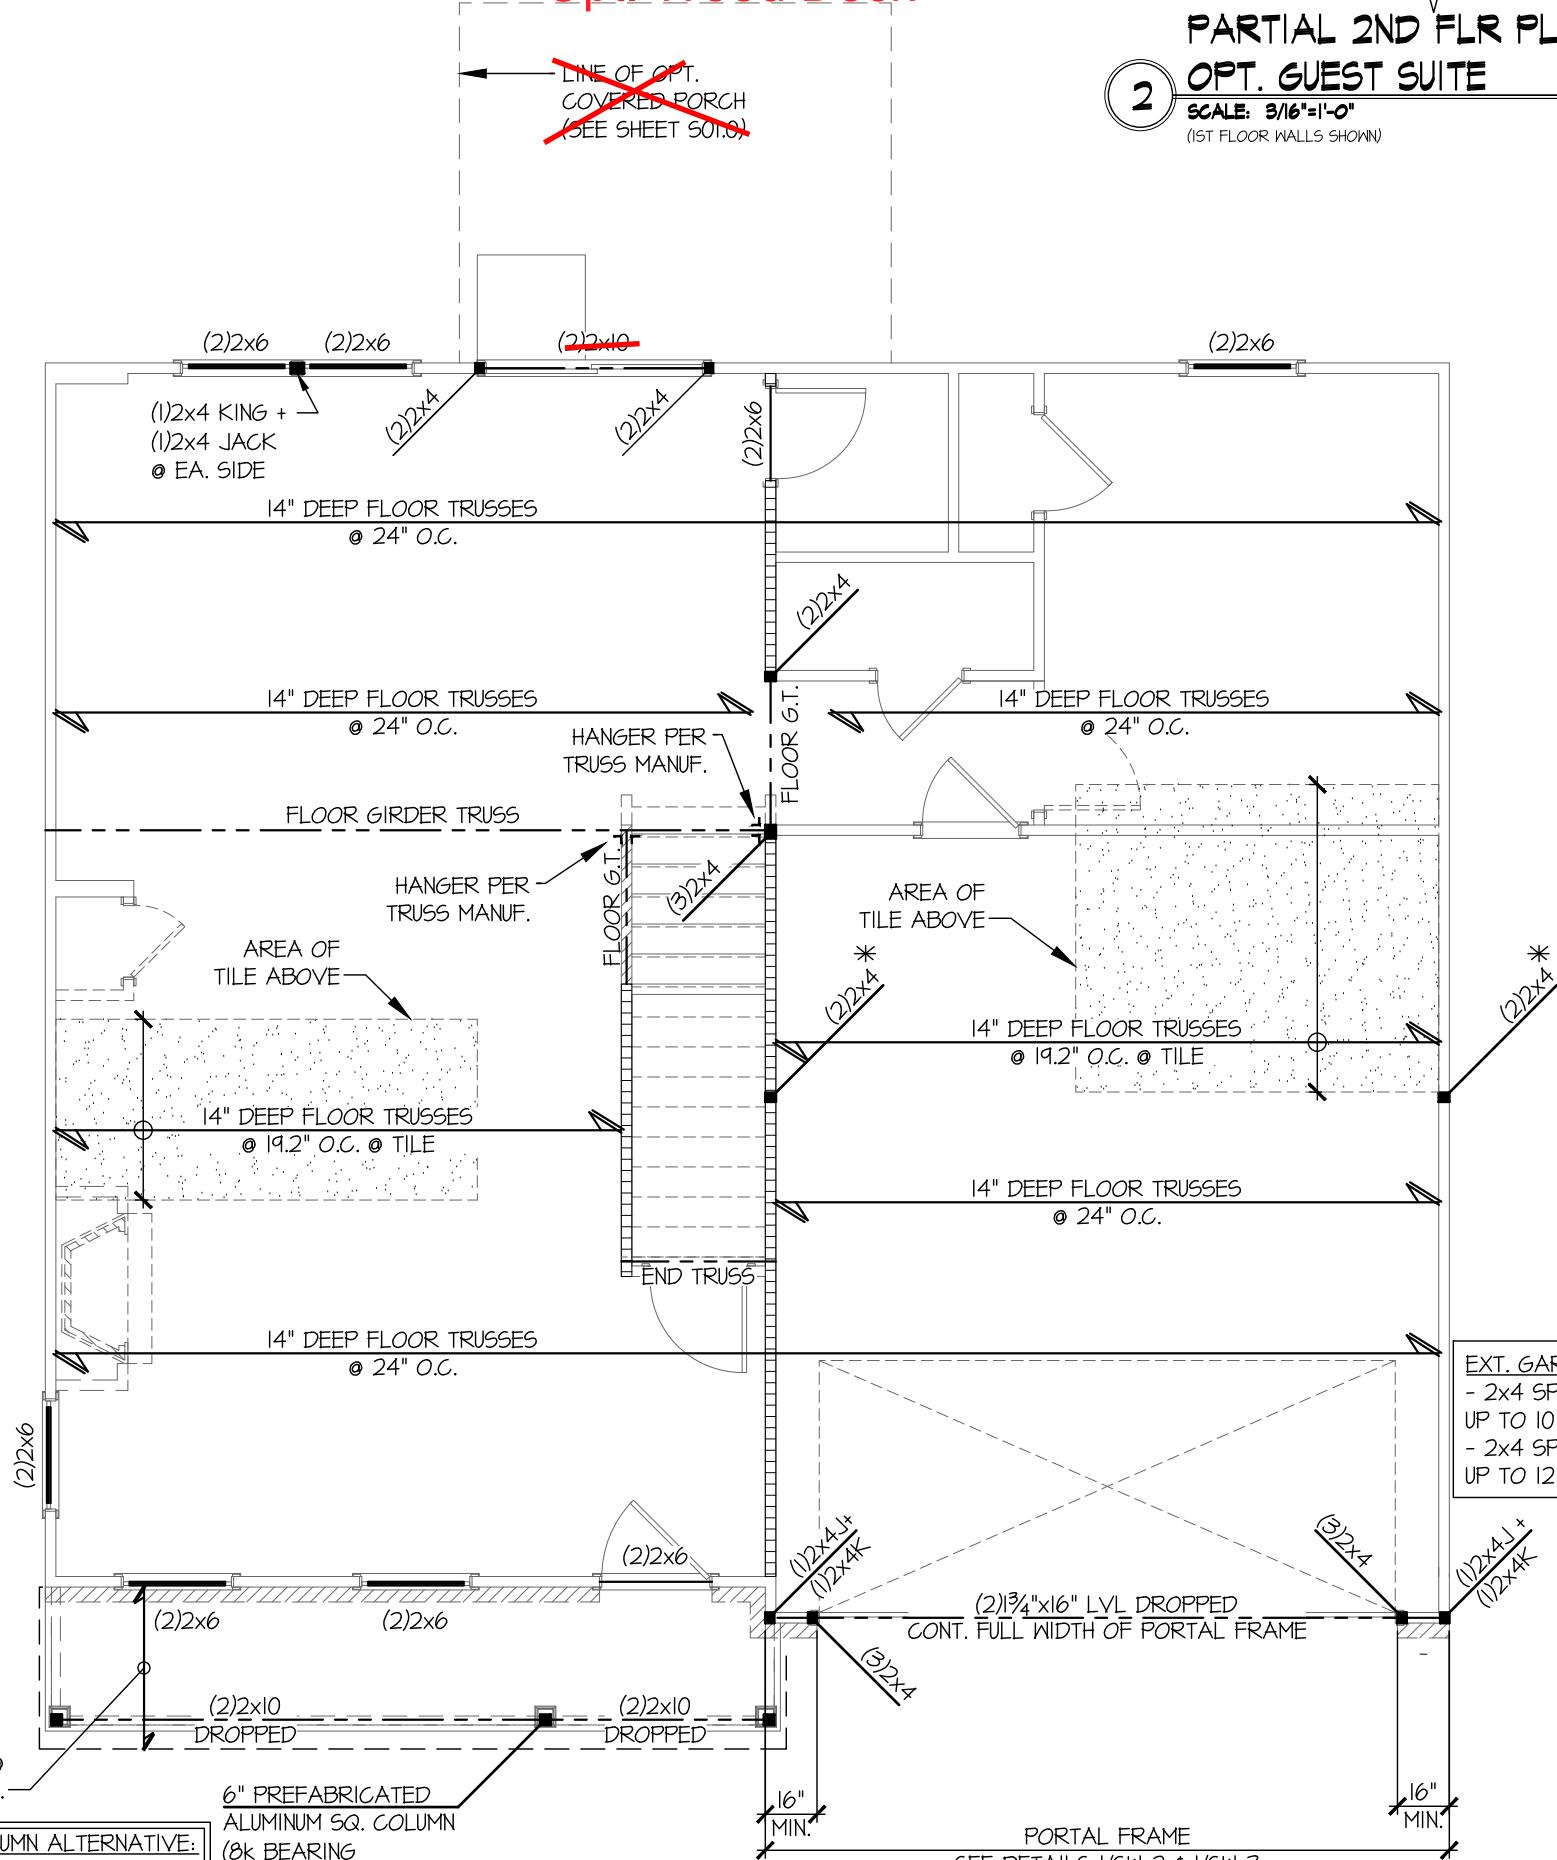

**PLAN DESIGNED FOR  
8' -OR- 9' PLATE HEIGHT**

**REFER TO S-0.0 FOR  
TYPICAL STRUCTURAL NOTES  
& SCHEDULES**

**2ND FLOOR FRAMING PLAN  
ELEV. B**

**SCALE: 3/16"=1'-0"**

**(1ST FLOOR WALLS SHOWN)**



ARCH-NW-02.01.0000

REVISIONS:

date: initial:


project mgr: SMK

drawn by: MRG

issue date: 03-24-22




**MULHERN+KULP**  
RESIDENTIAL STRUCTURAL ENGINEERING  
300 Brookside Ave, Building 4 • Ambler, PA 19002  
p 215-645-8007 • [mulhernkulp.com](http://mulhernkulp.com)  
NC License # C-3825

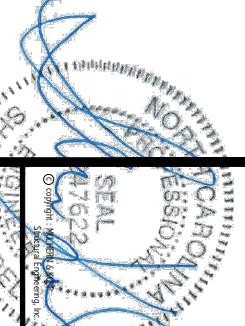

**S2.1**


**2ND FLOOR FRAMING PLAN  
McDOWELL  
ELEVATION B  
WIND SPEED < 115 MPH NORTH CAROLINA**

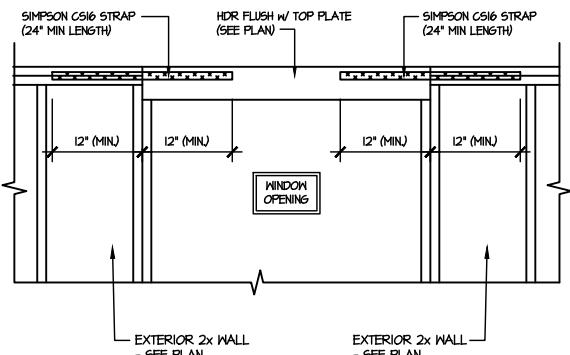

**SHEAR TRANSFER DETAIL  
AT UPSET WINDOW**

SCALE 9/16"=1'-0"

ROOF HARDWARE SCHEDULE ELEVATION B	
QTY	PRODUCT
52	SIMPSON H2.5A CLIP
2	SIMPSON MTS16 STRAP
HARDWARE NOTES:	
- ALL NAIL HOLES FILLED	
- ALL COUNTS ESTIMATED	
- HARDWARE COUNT DOES NOT INCLUDE TRUSS TO TRUSS CONNECTIONS	

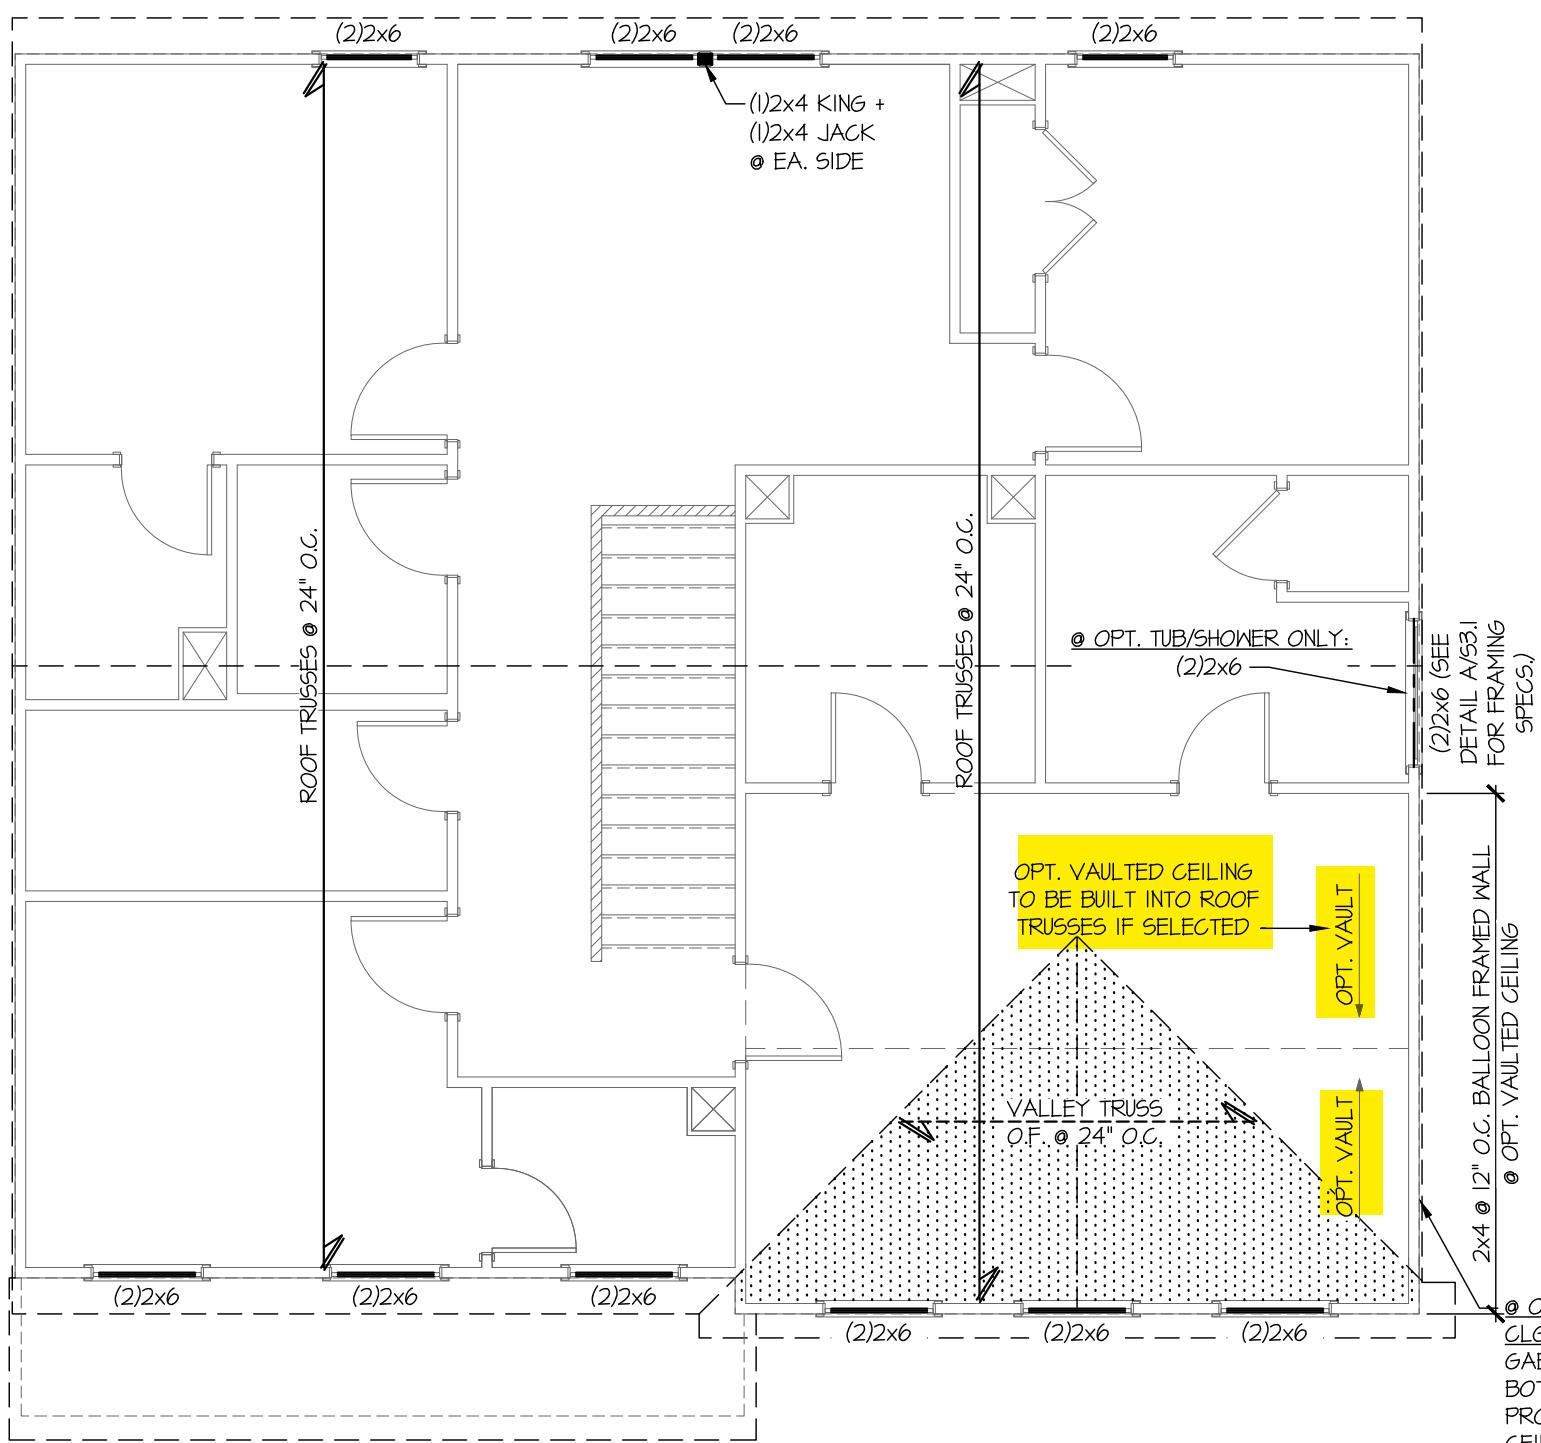

PLAN DESIGNED FOR  
8' PLATE HEIGHT

REFER TO S-0.0 FOR  
TYPICAL STRUCTURAL NOTES  
& SCHEDULES

**ROOF FRAMING PLAN**  
SCALE: 9/16"=1'-0"  
(2ND FLOOR WALLS SHOWN) ELEV. B

**S3.1**

ROOF FRAMING PLAN  
McDOWELL  
ELEVATION B  
WIND SPEED < 115 MPH NORTH CAROLINA




Arch't: 02/01/0000


Proj. #/Arch't: 192-17012  
Drawn by: SMK  
Issue date: 03-24-22  
Revisions: date: init. by:



**MULHERN + KULP**  
RESIDENTIAL STRUCTURAL ENGINEERING  
300 Shadyside Ave, Building 4 • Ambler, PA 19002  
p. 215.646.8000 • [mulk.com](http://mulk.com)  
NC License # C-3825

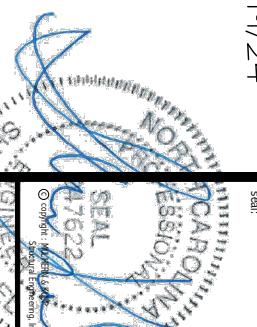

2/19/24

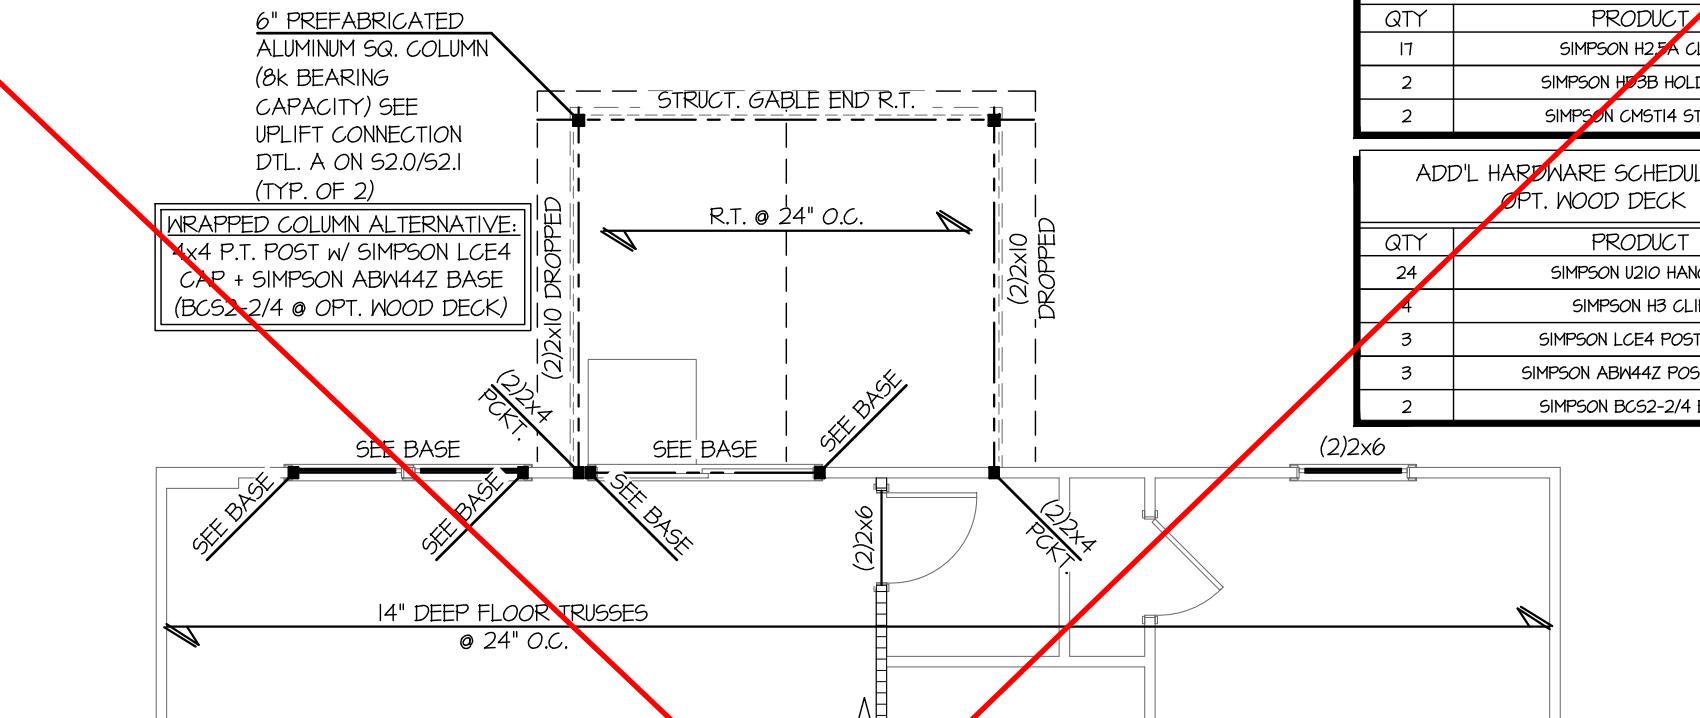


### PARTIAL ROOF FRAMING PLAN

#### OPT. COVERED PORCH

SCALE: 3/16"=1'-0"  
(1ST FLOOR WALLS SHOWN)

ALL ELEVS. SIM.

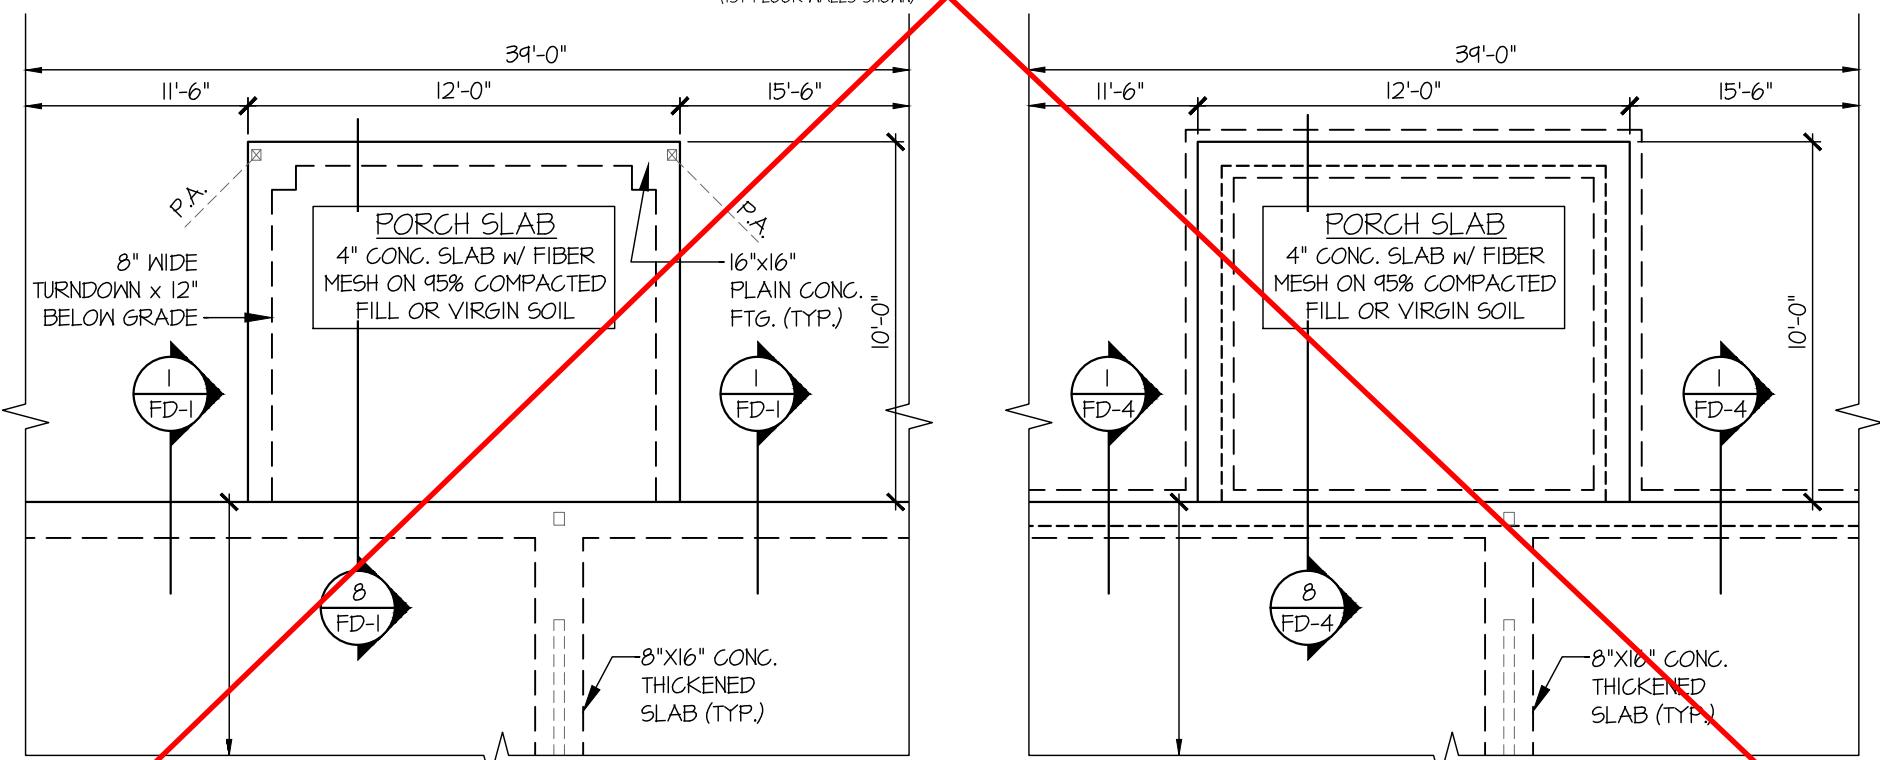

### PARTIAL MONOSLAB FOUNDATION PLAN

#### OPT. COVERED PORCH

SCALE: 3/16"=1'-0"


ALL ELEVS. SIM.

### PARTIAL RAISED SLAB FOUNDATION PLAN

#### OPT. COVERED PORCH

SCALE: 3/16"=1'-0"

ALL ELEVS. SIM.

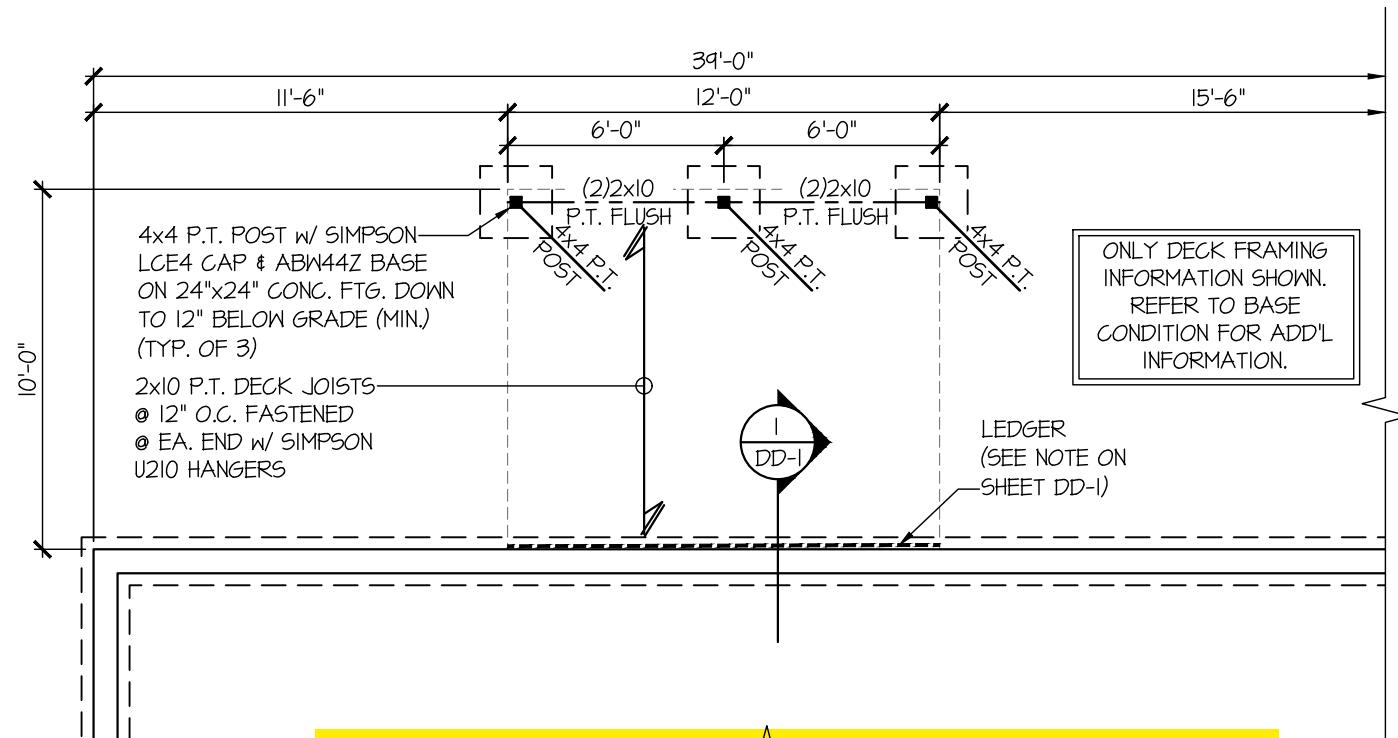

### PARTIAL CRAWLSPACE FOUNDATION PLAN

#### OPT. WOOD DECK

SCALE: 3/16"=1'-0"

ALL ELEVS. SIM.

REFER TO S-0.0 FOR  
TYPICAL STRUCTURAL NOTES  
& SCHEDULES

Spec:  
SO1.0

OPTION FRAMING PLANS  
McDOWELL  
COVERED PORCH / WOOD DECK  
WIND SPEED < 115 MPH NORTH CAROLINA



Arch't: 02/01/0000

Arch't:

date:

initial:

M&K project number:  
192-17012





MULHERN + KULP  
RESIDENTIAL STRUCTURAL ENGINEERING  
300 Biscayne Ave, Building 4 • Aventura, FL 33180  
p: 305.936.8000 • mulhernkulp.com  
NC License # C-3825




2/19/24




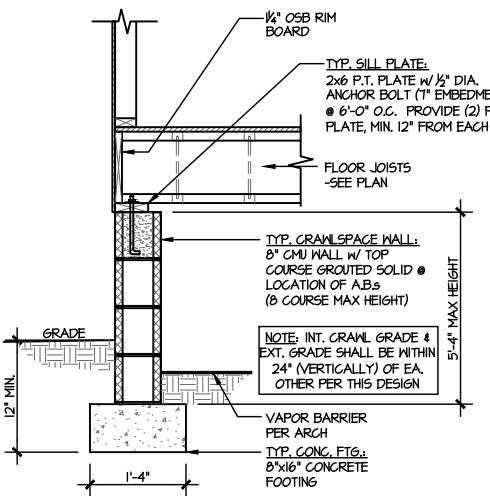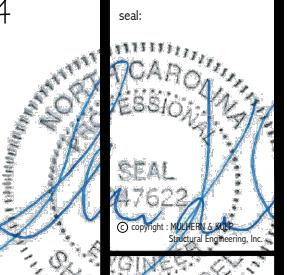


1 TYPICAL CRAWLSPACE FOUNDATION  
SCALE 9/8=1'-0"

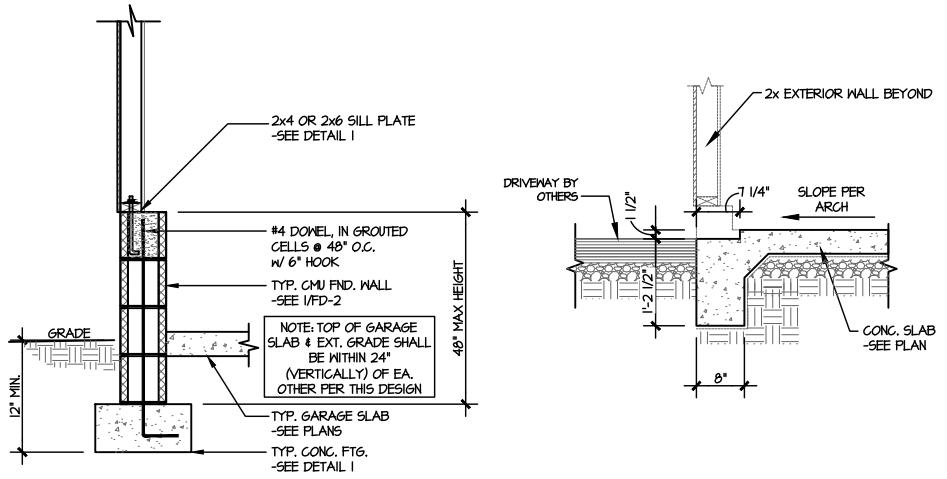


3 TYPICAL PERIMETER FOOTING @ EXTERIOR GARAGE WALL  
SCALE 9/8=1'-0"

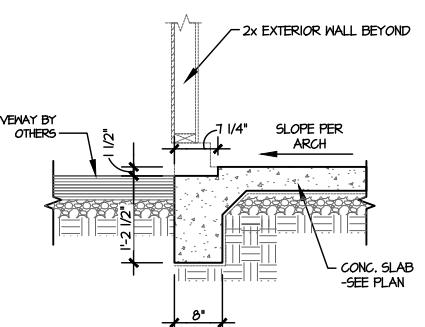


4 TYPICAL TURNDOWN FOOTING AT EXTERIOR GARAGE APRON  
SCALE 9/8=1'-0"

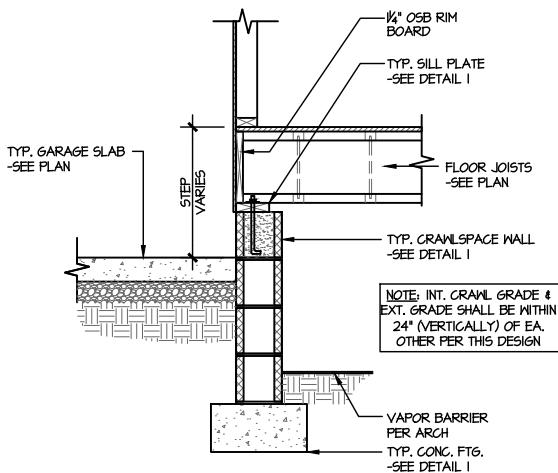


5 TYPICAL CRAWLSPACE FOUNDATION @ INTERIOR GARAGE WALL  
SCALE 9/8=1'-0"

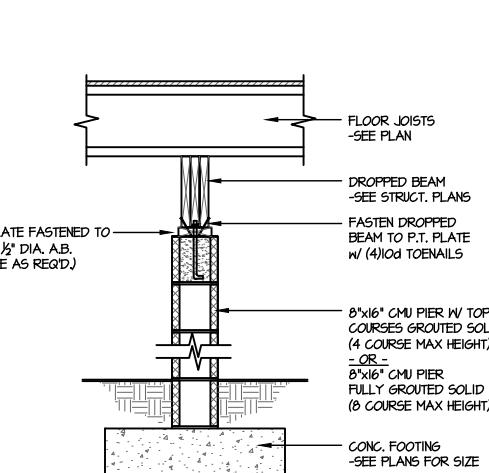


6 TYPICAL CRAWLSPACE FOUNDATION @ INTERIOR PIER  
SCALE 9/8=1'-0"

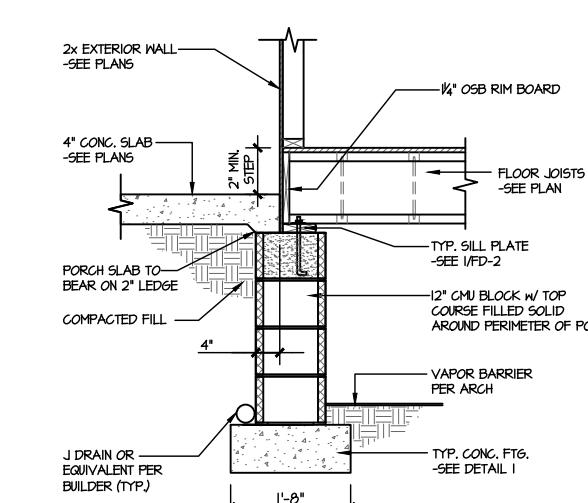


7 TYPICAL CRAWLSPACE FOUNDATION @ PORCH SLAB  
SCALE 9/8=1'-0"

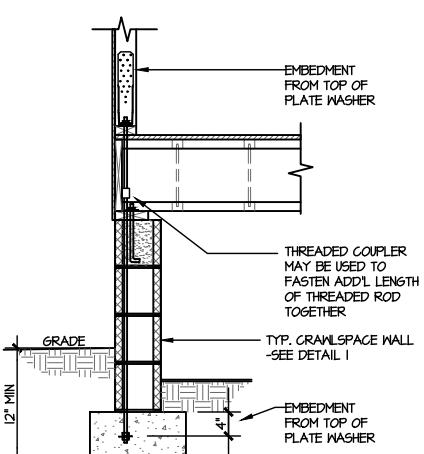



A TYPICAL CRAWLSPACE FOUNDATION HOLD-DOWN INSTALLATION  
SCALE 9/8=1'-0"  
w/ STONE VENEER OR SIDING

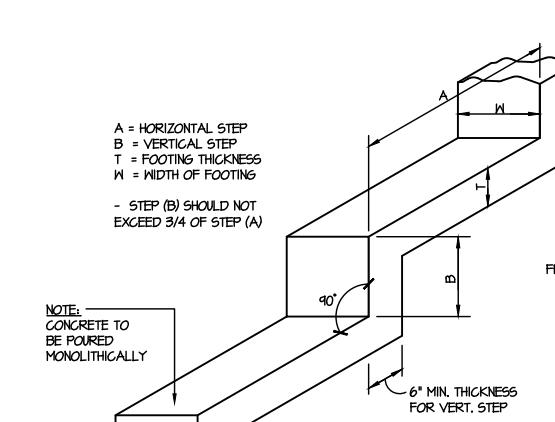

B TYPICAL STEPPED FOOTING DETAIL  
SCALE 9/8=1'-0"


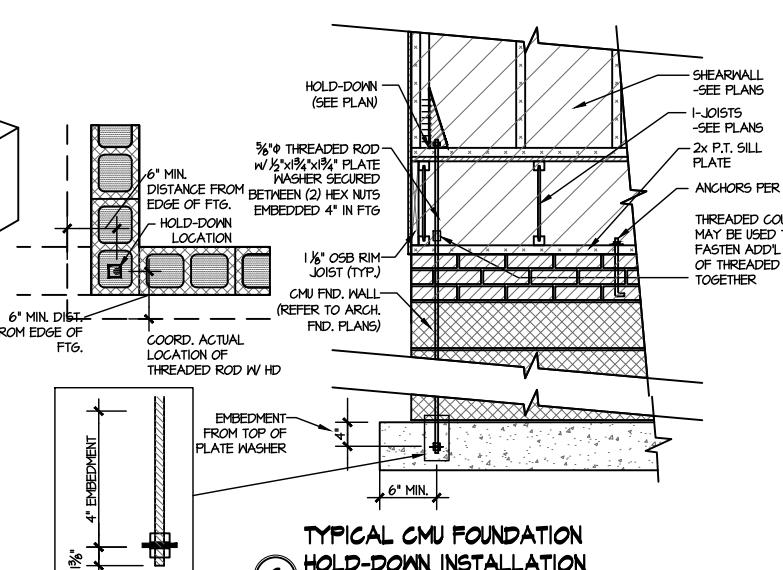


C TYPICAL CMU FOUNDATION HOLD-DOWN INSTALLATION  
SCALE 9/8=1'-0"  
(CORNER SHOWN - APPLICABLE TO ALL CONDITIONS)

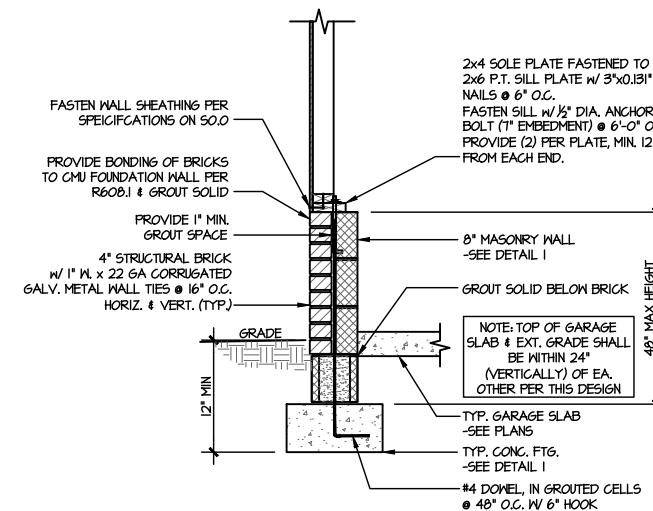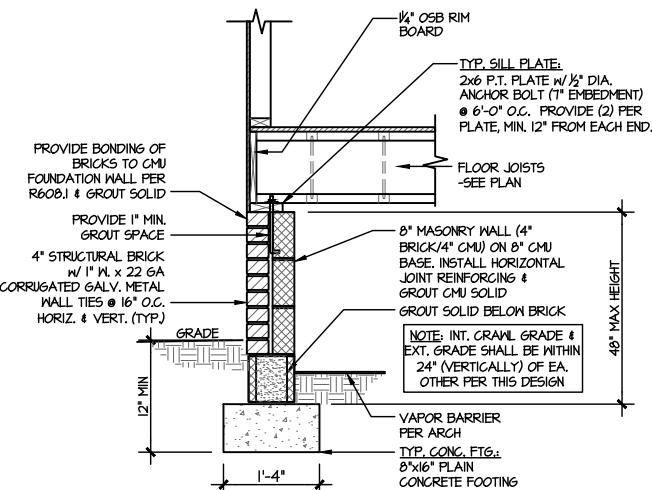




3 TYPICAL CRAWLSPACE FOUNDATION  
@ EXTERIOR GARAGE WALL  
w/ BRICK VENEER  
SCALE: 3/8"=1'-0"

4 NOT USED  
SCALE: 3/8"=1'-0"

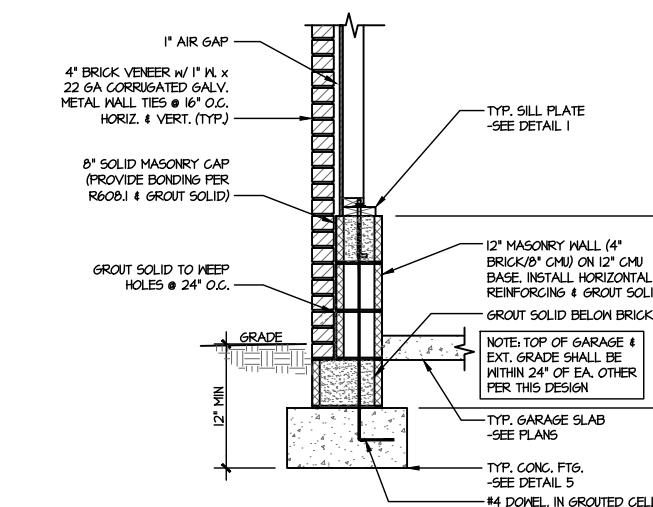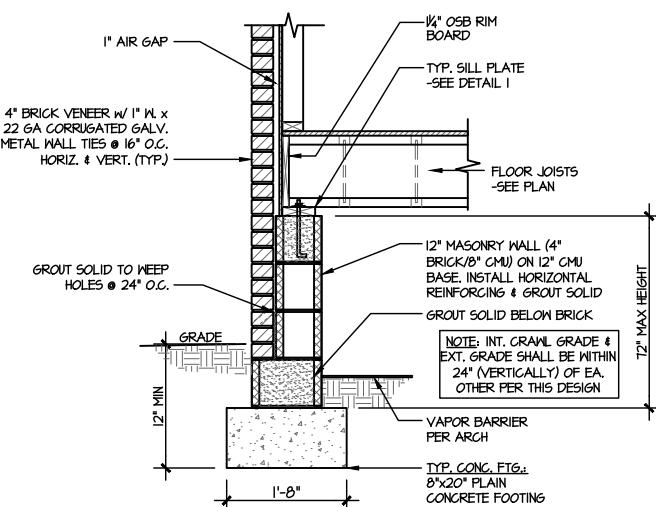


7 TYPICAL CRAWLSPACE FOUNDATION  
@ EXTERIOR GARAGE WALL  
w/ FULL BRICK VENEER  
SCALE: 3/8"=1'-0"

8 NOT USED  
SCALE: 3/8"=1'-0"

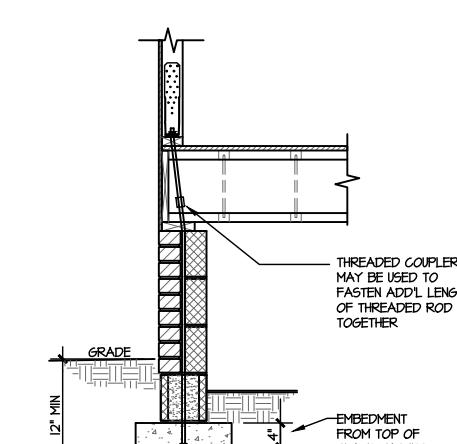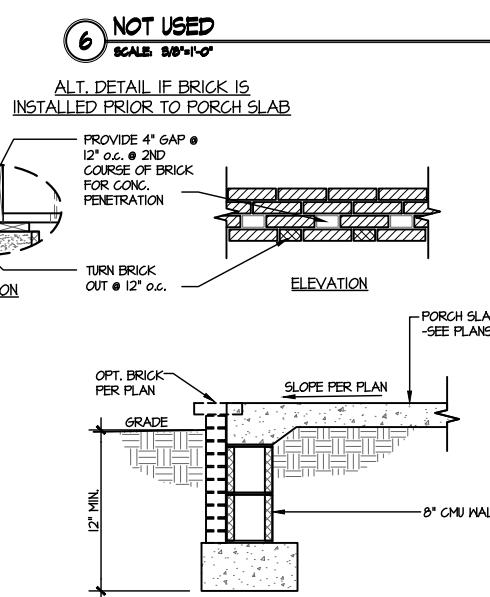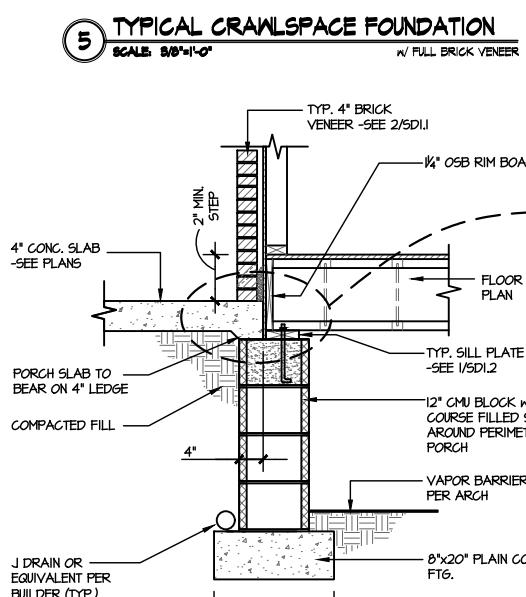

TYPICAL CRAWLSPACE FOUNDATION  
HOLD-DOWN INSTALLATION  
w/ BRICK VENEER  
SCALE: 3/8"=1'-0"

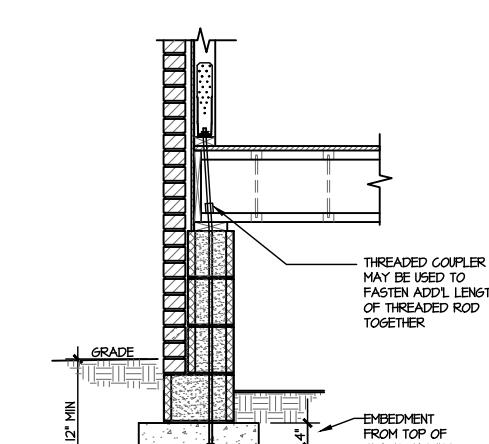

FOUNDATION DETAILS  
McDOWELL

WIND SPEED < 115 MPH NORTH CAROLINA

M&K project number: 192-17012  
project mgr: SMK  
drawn by: MRG  
issue date: 03-24-22  
REVISIONS:  
date: initial:  
ARCH: v.02.01.00.00








M&K project number: 192-17012  
 project mgr: SMK  
 drawn by: MRG  
 issue date: 03-24-22  
 REVISIONS:  
 date: initial:



STRUCTURAL DETAILS  
 McDowell  
 WIND SPEED < 115 MPH NORTH CAROLINA  
 sheet: SW-2


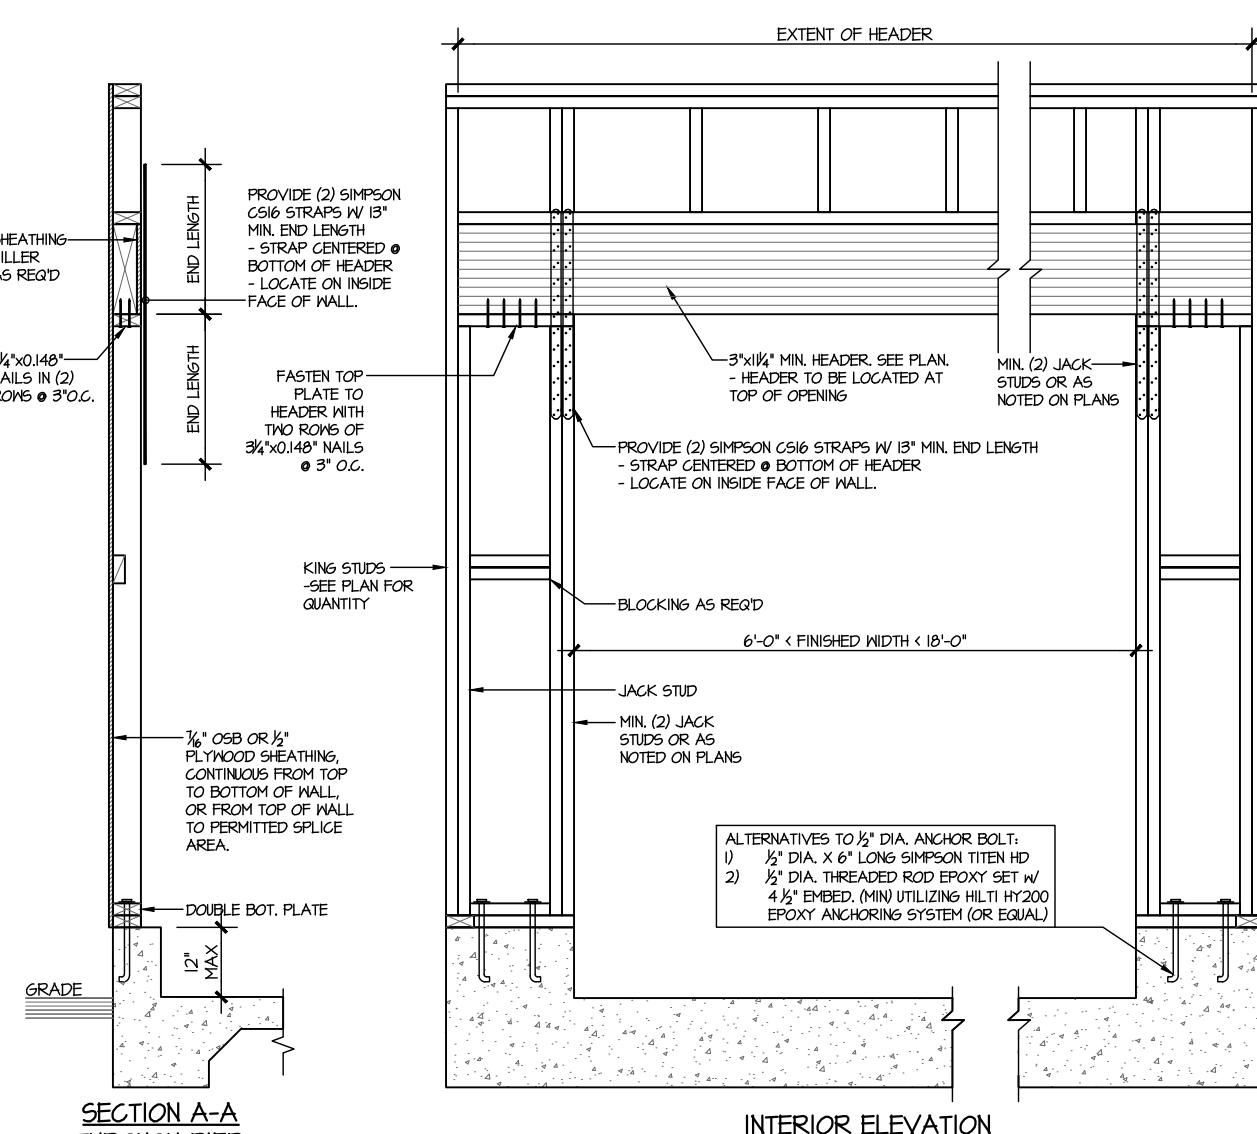
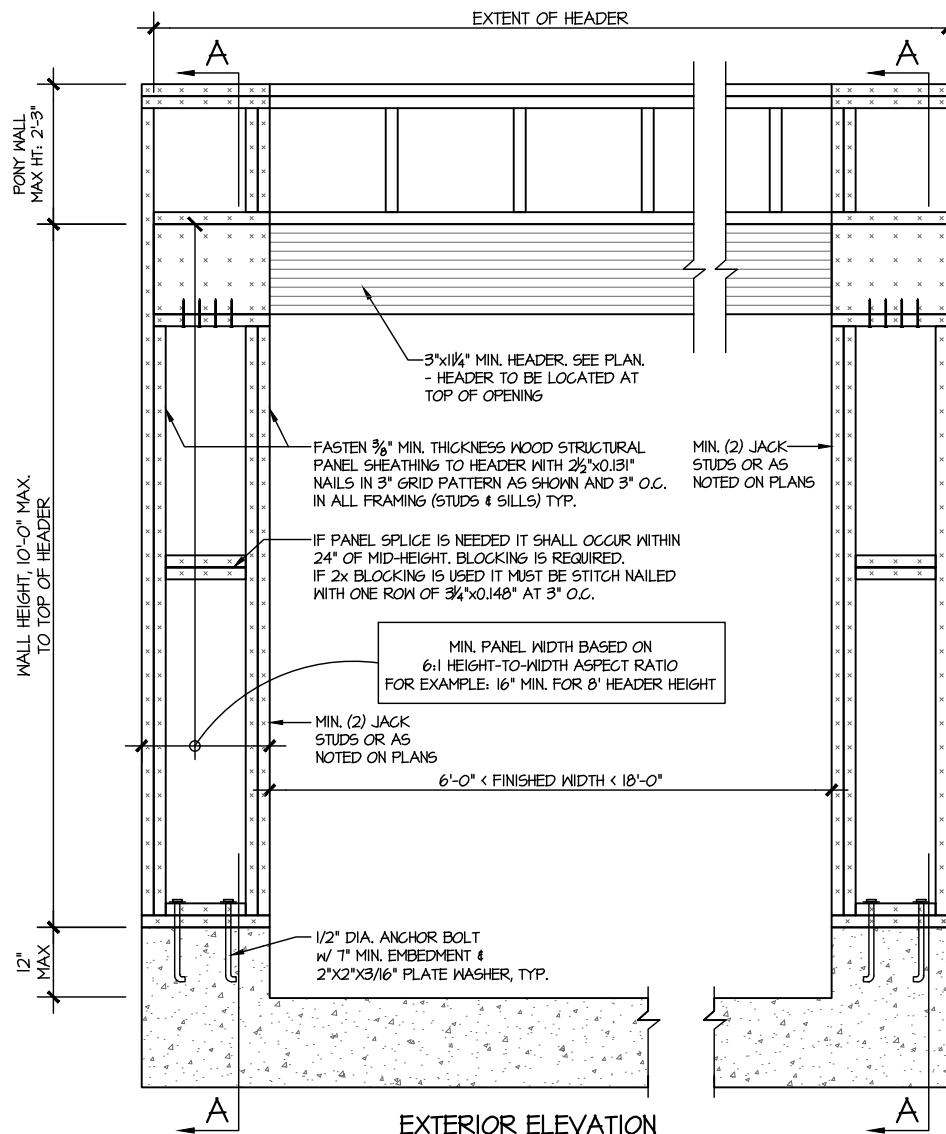


WALL FRAMING SPECIFICATION:  
 • 2x4 WALL: USE SP/SPF #2 GRADE STUDS (OR BETTER)  
 • 2x6 WALL: USE SP/SPF #2 GRADE STUDS (OR BETTER)

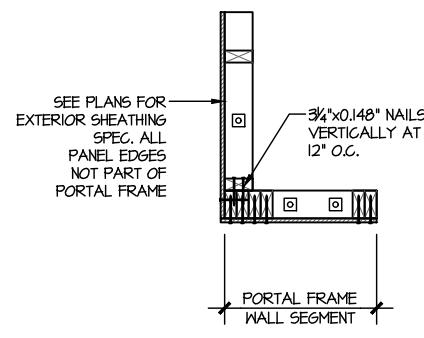

PLAN VIEW OF CORNER DETAIL

MONOSLAB FOUNDATION

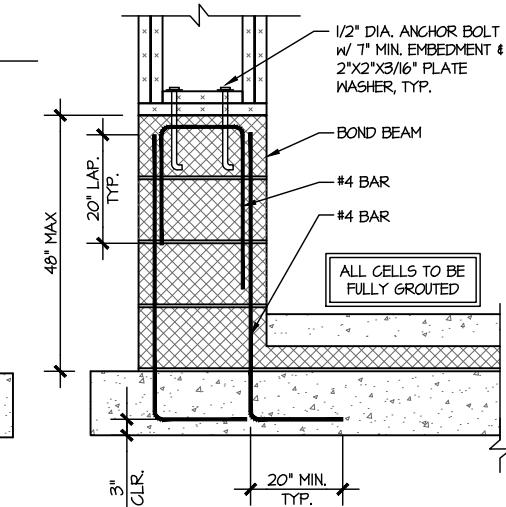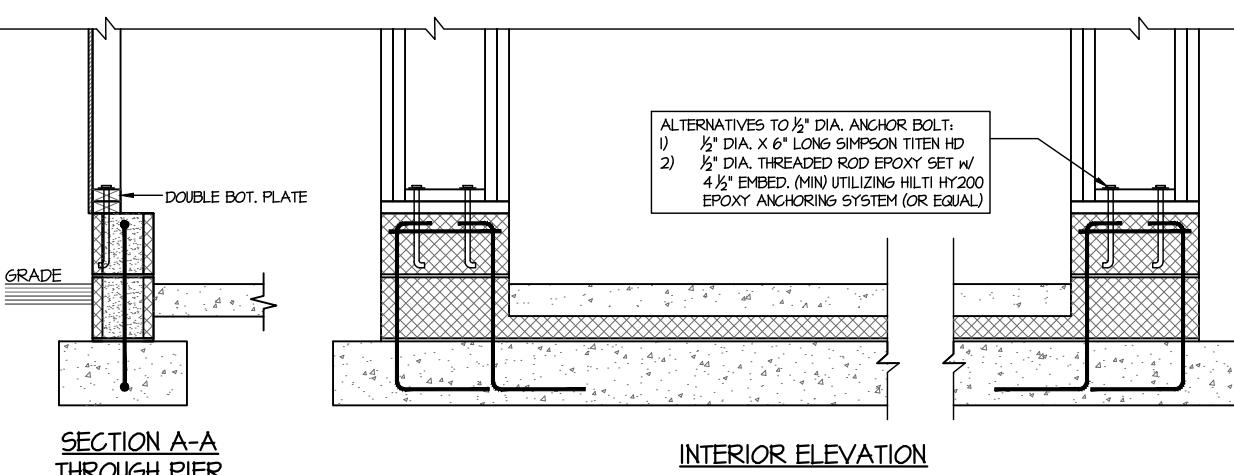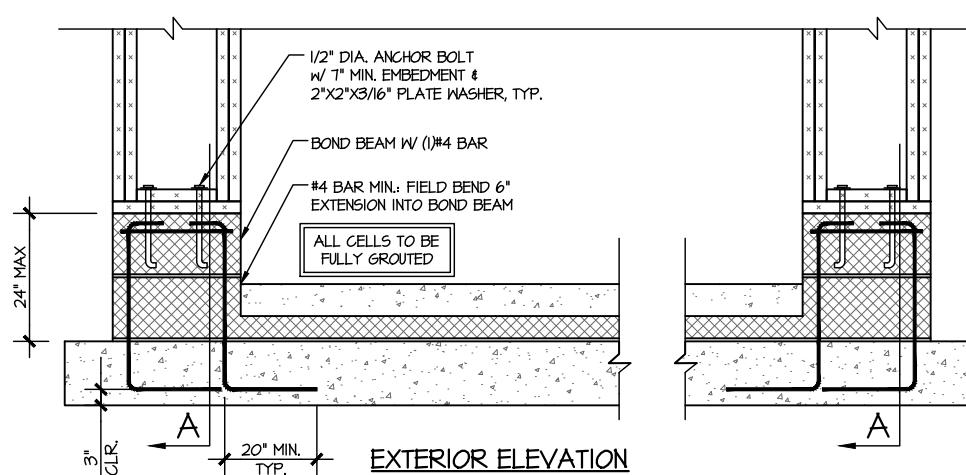

STEM ≤ 48" TALL

RAISED SLAB FOUNDATION

PORTAL FRAME DETAIL  
 SCALE: N.T.S.

BOTH SIDES OF GARAGE DOOR  
 1 KING STUD & RETURN WALLS




MULHERN+KULP  
RESIDENTIAL STRUCTURAL ENGINEERING  
300 Biscayne Ave, Building 1 • Aventura, FL 33180  
NC License # C-3825




STRUCTURAL DETAILS  
McDOWELL  
WIND SPEED < 115 MPH NORTH CAROLINA  
sheet:

SW-3

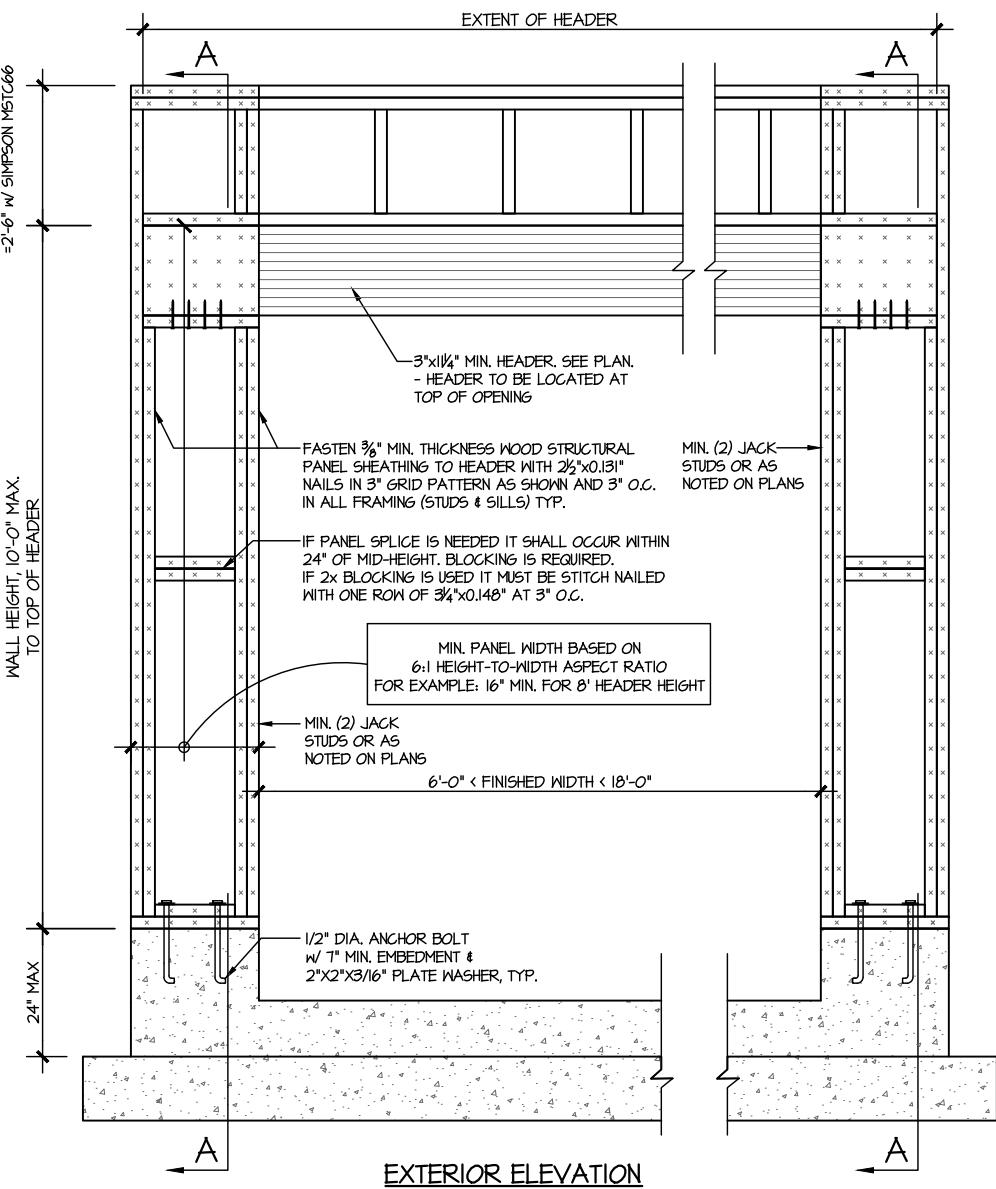


EXTERIOR ELEVATION

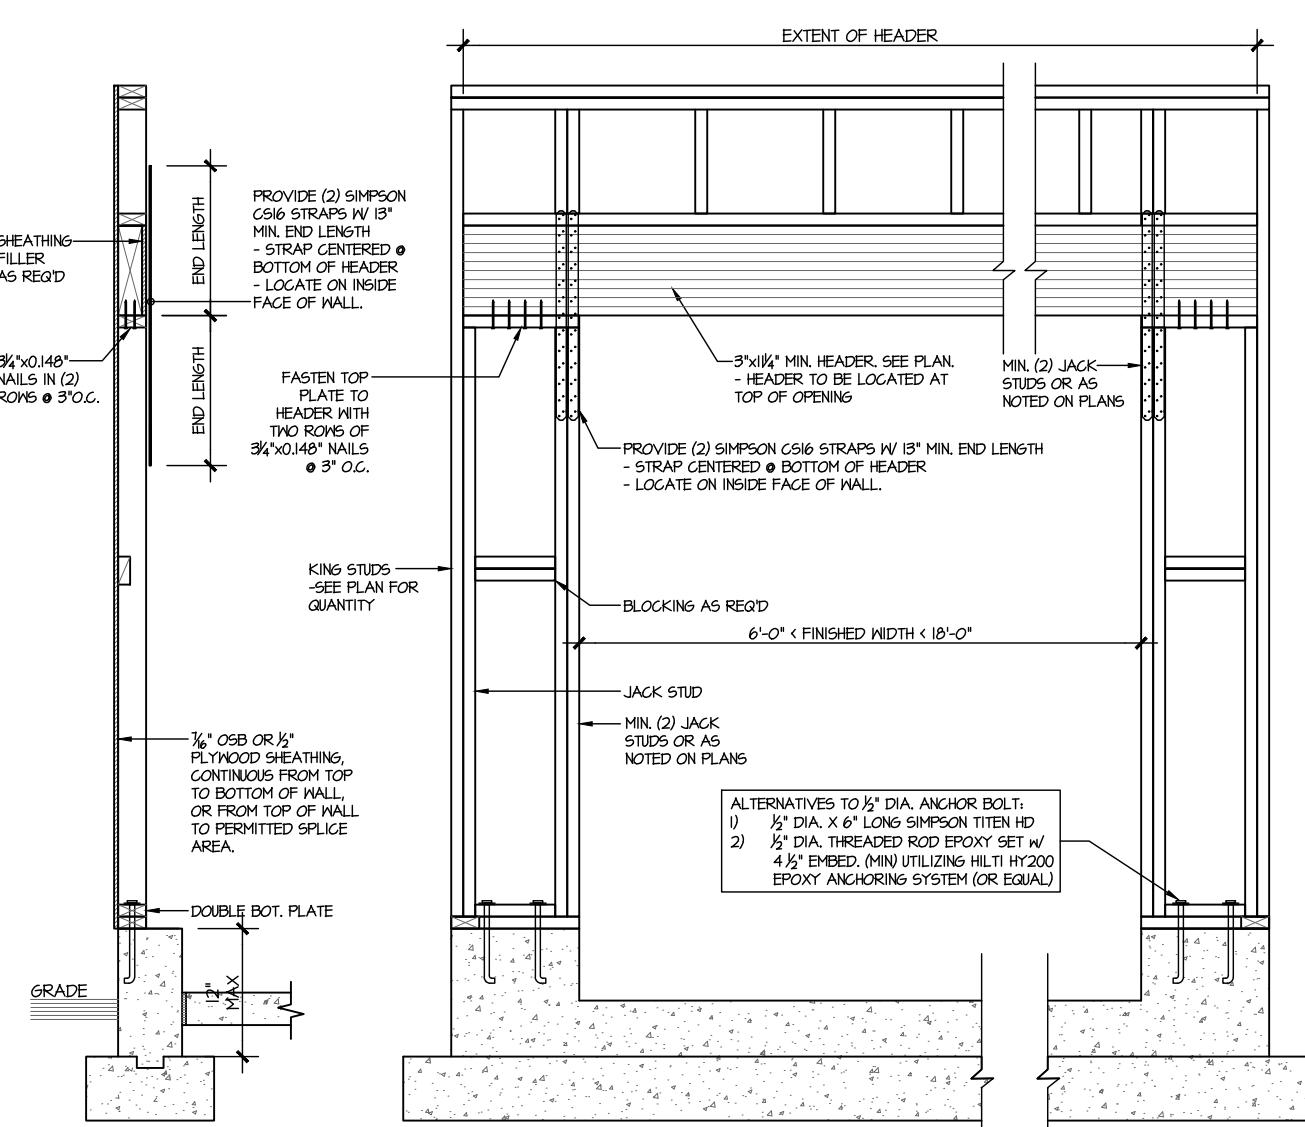


SECTION A-A  
THROUGH PIER

INTERIOR ELEVATION

BASEMENT FOUNDATION

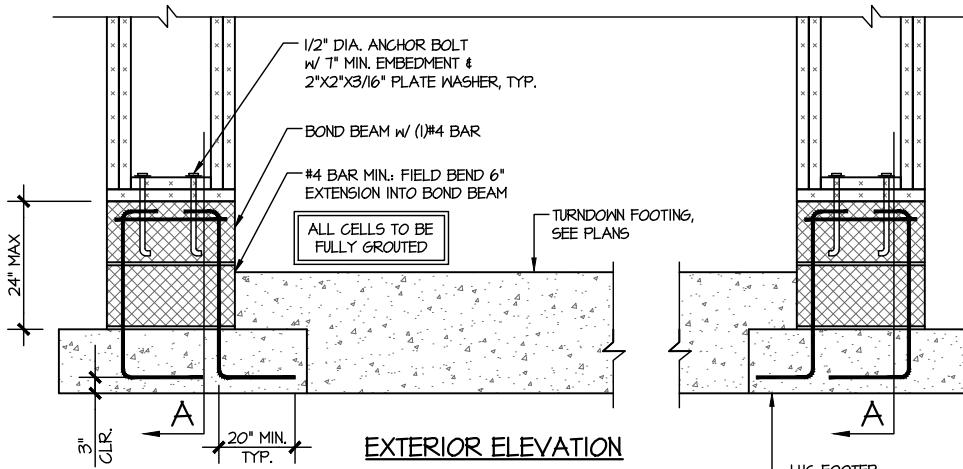

EXTERIOR ELEVATION

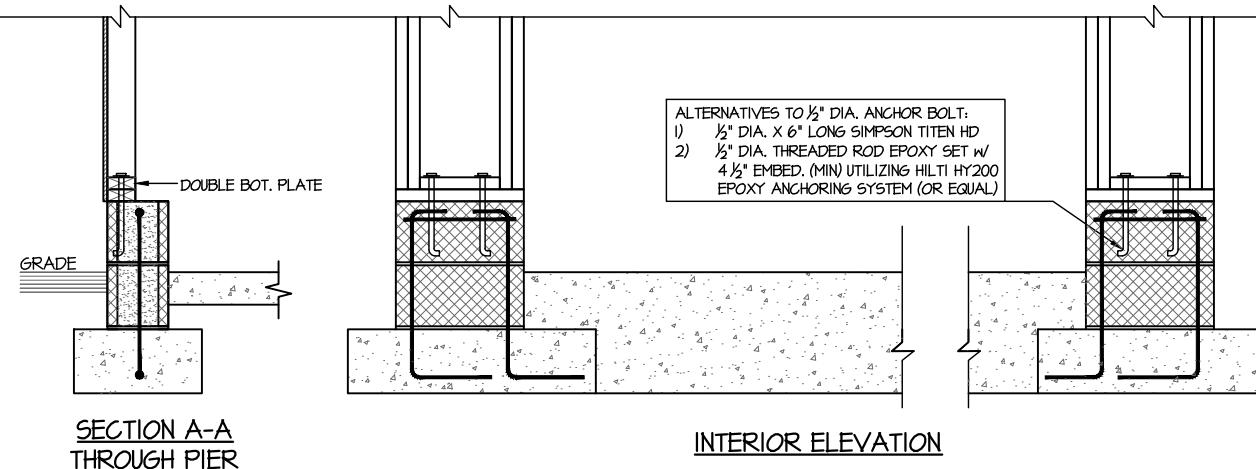

SECTION A-A  
THROUGH PIER


INTERIOR ELEVATION

CRAWLSPACE FOUNDATION


PORTAL FRAME DETAIL  
SCALE: N.T.S.

BOTH SIDES OF GARAGE DOOR  
1 KING STUD & RETURN WALLS


WALL FRAMING SPECIFICATION:  
• 2x4 WALL: USE SP/SPF #2  
GRADE STUDS (OR BETTER)  
• 2x6 WALL: USE SP/SPF #2  
GRADE STUDS (OR BETTER)

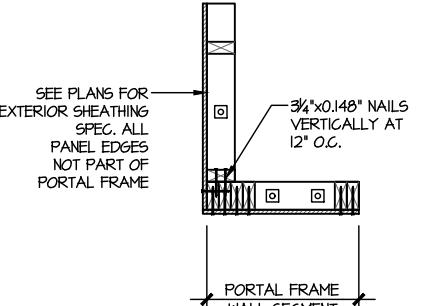

PLAN VIEW OF  
CORNER DETAIL

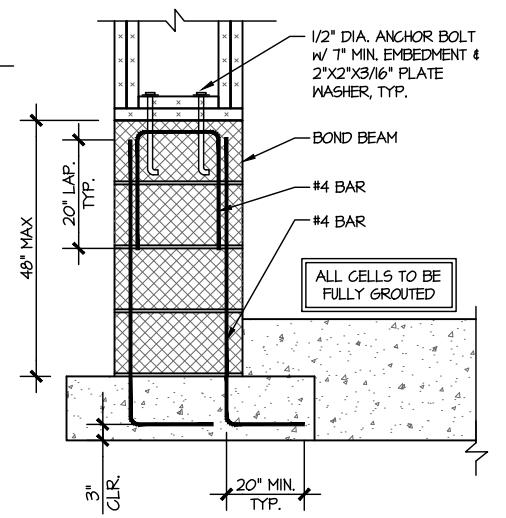

STEM HEIGHT >  
24" & ≤ 48"  
TALL

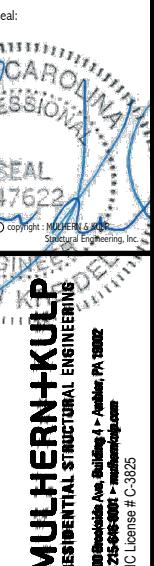

Copyright, MULHERN+KULP, Structural Engineering, Inc.  
308 Biscayne Ave, Building 1 • Aventura, FL 33180  
NC License # C-3825



M&K project number: 192-17012  
project mgr: SMK  
drawn by: MRG  
issue date: 03-24-22  
REVISIONS:  
date: initial  
ARCH: v.02.01.00.00



FOUNDATION DETAILS  
McDOWELL  
WIND SPEED < 115 MPH NORTH CAROLINA

sheet: DD-1

LEDGER NOTE	
• LEDGER TO END TRUSS:	-FASTEN 2x LEDGER (MATCH D.J.) TO END TRUSS VERTICALS w/ (1) 1/2" DIA. THRU BOLT + (4) 2 1/2" x 0.155" NAILS @ 16" O.C. PACK OUT END TRUSS AS REQD FOR LEDGER FASTENING.
• LEDGER TO RIMBOARD/BLOCKING:	-FASTEN 2x LEDGER (MATCH D.J.) TO RIMBOARD/BLOCKING (1) 1/2" DIA. THRU BOLT + (4) 2 1/2" x 0.155" NAILS @ 16" O.C.
• PROVIDE (2) BOLTS IN END (2) JOIST BAYS @ EACH END OF DECK	
• INSTALL (1) SIMPSON HB CLIP ON LAST (2) DECK JOISTS @ EACH END OF DECK, CONNECTING SIDE OF JOIST TO TOP OF LEDGER (IRC R502.2.2)	
• ALT. LEDGER SPEC:	FASTEN 2x10 LEDGER TO RIMBOARD W (2) 1/4" DIA. X 3 1/2" LONG SIMPSON SDS SCREWS @ 16" O.C.
• NOT APPLICABLE AT BRICK CONDITIONS	

