
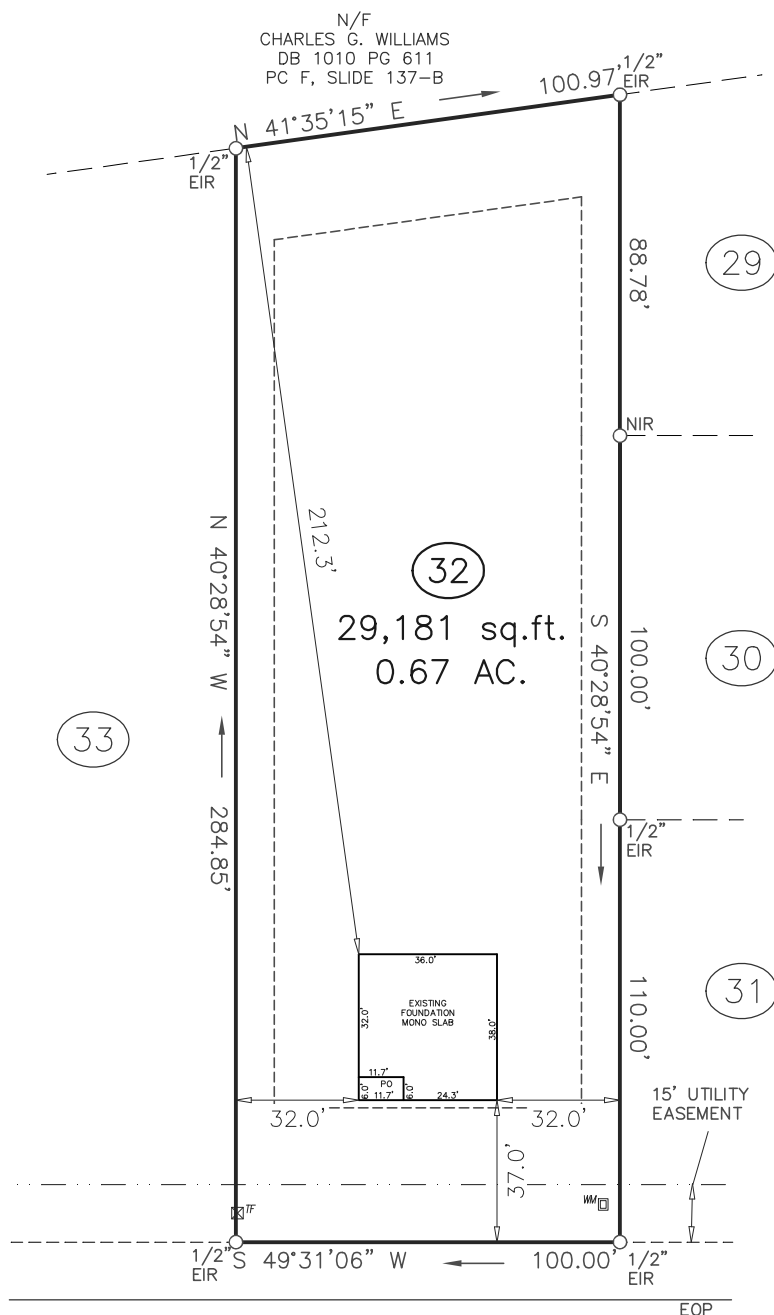
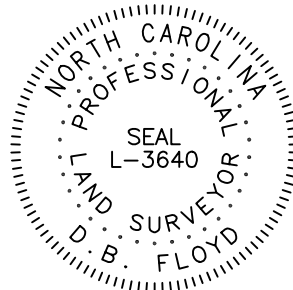


FRONT	35'
SIDE	20'
REAR	10'
SIDE STREET	25'

5. THIS PARCEL IS NOT LOCATED WITHIN A FLOOD HAZARD ZONE AS INDICATED ON CID NO. 370328 PANEL 1508, SUFFIX J, HARNETT COUNTY WITH AN EFFECTIVE DATE OF 10/03/2006.

DATE \_\_\_\_\_

THIS MAP MAY NOT BE A CERTIFIED  
SURVEY AND HAS NOT BEEN REVIEWED BY LOCAL  
GOVERNMENT AGENCY FOR COMPLIANCE WITH ANY  
APPLICABLE LAND DEVELOPMENT REGULATIONS  
AND HAS NOT BEEN REVIEWED FOR COMPLIANCE  
WITH RECORDING REQUIREMENTS FOR PLATS.

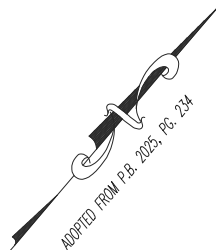

1 INCH = 50 FT.

**ECLS**  
GLOBAL, INC.  
U.S. VETERAN-OWNED  
19 N MCKINLEY ST  
COATS, NC 27521  
3257ECLSGLOBALINC.COM  
2329 (FAX) CO#C-4175