



SOUTH BREEZE WAY  
50' PUBLIC R/W - MB 2024-298

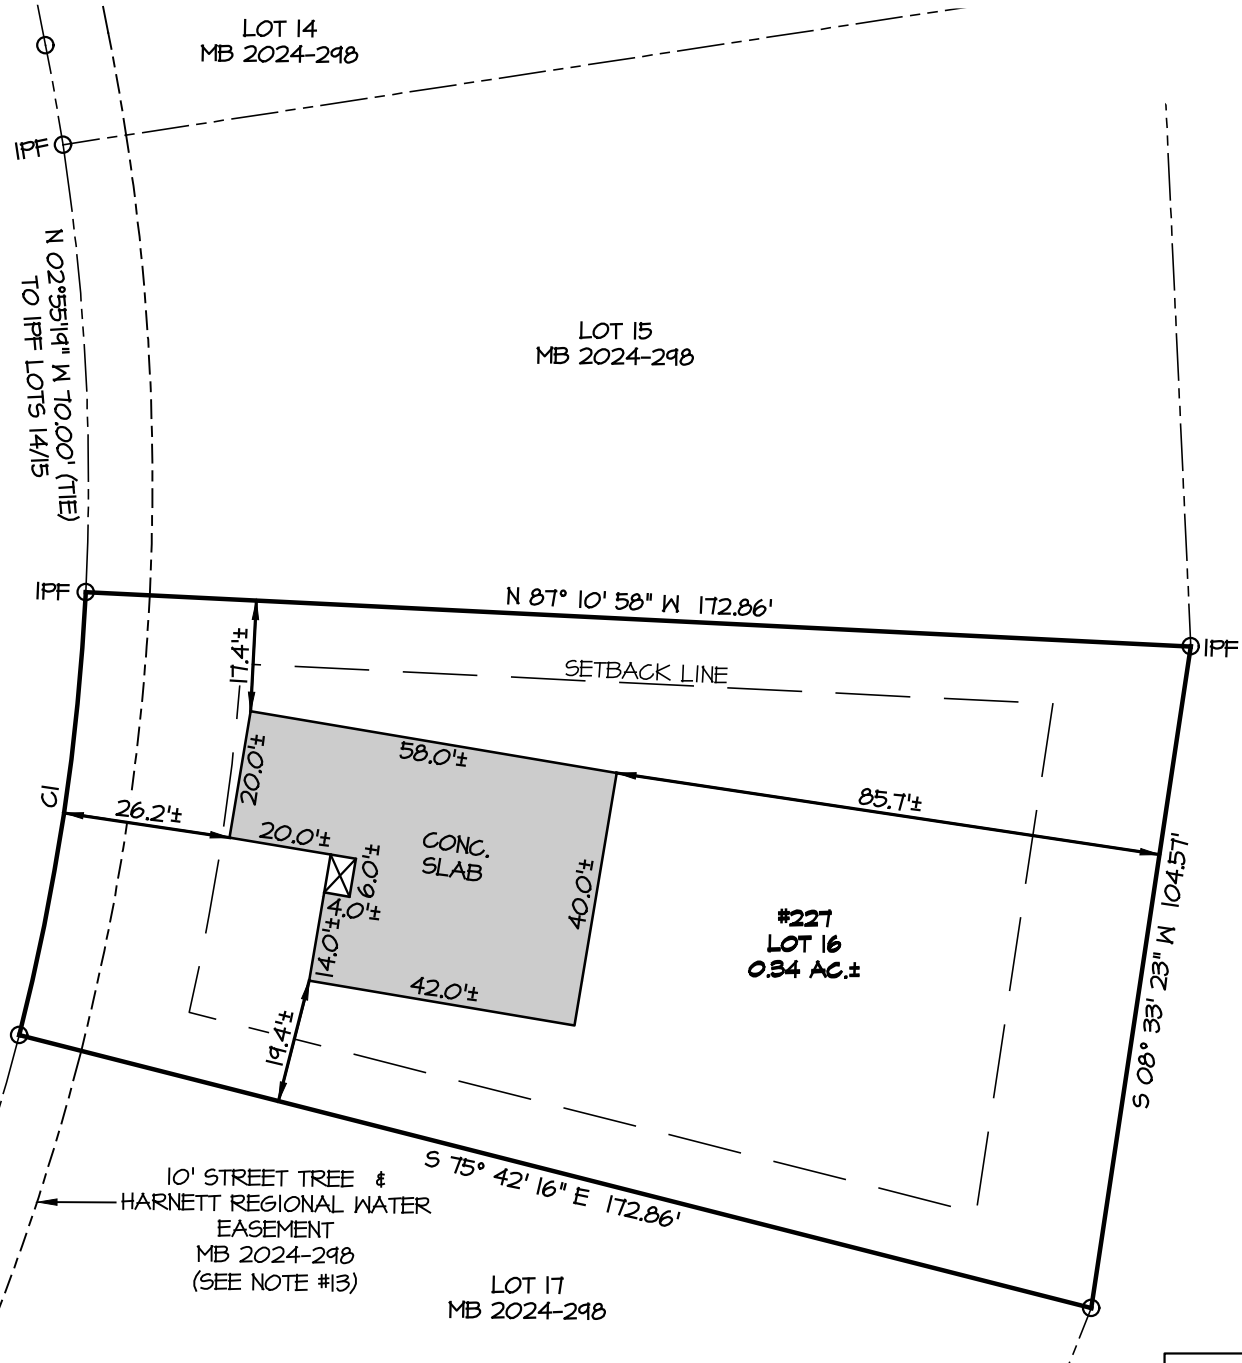

LEGEND

- IPF IRON PIPE FND.
- IPS IRON PIPE SET
- IRF REBAR FND.
- CALCULATED POINT
- ⊞ WATER METER
- CLEANOUT
- ⊞ YARD DRAIN
- ⊞ ELEC. TRANSFORMER
- ⊞ CABLE BOX
- ⊞ ELEC. BOX
- ⊞ COMM. VAULT
- ⊞ TELE. PEDESTAL
- ⊞ HVAC
- CONC. CONCRETE
- AG ABOVE GROUND
- BG BELOW GROUND
- MB MAP BOOK

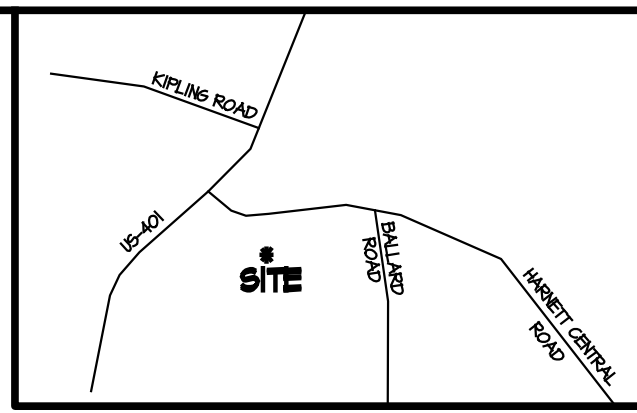

VICINITY MAP  
(NOT TO SCALE)

GENERAL NOTES


- DISTANCES DEPICTED HEREON ARE GROUND DISTANCES IN U.S. SURVEY FEET. AREAS COMPUTED USING THE COORDINATE METHOD.
- THIS SURVEY WAS PERFORMED WITHOUT BENEFIT OF CURRENT TITLE REPORT. PROPERTY DEPICTED HEREON MAY BE SUBJECT TO SUCH EASEMENTS, ETC. AS A CURRENT TITLE PACKAGE MAY DISCLOSE.
- PLAT REFERENCE: MAP BOOK 2024, PAGES 295-300.
- OFFSETS AND DIMENSIONS DEPICTED HEREON FROM THE PROPERTY LINES TO THE FOUNDATION OR BUILDING LINE ARE NOT INTENDED TO MONUMENT THE PROPERTY LINES AND ARE NOT TO BE USED TO GUIDE OR ASSIST IN THE ERECTION OF FENCES, STRUCTURES, OR ANY OTHER IMPROVEMENTS.
- ALL PROPERTY CORNERS FOUND ARE 5/8" IRON PIPES (OR REBAR) FLUSH WITH THE EXISTING GROUND AT THE TIME OF SURVEY UNLESS OTHERWISE NOTED HEREON.
- ALL PROPERTY CORNERS SET ARE 5/8" IRON PIPES SET FLUSH WITH THE EXISTING GROUND AT THE TIME OF SURVEY UNLESS OTHERWISE NOTED HEREON.
- ADJOINING OWNER INFORMATION TAKEN FROM DEEDS AND MAPS OF RECORD.
- SETBACKS: FRONT - 25'  
SIDE - 10'  
REAR - 20'
- PER RECORDED MAP, PORTION OF PROPERTY IS NOT LOCATED WITHIN SPECIAL FLOOD HAZARD AREA PER F.I.R.M. FLOOD RATE INSURANCE MAP NO. 3120064200J, BEARING EFFECTIVE DATE OF 10/03/2006.
- ZONING - RA-20R
- DATE OF FIELD SURVEY: 06/16/2025
- SURFACE LOCATIONS OF UTILITIES DEPICTED HERON. U/G UTILITIES NOT SURVEYED.
- 10' STREET TREE & HRW EASEMENT SHOWN HERON PER EXEMPT MAP OF CORRECTION "KIPLING VILLAGE, PHASE 1A" IS NOT SPECIFIED AS PUBLIC OR PRIVATE. AN ATTORNEY SHOULD BE CONTACTED FOR ANY ISSUES OR CLARIFICATIONS.

OPEN SPACE  
MB 2024-298

THIS MAP IS NOT A CERTIFIED SURVEY AND  
HAS NOT BEEN REVIEWED BY A LOCAL  
GOVERNMENT AGENCY FOR COMPLIANCE WITH  
ANY APPLICABLE LAND DEVELOPMENT  
REGULATIONS


CURVE TABLE

CURVE #	LENGTH	RADIUS	CHORD BEARING	CHORD LENGTH
C1	70.12'	350.00'	N 08° 33' 23" E	70.00'

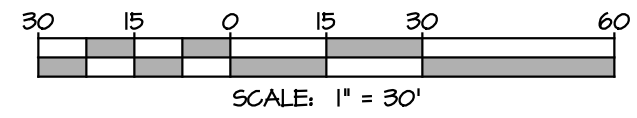

I HEREBY CERTIFY THAT THIS AS-BUILT SURVEY WAS DRAWN UNDER MY DIRECT SUPERVISION FROM AN ACTUAL FIELD-RUN SURVEY AND THAT THERE ARE NO ENCROACHMENTS UNLESS OTHERWISE SHOWN. DEED REFERENCES ARE AS DEPICTED HEREON. THE RATIO OF PRECISION OR POSITIONAL ACCURACY IS 1:10,000+ AND THAT THIS PLAT MEETS THE REQUIREMENTS OF THE STANDARD OF PRACTICE FOR LAND SURVEYING IN NORTH CAROLINA (21 NCAC 56, 1600).

CALEB TROY CLAYTON SR., PLS L-5306  
06/23/25

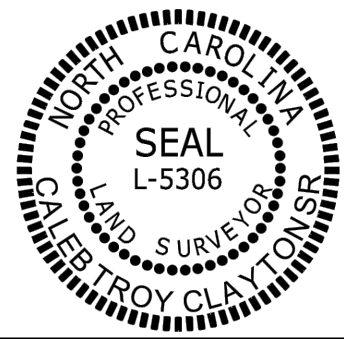

MORRIS & RITCHIE ASSOCIATES OF NC, PC  
ENGINEERS, ARCHITECTS, PLANNERS, SURVEYORS AND  
LANDSCAPE ARCHITECTS  
530 HINTON POND ROAD, SUITE 104  
KNIGHTDALE, NORTH CAROLINA 27545  
(984) 200-2103  
LICENSE # C-4182, G-442  
MRASTA.COM  
© 2025 MORRIS & RITCHIE ASSOCIATES, INC.

FOUNDATION AS-BUILT SURVEY  
LOT 16 - #227 SOUTH BREEZE WAY  
KIPLING VILLAGE - PHASE 1A  
HARNETT COUNTY-FUQUAY-VARINA-NORTH CAROLINA

SURVEYED FOR: RYAN HOMES - RALEIGH  
5734 TRINITY ROAD, SUITE 200  
RALEIGH, NC 27607

SCALE: 1"=30'	DATE: 06/11/2025	DRAWN BY: CDM	REVISED:	REVIEW BY: CTC	JOB NO.: 21103
---------------	------------------	---------------	----------	----------------	----------------