Harnett County Department of Public Health Operation Permit PERMIT # SFD 2505-0174 Mew Installation Message Septic Tank Message Nitrification Line Repair Expansion PROPERTY LOCATION: 126 m. (Sel Place (8278) SUBDIVISION Harrington Place Name: (owner) Smith Douglas Homas LOT # 60 System Installer: Garage Number of Bedrooms 4 (8people) Basement with plumbing: Type of Water Supply: 

Community Public ☐ Well Distance from well System Type: Types V and VI Systems expire in 5 years. (In accordance with Table V a) Owner must contact Health Department 6 months prior to expiration for permit renewal. This system has been installed in compliance with applicable North Carolina General Statutes, Rules for Sewage Treatment and Disposal, and all conditions of the Improvement Permit and Construction Authorization. 481 PERMIT CONDITIONS: mildred Pl Performance: System shall perform in accordance with Rule . 1961. II. Monitoring: As required by Rule .1961. III. Maintenance: As required by Rule .1961. Other: Subsurface system operator required? Yes 
No 
No If yes, see attached sheet for additional operation conditions, maintenance and reporting. IV. Operation: Other: D-Box H20Line **PWR Line** Following are the specifications for the sewage disposal system on the above captioned property. Other 256 reductions IQu Type of system: 


Conventional Septic Tank: gallons Pump Tank: Subsurface No. of exact length width of depth of Drainage Field ditches of each ditch ditches


Date Authorized State Agent

Linear feet

French Drain Required:

## Harrington Place Lot 60 System Detail "As Built"

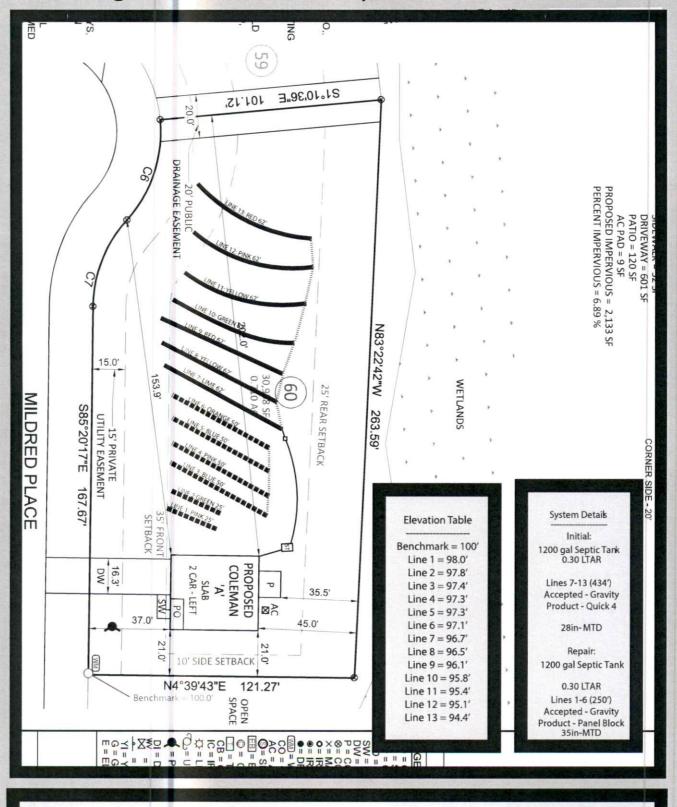

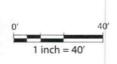



Legend



