

Harnett County Department of Public Health

PERMIT # SFD 2503-0185

Operation Permit

New Installation Septic Tank Nitrification Line Repair Expansion

PROPERTY LOCATION: 98 Priming Way, Angier

SUBDIVISION Tobacco Road

LOT # 107

Name: (owner) David Sen Homes

System Installer: Genes Backhoe

Basement with plumbing: Garage Number of Bedrooms 4


Type of Water Supply: Community Public Well Distance from well _____ feet

System Type: 25% Reduction Type III(g) EZ-Flow Types V and VI Systems expire in 5 years.

(In accordance with Table V a)

Owner must contact Health Department 6 months prior to expiration for permit renewal.

This system has been installed in compliance with applicable North Carolina General Statutes, Rules for Sewage Treatment and Disposal, and all conditions of the Improvement Permit and Construction Authorization.

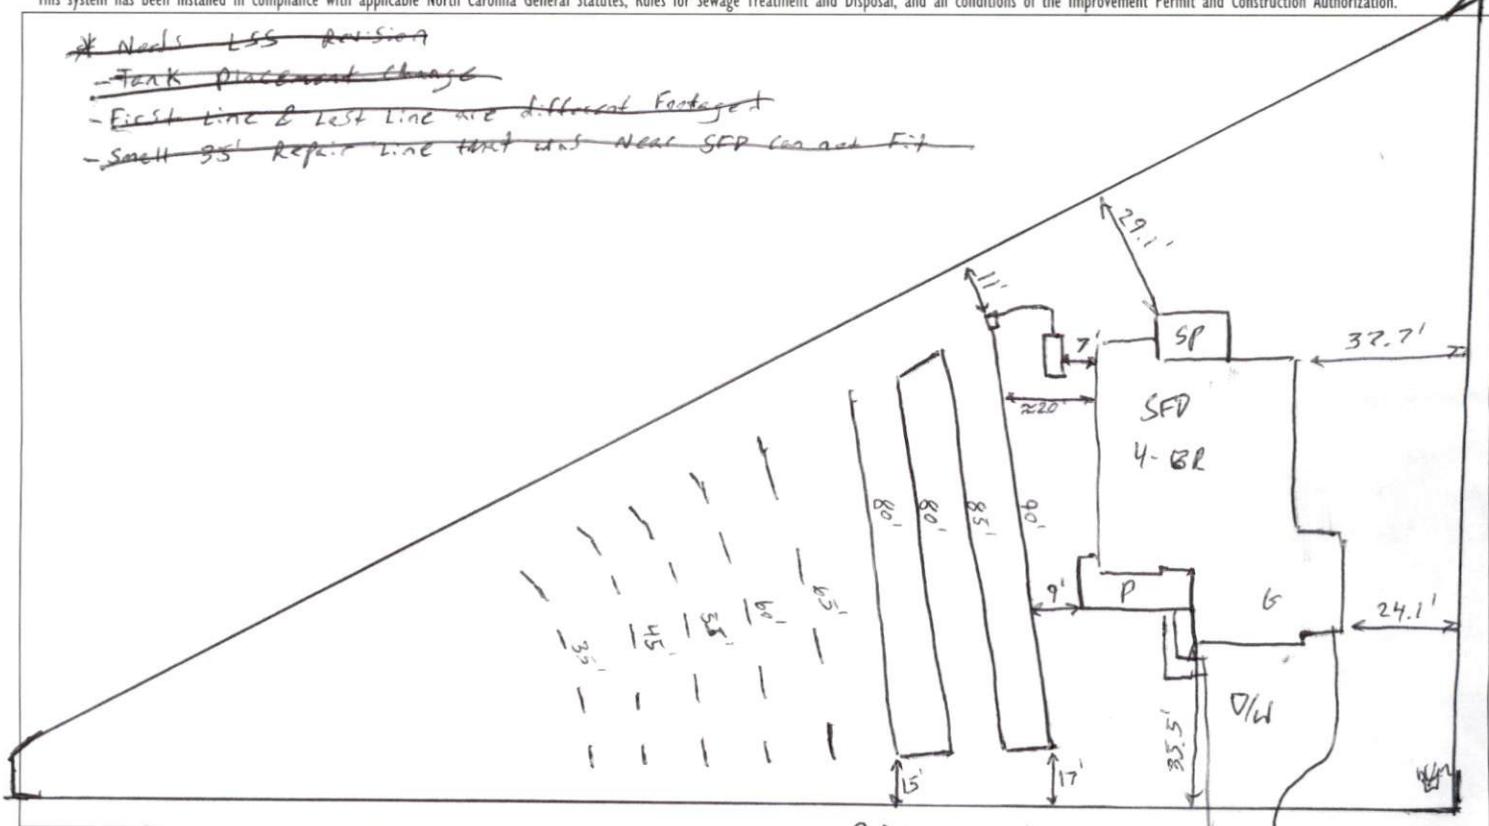

PERMIT CONDITIONS:

I. Performance: System shall perform in accordance with Rule .1961.

II. Monitoring: As required by Rule .1961.

III. Maintenance: As required by Rule .1961. Other: _____

Subsurface system operator required? Yes No

If yes, see attached sheet for additional operation conditions, maintenance and reporting.

IV. Operation: _____

V. Other: _____

D-Box Pump Alarm H2OLine PWR Line

Following are the specifications for the sewage disposal system on the above captioned property.

Type of system: Conventional Other TYPE III(g) EZ Flow Septic Tank: 1,000 gallons Pump Tank: _____ gallons

Subsurface No. of exact length width of depth of
Drainage Field ditches 1 of each ditch 33.5 feet ditches 3 feet ditches 18 inches

French Drain Required: _____ Linear feet

Authorized State Agent Don Juan REHIS

Date 11-13-25

Tobacco Road PH 2
Lot 107
4 BR
Harnett County
**As Built" revision - approved by Alex Adams


*House footprint to be field staked by surveyor and system verified prior to any construction

**Septic area must not be altered by construction activities.

***No cuts of 2' or greater within
within 15' of septic area

**** Recommend protective barrier around septic field during construction.

If plumbing is not sufficient a pump tank will be required to septic field

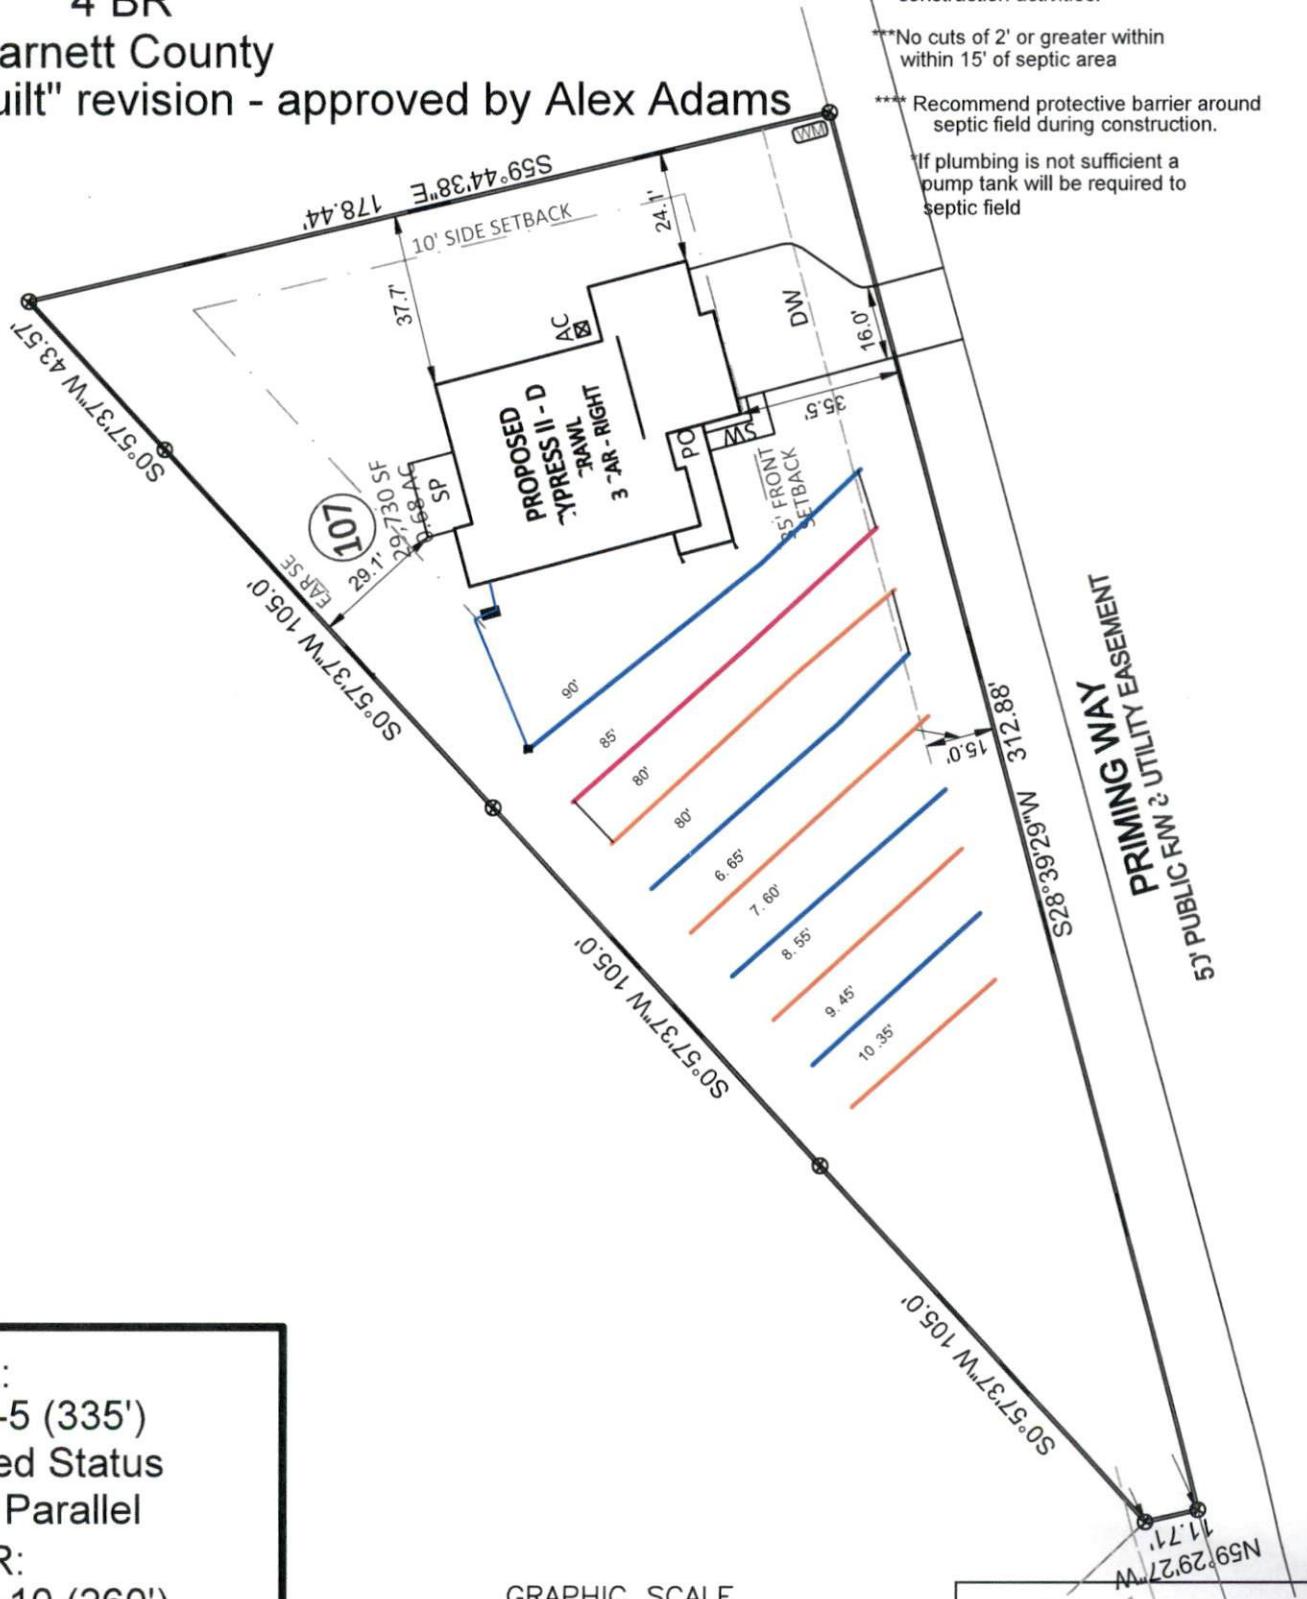

INITIAL:
Lines 2-5 (335')
Accepted Status
Gravity Parallel
REPAIR:
Lines 6-10 (260')
PPBPS
Pressure Manifold

GRAPHIC SCALE
1" = 50'



Adams
Soil Consulting
919-414-6761