

Harnett County Department of Public Health

PERMIT # SFD2506-0004

Operation Permit

☒ New Installation ☒ Septic Tank ☒ Nitrification Line ☐ Repair ☐ Expansion

PROPERTY LOCATION: 697 Beacon Hill Rd (SR 1292)

SUBDIVISION Duncans Creek

LOT # 39

Name: (owner) New Home Inc.

System Installer: Dennis Medlin

Basement with plumbing: ☐ Garage ☒ Number of Bedrooms 4 (8 people)


Type of Water Supply: ☐ Community ☒ Public ☐ Well Distance from well _____ feet

System Type: TYPE III 9 Types V and VI Systems expire in 5 years.

(In accordance with Table V a)

Owner must contact Health Department 6 months prior to expiration for permit renewal.

This system has been installed in compliance with applicable North Carolina General Statutes, Rules for Sewage Treatment and Disposal and all conditions of the Improvement Permit and Construction Authorization.

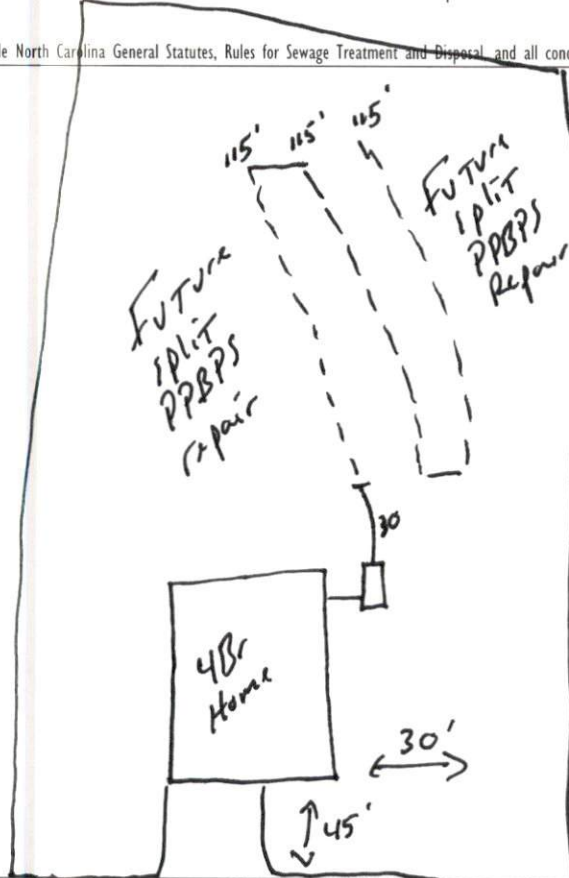

PERMIT CONDITIONS:

I. Performance: System shall perform in accordance with Rule .1961.

II. Monitoring: As required by Rule .1961.

III. Maintenance: As required by Rule .1961. Other: _____

Subsurface system operator required? Yes ☐ No ☐

If yes, see attached sheet for additional operation conditions, maintenance and reporting.

IV. Operation: _____

V. Other: _____

☐ D-Box ☐ Pump ☐ Alarm ☐ H2O Line ☐ PWR Line

Following are the specifications for the sewage disposal system on the above captioned property.

Type of system: ☐ Conventional ☒ Other 25% reduction effluent Septic Tank: 1000 gallons Pump Tank: _____ gallons

Subsurface No. of exact length width of depth of
Drainage Field ditches 3 of each ditch 115 feet ditches 3 feet ditches 20 inches

French Drain Required: _____ Linear feet

Authorized State Agent

[Signature] REB

Date 9-22-25

*House footprint to be field staked by surveyor and system verified prior to any construction

**Septic area must not be altered by construction activities.


***No cuts of 2' or greater within 15' of septic area

**** Recommend protective barrier around septic field during construction.

*If plumbing is not sufficient a pump tank will be required to septic field

Duncans Creek Lot 39 "AS Built Revision" Harnett County

At time of installation septic installer was able to dose septic field with gravity to serial distribution. This system modification is Approved by Alex Adams.

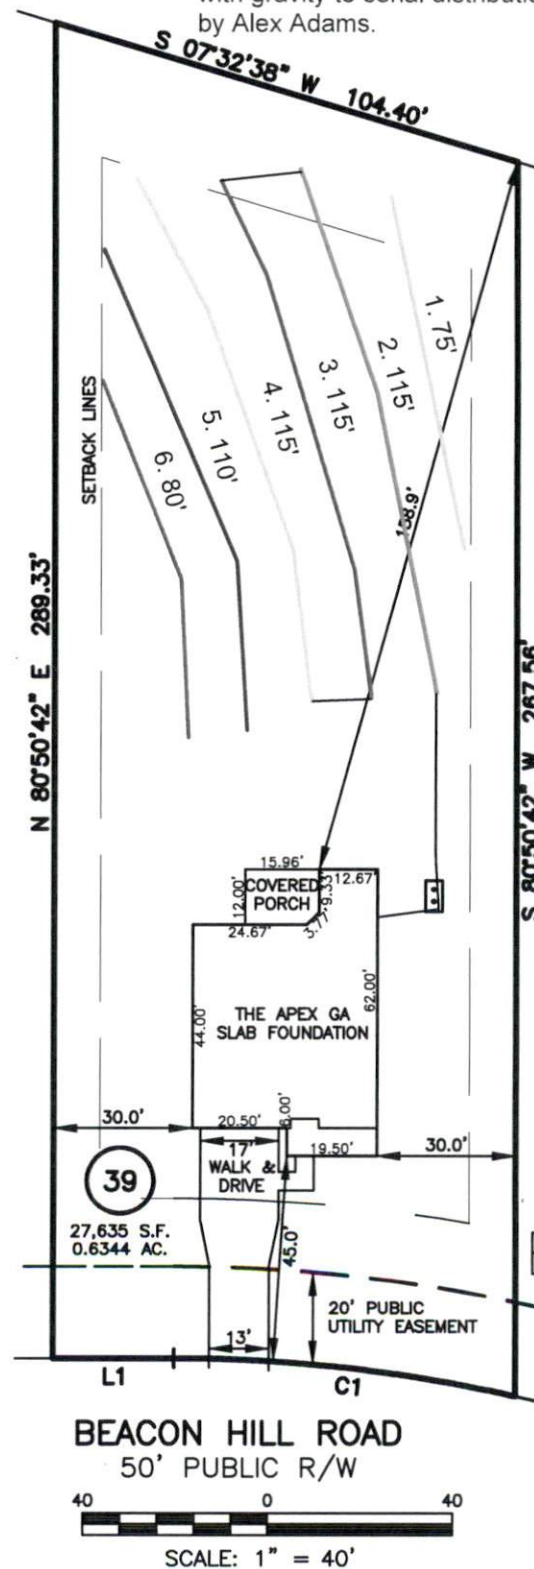

Adams
Soil Consulting
919-414-6761

INITIAL:
Lines 2-4 (345')
Accepted Status
serial distribution
REPAIR:
Lines 1,5-6 (270')
PPBPS
Pressure Manifold