

Harnett County Department of Public Health

PERMIT # SFD 2506-0010

Operation Permit

New Installation Septic Tank Nitrification Line Repair Expansion

PROPERTY LOCATION: 1326 Main St, Lillington

Name: (owner) BC Brink Creek, LLC - Davison Homes SUBDIVISION Retreat at North Main LOT # 4

System Installer: Genes Deckhouse

Basement with plumbing: Garage Number of Bedrooms 4


Type of Water Supply: Community Public Well Distance from well _____ feet

System Type: 25% Reduction Type III (G) EZ-Flow Types V and VI Systems expire in 5 years.

(In accordance with Table V a) Owner must contact Health Department 6 months prior to expiration for permit renewal.

This system has been installed in compliance with applicable North Carolina General Statutes, Rules for Sewage Treatment and Disposal, and all conditions of the Improvement Permit and Construction Authorization.

~~Needs LSS
Revision For Final~~

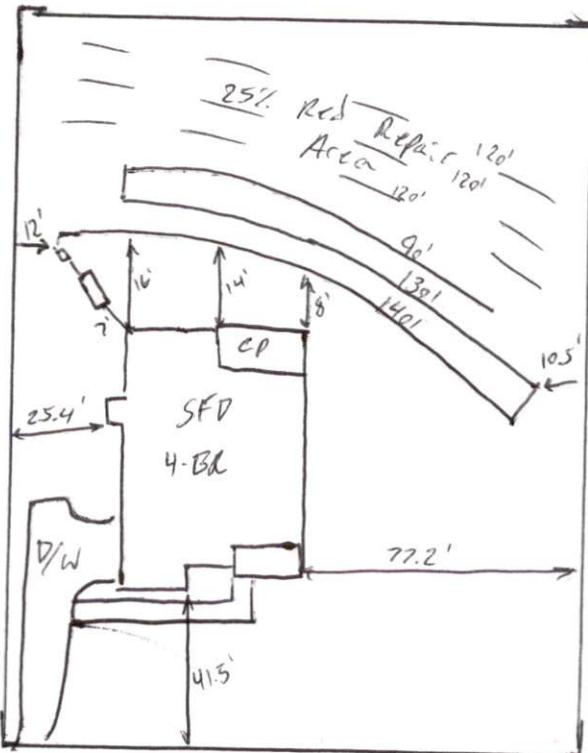

PERMIT CONDITIONS:

I. Performance: System shall perform in accordance with Rule .1961.

II. Monitoring: As required by Rule .1961.

III. Maintenance: As required by Rule .1961. Other: _____

Subsurface system operator required? Yes No

If yes, see attached sheet for additional operation conditions, maintenance and reporting.

IV. Operation: _____

V. Other: _____

D-Box Pump Alarm H2OLine PWR Line

Following are the specifications for the sewage disposal system on the above captioned property.

Type of system: Conventional Other Type III (G) EZ-Flow Septic Tank: 14000 gallons Pump Tank: — gallons

Subsurface No. of exact length width of ditches depth of ditches inches

Drainage Field ditches 1 of each ditch 360' feet 3' feet 20" inches

French Drain Required: _____ Linear feet

Authorized State Agent Patricia R. Edwards

Date 10-30-25

Lot #4 - Retreat at North Main St.

"AS Built Revision"


1326 N Main St. - Lillington, NC

Davidson Homes

Harnett County PIN: 0680-09-7462

*At time of installation installation was modified as shown. Change is "Approved" by Alex Adams

*Not a Survey
Sketched from a plot plan supplied by owner

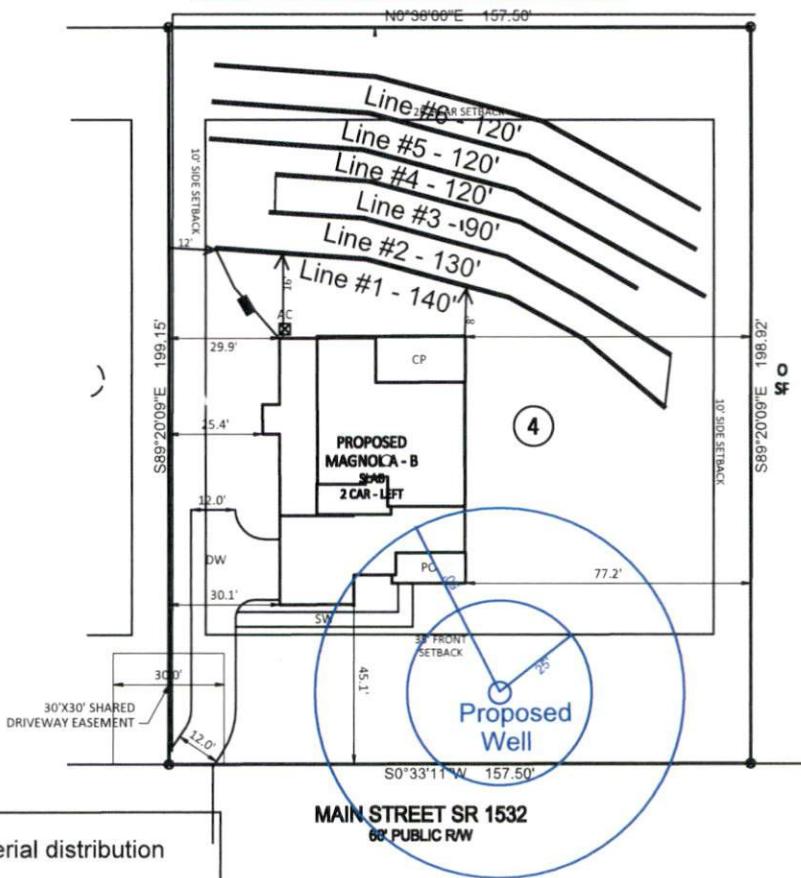

System: Gravity to serial distribution

Lines: 1-3 (360')

0.35 LTAR

20" Max Trench Bottom

Accepted Status System

Repair: Pressure Manifold

Lines: 4-6 (360')

0.35 LTAR

24" Max Trench Bottom

Accepted Status System

**1000 Gallon Septic and Pump Tanks
Tank and trenches to be located minimum of 10' from any property line and minimum of 5' from any building foundation.
*Do Not Cut, Fill, or Alter Drainfield or Repair Area
*Comply with all setbacks
*Contact local health dept. and/or Alex Adams prior to or during installation with any questions or concerns.

Adams
Soil Consulting
919-414-6761
Job #1945
10-29-25

GRAPHIC SCALE
1" = 50'

