

GRID NORTH  
NAD 83 (2011)




Map #2025-386


Joseph Paul Johnson  
Edward Lee Johnson  
PC #1, Slide 341  
(Tract 3)

- LEGEND:**
- Subject Property Line
  - Adjoining Property Line
  - R/W Right-of-Way Line
  - C/L Centerline
  - Minimum Building Line
  - Survey tie lines
  - Calculated Point
  - CP Existing Iron Stake
  - ERB Existing Re-Bar
  - EPK Existing PK Nail
  - EMS Existing Magnetic Spike
  - BG/AG Below/Above Grade
  - PP Power Pole

**FEMA FLOOD HAZARD STATEMENT**  
The subject property shown on this plat is located within the FEMA "Zone X" (Minimal Flood Risk) Area as shown on FIRM Number: 3720150900J  
Effective date: 10/3/2006

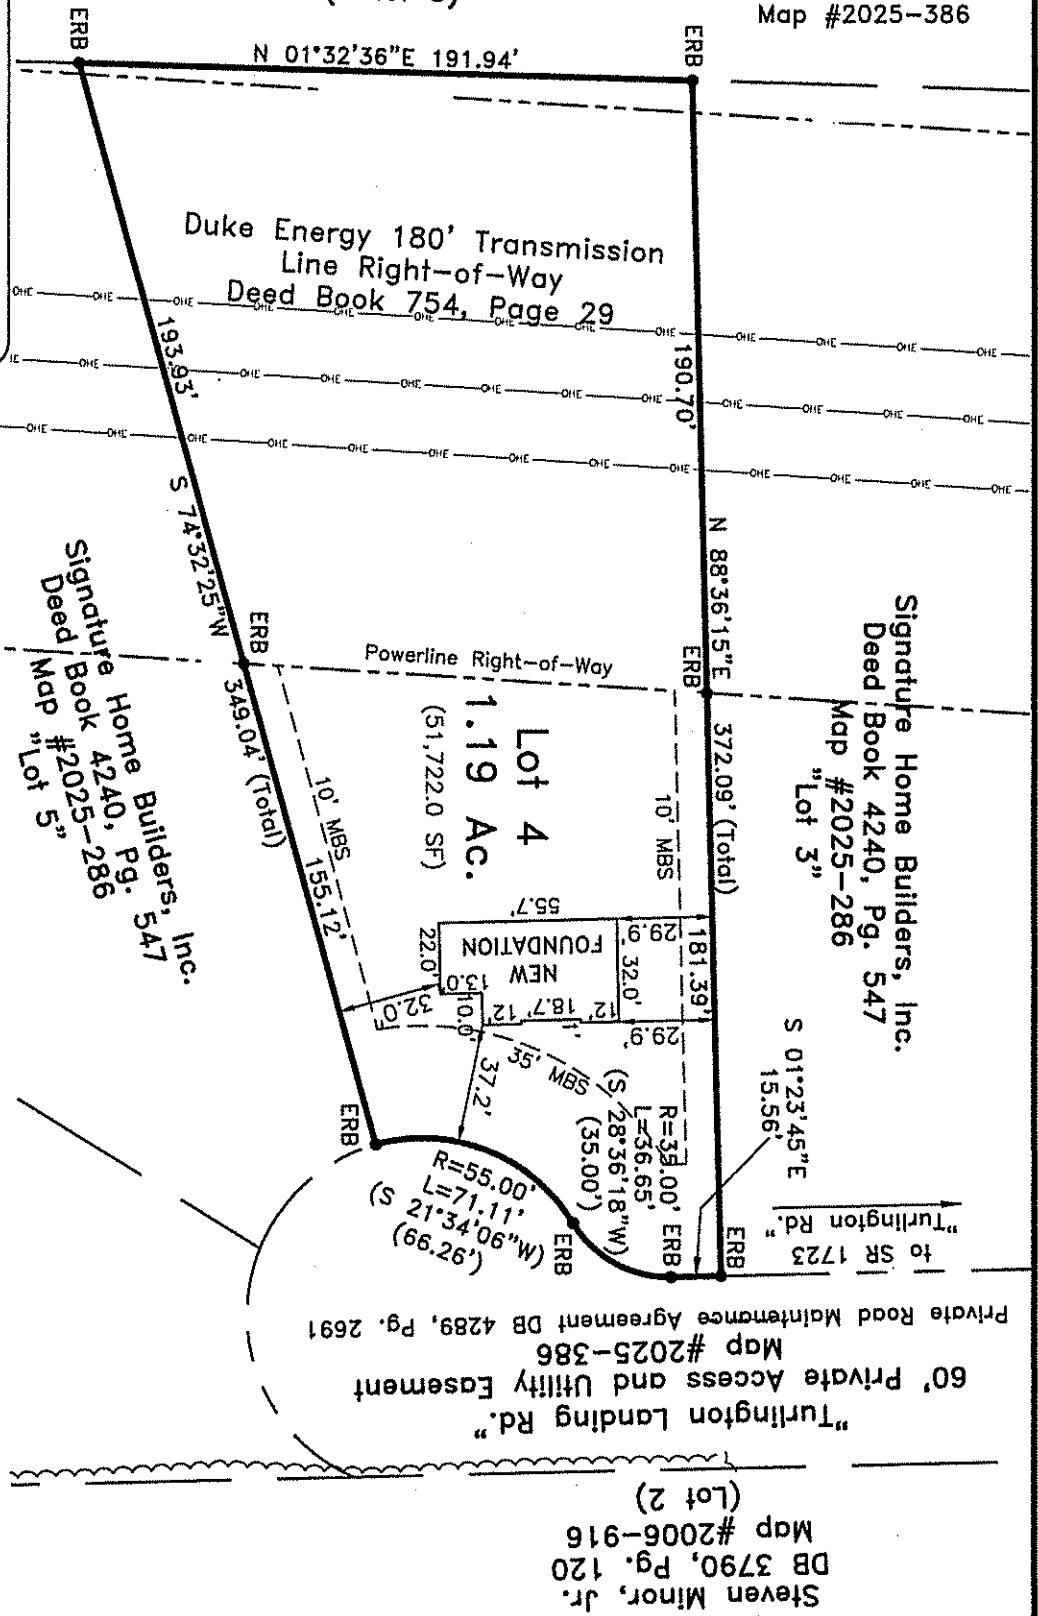


**Note:**  
Foundation Location based upon nails set in concrete footing for brick masons on July 22nd, 2025. As-built dimensions of foundation confirmed on this date.

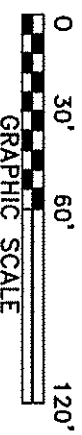

Steven Minor, Jr.  
DB 3790, Pg. 120  
Map #2006-916  
(Lot 2)

"Turlington Landing Rd."  
60' Private Access and Utility Easement  
Map #2025-386  
Private Road Maintenance Agreement DB 4289, Pg. 2691

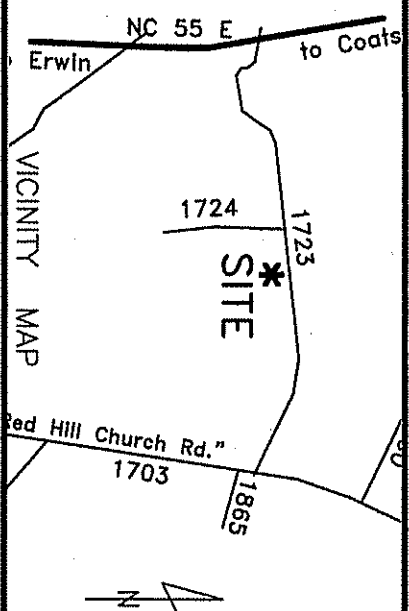

~ Foundation Survey ~  
**Signature Home Builders, Inc.**

Grove Township Harnett County  
Scale: 1" = 60' Date: 8/29/2025

Surveyed & Mapped By  
**STREAMLINE**  
**LAND SURVEYING, Inc.**

NC FIRM C-1898  
870 NC 55 W, Coats, N.C. 27521  
Phone: 910-897-7715

I hereby certify that the foundation location shown hereon is correct in relation to property lines of record.  
**NOTE:** The purpose of this survey is to locate the newly constructed foundation.  
Other features, fixtures, encumbrances and indications of use may be revealed by a complete site survey.



NOT FOR RECORDATION