

VICINITY MAP (NTS)

LEGEND
EOP-EDGE OF PAVEMENT
TP-TELECOMMUNICATION PEDESTAL
-W--WATER LINE

O=EXISTING IRON PIPE (EIP) O=EXISTING IRON ROD (EIR) O=NEW IRON PIPE (NIP) O=MAG NAIL SET (MNS)

AG=ABOVE GROUND BG=BELOW GROUND

35° 10° 25° 20° FRONT SIDE REAR SIDE CORNER ZONING: RA-30

THIS EXHIBIT MAP IS OF AN EXISTING PARCEL OR PARCELS OF LAND AND DOES NOT CREATE A NEW STREET OR CHANGE AN EXISTING STREET.

## PRELIMINARY

NICHOLAS M. FRENCH, PLS L-4817

THIS MAP IS ONLY INTENDED FOR THE PARTIES AND PURPOSES SHOWN. THIS MAP IS NOT FOR RECORDATION. NO TITLE REPORT PROVIDED.

THIS MAP MAY NOT BE A CERTIFIED SURVEY AND HAS NOT BEEN REVIEWED BY A LOCAL GOVERNMENT AGENCY FOR COMPLIANCE WITH ANY APPLICABLE LAND DEVELOPMENT REGULATIONS AND HAS NOT BEEN REVIEWED FOR COMPLIANCE WITH RECORDING REQUIREMENTS FOR PLATS.

- ALL DISTANCES ARE HORIZONTAL GROUND DISTANCES IN U.S. SURVEY FEET UNLESS OTHERWISE NOTED. AREAS SHOWN HEREON WERE COMPUTED USING THE COORDINATE. METHOD.

- AREAS SHOWN HEREON WERE COMPUTED USING THE COCUMARIEM METHOD.

  3. LINES NOT SURVEYED ARE SHOWN AS DASHED LINES FROM INFORMATION REFERENCED ON THE FACE OF THIS PLAT.

  4. PROPERTY MAY BE SUBJICT TO ANY/ALL EASEMENTS AND RESTRICTIONS OF RECORD. THIS ASBUILT IS A CORRECT REPRESENTATION OF THE LAND PLATTED AND OR DEEDED AND HAS BEEN PREPARED WITHOUT THE BENEFIT OF A TITLE REPORT. A NORTH CAROLINA LICENSED ATTORNEY—AT—LAW SHOULD BE CONSULTED REGARDING CORRECT OWNERSHIP, WIDTH AND LOCATION OF EASEMENTS, AND OTHER TITLE QUESTIONS REVEALED BY TITLE EXAMINATION.


  5. WATER LINE (UNDERGROUND) SHOWN HEREON IS FOR GRAPHICAL PURPOSES ONLY AND NOT FIELD SURVEYED BY ECLS GLOBAL INC.


  6. UNDERGROUND LITLITY NOT FIELD LOCATED BY ECLS GLOBAL INC.

SEAL L-4817 DAS M. FRETH

THIS PROPERTY IS NOT LOCATED IN THE SPECIAL FLOOD HAZARD AREA. FLOOD MAP: 3720068200J HARNETT COUNTY-CID: 370328 PANEL: 0682 SUFFIX: J EFFECTIVE DATE 10/03/2006

LINE		DISTANCE
L1	S 61*33'49" W	23.29

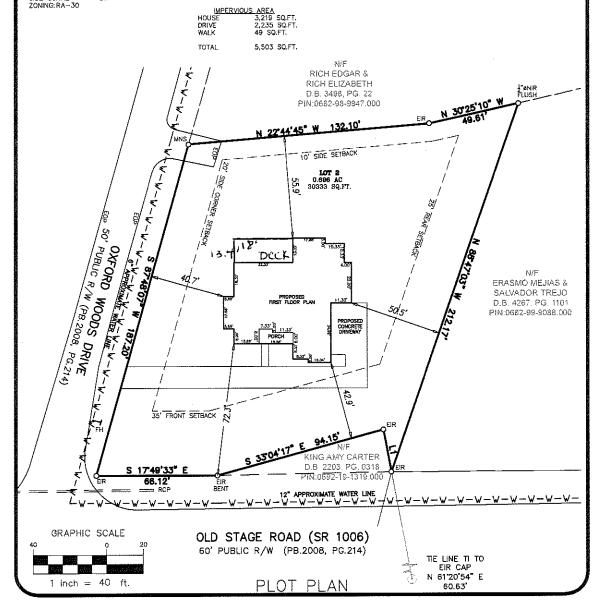

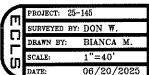

ERASMO MEJIAS CALLEJAS & SALVADOR TREJO MEJIAS OLD STAGE RD, ANGIER NC 27501 LOT 2 BLACK RIVER TWP., HARNETT CO., NC

P.B. 2025, PG. 390 PIN: 0682-99-9088.000

