


AS-BUILT IMPROVEMENTS FOR  
NEW HOME, INC.  
620 BEACON HILL ROAD  
LOT 55, DUNCAN'S CREEK PHASE 2  
UPPER LITTLE CREEK TOWNSHIP, HARNETT COUNTY, NORTH CAROLINA

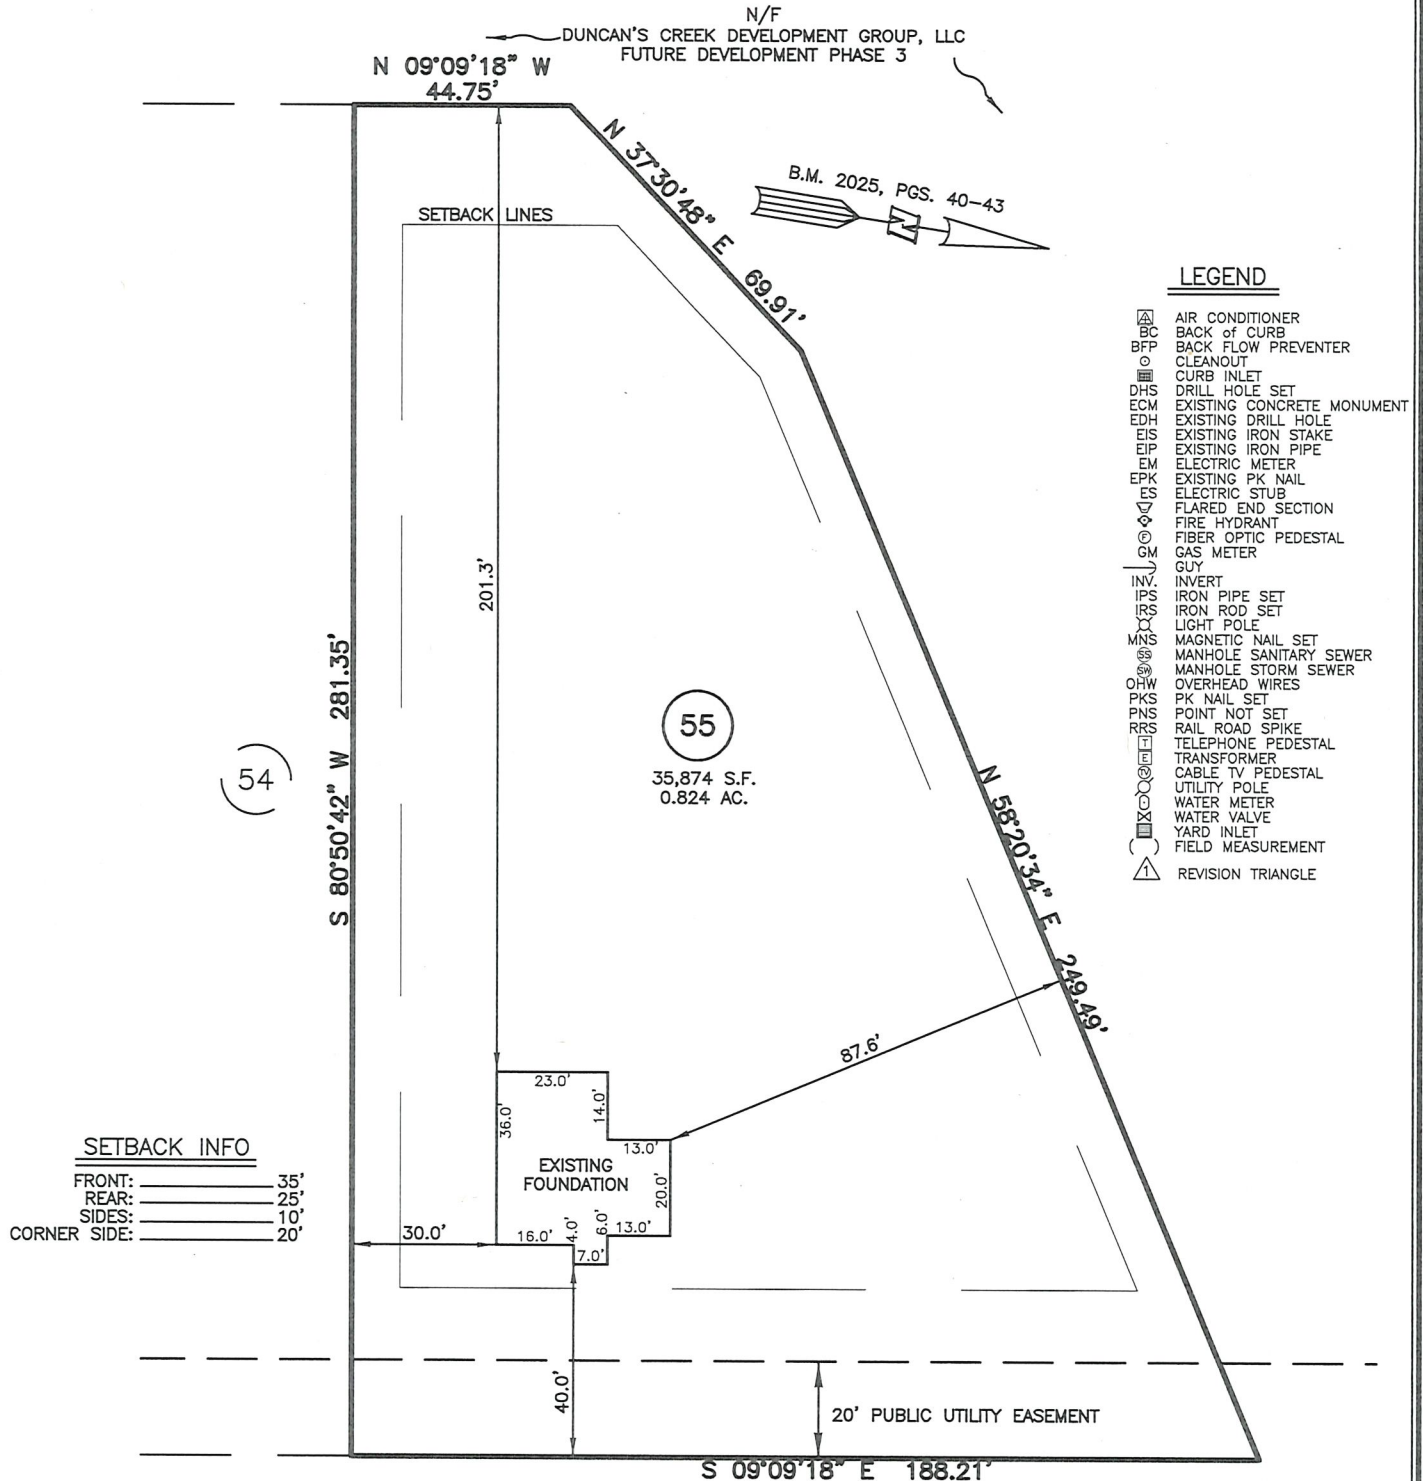

THIS AS-BUILT IS  
FOR CODE COMPLIANCE.  
NOT FOR SALES OR  
CONVEYANCE


BEACON HILL ROAD  
50' PUBLIC R/W

WAKE COUNTY, NORTH CAROLINA

I CERTIFY THAT THIS MAP WAS DRAWN UNDER MY  
SUPERVISION FROM FIELDWORK DONE UNDER  
MY SUPERVISION; THAT THE IMPROVEMENTS LIE  
WHOLLY UPON THE LOT AND THAT THE PROPERTY  
SHOWN IS AN EXISTING PARCEL OR PARCELS OF  
LAND.

CHARLES R. PIRATZKY


L-2813

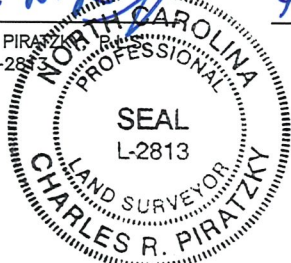

DATE: SEPT. 02, 2025

Q:\FieldLoc\DUNCANCREEK55FDN.txt

REFERENCES:  
B.M. 2025, PGS. 40-43

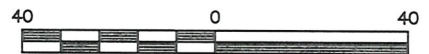

NOTES

SCALE: 1" = 40'

1. THIS SURVEY SUBJECT TO ANY FACTS THAT MAY BE DISCLOSED BY A FULL AND ACCURATE TITLE SEARCH.
2. THIS MAP MAY NOT BE A CERTIFIED SURVEY AND HAS NOT BEEN REVIEWED BY A LOCAL GOVERNMENT AGENCY FOR COMPLIANCE WITH ANY APPLICABLE LAND DEVELOPMENT REGULATIONS AND HAS NOT BEEN REVIEWED FOR COMPLIANCE WITH RECORDING REQUIREMENTS FOR PLATS.

**RWK, PA**  
ENGINEERING ~ SURVEYING  
CORPORATE LICENSE: C-1771  
101 W. MAIN ST., SUITE 202  
GARNER, NC 27529  
PHONE (919) 779-4854  
FAX (919) 779-4056

O:\DUNCAN'S CREEK\DNCK55\DUNCAN CREEK 55.DWG