


AS-BUILT IMPROVEMENTS FOR  
MATTAMY HOMES  
171 SCARLET SAGE DRIVE  
LOT 3, BLOOM SUBDIVISION-NORTH  
HECTORS CREEK TOWNSHIP, HARNETT COUNTY, NORTH CAROLINA

SPENCE MILL ROAD  
60' PUBLIC R/W

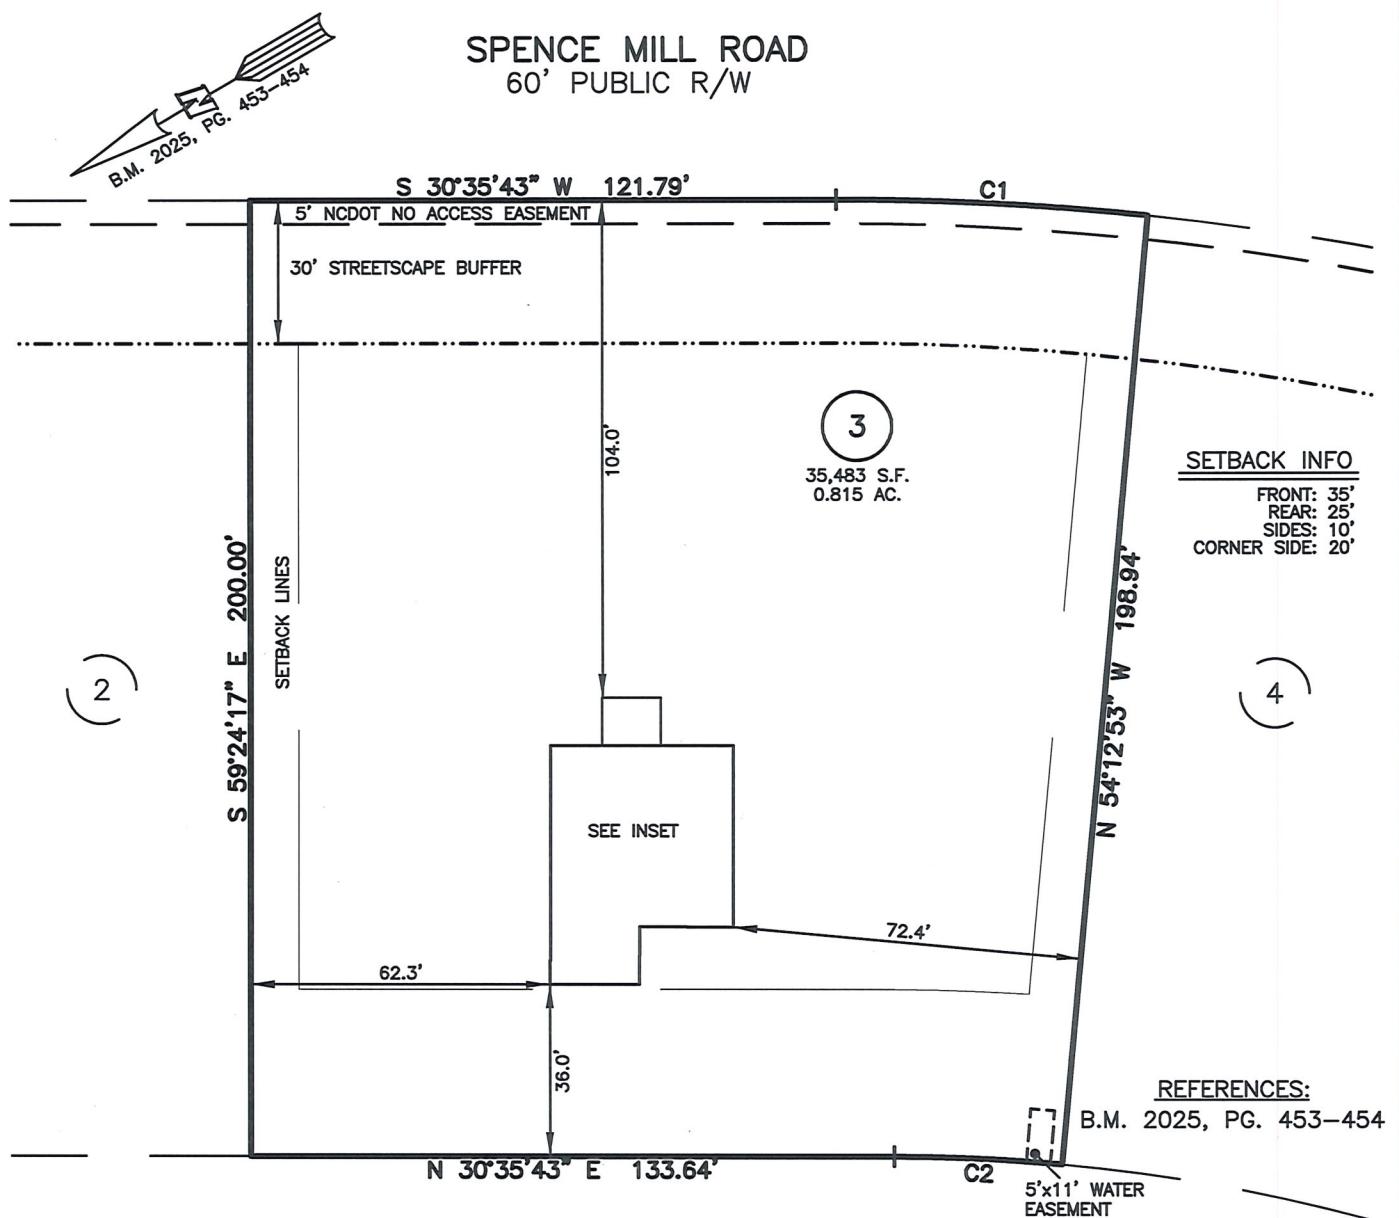

SCARLET SAGE DRIVE  
50' PUBLIC R/W

NUM	RADIUS	ARC	CHORD	CHORD BRG	DELTA
C1	606.62'	64.80'	64.77'	S 33°39'20" W 6°07'14"	
C2	385.20'	34.88'	34.86'	N 33°11'25" E 5°11'18"	

LEGEND


▲	AIR CONDITIONER	INV.	INVERT
BC	BACK OF CURB	IPS	IRON PIPE SET
BFP	BACK FLOW PREVENTER	IRS	IRON ROD SET
○	CLEANOUT	LP	LIGHT POLE
■	CURB INLET	MNS	MAGNETIC NAIL SET
DHS	DRILL HOLE SET	MS	MANHOLE SANITARY SEWER
ECM	EXISTING CONCRETE MONUMENT	MS	MANHOLE STORM SEWER
EDH	EXISTING DRILL HOLE	OHW	OVERHEAD WIRES
EIS	EXISTING IRON STAKE	PKS	PK NAIL SET
EIP	EXISTING IRON PIPE	PNS	POINT NOT SET
EM	ELECTRIC METER	RRS	RAIL ROAD SPIKE
EPK	EXISTING PK NAIL	TP	TELEPHONE PEDESTAL
ES	ELECTRIC STUB	TP	TRANSFORMER
▽	FLARED END SECTION	CT	CABLE TV PEDESTAL
♦	FIRE HYDRANT	UP	UTILITY POLE
○	FIBER OPTIC PEDESTAL	WM	WATER METER
GM	GAS METER	WV	WATER VALVE
GUY	GUY	YI	YARD INLET
		FM	FIELD MEASUREMENT

THIS AS-BUILT IS  
FOR CODE COMPLIANCE.  
NOT FOR SALES OR  
CONVEYANCE

WAKE COUNTY, NORTH CAROLINA

I CERTIFY THAT THIS MAP WAS DRAWN UNDER MY  
SUPERVISION FROM FIELDWORK DONE UNDER  
MY SUPERVISION; THAT THE IMPROVEMENTS LIE  
FULLY UPON THE LOT UNLESS OTHERWISE SHOWN  
AND THAT THE PROPERTY SHOWN IS AN EXISTING  
PARCEL OR PARCELS OF LAND.


10/14/25

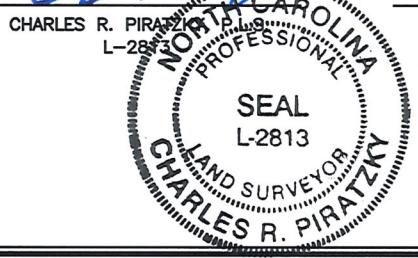

DATE

DATE: OCT. 09, 2025

Q:\FieldLoc\BLOOMFDN2-5 CTRL.txt

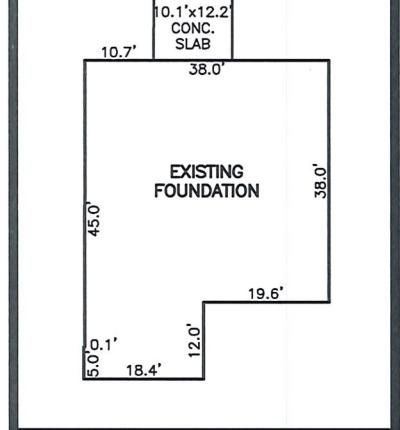

SCALE: 1" = 40'

NOTES

1. THIS SURVEY SUBJECT TO ANY FACTS THAT MAY BE DISCLOSED BY A FULL AND ACCURATE TITLE SEARCH.
2. THIS MAP MAY NOT BE A CERTIFIED SURVEY AND HAS NOT BEEN REVIEWED BY A LOCAL GOVERNMENT AGENCY FOR COMPLIANCE WITH ANY APPLICABLE LAND DEVELOPMENT REGULATIONS AND HAS NOT BEEN REVIEWED FOR COMPLIANCE WITH RECORDING REQUIREMENTS FOR PLATS.

**RWK, PA**  
ENGINEERING ~ SURVEYING  
CORPORATE LICENSE: C-1771  
101 W. MAIN ST., SUITE 202  
GARNER, NC 27529  
PHONE (919) 779-4854  
FAX (919) 779-4056

0:\BLOOM\BLM 03\BLOOM 3.DWG