


AS-BUILT IMPROVEMENTS FOR  
MATTAMY HOMES, LLC.  
467 DENALI DRIVE  
LOT 57, RIVERFALL SUBDIVISION PHASE TWO  
BLACK RIVER TOWNSHIP, HARNETT COUNTY, NORTH CAROLINA

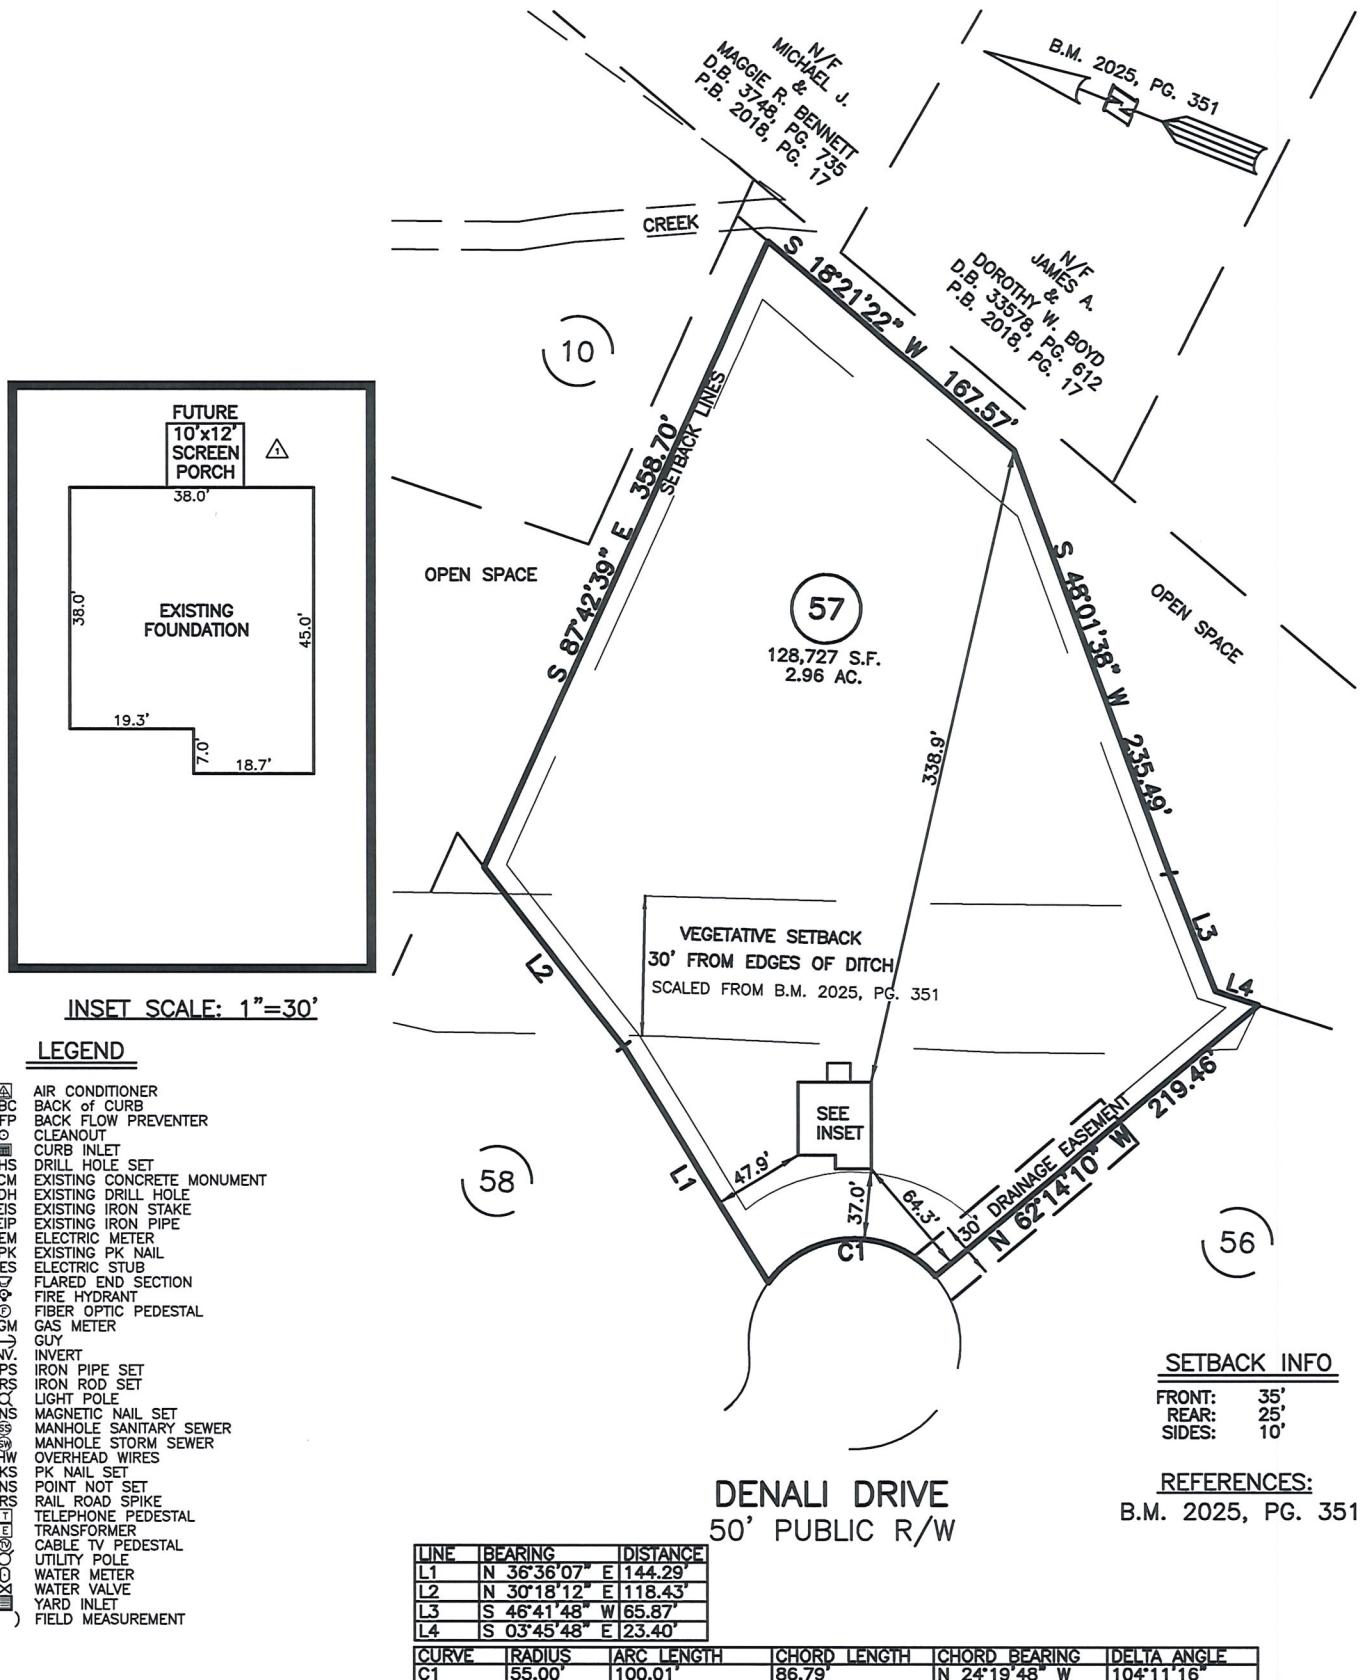

WAKE COUNTY, NORTH CAROLINA

I CERTIFY THAT THIS MAP WAS DRAWN UNDER MY SUPERVISION FROM FIELDWORK DONE UNDER MY SUPERVISION; THAT THE IMPROVEMENTS LIE WHOLLY UPON THE LOT AND THAT THE PROPERTY SHOWN IS AN EXISTING PARCEL OR PARCELS OF LAND.




THIS AS-BUILT IS FOR CODE COMPLIANCE. NOT FOR SALES OR CONVEYANCE

△ ADDED FUTURE SCREEN PORCH

REV1: NOV. 26 2025  
DATE: OCT. 28, 2025

Q:\FieldLoc\RIVERFALL36\_57FDN.txt

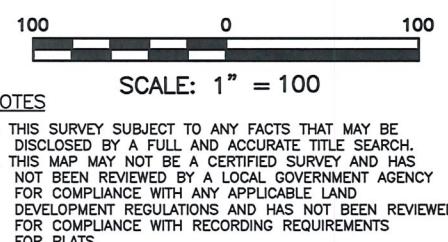

**RWK, PA**  
ENGINEERING ~ SURVEYING  
CORPORATE LICENSE: C-1771  
101 W. MAIN ST., SUITE 202  
GARNER, NC 27529  
PHONE (919) 779-4854  
FAX (919) 779-4056