Tobacco Road Lot 97 CRAWFORD



INCLUDED OPTIONS:

1st FLOOR SUNROOM/SCREENED PORCH/DECK **GOURMET KITCHEN** FIREPLACE W/ BUILT-INS TRAY CEILING @ FAMILY ROOM **BOX OAK STAIRS** FRENCH DOORS @ STUDY TRAY CEILING @ DINING **GUEST SHOWER ILO TUB BENCH @ MUD ROOM** SIDE LOAD W/ 3RD CAR GARAGE

2nd FLOOR TRAY CEILING @ OWNERS **OWNERS DELUXE BATH** SHARED BATH 2 2ND SINK @ BATH 2 LAUNDRY SINK **POCKET OFFICE**

SQUARE FOOTAGE

FIRST FLOOR	1661 SQ. FT.
SECOND FLOOR	1767 SQ. FT.
TOTAL CONDITIONED	3428 SQ. FT.
FRONT PORCH	102 SQ. FT.
GARAGE	453 SQ. FT.
OPTIONS	
SUNROOM	192 SQ. FT.
SCREENED PORCH	120 SQ. FT.
ADDITIONAL PORCH (UNCOVERED)	80 SQ. FT.
THIRD CAR GARAGE	210 SQ. FT.

THE FINISHED SOLIARE FOOTAGE OF A PLAN IS TO BE REPORTED TO THE NEAREST WHOLE FOOT. THE FINISHED SQUARE FOOTAGE CALCULATIONS FOR THIS PLAN WERE MADE BASED ON PLAN DIMENSIONS OR DIGITAL DRAWINGS FILES ONLY, AND MAY VARY FROM THE FINISHED SQUARE FOOTAGE OF THE PLAN AS BUILT

GENERAL NOTES

- NATIONAL, STATE AND LOCAL CODES AND REGULATIONS SHALL BE APPLIED TO ALL WORK BEING PERFORMED
- BUILDER TO VERIFY ALL SITE CONDITIONS. STRUCTURAL OPTIONS AND DIMENSIONS BEFORE START OF CONSTRUCTION DISCREPANCIES SHALL BE REPORTED TO PLAN DESIGNER FOR CORRECTION OR CLARIFICATION BEFORE CONTINUING WORK

GOVERNING CODES & STANDARDS

- 2018 RESIDENTIAL BUILDING CODE WITH GEORGIA 2020 AMENDMENTS
- 2015 INTERNATIONAL ENERGY CONSERVATION CODE WITH GEORGIA 2020 AMENDMENTS 2018 INTERNATIONAL FIRE CODE WITH NO AMENDMENTS
- 2018 INTERNATIONAL FUEL GAS CODE WITH GEORGIA 2020AMENDMENTS
- 2018 INTERNATIONAL MECHANICAL CODE WITH GEORGIA 2020 AMENDMENTS 2018 INTERNATIONAL PLUMBING CODE WITH GEORGIA 2020 AMENDMENTS
- 2020 NATIONAL ELECTRICAL CODE WITH NO GEORGIA AMENDMENTS

DESIGN CRITERIA

ROOF LIVE LOAD: 20PSF FLOOR LIVE LOAD: 40PSF. (INCLUDES DECKS, PATIOS AND PORCHES) BASIC WIND VELOCITY: 90MPH SEISMIC DESIGN CATEGORY: B

S.O SH


DAVIDSON HOMES, LLC
3460 PRESTON RIDGE ROAD, SUITE 525
ALPHARETTA, GEORGIA 30005
© 2024 ALL RIGHTS RESERVED. CONFIDENTIAL
AND PROPRIETARY. DO NOT REPRODUCE OR
DISCLOSE. THIS AN UNPUBLISHED WORK AND

CRAWFORD A-D

ZACHARY.MYRIC SION DATE 2024-09-2

COVER SHEET

A-CS.2

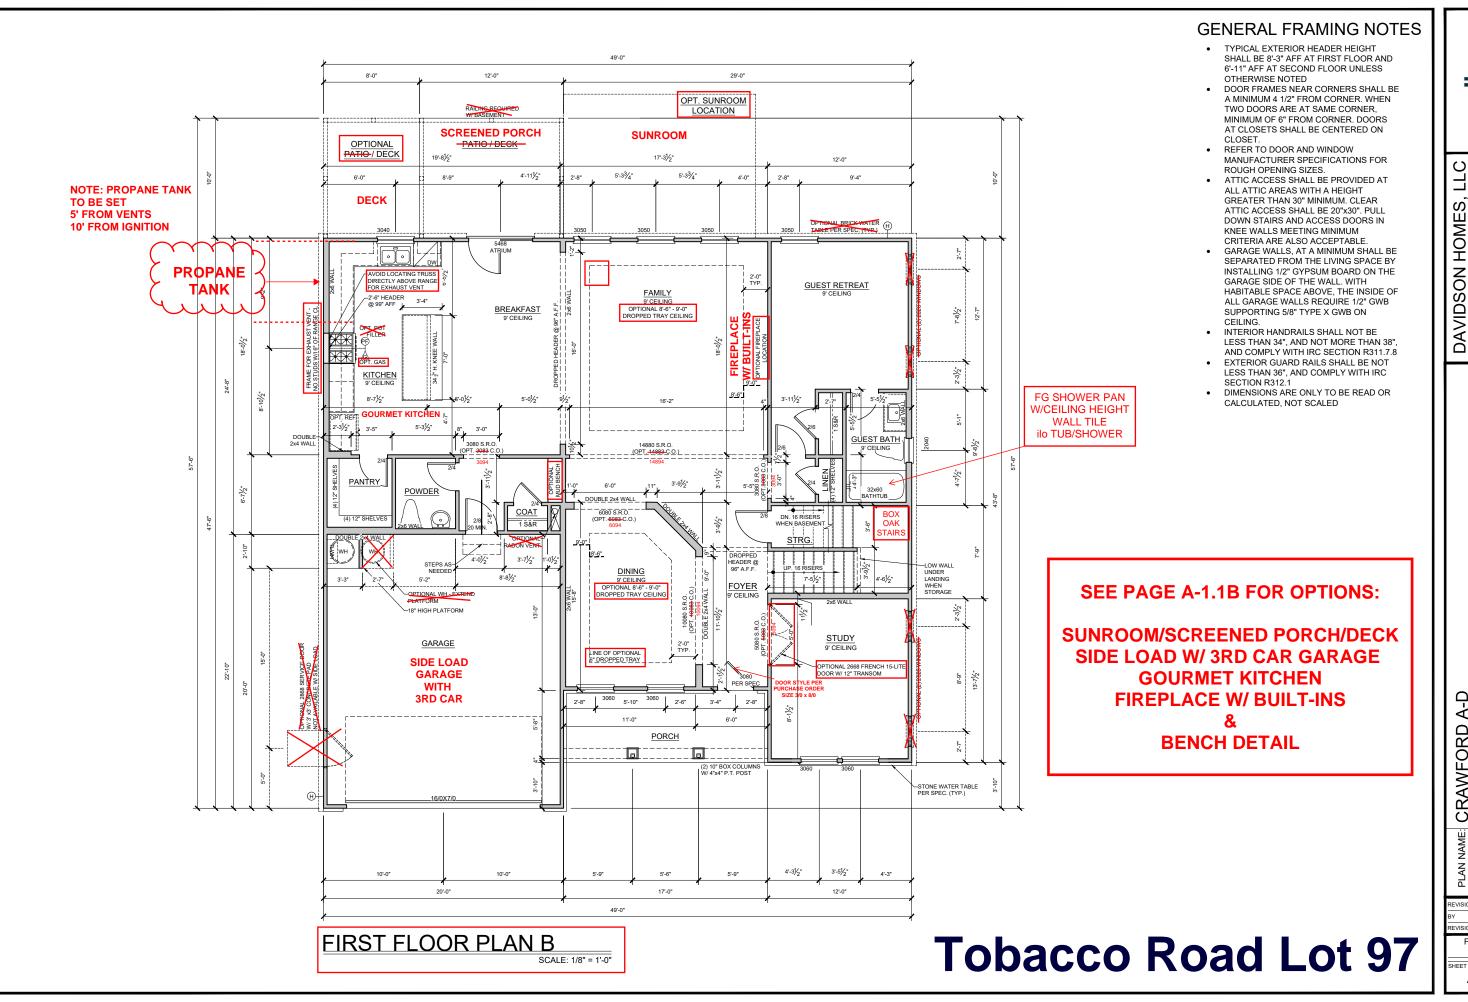

S_s -SH **4**5≥

DAVIDSON HOMES, LLC 3460 PRESTON RIDGE ROAD, SUITE 525 ALPHARETTA, GEORGIA 30005 © 2024 ALL RIGHTS RESERVED. CONFIDENTIAL AND PROPRIETARY. DO NOT REPRODUCE OR DISCLOSE. THIS IS AN UNPUBLISHED WORK AND IS CONSIDERED A TRADE SECRET.

CRAWFORD A-D

SUBDIVISION

ZACHARY.MYRIC


VISION DATE 2024-09-2 FIRST FLOOR

A-1.0B

HEADER PER-


10'-0"


GARAGE

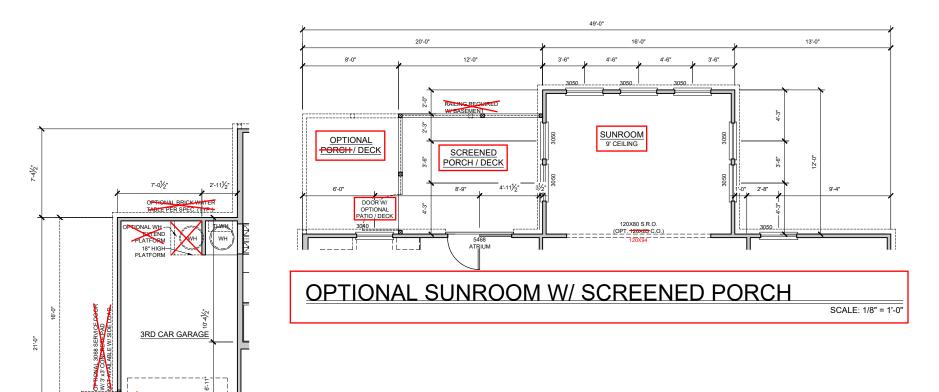


GENERAL FRAMING NOTES

- TYPICAL EXTERIOR HEADER HEIGHT SHALL BE 8'-3" AFF AT FIRST FLOOR AND 6'-11" AFF AT SECOND FLOOR UNLESS OTHERWISE NOTED
- DOOR FRAMES NEAR CORNERS SHALL BE A MINIMUM 4 1/2" FROM CORNER. WHEN TWO DOORS ARE AT SAME CORNER. MINIMUM OF 6" FROM CORNER, DOORS AT CLOSETS SHALL BE CENTERED ON CLOSET.
- REFER TO DOOR AND WINDOW MANUFACTURER SPECIFICATIONS FOR ROUGH OPENING SIZES.
- ATTIC ACCESS SHALL BE PROVIDED AT ALL ATTIC AREAS WITH A HEIGHT GREATER THAN 30" MINIMUM. CLEAR ATTIC ACCESS SHALL BE 20"x30". PULL DOWN STAIRS AND ACCESS DOORS IN KNEE WALLS MEETING MINIMUM CRITERIA ARE ALSO ACCEPTABLE.
- GARAGE WALLS, AT A MINIMUM SHALL BE SEPARATED FROM THE LIVING SPACE BY INSTALLING 1/2" GYPSUM BOARD ON THE GARAGE SIDE OF THE WALL. WITH HABITABLE SPACE ABOVE, THE INSIDE OF ALL GARAGE WALLS REQUIRE 1/2" GWB SUPPORTING 5/8" TYPE X GWB ON
- INTERIOR HANDRAILS SHALL NOT BE LESS THAN 34", AND NOT MORE THAN 38", AND COMPLY WITH IRC SECTION R311.7.8
- EXTERIOR GUARD RAILS SHALL BE NOT LESS THAN 36", AND COMPLY WITH IRC SECTION R312.1
- DIMENSIONS ARE ONLY TO BE READ OR CALCULATED, NOT SCALED

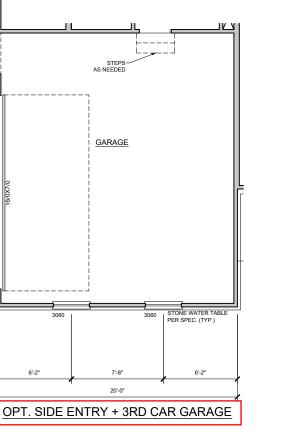

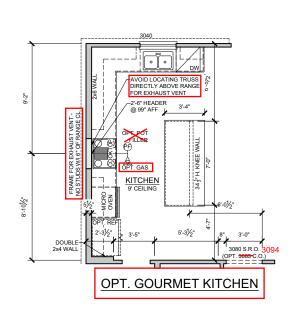

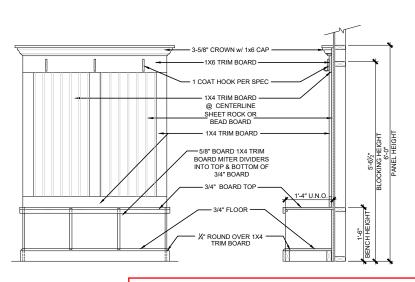

OPT.

FIREPLACE

OPTIONAL MUD BENCH

SCALE: 3/8" = 1'-0"

FIRST FLOOR PLAN **OPTIONS**

SCALE: 1/8" = 1'-0"

Os SI


DAVIDSON HOMES, LLC
3460 PRESTON RIDGE ROAD, SUITE 525
ALPHARETTA, GEORGIA 30005
© 2024 ALL RIGHTS RESERVED. CONFIDENTIAL
AND PROPRIETARY. DO NOT REPRODUCE OR
DISCLOSE. THIS IS AN UNPUBLISHED WORK AND
IS CONSIDERED A TRADE SECRET.


CRAWFORD A-D PLAN NAME:

ZACHARY.MYRIC


ISION DATE 2024-09-2 FIRST FLOOR

OPTIONS - GARAGE A-1.1B

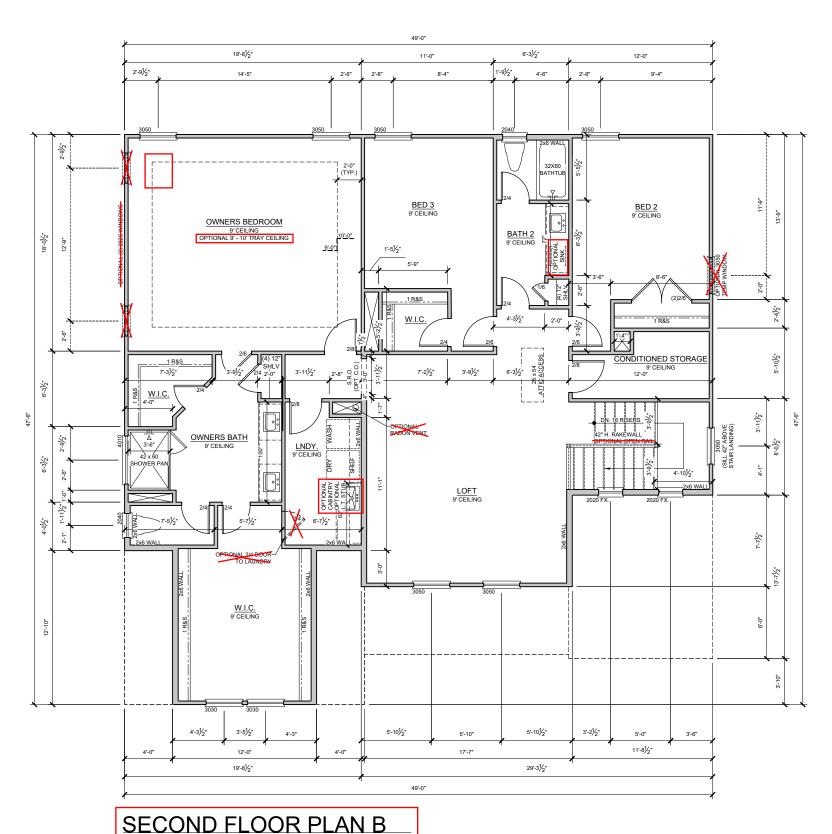

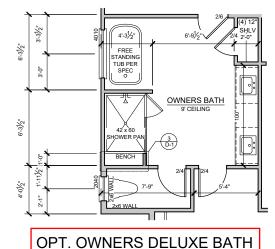



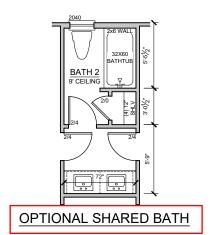

GENERAL FRAMING NOTES

- TYPICAL EXTERIOR HEADER HEIGHT SHALL BE 8'-3" AFF AT FIRST FLOOR AND 8'-3" AFF AT SECOND FLOOR UNLESS OTHERWISE NOTED
- DOOR FRAMES NEAR CORNERS SHALL BE A MINIMUM 4 1/2" FROM CORNER. WHEN TWO DOORS ARE AT SAME CORNER, MINIMUM OF 6" FROM CORNER. DOORS AT CLOSETS SHALL BE CENTERED ON CLOSET.
- REFER TO DOOR AND WINDOW
 MANUFACTURER SPECIFICATIONS FOR
 ROUGH OPENING SIZES.
- ATTIC ACCESS SHALL BE PROVIDED AT ALL ATTIC AREAS WITH A HEIGHT GREATER THAN 30" MINIMUM. CLEAR ATTIC ACCESS SHALL BE 20"x30". PULL DOWN STAIRS AND ACCESS DOORS IN KNEE WALLS MEETING MINIMUM CRITERIA ARE ALSO ACCEPTABLE.
- GARAGE WALLS, AT A MINIMUM SHALL BE SEPARATED FROM THE LIVING SPACE BY INSTALLING 1/2" GYPSUM BOARD ON THE GARAGE SIDE OF THE WALL. WITH HABITABLE SPACE ABOVE, THE INSIDE OF ALL GARAGE WALLS REQUIRE 1/2" GWB SUPPORTING 5/8" TYPE X GWB ON CEILING.
- INTERIOR HANDRAILS SHALL NOT BE LESS THAN 34", AND NOT MORE THAN 38", AND COMPLY WITH IRC SECTION R311.7.8
- EXTERIOR GUARD RAILS SHALL BE NOT LESS THAN 36", AND COMPLY WITH IRC SECTION R312.1
 DIMENSIONS ARE ONLY TO BE READ OR
- DIMENSIONS ARE ONLY TO BE READ OF CALCULATED, NOT SCALED

AVIDSON HOMES.

DAVIDSON HOMES, LLC
3460 PRESTON RIDGE ROAD, SUITE 525
ALPHARETTA, GEORGIA 30005
© 2024 ALL RIGHTS RESERVED. CONFIDENTIAL
AND PROPRIETARY. DO NOT REPRODUCE OR
DISCLOSE. THIS IS AN UNPUBLISHED WORK AND
IS CONSIDERED A TRADE SECRET.

CRAWFORD A-D


PLAN NAME: SUBDIVISION:


REVISION NO. 10

BY ZACHARY.MYRICK
REVISION DATE 2024-09-20

OPTIONAL SECOND FLOOR PLAN 9' PLT H

A-2.1B

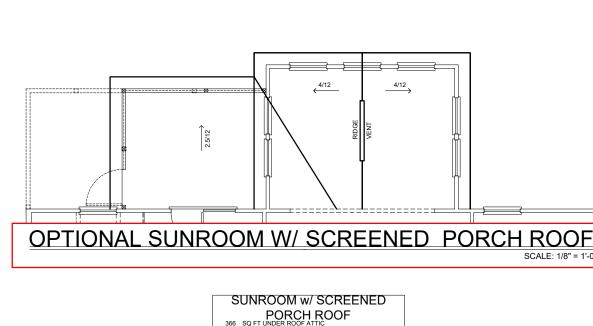

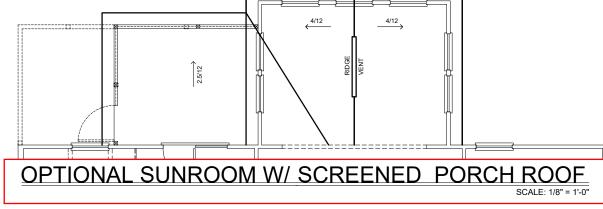

PORCH ROOF 366 SQ FT UNDER ROOF ATTIC 300 SQ FT / 1 SQ FT = 1.22 SQ FT VENTILATION

RIDGE VENTS 18 SQ IN = (.125 SQ FT) VENTED SOFFIT 9 SQ IN = (.0625 SQ FT) BOX VENTS 50 SQ IN = (.347 SQ FT) INTAKE VENTS 36 SQ IN = (.25 SQ FT)

60 FEET 64 FEET -19.1 COUNT -13.6 COUNT (NEGATIVE = 0)

ROOF PLAN B

MAIN ROOF

9/12

9/12

2415 SQ FT UNDER ROOF ATTIC 300 SQ FT / 1 SQ FT = 8.05 SQ FT VENTILATION

RIDGE VENTS 18 SQ IN = (.125 SQ FT) VENTED SOFFIT 9 SQ IN = (.0625 SQ FT) BOX VENTS 50 SQ IN = (.347 SQ FT) INTAKE VENTS 36 SQ IN = (.25 SQ FT)

SCALE: 1/8" = 1'-0"

8.05 SQ FT x 50% 4.025 SQ FT OF RIDGE 8.05 SQ FT x 50% 4.025 SQ FT OF SOFFIT

4.025 SQ FT = 64.4 FEET OF VENTED SOFFIT 0.0625 SQ FT

RIDGE VENT PROVIDED VENTED SOFFIT PROVIDED # BOX VENTS @ RIDGE # INTAKE VENTS @ SOFFIT

CRAWFORD A-D


AVIDSON HOMES.


DAVIDSON HOMES, LLC 3460 PRESTON RIDGE ROAD, SUITE 525 ALPHARETTA, GEORGÍA 30005 © 2024 ALL RIGHTS RESERVED. CONFIDENTIAL AND PROPRIETARY. DO NOT REPRODUCE OR DISCLOSE. THIS IS AN UNPUBLISHED WORK AND IS CONSIDERED A TRADE SECRET.

ISION DATE 2024-09-20

ROOF PLAN B

A-4.0B

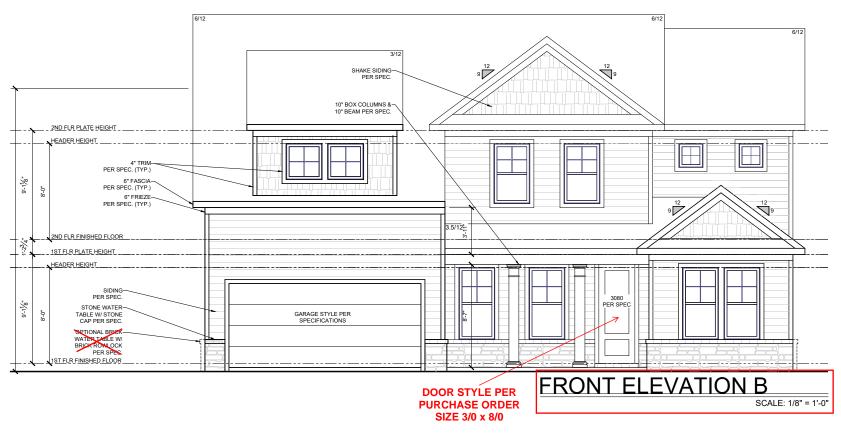

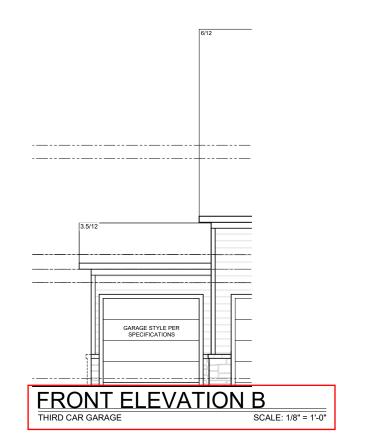



GENERAL ELEVATION NOTES

- FASCIA, FRIEZE, RAKE, AND SKIRT BOARDS TO BE 1X UNLESS OTHERWISE NOTED
- ALL OTHER TRIM TO BE 5/4 UNLESS OTHERWISE NOTED
- LAP SIDING REVEALS PER SPEC., UNLESS OTHERWISE NOTED
- ROOF COVERING TO BE SHINGLES PER SPEC., UNLESS OTHERWISE NOTED

CS AND DAVIDSON HOMES.

DAVIDSON HOMES, LLC 3460 PRESTON RIDGE ROAD, SUITE 525 ALPHARETTA, GEORGIA 30005 © 2024 ALL RIGHTS RESERVED. CONFIDENTIAL AND PROPRIETARY. DO NOT REPRODUCE OR DISCLOSE. THIS IS AN UNPUBLISHED WORK AND IS CONSIDERED A TRADE SERRET


CRAWFORD A-D


PLAN NAME: SUBDIVISION:


REVISION NO. 10
BY ZACHARY.MYRICK
REVISION DATE 2024-09-20
FRONT ELEVATION B

OPT. 9' 2ND FLOOR
SHEET NO.

A-5.4B

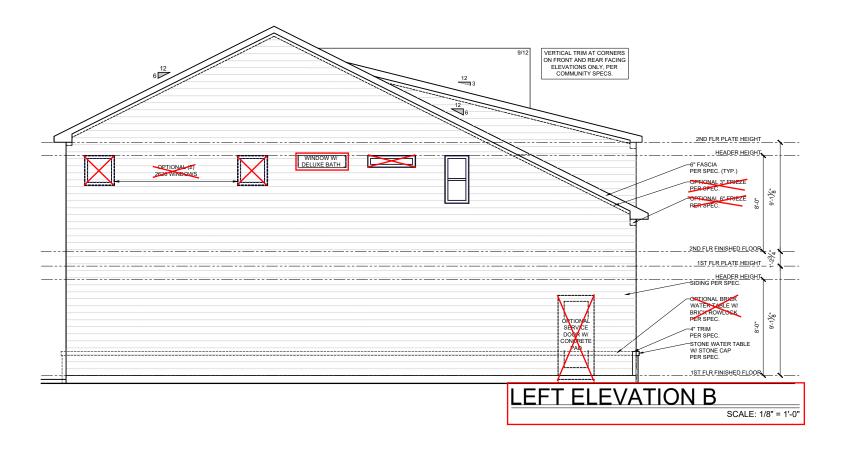

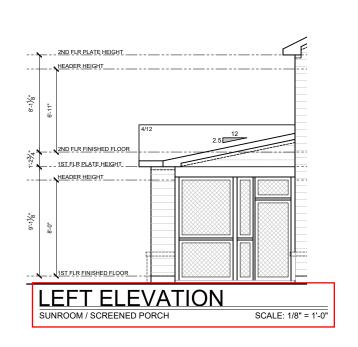

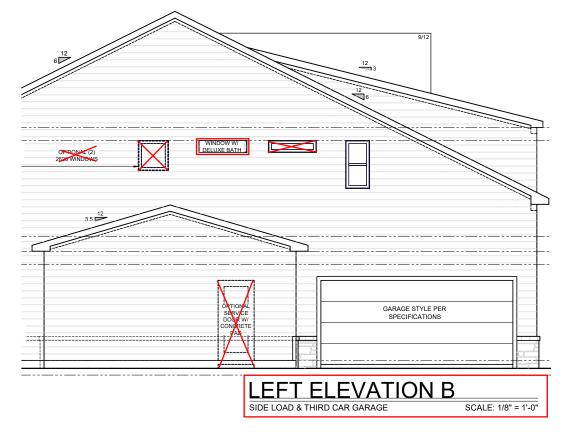

GENERAL ELEVATION NOTES

- FASCIA, FRIEZE, RAKE, AND SKIRT BOARDS TO BE 1X UNLESS OTHERWISE
- ALL OTHER TRIM TO BE 5/4 UNLESS OTHERWISE NOTED LAP SIDING REVEALS PER SPEC., UNLESS
- OTHERWISE NOTED
- ROOF COVERING TO BE SHINGLES PER


VIDSON HOMES.

PLAN NAME: CRAWFORD A-D

EVISION DATE 2024-09-20

LEFT ELEVATION B OPT. 9' 2ND FLOOR

A-5.5B

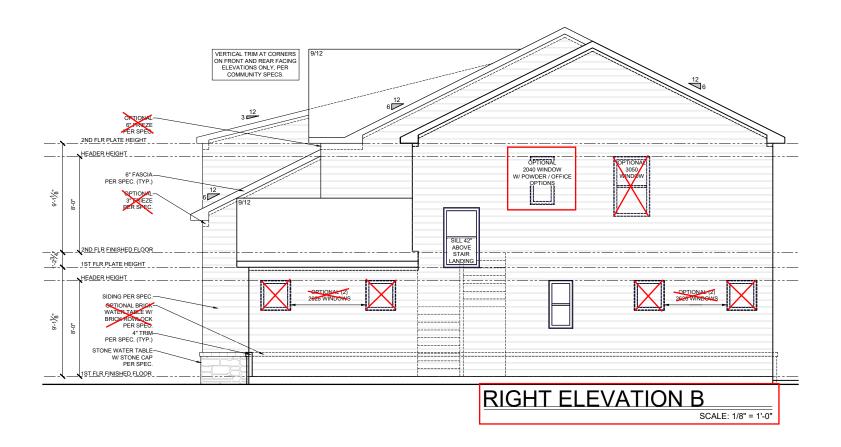



GENERAL ELEVATION NOTES

- FASCIA, FRIEZE, RAKE, AND SKIRT BOARDS TO BE 1X UNLESS OTHERWISE NOTED
- ALL OTHER TRIM TO BE 5/4 UNLESS OTHERWISE NOTED
- LAP SIDING REVEALS PER SPEC., UNLESS OTHERWISE NOTED
- ROOF COVERING TO BE SHINGLES PER SPEC., UNLESS OTHERWISE NOTED

CRAWFORD A-D

EVISION DATE 2024-09-20


RIGHT ELEVATION B


OPT. 9' 2ND FLOOR

A-5.6B

AVIDSON HOMES.



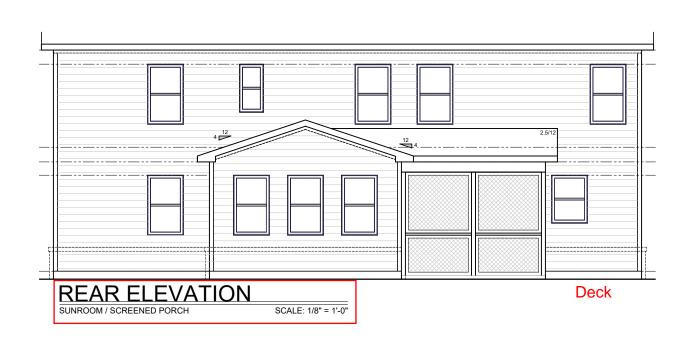

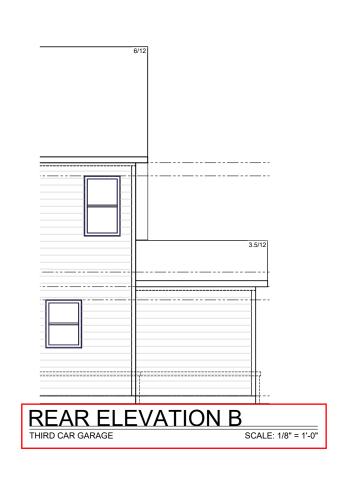

GENERAL ELEVATION NOTES

- FASCIA, FRIEZE, RAKE, AND SKIRT BOARDS TO BE 1X UNLESS OTHERWISE NOTED.
- ALL OTHER TRIM TO BE 5/4 UNLESS OTHERWISE NOTED
- LAP SIDING REVEALS PER SPEC., UNLESS OTHERWISE NOTED
- ROOF COVERING TO BE SHINGLES PER SPEC., UNLESS OTHERWISE NOTED

DAVIDSON HOMES.

GE ROAD, SUITE 525
GEORGIA 30005
SERVED. CONFIDENTIAL


DAVIDSON
3460 PRESTON RI
ALPHARETTA
© 2024 ALL RIGHTS R
AND PROPRIETARY.
DISCLOSE, THIS IS AN

PLAN NAME: CRAWFORD A-D
UBDIVISION: ----

REVISION NO.
BY ZACHARY.MYRI

BY ZACHARY.MYRICK
REVISION DATE 2024-09-20
REAR ELEVATION B

OPT. 9' 2ND FLOOR
SHEET NO.
A-5.7B

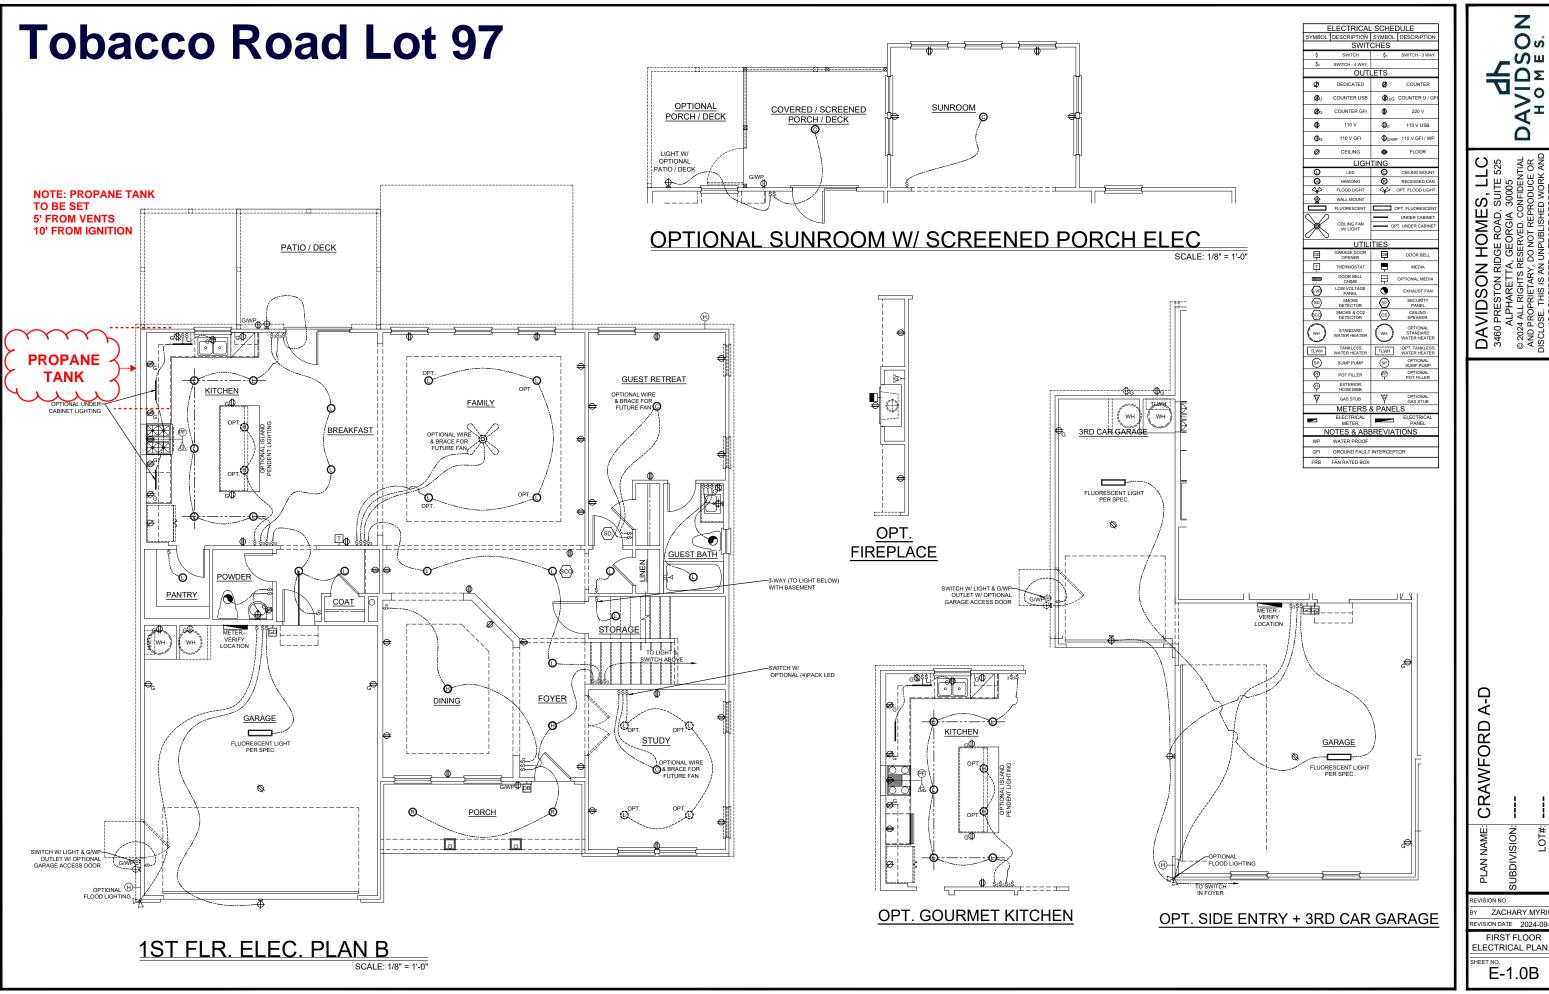



Os

ZACHARY.MYRIC ISION DATE 2024-09-2


FIRST FLOOR **ELECTRICAL PLAN E**

E-1.0B

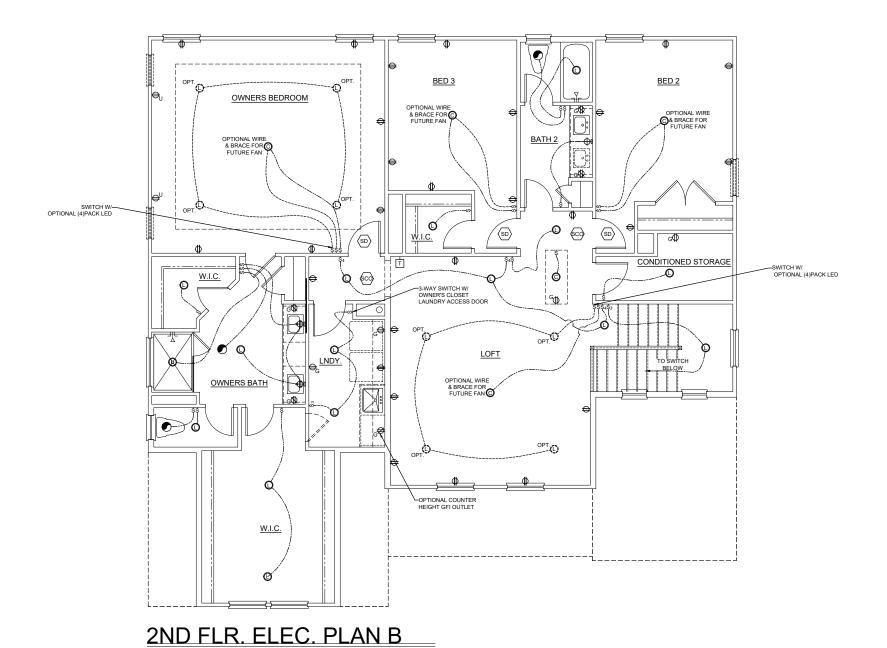


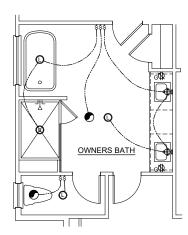

OPT. OWNERS DELUXE BATH

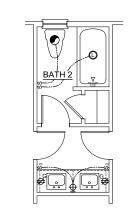

OPTIONAL SHARED BATH

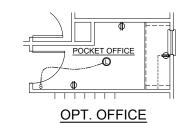

DESCRIPTION SWITCH	SYMBOL CHES	DESCRIPTION
	CHES	
SIMITCH		
SWITCH	\$3	SWITCH - 3 WAY
SWITCH - 4 WAY		
OUT	LETS	
DEDICATED	Ø≯	COUNTER
COUNTER USB	₩urg	COUNTER U / G
COUNTER GFI	Φ	220 V
110 V	Ф	110 V USB
110 V GFI	Фсли	P 110 V GFI / WP
CEILING	•	FLOOR
LIGH	TING	
LED	0	CEILING MOUNT
HANGING	®	RECESSED CAN
FLOOD LIGHT	4	OPT. FLOOD LIGHT
WALL MOUNT		
FLUORESCENT		OPT. FLUORESCEN
	_	UNDER CABINET
CEILING FAN	01	PT. UNDER CABINE
UTIL	ITIES	
GARAGE DOOR OPENER	DB	DOOR BELL
THERMOSTAT	₽	MEDIA
DOOR BELL CHIME	目	OPTIONAL MEDIA
PANEL	•	EXHAUST FAN
	(SP)	SECURITY PANEL
SMOKE & CO2 DETECTOR	(cs)	CEILING SPEAKER
STANDARD WATER HEATER	WH	OPTIONAL STANDARD WATER HEATER
TANKLESS WATER HEATER	TLWH	OPT. TANKLESS WATER HEATER
SUMP PUMP	(SP)	OPTIONAL SUMP PUMP
POT FILLER	ø	OPTIONAL POT FILLER
HOSE BIBB		OPTIONAL
		GAS STUB
	& PANE	
ELECTRICAL METER	_	ELECTRICAL PANEL
NOTES & ABBREVIATIONS		
WP WATER PROOF		
GFI GROUND FAULT INTERCEPTOR		
FAN RATED BOX		
	DEDICATED COUNTER USB COUNTER GFI 110 V 110 V GFI CEILING LIGH HANGING FLOOD LIGHT WALL MOUNTER FLOOD LIGHT WALL MOUNTER FLOOD LIGHT WALL MOUNTER COPENER CEILING FAN WILIGHT UTIL GARAGE BOOR OPENER THERMOSTE THERMOSTE PANEL SANCIE	COUNTER USB \$\frac{\partial Decomposed Counter GFI}{110 \ V \ GFI}\$ 110 \ V \ GFI \ \ \ \ \ \ \ \ \ \ \ \ \ \ \ \ \ \ \



TON RIDGE ROAD, SUITE & ARETTA, GEORGIA 30005
IGHTS RESERVED. CONFIDEN. TEARY. DO NOT REPRODUCE IS IS AN INDIRI INDIRI IS IS AN INDIRI IS IS AN INDIRI INDIRI IS IS AN INDIRI INDIRI IS IS AN INDIRI INDIRI IS IS AND INDIRI INDI

AEI CRAWFORD A-D

SION NO.

ZACHARY.MYR

REVISION DATE 2024-09-20 SECOND FLOOR ELECTRICAL PLAN B

E-2.0B

CONNECTION SPECIFICATIONS (TYP. U.N.O.)

DESCRIPTION OF BLDG. ELEMENT	3"x0.l31" NAILS	3"x0.120" NAILS		
JOIST TO SOLE PLATE SOLE PL. TO JOIST/RIM OR BLK'G	(3) TOENAILS NAILS @ 4" o.c.	(3) TOENAILS* NAILS @ 4" o.c.		
STUD TO PLATE	(4) TOENAILS/ (3)END NAILS	(4) TOENAILS/ (4)END NAILS*		
RIM TO TOP PLATE	TOENAILS @ 6" o.c.	TOENAILS @ 4" o.c.*		
BLK'G. BTWN. JOISTS TO TOP PL.	(3) TOENAILS EA. END	(3) TOENAILS EA. END*		
DOUBLE STUD	NAILS @ 16" o.c.	NAILS @ 16" o.c.		
DOUBLE TOP PLATE	NAILS @ 12" o.c.	NAILS @ 8" o.c.		
DOUBLE TOP PLATE LAP SPLICE	(12) NAILS IN LAPPED AREA (24" MIN.)	(15) NAILS IN LAPPED AREA (24" MIN.)		
TOP PLATE LAP @ CORNERS & INTERSECTING WALLS	(3) NAILS	(3) NAILS		
SOLE PLATE TO LADDER TRUSS OR CONT. RIBBON	NAILS @ 6" o.c.	NAILS @ 4" o.c.		
LADDER TRUSS BOTTOM CHORD TO TOP PLATE OR SILL PLATE (PARALLEL)	NAILS @ 6" o.c.	NAILS @ 4" o.c.		
BOTTOM CHORD OF EA. TRUSS TO TOP PLATE OR SILL PLATE (PERPENDICULAR)	(3) TOENAILS	(3) TOENAILS*		
RAFTER/TRUSS TO TOP PLATE	(3) TOENAILS + (1) SIMPSON H2.5T	(3) TOENAILS + (1) SIMPSON H2.5T		
GAB. END TRUSS TO DBL. TOP PL.	TOENAILS @ 8" o.c.	TOENAILS @ 6" o.c.		
R.T. w/ HEEL HT. 9 4 TO 12"	2xIO BLK EVERY 3RD BAY FASTENED TO DBL. TOP PLATE w/ TOENAILS @ 6" O.C.	2xIO BLK EVERY 3RD BAY FASTENED TO DBL. TOP PLATE w/ TOENAILS @ 4" O.C.		
R.T. w/ HEEL HT. 12" TO 16"	2xI2 BLK EVERY 3RD BAY FASTENED TO DBL. TOP PLATE w/ TOENAILS @ 6" O.C.	2xI2 BLK EVERY 3RD BAY FASTENED TO DBL. TOP PLATE w/ TOENAILS @ 4" O.C.		
R.T. w/ HEEL HT. UP TO 24"	LAP WALL SHTG. W/ DBL. TOP PL. & INSTALL ON TRUSS VERT FASTEN W/ NAILS @ 6" O.C.	LAP WALL SHTG. w/ DBL. TOP PL. & INSTALL ON TRUSS VERT FASTEN w/ NAILS @ 6" O.C.*		
R.T. w/ HEEL HT. 24" TO 48"	LAP WALL SHTG. W/ DBL. TOP PL. & INSTALL ON TRUSS VERT FASTEN W/ NAILS @ 6" O.C. PROVIDE 2x BLK @ EA. BAY AT TOP OF HEEL	LAP WALL SHTG. W/ DBL. TOP PL. & INSTALL ON TRUSS VERT FASTEN W/ NAILS @ 6" O.C. PROVIDE 2x BLK @ EA. BAY AT TOP OF HEEL*		
WALL TO FOUNDATION	WALL SHTG. LAP W/ SILL PL. & FASTENED PER SHEAR WALL FASTENING SPEC.			
* 3/1.012 IC AN ACCEPTABLE ALTERNATIVE TO A 21.01201 CAME CRACING OR NUMBER OF MALIC				

* 2½"x0.113 IS AN ACCEPTABLE ALTERNATIVE TO A 3"x0.120", SAME SPACING OR NUMBER OF NAILS. (ONLY ACCEPTABLE WHERE * ARE SHOWN)

ADDITIONAL NOTES FOR TRUSS \$ I-JOIST MANUFACTURER

ROOF TRUSS, FLOOR TRUSS AND ENGINEERED JOISTS SHALL BE DESIGNED TO MEET THE DEFLECTION CRITERIA BELOW, UNLESS NOTED OTHERWISE ON PLAN. MULHERN & KULP CANNOT BE HELD RESPONSIBLE FOR ANY STRUCTURAL ISSUES RELATED TO ANY BUILDING COMPONENT IF COMPONENT SHOP DRAWINGS ARE NOT SUBMITTED TO M&K FOR REVIEW PRIOR TO FABRICATION, DELIVERY, OR INSTALLATION.

TRUSSES/JOISTS SHALL BE DESIGNED SO THAT DIFFERENTIAL DEFLECTION BETWEEN ADJACENT PARALLEL TRUSSES/JOISTS OR GIRDER TRUSSES/FLUSH BEAMS DO NOT EXCEED THE FOLLOWING:

- A. ROOF TRUSSES: 1/4" DEAD LOAD
- B. FLOOR TRUSSES, ATTIC TRUSSES, & I-JOISTS: 1/8" DEAD LOAD

ABSOLUTE DEAD LOAD DEFECTION OF FLOOR TRUSSES/ATTIC TRUSSES WHEN ADJACENT TO FLOOR FRAMING BY OTHERS SHALL BE LIMITED TO 3/16". (NOT DIFFERENTIAL DEFLECTION)

VENEER LINTEL SCHEDULE

SPAN (MAX)	HEIGHT OF VENEER ABOVE LINTEL	STEEL ANGLE SIZE
3'-0"	20 FT. MAX	L3"x3"x/4"
	3 FT. MAX	L3"x3"x1/4"
6'-0"	I2 FT. MAX	L4"x3"x1/4"
	20 FT. MAX	L5"x3½"x5%"
8'-0"	3 FT. MAX	L4"x4"x/4" *
	I2 FT. MAX	L5"x3½"x5%"
	I6 FT. MAX	L6"x3½"x¾"
9'-6"	I2 FT. MAX	L6"x3½"x5%"
16'-0"	2 FT. MAX	L7"x4"x½" **
	3 FT. MAX	L8"×4"×1⁄2" **

- SHALL SUPPORT 2 %" - 3½" VENEER w/ 40 psf MAXIMUM WEIGHT. < 16' SHALL HAVE 4" MIN. BEARING

= 16' SHALL HAVE 8" MIN. BEARING

< 16' SHALL NOT BE FASTENED BACK TO HEADER. = 16' SHALL BE FASTENED BACK TO WOOD HEADER IN WALL @48"o.c. w/ ½" DIA. x 3 ½" LONG LAG SCREWS IN 2" LONG VERTICALLY SLOTTED HOLES MAX. VENEER HT. APPLIES TO ANY PORTION OF BRICK OVER THE OPENING.

ALL LINTELS SHALL BE LONG LEG VERTICAL. - WHEN SUPPORTING VENEER < 3" WIDE THE EXTERIOR TOE OF THE HORIZONTAL LEG MAY BE CUT IN THE FIELD TO BE 3 1/4" WIDE OVER THE BEARING LENGTH ONLY. THIS - SEE STRUCTURAL PLANS FOR ANY LINTEL CONDITION NOT ENCOMPASSED BY THE ABOVE PARAMETERS.

* FOR QUEEN VENEER USE I 4x3x1/4" ** FOR 3½" VENEER ONLY. SEE PLAN FOR VENEER SUPPORT IF VENEER < 3½" THICK.

M&K STND. - MAY 2016

LATERAL/WALL BRACING & WALL SHEATHING SPECIFICATIONS

THIS MODEL HAS BEEN DESIGNED TO RESIST LATERAL FORCES RESULTING FROM: 120 MPH WIND IN 2018 NCSBC

(120 MPH WIND SPEED IN ASCE 7 WIND MAP, PER IRC R301.2.1.1) EXP. B. RISK CAT. 2 & SEISMIC CAT. A/B.

THE DESIGN WAS COMPLETED PER 2015 IBC SECTION 1609) & ASCE 7, AS PERMITTED BY R301.1 OF THE 2018 NCSBC:RC. ACCORDINGLY, THIS MODEL, AS DOCUMENTED AND DETAILED HEREWITHIN, IS ADEQUATE TO RESIST THE CODE REQUIRED LATERAL FORCES.

DESIGN WIND UPLIFT LOADS HAVE BEEN CALCULATED UTILIZING ASCE 7 (ACCEPTED ENGINEERING PRACTICE) AS ALLOWED PER 2018 NCSBC:RC SECTION R802.II.I.I. THIS MODEL HAS BEEN DETAILED WHERE REQUIRED & ENGINEERED I RESIST THE WIND UPLIFT LOAD PATH PER SECTIONS R602.3.5 R802.II.

EXT. WALL SHEATHING SPECIFICATION

• 7/16" OSB OR 15/32" PLYWOOD:

FASTEN SHEATHING W/ $2\frac{3}{8}$ " x 0.113" NAILS @ 6" O.C. AT EDGES & @ 12" O.C. IN PANEL FIELD. (TYP, U.N.O.)

• HORIZONTAL BLOCKING OF EXT. WALL/SHEAR WALL PANEL EDGES IS NOT REQUIRED BY THIS DESIGN EXCEPT FOR THOSE AREAS SPECIFICALLY NOTED.

• ALL EXT. WALLS SHALL BE CONTINUOUSLY SHEATHED AND ARE CONSIDERED SHEAR WALLS.

 ALT. STAPLE CONNECTION SPEC: 1 3/4" 16 GA STAPLES (1/6" CROMN) @ 3" O.C. AT EDGES & @ 6" O.C IN FIELD.

BLOCKED PANEL EDGES

• AT DESIGNATED AREAS - FASTEN SHEATHING W/ $2\frac{3}{8}$ " x 0.113" NAILS @ 6" O.C. AT ALL PANEL EDGES AND 12" O.C. IN THE PANEL FIELD OR 13/4" 16 GA STAPLES (1/4" CROWN) @ 3" O.C. AT EDGES & @ 6" O.C IN FIELD. ALL SHEATHING PANELS SHALL BE ORIENTED VERTICALLY (LONG DIRECTION PARALLEL TO STUDS) AND INSTALLED FULL HEIGHT OF SHEAR WALL - OR - 2x HORIZONTAL BLOCKING SHALL BE PROVIDED TO SUPPORT ALL UNSUPPORTED PANEL EDGES & EDGE FASTENING.

3" O.C. EDGE NAILING

• AT DESIGNATED AREAS - FASTEN PANEL EDGES OF WOOD STRUCTURAL WALL SHEATHING TO FRAMING W/ $2\frac{3}{8}$ " x 0.113" NAILS @ 3" O.C. AND 12" O.C. IN THE PANEL FIELD NO STAPLE ALTERNATIVE AVAILABLE AT THIS SPEC. ALL SHEATHING PANELS SHALL BE ORIENTED VERTICALLY (LONG DIRECTION PARALLEL TO STUD) AND INSTALLED FULL HEIGHT OF SHEAR WALL - OR - 2x HORIZONTAL BLOCKING SHALL BE PROVIDED TO SUPPORT UNSUPPORTED PANEL EDGES AND 3" O.C. EDGE FASTENING.

• SEE CONNECTION SPECIFICATIONS CHART FOR STANDARD SHEAR TRANSFER DETAILING. IF ADDITIONAL CAPACITY IS REQUIRED BY DESIGN, IT WILL BE SPECIFICALLY NOTED ON PLAN.

• DESIGN ASSUMES 16" O.C MAX. STUD SPACING, U.N.O.

• ALL STRUCTURAL PANELS ARE TO BE DIRECTLY APPLIED TO STUD FRAMING.

• PRE-MANUFACTURED PANELIZED WALLS: FASTEN TOGETHER END STUDS OF WALL PANELS SHEATHED w/ OSB OR PLYWOOD w/ 3" x 0.120" NAILS @ 4" O.C. (THRU ONE SIDE ONLY)

INDICATES EXTENT OF INT. OSB SHEARWALL, BLOCKED PANEL EDGES, AND/OR 3" O.C. EDGE NAILING

NDICATES HOLDOWN

M&K STND. - MAR 2016

GENERAL STRUCTURAL NOTES

FOUNDATION

• DESIGN IS BASED ON 2018 NCSBC-RESIDENTIAL CODE

• FOOTING DESIGN - 2,000 PSF NET ALLOWABLE SOIL BEARING PRESSURE IS ASSUMED. BUILDER/CONTRACTOR MUST VERIFY.

• FASTEN 2x4/6 SILL PLATES TO CONC FND WITH A MINIMUM OF 2

ANCHORS PER PLATE, 12" MAX. FROM PLATE ENDS - UTILIZING: • 1/2" DIA. ANCHOR BOLTS @ 6'-0" O.C.,7" MIN. EMBEDMENT

• SIMPSON MASA ANCHOR STRAPS @ 6'-0" O.C.

• 1/2" DIA. x 6" LONG SIMPSON TITEN HD @ 6'-0" O.C.

• ALL LUMBER EXPOSED TO WEATHER OR IN CONTACT W/ PERIMETER FOUNDATION SHALL BE PRESERVATIVE TREATED SOUTHERN PINE #2.

• BUILDER TO VERIFY CORROSION-RESISTANCE COMPATIBILITY OF HARDWARE & FASTENERS IN CONTACT W/ PRESERVATIVE-TREATED WOOD. CONTACT LUMBER & HARDWARE SUPPLIERS TO COORD.

• FOUNDATION WALLS & FOOTINGS SHALL BE PLAIN CONCRETE, U.N.O.

• CONCRETE DESIGN BASED ON ACI 318. CONCRETE SHALL ATTAIN THE FOLLOWING MIN. COMPRESSIVE STRENGTHS IN 28 DAYS, U.N.O.: f'c = 4,000 psi: FOUNDATION WALLS

3,000 psi: FOOTINGS & INTERIOR SLABS ON GRADE 3,500 psi: GARAGE & EXTERIOR SLABS ON GRADE fy = 60,000 psi

• BASEMENT FOUNDATION WALL DESIGN BASED ON: 8' OR 9' HEIGHT (AS NOTED ON PLANS)

- TALLER WALLS MUST BE ENGINEERED • DESIGNS ARE BASED ON ACTUAL WALL WIDTHS. NOMINAL WIDTH

(7岁" FOR 8" WALL, 9岁" FOR 10" WALL) MAY NOT BE USED. • BASEMENT WALL DESIGN IS BASED ON 30 OR 45 PCF BACKFILL

SOIL TYPE CLASSIFICATIONS: 30 PCF TYPE (GW, GP, SW, SP) 45 PCF TYPE (GM, GC, SM, SM-SC, ML)

> • IMPORTANT - IF 60 PCF SOIL TYPE (SC, ML-CL, OR CL) IS UTILIZED FOR BACKFILL, CONTACT MULHERN & KULP FOR FURTHER EVALUATION OF FOUNDATION DESIGN.

• BASEMENT WALLS SHALL BE BRACED, PRIOR TO BACKFILLING, BY ADEQUATE TEMPORARY BRACING OR INSTALL IST FLOOR DECK.

• ALL CONCRETE EXPOSED TO THE WEATHER SHALL NOT HAVE LESS THAN 5% OR MORE THAN 7% AIR ENTRAINMENT.

• ALL FOOTINGS SHALL BEAR BELOW FROST LINE (TYP.) OR 12" MIN IN REGIONS WHERE CODE FROST DEPTH IS NOT APPLICABLE. CONSULT SOILS REPORT OR BUILDING DEPT. FOR MINIMUM DEPTH BELOW GRADE.

• FOOTINGS AND SLABS ON GRADE SHALL BEAR ON VIRGIN SOIL OR 95% COMPACTED FILL.

• PROVIDE CONTROL JOINTS AT ALL INSIDE CORNERS OF SLAB EDGES, AND OTHER LOCATIONS WHERE SLAB CRACKS ARE LIKELY

TO DEVELOP. JOINTS SHALL BE LOCATED @ 10'-0" O.C. (RECOMMENDED) OR 15'-0" O.C. (MAXIMUM)

• JOINT GRID PATTERN SHALL BE AS CLOSE TO SQUARES AS POSSIBLE (I:I RATIO), WITH A MAXIMUM OF I:1.5 RATIO • CONTROL JOINTS SHALL NOT BE INSTALLED IN STRUCTURAL

• TYPICAL REINFORCEMENT DETAILS: PROVIDE 3" MIN. CLEAR COVER WHERE CAST AGAINST EARTH, I 1/2" MIN. CLEAR COVER AGAINST FORMS. LAP ALL REBAR 48 BAR DIAMETERS MIN. (24" FOR #4 BARS) & BEND BARS AND LAP AT CORNERS. PROVIDE 6"

HOOK INTO SUPPORTING FOOTINGS WHEN FOOTINGS INTERSECT. • DIMENSIONS BY OTHERS, BUILDER TO VERIFY. M&K STND. - MAY 2012

MEANS & METHODS NOTES

THE STRUCTURE IS DESIGNED TO BE SELF SUPPORTING AND STABLE AFTER THE BUILDING IS FINISHED AND ALL PLAN, DETAIL, AND NOTE SPECIFICATIONS HAVE BEEN COMPLETED. IT IS THE CONTRACTOR'S SOLE RESPONSIBILITY TO DETERMINE THE ERECTION PROCEDURES AND SEQUENCE TO INSURE THE SAFETY OF THE BUILDING AND ITS COMPONENTS DURING CONSTRUCTION. THIS INCLUDES, BUT IS NOT LIMITED TO, THE ADDITION OF NECESSARY SHORING, SHEETING, TEMPORARY BRACING, GUYS, AND TIE-DOWNS. CONTRACTOR SHALL BE RESPONSIBLE FOR ALL SHORING AND BRACING REQUIRED TO STABILIZE AND PROTECT EXISTING AND ADJACENT STRUCTURES AND SYSTEMS DURING COURSE OF DEMOLITION AND CONSTRUCTION OF THE PROJECT.

STRUCTURAL DESIGN AND SPECIFICATIONS ASSUME THAT ALL SUPPORTING AND NON-SUPPORTING ELEMENTS IN CONTACT WITH FLOOR FRAMING ARE LEVEL, INCLUDING, BUT NOT LIMITED TO; FOUNDATIONS, SLABS ON GRADE, BEAMS, WALLS, AND NON-BEARING ELEMENTS. IT IS THE CONTRACTOR'S RESPONSIBILITY TO VERIFY LEVELNESS AND MAKE ADJUSTMENTS AS NECESSARY, INCLUDING CONSIDERATION OF THOSE AREAS THAT MAY BE WITHIN CONTRACTUAL, INDUSTRY, OR WARRANTY TOLERANCES.

FLOOR FRAMING

● I-JOISTS/TRUSSES SHALL BE DESIGNED BY MANUF. TO MEET OR EXCEED L/480 LIVE LOAD DEFLECTION CRITERIA. (EXCLUDES STONE/MARBLE OR WET BED CONSTRUCTED FLOORS - CONTACT M&K FOR EXCLUDED FLOOR DESIGNS)

• PER THE GUIDELINES OF THE TILE COUNCIL OF NORTH AMERICA (TCNA HANDBOOK), IT SHALL BE THE FLOOR FINISH INSTALLER'S RESPONSIBILITY TO VERIFY THAT THE FINISHES TO BE INSTALLED MATCH THE DESIGN CRITERIA NOTED ABOVE (UNDER "DESIGN

• FLOOR SYSTEMS & SHEATHING HAVE BEEN DESIGNED TO SUPPORT ADDITIONAL DEAD LOAD FROM CERAMIC TILE (EXCLUDING MARBLE OR STONE). HOWEVER, IT SHALL BE THE FLOOR FINISH INSTALLER'S RESPONSIBILITY TO PROVIDE PROPER UNDERLAYMENT, UNCOUPLING MEMBRANE AND MORTAR/GROUT PER THE ASSEMBLY DESIGNATIONS IN THE TONA HANDBOOK (TILE COUNCIL OF NORTH AMERICA).

• 2x FLOOR JOISTS HAVE BEEN DESIGNED TO MEET OR EXCEED L/360 LIVE LOAD DEFLECTION CRITERIA.

• AT I-JOIST FLOORS, PROVIDE I 1/8" MIN. OSB RIM BOARD.

• METAL HANGERS SHALL BE SPECIFIED BY MANUFACTURER, U.N.O. • I-JOIST/TRUSS SHOP DWGS. SHALL BE SUBMITTED TO ARCH. & ENG. FOR REVIEW AND APPROVAL PRIOR TO FABRICATION OR DELIVER'

• FLOOR SHEATHING SHALL BE 23/32" A.P.A. RATED 'STURD-I-FLOOR 24" O.C., EXPOSURE I (OR APPROVED EQUAL) WITH TONGUE AND GROOVE EDGES. FASTEN TO FRAMING MEMBERS W/ GLUE AND - 2 ½" x 0.131" NAILS @ 6"o.c. @ PANEL EDGES \$ @ 12"o.c. FIELD. - 2 3 × 0.120 NAILS @ 4" O.C. @ PANEL EDGES & @ 8" O.C. FIELD - 2 3 × 0.113 NAILS @ 3 O.C. @ PANEL EDGES & @ 6 O.C. IN FIELD

ROOF FRAMING

• ROOF SHEATHING SHALL BE 7/16" A.P.A. RATED SHEATHING 24/16 EXPOSURE I (OR APPROVED EQUAL). FASTEN TO FRAMING MEMBERS - w/ 2 ½" x 0.131" NAILS @ 6"о.с. @ PANEL EDGES & @ 12" О.С. FIELD. - W/ $2\frac{3}{8}$ " \times 0.120" NAILS @ 4"o.c. @ PANEL EDGES \$ @ 8" O.C. FIELD. - w/ 2 🖁 x 0.113" NAILS @ 3"о.с. @ PANEL EDGES & @ 6" О.С. FIELD.

• WITHIN 48" OF ALL ROOF EDGES, RIDGES, & HIPS FASTEN ROOF SHEATHING FIELDS PER EDGE NAILING SPEC.

● FASTEN EACH ROOF TRUSS TO TOP PLATE W/ SIMPSON H2.5T CLIP (OR APPROVED EQUAL) @ ALL BEARING POINTS. PROVIDE (2) H2.5T CLIPS AT 2-PLY GIRDER TRUSSES, (3) H2.5T CLIPS AT 3-PLY GIRDER TRUSSES & ROOF BEAMS - AT ALL BEARING POINTS.

 METAL HANGERS SHALL BE SPECIFIED BY THE MANUFACTURER, U.N.O. • ROOF TRUSS SHOP DWGS. SHALL BE SUBMITTED TO ARCH & ENG. FOR REVIEW AND APPROVAL PRIOR TO FABRICATION OR DELIVERY. • ERECT AND INSTALL ROOF TRUSSES PER WTCA & TPI'S BCSI I "GUIDE TO GOOD PRACTICE FOR HANDLING, INSTALLING & BRACING

• SUPPORT SHORT SPAN ROOF TRUSSES w/2x4 LEDGER FASTENED TO FRAMING w/(2) 3" x 0.120" NAILS @ 16" O.C. (UP TO 7' SPAN).

OF METAL PLATE CONNECTED WOOD TRUSSES."

LEGEND

• R.T. INDICATES ROOF TRUSSES @ 24" O.C. PER ROOF. MANUF. (TYP. U.N.O.)

• O.F. INDICATES TRUSS OVERFRAMING @ 24" O.C. (TYP. U.N.O.)

• F.J. INDICATES 14" DEEP FLOOR 1-JOISTS (19.2" O.C. MAX SPACING). JOIST SERIES AND SPACING SHALL BE THE RESPONSIBILITY OF THE JOIST MANUFACTURER

M&K STND. - MAR 2016

F.T. 🕟 INDICATES 16" DEEP FLOOR TRUSSES (24" O.C. MAX

• F.S. NDICATES 14" DEEP FLOOR JOISTS (19.2" O.C. MAX SPACING). JOIST SERIES AND SPACING SHALL BE THE RESPONSIBILITY OF THE JOIST MANUFACTURER -OR- 14" DEEP FLOOR TRUSSES (24" O.C. MAX SPACING).

• D.J. INDICATES 2x8 P.T. DECK JOISTS @ 16" O.C. (MAX.)

____ INDICATES LOCATIONS OF POTENTIAL TILE FLOOR. • Joist Manufacturer Shall Design Floor THESE SYSTEM FOR ADD'L 10 PSF DEAD LOAD AT THESE

• IIIIIIII INTERIOR BEARING WALL

• ==== BEARING WALL ABOVE (B.W.A.)

• BEAM/HEADER

• JL METAL HANGER

• * INDICATES POST ABOVE (P.A.) PROVIDE SOLID BLOCKING UNDER POST OR JAMB ABOVE.

GENERAL STRUCTURAL NOTES

• DESIGN IS BASED ON 2018 NCSBC-RESIDENTIAL CODE

• WOOD FRAME ENGINEERING IS BASED ON NDS, "NATIONAL DESIGN SPECIFICATION FOR WOOD CONSTRUCTION" - LATEST EDITION.

• DESIGN LOADS:

ROOF LIVE = 20 PSF DEAD = 7 PSF T.C., 10 PSF B.C. LOAD DURATION FACTOR = 1.25

FLOOR LIVE = 40 PSF (30 PSF @ SLEEPING AREAS) DEAD = 10 PSF (I-JOISTS & SOLID SAWN) 10 PSF T.C., 5 PSF B.C. (TRUSSES) ADD'L 10 PSF @ CERAMIC TILE IN

BATHS AND LAUNDRY

2,000 PSF ASSUMED ALLOWABLE BEARING PRESSURE (TO BE VERIFIED BY BUILDER)

GENERAL FRAMING

• ALL TYP. NAIL FASTENER REQUIREMENTS ARE NOTED IN STANDARD CONNECTIONS TABLE (IRC TABLE R602.3(I)) OR ON PLANS. ALL NAILS SPECIFIED ARE MIN DIAMETER AND LENGTH REQUIRED FOR CONNECTION. ALL HANGER NAILS SHALL BE INSTALLED PER MANUFACTURER'S REQUIREMENTS FOR MAX CHARTED CAPACITY. NOTE: HANGERS USE COMMON NAIL DIAMETERS NOT TYPICAL FRAMING GUN NAILS.

• EXT. & INT. BEARING WALLS SHALL BE 2x4 OR 2x6 (AS SHOWN ON PLANS) @ 16" O.C. SPF/SP "STUD" GRADE LUMBER, OR BETTER, U.N.O. • WALLS OVER 12' TALL SHALL BE PER PLAN.

• ALL INTERIOR BEARING WALLS ARE ASSUMED TO BE SHEATHED W/ GYP WALL BOARD (ONE SIDE MIN.) OR PROVIDE MID HT. BLOCKING.

• ALL HEADERS, BEAMS & OTHER STRUCTURAL MEMBERS SHALL BE SPRUCE-PINE-FIR #2 (SPF) OR SOUTHERN PINE #2 (SP) LUMBER, OR BETTER, SUPPORT ALL HEADERS/ BEAMS W/ (1)2x JACK STUD & (1)2x KING STUD, MINIMUM. - THE NUMBER OF STUDS SPECIFIED AT A SUPPORT INDICATES THE

NUMBER OF JACK STUDS REQUIRED, U.N.O., • ALL NON-BEARING INTERIOR STUD WALLS SHALL BE CONSTRUCTED WITH 2x 'STUD' GRADE MEMBERS SPACED @ 24" O.C. (MAX., U.N.O.) • HEADERS IN NON-LOAD BEARING WALLS SHALL BE:

(1)2x4/6 FLAT @ OPENINGS UP TO 4', (2)2x4/6 FLAT UP TO 8'. • ALL FRAMING LUMBER SHALL BE DRIED TO 15% MC (KD-15). $lap{ullet}$ ENGINEERED LUMBER BEAMS TO MEET OR EXCEED THE FOLLOWING:

• 'LVL' - Fb=2600 psi; Fv=285 psi; E=2.0x10^6 psi • ENGINEERED LUMBER POSTS TO MEET OR EXCEED THE FOLLOWING:

'LSL' - Fb=1700 psi; Fv=425 psi; E=1.3x10^6 psi

• 'LVL' - Fb=2400 psi; Fcll=2500 psi; E=1.8x10^6 psi • FOR 2 & 3 PLY BEAMS OF EQUAL 13/4" MAX. WIDTH, FASTEN PLIES TOGETHER WITH 3 ROWS OF 3"XO.120" NAILS @ 8" O/C OR 2 ROWS 1/4"x31/5" SIMPSON SDS SCREWS (OR 31/5" TRUSSLOK SCREWS) @ 16" O/C. USE A MINIMUM OF 4 ROWS FOR BEAM DEPTHS OF 14" OR GREATER. APPLY FASTENING AT BOTH FACES FOR 3-PLY CONDITION. LOCATE TOP & BOTTOM NAILS/SCREWS 2" FROM EDGE. SOLID 3 岁" OR 5 ¼" BEAMS ARE ACCEPTABLE. USE 2 ROWS OF NAILS FOR 2x6 \$ 2x8 MEMBERS.

• FOR 4 PLY BEAMS OF EQUAL 13/4" MAX. WIDTH, FASTEN PLIES TOGETHER WITH 3 ROWS OF 1/4"x6" SIMPSON SDS SCREWS (OR 6 3/4" TRUSSLOK SCREWS) @ 16" O/C. USE A MINIMUM OF 4 ROWS FOR BEAM DEPTHS OF 14" OR GREATER. APPLY FASTENING AT BOTH FACES (ONE SIDE ONLY FOR TRUSSLOK SCREWS). LOCATE TOP AND BOTTOM SCREWS 2" FROM EDGE. A SOLID 7" BEAM IS ACCEPTABLE

• PROVIDE SOLID BLOCKING IN FLOOR SYSTEM UNDER ALL POSTS CONTINUOUS TO FND./BEARING. BLOCKING TO MATCH POST ABOVE.

• ALL EXTERIOR 4x4 WOOD POSTS SHALL HAVE SIMPSON BCS2-2/4 CAP & ABW44 BASE, U.N.O.

• SIMPSON CONNECTORS SPECIFIED ON PLAN MAY BE SUBSTITUTED WITH EQUIVALENT UNITED STEEL PRODUCTS (USP), PROVIDED THE INSTALLED PRODUCT MATCHES THE MINIMUM REQUIREMENTS/CAPACITIES OF SPECIFIED SIMPSON HARDWARE.

CORROSION NOTES:

 BUILDER RESPONSIBLE TO DETERMINE CORROSION-RESISTANCE REQUIREMENTS AND COMPATIBILITY OF HARDWARE, FASTENERS AND CONNECTORS FOR ENVIRONMENTAL EXPOSURE AND IN CONTACT W/ PRESERVATIVE-TREATED WOOD OF ACTUAL FINAL CONDITIONS AND SOURCED MATERIALS. CONTACT LUMBER & HARDWARE SUPPLIERS TO COORD.

 ALL FASTENERS AND CONNECTORS EXPOSED TO SALT WATER (WITHIN 300' OF SALT WATER SHORELINE, INCLUDING VENTED SPACES) SHALL BE STAINLESS STEEL.

copyright : MULHERN & KULP Structural Engineering, Inc.

□ \$



Mulhern+Kulp project number: 260-22002

SMK project mgr: RKS issue date: 05.17.2024

REVISIONS:

initial: 10/01/2024 Framewalk revisions SMM

0

Ĭ

S0.0

Tobacco Road Lot 97

Tobacco Road Lot 97 8'-2 3/4" 5'-9 1/4" 29'-2 3/4" 5'-9 1/4" 6x6 P.T. POST SHOULDER CUT POST TO RECEIVE DROPPED BEAM. REMAINING POST w/ (2)/2" THRU BOLTS. <u>DO NOT</u> REFER TO SDI.2A FOR OVERCUT NOTCH. EMBED 16"x16"x12" PLAIN-TYPICAL DETAILS. POSTS 12" MIN INTO COMP. CONC. FTG. DIMENSIONS SHOWN ARE FILL TO TOP OF FOOTING (TYP. OF 3) TO OUTSIDE OF FACE (TYP. OF 3) OF FRAMING 2xIO P.T. LEDGER FASTENED TO FRAMING W/ (2) ROWS OF 1/4"x31/2" SIMPSON SDS **NOTE: PROPANE** SCREWS @ 16" O.C. MAXT TANK TO BE SET LUS28 (TYP.) **5' FROM VENTS 10' FROM IGNITION** ADD'L JOIST UNDER PILASTER— ADD'L JOIST UNDER FRONT OF CABINETS **PROPANE** 12"x24" FTG. **TANK** UNDER PIER-2x10 JOISTS @ 16" O.C. MAX. DBL. 2x10 JOISTS @ 16" O.C. UNDER ISLAND ABOVE 2xIO JOISTS 2xI0 JOISTS @ 16" O.C. MAX. EXTENTS OF KITCHEN ISLAND ABOVE-36"x36"xI2" PLAIN CONC. -16"x16" CMU PIER ON_ // 2x10 JOISTS @ 16" O.C. MAX. 30"x30"x12" *CO*NT. 2x10 JOISTS **10** 16" O.C. MAX. (SEE DETAIL 8/SDI.2) DBL. JOIST UNDER POST ABOVE 2x10 JOISTS // @ 16" O.C. MAX. DBL. JOIST UNDER POST ABOVE 36"x36"x12" PLAIN CONC. FTG. (4)134"X914" LVL UNDER B.W.A. REFER TO SO.O FOR TYPICAL STRUCTURAL NOTES & SCHEDULES LEGEND 36"x36"x12" DEEP CONC. FTG. UNDER P.A. • R.T. INDICATES ROOF TRUSSES @ 24" O.C. PER ROOF. MANUF. (TYP. U.N.O.) THICKENED SLAB UNDER P.A. • NDICATES TRUSS OVERFRAMING @ 24" O.C. (TYP. U.N.O.) GARAGE SLAB SEE TYPICAL DETAILS 2x10 JOISTS @ 16" O.C. MAX. • F.J. INDICATES 14" DEEP FLOOR I-JOISTS (19.2" O.C. MAX SPACING). JOIST SERIES AND SPACING SHALL BE THE RESPONSIBILITY OF THE JOIST SEE TYPICAL DETAILS MANUFACTURER • F.T. INDICATES 16" DEEP FLOOR TRUSSES (24" O.C. MAX F.S. INDICATES 14" DEEP FLOOR JOISTS (19.2" O.C. MAX SPACING). JOIST SERIES AND SPACING SHALL BE THE RESPONSIBILITY OF THE JOIST MANUFACTURER -OR- 14" DEEP FLOOR TRUSSES (24" O.C. MAX SPACING). REFER TO SHEET • D.J. INDICATES 2x8 P.T. DECK JOISTS @ 16" O.C. (MAX.) SDI.2 FOR TYPICAL DETAILS • JOIST MANUFACTURER SHALL DESIGN FLOOR SYSTEM FOR ADD'L 10 PSF DEAD LOAD AT THESE LOCATIONS. • IIIIIIII INTERIOR BEARING WALL IST FLOOR FRAMING & ■ □□□□□ BEARING WALL ABOVE (B.W.A.) SEE PAGE S1.18M for OPTIONS CRAWLSPACE FOUNDATION PLAN W/ 2x JOISTS • BEAM/HEADER SCALE: 1/4"=1'-0" ON 22x34

1/8"=1'-0" ON 11x17

copyright : MULHERN & KULP

Structural Engineering, Inc.

Mulhern+Kulp project number: 260-22002


SMK project mgr: RKS issue date: 05.17.2024

REVISIONS:

initial: 10/01/2024 Framewalk revisions SMM

• JL METAL HANGER

• * INDICATES POST ABOVE (P.A.) PROVIDE SOLID BLOCKING UNDER POST OR JAMB ABOVE.

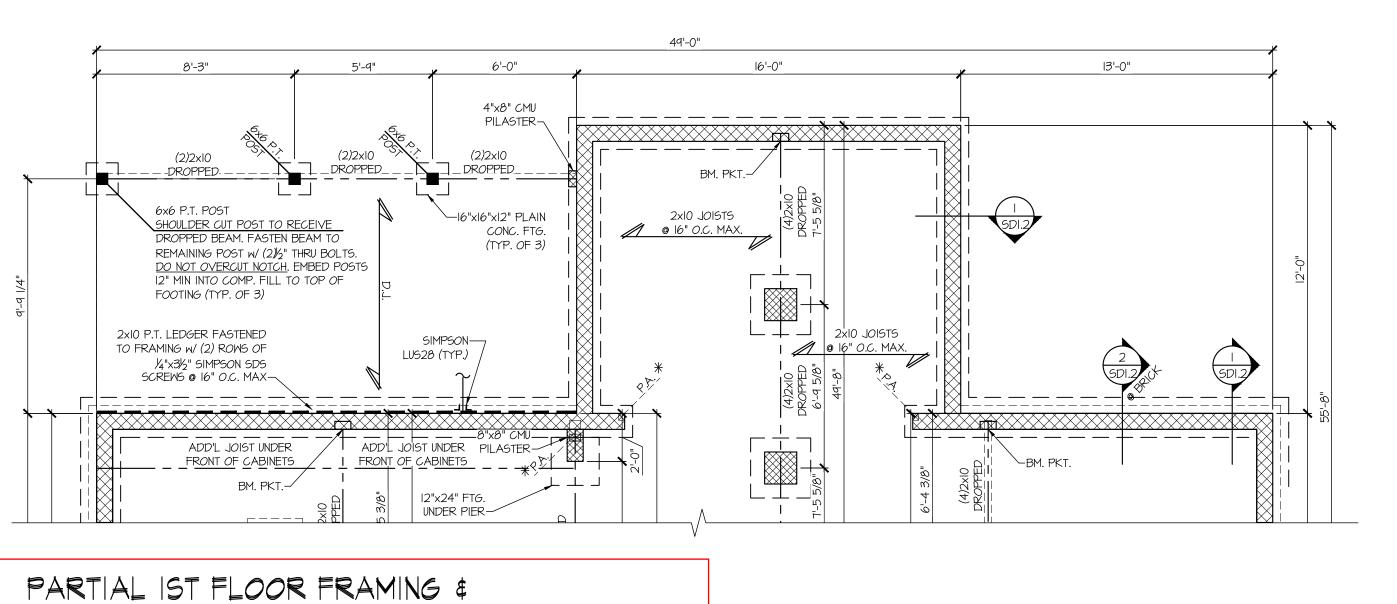

UNDER PIER-EXTENTS OF KITCHEN ISLAND DBL. 2xIO JOISTS @ I6" O.C.
UNDER ISLAND ABOVE 10'-3 1/8" 36"x36"x12" // 2x10 JOISTS @ 16" O.C. MAX. GARAGE SLAB SEE TYPICAL DETAILS CONC. FTG. UNDER P.A. 36"x36"x12" DEEP THICKENED SLAB UNDER P.A. GARAGE SLAB SEE TYPICAL DETAILS . CONC. FTG. _____

PARTIAL IST FLOOR FRAMING &

CRAWLSPACE FOUNDATION PLAN W/ 2x JOISTS

SCALE: 1/4"=1'-0" ON 22x34

OPT. SIDE LOAD GARAGE

1/8"=1'-0" ON 11x17

OPT. SIDE LOAD GARAGE \$ 3RD CAR GARAGE ALL ELEV. SIM. CRAMLSPACE FOUNDATION PLAN W/ 2x JOISTS

SCALE: 1/4"=1'-0" ON 22x34
1/8"=1'-0" ON 1|x|7

OPT. SUNROOM + OPT. DECK
ALL ELEV. SIM.

REFER TO SO.O FOR TYPICAL STRUCTURAL NOTES & SCHEDULES

LEGEND

• R.T. INDICATES ROOF TRUSSES @ 24" O.C. PER ROOF. MANUF. (TYP. U.N.O.)

• O.F. INDICATES TRUSS OVERFRAMING @ 24" O.C. (TYP. U.N.O.)

• F.J. INDICATES 14" DEEP FLOOR I-JOISTS (19.2" O.C. MAX SPACING). JOIST SERIES AND SPACING SHALL BE THE RESPONSIBILITY OF THE JOIST MANUFACTURER

• F.T. INDICATES 16" DEEP FLOOR TRUSSES (24" O.C. MAX SPACING).

• F.S. INDICATES 14" DEEP FLOOR JOISTS (19.2" O.C. MAX SPACING). JOIST SERIES AND SPACING SHALL BE THE RESPONSIBILITY OF THE JOIST MANUFACTURER -OR- 14" DEEP FLOOR TRUSSES (24" O.C. MAX SPACING).

• D.J. INDICATES 2x8 P.T. DECK JOISTS @ 16" O.C. (MAX.)

INDICATES LOCATIONS OF POTENTIAL TILE FLOOR.

JOIST MANUFACTURER SHALL DESIGN FLOOR

SYSTEM FOR ADD'L 10 PSF DEAD LOAD AT THESE LOCATIONS.

• INTERIOR BEARING WALL

• ==== BEARING WALL ABOVE (B.W.A.)

• BEAM/HEADER

• JL METAL HANGER

INDICATES POST ABOVE (P.A.) PROVIDE SOLID BLOCKING UNDER POST OR JAMB ABOVE.

© copyright: MULHERN & KULP
Structural Engineering, Inc.

LCTURAL ENGINEERING
ite 165 • Alpharetta, GA 30022
ulp.com

RESIDENTIAL STRUCTUR
3625 Brookside Parkway, Suite 165
p 770-777-0074 > mulhernkulp.com



Mulhern+Kulp project number: 260-22002

project mgr: SMK drawn by: RKS issue date: 05.17.2024

REVISIONS:


date: initial: IO/01/2024 SMM FRAMEWALK REVISIONS


MOH NOSC

OUNDATION PLAN
RAWFORD MODEL

RALFIGH NO

S1.18M

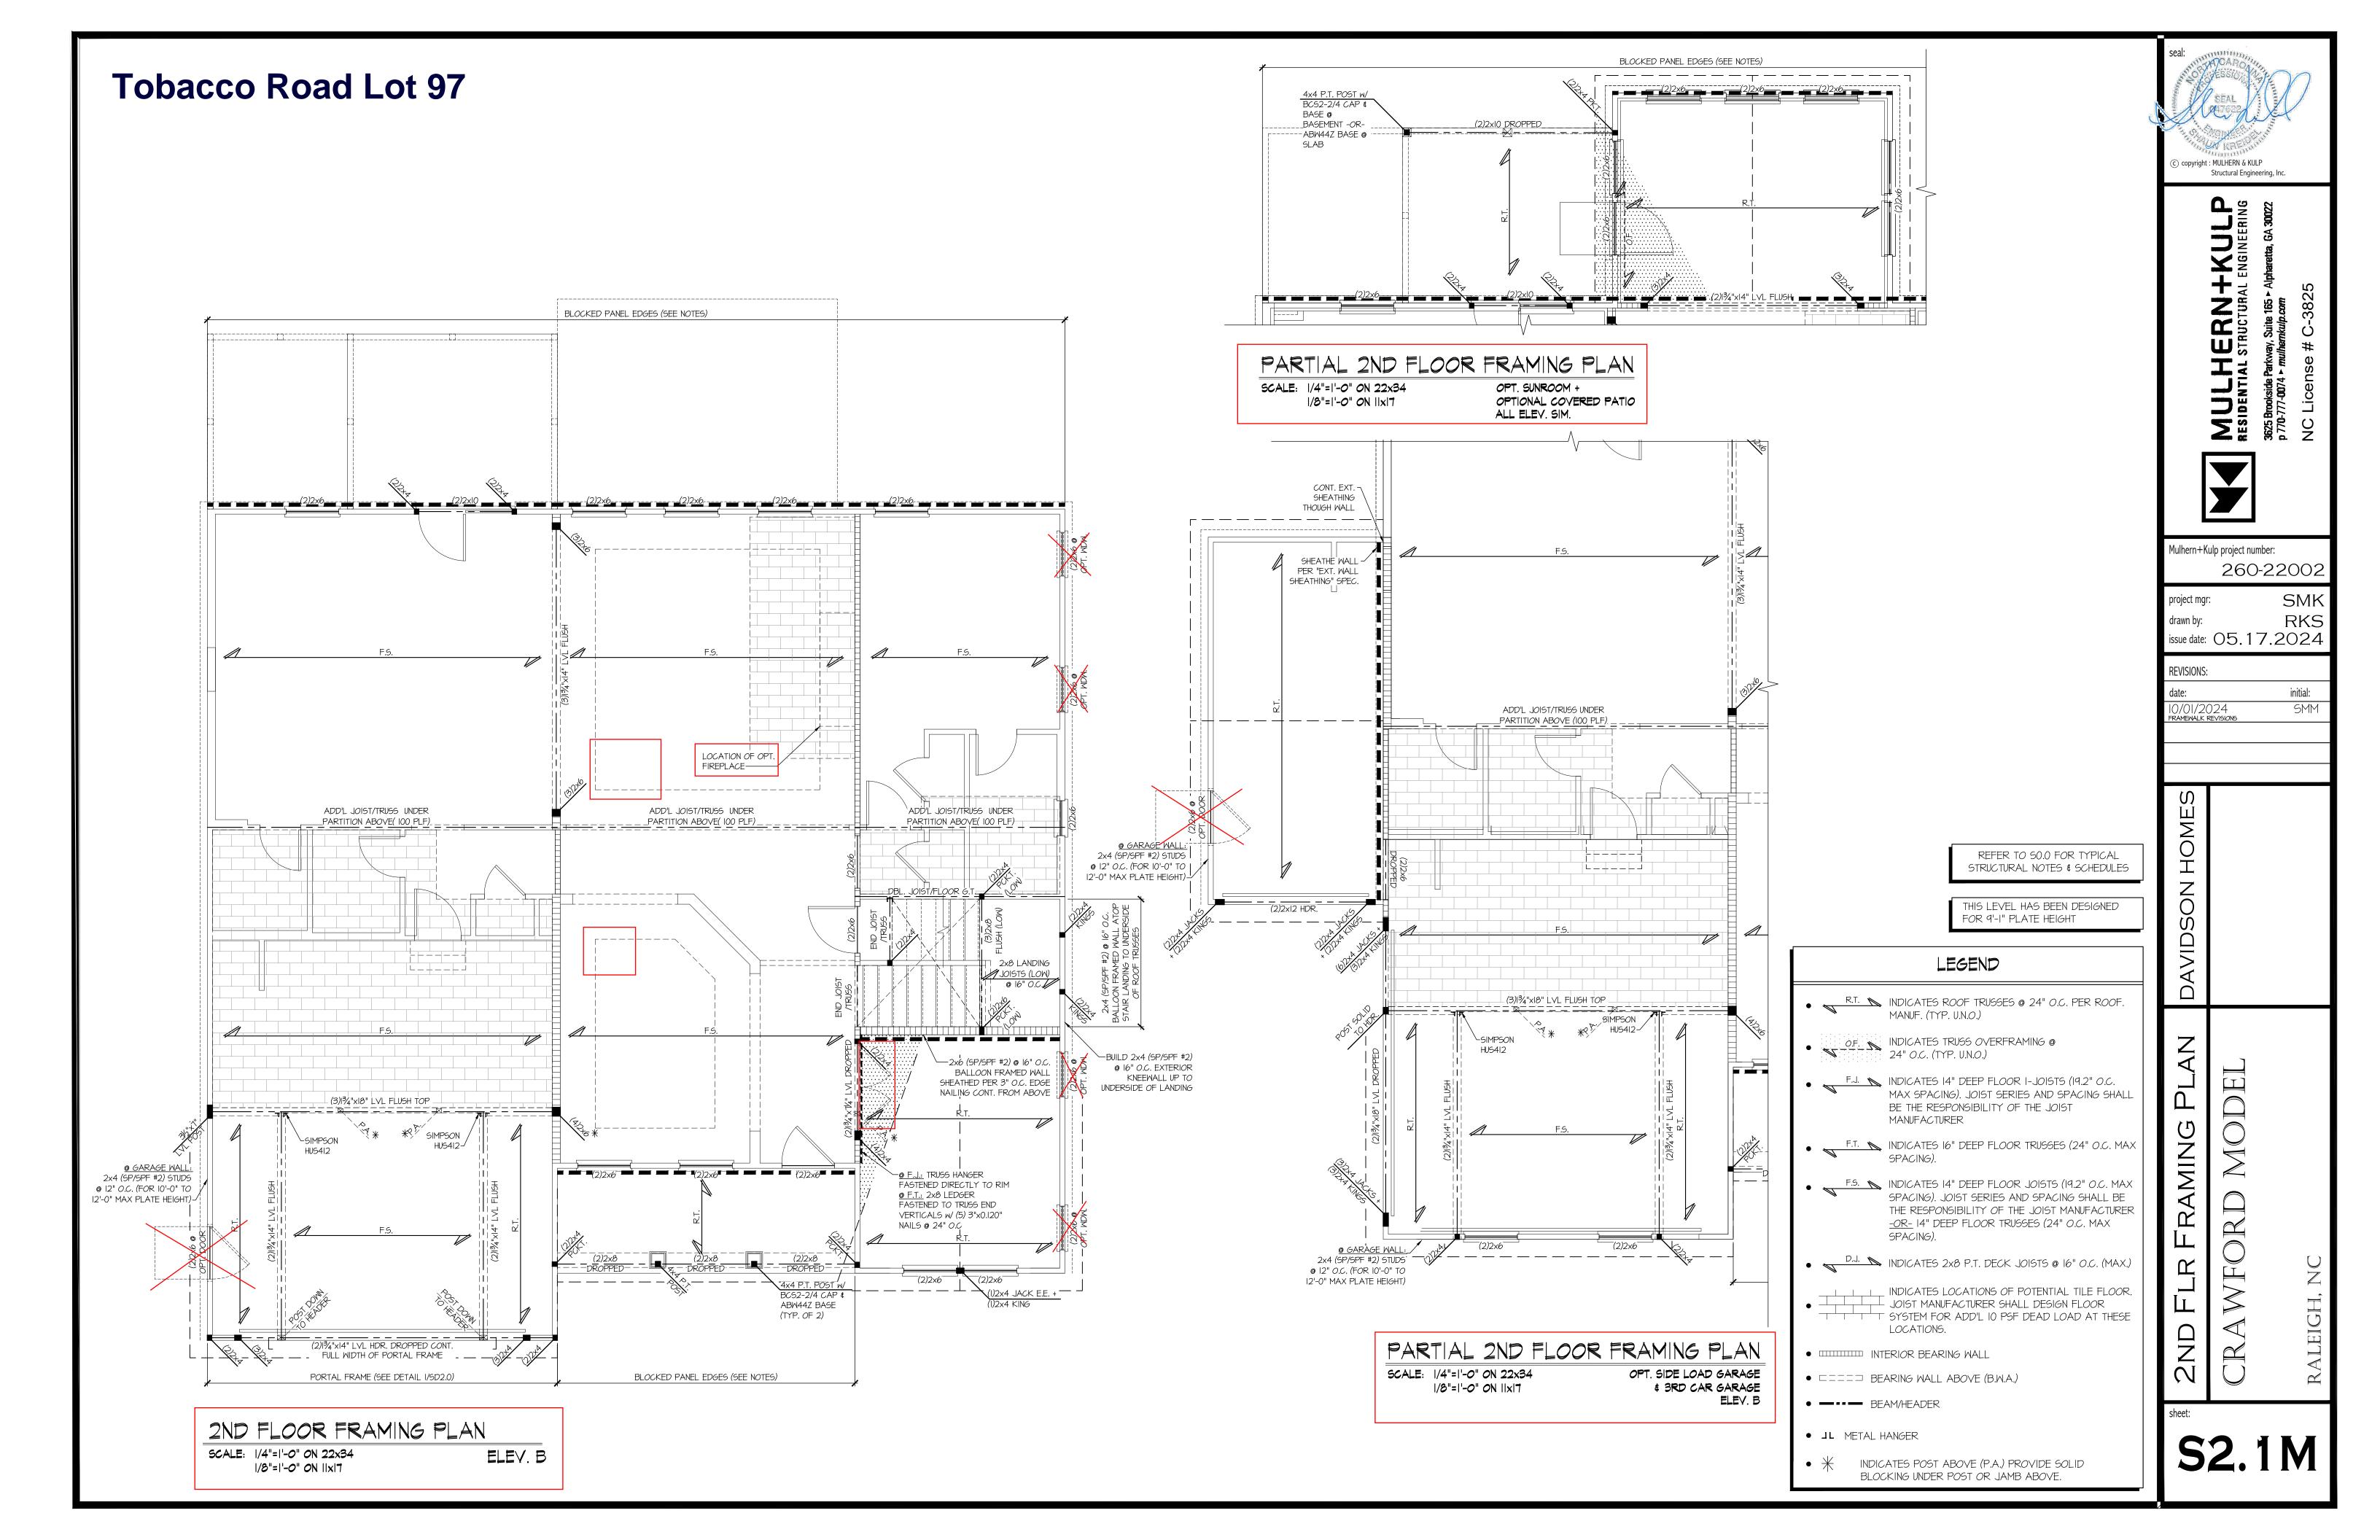

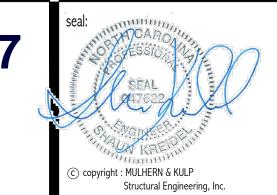



Mulhern+Kulp project number: 260-22002

SMK RKS issue date: 05.17.2024

REVISIONS:

initial: 10/01/2024 Framewalk revisions

REFER TO SO.O FOR TYPICAL

THIS LEVEL HAS BEEN DESIGNED FOR 8'-1" AND 9'-1" PLATE HEIGHT

LEGEND

• R.T. INDICATES ROOF TRUSSES @ 24" O.C. PER ROOF. MANUF. (TYP. U.N.O.)

MAX SPACING). JOIST SERIES AND SPACING SHALL BE THE RESPONSIBILITY OF THE JOIST

SPACING).

SPACING).

• D.J. INDICATES 2x8 P.T. DECK JOISTS @ 16" O.C. (MAX.)

INDICATES LOCATIONS OF POTENTIAL TILE FLOOR.

JOIST MANUFACTURER SHALL DESIGN FLOOR

SYSTEM FOR ADD'L 10 PSF DEAD LOAD AT THESE LOCATIONS.

□□□□□□ BEARING WALL ABOVE (B.W.A.)

 INDICATES POST ABOVE (P.A.) PROVIDE SOLID BLOCKING UNDER POST OR JAMB ABOVE.

• NDICATES TRUSS OVERFRAMING @ 24" O.C. (TYP. U.N.O.)

F.J. INDICATES 14" DEEP FLOOR 1-JOISTS (19.2" O.C. MANUFACTURER


• F.T. INDICATES 16" DEEP FLOOR TRUSSES (24" O.C. MAX

F.S. INDICATES 14" DEEP FLOOR JOISTS (19.2" O.C. MAX SPACING). JOIST SERIES AND SPACING SHALL BE THE RESPONSIBILITY OF THE JOIST MANUFACTURER <u>-OR-</u> 14" DEEP FLOOR TRUSSES (24" O.C. MAX

• IIIIIIII INTERIOR BEARING WALL

• BEAM/HEADER


• JL METAL HANGER

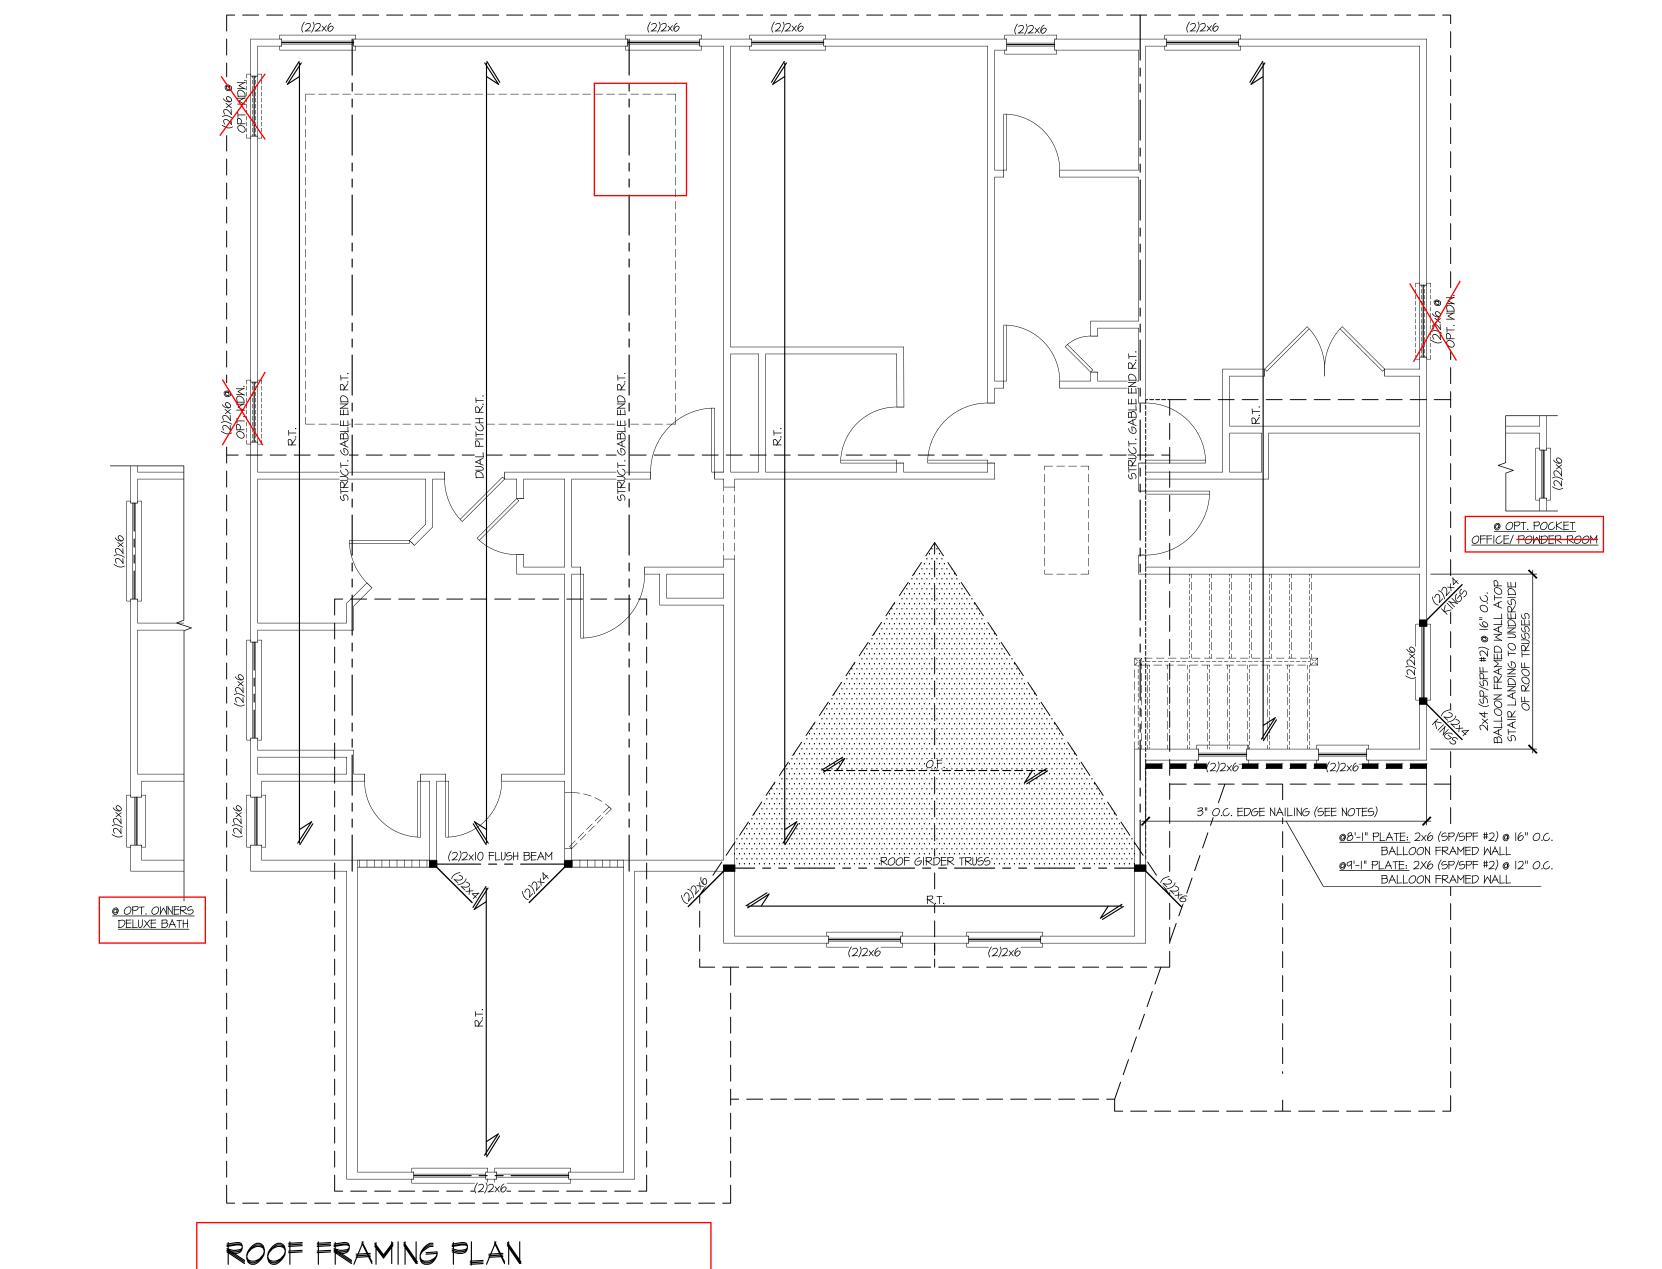

SCALE: 1/4"=1'-0" ON 22x34

1/8"=1'-0" ON 11x17

ELEV. B

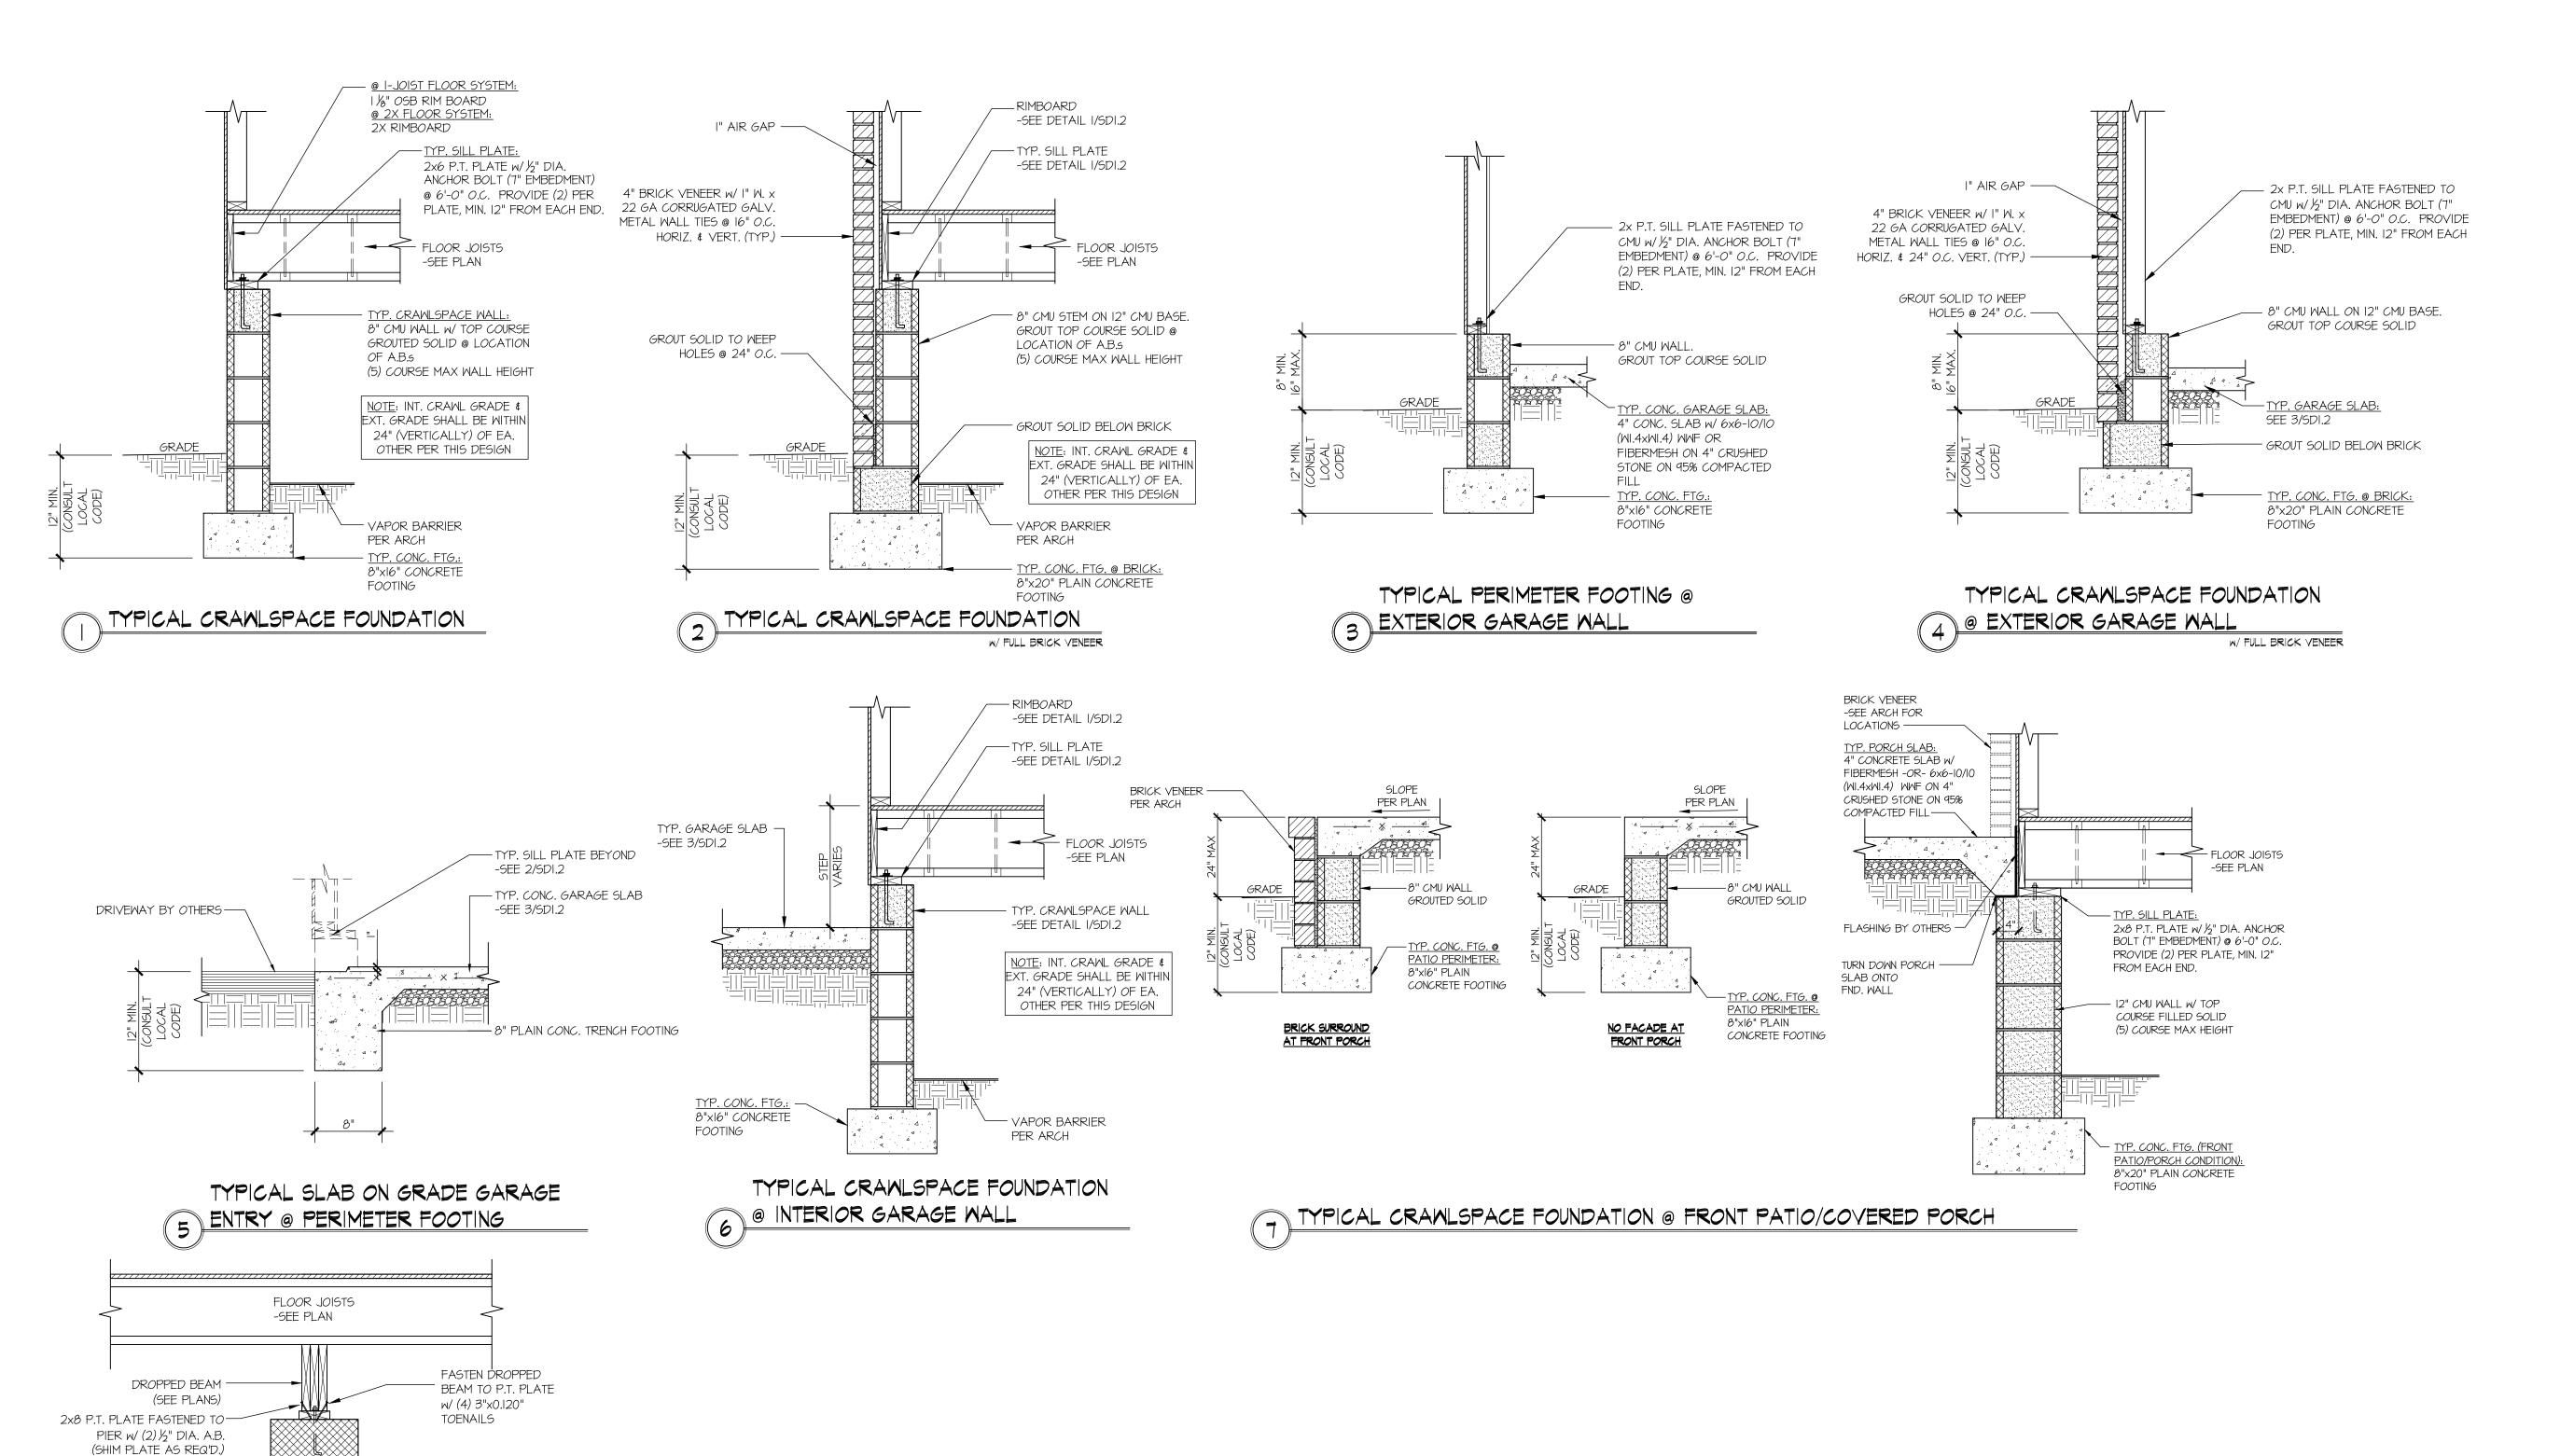


UP TO 5 COURSE MAX: 16"X16" CMJ PIER CROJTED SOLID

CONC. FOOTING (SEE PLANS)

TYPICAL CRAWLSPACE


FOUNDATION @ INTERIOR PIER

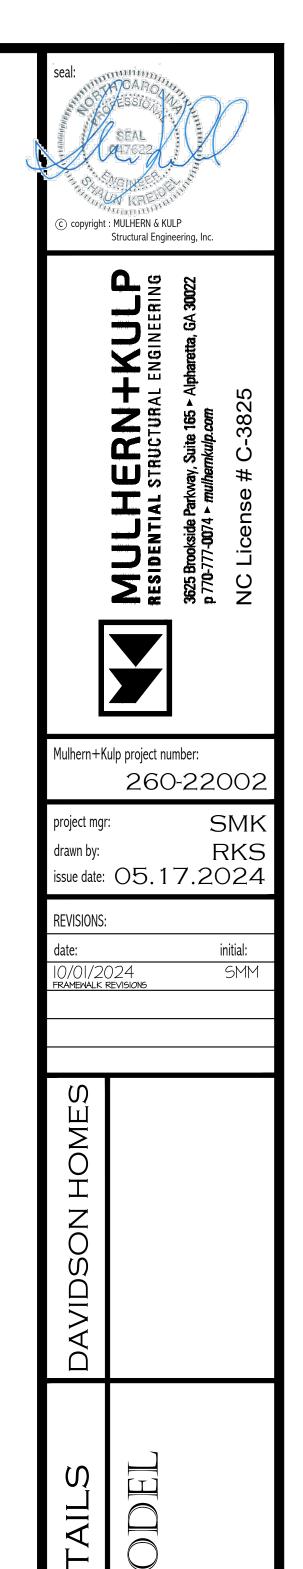

Tobacco Road Lot 97

SD1.2

FOUNDATION

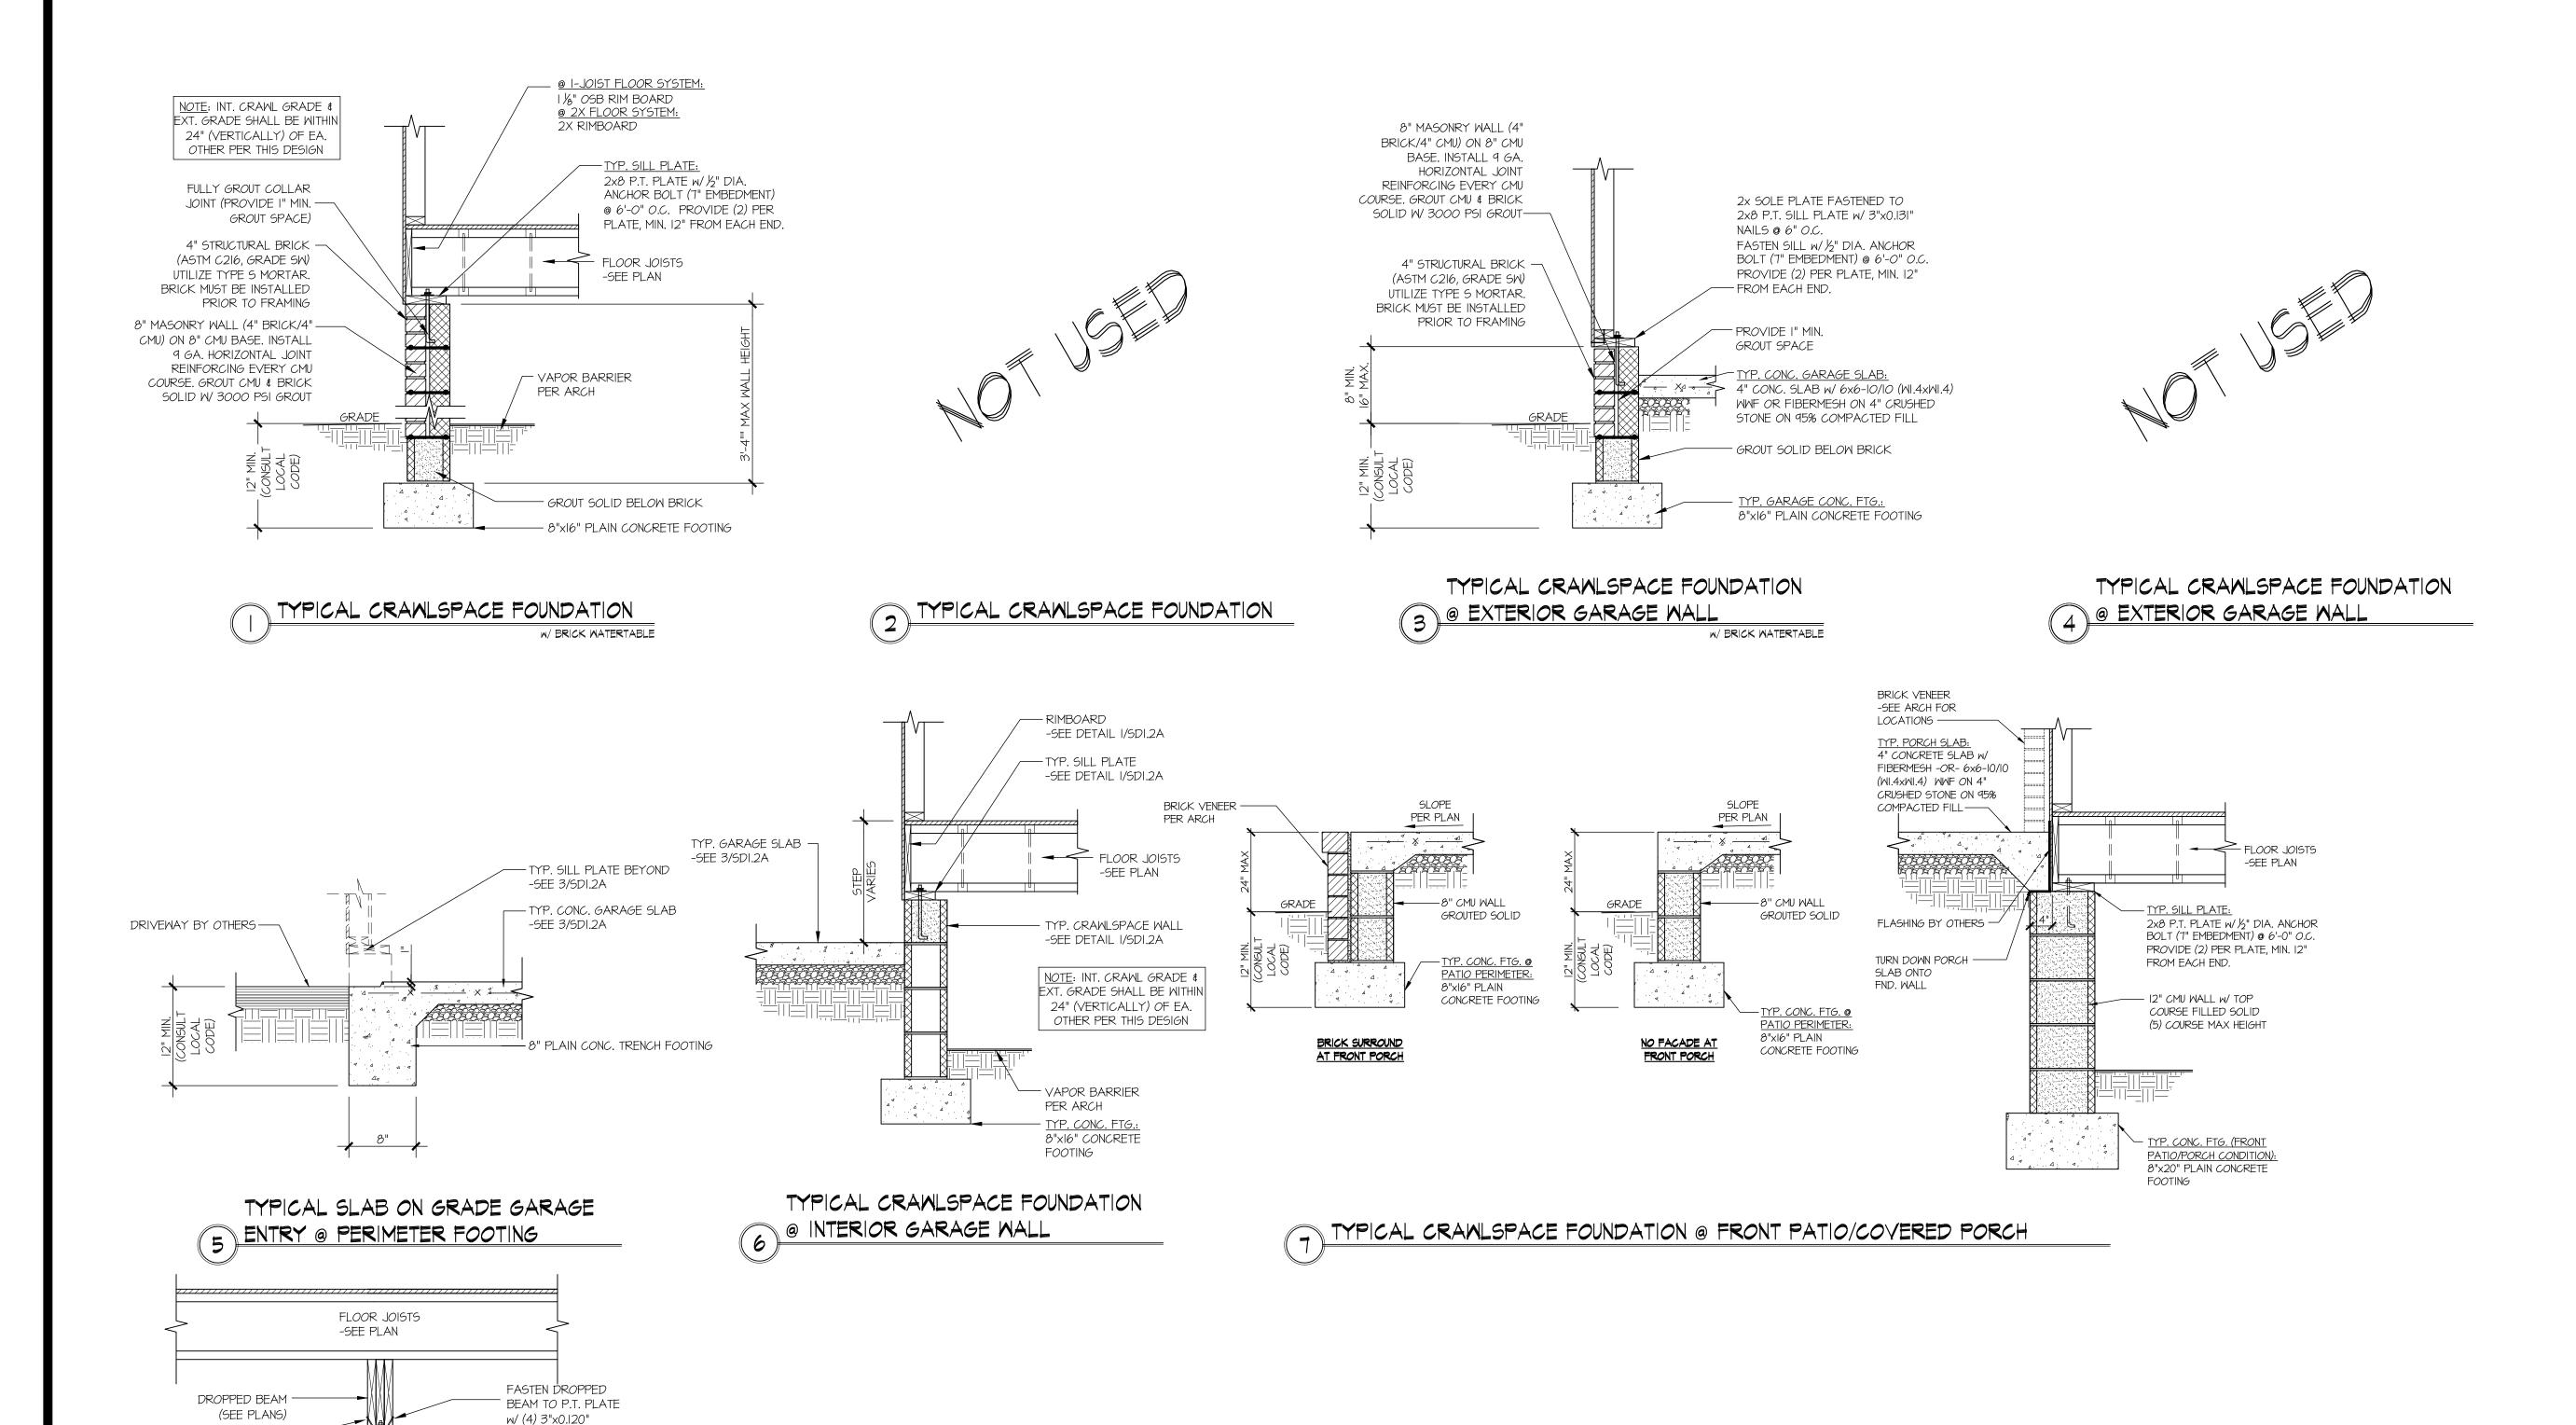

2x8 P.T. PLATE FASTENED TO-PIER w/ (2) 1/2" DIA. A.B. (SHIM PLATE AS REQ'D.)

> UP TO 5 COURSE MAX: 16"x16" CMJ PIER GROUTED SOLID


+ CONC. FOOTING (SEE PLANS)


TYPICAL CRAWLSPACE

FOUNDATION @ INTERIOR PIER


copyright: MULHERN & KULP Structural Engineering, Inc. Mulhern+Kulp project number: 260-22002 SMK project mgr: RKS drawn by: issue date: 05.17.2024**REVISIONS:** initial: 10/01/2024 Framewalk revisions SMM HOM TAILS


FOUNDATION

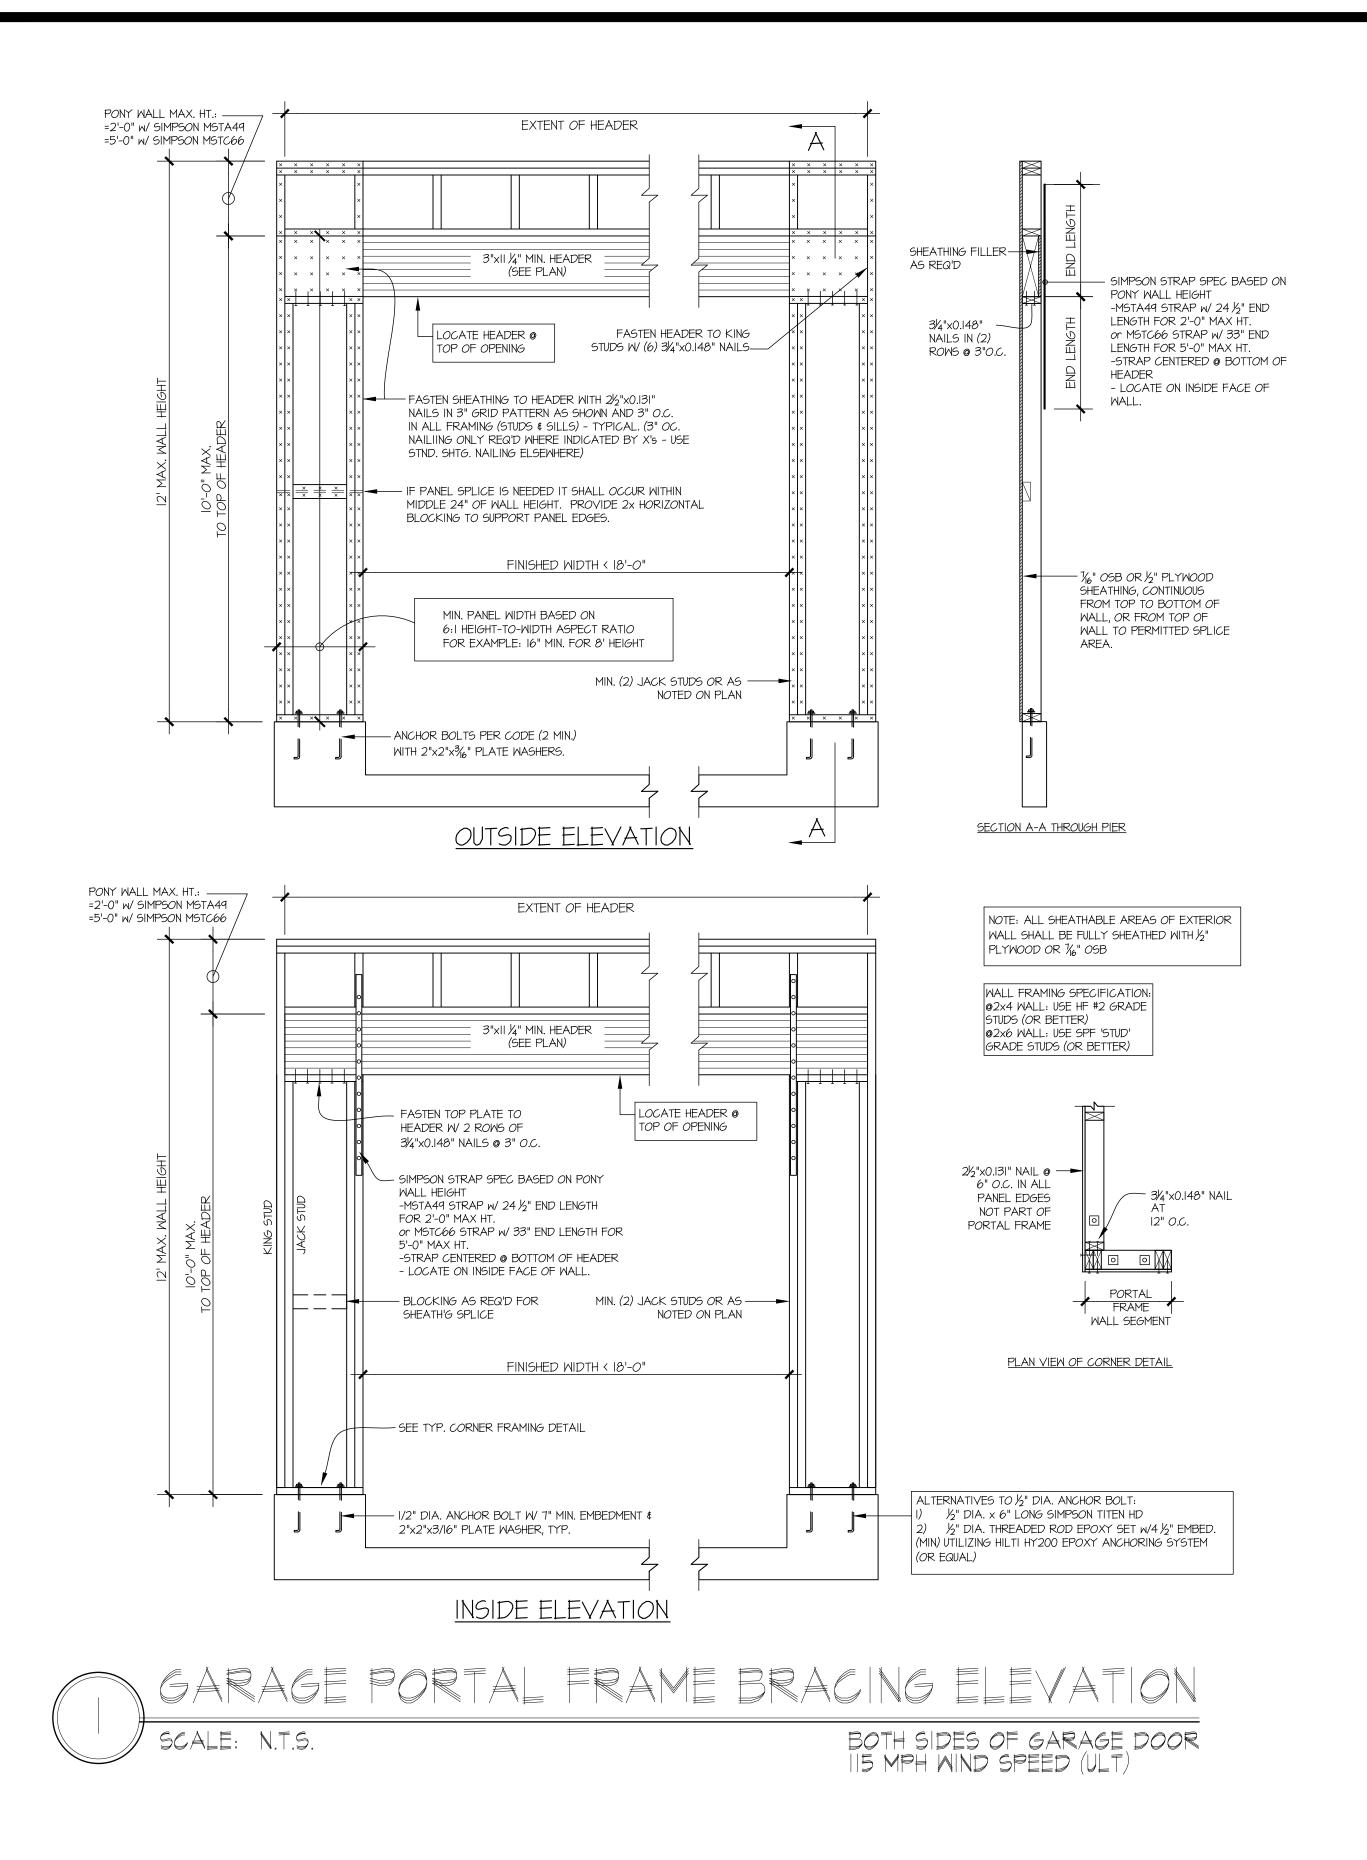


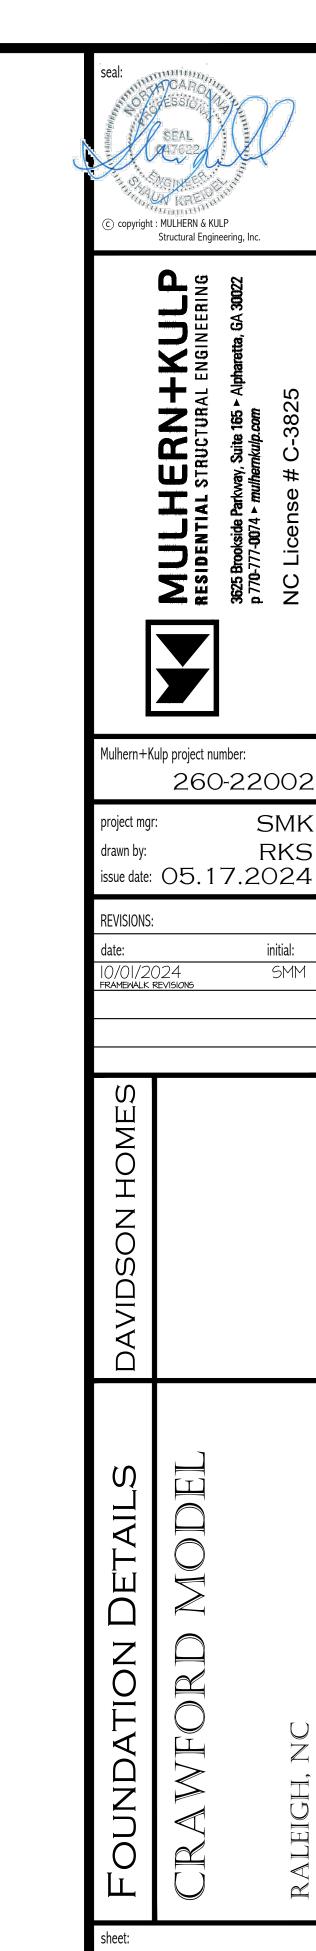

SD2.0

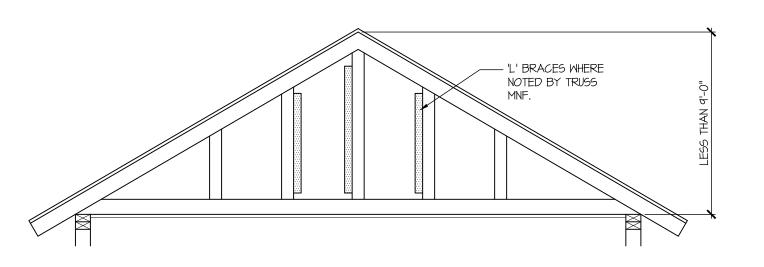


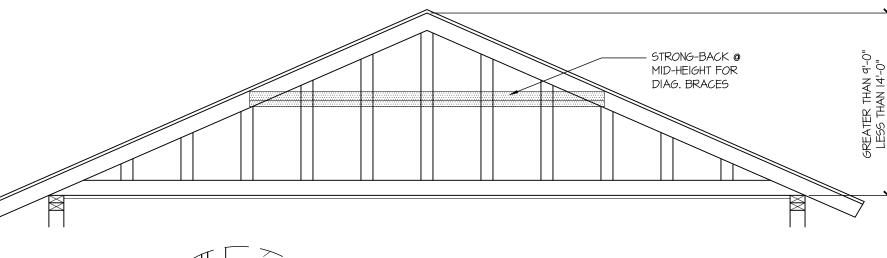

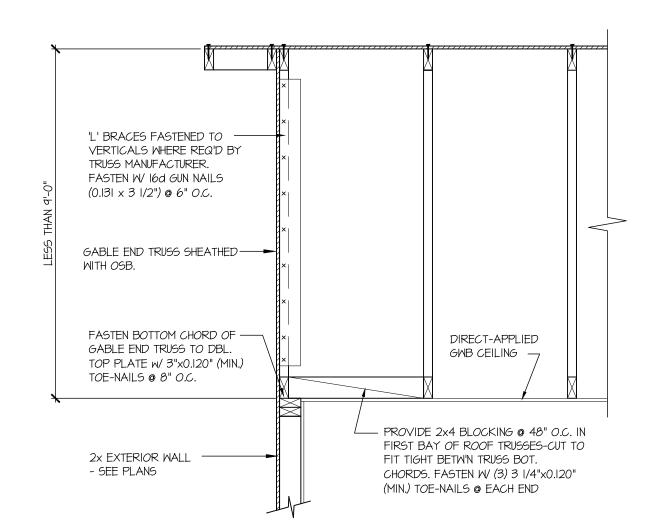




BRACE GABLE END TRUSSES PER ABOVE DETAIL WHEN GABLE HEIGHT IS LESS THAN 9'-0'. 'L' BRACES REQUIRED WHERE NOTED BY TRUSS MANUFACTURER.

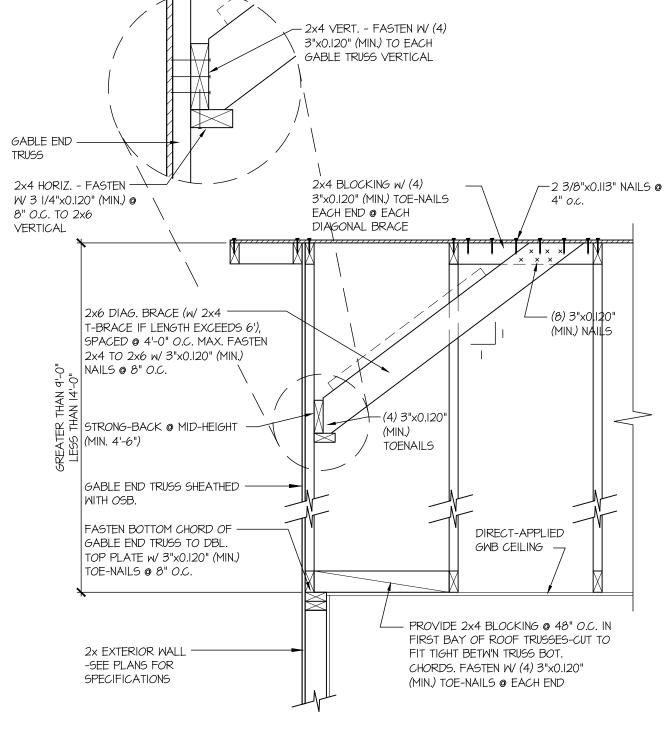


BRACE GABLE END TRUSSES PER ABOVE DETAIL WHEN GABLE HEIGHT EXCEEDS 9'-0'. 'L' BRACES NOT REQUIRED.

TYPICAL GABLE END BRACING DETAIL

HEIGHT BETW'N 9'-0" TO 14'-0"

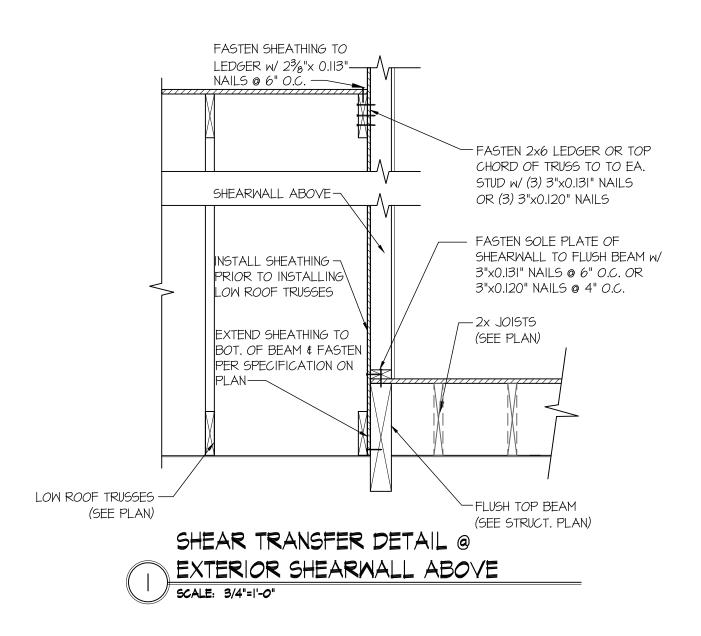

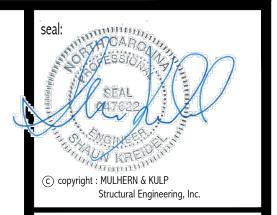

ILHERN+KUCLURAL ENGINEERIN kside Parkway, Suite 165 • Alpharetta, GA 30074 • mulhernkulp.com

RES 3625

Mulhern+Kulp project number: 260-22002

project mgr: SMK drawn by: RKS issue date: 05.17.2024

REVISIONS:


date: initial:

10/01/2024 SMM
FRAMEMALK REVISIONS

DAVIDSON HOMES

NDATION DETAILS
WEORD MODEL

SD2.1

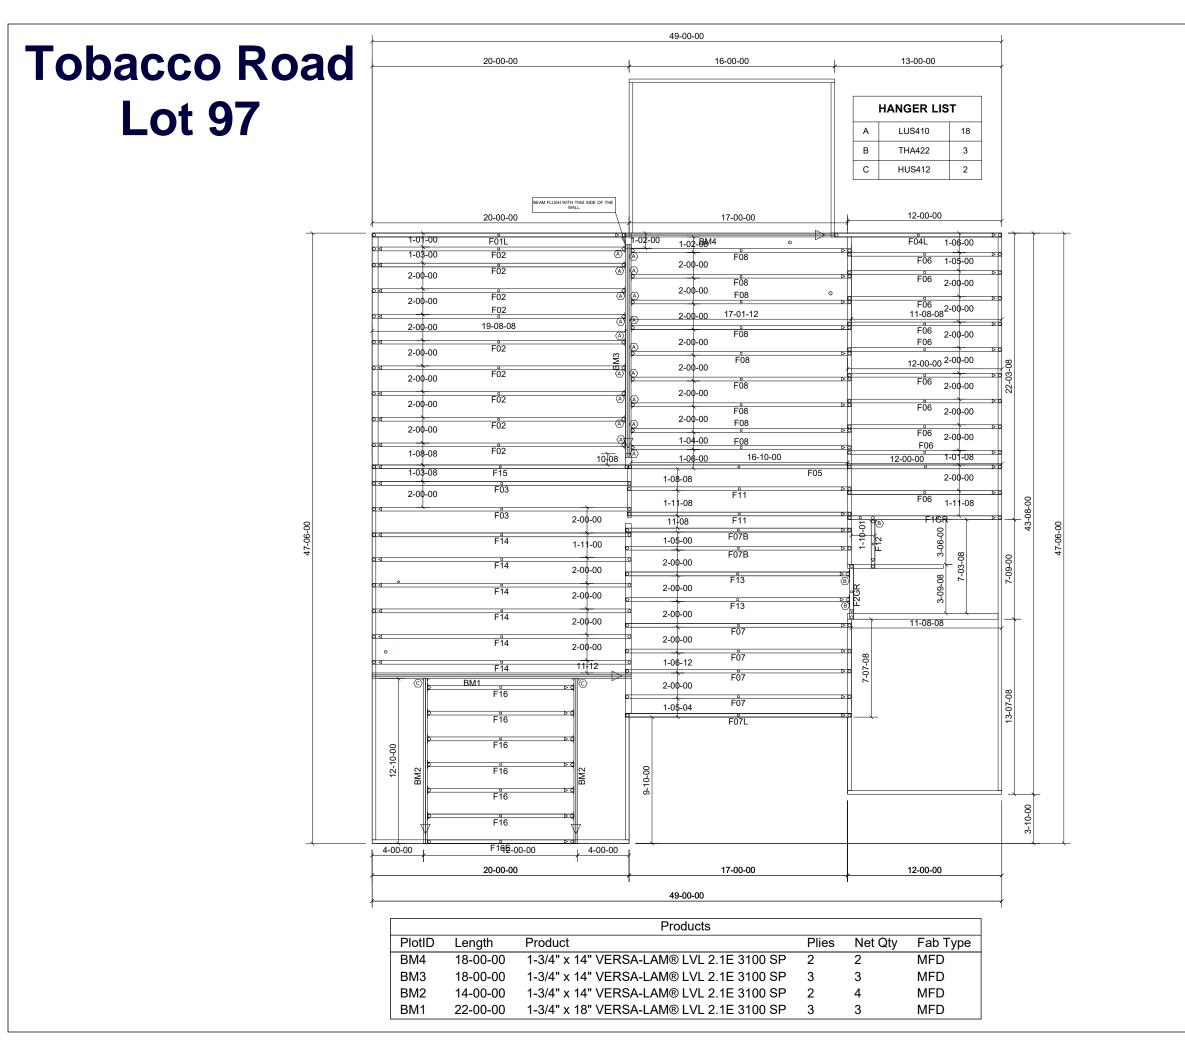


84 Components 200 Emmett Rd Dunn NC 28334 United States Office: (910) 892-8400 FLOOR P03518-26899 Road **Davidson Homes** Tobacco **CRAWFORD** #qof 2383-Dunn Location Designer James Mcintyre DO NOT CUT, NOTCH, OR BORE HOLES UNLESS SPECIFIC, WRITTEN PERMISSION IS COVIDED BY AN AUTHORIZED REPRESENTATIVE (84 LUMBER. TRUSS INSTALLATION REQUIRES TEMPORARY AN PERMANENT BRACING, GENERAL GUIDANCE IS PROVIDED IN SBCA DOC'S B-1 and B-3. THESE ARE INCLUDED WITH EACH JOI Sheet # 1 of 1 Floor Truss **Placement Plan**

NOT TO SCALE

DESIGNED DATE

6/24/2025

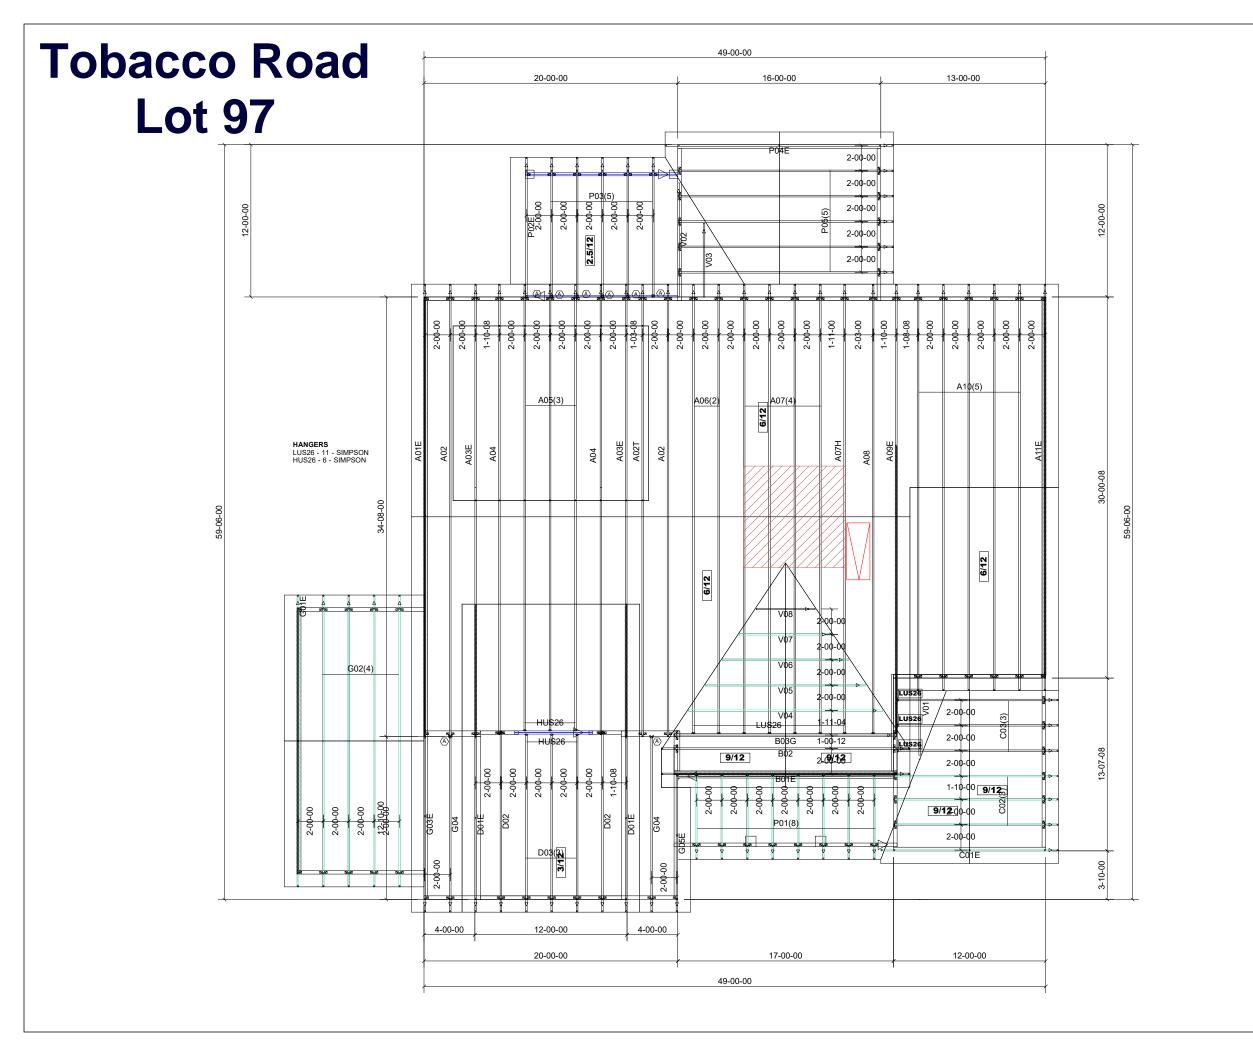



Davidson Homes

CRAWFORD

ROOF

 \mathbf{m}

P03518-26898

Location 2383-Dunn

Designer James Mcintyre

DO NOT CUT, NOTCH, OR BORE HOLES UNLESS SPECIFIC, WRITTEN PERMISSION IS ROVIDED BY AN AUTHORIZED REPRESENTATIVE OF 84 LUMBER

TRUSS INSTALLATION REQUIRES TEMPORARY AND PERMANENT BRACING, GENERAL, GUIDANCE IS PROVIDED IN SBCA DOC'S B-1 and B-3. THESE ARE INCLUDED WITH EACH JOE IN YOUR TRUSS PACKET.

Sheet # 1 of 1

Roof Truss Placement Plan

NOT TO SCALE

DESIGNED DATE

6/24/2025