
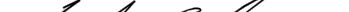
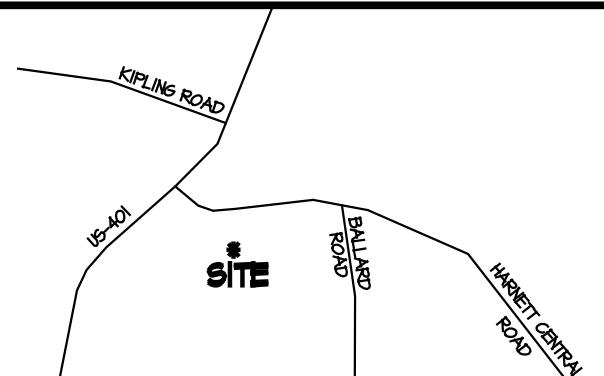


I HEREBY CERTIFY THAT THIS AS-BUILT SURVEY WAS DRAWN UNDER MY DIRECT SUPERVISION FROM AN ACTUAL FIELD-RUN SURVEY AND THAT THERE ARE NO ENCROACHMENTS UNLESS OTHERWISE SHOWN. DEED REFERENCES ARE AS DEPICTED HEREON. THE RATIO OF PRECISION OR POSITIONAL ACCURACY IS 1:10,000+ AND THAT THIS PLAT MEETS THE REQUIREMENTS OF THE STANDARD OF PRACTICE FOR LAND SURVEYING IN NORTH CAROLINA (21 NCAC 56, 1600).

  
CALEB TROY CLAYTON SR., PLS | -530


11/13/25

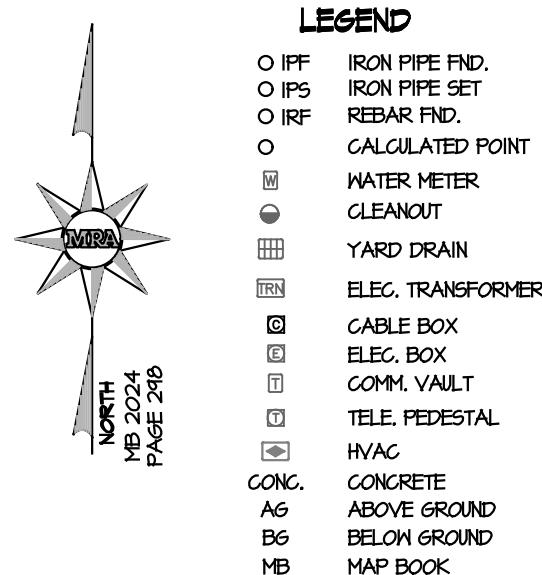

## **VICINITY MAP** (NOT TO SCALE)

## GENERAL NOTES

1. DISTANCES DEPICTED HEREON ARE GROUND DISTANCES IN U.S. SURVEY FEET. AREAS COMPUTED USING THE COORDINATE METHOD.
2. THIS SURVEY WAS PERFORMED WITHOUT BENEFIT OF CURRENT TITLE REPORT. PROPERTY DEPICTED HEREON MAY BE SUBJECT TO SUCH EASEMENTS, ETC. AS A CURRENT TITLE PACKAGE MAY DISCLOSE.
3. PLAT REFERENCE: MAP BOOK 2024, PAGES 443-447.
4. OFFSETS AND DIMENSIONS DEPICTED HEREON FROM THE PROPERTY LINES TO THE FOUNDATION OR BUILDING LINE ARE NOT INTENDED TO MONUMENT THE PROPERTY LINES AND ARE NOT TO BE USED TO GUIDE OR ASSIST IN THE ERECTION OF FENCES, STRUCTURES, OR ANY OTHER IMPROVEMENTS.
5. ALL PROPERTY CORNERS FOUND ARE 5/8" IRON PIPES (OR REBAR) FLUSH WITH THE EXISTING GROUND AT THE TIME OF SURVEY UNLESS OTHERWISE NOTED HEREON.
6. ALL PROPERTY CORNERS SET ARE 5/8" IRON PIPES SET FLUSH WITH THE EXISTING GROUND AT THE TIME OF SURVEY UNLESS OTHERWISE NOTED HEREON.
7. ADJOINING OWNER INFORMATION TAKEN FROM DEEDS AND MAPS OF RECORD.
8. SETBACKS: FRONT - 25'  
                  SIDE - 10'  
                  REAR - 20'
9. PER RECORDED MAP, PORTION OF PROPERTY IS NOT LOCATED WITHIN SPECIAL FLOOD HAZARD AREA PER F.I.R.M. FLOOD RATE INSURANCE MAP NO. 3120064200J, BEARING EFFECTIVE DATE OF 10/03/2006.
10. ZONING - RA-20R
11. DATE OF FIELD SURVEY: 11/06/2025
12. SURFACE LOCATIONS OF UTILITIES DEPICTED HERON. U/G UTILITIES NOT SURVEYED.
13. 10' STREET TREE & HRW EASEMENT SHOWN HERON PER SUBDIVISION PLAT "KIPLING VILLAGE, PHASE 1B" IS NOT SPECIFIED AS PUBLIC OR PRIVATE. AN ATTORNEY SHOULD BE CONTACTED FOR ANY ISSUES OR CLARIFICATIONS.

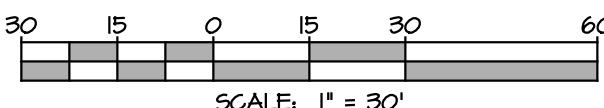

SCALE: 1" = 30'



**MORRIS & RITCHIE ASSOCIATES OF NC, PC**  
ENGINEERS, ARCHITECTS, PLANNERS, SURVEYORS AND  
LANDSCAPE ARCHITECTS  
530 HINTON POND ROAD, SUITE 104  
KNIGHTDALE, NORTH CAROLINA 27545  
(984) 200-2103  
LICENSE # C-4182, G-492  
MRAGTA.COM  
© 2005 MORRIS & RITCHIE ASSOCIATES, INC.

FOUNDATION AS-BUILT SURVEY  
LOT 20 - #287 SOUTH BREEZE WAY  
KIPLING VILLAGE - PHASE 1B  
HARNETT COUNTY-FUQUAY-VARINA-NORTH CAROLINA

SURVEYED FOR: RYAN HOMES - RALEIGH  
5134 TRINITY ROAD, SUITE 200  
RALEIGH, NC 27607

CALEB TROY CLAYTON SR., PLS | -5306

SCALE: 1"

DATE: 11/10/2025

DRAWN BY: GDM

REVISED.

REVIEW BY: GTG

JOB NO. : 21103