





Guilford Georgian

Trademark Series

Lot: 56 | Duncans Creek
570 Beacon Hill Road
Lillington, NC 27546



New Home Inc
1611 Jones Franklin,
Raleigh, NC, 27606

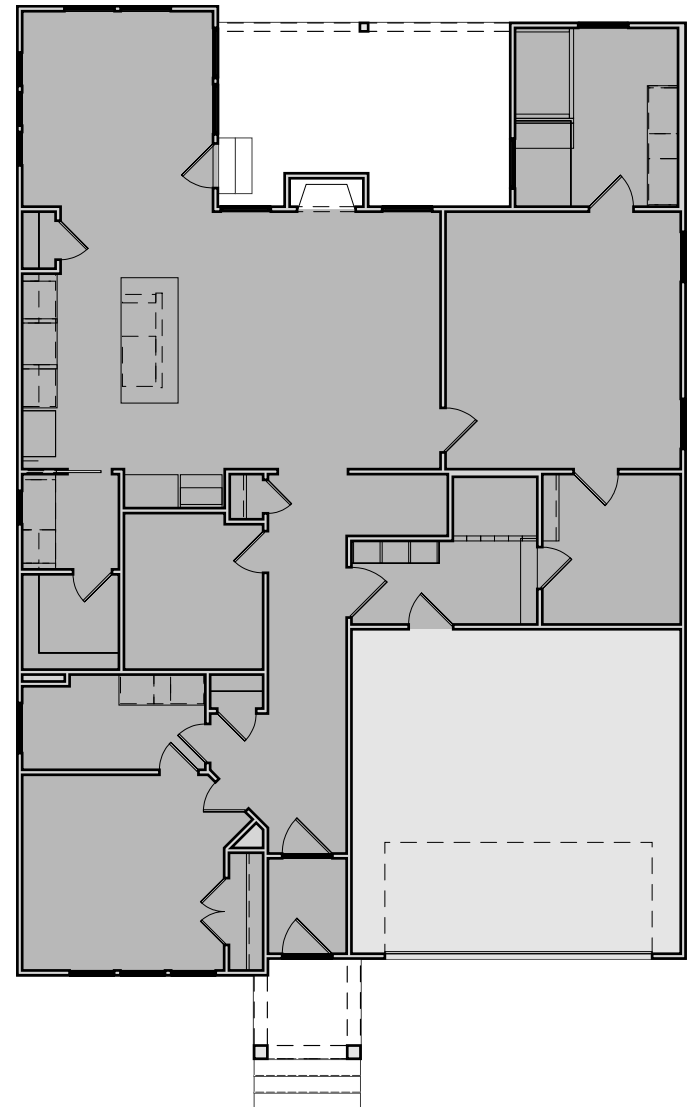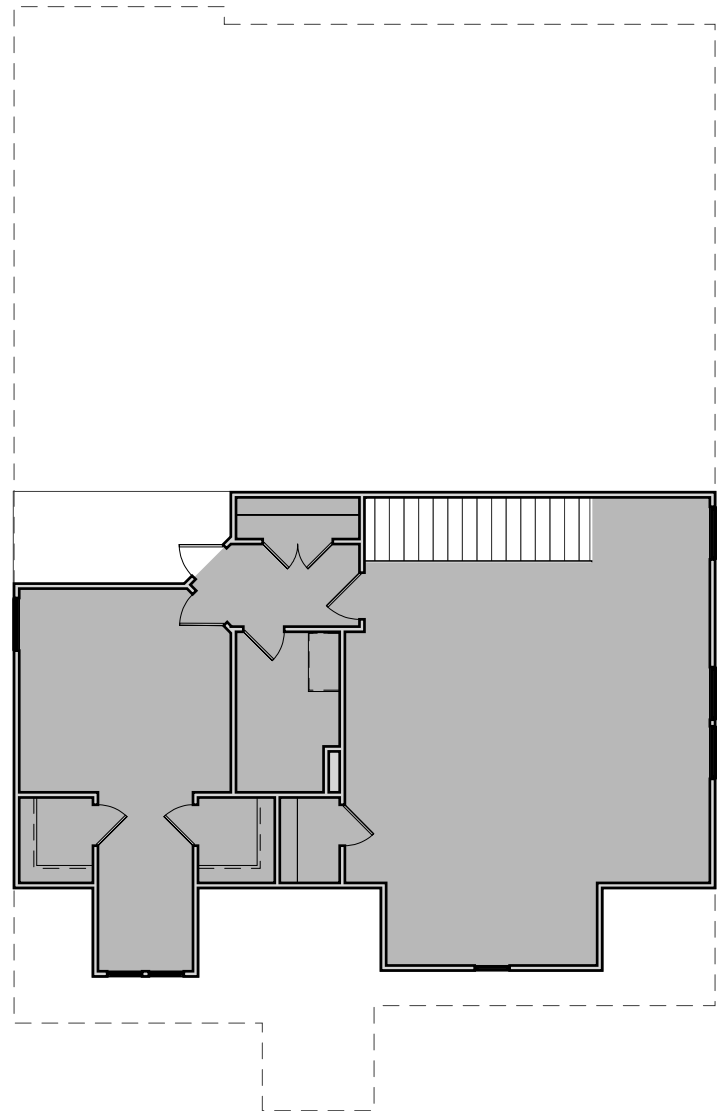SHEET INDEX		OPTIONS		BUILDING CODES		1ST FLOOR AREA	
Name	Number	OPTION SET	SELECTION	BUILDING CODES			
Cover Sheet	G-100	Owner's Bath Shower	4 2x 42 Shower, Seat & Bathtub	...			
General Notes & Specifications Instance	G-110	Cafe Room	Add Cafe Room	...			
Foundation Plan	A-100	Entry Hall Opening (Level 2)	Additional 28/ 68 Door	...			
First Floor Plan	A-110	Cafe Windows	Additional Window	...			
Second Floor Plan	A-120	Bed 3 to Bath 2	Bed 3 to Bath 2	...			
Roof Plan	A-200	Laundry Room Access	Connected Laundry Door to Owner 's Suite				
Elevations - Front and Back	A-310	Rear Addition	Covered Patio	BUILDING INFO			
Elevations - Left and Right	A-320	~Foundation Type	Crawlspace				
First Floor Electrical Plan	E-110	Kitchen Range	Gas Range				
Second Floor Electrical Plan	E-120	Elevation	Georgian				
Perspectives	P-100	Second Floor Plan	Georgian				
		Kitchen Type	Gourmet Kitchen				
		Bedroom 2 Optionals	Messy Kitchen & Pocket Office				
		Messy Kitchen Sink	Messy Kitchen Sink				
		Messy Kitchen Window	Messy Kitchen Window				
		Messy Kitchen Door	Pocket Door				
		Living Room Fireplace	Rear Fireplace				
		Smart Door Delivery Center	Smart Door Delivery Center				
		Owner's Bath Window	Window at Bath				
						UNCONDITIONED AREA	
						TOTAL UNCONDITIONED AREA	685 SF
		Garage Area	394 SF				
		Covered Patio Area	193 SF				
		Front Porch Area	37 SF				
		TOTAL AREA					
		TYPE	TOTAL AREA				
		TOTAL CONDITIONED AREA	2561 SF				
		TOTAL UNCONDITIONED AREA	685 SF				
		TOTAL UNDER ROOF	3246 SF				

DESCRIPTION	
REV.#	
1	
2	
3	
4	
5	
6	
7	
8	

Lot 56: Guilford Georgian at Duncans Creek

Cover Sheet

DRAWN BY:
JJ/DREW

HANDING:
RIGHT

ISSUE DATE:
11/11/1111

SHEET

G-100

DATE							
------	--	--	--	--	--	--	--

DESCRIPTION							
REV.#	1	2	3	4	5	6	7
REV.#	8						

Lot 56: Guilford Georgian at Duncans Creek

Cover Sheet


DRAWN BY: JJ/DREW
HANDING: RIGHT
ISSUE DATE: 11/11/1111
SHEET G-100

GENERAL NOTES AND SPECIFICATIONS: 1 GENERAL DATA PROJECT DESCRIPTION: THIS PROJECT IS FOR THE CONSTRUCTION OF A NEW SINGLE-FAMILY RESIDENCE, AND ASSOCIATED SITE WORK. TYPICAL NOTES: ALL WORK TO BE COORDINATED AND SCHEDULED BY THE OWNER. ALL WORK, INCLUDING PLUMBING, HVAC AND ELECTRICAL WORK NOT DETAILED HEREIN, SHALL COMPLY WITH APPLICABLE STATE AND LOCAL BUILDING CODES AND THE BUILDING STANDARDS REFERENCED THEREIN. ALL WORK SHALL CONFORM TO THE HIGHEST LEVELS OF THE APPROPRIATE INDUSTRY STANDARDS FOR CUSTOM WORK. ALL ITEMS SPECIFIED HEREIN ARE TO BE USED WITHOUT SUBSTITUTION. IF THESE NOTES CONFLICT WITH THE OWNERS SCOPE OF WORK DOCUMENTS, THE NOTES HEREIN SHALL GOVERN AND TAKE PRECEDENT. THE STRUCTURE IS DESIGNED TO BE SELF-SUPPORTING AND STABLE AFTER THE BUILDING IS FULLY COMPLETE. IT IS SOLELY THE CONTRACTORS RESPONSIBILITY TO ENSURE THE SAFETY OF THE BUILDING AND ITS COMPONENT PARTS DURING ERECTION. THIS INCLUDES THE ADDITION OF TEMPORARY BRACING THAT MAY BE REQUIRED. IT IS SOLELY THE CONTRACTOR'S RESPONSIBILITY TO FOLLOW ALL APPLICABLE SAFETY CODES AND REGULATIONS DURING ALL PHASES OF CONSTRUCTION. PLAN DIMENSIONS ARE TO FACE OF ROUGH FRAMING OR MASONRY UNLESS NOTED OTHERWISE. DIMENSIONS TO EXTERIOR WALLS INCLUDE 7/16" OSB WALL SHEATHING WITH WATER-RESISTIVE BARRIER, ROUNDED TO THE NEAREST 1/4". FINISH FLOOR ELEVATION @ FIRST FLOOR LEVEL IS SET AT 0'-0". SEE SITE PLAN FOR ACTUAL FIRST FLOOR ELEVATION @ EACH BUILDING. ALL @ INTERIOR PARTITIONS SHALL BE 2x4 STUDS @ 16" O.C. WITH 1/2" DRYWALL EACH SIDE. PLAN DIMENSION IS ASSUMED TO BE 3 1/2" UNLESS NOTED OTHERWISE. PROVIDE SOLID LUMBER BLOCKING FOR ALL WALL MOUNTED ITEMS. SUBSTRATE (BACKER) FOR TILE IN SHOWERS/TUBS SHALL BE FIBER-CEMENT OR SIMILAR PER APPLICABLE CODE. ALL INTERIOR COLORS AND FINISHES, NOT SPECIFIED HEREIN, TO BE SELECTED BY THE OWNER. 2 SITE CONSTRUCTION CONTRACTOR OR EXCAVATOR MUST CONTACT THE APPROPRIATE UTILITIES PROTECTION SERVICE AT LEAST 48 HOURS BUT NO MORE THAN 10 WORKING DAYS BEFORE BEGINNING ANY DIGGING PROJECT. SOILS BEARING PRESSURE AS INDICATED ON THE STRUCTURAL ENGINEERING PLANS BY OTHER. 3 CONCRETE REFER TO STRUCTURAL ENGINEERING PLANS BY OTHER. SEE OWNER SCOPE OF WORK DOCUMENTS FOR ADDITIONAL REQUIREMENTS. 4 MASONRY STONE /ENEER IF USED) TO BE MANUFACTURED STONE - REFER TO OWNERS SCOPE OF WORK DOCUMENT FOR MATERIAL SELECTION AND COLORS. BRICK ACCENTS (IF USED) TO BE FULL SIZE UNITS, CUT TO THICKNESS OR SHAPE REQUIRED FOR THE SPECIFIC USE. REFER TO THE OWNERS SCOPE OF WORK DOCUMENT FOR MATERIAL SELECTION AND COLORS. 5 METALS REFER TO STRUCTURAL ENGINEERING PLANS BY OTHER. 6 WOOD & PLASTICS PROVIDE SOLID BLOCKING FOR ALL WALL MOUNTED ITEMS INCLUDING: • CABINETS & SHELVES CLOSET RODS • MIRRORS AND BATH ACCESSORIES FRAMING LUMBER IN CONTACT WITH CONCRETE OR MASONRY OR EXPOSED TO THE EXTERIOR SHALL BE PRESERVATIVE PRESSURE TREATED. ANY WOOD, INCLUDING EXTERIOR SHEATHING, WITHIN 6" OF FINISHED GRADE SHALL BE PRESERVATIVE-PRESSURE TREATED. ANY WOOD, INCLUDING EXTERIOR WALL SHEATHING, LESS THAN 2" VERTICALLY FROM CONCRETE STEPS, PORCH SLABS, PATIO SLABS AND SIMILAR HARD HORIZONTAL SURFACES SHALL BE PRESERVATIVE PRESSURE TREATED. PROTECTION OF WOOD AND WOOD-BASED PRODUCTS AGAINST DECAY AS REQUIRED BY R317. PROTECTION AGAINST TERMITES AS REQUIRED BY R318. FIRE BLOCKING TO COMPLY WITH R302.11. REFER TO STRUCTURAL ENGINEERING PLANS BY OTHER.		CABINETS AND COUNTERTOPS REFER TO OWNERS SCOPE OF WORK DOCUMENTS FOR CABINET, COUNTERTOP AND HARDWARE SELECTIONS. INTERIOR TRIM OF REFER TO OWNERS SCOPE OF WORK DOCUMENTS FOR REQUIRED INTERIOR TRIM PROFILES. 7 THERMAL & MOISTURE PROTECTION WATER BARRIER THE WATER BARRIER SYSTEM IS AN INTEGRAL PART OF THE WALL SHEATHING SYSTEM. THERMAL INSULATION • INSULATION TO HAVE THE FOLLOWING MINIMUM R-VALUES: • EXTERIOR WALLS R=15 MIN. • SLOPED CEILINGS (WITH ATTIC SPACE) R=38 OR R=30 WHEREVER THE FULL HEIGHT OF UNCOMPRESSED R=38 INSULATION EXTENDS OVER THE WALL TOP PLATE AT THE EAVES. • SLOPED CEILINGS (WITHOUT ATTIC SPACE) R=38 MIN., OR R=30 MIN. WHERE THERE IS NOT SUFFICIENT SPACE FOR REQ'D INSULATION. • FLAT CEILINGS (WITH ATTIC SPACE) R=38 OR R=30 WHEREVER THE FULL HEIGHT OF UNCOMPRESSED R=38 INSULATION EXTENDS OVER THE WALL TOP PLATE AT THE EAVES. • FLOORS R=19 MIN. • REFER TO OWNERS SCOPE OF WORK DOCUMENTS FOR INSULATION TYPES AND ADDITIONAL REQUIREMENTS. ARCHITECTURAL SHINGLE ROOFING - SHINGLE ROOFING SHALL BE DIMENSIONAL ASPHALT TYPE WITH DIMENSION FEATURES. SEE OWNERS SCOPE OF WORK DOCUMENTS FOR MANUFACTURER, STYLE, COLOR AND ADDITIONAL REQUIREMENTS FOR INSTALLATION AND ACCESSORIES. • SHINGLES SHALL BE TESTED IN ACCORDANCE WITH AST D 7185. • SHINGLES SHALL MEET THE CLASSIFICATION REQUIREMENTS FOR THE APPROPRIATE MAXIMUM BASIC WIND SPEED: MAXIMUM BASIC WIND SPEED CLASSIFICATION REQUIREMENT • REFER TO STRUCTURAL ENGINEERING PLANS BY OTHER. • ROOFING SHALL BE INSTALLED OVER ONE LAYER OF ASPHALT IMPREGNATED 15# ROOFING FELT. 2 LAYERS FOR ROOF PITCHES 2:12 - 4:12. VALLEY LININGS TO BE INSTALLED PER R905.2.8.2 GUTTERS TO BE MINIMUM 5" ALUMINUM OGEE STYLE WITH 4" CORRUGATED RECTANGULAR ALUMINUM DOWNSPOUTS AT LOCATIONS AS INDICATED ON THE DRAWINGS. DOWNSPOUTS TO BE CONNECTED TO UNDERGROUND STORM PIPING AND ROUTED TO DISCHARGE LOCATIONS AS SPECIFIED BY THE GENERAL CONTRACTOR. 12" WIDE (2" THICKNESS) RIGID FOAM LOCATED AT TOP OF FOOTER, SLOPING AWAY FROM THE UNIT TO PREVENT CONCRETE OVERFLOW AND ALLOW PIPE TO TIGHTLY FIT TO STEM WALL. UNDERGROUND DRAINPIPES TO BE PROVIDED AT ALL COURTYARD SLAB CUTOUT LANDSCAPE AREAS TO PREVENT POOLING WATER. LAP SIDING - REFER TO OWNERS SCOPE OF WORK DOCUMENTS FOR MATERIAL, MANUFACTURER, STYLE, COLOR AND OTHER REQUIREMENTS. EXTERIOR TRIM & SOFFITS - REFER TO OWNERS SCOPE OF WORK DOCUMENTS FOR MATERIAL, MANUFACTURER, STYLE, COLOR AND OTHER REQUIREMENTS. PROVIDE EXTERIOR TRIM OF SIZES INDICATED ON THE DRAWINGS. 8 DOORS & WINDOWS EXTERIOR PATIO DOORS AND SLIDING PATIO DOORS - REFER TO OWNERS SCOPE OF WORK DOCUMENTS FOR MANUFACTURER, STYLE COLOR AND HARDWARE SELECTIONS. • SIZES AS INDICATED ON THE DRAWINGS. • ALL DOORS TO HAVE LOW-E GLASS SAFETY GLAZING. INTERIOR DOORS - REFER TO OWNERS SCOPE OF WORK DOCUMENTS FOR DOOR TYPE, STYLE AND HARDWARE SELECTIONS. SIZES AS INDICATED ON THE DRAWINGS. WINDOWS - REFER TO OWNERS SCOPE OF WORK DOCUMENTS FOR WINDOW MANUFACTURER, STYLE, COLOR AND HARDWARE SELECTIONS. • SIZES AS INDICATED ON THE DRAWINGS. • ALL WINDOWS TO HAVE LOW-E INSULATING GLASS • WINDOW MANUFACTURER SHALL PROVIDE TEMPERED GLASS AS REQUIRED BY R308.4 AT ALL HAZARDOUS LOCATIONS. • WINDOW FALL PROTECTION AS REQUIRED BY R312.2. • WRITTEN INSTALLATION INSTRUCTIONS SHALL BE PROVIDED BY THE WINDOW MANUFACTURER FOR EACH WINDOW - SEE FULL INSTRUCTIONS FOR ALL ADDITIONAL REQUIREMENTS. • ALL BEDROOM WINDOWS TO MEET EMERGENCY RESCUE OPENING CODE REQUIREMENTS. • WINDOW TRIM TO BE OFFSET MIN. 1/4" WHERE WINDOW MEETS TRIM FOR CAULKING. COORDINATE WITH WINDOW SELECTION. PAD OUT THE TRIM IF NEEDED. • TRIM MATERIAL PER OWNERS SCOPE OF WORK DOCUMENTS. SIZES AS INDICATED ON THE DRAWINGS. • SEE CURRENT BUILDING CODE FOR ALL ADDITIONAL REQUIREMENTS. 9 FINISHES DRYWALL WALLS AND CEILINGS- REFER TO OWNERS SCOPE OF WORK DOCUMENTS FOR REQUIRED DRYWALL FINISHES. • PROVIDE TYPE-X GYPSUM PANELS AT LOCATIONS INDICATED ON THE DRAWINGS FOR FIRE-RATED ASSEMBLIES. • ALL BATHROOMS TO HAVE MOISTURE-RESISTANT, PAPERLESS GYPSUM. • PROVIDE 1/2" TILE BACKER BOARD IN LIEU OF DRYWALL AT ALL WALL LOCATIONS REQUIRING A TILE FINISH. INTERIOR FINISHES - REFER TO OWNERS SCOPE OF WORK DOCUMENTS FOR ALL INTERIOR FLOOR, WALL AND CEILING FINISHES.	10 SPECIALTIES BATH ACCESSORIES - REFER TO OWNERS SCOPE OF WORK DOCUMENTS FOR REQUIRED BATH ACCESSORIES. FIREPLACE - REFER TO OWNERS SCOPE OF WORK DOCUMENTS FOR FIREPLACE REQUIREMENT AND SELECTIONS. CLOSET ROODS AND SHELVING - REFER TO OWNERS SCOPE OF WORK DOCUMENTS FOR REQUIREMENTS AND SELECTIONS. 11 EQUIPMENT APPLIANCES - REFER TO OWNERS SCOPE OF WORK DOCUMENTS FOR APPLIANCE SELECTIONS. 12 FURNISHINGS SECTION NOT USED 13 SPECIAL CONSTRUCTION SECTION NOT USED 14 CONVEYING SYSTEMS SECTION NOT USED 22 PLUMBING REFER TO PLUMBING PLANS BY OTHERS. 23 HVAC REFER TO HVAC PLANS BY OTHERS. 26 ELECTRICAL REFER TO ELECTRICAL PLANS BY OTHERS.	NEW HOME INC. New Home Inc 1611 Jones Franklin, Raleigh, NC, 27606 <table><tr><th rowspan="2">REV.#</th><th colspan="8">DESCRIPTION</th><th rowspan="9">DATE</th></tr><tr><th>1</th><th>2</th><th>3</th><th>4</th><th>5</th><th>6</th><th>7</th><th>8</th></tr><tr><td colspan="10">Lot 56: Guilford Georgian at Duncans Creek</td></tr><tr><td colspan="10">General Notes and Specifications</td></tr><tr><td colspan="10">DRAWN BY: JJ/DREW</td></tr><tr><td colspan="10">HANDING: RIGHT</td></tr><tr><td colspan="10">ISSUE DATE: JJ/DREW</td></tr><tr><td colspan="10">SHEET</td></tr><tr><td colspan="10">G-110</td></tr></table>	REV.#	DESCRIPTION								DATE	1	2	3	4	5	6	7	8	Lot 56: Guilford Georgian at Duncans Creek										General Notes and Specifications										DRAWN BY: JJ/DREW										HANDING: RIGHT										ISSUE DATE: JJ/DREW										SHEET										G-110									
REV.#	DESCRIPTION								DATE																																																																																			
	1	2	3	4	5	6	7	8																																																																																				
Lot 56: Guilford Georgian at Duncans Creek																																																																																												
General Notes and Specifications																																																																																												
DRAWN BY: JJ/DREW																																																																																												
HANDING: RIGHT																																																																																												
ISSUE DATE: JJ/DREW																																																																																												
SHEET																																																																																												
G-110																																																																																												

GENERAL FLOOR PLAN NOTES:

General Floor Plan Notes shall apply unless noted otherwise on plan.

1. Wall Heights: Typically 9'-1 1/2" at first floor and second floor, and 9'-1 1/2" at attics U.N.O. All walls are constructed using a double top plate. Splices at Double Top Plate do not need to occur at Vertical Studs but must be at least 24" apart from Joint in other Top Plate layer. Special wall heights are noted on plans where they occur.
2. Wall Thickness is typically 3 1/2". 2x6 frame shall be used at walls that back up to plumbing fixtures. Walls greater than 10' high shall be framed with 2x6 framing or greater and will be noted as a special condition where it occurs on plan.
3. Typical header height shall be 7'-8" AFF at First Floor, and 7'-4" AFF at Second Floor U.N.O.
4. Jacks: Openings up to 3'-4" wide shall have (1) 2x4 jack stud SPF on each side. Openings greater than 3'-4" wide shall have (2) 2x4 jack studs SPF on each side.
5. Soffits, Coffered Ceilings, Trey Ceilings and other significant ceiling plan elements are shown on the floor plans and are denoted as single dashed lines. Unless specifically call out as included, Kitchens include soffits over wall cabinetry.
6. Door & Window Frames, where occurring near corners, shall be a minimum of 4 1/2" from corner. Except for walk-in closets with doors near a corner, doors at closets shall be centered on closet.
7. Windows: Shall have at least (1) window in each sleeping room, that meets egress. Shall be provided with tempered glass at hazardous glazing areas. False windows shall be installed with obscure glazing.
8. Closets for clothing or coat storage shall be equipped with 1 rod/shelf. Closets for linen shall have 4 open equal shelves. Closets for pantries shall have 4 equal wood shelves, painted.
9. Stair treads shall be a min of 9" deep, risers shall be a maximum of 8 1/4", unless noted otherwise, per the current North Carolina Residential Code.
10. Handrails and Guards at stairs shall be 34" above the finished surface of the ramp surface of the stair. Handrails at landings and overlooks of multilevel spaces shall be 36" above finished floor. Guards (pickets or balusters) shall be spaced with no more than 4" between guards.
11. Attic Access shall be provided at all attic area with a height greater than 30". Minimum clear attic access shall be 20" x 30". Pull down stairs and access doors in knee walls meeting minimum criteria are also acceptable.
12. Garage Door to Living Space shall be 2'-8" x 6'-8" minimum size and shall be 20 minute fire rated and weather sealed.
13. Garage Walls, as a minimum, shall be separated from living space by installing 1/2" gypsum board on the garage side of the wall. With habitable space above, the inside of all garage walls require 1/2" GWB supporting 5/8" type X GWB on ceiling.

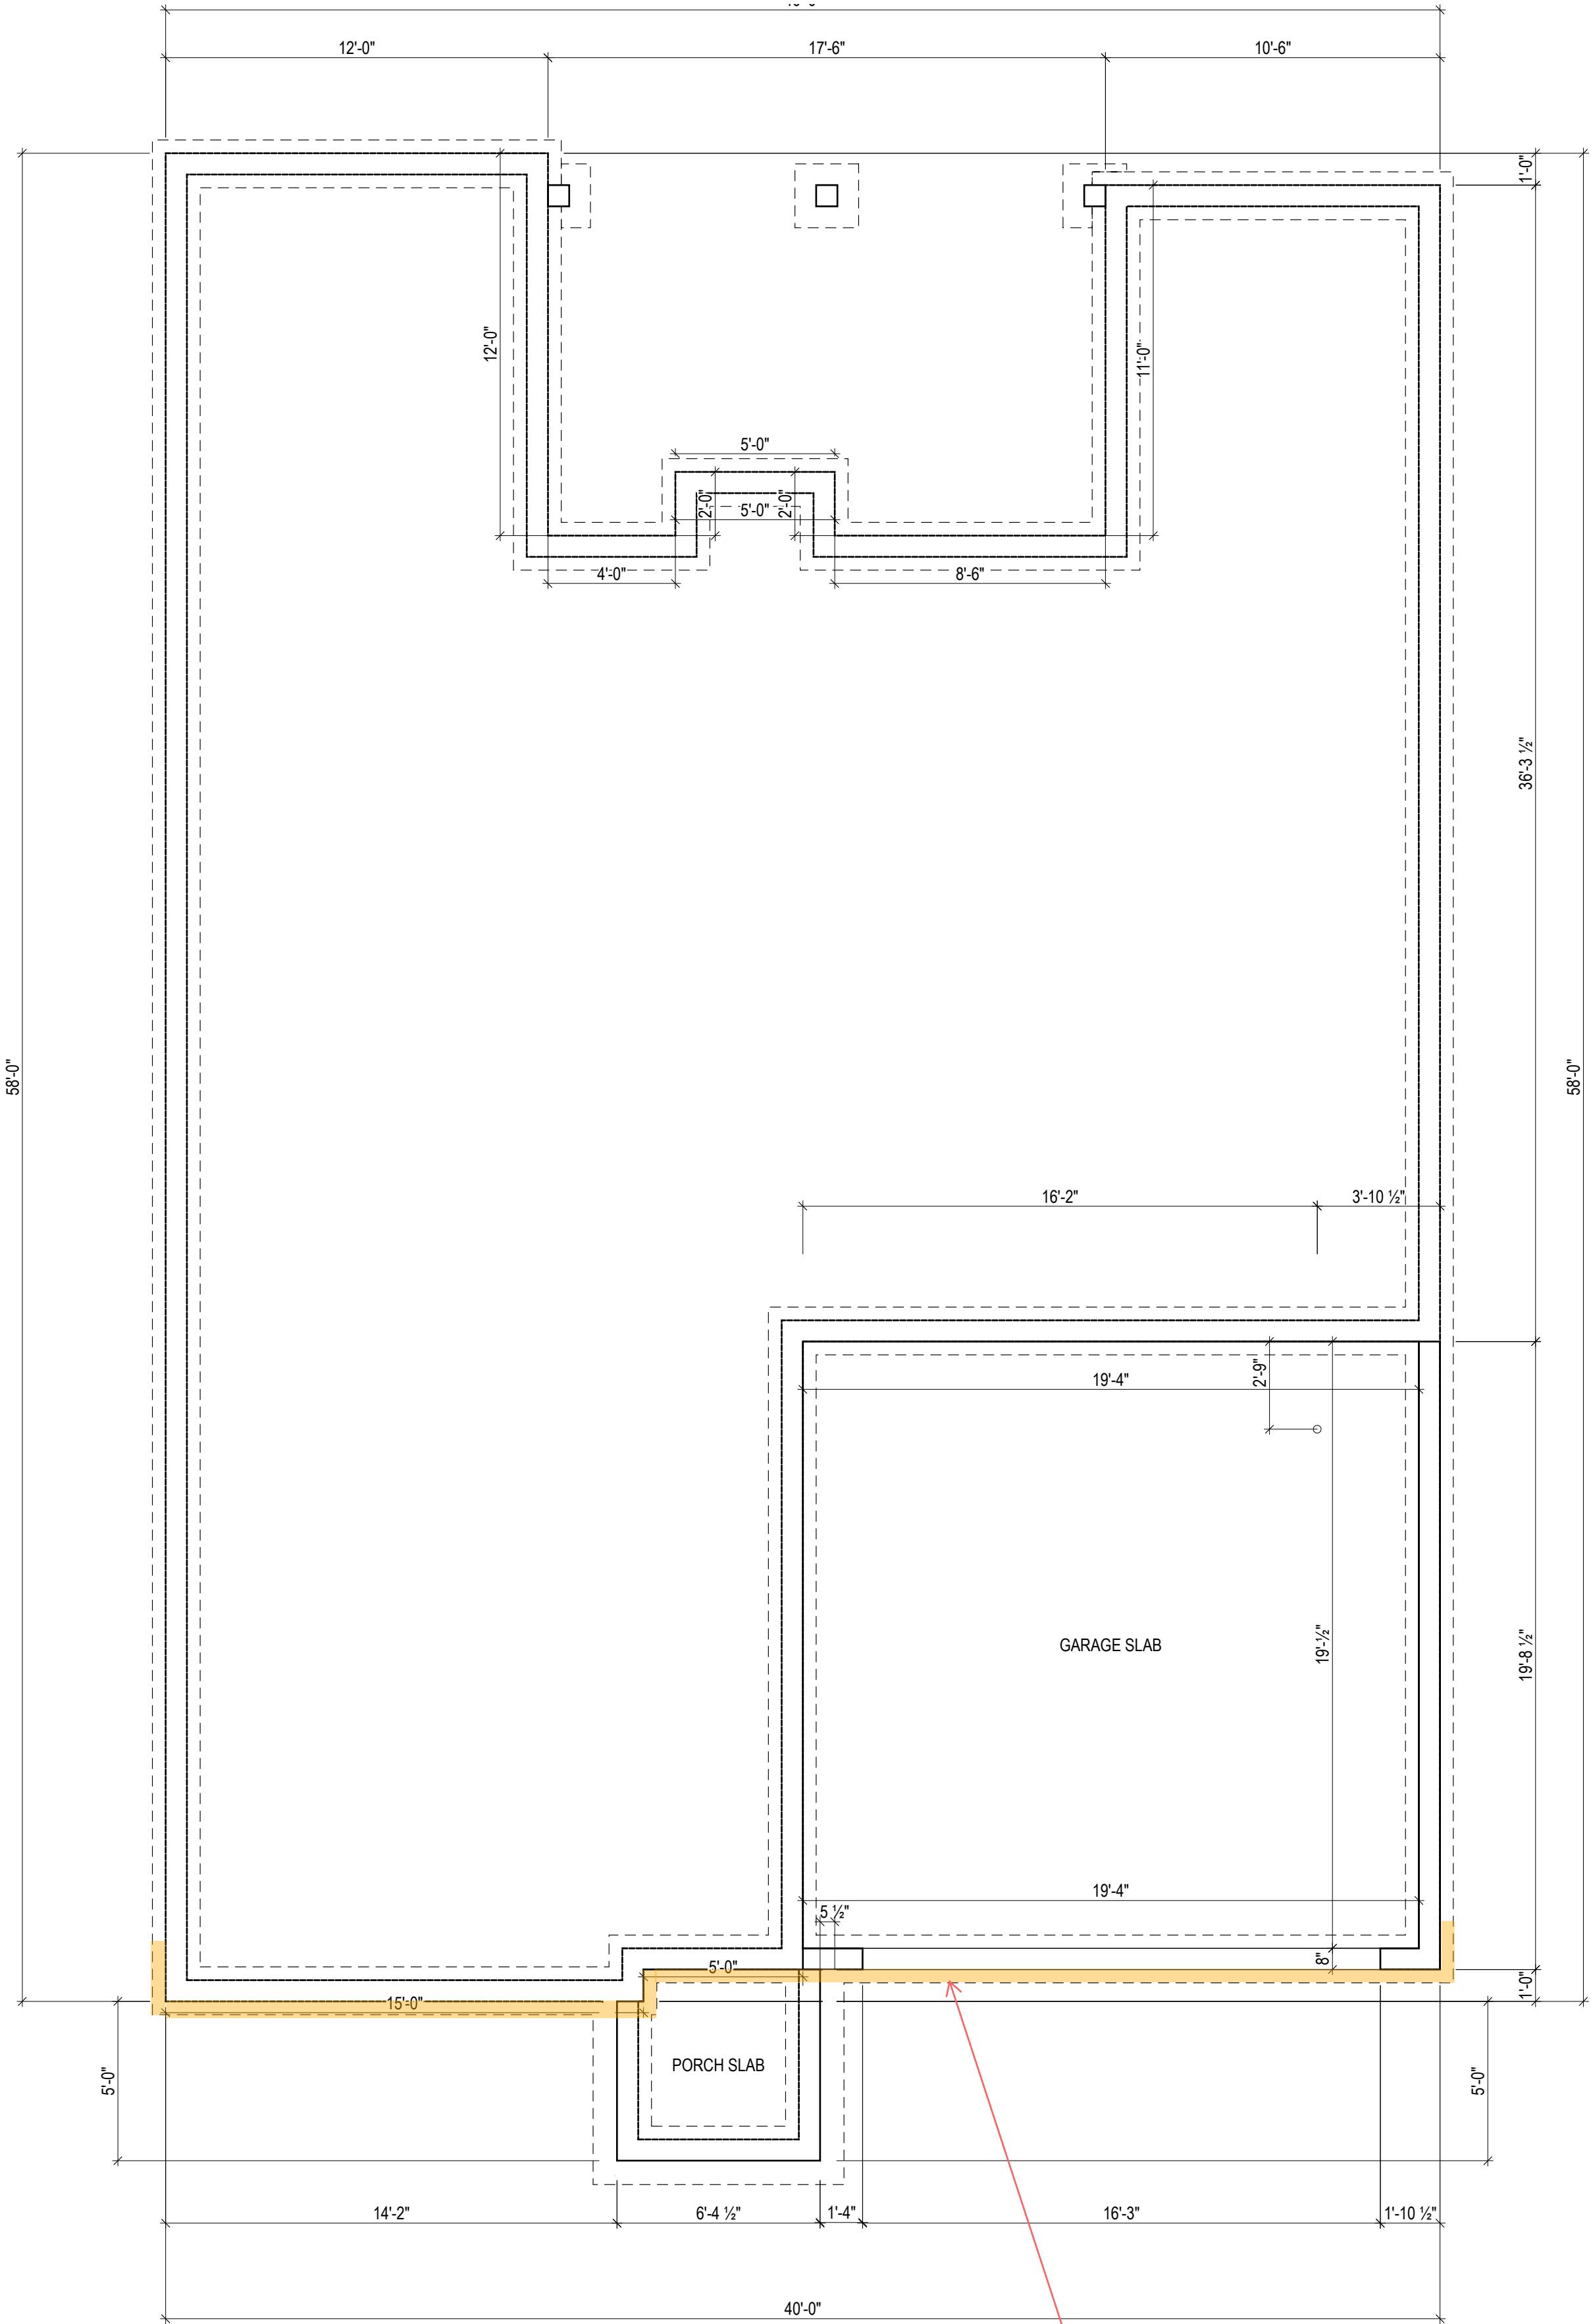

1 FOUNDATION PLAN - Crawlspace
1/4" = 1'-0" (WHEN PRINTED ON 22x34)
1/8" = 1'-0" (WHEN PRINTED ON 11x17)



New Home Inc

1611 Jones Franklin,
Raleigh, NC, 27606

DESCRIPTION		DATE
REV.#	1	
	2	
	3	
	4	
	5	
	6	
	7	
	8	

Lot 56: Guilford Georgian at Duncans Creek

FOUNDATION PLAN

DRAWN BY: JJ/DREW
HANDING: RIGHT
ISSUE DATE: 11/11/1111
SHEET

A-100

GENERAL FLOOR PLAN NOTES:

General Floor Plan Notes shall apply unless noted otherwise on plan.

1. Wall Heights: Typically 9'-1 1/2" at first floor and second floor, and 9'-1 1/2" at attics U.N.O. All walls are constructed using a double top plate. Splices at Double Top Plate do not need to occur at Vertical Studs but must be at least 24" apart from Joint in other Top Plate layer. Special wall heights are noted on plans where they occur.

2. Wall Thickness is typically 3 1/2". 2x6 frame shall be used at walls that back up to plumbing fixtures. Walls greater than 10' high shall be framed with 2x6 framing or greater and will be noted as a special condition where it occurs on plan.

3. Typical header height shall be 7'-8" AFF at First Floor, and 7'-4" AFF at Second Floor U.N.O.

4. Jacks: Openings up to 3'-4" wide shall have (1) 2x4 jack stud SPF on each side. Openings greater than 3'-4" wide shall have (2) 2x4 jack studs SPF on each side.

5. Soffits, Coffered Ceilings, Trey Ceilings and other significant ceiling plan elements are shown on the floor plans and are denoted as single dashed lines. Unless specifically call out as included, Kitchens include soffits over wall cabinetry.

6. Door & Window Frames, where occurring near corners, shall be a minimum of 4 1/2" from corner. Except for walk-in closets with doors near a corner, doors at closets shall be centered on closet.

7. Windows: Shall have at least (1) window in each sleeping room, that meets egress. Shall be provided with tempered glass at hazardous glazing areas. False windows shall be installed with obscure glazing.

8. Closets for clothing or coat storage shall be equipped with 1 rod/shelf. Closets for linen shall have 4 open equal shelves. Closets for pantries shall have 4 equal wood shelves, painted.

9. Stair treads shall be a min of 9" deep, risers shall be a maximum of 8 1/4", unless noted otherwise, per the current North Carolina Residential Code.


10. Handrails and Guards at stairs shall be 34" above the finished surface of the ramp surface of the stair. Handrails at landings and overlooks of multilevel spaces shall be 36" above finished floor. Guards (pickets or balusters) shall be spaced with no more than 4" between guards.

11. Attic Access shall be provided at all attic area with a height greater than 30". Minimum clear attic access shall be 20" x 30". Pull down stairs and access doors in knee walls meeting minimum criteria are also acceptable.

12. Garage Door to Living Space shall be 2'-8" x 6'-8" minimum size and shall be 20 minute fire rated and weather sealed.

13. Garage Walls, as a minimum, shall be separated from living space by installing 1/2" gypsum board on the garage side of the wall. With habitable space above, the inside of all garage walls require 1/2" GWB supporting 5/8" type X GWB on ceiling.

Cabinets ILO
Pantry

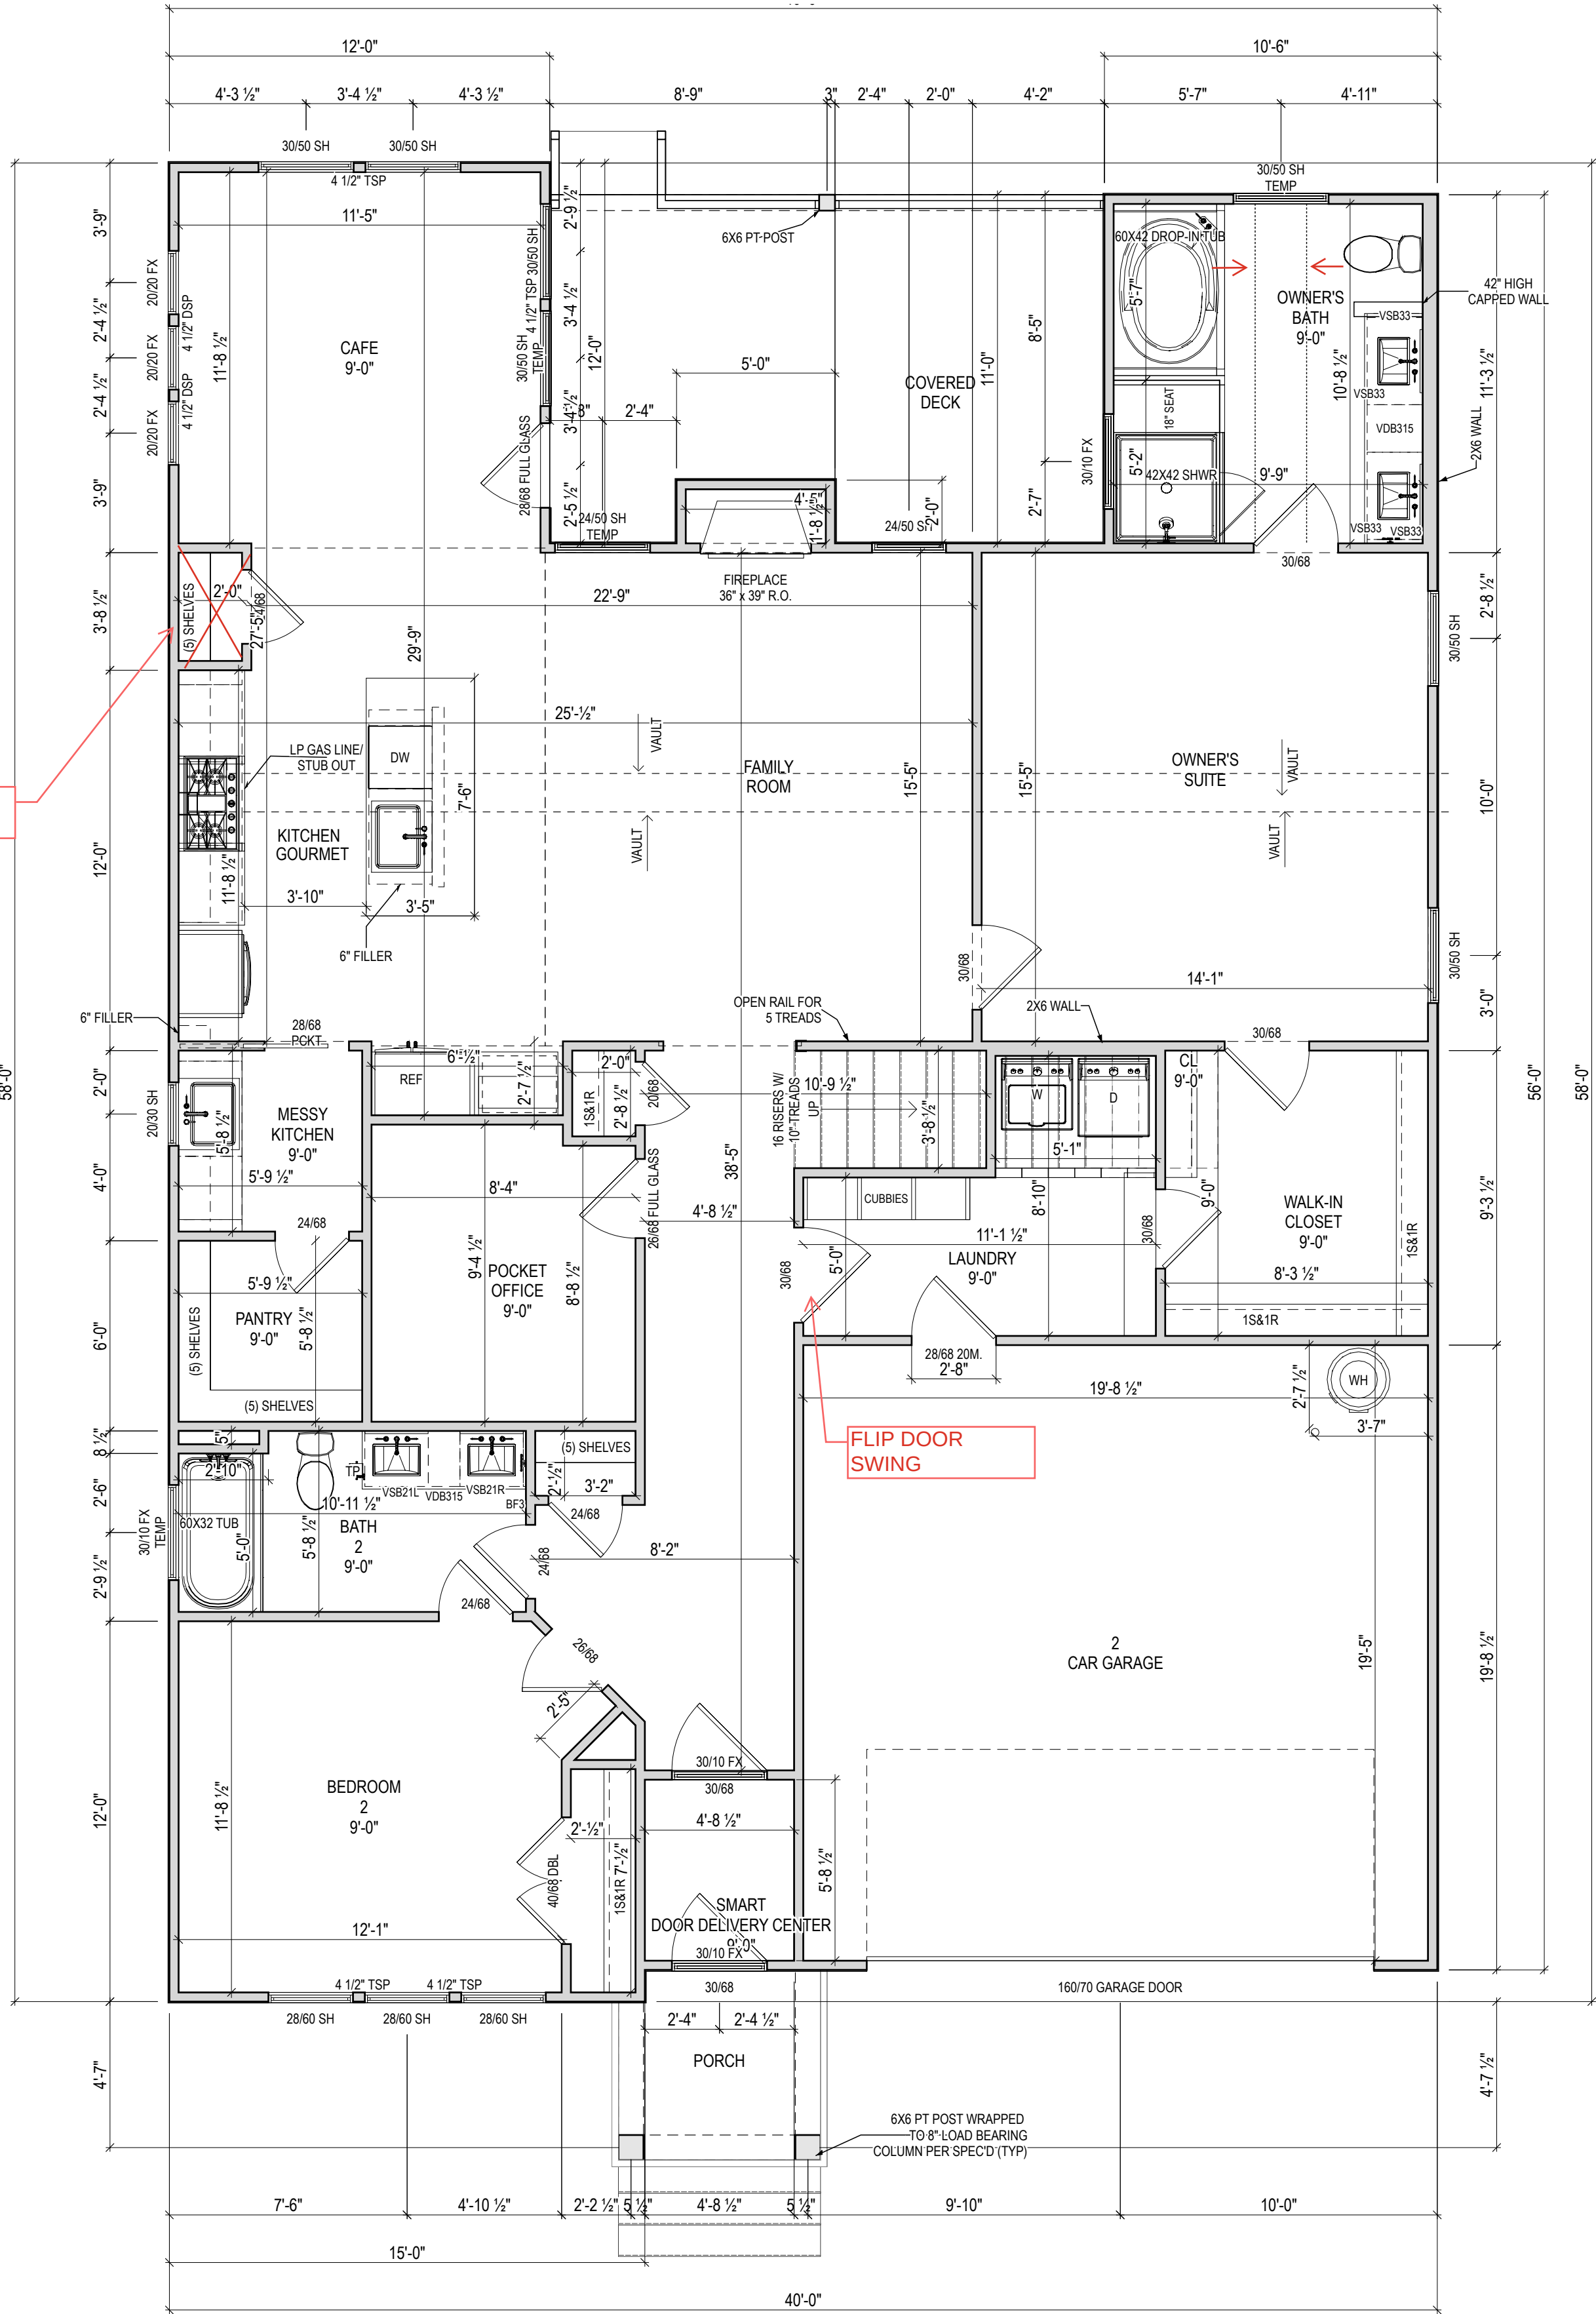

1 First Floor Plan

1/4" = 1'-0" (WHEN PRINTED ON 22x34)

1/8" = 1'-0" (WHEN PRINTED ON 11x17)



New Home Inc

1611 Jones Franklin,
Raleigh, NC, 27606

REV.#	DESCRIPTION	DATE
1		
2		
3		
4		
5		
6		
7		
8		

Lot 56: Guilford Georgian at Duncans Creek

First Floor Plan

DRAWN BY:

JJ/DREW

HANDING:

RIGHT

ISSUE DATE:

11/11/1111

SHEET

A-110

GENERAL FLOOR PLAN NOTES:

General Floor Plan Notes shall apply unless noted otherwise on plan.

1. Wall Heights: Typically 9'-1 1/2" at first floor and second floor, and 9'-1 1/2" at attics U.N.O. All walls are constructed using a double top plate. Splices at Double Top Plate do not need to occur at Vertical Studs but must be at least 24" apart from Joint in other Top Plate layer. Special wall heights are noted on plans where they occur.

2. Wall Thickness is typically 3 1/2". 2x6 frame shall be used at walls that back up to plumbing fixtures. Walls greater than 10' high shall be framed with 2x6 framing or greater and will be noted as a special condition where it occurs on plan.

3. Typical header height shall be 7'-8" AFF at First Floor, and 7'-4" AFF at Second Floor U.N.O.

4. Jacks: Openings up to 3'-4" wide shall have (1) 2x4 jack stud SPF on each side. Openings greater than 3'-4" wide shall have (2) 2x4 jack studs SPF on each side.

5. Soffits, Coffered Ceilings, Trey Ceilings and other significant ceiling plan elements are shown on the floor plans and are denoted as single dashed lines. Unless specifically call out as included, Kitchens include soffits over wall cabinetry.

6. Door & Window Frames, where occurring near corners, shall be a minimum of 4 1/2" from corner. Except for walk-in closets with doors near a corner, doors at closets shall be centered on closet.

7. Windows: Shall have at least (1) window in each sleeping room, that meets egress. Shall be provided with tempered glass at hazardous glazing areas. False windows shall be installed with obscure glazing.

8. Closets for clothing or coat storage shall be equipped with 1 rod/shelf. Closets for linen shall have 4 open equal shelves. Closets for pantries shall have 4 equal wood shelves, painted.


9. Stair treads shall be a min of 9" deep, risers shall be a maximum of 8 1/4", unless noted otherwise, per the current North Carolina Residential Code.

10. Handrails and Guards at stairs shall be 34" above the finished surface of the ramp surface of the stair. Handrails at landings and overlooks of multilevel spaces shall be 36" above finished floor. Guards (pickets or balusters) shall be spaced with no more than 4" between guards.

11. Attic Access shall be provided at all attic area with a height greater than 30". Minimum clear attic access shall be 20" x 30". Pull down stairs and access doors in knee walls meeting minimum criteria are also acceptable.

12. Garage Door to Living Space shall be 2'-8" x 6'-8" minimum size and shall be 20 minute fire rated and weather sealed.

13. Garage Walls, as a minimum, shall be separated from living space by installing 1/2" gypsum board on the garage side of the wall. With habitable space above, the inside of all garage walls require 1/2" GWB supporting 5/8" type X GWB on ceiling.

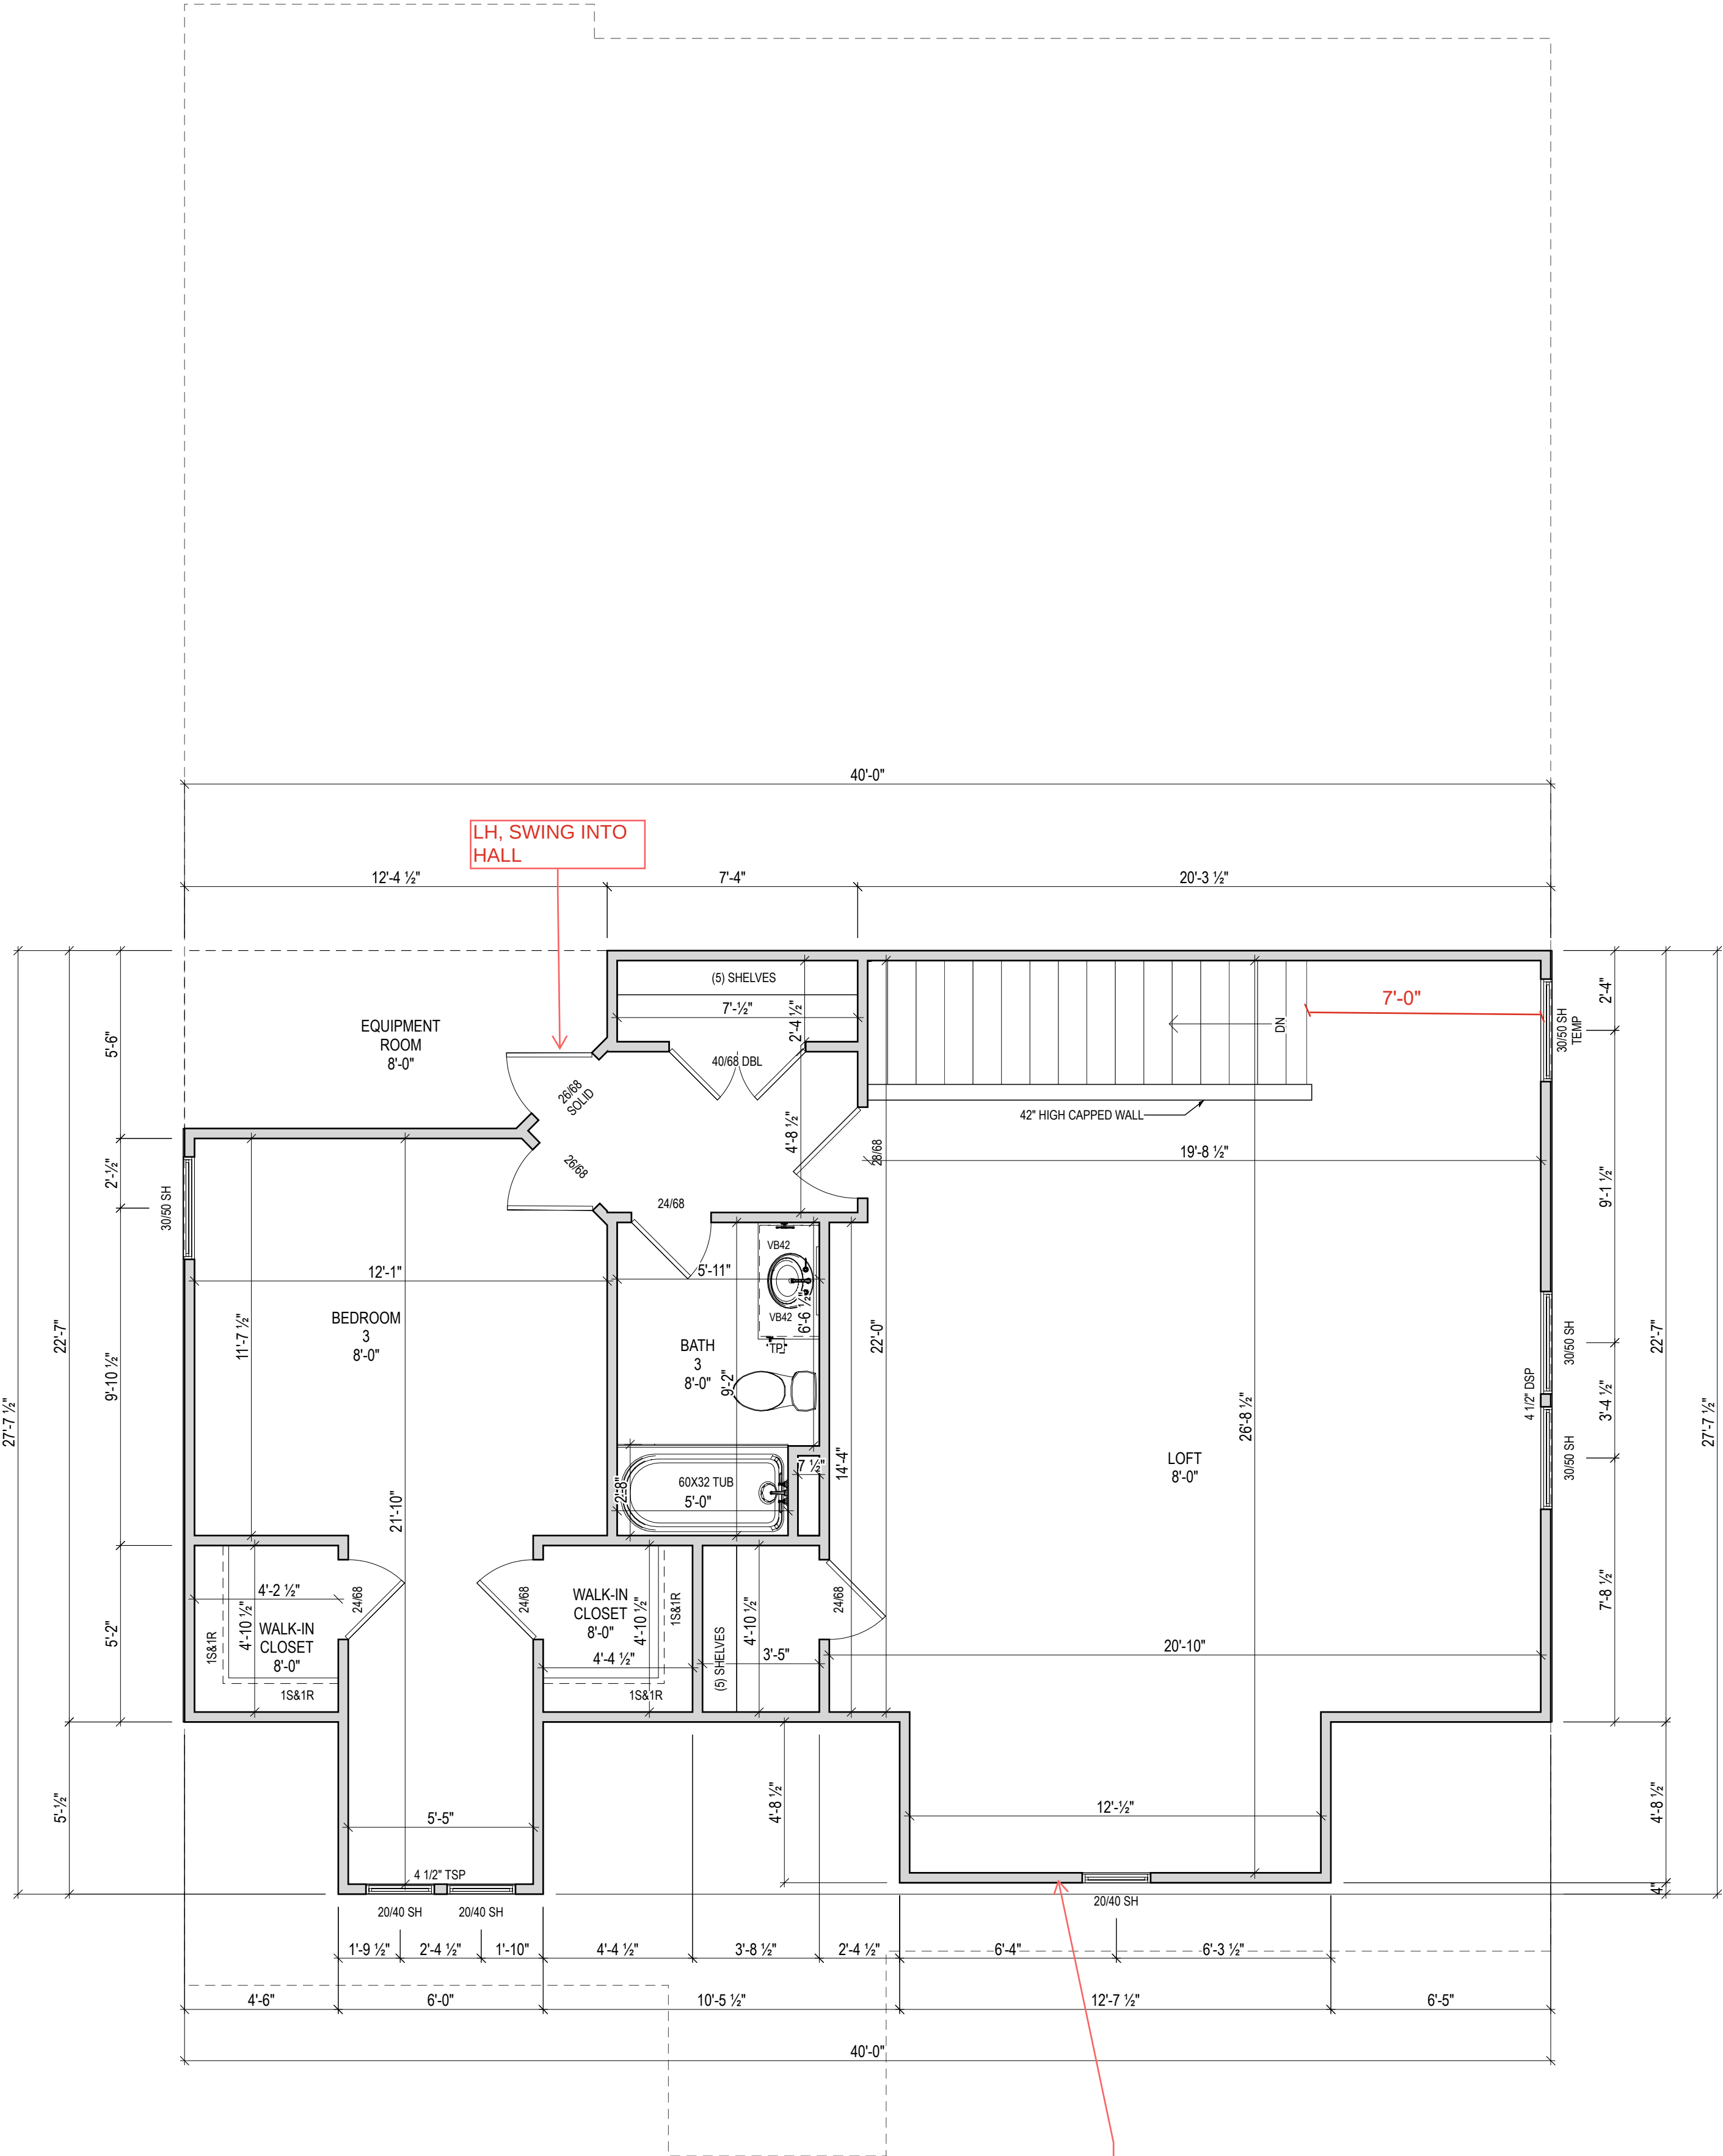

1 Second Floor Plan
1/4" = 1'-0" (WHEN PRINTED ON 22x34)
1/8" = 1'-0" (WHEN PRINTED ON 11x17)



New Home Inc

1611 Jones Franklin,
Raleigh, NC, 27606

REV.#	DESCRIPTION	DATE
1		
2		
3		
4		
5		
6		
7		
8		

Lot 56: Guilford Georgian at Duncans Creek

Second Floor Plan

DRAWN BY:

JJ/DREW

HANDING:

RIGHT

ISSUE DATE:


11/11/1111

SHEET

A-120

GENERAL ROOF PLAN NOTES:

1. ALL ROOF OVERHANGS TO BE 1'-0" UNLESS NOTED OTHERWISE
2. ALL TRAY CEILING TRAY HEIGHTS TO BE 12' UNLESS NOTED OTHERWISE
3. THESE PLANS ARE NOT TO BE SCALED FOR CONSTRUCTION PURPOSES.
4. IT IS THE CONTRACTOR'S RESPONSIBILITY TO VERIFY THE ACCURACY OF ALL DETAILS AND DIMENSIONS.
5. 8×16' ATTIC STORAGE PLATFORM - PROVIDE 3/4" APA RATED PLYWOOD SUB-FLOORING OR OSB SHEATHING RATED FOR 20#/SF ON BOTTOM CHORD OF TRUSSES. TRUSS MANUFACTURER TO ACCOUNT FOR ADDITIONAL LOADS

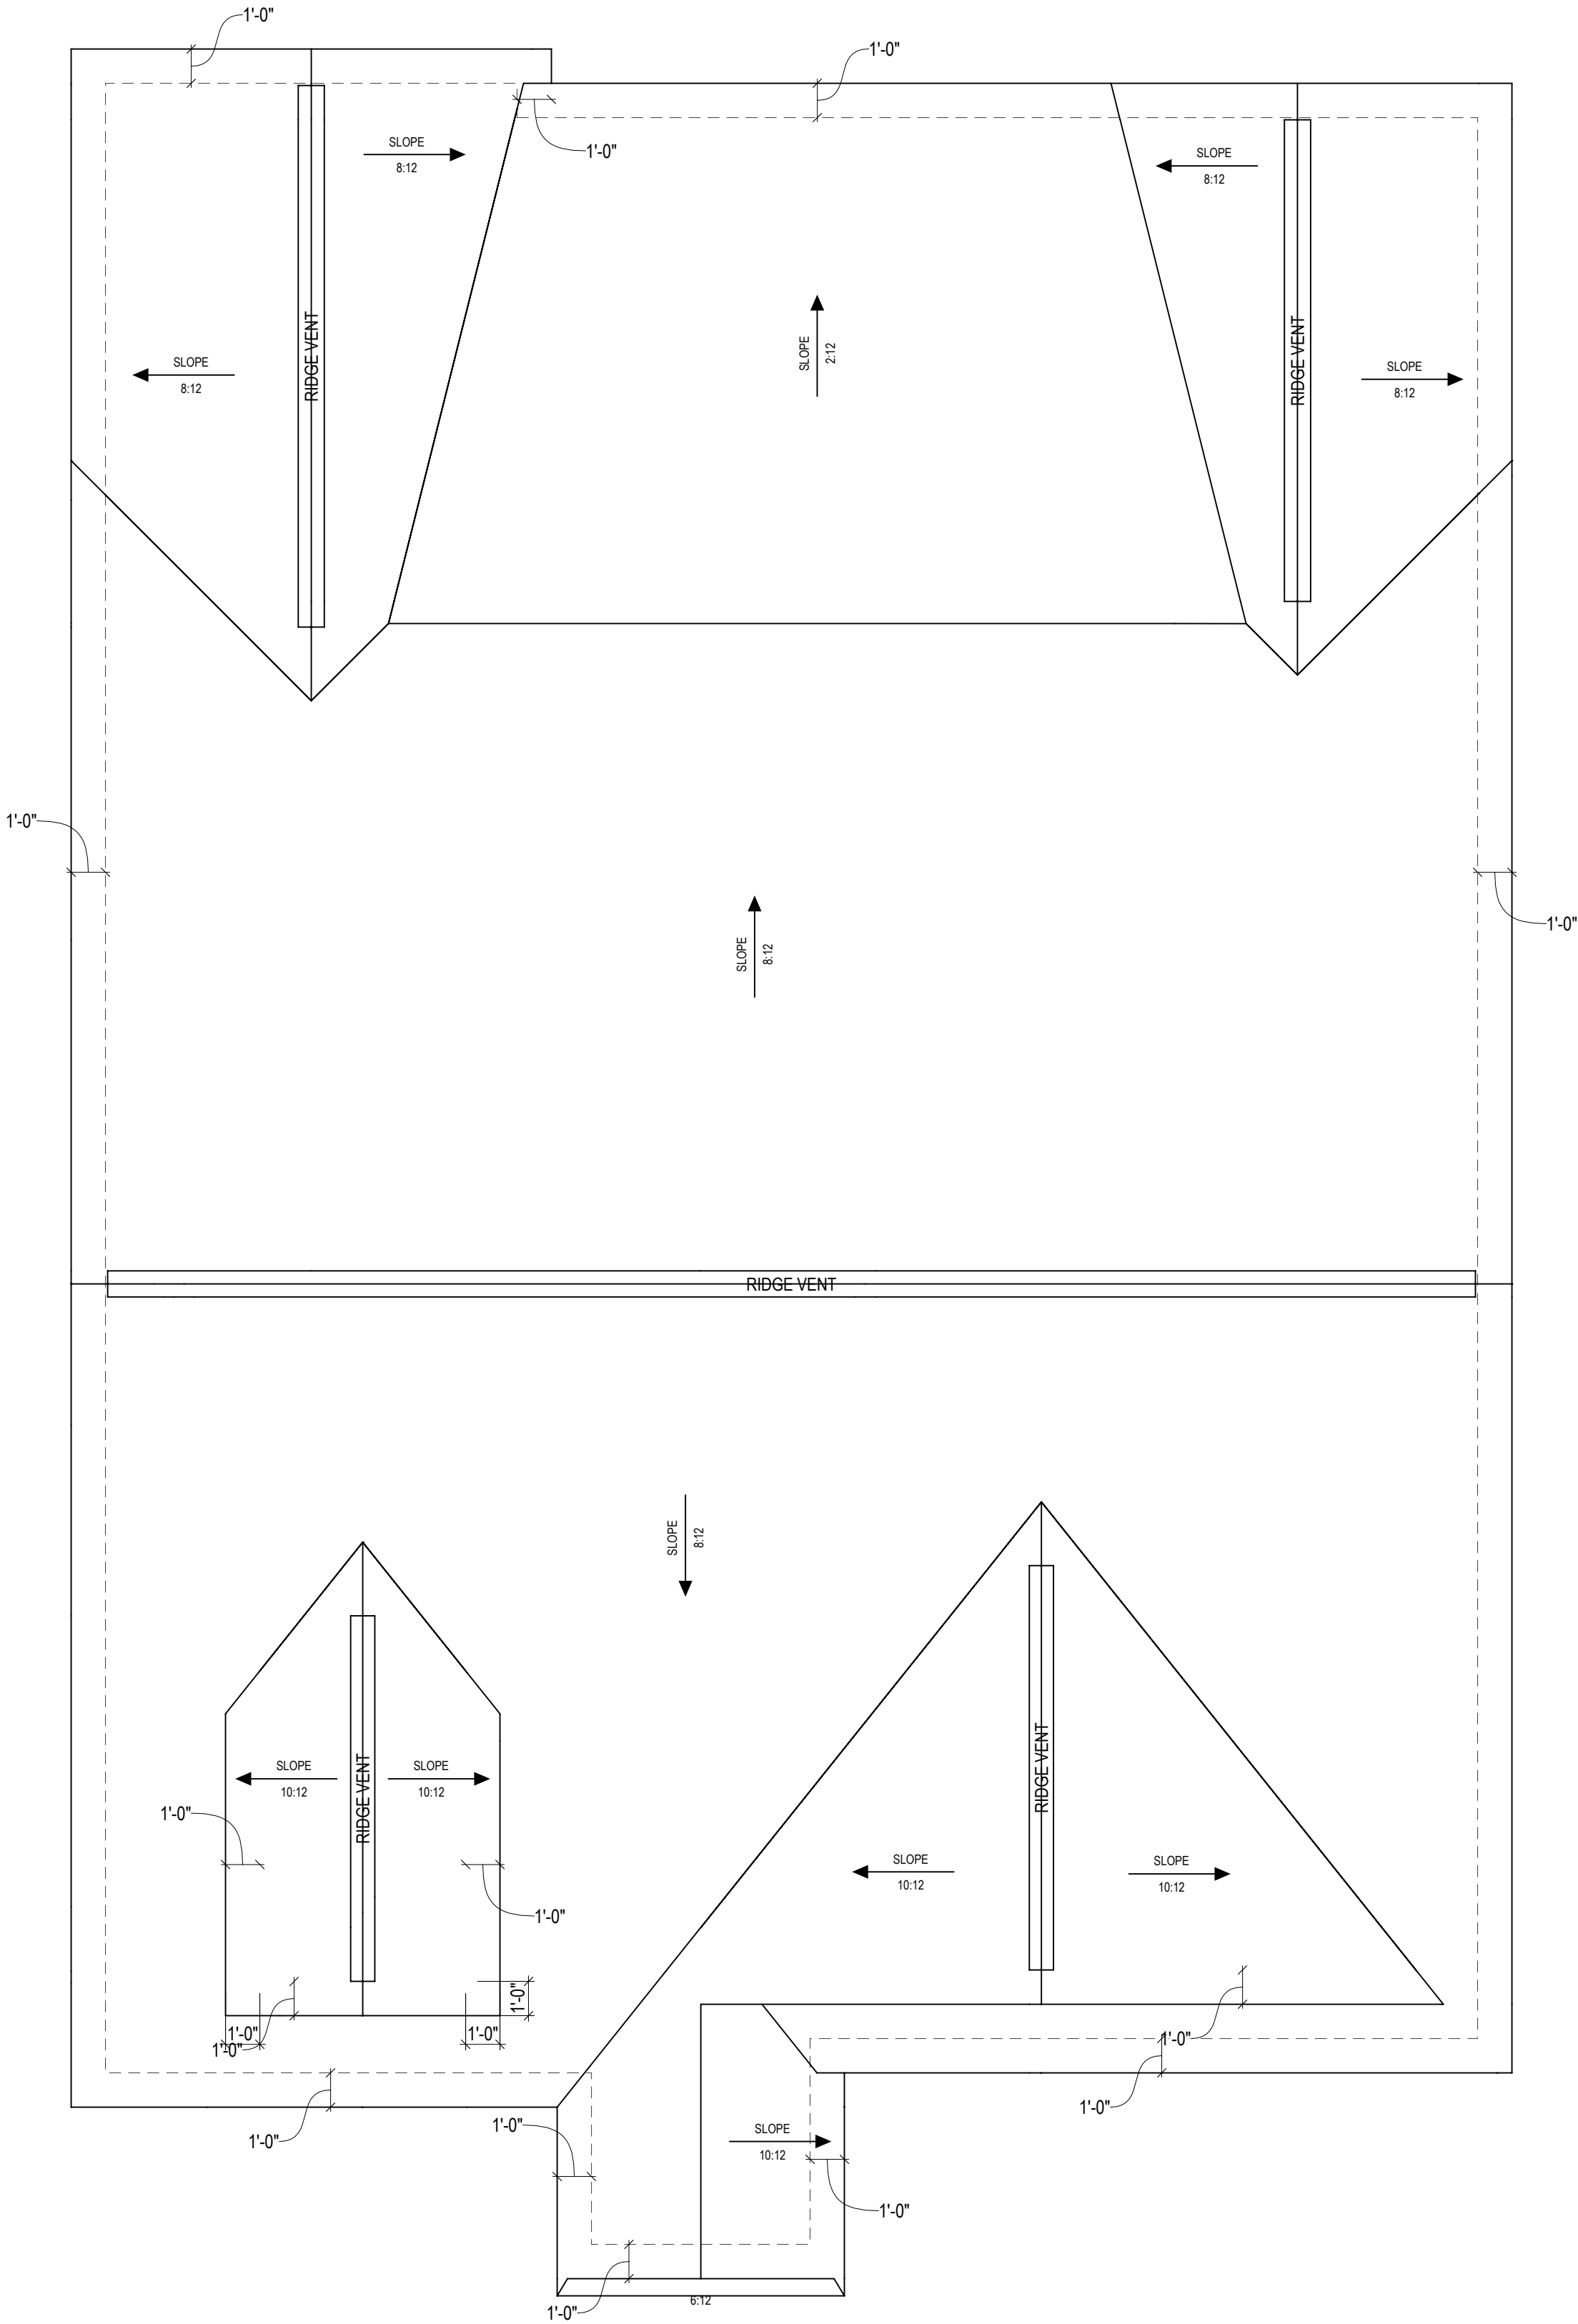

1

Roof Plan

1/4" = 1'-0" (WHEN PRINTED ON 22x34)

1/8" = 1'-0" (WHEN PRINTED ON 11x17)



New Home Inc

1611 Jones Franklin,
Raleigh, NC, 27606

REV.#	DESCRIPTION	DATE
1		
2		
3		
4		
5		
6		
7		
8		

Lot 56: Guilford Georgian at Duncans Creek

Roof Plan

DRAWN BY:

JJ/DREW

HANDING:

RIGHT

ISSUE DATE:

11/11/1111

SHEET

A-200

GENERAL ELEVATION NOTES:

General Elevation Notes shall apply unless noted otherwise on plan.

1. Roof shall be finished with architectural composition shingles with slopes as noted on plan.

2. Ridge Vent shall be provided and installed on all ridges greater than 6' in length per manufacturer's specifications.

3. Soffit Vent shall be continuous soffit vent.

4. House Wrap, "tyvek" or approved equal shall be installed over entire exterior wall per manufacturer's specifications and recommendations.


5. Flashing shall be provided above all door and window openings, above finish wall material changes and at wall surfaces where lower roof areas abut vertical wall surfaces.

6. Porch Railings shall be provided at all porch walking surfaces greater than 30" above adjacent finished grade. It shall be 36" high with guards spaced no more than 4" apart. Consult community specifications for material.


7. Finish Wall Material shall be as noted on elevation drawings.

8. Brick Veneer, if included on elevation shall be tied to wall surface with galvanized corrugated metal ties at a rate of 24" oc horizontally and 16" oc vertically so that no more than 2.67sf of brick is supported by (1) tie. Space between face of wall and back face of brick shall be limited to a maximum of 1". Flashing shall be provided behind brick above all wall openings and at base of brick wall. Flashing shall be a minimum of 6-mil poly or other corrosion resistant material and shall be installed so that it laps under the house wrap material a minimum of 2". Weepholes shall be provided at a rate of 48" oc and shall not be less than 3/16" in diameter and shall be located immediately above flashing.

9. Brick Veneer Support Lintels shall be provided if brick veneer is included on elevation. Lintels shall be provided as listed in the following schedule and shall have a minimum bearing length of 6". Masonry Lintels shall be provided so that deflection is limited to L/600.

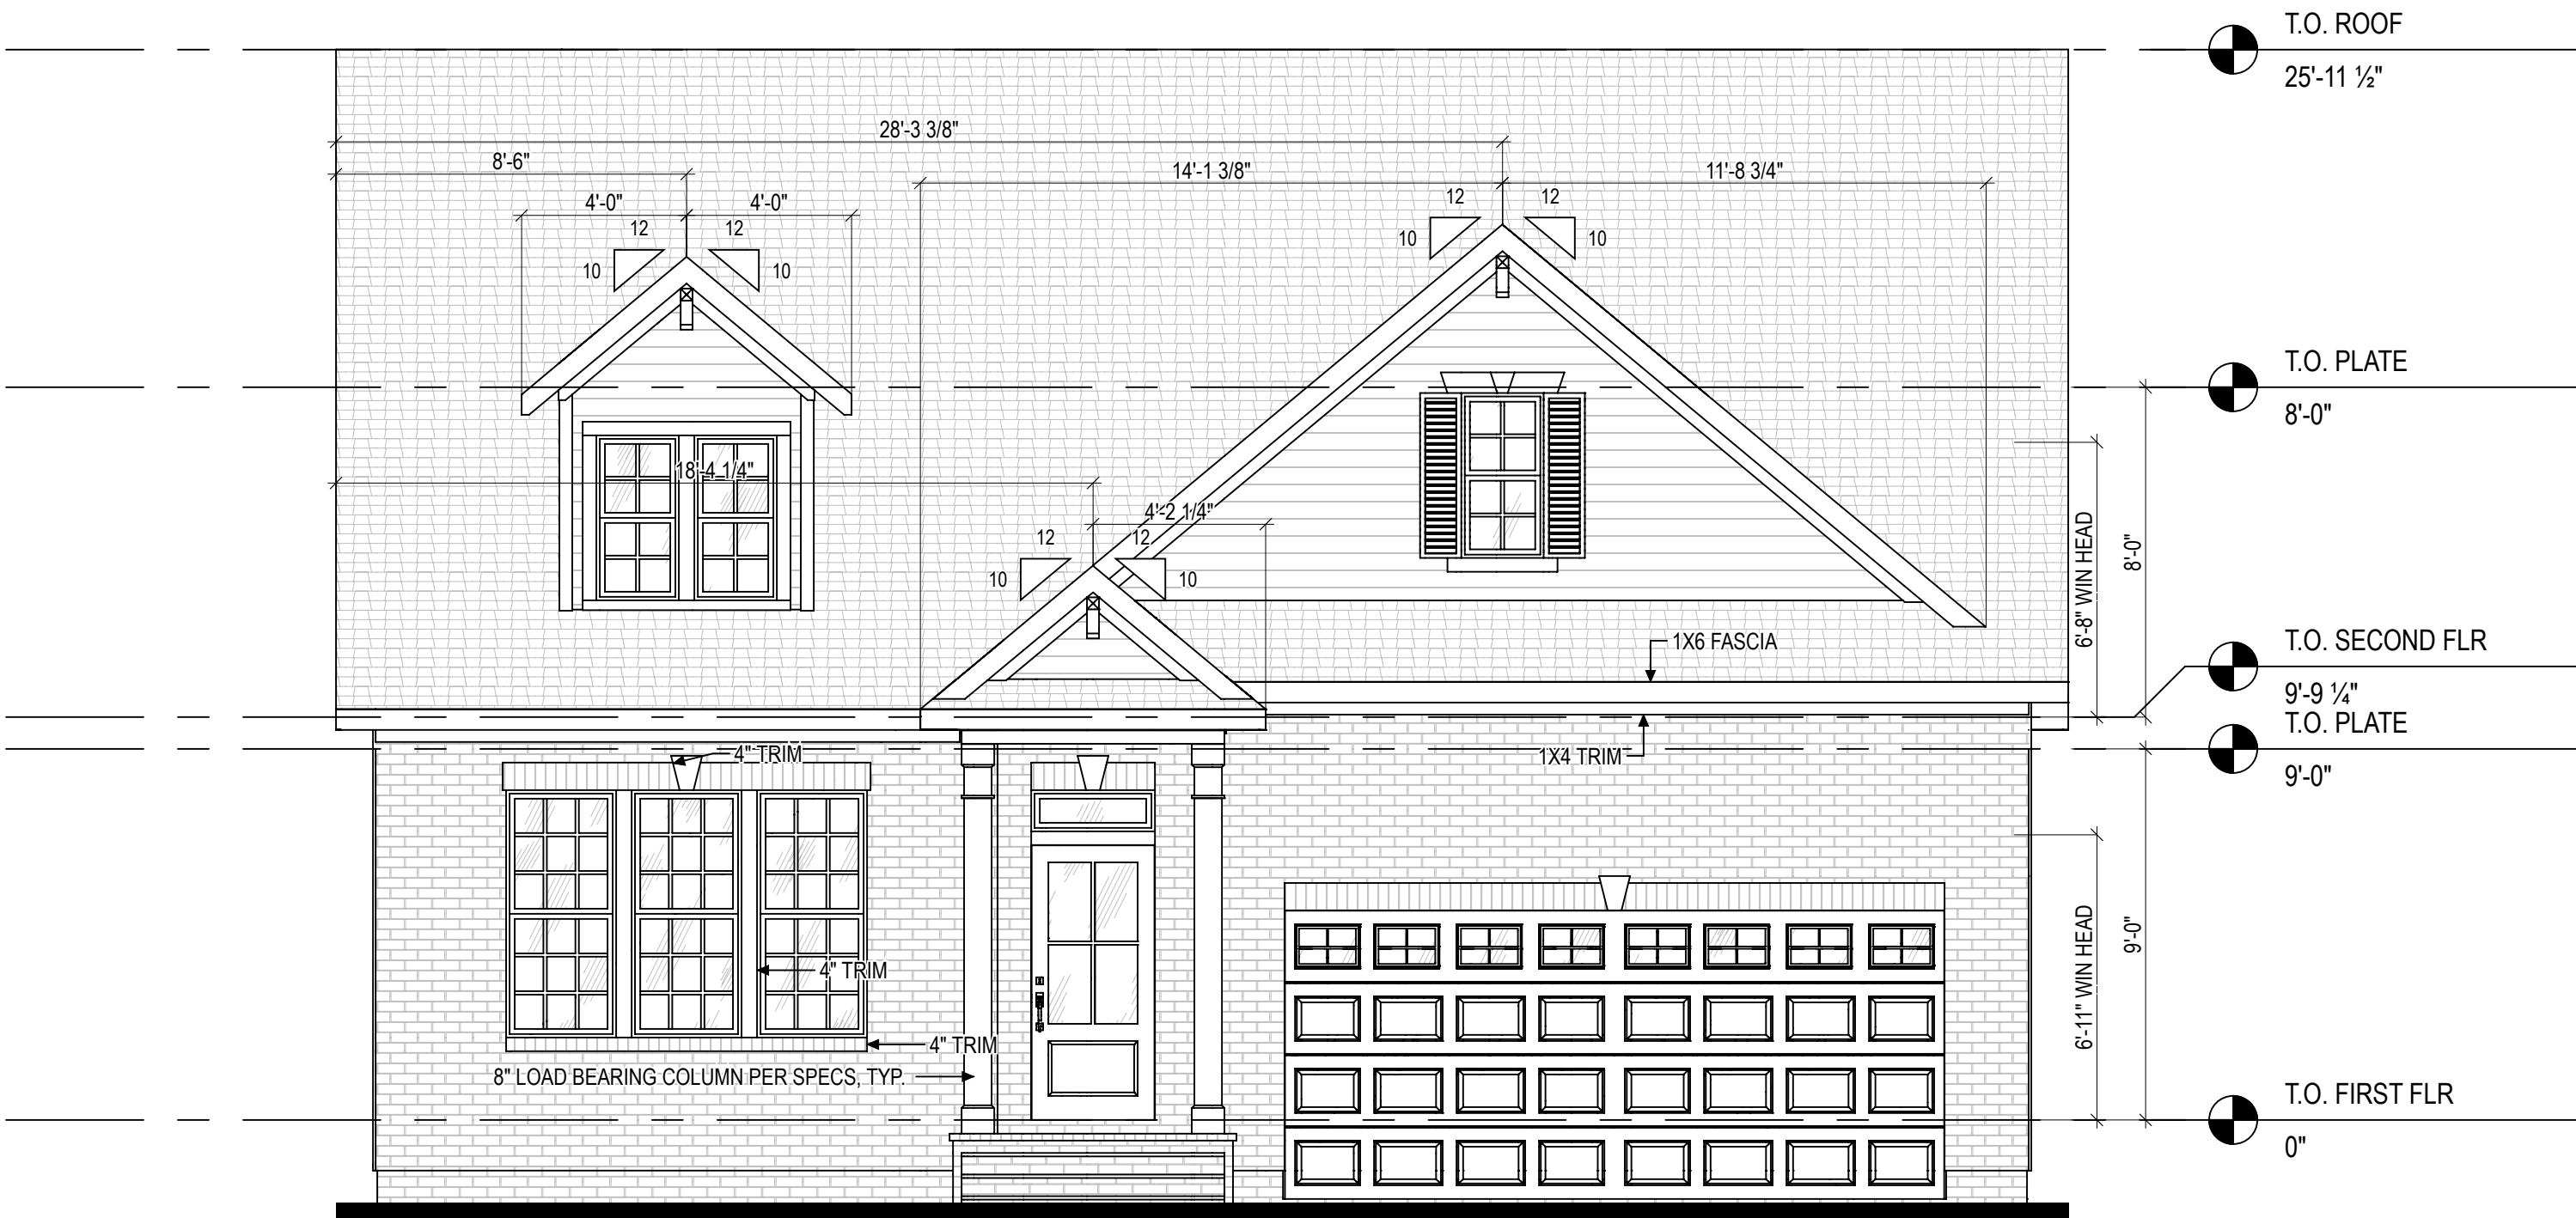

1 Front Elevation
1/4" = 1'-0" (WHEN PRINTED ON 22x34)
1/8" = 1'-0" (WHEN PRINTED ON 11x17)

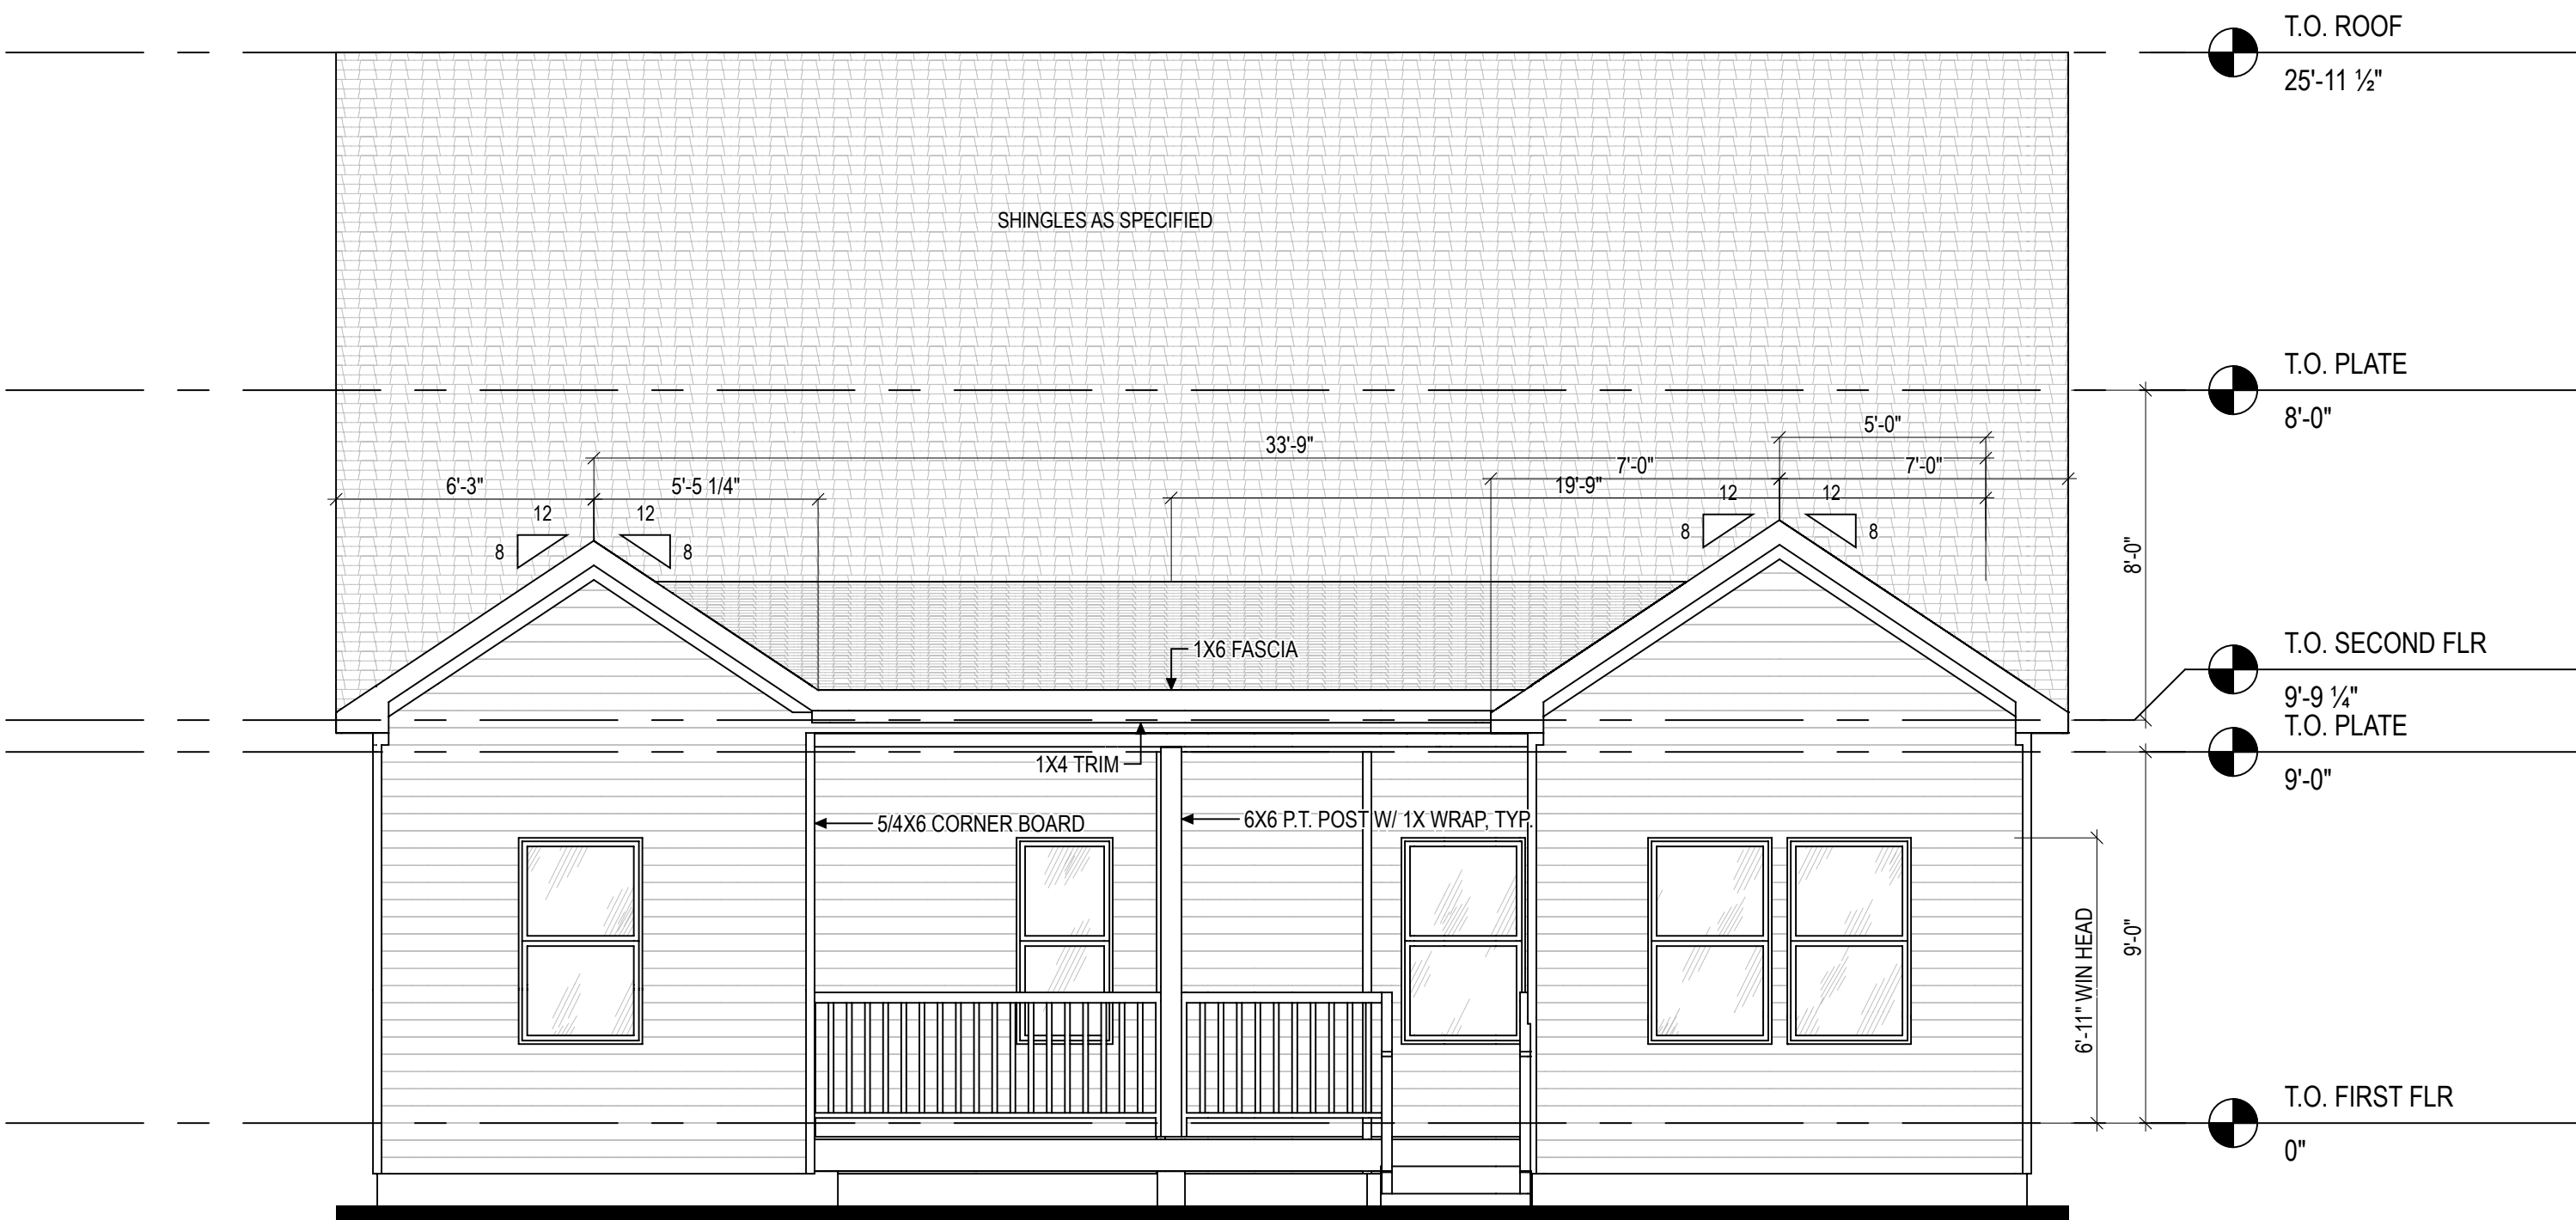

2 Back Elevation
1/4" = 1'-0" (WHEN PRINTED ON 22x34)
1/8" = 1'-0" (WHEN PRINTED ON 11x17)



New Home Inc

1611 Jones Franklin,
Raleigh, NC, 27606

REV.#	DESCRIPTION	DATE
1		
2		
3		
4		
5		
6		
7		
8		

Lot 56: Guilford Georgian at Duncans Creek

Elevations - Front and Back

DRAWN BY:
JJ/DREW

HANDING:
LEFT

ISSUE DATE:
11/11/1111

SHEET

A-310

GENERAL ELEVATION NOTES:

General Elevation Notes shall apply unless noted otherwise on plan.

1. Roof shall be finished with architectural composition shingles with slopes as noted on plan.

2. Ridge Vent shall be provided and installed on all ridges greater than 6' in length per manufacturer's specifications.

3. Soffit Vent shall be continuous soffit vent.

4. House Wrap, "tyvek" or approved equal shall be installed over entire exterior wall per manufacturer's specifications and recommendations.


5. Flashing shall be provided above all door and window openings, above finish wall material changes and at wall surfaces where lower roof areas abut vertical wall surfaces.

6. Porch Railings shall be provided at all porch walking surfaces greater than 30" above adjacent finished grade. It shall be 36" high with guards spaced no more than 4" apart. Consult community specifications for material.

7. Finish Wall Material shall be as noted on elevation drawings.

8. Brick Veneer, if included on elevation shall be tied to wall surface with galvanized corrugated metal ties at a rate of 24" oc horizontally and 16" oc vertically so that no more than 2.67sf of brick is supported by (1) tie. Space between face of wall and back face of brick shall be limited to a maximum of 1". Flashing shall be provided behind brick above all wall openings and at base of brick wall. Flashing shall be a minimum of 6-mil poly or other corrosion resistant material and shall be installed so that it laps under the house wrap material a minimum of 2". Weepholes shall be provided at a rate of 48" oc and shall not be less than 3/16" in diameter and shall be located immediately above flashing.

9. Brick Veneer Support Lintels shall be provided if brick veneer is included on elevation. Lintels shall be provided as listed in the following schedule and shall have a minimum bearing length of 6". Masonry Lintels shall be provided so that deflection is limited to L/600.

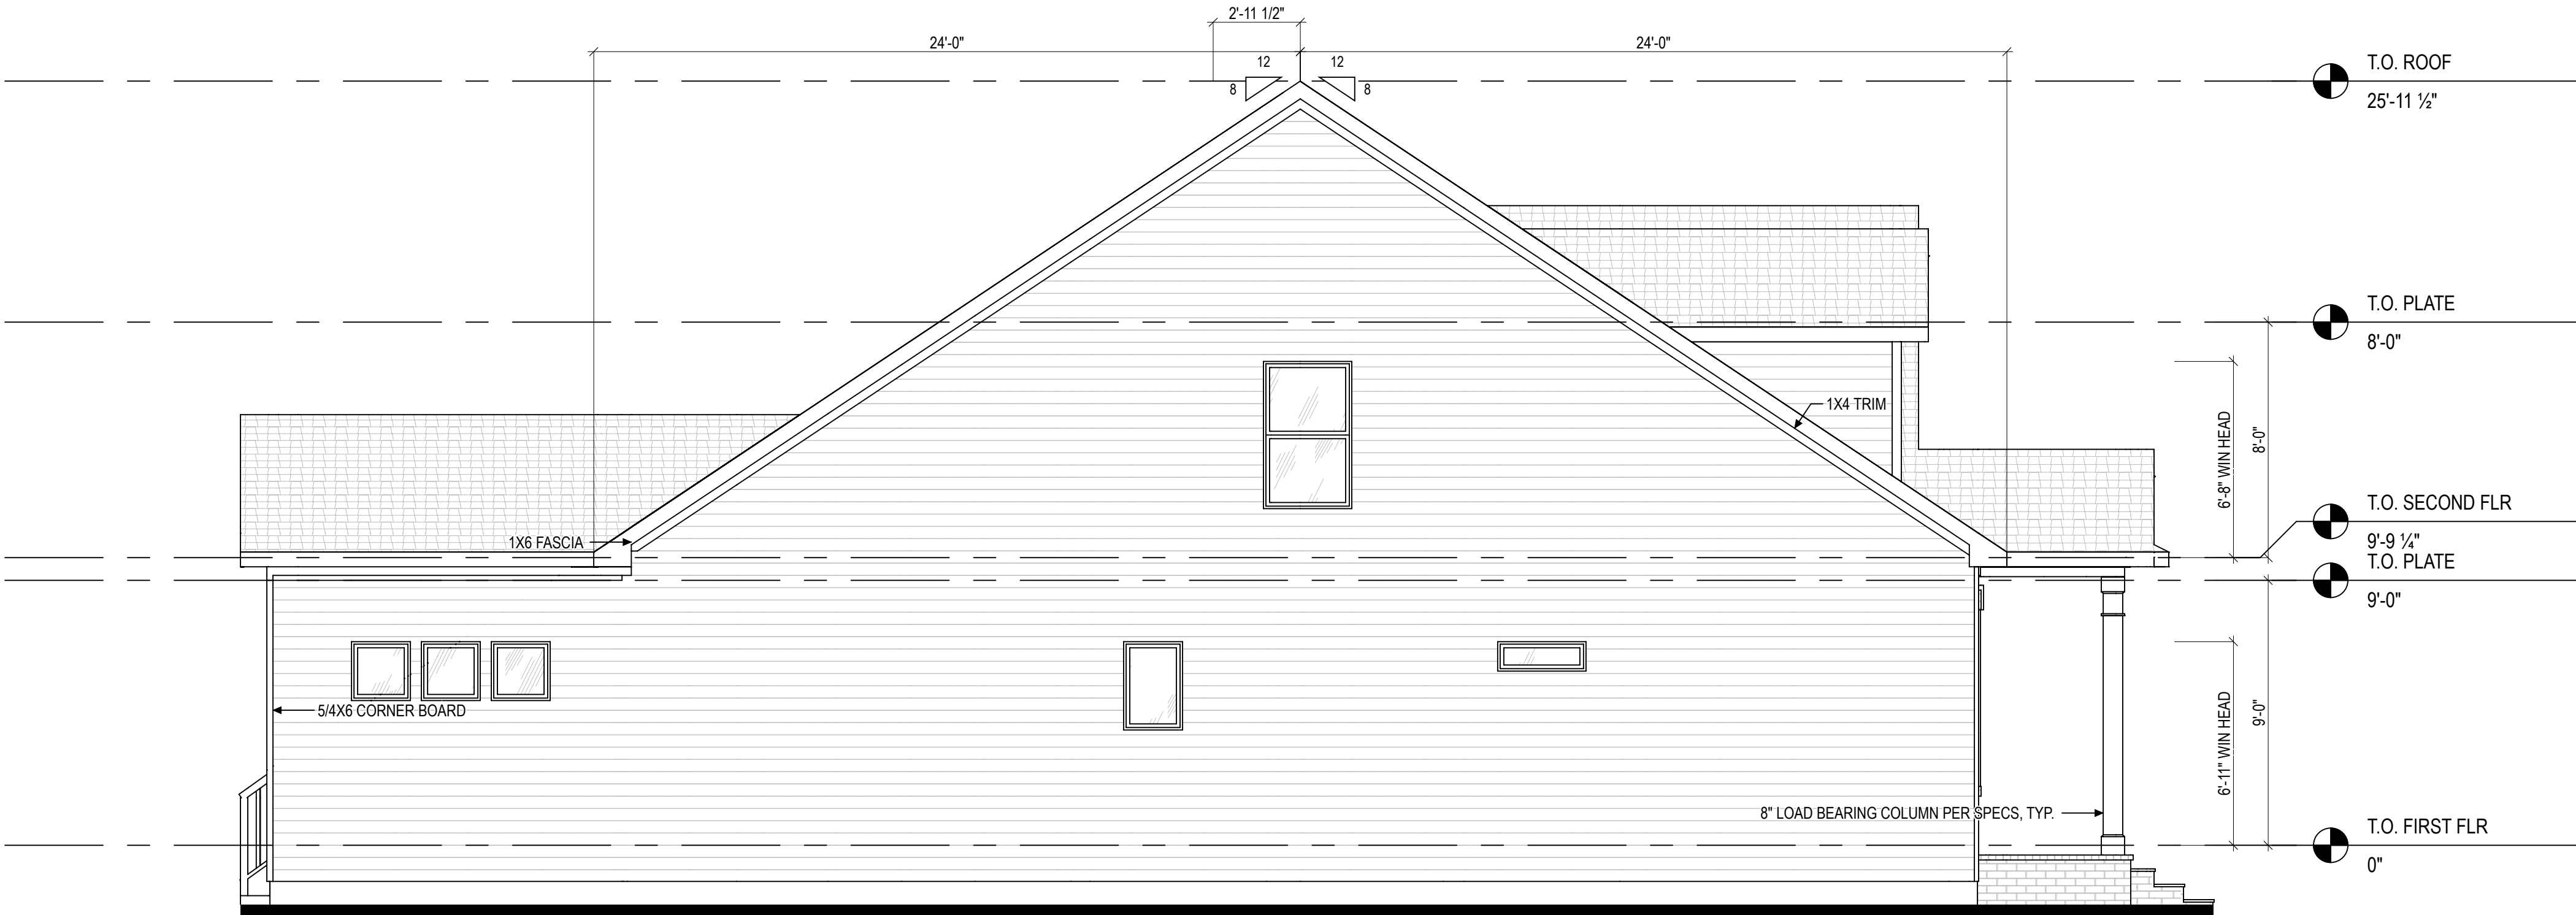

1 Left Elevation
1/4" = 1'-0" (WHEN PRINTED ON 22x34)
1/8" = 1'-0" (WHEN PRINTED ON 11x17)



2 Right Elevation
1/4" = 1'-0" (WHEN PRINTED ON 22x34)
1/8" = 1'-0" (WHEN PRINTED ON 11x17)



New Home Inc

1611 Jones Franklin,
Raleigh, NC, 27606

REV.#	DESCRIPTION	DATE
1		
2		
3		
4		
5		
6		
7		
8		

Lot 56: Guilford Georgian at Duncans Creek

Elevations - Front and Back


DRAWN BY:
JJ/DREW

HANDING:
LEFT


ISSUE DATE:
11/11/1111

SHEET


A-320

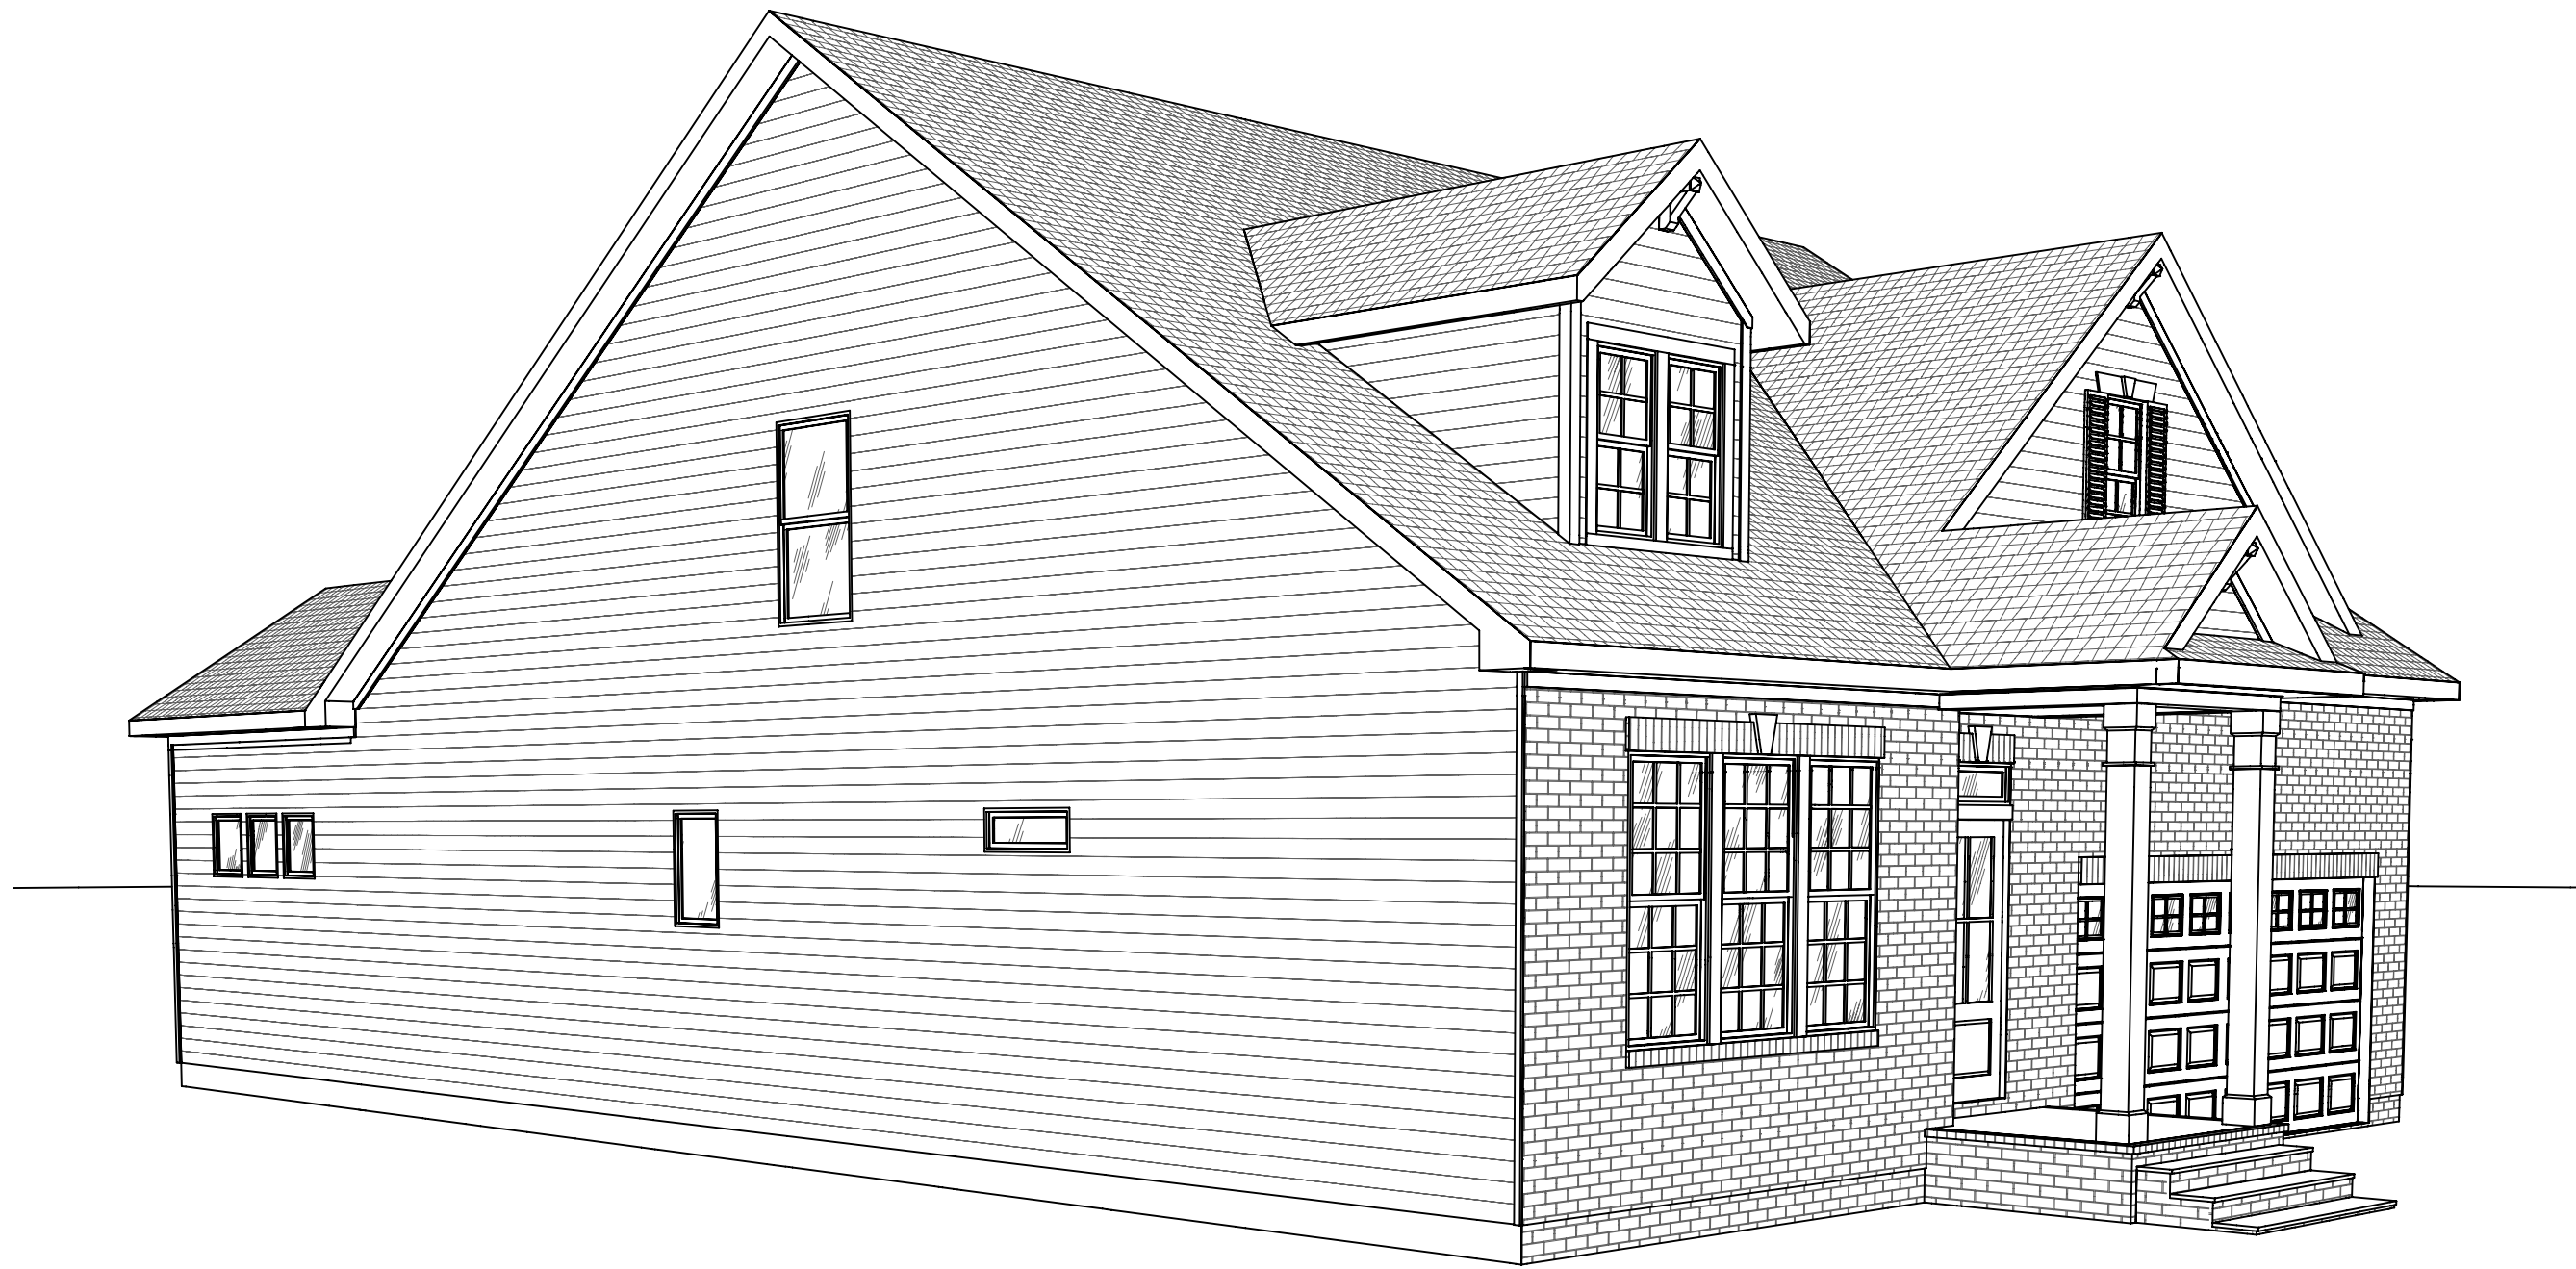


1 Front Left
NTS

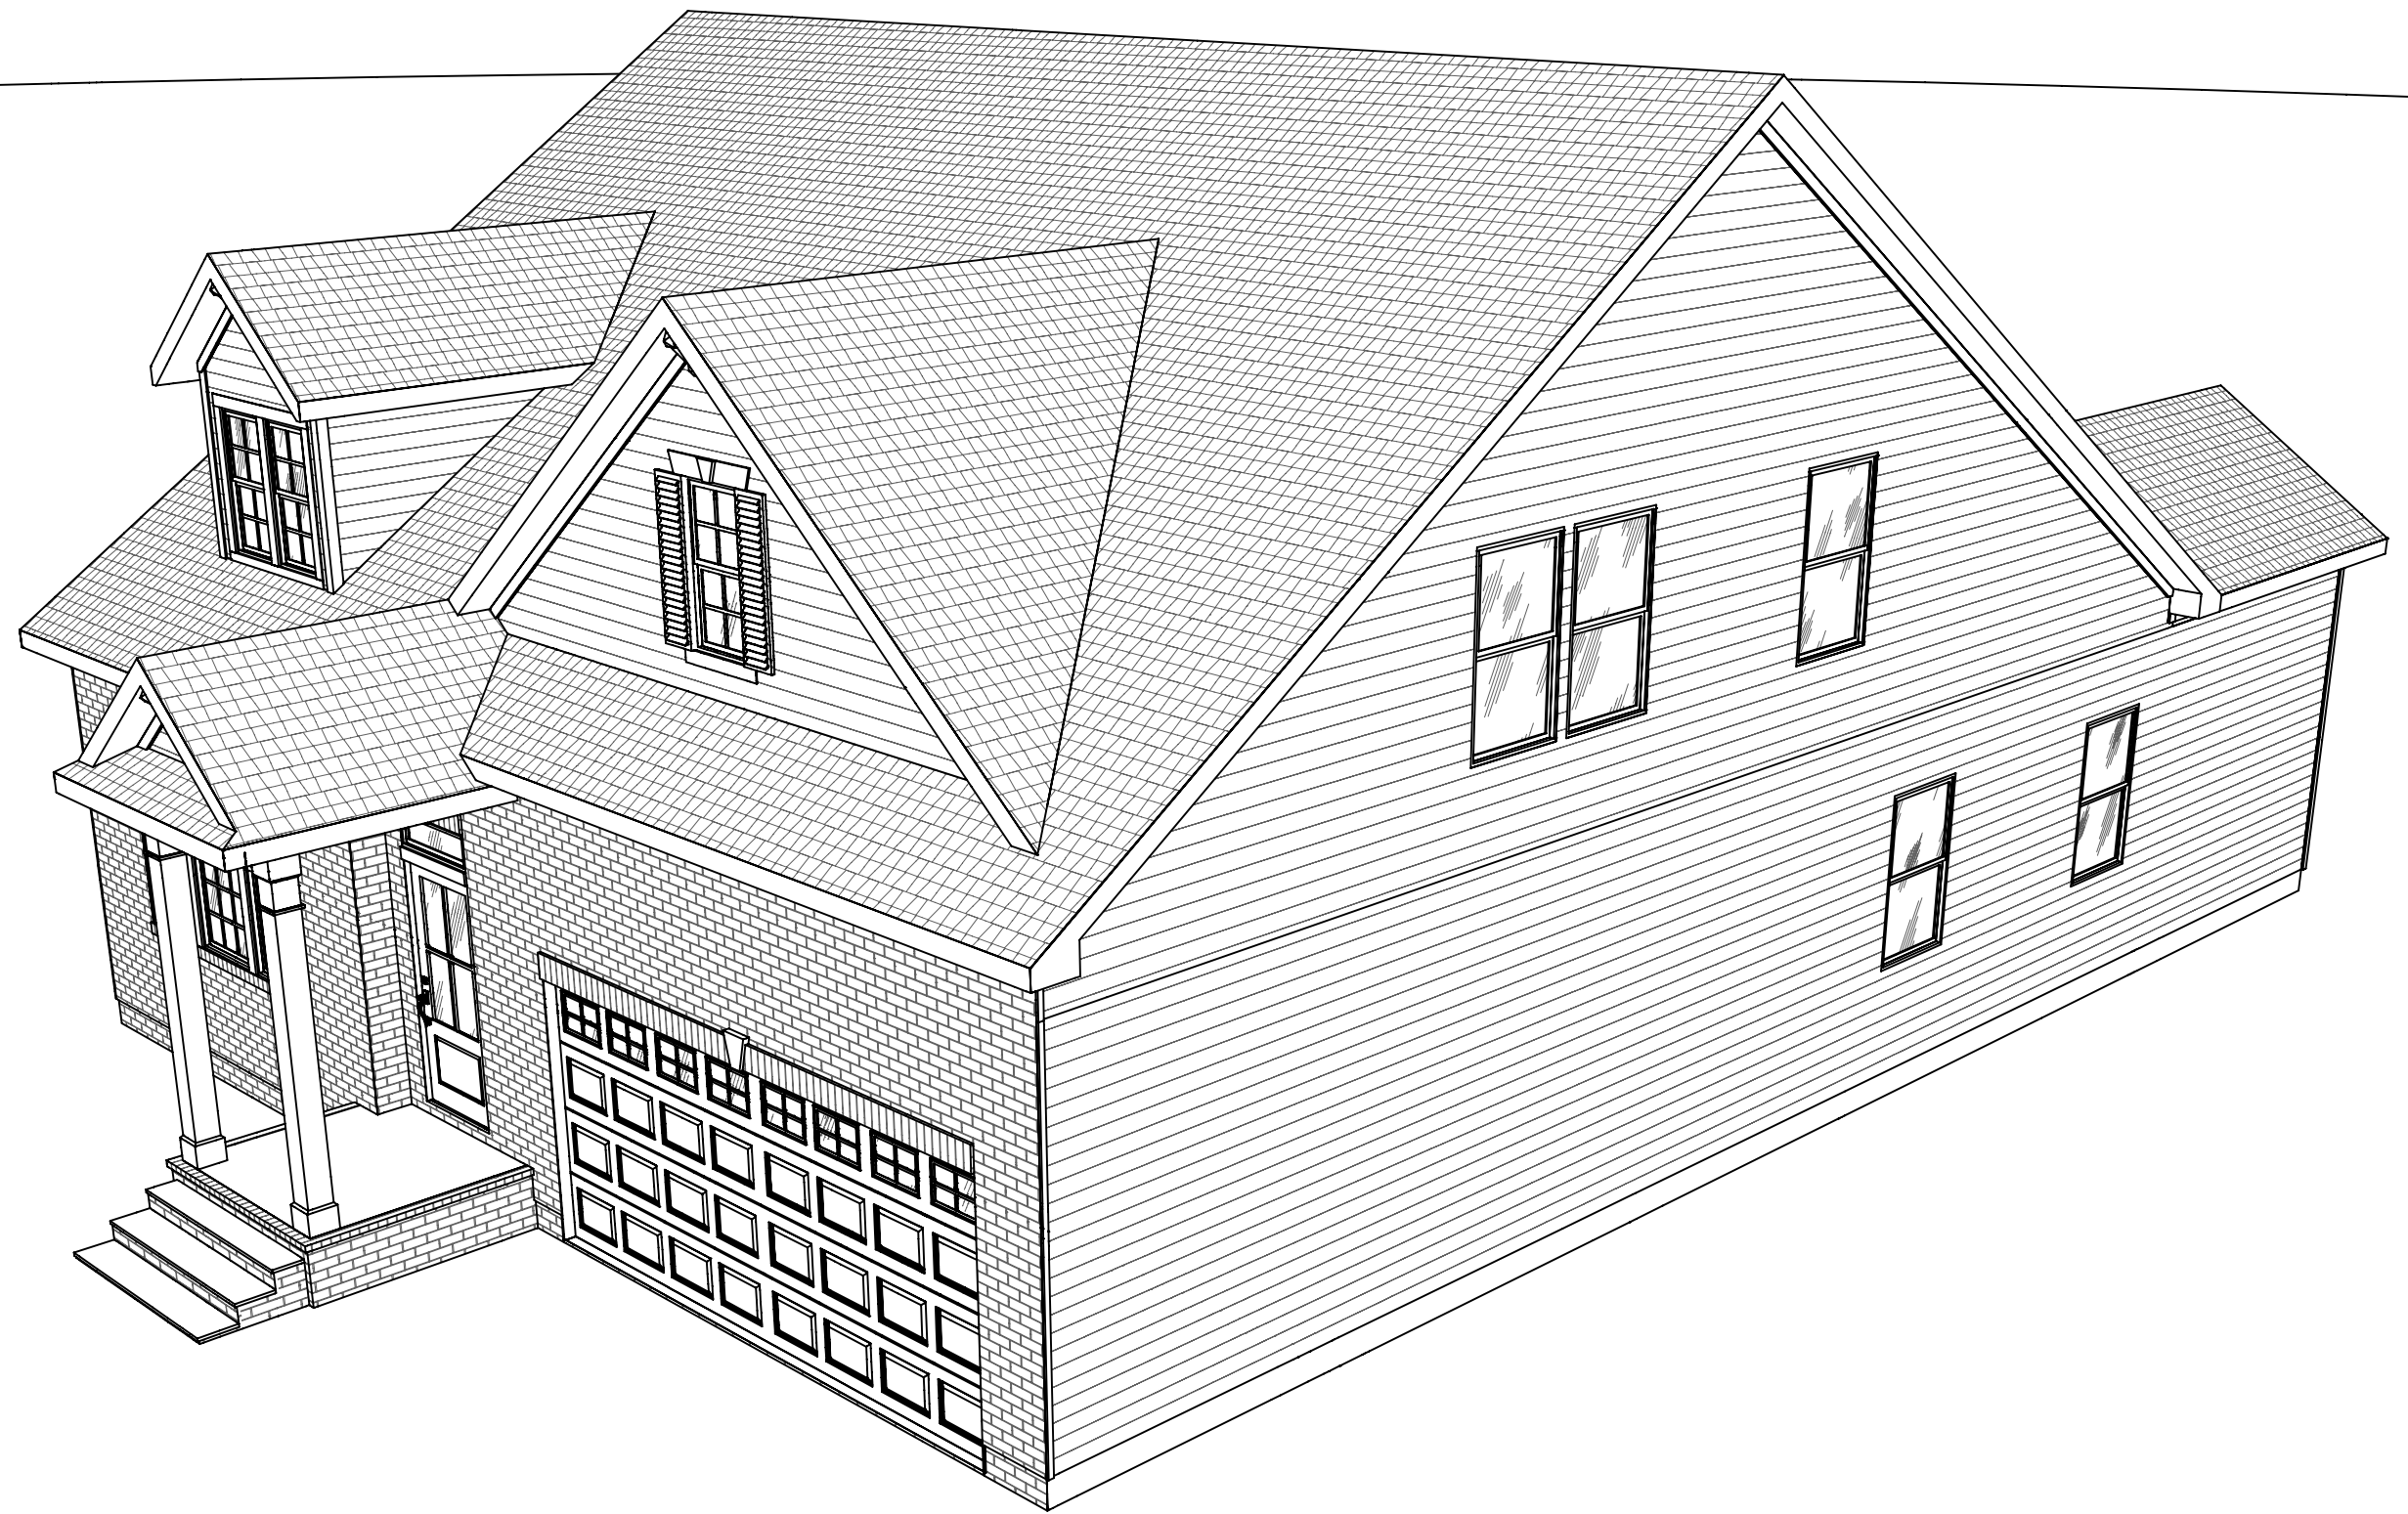

1 Front Right
NTS

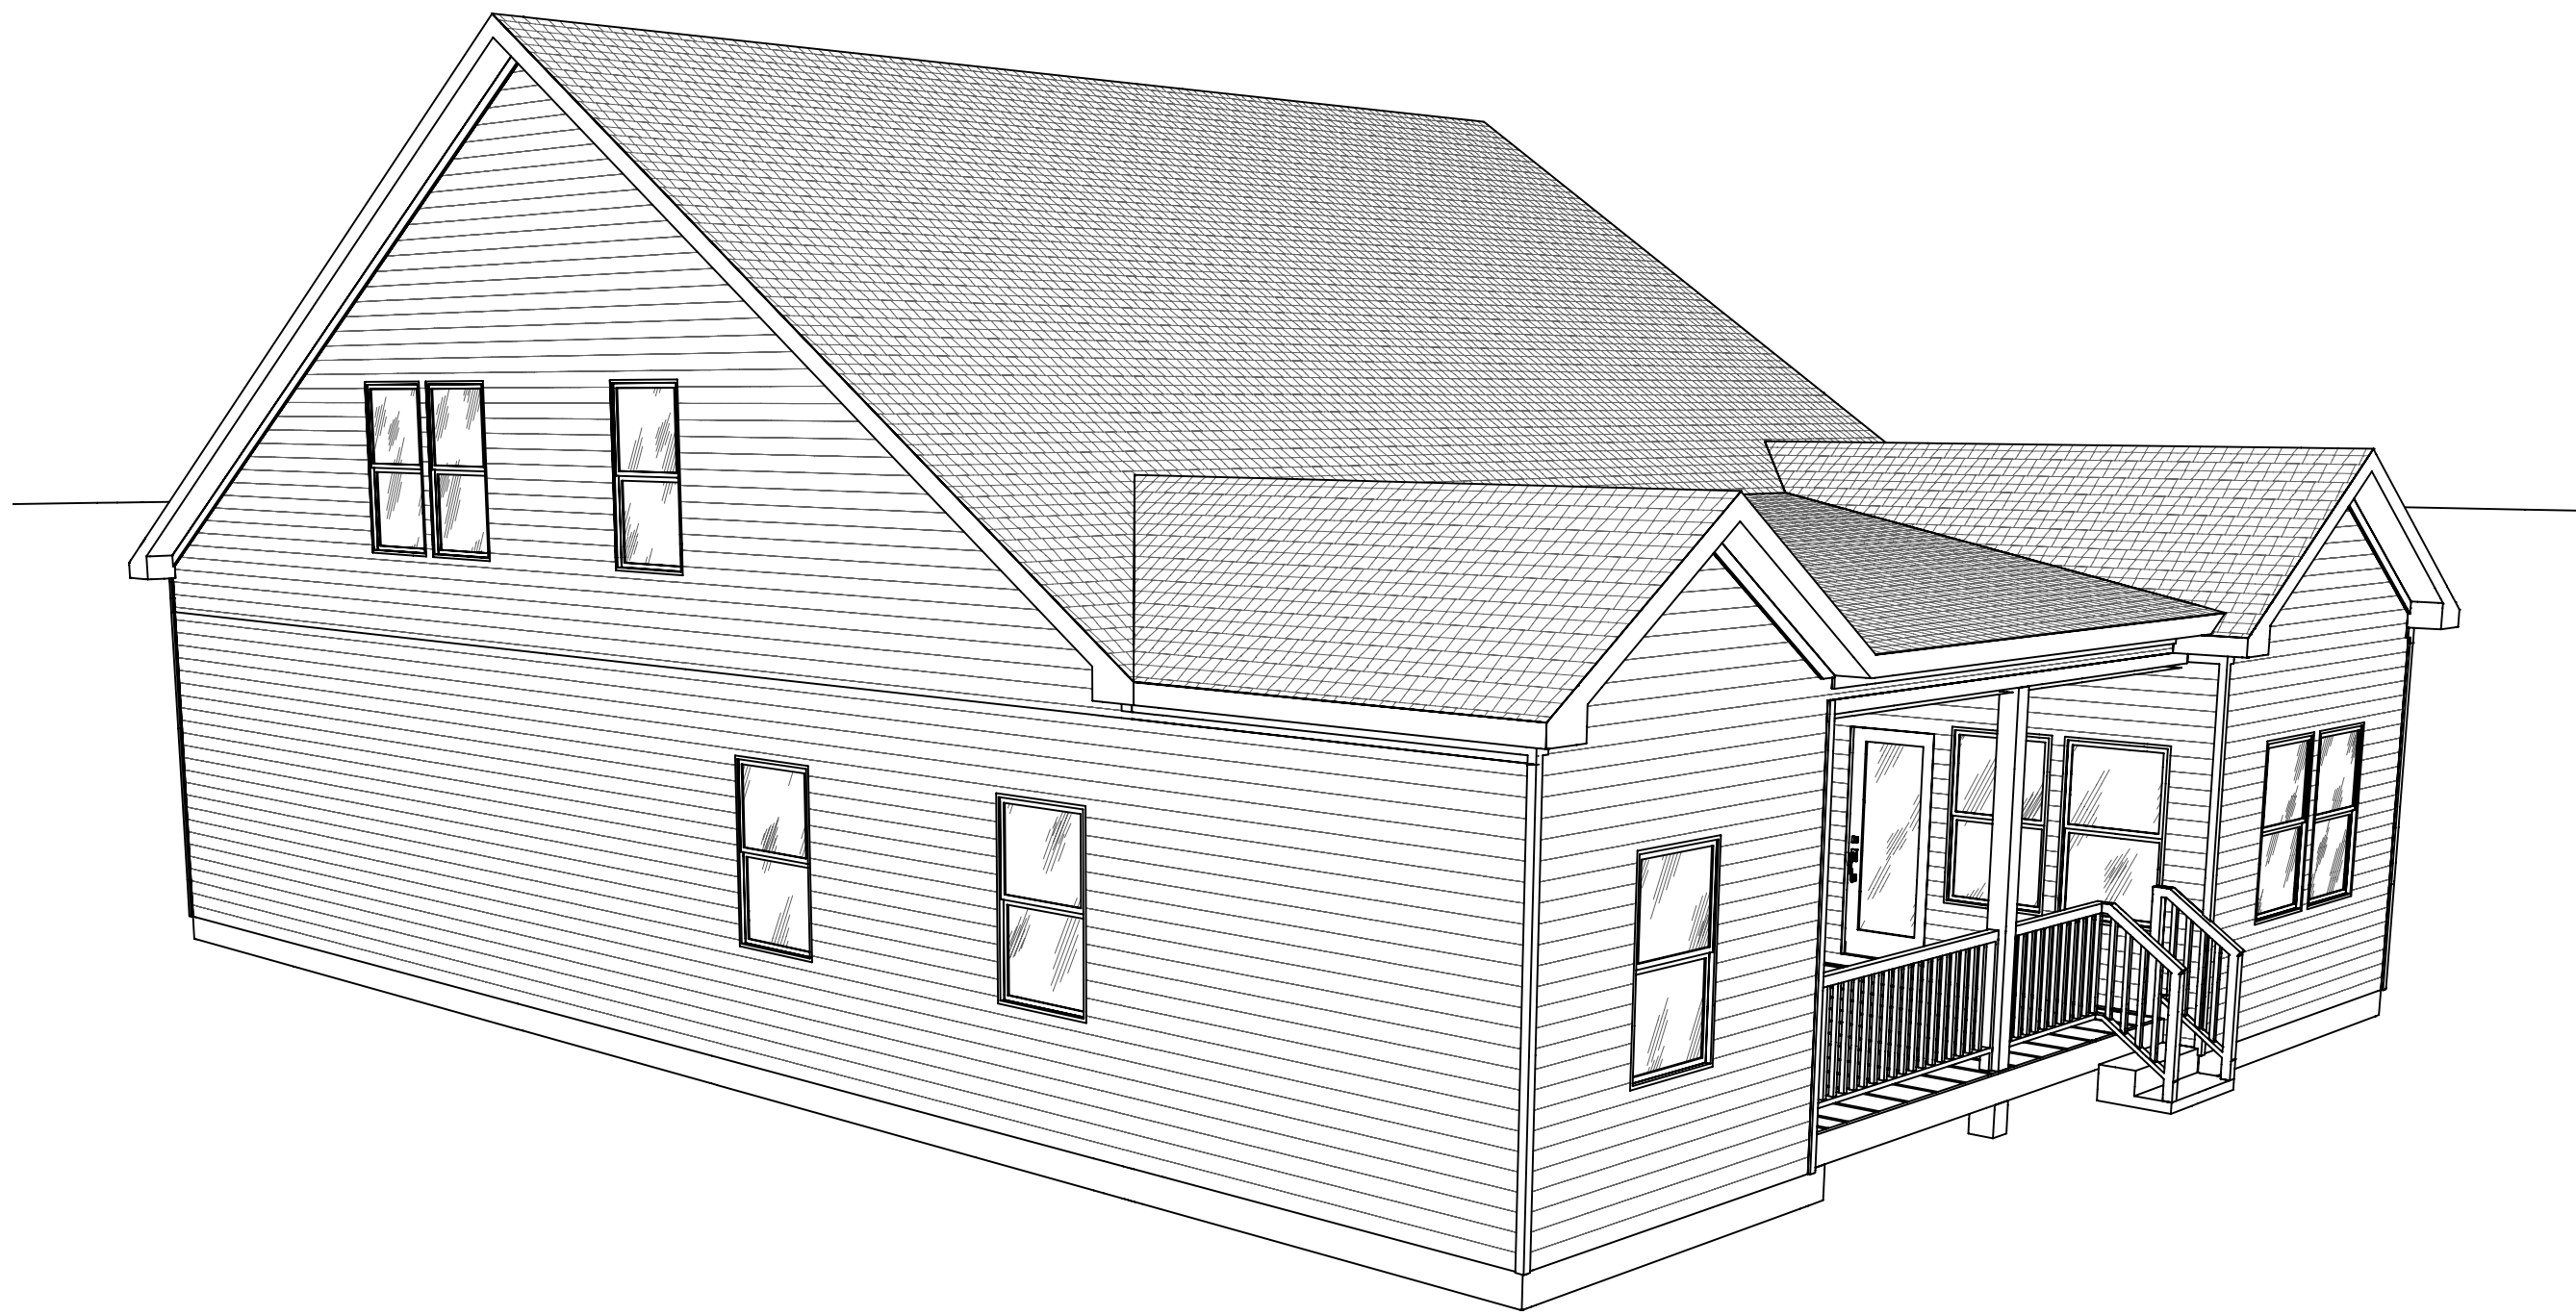


1 Back Left
NTS

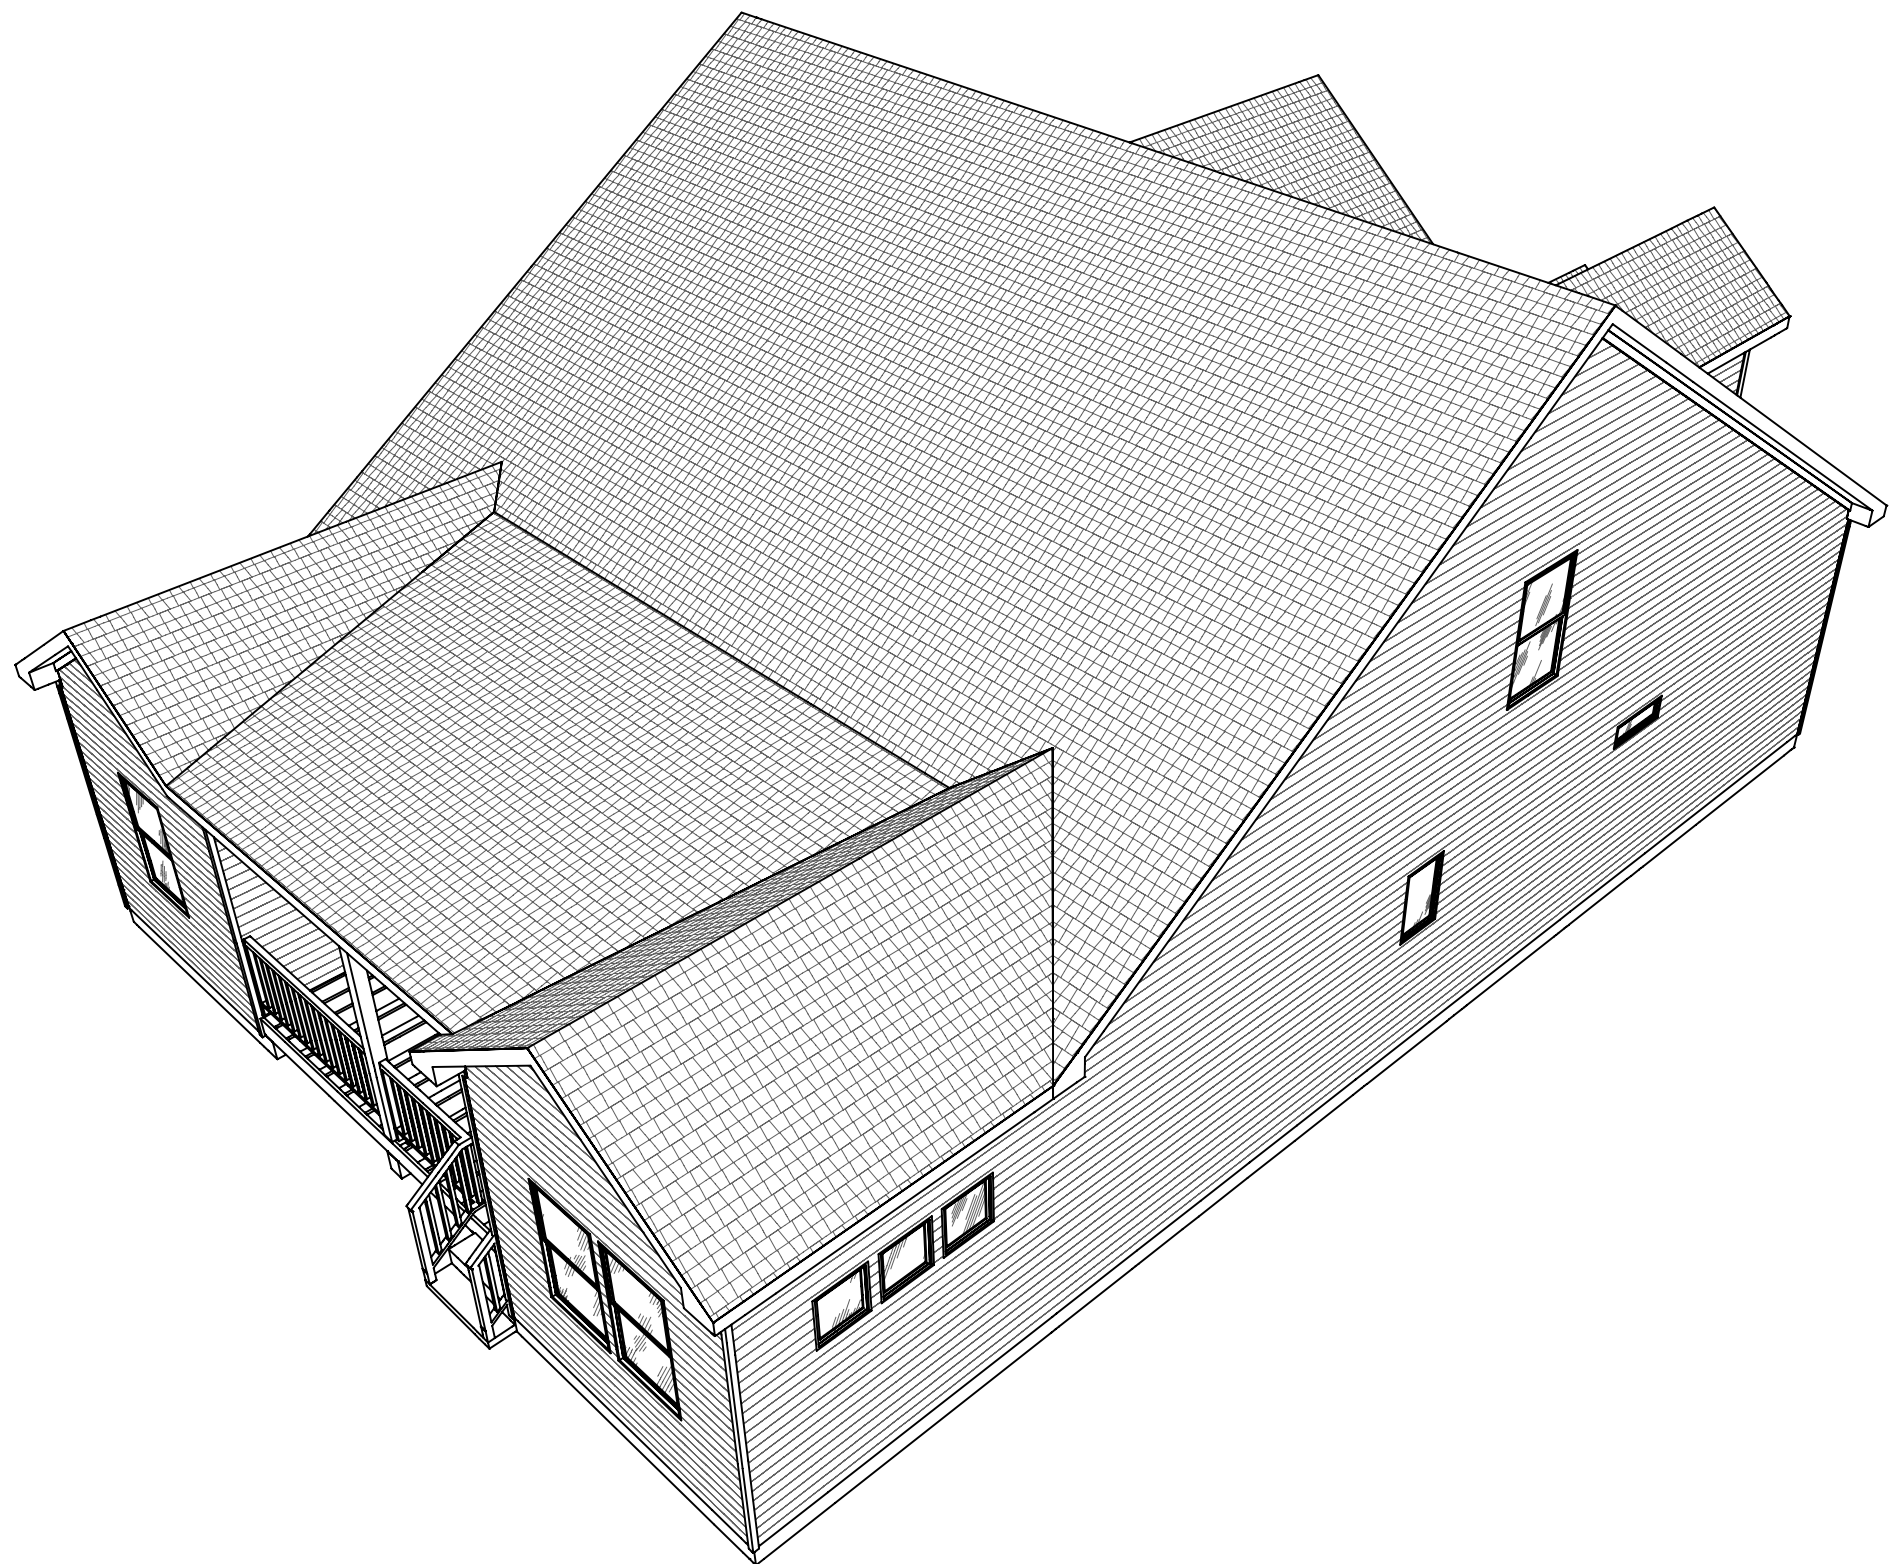

1 Back Right
NTS


REV.#	DESCRIPTION	DATE
1		
2		
3		
4		
5		
6		
7		
8		

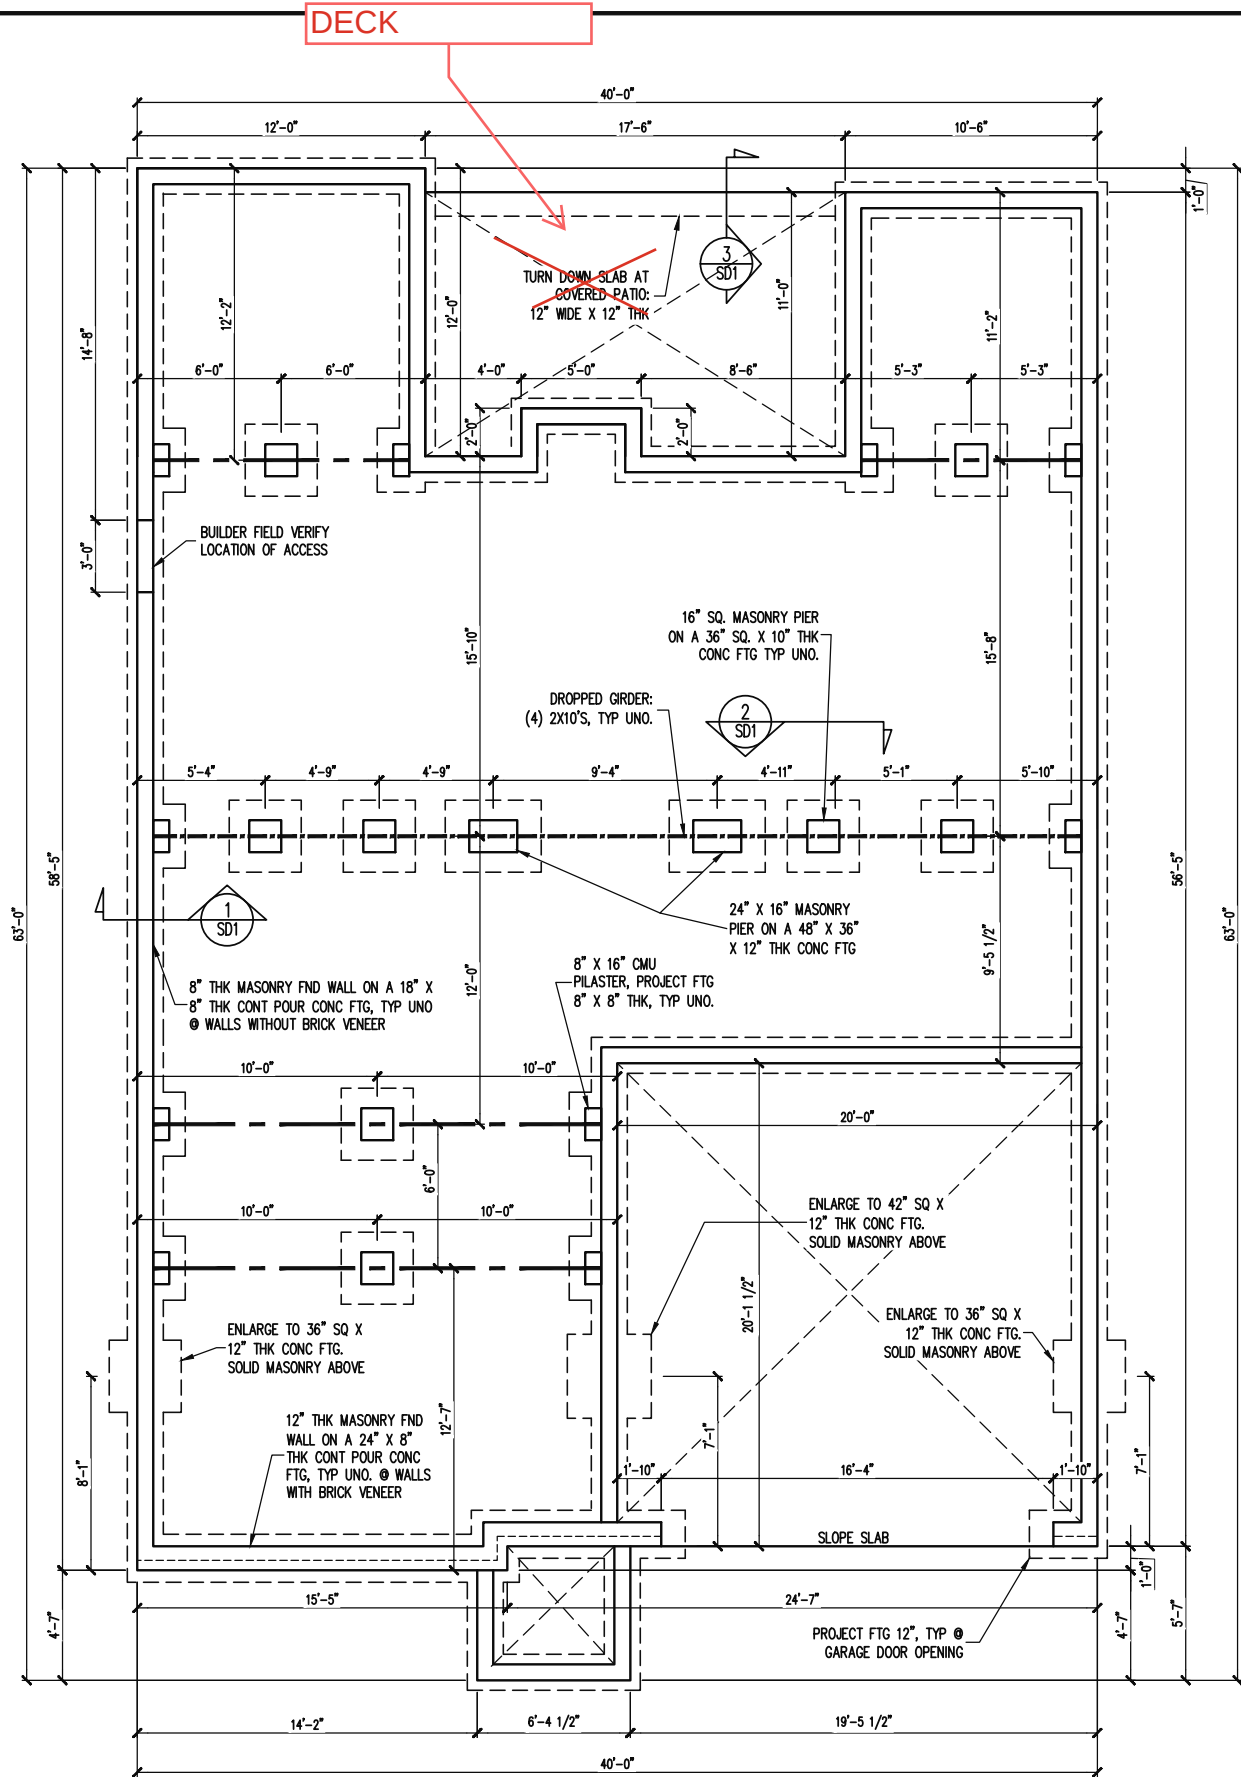

NOTES:
-HEIGHT AND BACKFILL LIMITATIONS FOR FOUNDATION WALLS ARE TO BE GOVERNED BY THE NCSBC, LATEST EDITION. REINFORCEMENT AND GROUTING SHALL BE DETERMINED BY FINAL SITE CONDITIONS.
-PLUMBING SHOWN FOR REFERENCE ONLY. BUILDER VERIFY FINAL FIXTURE LOCATIONS, SIZES AND REQUIREMENTS PRIOR TO INSTALLATION.

FOUNDATION PLAN
1/8" = 1'-0"

The structural design of this plan is the property of Engineering Tech Associates, P.A. These plans are for the one time use at the location and for the client listed. Engineering Tech Associates, P.A. assumes no liability for these plans if they are reproduced, in whole or in part, for construction at any other location without written permission from Engineering Tech Associates, P.A.

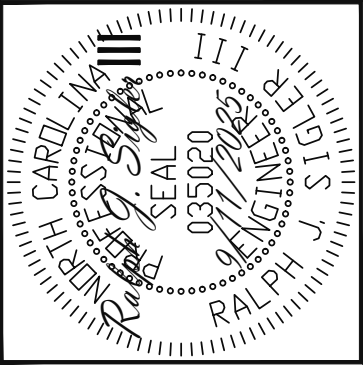

Engineering Tech Associates, P.A.
STRUCTURAL ENGINEERS
License No. C-3870
318 W Millbrook Rd. Unit 201
Raleigh, North Carolina 27609
Phone (919) 844-1661


NEW HOME INC.			
STRUCTURAL ADDENDUM			
SCOPE	REV #	REF PROJ #	DATE
LOC: 570 DEACON HILL ROAD			
ELEVATION: GEORGIAN			

ENG: RJS/ZCH
DATE: 9/11/2025

PLAN
GUILFORD

PROJECT NO.
25-29-010

SHEET NO.
S1
1 of 8

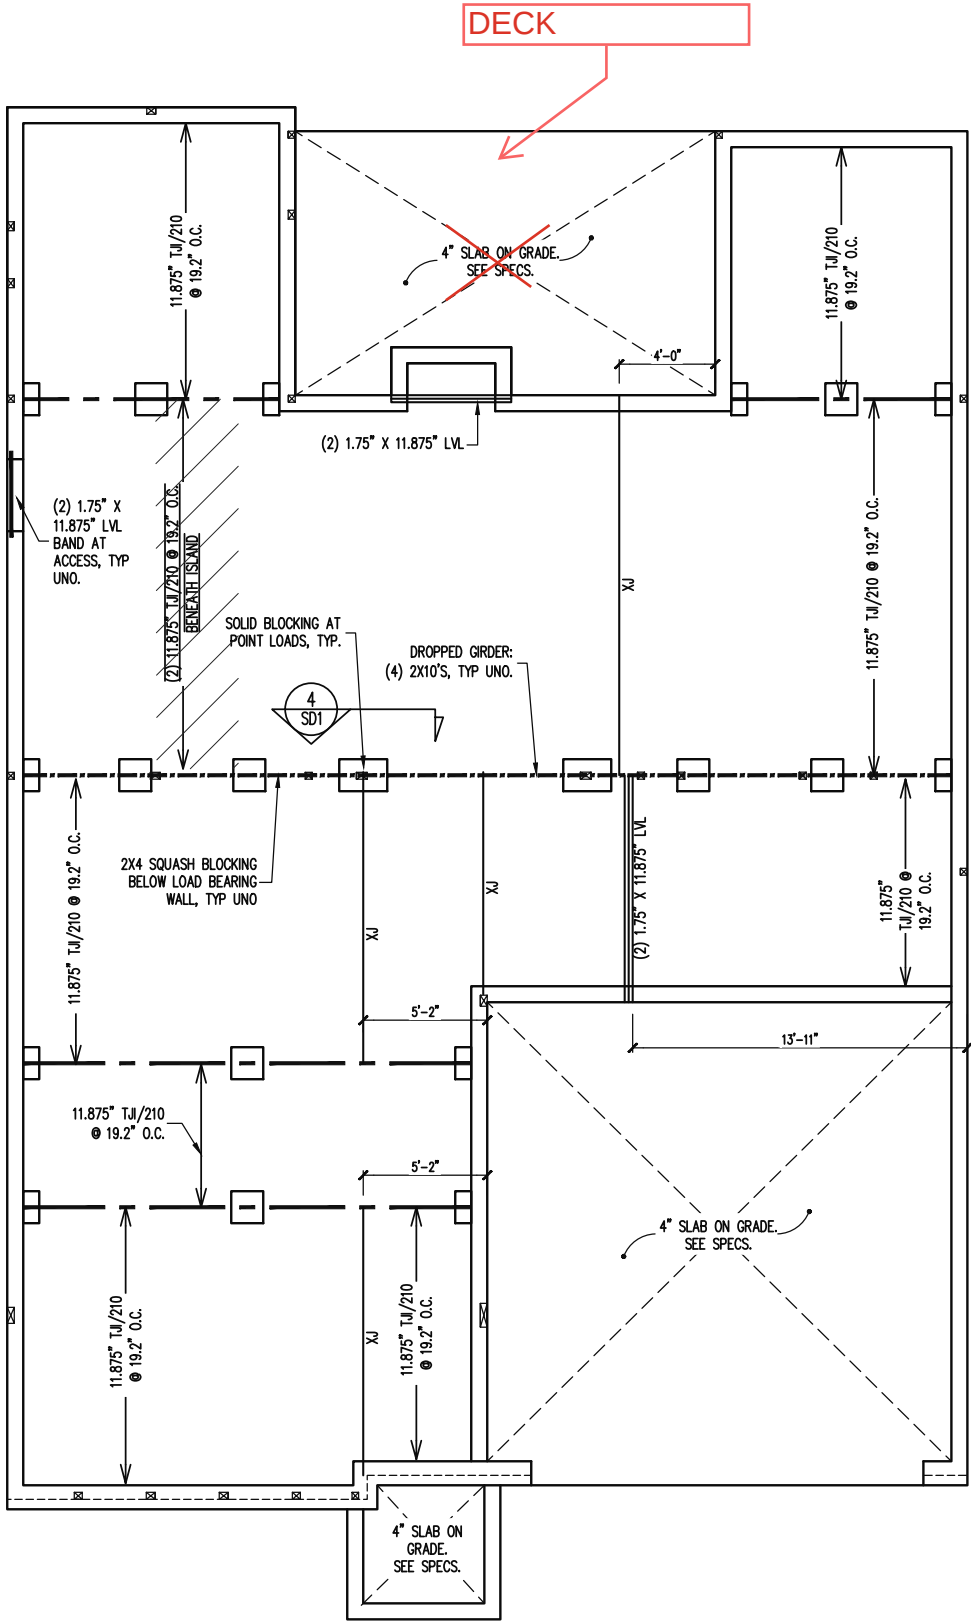


GIRDER LEGEND	
ALL GIRDERS (4) 2X10'S, TYP UNO. BOLTING NOT REQUIRED FOR DROPPED GIRDERS.	
I-JOIST SQUASH BLOCKING REQUIRED	_____
NOT REQUIRED	_____

CRAWLSPACE FRAMING PLAN

1/8" = 1'-0"

The structural design of this plan is the property of Engineering Tech Associates, P.A. These plans are for the one time use at the location and for the client listed. Engineering Tech Associates, P.A. assumes no liability for these plans if they are reproduced, in whole or in part, for construction at any other location without written permission from Engineering Tech Associates, P.A.

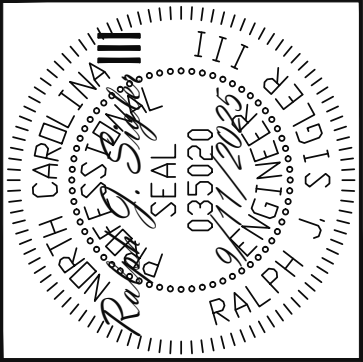

Engineering

Tech

ASSOCIATES, P.A.

STRUCTURAL ENGINEERS

License No. C-3870

318 W Millbrook Rd. Unit 201

Raleigh, North Carolina 27609

Phone (919) 844-1661


NEW HOME INC.			
STRUCTURAL ADDENDUM			
SCOPE	REV #	REF PROJ #	DATE
LOC: 570 DEACON HILL ROAD			
ELEVATION: GEORGIAN			

ENG: RJS/ZCH
DATE: 9/11/2025

PLAN
GUILFORD

PROJECT NO.
25-29-010

SHEET NO.
S2
2 of 8

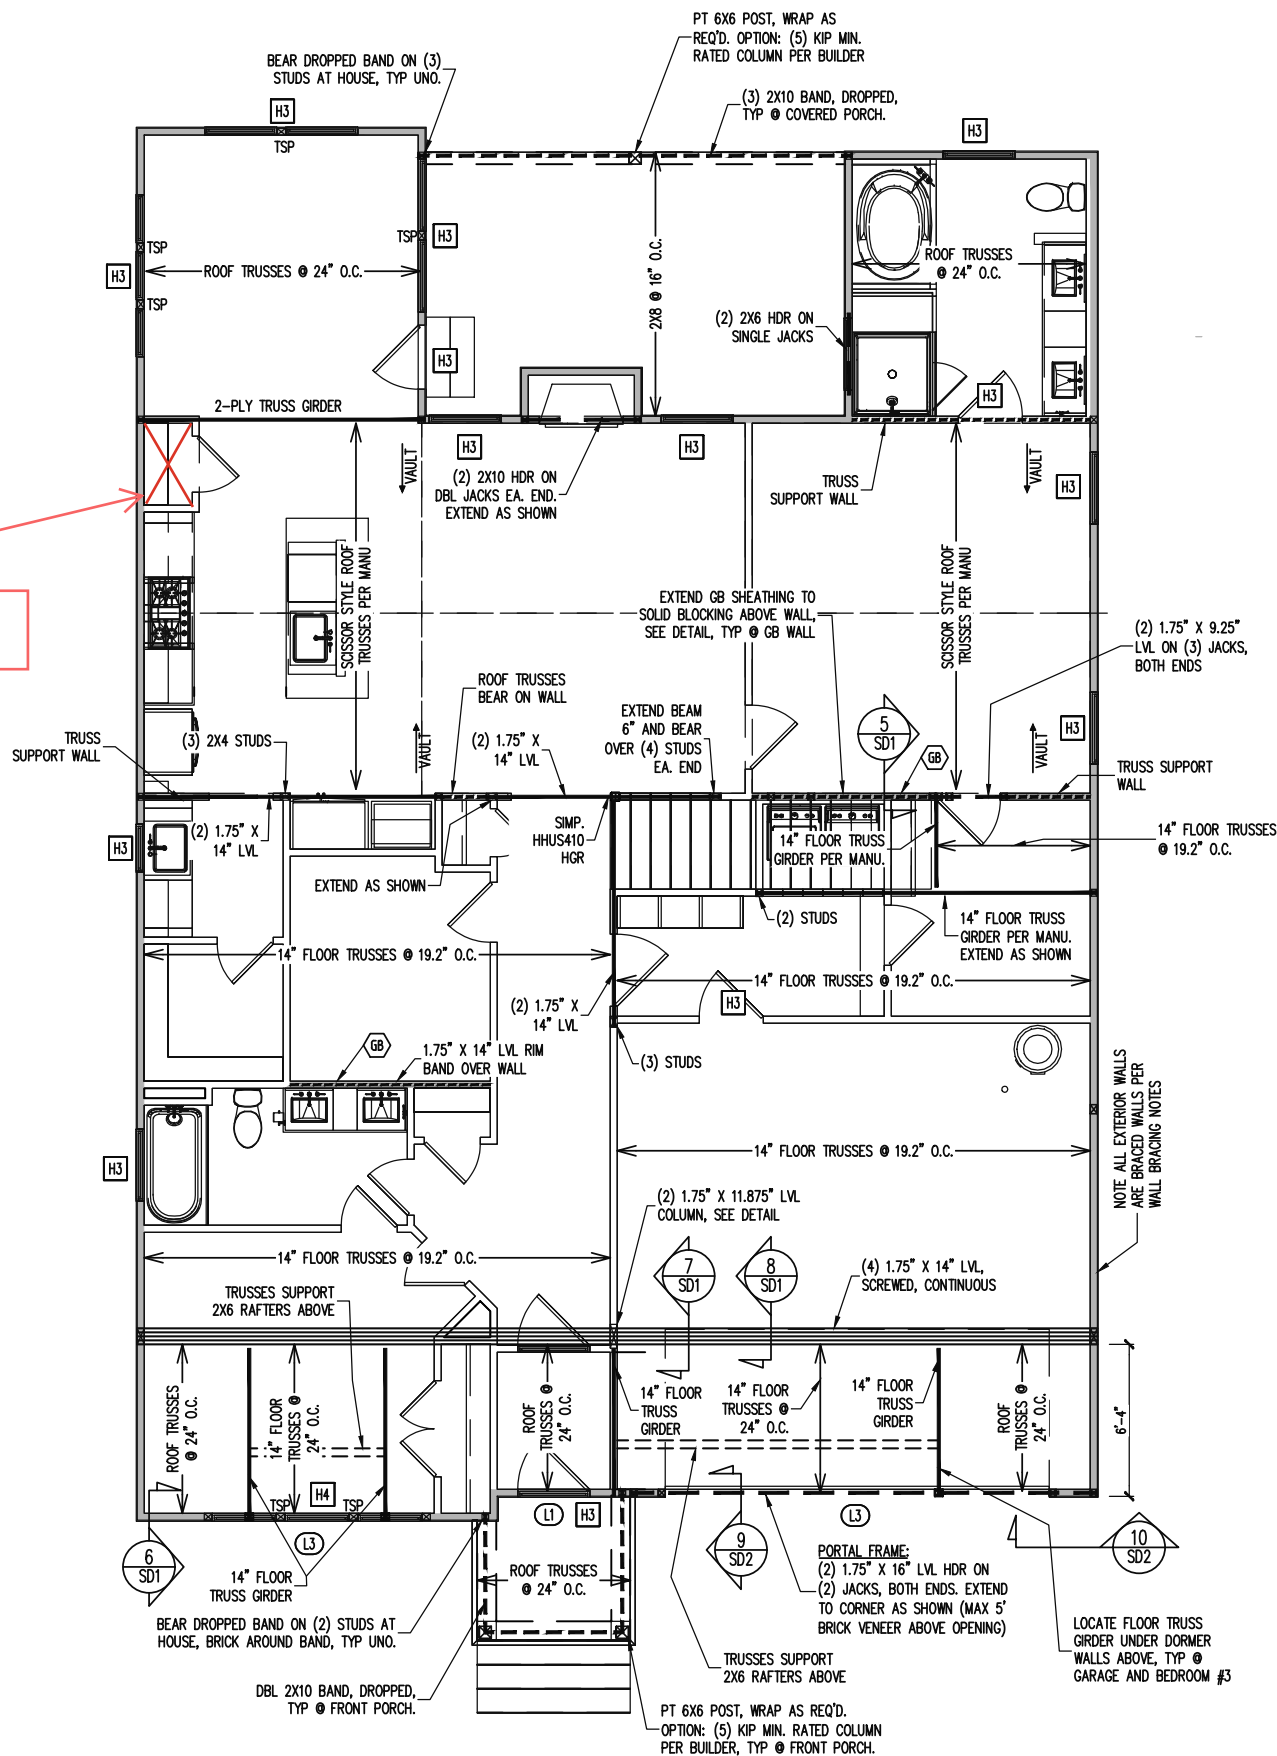

H1 SINGLE 2X4 TURNED FLAT (A)

H2 (2) 2X4'S ON SINGLE JACKS (B)

H3 (2) 2X10'S ON SINGLE JACKS (C)

H4 (2) 1.75" X 9.25" LVL'S ON DBL JACKS

H5 (3) 2X10'S ON SINGLE JACKS


(A) TYPICAL FOR INTERIOR NON LOAD BEARING WALLS ONLY, ROUGH OPENING 38" MAX.

(B) TYPICAL FOR INTERIOR NON LOAD BEARING WALLS ONLY, ROUGH OPNG 38" TO 74" MAX.

(C) TYPICAL FOR ALL CONDITIONS NOT LISTED IN (A) OR (B) UNO.

NOTES:

-HEADERS IN NON LOAD BEARING INTERIOR WALLS ARE NOT LABELED.

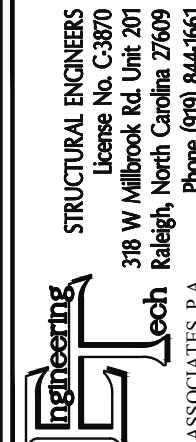



The structural design of this plan is the property of Engineering Tech Associates, P.A. These plans are for the one time use at the location and for the client listed. Engineering Tech Associates, P.A. assumes no liability for these plans if they are reproduced, in whole or in part, for construction at any other location without written permission from Engineering Tech Associates, P.A.

NEW HOME INC.			
SCOPE: STRUCTURAL ADDENDUM			
LOC:	570 DEACON HILL ROAD	REV #	REF PROJ #
ELEVATION:	GEORGIAN		
ENG: RJS/ZCH			
DATE: 9/11/2025			
PLAN			
GUILFORD			
PROJECT NO.			
25-29-010			
SHEET NO.			
S3			
3 of 8			



NEW HOME INC.	
SCOPE:	STRUCTURAL ADDENDUM
LOC:	570 DEACON HILL ROAD
ELEVATION:	GEORGIAN
ENG:	RJS/ZCH
DATE:	9/11/2025
PLAN	
GUILFORD	
PROJECT NO.	
25-29-010	
SHEET NO.	
S4	
4 of 8	

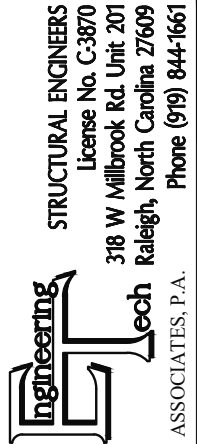

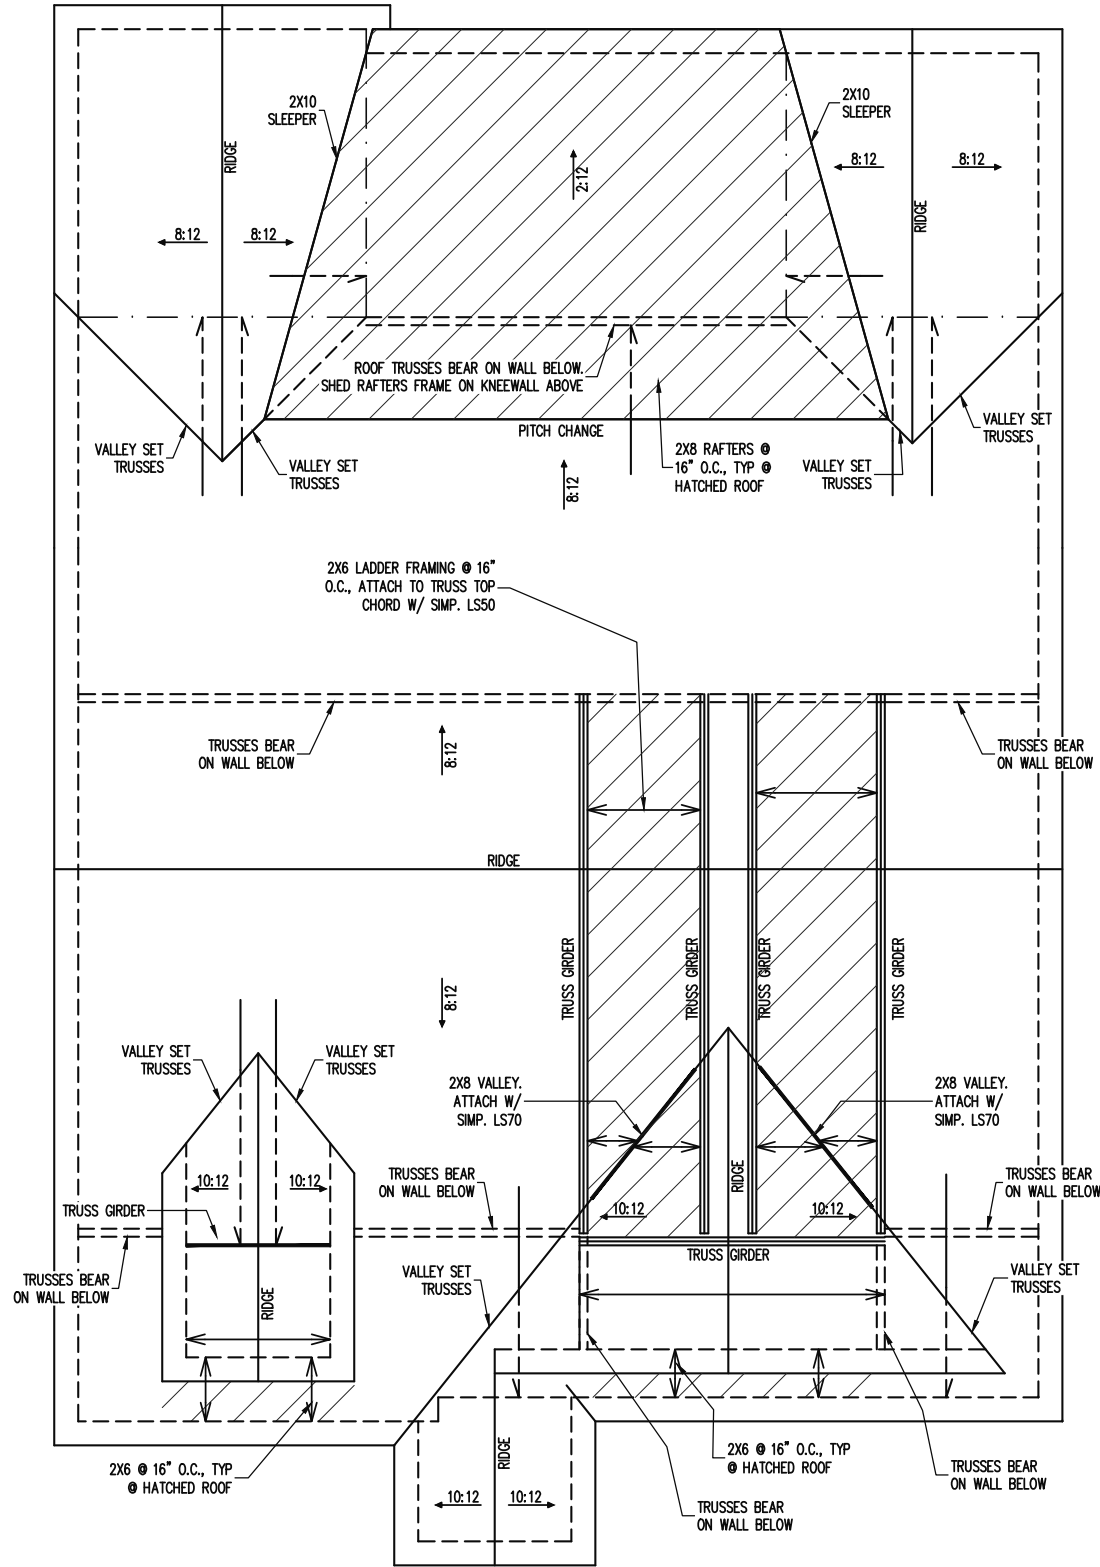


FRAMING NOTES

TRUSS UPLIFT CONNECTORS

1/8" = 1'-0"

ROOF FRAMING PLAN

The structural design of this plan is the property of Engineering Tech Associates, P.A. These plans are for the one time use at the location and for the client listed. Engineering Tech Associates, P.A. assumes no liability for these plans if they are reproduced, in whole or in part, for construction at any other location without written permission from Engineering Tech Associates, P.A.

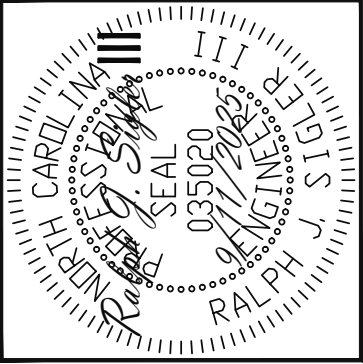

Engineering Tech Associates, P.A.

STRUCTURAL ENGINEERS

License No. C-3870

318 W Millbrook Rd. Unit 201

Raleigh, North Carolina 27609

Phone (919) 844-1661









NEW HOME INC.			
STRUCTURAL ADDENDUM			
SCOPE	REV #	REF PROJ #	DATE
LOC	570 DEACON HILL ROAD		
ELEVATION:	GEORGIAN		

ENG	RJS/ZCH
DATE	9/11/2025


PLAN
GUILFORD

PROJECT NO.
25-29-010

SHEET NO.
S5
5 of 8

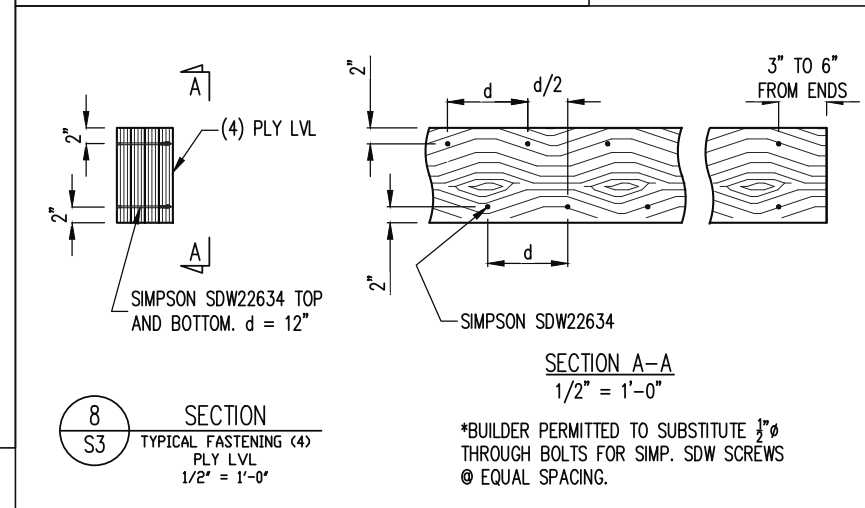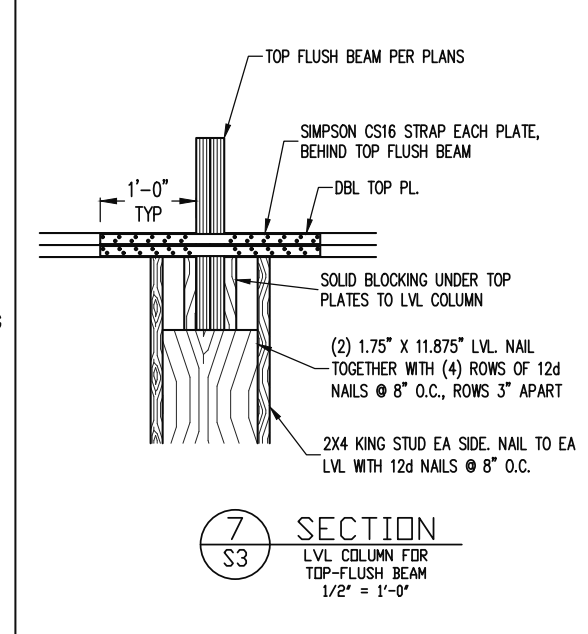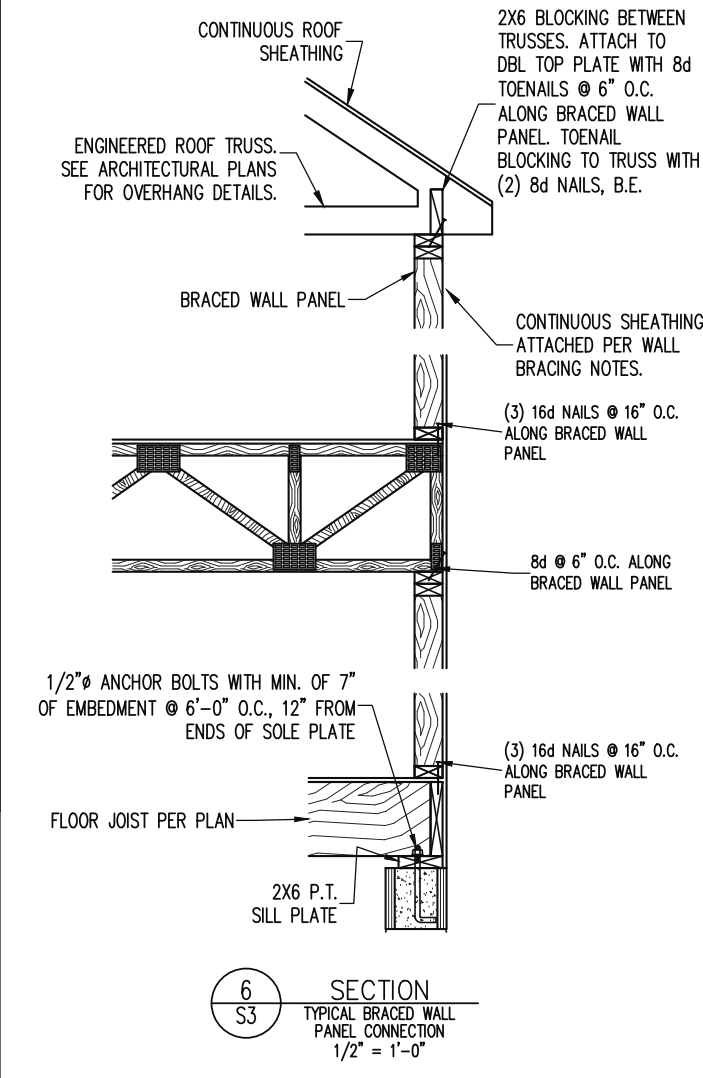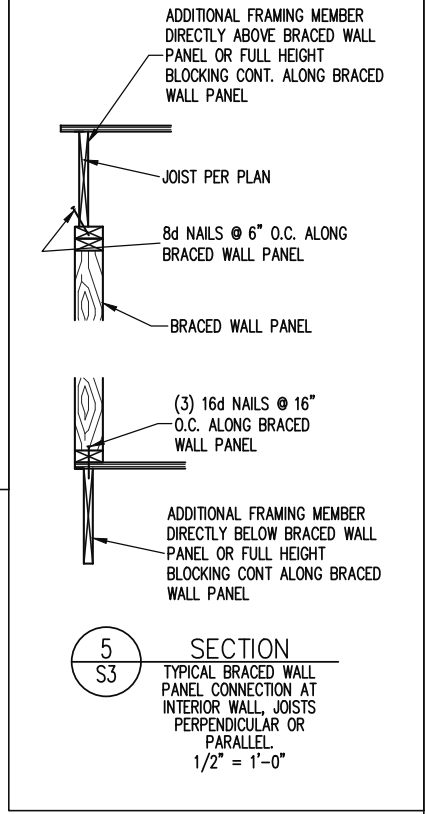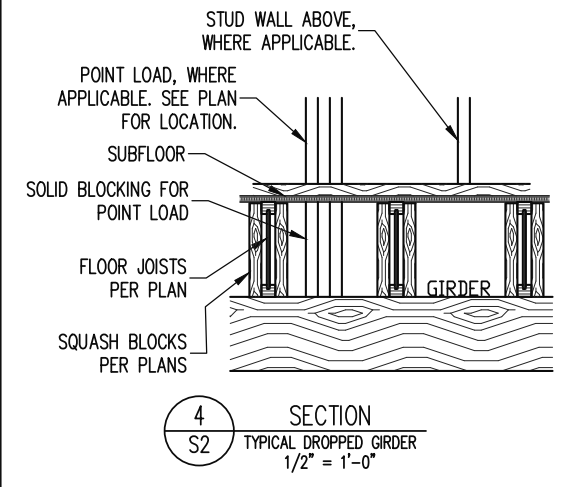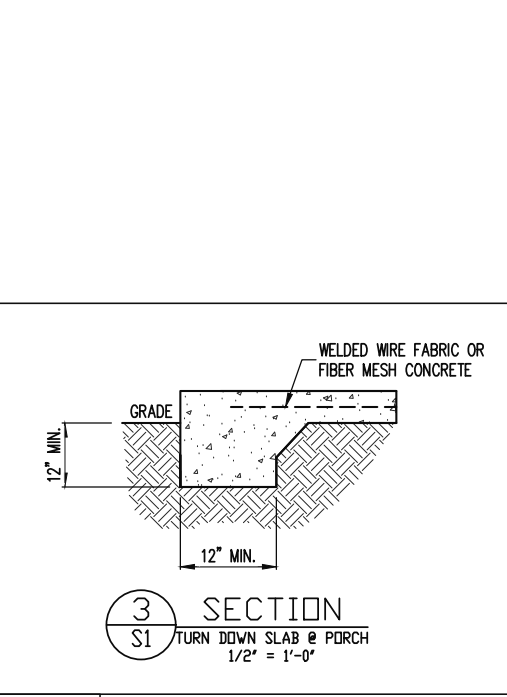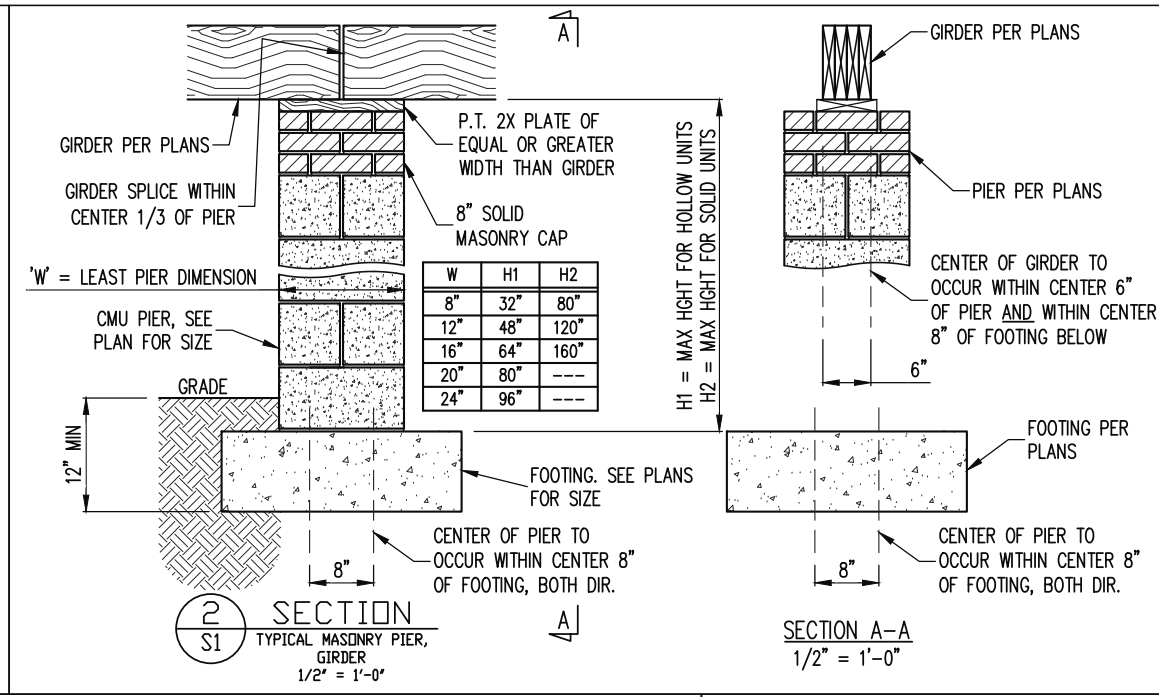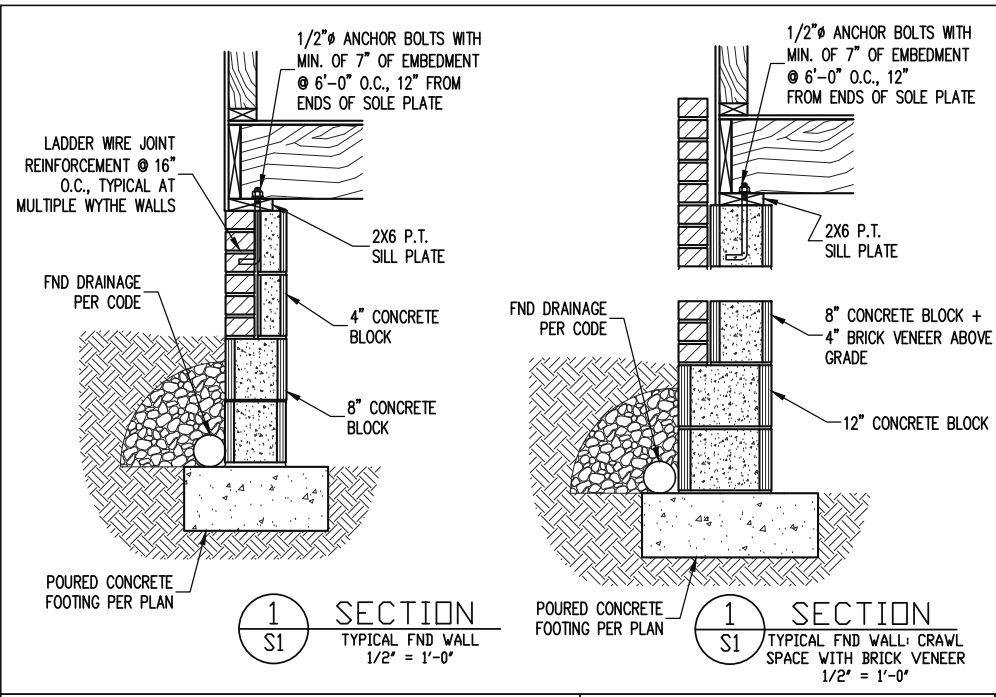

The structural design of this plan is the property of Engineering Tech Associates, P.A. These plans are for the one time use at the location and for the client listed. Engineering Tech Associates, P.A. assumes no liability for these plans if they are reproduced, in whole or in part, for construction at any other location without written permission from Engineering Tech Associates, P.A.

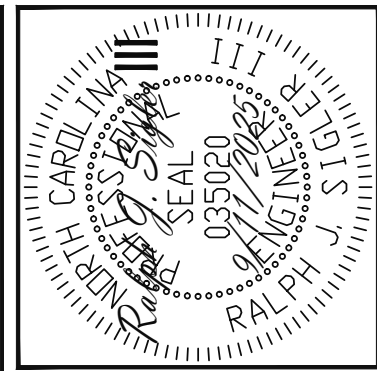

Engineering Tech Associates, P.A.
STRUCTURAL ENGINEERS
License No. C-3870
318 W Millbrook Rd. Unit 201
Raleigh, North Carolina 27609
Phone (919) 844-1661




NEW HOME INC.			
STRUCTURAL ADDENDUM			
SCOPE	REV #	REF PROJ #	DATE
LOC	570 DEACON HILL ROAD		
ELEVATION:	GEORGIAN		

ENG: RJS/ZCH
DATE: 9/11/2025

PLAN
GUILFORD

PROJECT NO.
25-29-010

SHEET NO.
SD1
6 of 8

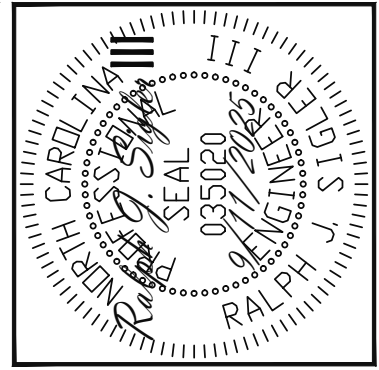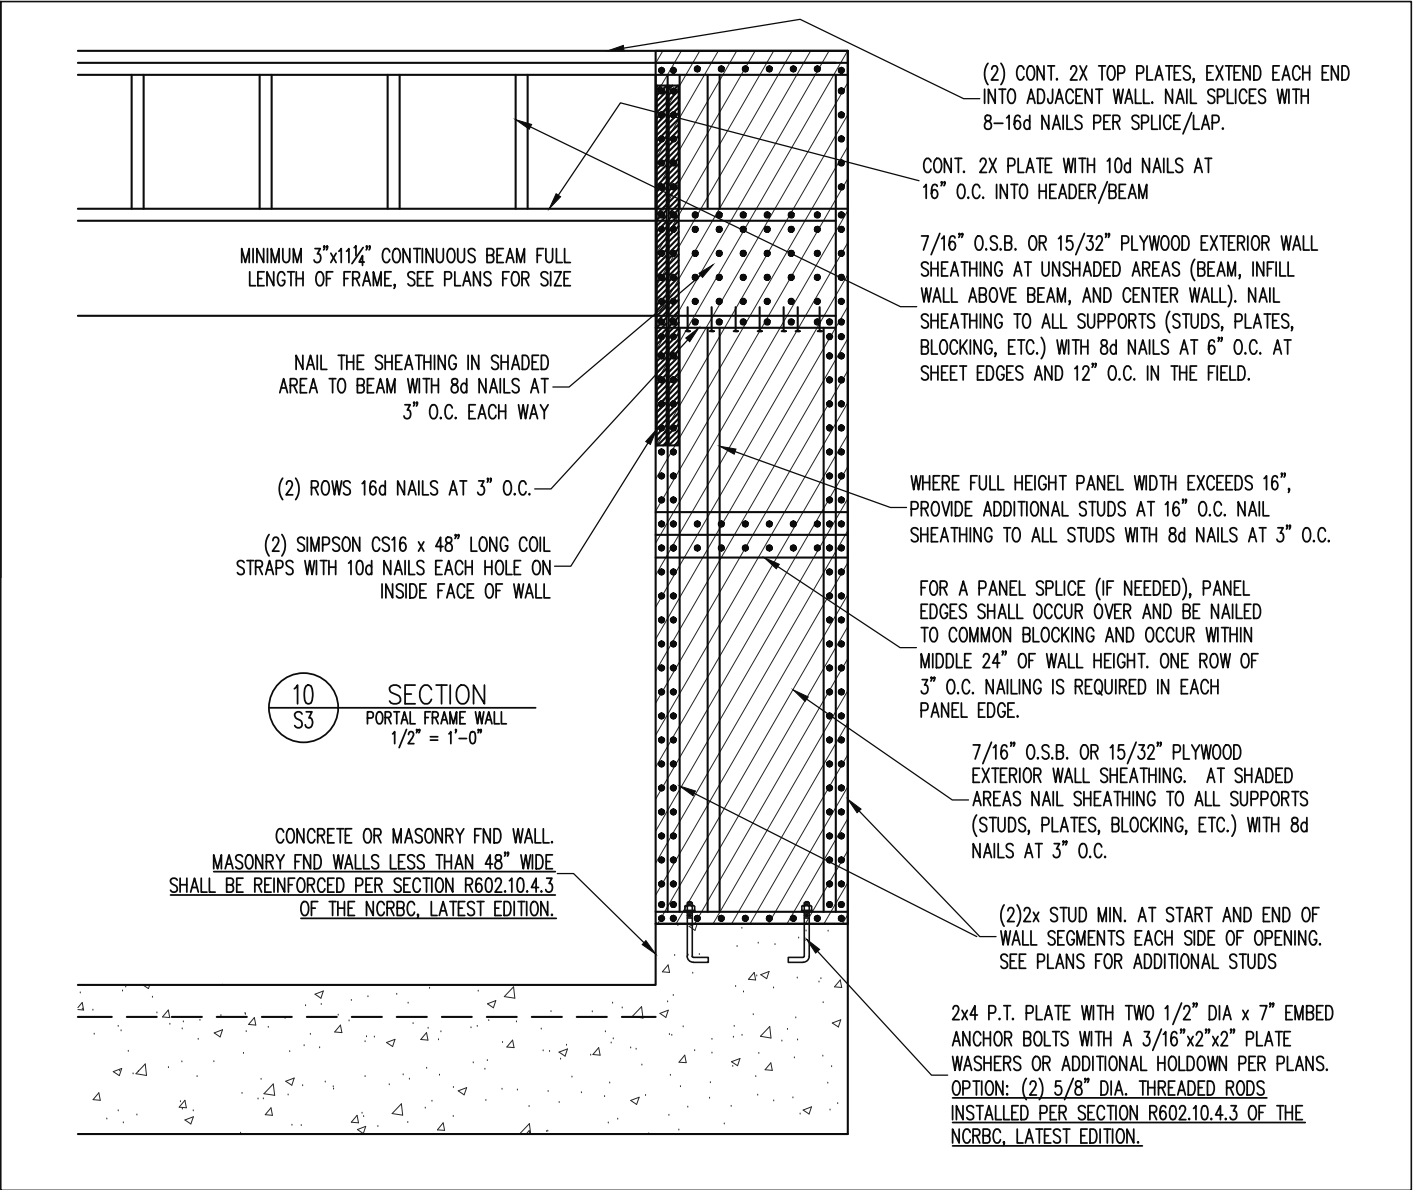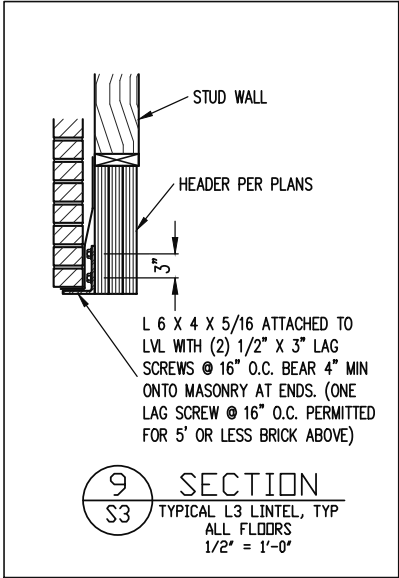

The structural design of this plan is the property of Engineering Tech Associates, P.A. These plans are for the one time use at the location and for the client listed. Engineering Tech Associates, P.A. assumes no liability for these plans if they are reproduced, in whole or in part, for construction at any other location without written permission from Engineering Tech Associates, P.A.

Engineering Tech Associates, P.A.
STRUCTURAL ENGINEERS
 License No. C-3870
 318 W Millbrook Rd. Unit 201
 Raleigh, North Carolina 27609
 Phone (919) 844-1661


NEW HOME INC.			
SCOPE	STRUCTURAL ADDENDUM	REV #	REF PROJ #
LOC	570 DEACON HILL ROAD		
ELEVATION:	GEORGIAN		
		DATE	

ENG	RJS/ZCH
DATE	9/11/2025

PLAN
GUILFORD

PROJECT NO.
25-29-010

SHEET NO.
SD2
7 of 8

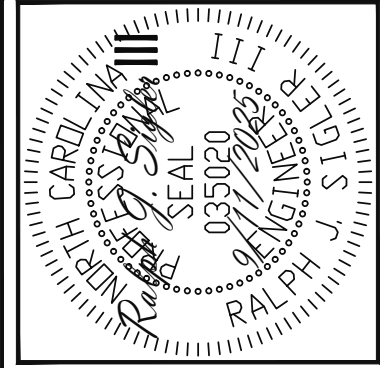

The structural design of this plan is the property of Engineering Tech Associates, P.A. These plans are for the one time use at the location and for the client listed. Engineering Tech Associates, P.A. assumes no liability for these plans if they are reproduced, in whole or in part, for construction at any other location without written permission from Engineering Tech Associates, P.A.

Engineering
Tech
ASSOCIATES, P.A.

STRUCTURAL ENGINEERS
License No. C-3870
318 W Millbrook Rd. Unit 201
Raleigh, North Carolina 27609
Phone (919) 844-1661

NEW HOME INC.			
SCOPE	STRUCTURAL ADDENDUM		
	REV #	REF PROJ #	DATE
LOC	570 DEACON HILL ROAD		
ELEVATION:	GEORGIAN		

ENG	RJS/ZCH
DATE	9/11/2025
PLAN	
GUILFORD	
PROJECT NO.	
25-29-010	
SHEET NO.	
SD3	
8 of 8	

CONSTRUCTION SPECIFICATIONS			ABBREVIATIONS																																																																																																																																																						
PART 1: GENERAL 1.01 CONSTRUCTION SHALL MEET THE REQUIREMENTS OF THE NORTH CAROLINA RESIDENTIAL CODE, 2018 EDITION. 1.02 DIMENSIONS SHOWN SHALL GOVERN OVER SCALE ON THESE DRAWINGS. 1.05 METHODS, PROCEDURES AND SEQUENCES OF CONSTRUCTION ARE THE RESPONSIBILITY OF THE CONTRACTOR, WHO SHALL TAKE ALL NECESSARY PRECAUTIONS TO MAINTAIN AND INSURE THE INTEGRITY OF THE STRUCTURE AT ALL STAGES OF CONSTRUCTION. PART 2: DESIGN LOADS 2.01 DESIGN LOADS SHALL CONFORM WITH THE TABLE BELOW: <table><tr><th>USE</th><th>LIVE LOAD (PSF)</th><th>DEAD LOAD (PSF)</th></tr><tr><td>BALCONIES, DECKS, ATTICS WITH FIXED STAIR ACCESS, DWELLING UNITS INCLUDING ATTICS WITH FIXED STAIR ACCESS, STAIRS, FIRE ESCAPES</td><td>40</td><td>10</td></tr><tr><td>GARAGES (PASSENGER CARS ONLY)</td><td>50</td><td>---</td></tr><tr><td>ATTICS (NO STORAGE, LESS THAN 5' HEADROOM)</td><td>10</td><td>10</td></tr><tr><td>ATTICS (WITH STORAGE)</td><td>20</td><td>10</td></tr><tr><td>ROOF</td><td>20</td><td>10 (15 FOR VAULTS)</td></tr></table> NOTES: -- INDIVIDUAL STAIR TREADS ARE TO BE DESIGNED FOR THE UNIFORMLY DISTRIBUTED LIVE LOAD OF 40 PSF OR A 300 LB. CONCENTRATED LOAD ACTING OVER AN AREA OF 4 SQ. WHICHEVER PRODUCES THE GREATER STRESS. -- BUILD TO VERIFY DEAD LOAD DOES NOT EXCEED 10 PSF WHEN HEAVY FLOOR OR ROOF FINISHES SUCH AS TILE OR SLATE ARE UTILIZED. NOTIFY ENGINEERING UNDER THESE CONDITIONS. 2.02 INTERIOR WALLS: 5 PSF LATERAL. 2.03 BASIC WIND DESIGN VELOCITY OF 120 MPH. 2.04 SOIL BEARING CAPACITY 2000 PSF (PRESUMPTIVE). PART 3: STRUCTURAL STEEL 3.01 WIDE FLANGE BEAMS AND TEE SECTIONS SHALL CONFORM TO ASTM A992 MINIMUM GRADE. 3.02 SQUARE AND RECTANGULAR TUBING SHALL CONFORM TO ASTM A500 GRADE B MINIMUM GRADE. 3.03 STEEL PIPE SHALL CONFORM TO ASTM A53 GRADE B, TYPE S, MINIMUM GRADE. 3.04 ALL OTHER STRUCTURAL STEEL SHALL CONFORM TO ASTM A36 MINIMUM GRADE. 3.05 STRUCTURAL STEEL CONSTRUCTION SHALL MEET THE REQUIREMENTS OF THE AISC SPECIFICATION FOR THE DESIGN, FABRICATION AND ERECTION OF STRUCTURAL STEEL FOR BUILDINGS. PART 4: WELDING 4.01 WELDING ELECTRODES SHALL BE E70XX AND ALL WELDING SHALL BE PERFORMED BY AN AWS CERTIFIED WELDER. PART 5: CONCRETE AND SLABS ON GRADE 5.01 CAST IN PLACE CONCRETE SHALL BE OF NORMAL WEIGHT, 4-6% AIR ENTRAINMENT, FOR EXTERIOR CONCRETE AND SHALL HAVE A MINIMUM COMPRESSIVE STRENGTH OF 3000 PSI AT 28 DAYS TYP UNO. ALL ITEMS NOTED AS "CONCRETE" ARE TO BE CAST IN PLACE, TYP UNO. 5.02 REINFORCED CAST IN PLACE CONCRETE SHALL BE PROPORTIONED, MIXED AND PLACED IN ACCORDANCE WITH THE SPECIFICATIONS OF ACI 318, LATEST EDITION. 5.03 SLABS ON GRADE, IF ANY, SHALL BE CAST IN PLACE, CONTAIN SYNTHETIC POLYPROPYLENE FIBRILLATED MICRO FIBERS, FIBER LENGTH 1 1/2", DOSAGE RATE 1 1/2 LBS/CU YD. SLAB TO BE PLACED ON A 6 MIL VAPOR BARRIER ON 4" MIN GRANULAR FILL ON SOIL WITH 90% MIN STANDARD PROCTOR DENSITY. VAPOR BARRIER MAY BE OMITTED FOR SLABS NOT IN ENCLOSED AREAS. PART 6: REBAR AND WIRE REINFORCEMENT 6.01 REBAR SHALL BE DEFORMED STEEL CONFORMING TO ASTM A615 GRADE 60 TYP UNO 6.02 LAP SPICES SHALL BE CLASS B AS DEFINED BY ACI 318, TYP UNO. <u>STAGGER ADJACENT SPICES A MINIMUM OF ONE LAP LENGTH</u> 6.03 WIRE REINFORCEMENT SHALL BE 9 GA AND SHALL CONFORM TO ASTM A1064. PART 7: MASONRY			USE	LIVE LOAD (PSF)	DEAD LOAD (PSF)	BALCONIES, DECKS, ATTICS WITH FIXED STAIR ACCESS, DWELLING UNITS INCLUDING ATTICS WITH FIXED STAIR ACCESS, STAIRS, FIRE ESCAPES	40	10	GARAGES (PASSENGER CARS ONLY)	50	---	ATTICS (NO STORAGE, LESS THAN 5' HEADROOM)	10	10	ATTICS (WITH STORAGE)	20	10	ROOF	20	10 (15 FOR VAULTS)	7.01 CONCRETE MASONRY UNITS SHALL CONFORM TO ASTM C90 AND C55, NORMAL WEIGHT, FM = 1,500 PSI MIN 7.02 CLAY MASONRY UNITS SHALL CONFORM TO ASTM C62-17 GRADE SW 7.03 MORTAR SHALL BE TYPE S. MORTAR AND GROUT SHALL CONFORM TO ASTM C476, MIN COMPRESSIVE STRENGTH OF 2000 PSI. 7.04 MASONRY CONSTRUCTION SHALL CONFORM TO THE SPECIFICATIONS OF ACI 530 7.05 LADDER WIRE REINFORCEMENT SHALL CONFORM TO ASTM A951. 6" MIN LAPS FOR CONTINUOUS WALL APPLICATIONS PART 8: BOLTS AND LAG SCREWS 8.01 BOLTS SHALL CONFORM TO ASTM A307 MINIMUM GRADE TYP UNO. INSTALL USS STEEL WASHERS (ASTM F844-07a) FOR THE NUT / BOLT HEAD WHEN BOLTING WOOD MEMBERS. HOLES FOR BOLTS SHALL BE ALSO STANDARD HOLES UNO 8.02 LAG SCREWS SHALL CONFORM TO ANSI/ASME STANDARD B18.2.1-1981. PILOT HOLES SHALL BE USED FOR LAG SCREW INSTALLATION AND SHALL BE BORED ACCORDING TO NDS SPECIFICATIONS. INSTALL STANDARD STEEL WASHERS (ASTM F844-07a) FOR SCREW HEAD 8.03 ANCHOR RODS AND BOLTS SHALL CONFORM TO ASTM F1554-15 GRADE 36 UNO. BENT ANCHOR BOLTS SHALL HAVE A 2" MIN HOOK UNO PART 9: DRIVEN FASTENERS 9.01 NAILS, SPIKES AND STAPLES SHALL CONFORM TO ASTM F 1667-- 05. NAILS ARE TO BE COMMON WIRE OR BOX PART 10: DIMENSIONAL LUMBER 10.01 SOLID SAWN WOOD FRAMING DESIGN IS BASED ON NO. 2 SPRUCE PINE FIR OR SYP #2 FOR JOISTS, RAFTERS, GIRDERS, BEAMS, STUDS, ETC. MINIMUM ALLOWABLE DESIGN PROPERTIES ARE AS FOLLOWS: E= 1,400,000 PSI, F_{c pop} = 425 PSI, F_v = 135 PSI, SPECIFIC GRAVITY = 0.42 MIN F_b = 875 PSI FOR 2X4, 2X6, 2X8, F_b = 800 PSI FOR 2X10'S, 750 PSI FOR 2X12'S PART 11: ENGINEERED LUMBER 11.01 LVL OR PSL MINIMUM ALLOWABLE DESIGN PROPERTIES ARE AS FOLLOWS: E= 1,900,000 PSI, F_b = 2600 PSI, F_v = 285 PSI, F_{c pop} = 750 PSI LSL MINIMUM ALLOWABLE DESIGN STRESSES ARE AS FOLLOWS: E= 1.3 X 10E6 PSI, F_b = 1700 PSI, F_v = 400 PSI, F_{c pop} = 680 PSI 11.02 LVL OR PSL MEMBERS MAY BE RIPPED FROM DEEPER MEMBERS TO MATCH THE MEMBER DEPTH SPECIFIED IN THE PLANS. MAY SUBSTITUTE PSL AND LVL FOR EACH OTHER UNO PART 12: PRESSURE TREATED LUMBER 12.01 LUMBER IN CONTACT WITH THE GROUND, CONCRETE OR MASONRY SHALL BE PRESSURE TREATED IN ACCORDANCE WITH AMPA STANDARD C-15. ALL OTHER EXPOSED LUMBER SHALL BE TREATED IN ACCORDANCE WITH AMPA STANDARD C-2 OR BY ANY METHOD GIVING EQUAL PROTECTION. THE BUILDING CODE OFFICE MAY ALSO APPROVE A NATURAL DECAY RESISTANT WOOD PER SECTION 19-6(A) PART 13: STEEL FLITCH PLATE BEAMS 13.01 FLITCH PLATE BEAMS SHALL CONSIST OF A CONTINUOUS STEEL PLATE BOLTED BETWEEN TWO PIECES OF CONTINUOUS LUMBER AS SIZED ON THE PLANS. BOLT PIECES TOGETHER USING 1/2" Ø BOLTS SPACED AT 16" O.C. STAGGERED TOP TO BOTTOM OF THE BEAM. MAINTAIN A 2" EDGE DISTANCE. PLACE TWO BOLTS, ONE ABOVE THE OTHER, 16" MAX FROM EACH END OF THE BEAM. TYP UNO PART 14: STUD SUPPORTS FOR BEAMS 14.01 STEEL, ENGINEERED LUMBER, AND FLITCH PLATE BEAMS BEARING ON A STUD WALL SHALL BEAR AS FOLLOWS: 1-WHEN THE BEAM IS PERPENDICULAR TO, OR SKEWED RELATIVE TO THE WALL, THE BEAM SHALL BEAR FULL WIDTH ON THE SUPPORTING WALL INDICATED AND SHALL BE SUPPORTED BY A MINIMUM OF THREE GANGED STUDS, OR A GANGED STUD COLUMN WITH A NUMBER OF STUDS SUCH THAT THE STUD COLUMN IS AT LEAST AS WIDE AS THE TRUE WIDTH OF THE BEAM BEING SUPPORTED, WHICHEVER IS GREATER, TYP UNO. FOR THE SKEWED CONDITION PARTICULAR CARE SHALL BE TAKEN TO ENSURE STUD COLUMN IS CENTERED ON THE BEAM 2-BEAMS BEARING ONTO THE END OF A STUD WALL PARALLEL TO THE BEAM SHALL BEAR A MINIMUM OF 4 1/2" ONTO THE WALL AND BE SUPPORTED BY A TRPL STUD GANGED COLUMN TYP UNO. 14.02 DIMENSIONAL LUMBER BEAMS BEARING ON A STUD WALL SHALL BEAR AS FOLLOWS: 1-WHEN THE BEAM IS PERPENDICULAR TO, OR SKEWED RELATIVE TO THE WALL, THE BEAM SHALL BEAR FULL WIDTH ON THE SUPPORTING WALL INDICATED (LESS 1 1/2" TO ALLOW FOR A CONTINUOUS RM JOIST WHERE APPLICABLE) AND SHALL BE SUPPORTED BY A GANGED STUD COLUMN THE SAME WIDTH AS THE BEAM TYP UNO. (E.G. A TRIPLE 2X10 IS TO BE SUPPORTED BY (3) STUDS). FOR THE SKEWED CONDITION PARTICULAR CARE SHALL	BE TAKEN TO ENSURE STUD COLUMN IS CENTERED ON THE BEAM 2-BEAMS BEARING ONTO THE END OF A STUD WALL PARALLEL TO THE BEAM SHALL BEAR A MINIMUM OF 3" ONTO THE WALL AND BE SUPPORTED BY A DBL STUD GANGED COLUMN TYP UNO. 14.03 EXTRA JOISTS BEARING ON A STUD WALL PERPENDICULAR TO OR SKEWED RELATIVE TO THE BEAM SHALL BE SUPPORTED BY ONE ADDITIONAL STUD. 14.04 STUDS THAT ARE GANGED TO FORM A COLUMN SHALL HAVE ADJACENT STUDS WITHIN THE COLUMN NAILED TOGETHER WITH ONE ROW OF 10d NAILS AT 8" O.C. (TWO ROWS OF 10d NAILS @ 8" O.C., 3" APART, FOR 2X8 OR 2X10 STUDS) ALL COLUMNS SHALL BE CONTINUOUS DOWN TO THE FOUNDATION OR OTHER PROPERLY DESIGNED STRUCTURAL ELEMENT SUCH AS A BEAM. COLUMNS TRANSFERRING LOADS THROUGH FLOOR LEVELS SHALL BE SOLIDLY BLOCKED FOR THE FULL WIDTH OF THE STUD COLUMN WITHIN THE CAVITY FORMED BY THE FLOOR JOISTS. PART 15: NAILING OF MULTI PLY WOOD BEAMS 15.01 SOLID SAWN LUMBER JOISTS THAT ARE GANGED TO FORM A BEAM SHALL HAVE ADJACENT MEMBERS IN THE BEAM NAILED TOGETHER WITH THREE ROWS OF 10d NAILS @ 16" O.C. FOR 2X10 OR LARGER, TWO ROWS OF 10d NAILS @ 16" O.C. FOR 2X8, ONE ROW OF 10d NAILS @ 16" O.C. FOR 2X6 OR SMALLER. STAGGER ROWS 5" MIN. 15.02 LVL MEMBERS THAT ARE GANGED TO FORM A BEAM SHALL HAVE ADJACENT MEMBERS IN THE BEAM FASTENED TOGETHER PER MANUFACTURERS RECOMMENDATIONS, TYP UNO PART 16: WALL FRAMING AND BRACING 16.01 STUD WALLS SHALL CONSIST OF 2X4 STUDS SPACED AT 16" O.C. UNO. STUDS SHALL BE CONTINUOUS FROM SOLE PLATE AT FLOOR TO DOUBLE TOP PLATE AT THE CEILING OR ROOF. NO INTERMEDIATE BANDS OR PLATES SHALL CAUSE DISCONTINUITIES IN A STUD WALL EXCEPT AS REQUIRED FOR DOOR OR WINDOW OPENINGS. THE KING STUDS FOR SUCH OPENINGS SHALL BE CONTINUOUS, TYP UNO. MAY ALLOWABLE WALL HEIGHTS FOR EXTERIOR STUD WALLS, INCLUSIVE OF SOLE PLATE AND DBL TOP PLATE AND 7/16" OSB EXTERIOR BRACING AND ROW OF 2X4 2X6 PURLINS AT 8" HEIGHT (AND AT 16" HEIGHT FOR TALL WALLS), TYP UNO: 2X4 @ 16" O.C.: 11'-1 1/2" 2X6 @ 16" O.C.: 17'-0" 2X4 @ 12" O.C.: 12'-1 1/2" 2X6 @ 12" O.C.: 18'-8" DBL 2X4 @ 16" O.C.: 13'-4" DBL 2X6 @ 16" O.C.: 21'-0" 16.02 FOR WALL BRACING THE FOLLOWING SHALL APPLY: -BLOCKING AT UNSUPPORTED PANEL EDGES IS REQUIRED TYP UNO. -WALL BRACING IS BY ENGINEERED DESIGN AND NOT PRESCRIPTIVE PER SECTION 602.10 OF THE 2018 NRC. CONTINUOUS SHEATHING HAS BEEN PROVIDED, ALONG WITH ALTERNATIVE METHODS TO INSURE THE MINIMUM INTENT OF SECTION 602.10 OF THE 2018 NRC HAS BEEN MET AND EXCEEDED. -BRACED WALL PANELS SHALL BE FASTENED IN ACCORDANCE WITH TABLE 602.3(1) TO PROVIDE CONTINUOUS PANEL UPLIFT RESISTANCE AND COMPLIANCE WITH NRCBC 6002.3.5 AND 6002.11 UNLESS NOTED OTHERWISE ON STRUCTURAL PLANS. -MAY SUBSTITUTE WSP FOR GB -SINGLE JOIST, CONTINUOUS RM JOIST, OR BLOCKING OF EQUAL DEPTH IS REQUIRED ABOVE AND BELOW ALL BRACED WALLS. NAIL BLOCKING ABOVE WALL TO TOP PLATE WITH 16d TOE NAILS @ 6" O.C. NAIL SOLE PLATE OF BRACED WALL TO BLOCKING BELOW WITH (3) 16d NAILS @ 16" O.C. BLOCKING AT HORIZONTAL JOINTS IN BRACED WALL LINES ONLY REQUIRED AT SHADED WALLS, UNO. PART 17: KING STUDS 17.01 KING STUDS FOR OPENINGS IN EXTERIOR WALLS SHALL BE AS FOLLOWS: <table><tr><th rowspan="2">MAX OPENING WIDTH</th><th colspan="6">NUMBER OF KING STUDS</th></tr><tr><th>5'-0"</th><th>9'-0"</th><th>13'-0"</th><th>17'-0"</th><th>21'-0"</th><th></th></tr><tr><td>2X4</td><td>1</td><td>2</td><td>3</td><td>4</td><td>5</td><td></td></tr><tr><td>2X6</td><td>1</td><td>1</td><td>2</td><td>2</td><td>2</td><td></td></tr><tr><td>2X8</td><td>1</td><td>1</td><td>1</td><td>1</td><td>2</td><td></td></tr></table> PART 18: SUBSTITUTIONS 18.01 MATERIAL OR MEMBER SIZE SUBSTITUTIONS OR PLAN DEVIATIONS REQUIRE THE WRITTEN AUTHORIZATION OF THE DESIGNERS. UNAUTHORIZED DEVIATIONS ARE THE SOLE RESPONSIBILITY OF THE CONTRACTOR. PART 19: OWNERSHIP OF STRUCTURAL DESIGN 19.01 THE STRUCTURAL DESIGN OF THIS PLAN IS THE PROPERTY OF ENGINEERING TECH ASSOCIATES (ETA). THESE PLANS ARE FOR THE ONE TIME USE AT THE LOCATION INDICATED AND FOR THE CLIENT LISTED. ETA ASSUMES NO LIABILITY FOR THESE PLANS IF THEY ARE REPRODUCED, IN WHOLE OR IN PART, FOR CONSTRUCTION AT ANY OTHER LOCATION WITHOUT WRITTEN PERMISSION FROM ETA	MAX OPENING WIDTH	NUMBER OF KING STUDS						5'-0"	9'-0"	13'-0"	17'-0"	21'-0"		2X4	1	2	3	4	5		2X6	1	1	2	2	2		2X8	1	1	1	1	2		<table><tr><td>ABV</td><td>ABOVE</td><td>FND</td><td>FOUNDATION</td><td>TJ</td><td>TRIPLE JOIST</td></tr><tr><td>B.</td><td>BOTH</td><td>FTG</td><td>FOOTING</td><td>TYP</td><td>TYPICAL</td></tr><tr><td>B.E.</td><td>BOTH ENDS</td><td>HDG</td><td>HOT DIPPED</td><td>TRPL</td><td>TRIPLE</td></tr><tr><td>BTWN</td><td>BETWEEN</td><td>HGR</td><td>GALVANIZED</td><td>TSP</td><td>TRIPLE STUD POCKET</td></tr><tr><td>CP</td><td>CAST IN PLACE</td><td>UNO</td><td>HANGER</td><td>UNO</td><td>UNLESS NOTED OTHERWISE</td></tr><tr><td>CONC</td><td>CONCRETE</td><td>XJ</td><td>LAMINATED VENEER LUMBER</td><td>XJ</td><td>EXTRA JOIST</td></tr><tr><td>CS</td><td>CONTINUOUS SHEATHING</td><td></td><td>LVL</td><td></td><td></td></tr><tr><td>DIA</td><td>DIAMETER</td><td>NTS</td><td>NOT TO SCALE</td><td></td><td></td></tr><tr><td>DBL</td><td>DOUBLE</td><td>O.C.</td><td>ON CENTER</td><td></td><td></td></tr><tr><td>DJ</td><td>DOUBLE JOIST</td><td>PSL</td><td>PARALLEL STRAND LUMBER</td><td></td><td></td></tr><tr><td>DSP</td><td>DBL STUD POCKET</td><td>PT</td><td>PRESSURE TREATED</td><td></td><td></td></tr><tr><td>EQ</td><td>EQUAL</td><td>QJ</td><td>QUAD JOIST</td><td></td><td></td></tr><tr><td>EA</td><td>EACH</td><td>SP</td><td>SPACE (OR SPACING)</td><td></td><td></td></tr><tr><td>FLG</td><td>FLANGE</td><td>SSP</td><td>SINGLE STUD POCKET</td><td></td><td></td></tr><tr><td>FL PL</td><td>FLITCH PLATE</td><td>SQ</td><td>SQUARE</td><td></td><td></td></tr><tr><td>FLR</td><td>FLOOR</td><td></td><td></td><td></td><td></td></tr></table> NOTES THE BUILDER IS RESPONSIBLE FOR REVIEWING PLANS PRIOR TO CONSTRUCTION. THE BUILDER SHALL IMMEDIATELY CONTACT THE ENGINEER OF RECORD (EOR) BEFORE PROCEEDING IF THE FOLLOWING CONDITIONS ARE NOTED BEFORE OR DURING CONSTRUCTION: 1) THE WORKING PLANS DO NOT BEAR THE SEAL OF THE EOR 2) THE PLANS CONTAIN DISCREPANT OR INCOMPLETE INFORMATION ANY ERRORS DUE TO A FAILURE TO FOLLOW THE ABOVE PROCEDURES SHALL NOT BE THE RESPONSIBILITY OF THE EOR. FURTHERMORE, IT IS THE RESPONSIBILITY OF THE BUILDER TO ENSURE THAT ANY REVISIONS ISSUED BY THE EOR ARE PROMPTLY DISTRIBUTED TO THE SUBCONTRACTORS THE EOR DOES NOT PERFORM FENESTRATION OR VENTING CALCULATIONS OR ANY OTHER CALCULATIONS THAT ARE NOT DIRECTLY RELATED TO STRUCTURAL ENGINEERING. ROOF AND FLOOR TRUSSES TO BE DESIGNED BY AN ENGINEER REGISTERED BY THE STATE. FINAL TRUSS DRAWING SHOULD BE SUBMITTED TO THE EOR FOR REVIEW	ABV	ABOVE	FND	FOUNDATION	TJ	TRIPLE JOIST	B.	BOTH	FTG	FOOTING	TYP	TYPICAL	B.E.	BOTH ENDS	HDG	HOT DIPPED	TRPL	TRIPLE	BTWN	BETWEEN	HGR	GALVANIZED	TSP	TRIPLE STUD POCKET	CP	CAST IN PLACE	UNO	HANGER	UNO	UNLESS NOTED OTHERWISE	CONC	CONCRETE	XJ	LAMINATED VENEER LUMBER	XJ	EXTRA JOIST	CS	CONTINUOUS SHEATHING		LVL			DIA	DIAMETER	NTS	NOT TO SCALE			DBL	DOUBLE	O.C.	ON CENTER			DJ	DOUBLE JOIST	PSL	PARALLEL STRAND LUMBER			DSP	DBL STUD POCKET	PT	PRESSURE TREATED			EQ	EQUAL	QJ	QUAD JOIST			EA	EACH	SP	SPACE (OR SPACING)			FLG	FLANGE	SSP	SINGLE STUD POCKET			FL PL	FLITCH PLATE	SQ	SQUARE			FLR	FLOOR				
USE	LIVE LOAD (PSF)	DEAD LOAD (PSF)																																																																																																																																																							
BALCONIES, DECKS, ATTICS WITH FIXED STAIR ACCESS, DWELLING UNITS INCLUDING ATTICS WITH FIXED STAIR ACCESS, STAIRS, FIRE ESCAPES	40	10																																																																																																																																																							
GARAGES (PASSENGER CARS ONLY)	50	---																																																																																																																																																							
ATTICS (NO STORAGE, LESS THAN 5' HEADROOM)	10	10																																																																																																																																																							
ATTICS (WITH STORAGE)	20	10																																																																																																																																																							
ROOF	20	10 (15 FOR VAULTS)																																																																																																																																																							
MAX OPENING WIDTH	NUMBER OF KING STUDS																																																																																																																																																								
	5'-0"	9'-0"	13'-0"	17'-0"	21'-0"																																																																																																																																																				
2X4	1	2	3	4	5																																																																																																																																																				
2X6	1	1	2	2	2																																																																																																																																																				
2X8	1	1	1	1	2																																																																																																																																																				
ABV	ABOVE	FND	FOUNDATION	TJ	TRIPLE JOIST																																																																																																																																																				
B.	BOTH	FTG	FOOTING	TYP	TYPICAL																																																																																																																																																				
B.E.	BOTH ENDS	HDG	HOT DIPPED	TRPL	TRIPLE																																																																																																																																																				
BTWN	BETWEEN	HGR	GALVANIZED	TSP	TRIPLE STUD POCKET																																																																																																																																																				
CP	CAST IN PLACE	UNO	HANGER	UNO	UNLESS NOTED OTHERWISE																																																																																																																																																				
CONC	CONCRETE	XJ	LAMINATED VENEER LUMBER	XJ	EXTRA JOIST																																																																																																																																																				
CS	CONTINUOUS SHEATHING		LVL																																																																																																																																																						
DIA	DIAMETER	NTS	NOT TO SCALE																																																																																																																																																						
DBL	DOUBLE	O.C.	ON CENTER																																																																																																																																																						
DJ	DOUBLE JOIST	PSL	PARALLEL STRAND LUMBER																																																																																																																																																						
DSP	DBL STUD POCKET	PT	PRESSURE TREATED																																																																																																																																																						
EQ	EQUAL	QJ	QUAD JOIST																																																																																																																																																						
EA	EACH	SP	SPACE (OR SPACING)																																																																																																																																																						
FLG	FLANGE	SSP	SINGLE STUD POCKET																																																																																																																																																						
FL PL	FLITCH PLATE	SQ	SQUARE																																																																																																																																																						
FLR	FLOOR																																																																																																																																																								