

# TABLE OF CONTENTS

## OPTIONS

PRIMARY SUITE TRAY CEILING
PRIMARY BATH 3 WIZERO-ENTRY
GOURMET KITCHEN 2
12080 SGD AT GREAT ROOM
LAUNDRY CABS AND SINK
OFFICE ILO FLEX SPACE
FINISHED SECOND FLOOR
SCREENED EXT. COVD'D OUTDOOR LIV
GRAB BARS AT PRIMARY SHOWER
GRAB BAR AT PRIMARY WARM CLOSET
SHOWER ILO TUB AT BATH 2
OUTDOOR LIVING PATIO 2
EXTERIOR GAS STUB OUT
FULLY INSULATED GARAGE

[illegible]

## SYMBOLS

	ELEVATION KEY OR SECTION KEY		TUB/SHOWER		PLYWOOD
	CENTERLINE		LAVATORY		INSULATING SHEATHING
	CEILING TRANSITION LINE		DBL SINK		BATT INSULATION
	HOSE BIB (FREEZE PROOF)		LAUNDRY SINK		RIGID INSULATION
	GAS LINE STUB		PEDESTAL SINK		CONCRETE
	TOWEL BAR		WATER CLOSET		SAND OR GRAVEL FILL
	PAPER HOLDER		2x FRAME WALL		BRICK VENEER
	TOWEL RING		STONE VENEER		
	SHOWER HEAD				
	SHOWER CONTROLS				

BUILDING CODE COMPLIANCE
CONSTRUCTION PLANS DESIGNED TO MEET OR EXCEED MINIMUM CODE REQUIREMENTS OF 2018 I.R.C.
ELECTRICAL PLANS DESIGNED TO MEET OR EXCEED MINIMUM CODE REQUIREMENTS OF 2020 N.E.C.

**LOT 341**  
5921-07  
ASPEN CREEK  
ELEVATION C  
REVERSE PLAN  
LEFT-HAND GARAGE

OVER 9,000 FT<sup>2</sup> -  
**NO** FIRE-RATED  
WALL REQUIRED

CONSTRUCTION PLANS DESIGNED TO MEET OR EXCEED MINIMUM CODE REQUIREMENTS OF 2018 I.R.C.
ELECTRICAL PLANS DESIGNED TO MEET OR EXCEED MINIMUM CODE REQUIREMENTS OF 2020 N.E.C.

PRIMARY SUITE TRAY CEILING  
 PRIMARY BATH 3 WIZERO-ENTRY  
 GOURMET KITCHEN 2  
 12080 SGD AT GREAT ROOM  
 LAUNDRY CABS AND SINK  
 OFFICE ILO FLEX SPACE  
 FINISHED SECOND FLOOR  
 SCREENED EXT. COVD'D OUTDOOR LIV  
 GRAB BARS AT PRIMARY SHOWER  
 GRAB BAR AT PRIMARY WATER CLOSET  
 SHOWER ILO TUB AT BATH 2  
 OUTDOOR LIVING PATIO 2  
 EXTERIOR GAS STUB OUT  
 FULLY INSULATED GARAGE

- 1) HIP AND VALLEY RAFTERS SHALL BE SUPPORTED AT RIDGE DOWN TO BEARING PARTITION. CUT ENDS OF RAFTERS SHALL BE FULLY SUPPORTED WALL AND RIDGE.
- 2) REQUIRED VENTILATION AREAS CALCULATED AT 1/300 RATIO.

- 1) REVIEW ALL WINDOW HDR HEIGHTS PER PLATE HT. AND VERIFY W/ ELEVATIONS AND CORNICE DETAILS.
- 2) TEMPERED GLASS SHALL BE USED IN HAZARDOUS AREAS AS DESCRIBED IN SECTION R308.4 - I.R.C.
- 3) FRONT DOOR WIDTH PER IRC-R311.3
- 4) GARAGE DOOR PER IRC-R309.1
- 5) EMERGENCY EGRESS SHALL MEET REQUIREMENTS OF SECTION R310 - I.R.C. 2018 - SLEEPING ROOMS SHALL HAVE AT LEAST ONE EGRESS OPENING OF NOT LESS THAN 5.7 SF AND A CLEAR OPENING OF NOT LESS THAN 20" WIDE X 24" HIGH AND SHALL NOT BE MORE THAN 44" ABOVE THE FLOOR.

5440 WADE PARK BLVD, SUITE 400, RALEIGH, NC 27607

5440 Wade Park Blvd  
Suite 400  
Raleigh, NC 27607

© 2022

## LOT: 341

SHEET #:  
G0.01

## REVISION INDEX

[illegible][illegible]

**tri pointe.**  
HOMES  
5440 WADE PARK BLVD, SUITE 400, RALEIGH, NC 27607

Business Operations  
5440 Wade Park Blvd  
Suite 400  
Raleigh, NC 27607

© 2022

REVISIONS &amp; SYMBOLS

SUBDIVISION: ALTIS @ SERENITY  
ADDRESS: 137 FIREFLY LN  
LOT: 341

Issue Date: 10-01-24  
Drawn By: ACC

PLAN #:  
5921-07

PLAN NAME:  
**ASPEN CREEK**


SHEET #:  
G0.11



MAIN FLOOR NOTES	
#	EXPLANATION
1.	ALL NON-DIMENSIONED PARTITIONS ARE 3-1/2" ROUGH
2.	ALL ANGLED PARTITIONS ARE 45 DEGREES UNLESS NOTED OTHERWISE (U.N.O.)
3.	PROVIDE MIN. 2-2x12's w/ 1/2" PLYWD. FLITCH PLATE AT ALL EXTERIOR WALL OPENINGS & INTERIOR BEARING WALL OPENINGS U.N.O.
4.	ALL EXTERIOR DIM'S ARE TO FACE OF STUDS U.N.O.
5.	ALL TRUSSES TO BEAR ON EXTERIOR WALLS AND/OR GIRDER TRUSS U.N.O.
6.	TRUSS MFG. TO SIZE MEMBERS, FASTENERS, HANGERS & SET SPACING FOR ALL TRUSSES
7.	WINDOW SUPPLIER TO VERIFY AT LEAST ONE WINDOW IN ALL BEDROOMS TO HAVE A CLEAR EGRESS OPENING OF 5.7 SQ. FT. w/MIN DIM'S OF 24" IN HT AND 20" IN WIDTH; SILL HT NOT TO EXCEED 44" AFF
8.	ALL BALUSTER TO BE SPACED SUCH THAT A 4" SPHERE CANNOT PASS BETWEEN BALUSTER
9.	ALL ELEC. & MECH. EQUIPMENT & METERS ARE SUBJECT TO RELOCATION DUE TO FIELD CONDITIONS; CONTRACTOR TO VERIFY
10.	FOR ADDITIONAL NOTES, SEE GENERAL NOTES ON TITLE SHEET & DETAILS
11.	ALL TYP. WINDOWS 6'-0" IN HT AND SMALLER, THE HEAD HEIGHT SHALL BE 8'-10" ABOVE FINISHED FLOOR (U.N.O.)
12.	STRUCTURAL ENGINEERING PROVIDED BY OTHERS
13.	REFER TO INTERIOR ELEVATIONS SHEET TO VIEW BUBBLE CALLOUTS
14.	INTERIOR DOOR HEIGHTS ARE AS FOLLOWS - PRIMARY SUITE, PRIMARY BATH, & PRIMARY CLOSET ARE 8' TALL DOORS. ALL OTHER DOORS ARE 6'-8".
15.	BATH ACCESSORY INSTALLATION HEIGHTS ARE MEASURED TO CENTER OF ACCESSORY: TB - 60" A.F.F.      TR - 20" ABV. VANITY COUNTER-TOP TH - 60" A.F.F.      TP - 26" A.F.F. OPT. GRAB BAR (GB) - 36" A.F.F.
16.	SHUT-OFF VALVE TO BE LOCATED IN GARAGE
17.	ROD AND SHELF HEIGHTS ARE MEASURED TO TOP OF ROD AND BOTTOM OF SHELVES - SEE D-1.0 FOR DETAILS: 1R1S - ROD - 5'-8"      2R2S - TOP ROD - 6'-8" SHELF - 5'-10"      TOP SHELF - 6'-10" BOTTOM ROD - 3'-4"      BOTTOM SHELF - 3'-6"

**LOT 341**  
**5921-07 ASPEN CREEK**  
**ELEVATION C**  
**REVERSE PLAN**  
**LEFT-HAND GARAGE**

- \*OPT. GOURMET KITCHEN 2
- \*OPT. PRIMARY BATH 3 W/ ZERO ENTRY SHOWER
- \*OPT. GRAB BARS AT PRIMARY SHOWER
- \*OPT. GRAB BAR AT PRIMARY WATER CLOSET
- \*OPT. TRAY CEILING AT PRIMARY SUITE
- \*OPT. LAUNDRY SINK W/ BASE AND UPPER CABINETS
- \*OPT. SHOWER ILO TUB AT BATH 2
- \*OPT. OFFICE ILO FLEX SPACE
- \*OPT. FINISHED SECOND FLOOR (LOFT)
- \*OPT. 12080 MULTI SLIDE DOOR AT GREAT ROOM
- \*OPT. SCREENED EXTENDED COVERED OUTDOOR LIVING
- \*OPT. OUTDOOR LIVING PATIO 2
- \*OPT. EXTERIOR GAS STUB OUT
- \*OPT. FULLY INSULATED GARAGE

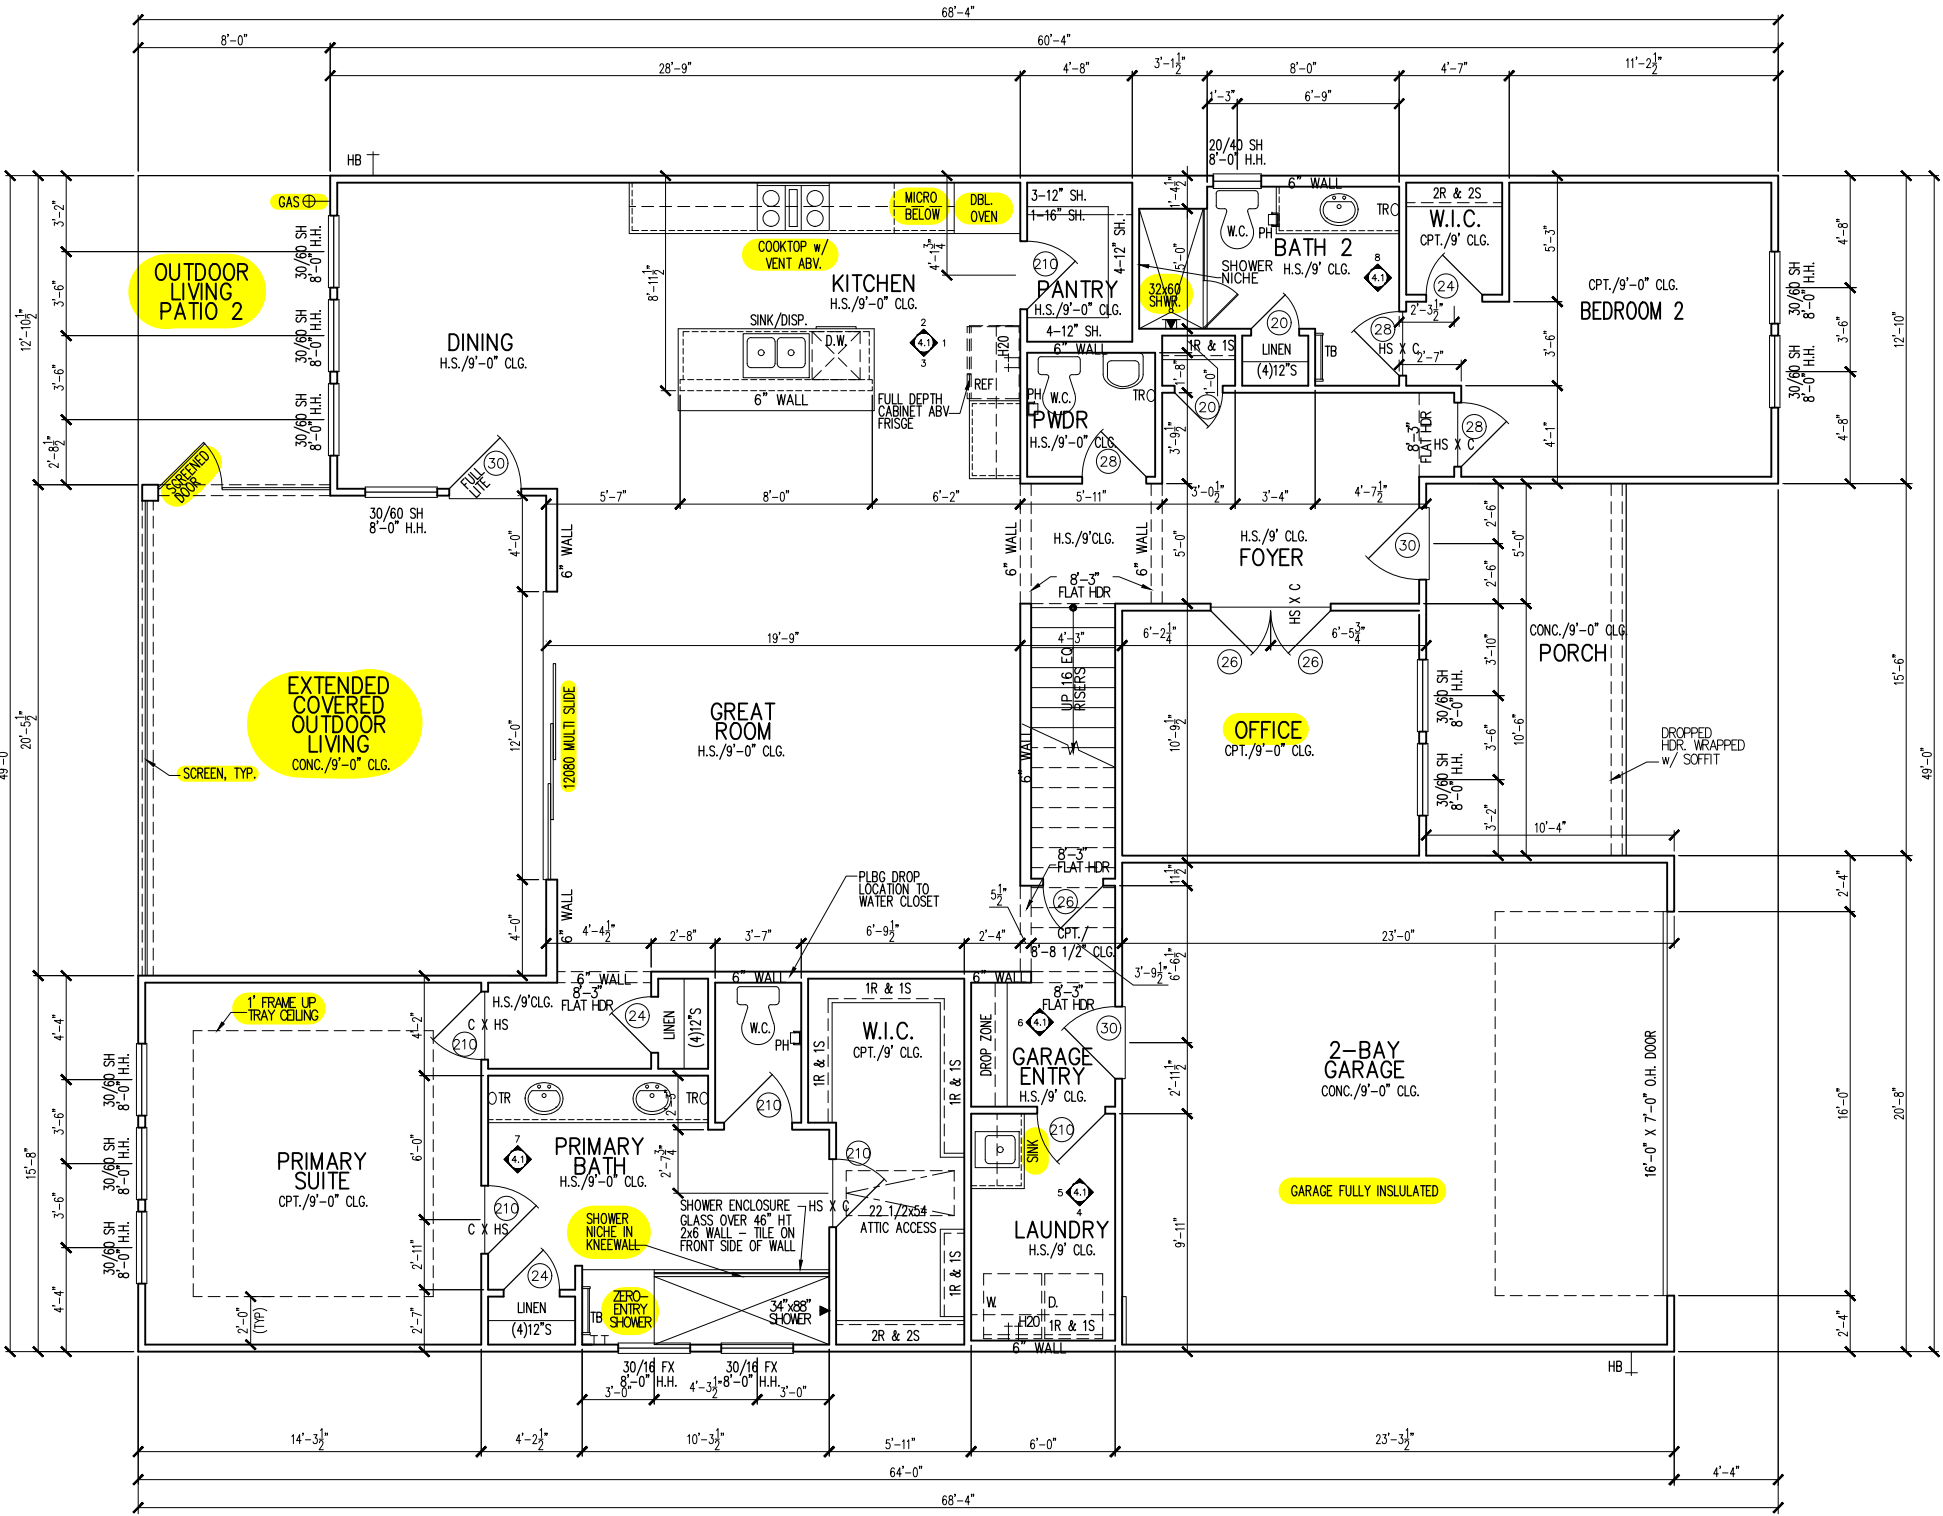

**OVER 9,000 FT<sup>2</sup> -**  
**NO FIRE-RATED**  
**WALL REQUIRED**

**tri pointe**  
H O M E S

5440 WADE PARK BLVD, SUITE 400, RALEIGH, NC 27607

Business Operations  
5440 Wade Park Blvd  
Suite 400  
Raleigh, NC 27607

© 2022

1st FLOOR PLAN

SUBDIVISION: ALTIS @ SERENITY  
ADDRESS: 137 FIREFLY LN  
LOT: 341

Issue Date: 10-01-24  
Drawn By: ACC

PLAN #:  
5921-07


PLAN NAME:  
ASPEN CREEK

SHEET #:  
A1.10



MAIN FLOOR NOTES	
#	EXPLANATION
1.	ALL NON-DIMENSIONED PARTITIONS ARE 3-1/2" ROUGH
2.	ALL ANGLED PARTITIONS ARE 45 DEGREES UNLESS NOTED OTHERWISE (U.N.O.)
3.	PROVIDE MIN. 2-2x12's w/ 1/2" PLYWD. FITCH PLATE AT ALL EXTERIOR WALL OPENINGS & INTERIOR BEARING WALL OPENINGS U.N.O.
4.	ALL EXTERIOR DIM's ARE TO FACE OF STUDS U.N.O.
5.	ALL TRUSSES TO BEAR ON EXTERIOR WALLS AND/OR GIRDER TRUSS U.N.O.
6.	TRUSS MFG. TO SIZE MEMBERS, FASTENERS, HANGERS & SET SPACING FOR ALL TRUSSES
7.	WINDOW SUPPLIER TO VERIFY AT LEAST ONE WINDOW IN ALL BEDROOMS TO HAVE A CLEAR EGRESS OPENING OF 5.7 SQ. FT. w/MIN DIM's OF 24" IN HT AND 20" IN WIDTH; SILL HT NOT TO EXCEED 44" AFF
8.	ALL BALUSTER TO BE SPACED SUCH THAT A 4" SPHERE CANNOT PASS BETWEEN BALUSTER
9.	ALL ELEC. & MECH. EQUIPMENT & METERS ARE SUBJECT TO RELOCATION DUE TO FIELD CONDITIONS; CONTRACTOR TO VERIFY
10.	FOR ADDITIONAL NOTES, SEE GENERAL NOTES ON TITLE SHEET & DETAILS
11.	ALL TYP. WINDOWS 6'-0" IN HT AND SMALLER, THE HEAD HEIGHT SHALL BE 8'-10" ABOVE FINISHED FLOOR (U.N.O.)
12.	STRUCTURAL ENGINEERING PROVIDED BY OTHERS
13.	REFER TO INTERIOR ELEVATIONS SHEET TO VIEW BUBBLE CALLOUTS
14.	INTERIOR DOOR HEIGHTS ARE AS FOLLOWS - PRIMARY SUITE, PRIMARY BATH, & PRIMARY CLOSET ARE 8' TALL DOORS. ALL OTHER DOORS ARE 6'-8".
15.	BATH ACCESSORY INSTALLATION HEIGHTS ARE MEASURED TO CENTER OF ACCESSORY: TB - 60" A.F.F.      TR - 20" ABV. VANITY COUNTER-TOP TH - 60" A.F.F.      TP - 26" A.F.F. OPT. GRAB BAR (GB) - 36" A.F.F.
16.	SHUT-OFF VALVE TO BE LOCATED IN GARAGE
17.	ROD AND SHELF HEIGHTS ARE MEASURED TO TOP OF ROD AND BOTTOM OF SHELVES - SEE D-1.0 FOR DETAILS: 1R1S - ROD - 5'-8"      2R2S - TOP ROD - 6'-8" SHELF - 5'-10"      TOP SHELF - 6'-10" BOTTOM ROD - 3'-4" BOTTOM SHELF - 3'-6"

- \*OPT. GOURMET KITCHEN 2
- \*OPT. PRIMARY BATH 3 W/ ZERO ENTRY SHOWER
- \*OPT. GRAB BARS AT PRIMARY SHOWER
- \*OPT. GRAB BAR AT PRIMARY WATER CLOSET
- \*OPT. TRAY CEILING AT PRIMARY SUITE
- \*OPT. LAUNDRY SINK W/ BASE AND UPPER CABINETS
- \*OPT. SHOWER ILO TUB AT BATH 2
- \*OPT. OFFICE ILO FLEX SPACE
- \*OPT. FINISHED SECOND FLOOR (LOFT)
- \*OPT. 12080 MULTI SLIDE DOOR AT GREAT ROOM
- \*OPT. SCREENED EXTENDED COVERED OUTDOOR LIVING
- \*OPT. OUTDOOR LIVING PATIO 2
- \*OPT. EXTERIOR GAS STUB OUT
- \*OPT. FULLY INSULATED GARAGE

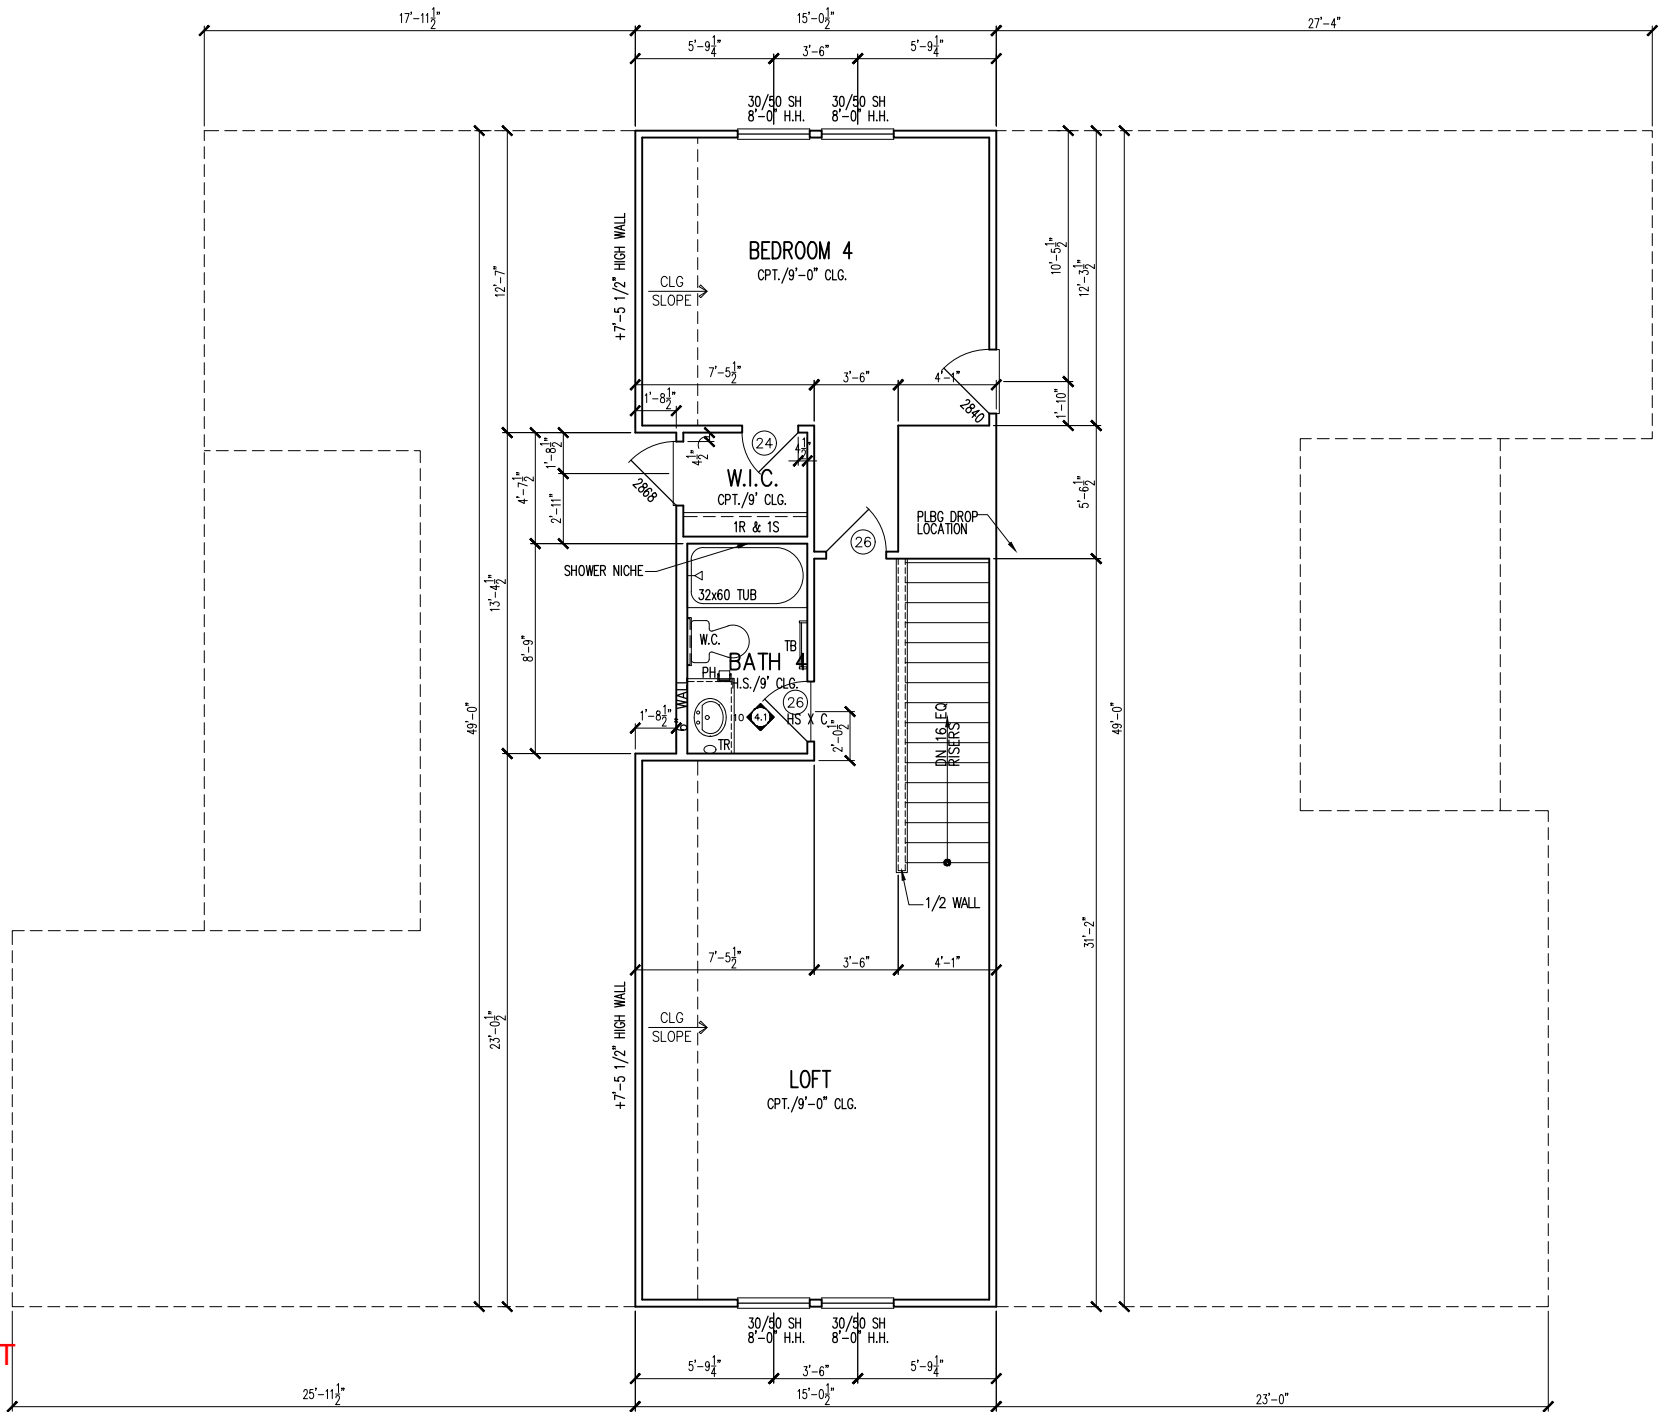

SECOND FLOOR PLAN  
PARTIAL FLOOR PLAN

1/8"=1'-0"

OVER 9,000 FT² -  
NO FIRE-RATED  
WALL REQUIRED

tri pointe  
H O M E S

5440 WADE PARK BLVD, SUITE 400, RALEIGH, NC 27607

Business Operations  
5440 Wade Park Blvd  
Suite 400  
Raleigh, NC 27607

© 2022

2ND FLOOR PLAN - OPTION

SUBDIVISION: ALTIS @ SERENITY  
ADDRESS: 137 FIREFLY LN  
LOT: 341

Issue Date: 10-01-24  
Drawn By: ACC


PLAN #:  
5921-07

PLAN NAME:  
ASPEN CREEK


SHEET #:  
01.A30

LOT 341  
5921-07 ASPEN CREEK  
ELEVATION C  
REVERSE PLAN  
LEFT-HAND GARAGE


OVER 9,000 FT<sup>2</sup> -  
**NO FIRE-RATED  
WALL REQUIRED**

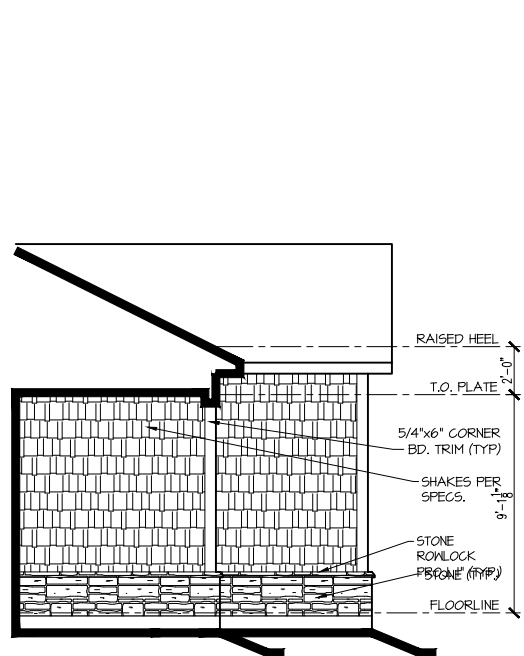


**RIGHT INSIDE  
PORCH ELEV. "C"**

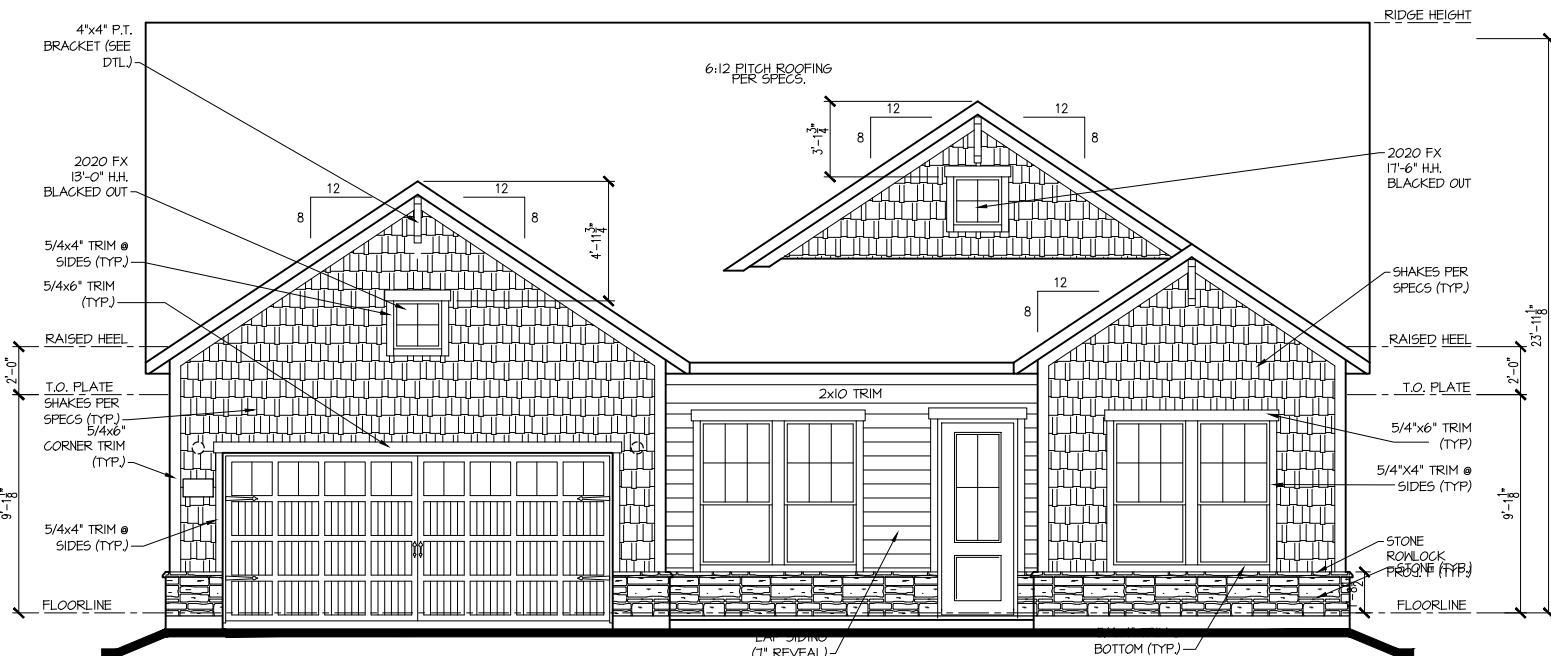


**FRONT ELEV. "C"**

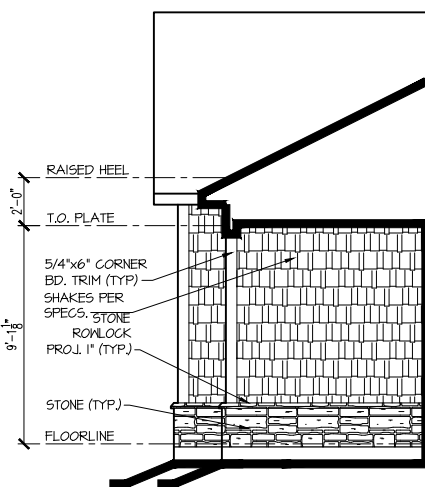


**LEFT INSIDE  
PORCH ELEV. "C"**

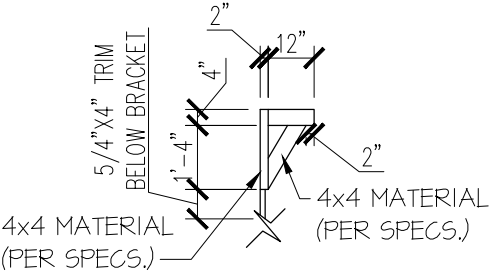

**BRACKET DETAIL**

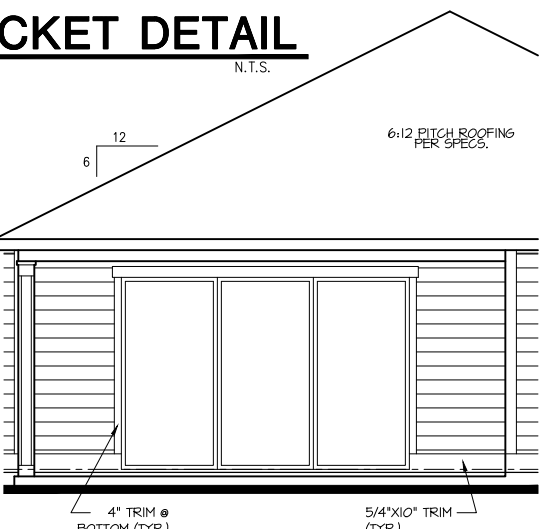

**SGD AT  
GREAT ROOM - REAR ELEV**

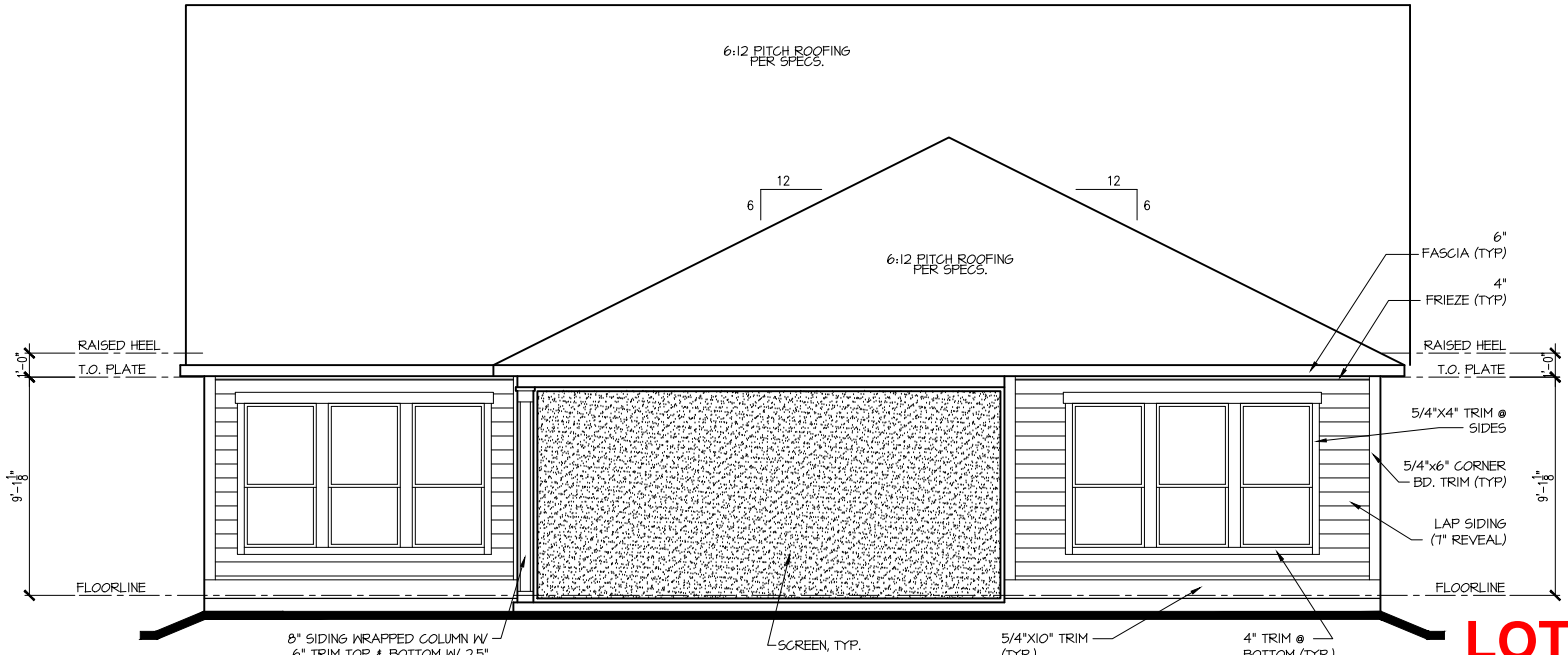

**REAR ELEV. "C"**

**LOT 341**  
**5921-07 ASPEN CREEK**  
**ELEVATION C**  
**REVERSE PLAN**  
**LEFT-HAND GARAGE**

**tri pointe**  
HOMES

5440 WADE PARK BLVD, SUITE 400, RALEIGH, NC 27607

Business Operations  
5440 Wade Park Blvd  
Suite 400  
Raleigh, NC 27607

© 2022

**EXTERIOR ELEVATIONS**

SUBDIVISION: ALTIS @ SERENITY

ADDRESS: 137 FIREFLY LN

LOT: 341


Issue Date: 10-01-24  
Drawn By: ACC

PLAN #:  
5921-07


PLAN NAME:  
ASPEN CREEK

SHEET #:  
A2.01C

OVER 9,000 FT<sup>2</sup> -  
**NO FIRE-RATED  
WALL REQUIRED**

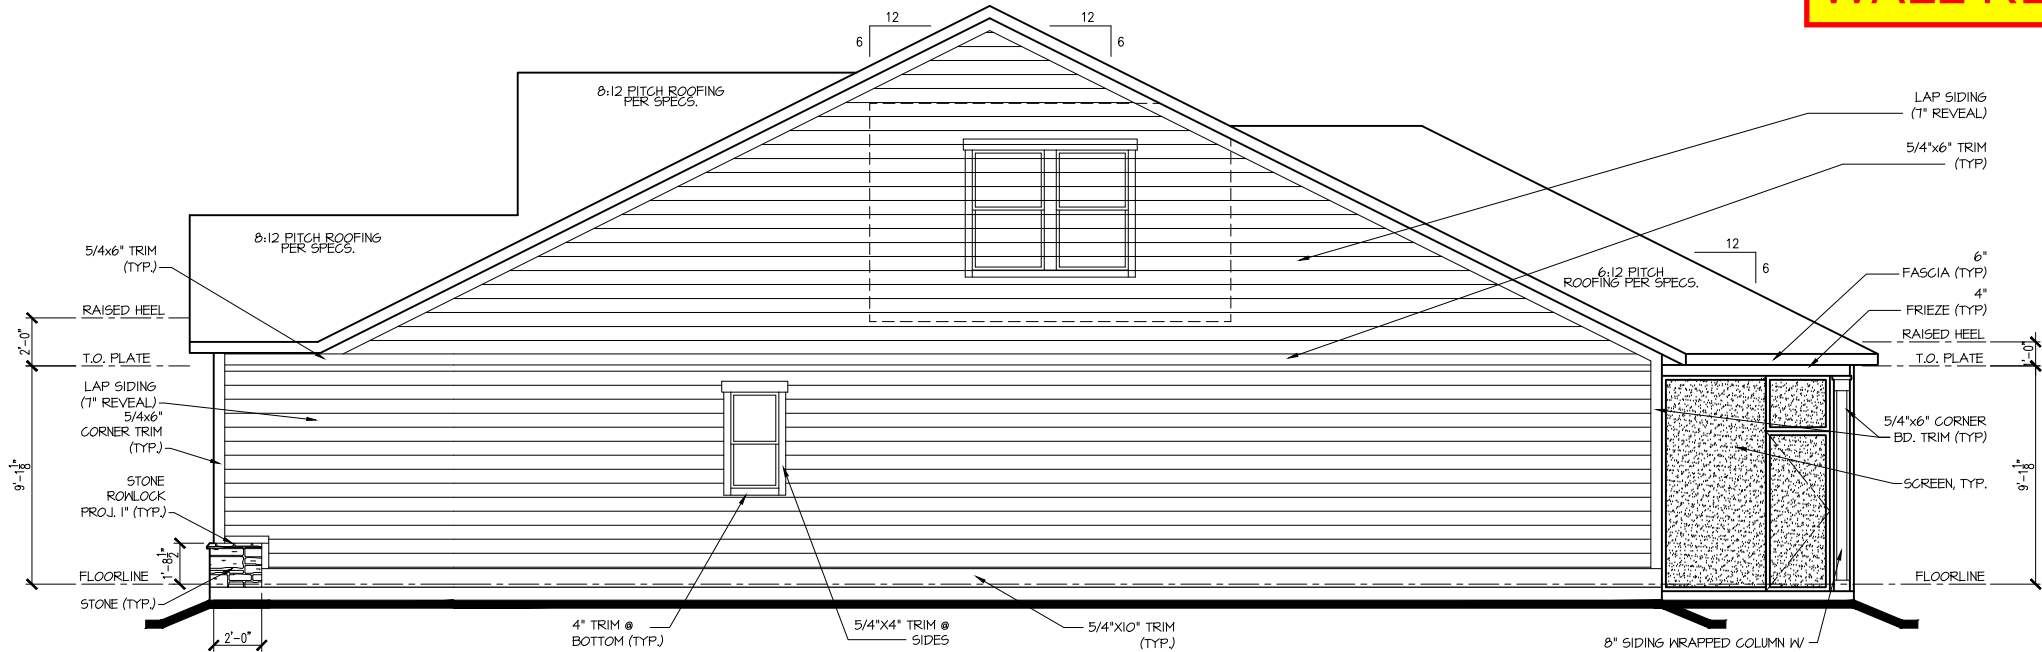

**RIGHT ELEV. "C"**

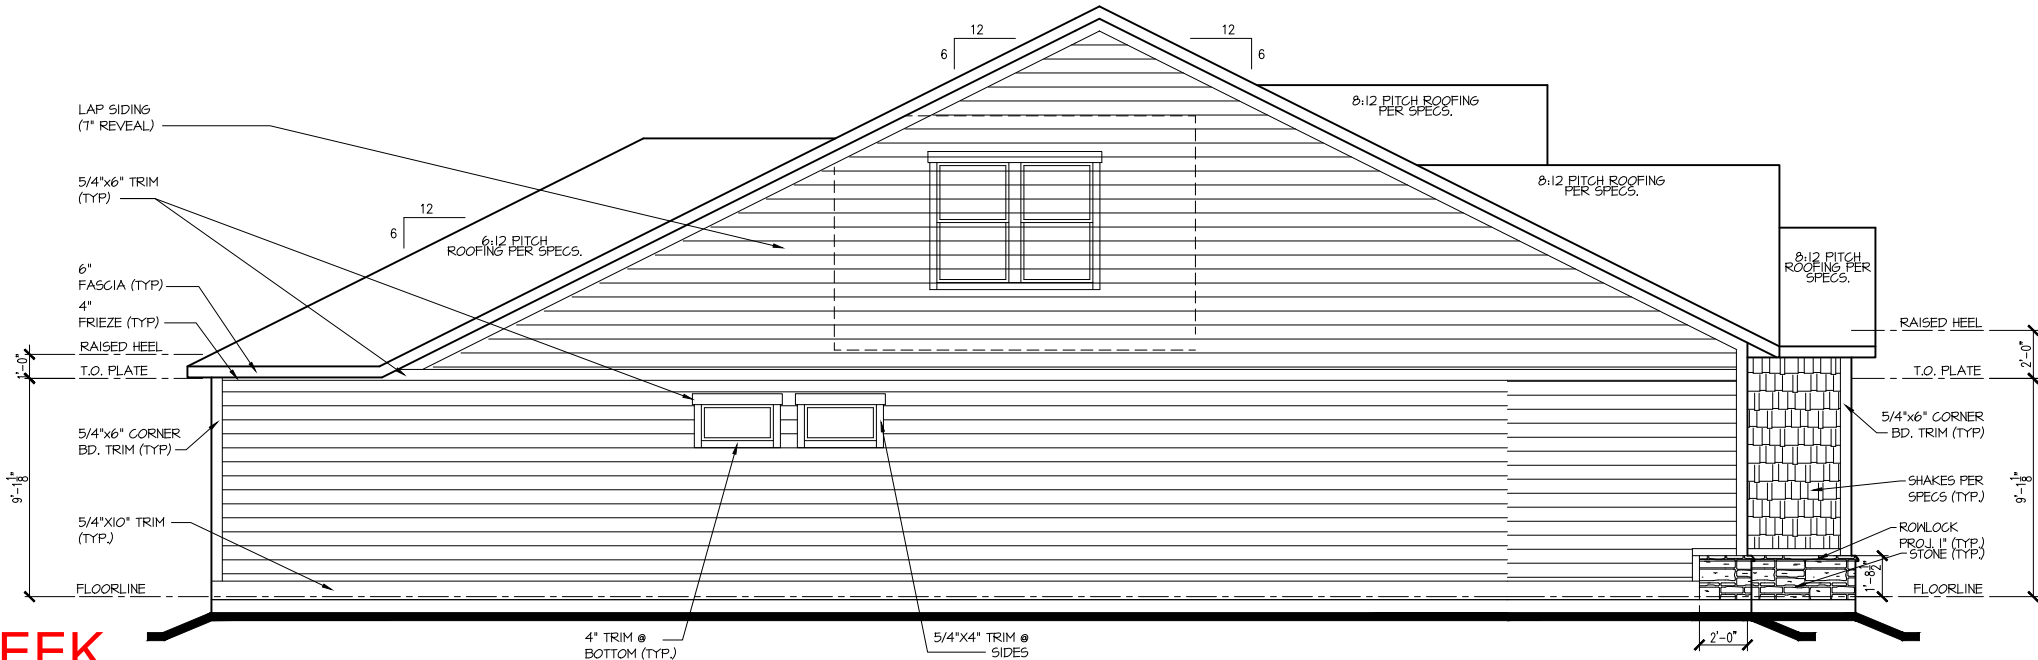

**LEFT ELEV. "C"**  
1/8"=1'-0"

**LOT 341**  
**5921-07 ASPEN CREEK**  
**ELEVATION C**  
**REVERSE PLAN**  
**LEFT-HAND GARAGE**

**tri pointe.**  
**HOMES**

**Business Operations**  
5440 Wade Park Blvd  
Suite 400  
Raleigh, NC 27607

EXTERIOR ELEVATIONS

SUBDIVISION: ALTIS @ SERENITY  
ADDRESS: 137 FIREFLY LN

Issue Date: 10-01-24  
Drawn By: ACC


PLAN #:  
5921-07

PLAN NAME:  
**ASPEN CREEK**

SHEET #:  
**A2.02C**

Attic Venting Calculations Elev. "C"	
ROOF INFORMATION	BASE
TOTAL SF ROOF AREA	3149
AVAILABLE L.F. ROOF SOFFIT	200
AVAILABLE L.F. ROOF RIDGE	91
VENT TYPES	QTY VENTS REQ'D
LOWER VENTS CONTINUOUS SOFFIT VENTING @ 5 S/LF	151 LF
UPPER VENTS SLANT 150 VENTS @ 150 S/LVENT	5
UPPER VENTS RIDGE VENTS @ 72 S/VENT	4" 10

NOTE:  
QTY OF UPPER VENTS SHOWN COVERS 100% OF UPPER VENTING. NO MIXING  
OF VENT TYPES FOR UPPER VENTING IS FIGURED FOR IN THIS TABLE.

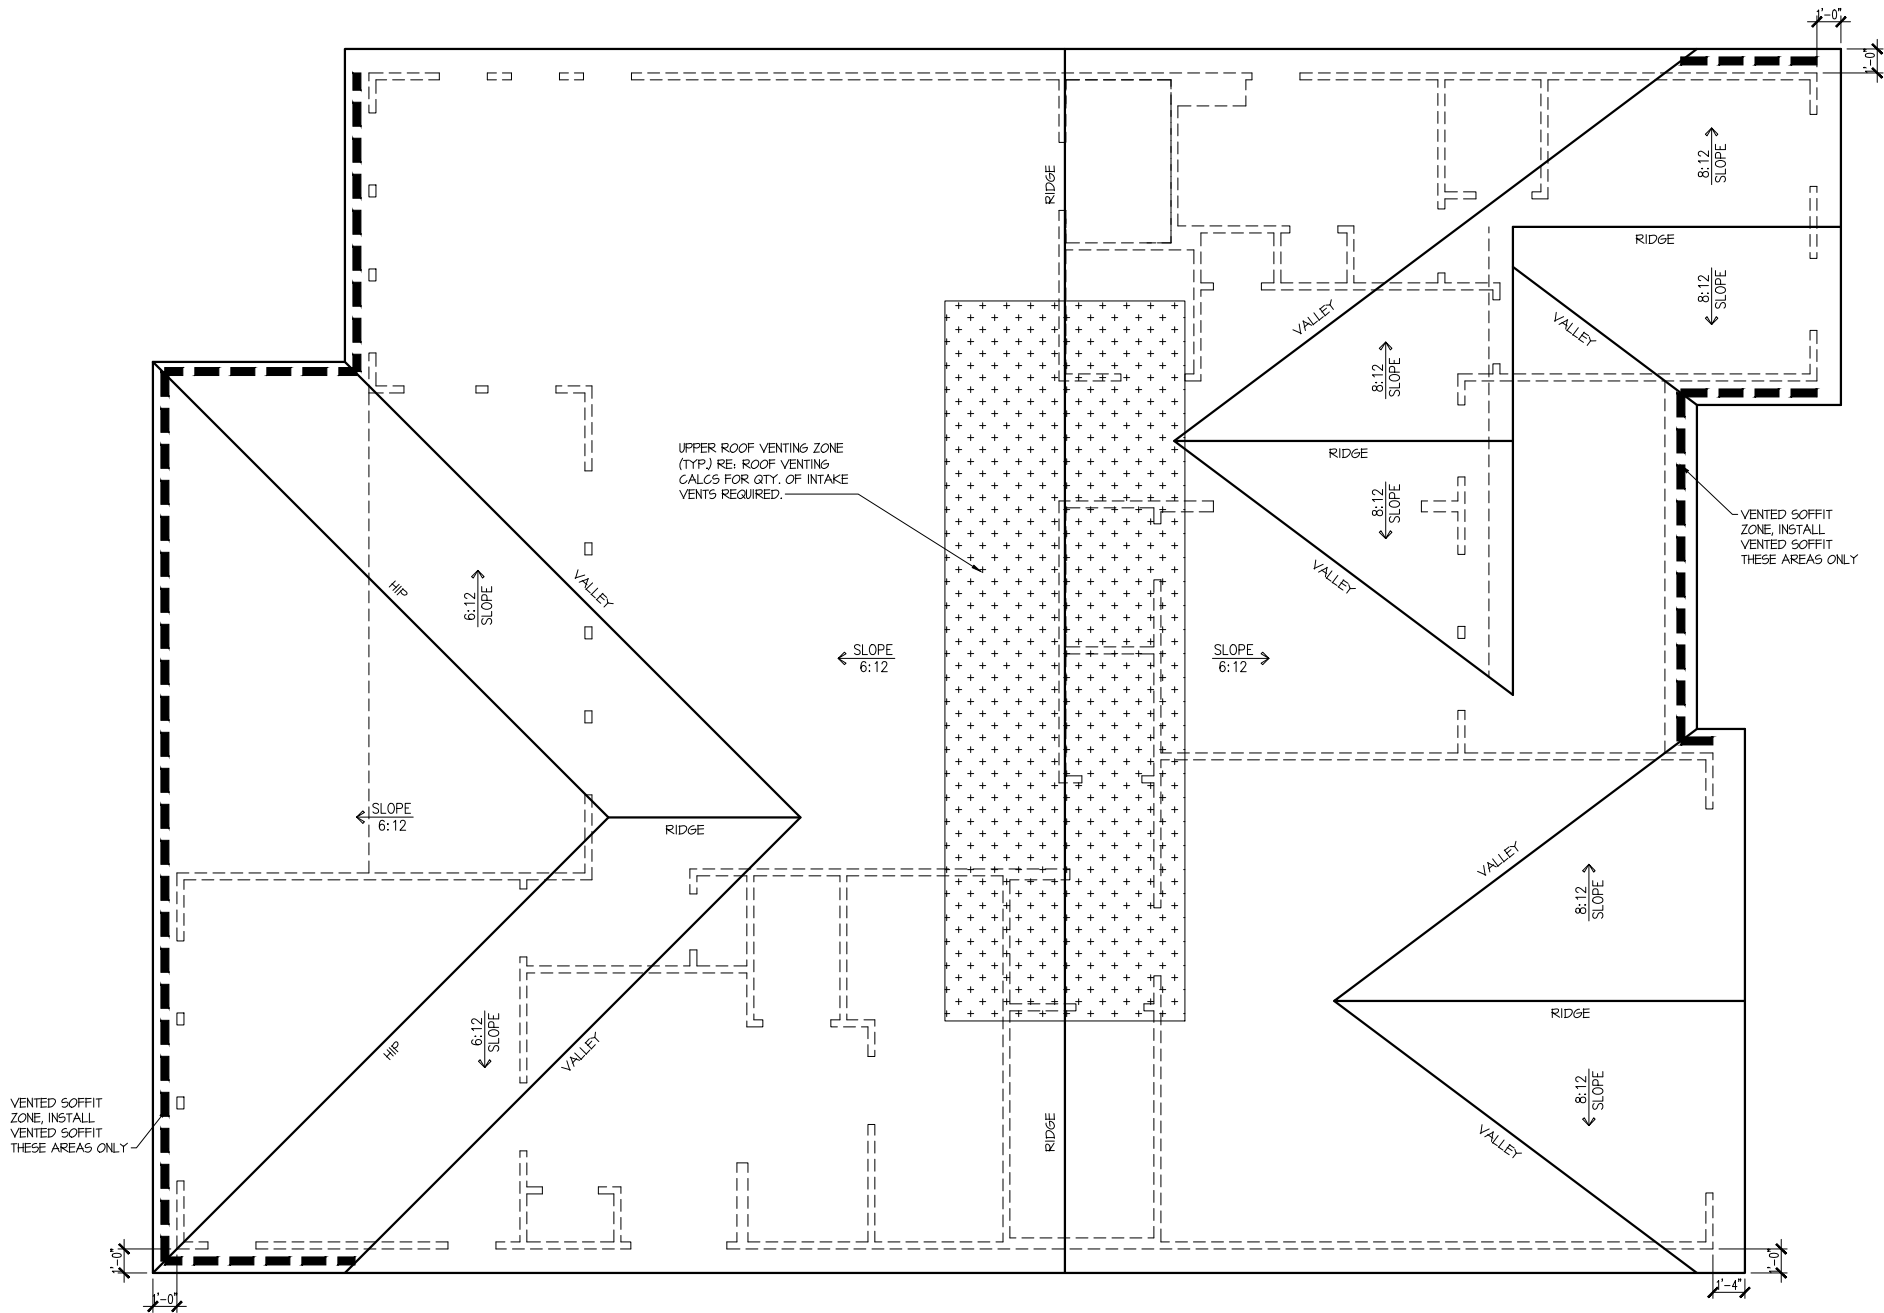

**ROOF PLAN 'C'**  
SCALE: 1/8" = 1'-0"

Business Operations  
5440 Wade Park Blvd  
Suite 400  
Raleigh, NC 27607

© 2022

ROOF PLAN  
SUBDIVISION: ALTIS @ SERENITY  
ADDRESS: 137 FIREFLY LN  
LOT: 341


Issue Date: 10-01-24  
Drawn By: ACC

PLAN #:  
5921-07

PLAN NAME:  
ASPEN CREEK


SHEET #:  
A3.01C

**tri pointe**  
H O M E S  
5440 WADE PARK BLVD, SUITE 400, RALEIGH, NC 27607

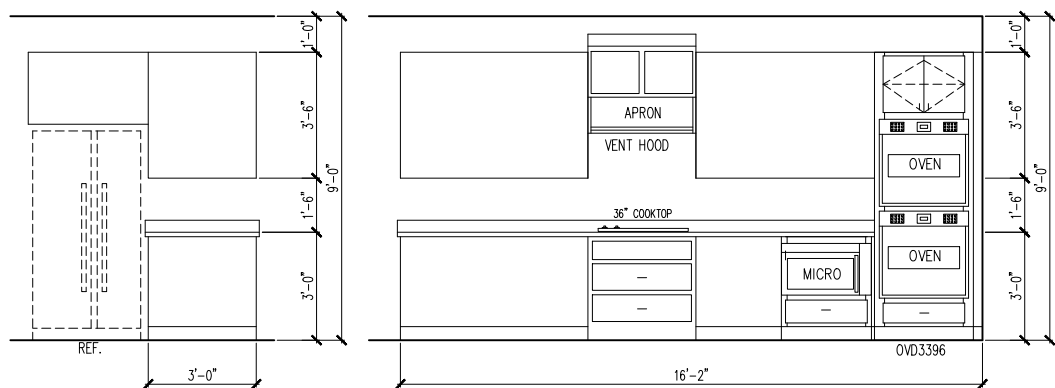


① KITCHEN


② KITCHEN

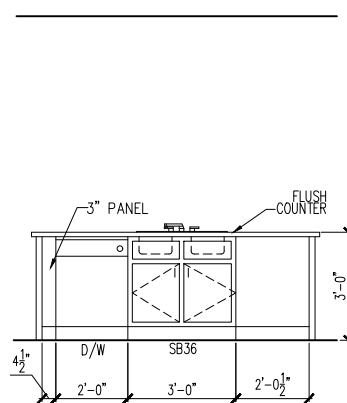


③ KITCHEN ISLAND

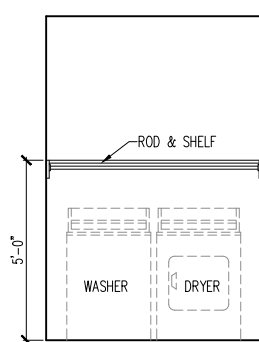


④ LAUNDRY ROOM

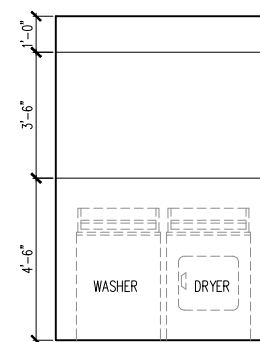


④ LAUNDRY ROOM  
WALL CABINET OPT.

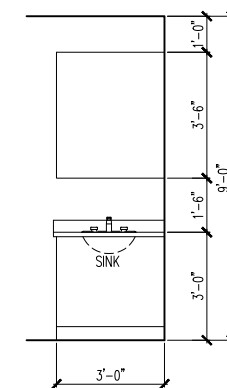


⑤ LAUNDRY ROOM

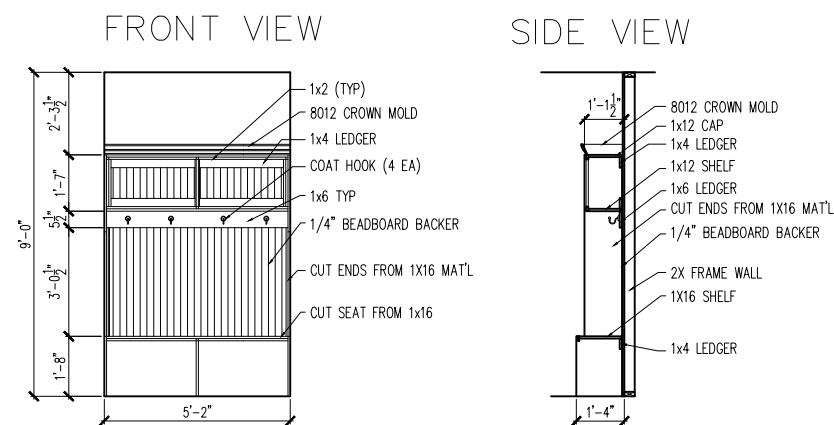


⑥ TYPICAL BENCH DETAIL (DROP ZONE)

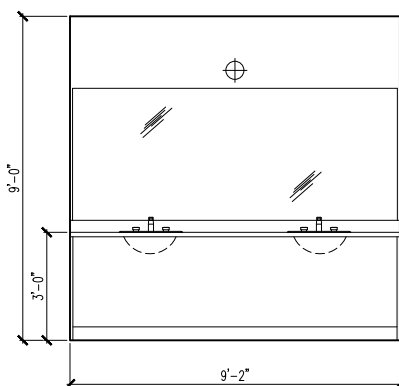


⑦ PRIMARY BATH

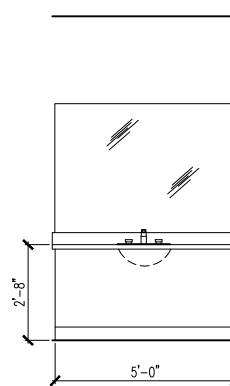

⑧ BATH 2

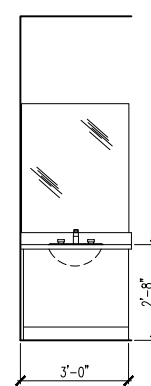

⑨ BATH 3

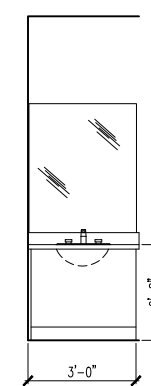

⑩ BATH 4

INTERIOR DETAIL SHEET

SUBDIVISION: ALTIS @ SERENITY  
ADDRESS: 137 FIREFLY LN  
LOT: 341

Issue Date: 10-01-24  
Drawn By: ACC

PLAN #:  
5921-07

PLAN NAME:  
ASPEN CREEK

SHEET #:  
A4.01

Business Operations  
5440 Wade Park Blvd  
Suite 400  
Raleigh, NC 27607

© 2022

tri pointe  
HOMES


5440 WADE PARK BLVD, SUITE 400, RALEIGH, NC 27607



ELECTRICAL FIXTURE SCHEDULE	
DESCRIPTION	SYMBOL
110V OUTLET	⌀
220V OUTLET	⌀ 220
1/2 HOT OUTLET	⌀
GFI OUTLET	⌀ GFI
WP GFI OUTLET	⌀ WP/GFI
GARAGE DOOR OPENER OUTLET	⌀ GDO
SECURITY SYSTEM	⌀ SEC SYS
DISHWASHER	● DW
JUNCTION BOX	⌀
CEILING MOUNTED LIGHT	⌀
CEILING FAN w/ LIGHT KIT	⌀ PROVIDE BRACING
RECESSED CEILING LIGHT	⌀
RECESSED WATER PROOF LIGHT	⌀ WP
WALL MOUNTED LIGHT	⌀
WALL MOUNTED PUSH BUTTON	⌀ PB
TWO WAY SWITCH	⌀
THREE WAY SWITCH	⌀
FOUR WAY SWITCH	⌀
DIMMER SWITCH	⌀ DIM
EXHAUST VENTS	⌀ VENT TO EXT
LOW VOLTAGE PANEL	⌀
PHONE OUTLET	⌀ PH
TV OUTLET	⌀ TV
DATA & RG6 COMBO BOX	⌀
SMOKE DETECTOR	⌀
CARBON MONOXIDE SMOKE DETECTOR COMBO	⌀ CM/SD
DOOR CHIMES	CHIMES
ELECTRICAL PANEL	⌀ EP
SURFACE MOUNT LED	⌀
EXTERIOR WALL MOUNT UPLIGHT	⌀
SOFFIT MOUNT FLOOD LIGHT	⌀
UNDER COUNTER LIGHTING	⌀ UCL
SMURF TUBE	.....

ELECTRICAL NOTES:

- PROVIDE AND INSTALL LOCALLY CERTIFIED SMOKE AND CARBON MONOXIDE DETECTORS AS REQUIRED BY NATIONAL FIRE PROTECTION ASSOCIATION (NFPA) AND MEETING THE REQUIREMENTS OF ALL GOVERNING CODES
  - PROVIDE AND INSTALL GROUND FAULT CIRCUIT-INTERRUPTERS (GFI) AS REQUIRED BY NATIONAL ELECTRIC CODE (NEC) AND MEETING THE REQUIREMENTS OF ALL GOVERNING CODES.
  - ELECTRICAL CONTRACTOR TO PROVIDE REQUIRED DIRECT HOOK-UPS/CUTOFFS.
  - HVAC CONTRACTOR TO VERIFY THERMOSTAT LOCATIONS.
  - ALL ELECTRICAL AND MECHANICAL EQUIPMENT (I.E. FURNACES, A/C UNITS, ELECTRICAL PANELS, SANITARY SUMP PITS, DRAIN TILE SUMP, AND WATER HEATERS) ARE SUBJECT TO RELOCATION DUE TO FIELD CONDITIONS.
- ELECTRICAL DEVICES: ABOVE FINISHED FLOOR:
- |                                 |  |
|---------------------------------|--|
| SWITCHES OVER COUNTER           | 48" TO CL  |
| WALL OUTLETS OVER COUNTER       | 42" TO BOTTOM OF HORIZONTAL OUTLET(TYP. @ COUNTER) |
| REMAINING SWITCHES              | 48" TO CL  |
| WALL OUTLETS                    | 12" TO CL  |
| BATH VANITY BRACKET OUTLET      | 12" (1" ABOVE TOP OF VANITY)                       |
| WATER SOFTENER AND SUMP OUTLETS | 48" TO CL  |
| EXTERIOR GFI OUTLETS            | 12" TO CL  |
| GARAGE GFI (ABOVE GARAGE FLOOR) | 48" TO CL  |
| FRONT DOOR COACH LIGHT          | 80" TO CL  |
| GARAGE DOOR COACH LIGHT         | 84" TO CL  |
| (ABOVE GARAGE FLOOR)            | 84" TO CL  |
| THERMOSTAT                      | 54" TO CL  |
| DOORBELL CHIMES                 | 84" TO CL  |
- LEVEL W/ DR HANDLE
- |                                    |           |
|------------------------------------|-----------|
| DOORBELL BUTTON                    | 66" TO CL |
| KITCHEN HOOD FAN "WHIP"            | 72" TO CL |
| KITCHEN WALL HUNG MICROWAVE OUTLET | 72" TO CL |
| KITCHEN DISHWASHER RECEPTACLE      | 24" TO CL |
| KITCHEN RANGE                      | 48" TO CL |
| KITCHEN REFRIGERATOR               | 48" TO CL |
| WASHER/DRYER OUTLET                | 48" TO CL |
- CL = CENTER LINE  
1 = FIELD VERIFY  
2 = MASTER BATH STANDARD 30" HIGH VANITY TO BE RAISED 4"

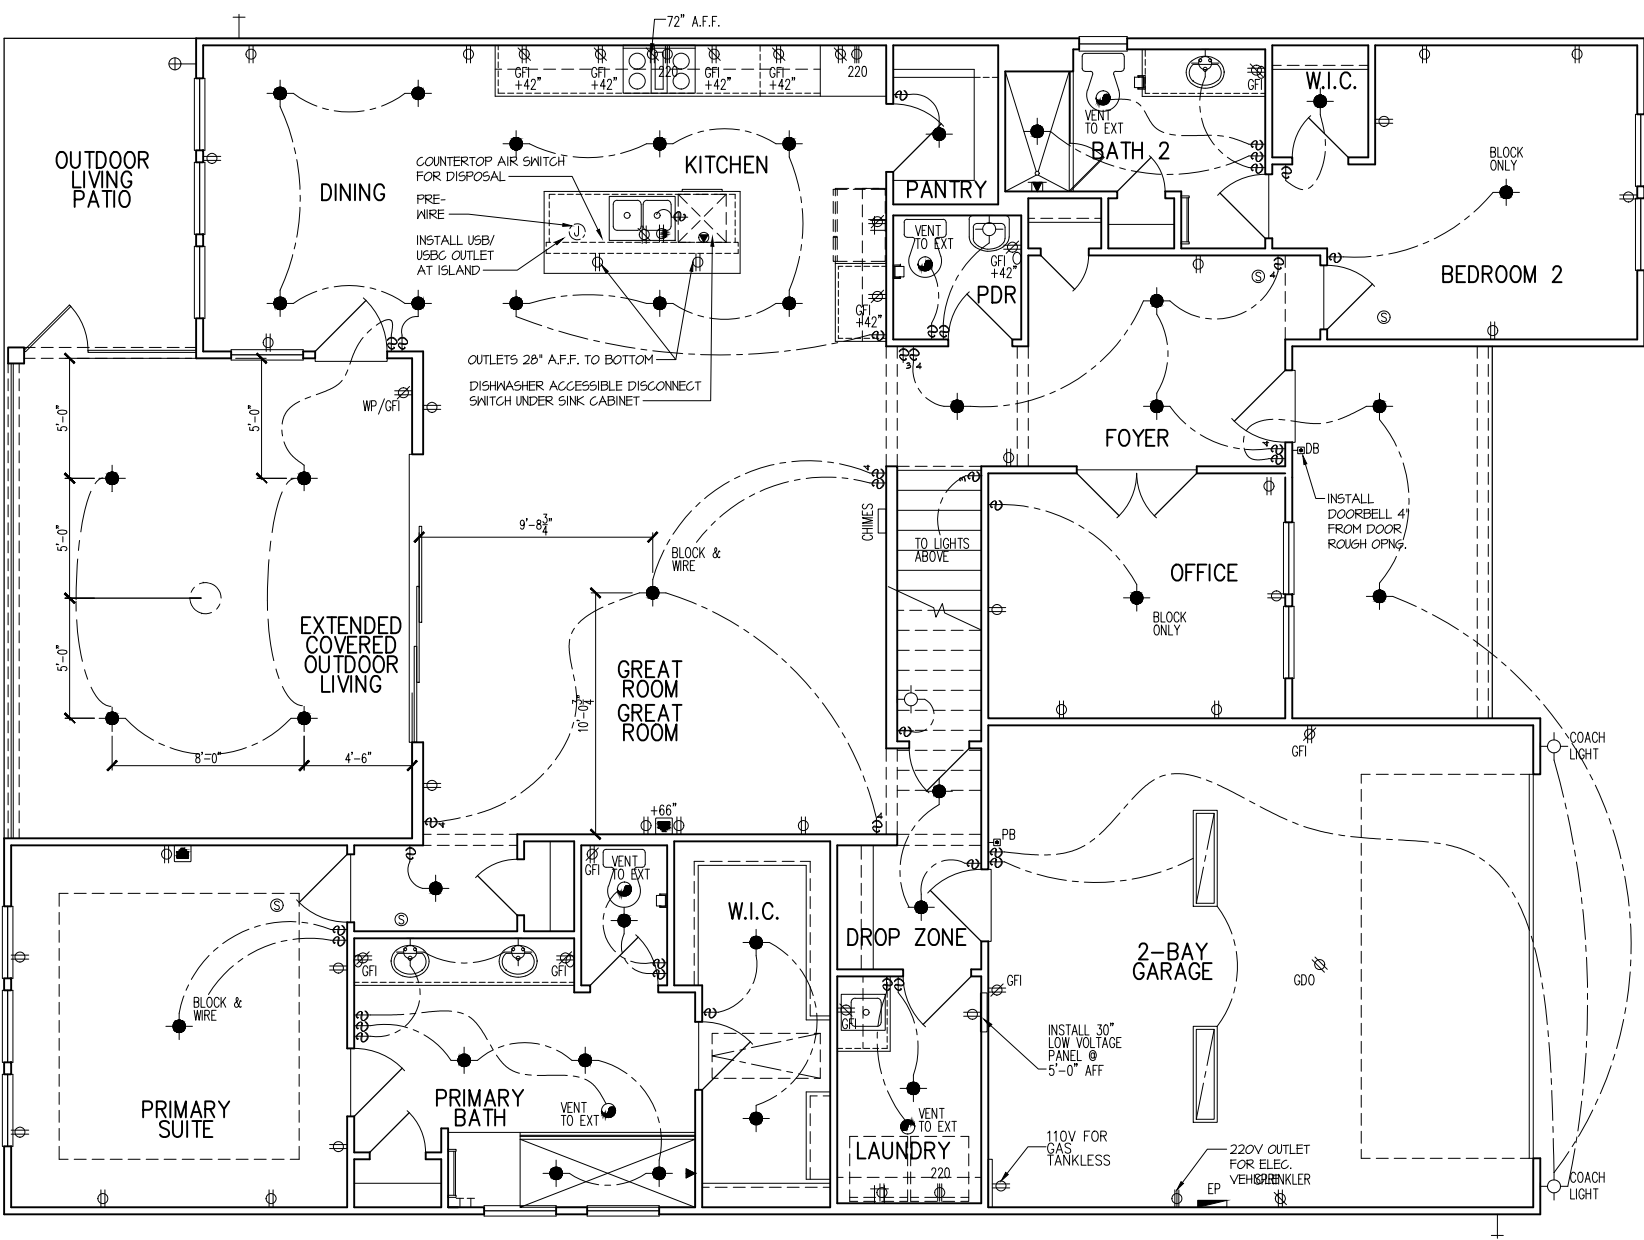

tri pointe  
H O M E S

5440 WADE PARK BLVD, SUITE 400, RALEIGH, NC 27607

Business Operations  
5440 Wade Park Blvd  
Suite 400  
Raleigh, NC 27607

© 2022

1st FLOOR ELECTRICAL PLAN

SUBDIVISION: ALTIS @ SERENITY  
ADDRESS: 137 FIREFLY LN  
LOT: 341

Issue Date: 10-01-24  
Drawn By: ACC

PLAN #:  
5921-07

PLAN NAME:  
ASPEN CREEK

SHEET #:  
E1.10C


ELECTRICAL FIXTURE SCHEDULE	
DESCRIPTION	SYMBOL
110V OUTLET	⌀
220V OUTLET	⌀ 220
1/2 HOT OUTLET	⌀
GFI OUTLET	⌀ GFI
WP GFI OUTLET	⌀ WP/GFI
GARAGE DOOR OPENER OUTLET	⌀ GDO
SECURITY SYSTEM	⌀ SEC SYS
DISHWASHER	⌀ DW
JUNCTION BOX	⌀
CEILING MOUNTED LIGHT	⌀
CEILING FAN w/ LIGHT KIT	⌀ PROVIDE BRACING
RECESSED CEILING LIGHT	⌀
RECESSED WATER PROOF LIGHT	⌀ WP
WALL MOUNTED LIGHT	⌀
WALL MOUNTED PUSH BUTTON	⌀ PB
TWO WAY SWITCH	⌀
THREE WAY SWITCH	⌀
FOUR WAY SWITCH	⌀
DIMMER SWITCH	⌀ DIM
EXHAUST VENTS	⌀ VENT TO EXT
LOW VOLTAGE PANEL	⌀
PHONE OUTLET	⌀ PH
TV OUTLET	⌀ TV
DATA & RG6 COMBO BOX	⌀
SMOKE DETECTOR	⌀
CARBON MONOXIDE SMOKE DETECTOR COMBO	⌀ CM/SD
DOOR CHIMES	CHIMES
ELECTRICAL PANEL	⌀ EP
SURFACE MOUNT LED	⌀
EXTERIOR WALL MOUNT UP LIGHT	⌀
SOFFIT MOUNT FLOOD LIGHT	⌀
UNDER COUNTER LIGHTING	⌀ UCL
SMURF TUBE	⌀

ELECTRICAL NOTES:

1. PROVIDE AND INSTALL LOCALLY CERTIFIED SMOKE AND CARBON MONOXIDE DETECTORS AS REQUIRED BY NATIONAL FIRE PROTECTION ASSOCIATION (NFPA) AND MEETING THE REQUIREMENTS OF ALL GOVERNING CODES
2. PROVIDE AND INSTALL GROUND FAULT CIRCUIT-INTERRUPTERS (GFI) AS REQUIRED BY NATIONAL ELECTRIC CODE (NEC) AND MEETING THE REQUIREMENTS OF ALL GOVERNING CODES.
3. ELECTRICAL CONTRACTOR TO PROVIDE REQUIRED DIRECT HOOK-UPS/CUTOFFS.
4. HVAC CONTRACTOR TO VERIFY THERMOSTAT LOCATIONS.
5. ALL ELECTRICAL AND MECHANICAL EQUIPMENT (I.E. FURNACES, A/C UNITS, ELECTRICAL PANELS, SANITARY SUMP PITS, DRAIN TILE SUMP, AND WATER HEATERS) ARE SUBJECT TO RELOCATION DUE TO FIELD CONDITIONS.

ELECTRICAL DEVICES: ABOVE FINISHED FLOOR:  
SWITCHES OVER COUNTER . . . . . 48" TO CL  
WALL OUTLETS OVER COUNTER . . . . . 42" TO BOTTOM OF HORIZONTAL OUTLET(TYP. @ COUNTER)  
REMAINING SWITCHES . . . . . 48" TO CL  
WALL OUTLETS . . . . . 12" TO CL  
BATH VANITY BRACKET OUTLET . . . . . 1,2 (1" ABOVE TOP OF VANITY)  
WATER SOFTENER AND SUMP OUTLETS . . . . . 48" TO CL  
EXTERIOR GFI OUTLETS . . . . . 12" TO CL  
GARAGE GFI (ABOVE GARAGE FLOOR) . . . . . 48" TO CL  
FRONT DOOR COACH LIGHT . . . . . 80" TO CL  
GARAGE DOOR COACH LIGHT, (ABOVE GARAGE FLOOR) . . . . . 84" TO CL  
THERMOSTAT . . . . . 54" TO CL  
DOORBELL CHIMES . . . . . 84" TO CL  
DOORBELL BUTTON . . . . . LEVEL W/ DR. HANDLE  
KITCHEN HOOD FAN "WHIP" . . . . . 66" TO CL  
KITCHEN WALL HUNG MICROWAVE OUTLET . . . . . 72" TO CL  
KITCHEN DISHWASHER RECEPTACLE . . . . . UNDER SINK  
KITCHEN RANGE . . . . . 24" TO CL  
KITCHEN REFRIGERATOR . . . . . 48" TO CL  
WASHER/DRYER OUTLET . . . . . 48" TO CL

CL = CENTER LINE  
1 = FIELD VERIFY  
2 = MASTER BATH STANDARD 30" HIGH VANITY TO BE RAISED 4"

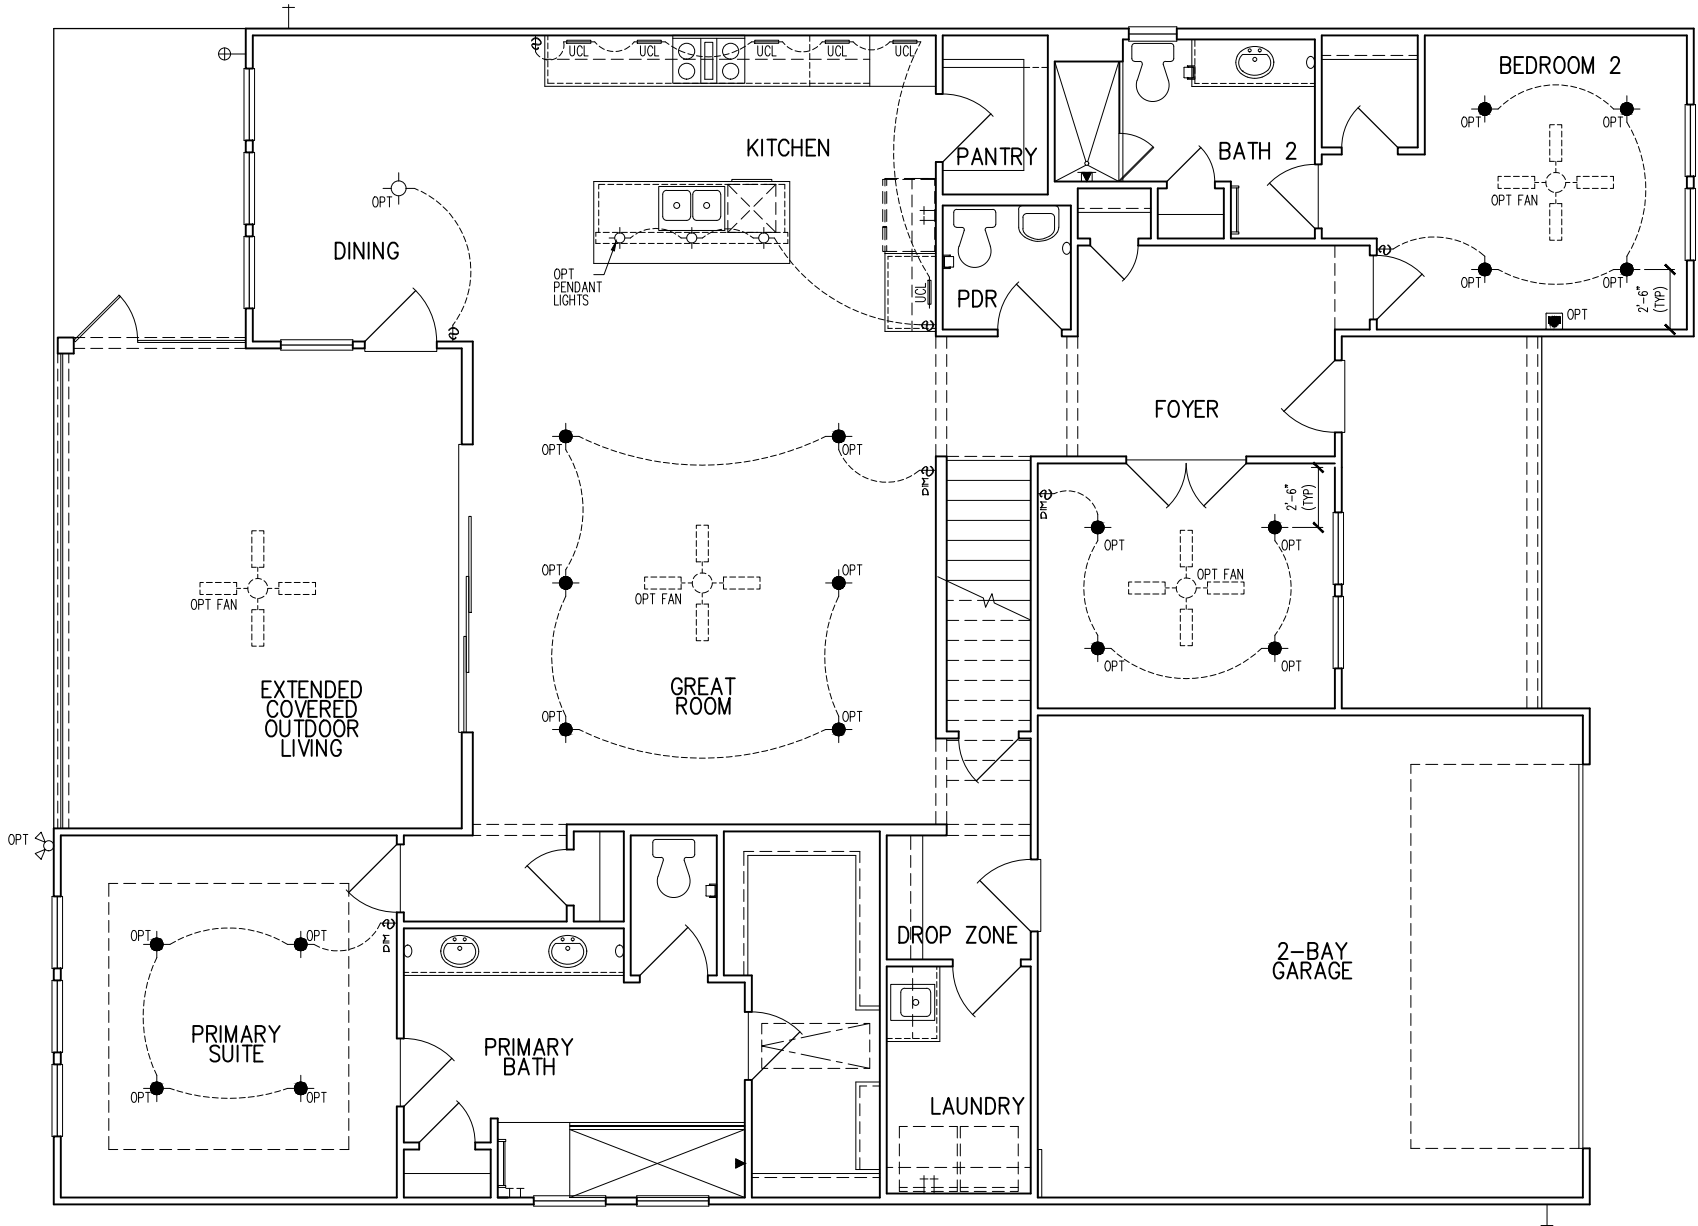

CHECK BOO FOR SELECTED ELECTRICAL OPTIONS

1st FLOOR ELEC. PLAN - OPITONS

SUBDIVISION: ALTIS @ SERENITY

ADDRESS: 137 FIREFLY LN

LOT: 341

Issue Date: 10-01-24  
Drawn By: ACC

PLAN #:  
5921-07

PLAN NAME:  
ASPEN CREEK

SHEET #:  
E1.11C


tri pointe  
H O M E S  
5440 WADE PARK BLVD, SUITE 400, RALEIGH, NC 27607

Business Operations  
5440 Wade Park Blvd  
Suite 400  
Raleigh, NC 27607  
© 2022

ELECTRICAL FIXTURE SCHEDULE	
DESCRIPTION	SYMBOL
110V OUTLET	⌀
220V OUTLET	⌀220
1/2 HOT OUTLET	⌀
GFI OUTLET	⌀GFI
WP GFI OUTLET	⌀WP/GFI
GARAGE DOOR OPENER OUTLET	⌀GDO
SECURITY SYSTEM	⌀SEC SYS
DISHWASHER	⬤DW
JUNCTION BOX	Ⓜ
CEILING MOUNTED LIGHT	⌀
CEILING FAN w/ LIGHT KIT	ⓧ PROVIDE BRACING
RECESSED CEILING LIGHT	ⓧ
RECESSED WATER PROOF LIGHT	ⓧWP
WALL MOUNTED LIGHT	⊙
WALL MOUNTED PUSH BUTTON	ⓂPB
TWO WAY SWITCH	Ⓢ
THREE WAY SWITCH	Ⓢ
FOUR WAY SWITCH	Ⓢ
DIMMER SWITCH	ⓈDIM
EXHAUST VENTS	⬤VENT TO EXT
LOW VOLTAGE PANEL	Ⓢ
PHONE OUTLET	⬤PH
TV OUTLET	⬤TV
DATA & RG6 COMBO BOX	Ⓢ
SMOKE DETECTOR	Ⓢ
CARBON MONOXIDE SMOKE DETECTOR COMBO	ⓈCM/SD
DOOR CHIMES	CHIMES
ELECTRICAL PANEL	ⓈEP
SURFACE MOUNT LED	⬤
EXTERIOR WALL MOUNT UPLIGHT	Ⓢ
SOFFIT MOUNT FLOOD LIGHT	Ⓢ
UNDER COUNTER LIGHTING	ⓈUCL
SMURF TUBE	.....

ELECTRICAL NOTES:

1. PROVIDE AND INSTALL LOCALLY CERTIFIED SMOKE AND CARBON MONOXIDE DETECTORS AS REQUIRED BY NATIONAL FIRE PROTECTION ASSOCIATION (NFPA) AND MEETING THE REQUIREMENTS OF ALL GOVERNING CODES
2. PROVIDE AND INSTALL GROUND FAULT CIRCUIT-INTERRUPTERS (GFI) AS REQUIRED BY NATIONAL ELECTRIC CODE (NEC) AND MEETING THE REQUIREMENTS OF ALL GOVERNING CODES. ELECTRICAL CONTRACTOR TO PROVIDE REQUIRED DIRECT HOOK-UPS/CUTOFFS.
3. HVAC CONTRACTOR TO VERIFY THERMOSTAT LOCATIONS.
4. ALL ELECTRICAL AND MECHANICAL EQUIPMENT (I.E. FURNACES, A/C UNITS, ELECTRICAL PANELS, SANITARY SUMP PITS, DRAIN TILE SUMP, AND WATER HEATERS) ARE SUBJECT TO RELOCATION DUE TO FIELD CONDITIONS.
5. ELECTRICAL DEVICES: ABOVE FINISHED FLOOR:
- SWITCHES OVER COUNTER. . . . . 48" TO CL
- WALL OUTLETS OVER COUNTER. . . . . 12" TO CL
- +42" TO BOTTOM OF HORIZONTAL OUTLET(TYP. @ COUNTER)
- REMAINING SWITCHES. . . . . 48" TO CL
- WALL OUTLETS. . . . . 12" TO CL
- BATH VANITY BRACKET OUTLET. . . . . 12" (1" ABOVE TOP OF VANITY)
- WATER SOFTENER AND SUMP OUTLETS. . . . 48" TO CL
- EXTERIOR GFI OUTLETS. . . . . 12" TO CL
- GARAGE GFI (ABOVE GARAGE FLOOR). . . . 48" TO CL
- FRONT DOOR COACH LIGHT. . . . . 80" TO CL
- GARAGE DOOR COACH LIGHT, (ABOVE GARAGE FLOOR). . . . . 84" TO CL
- THERMOSTAT. . . . . 54" TO CL
- DOORBELL CHIMES. . . . . 84" TO CL
- DOORBELL BUTTON. . . . . LEVEL W/ DOOR HANDLE
- KITCHEN HOOD FAN "WHIP". . . . . 66" TO CL
- KITCHEN WALL HUNG MICROWAVE OUTLET. . 72" TO CL
- KITCHEN DISHWASHER RECEPTACLE. . . . UNDER SINK
- KITCHEN RANGE. . . . . 24" TO CL
- KITCHEN REFRIGERATOR. . . . . 48" TO CL
- WASHER/DRYER OUTLET. . . . . 48" TO CL
- CL = CENTER LINE
- 1 = FIELD VERIFY
- 2 = MASTER BATH STANDARD 30" HIGH VANITY TO BE RAISED 4"

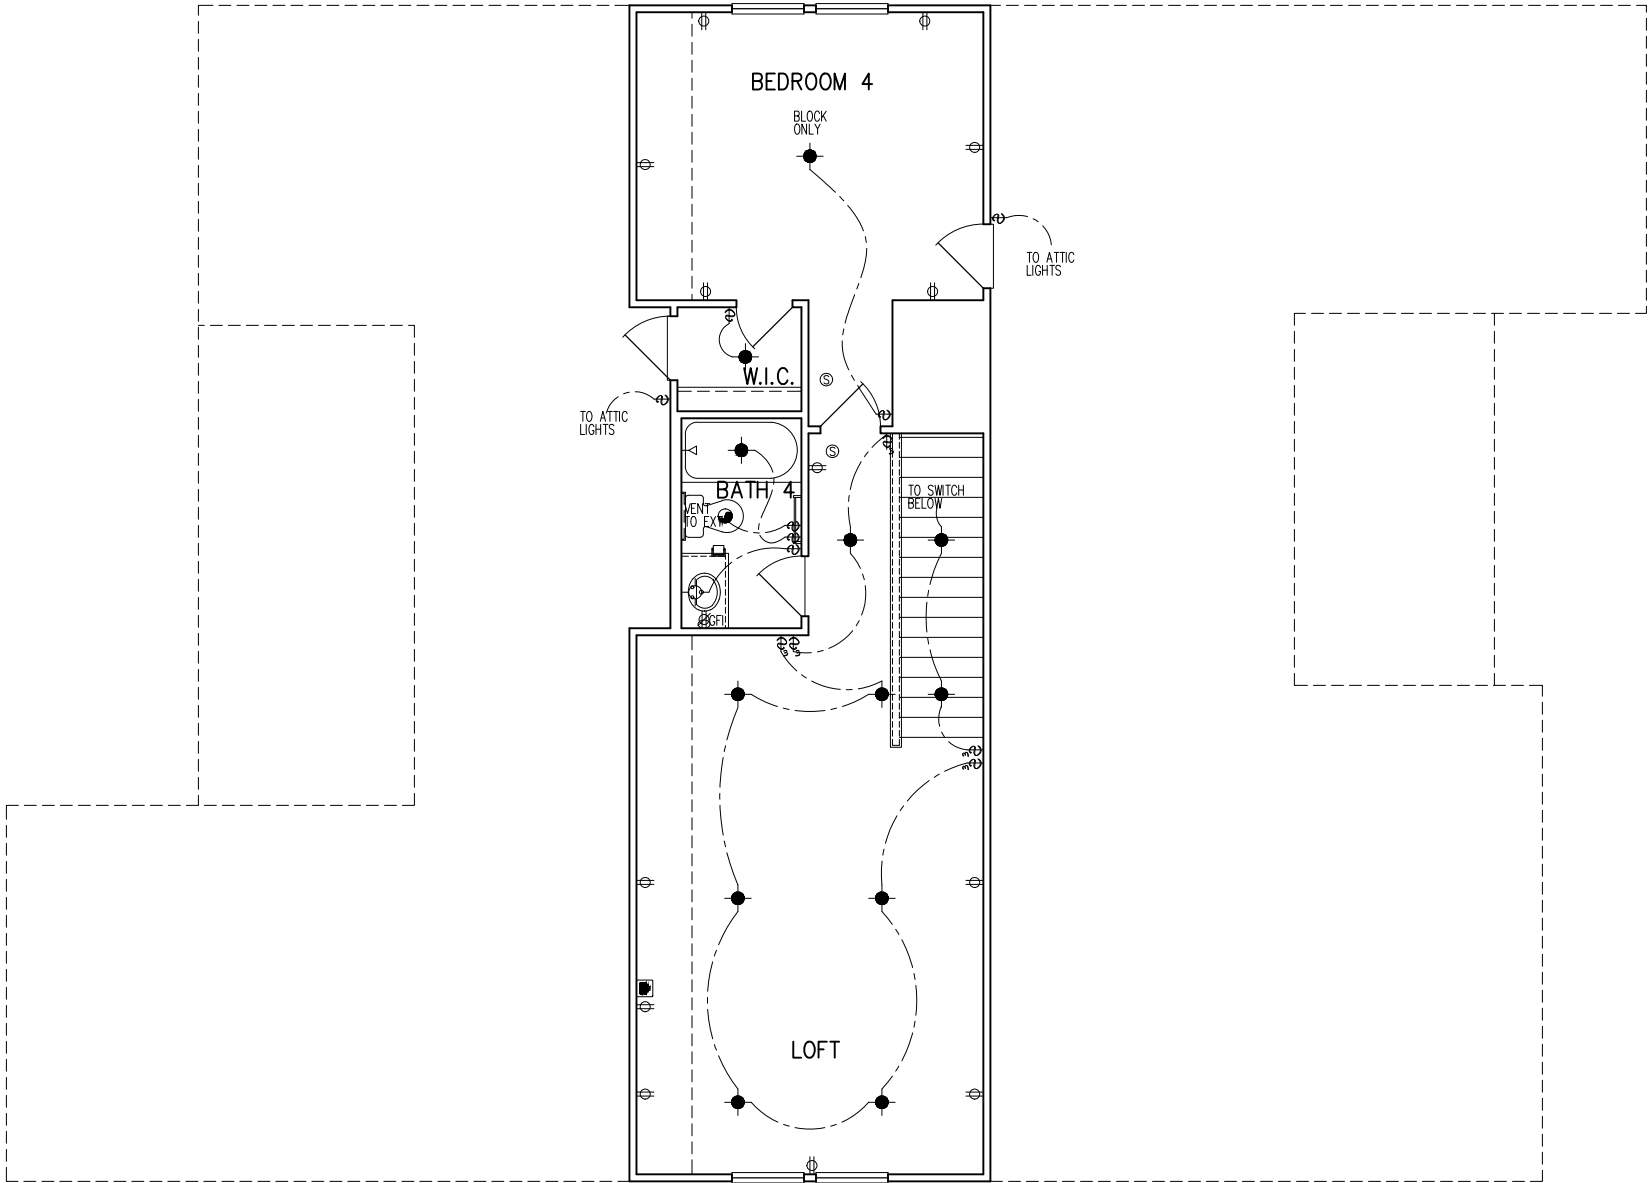

SECOND FLOOR PLAN  
PARTIAL ELECTRICAL PLAN

1/8"=1'-0"

tri pointe  
H O M E S

5440 WADE PARK BLVD, SUITE 400, RALEIGH, NC 27607

Business Operations  
5440 Wade Park Blvd  
Suite 400  
Raleigh, NC 27607

© 2022

2ND FLR ELEC. PLAN - OPTION


SUBDIVISION: ALTIS @ SERENITY  
ADDRESS: 137 FIREFLY LN  
LOT: 341

Issue Date: 10-01-24  
Drawn By: ACC

PLAN #:  
5921-07

PLAN NAME:  
ASPEN CREEK

SHEET #:  
01.E20

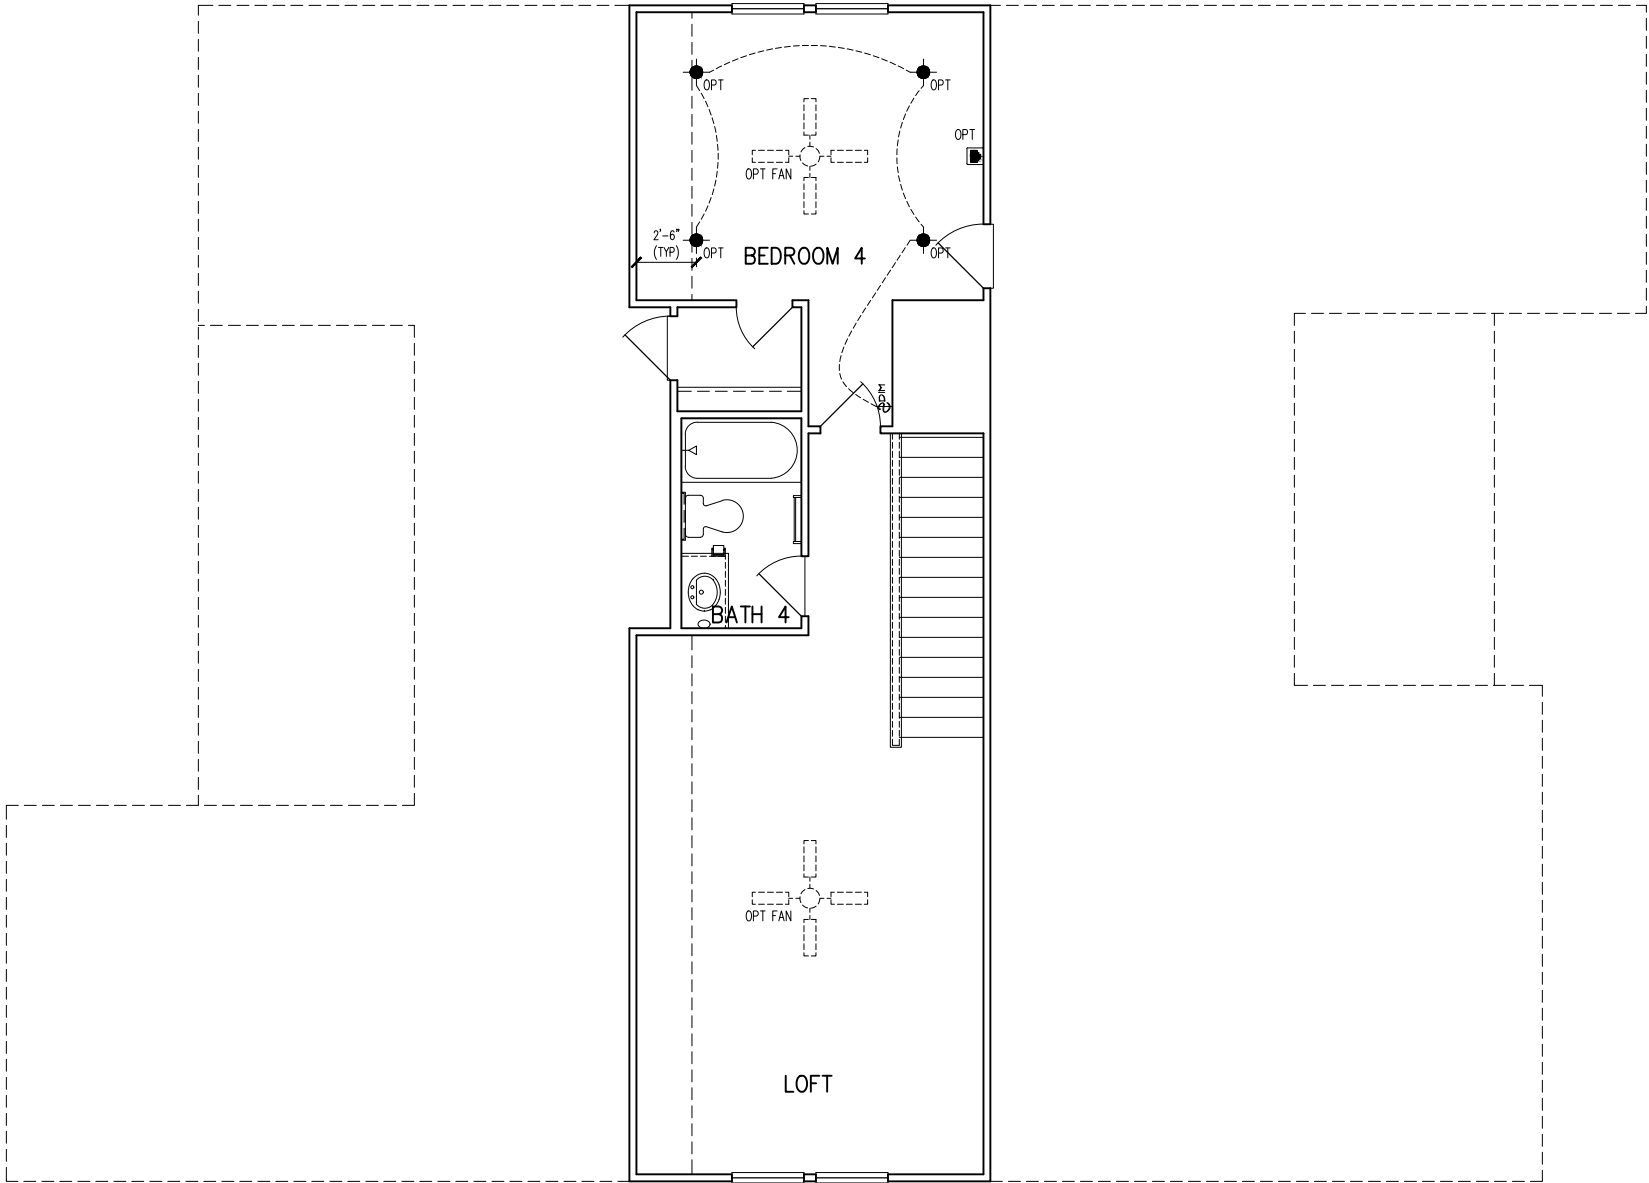

CHECK BOO FOR SELECTED ELECTRICAL OPTIONS

SECOND FLOOR PLAN  
PARTIAL ELECTRICAL PLAN

1/8"=1'-0"

tri pointe  
H O M E S

5440 WADE PARK BLVD, SUITE 400, RALEIGH, NC 27607

Business Operations  
5440 Wade Park Blvd  
Suite 400  
Raleigh, NC 27607

© 2022

2nd FLOOR ELEC. PLAN - OPTION

SUBDIVISION: ALTIS @ SERENITY

ADDRESS: 137 FIREFLY LN


LOT: 341

Issue Date: 10-01-24  
Drawn By: ACC


PLAN #:  
5921-07

PLAN NAME:  
ASPEN CREEK


SHEET #:  
01.E21

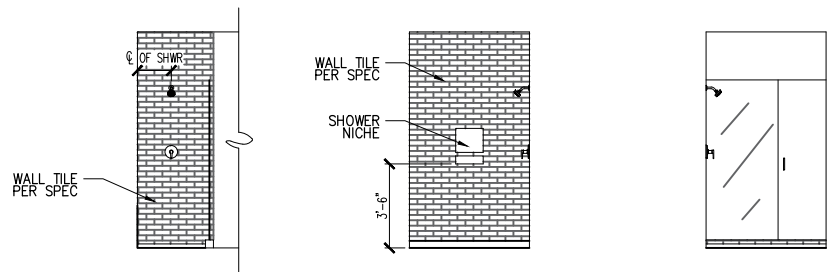


**TYPICAL SHOWER NICHE AT SHOWER DETAIL**  
3/16"=1'-0"

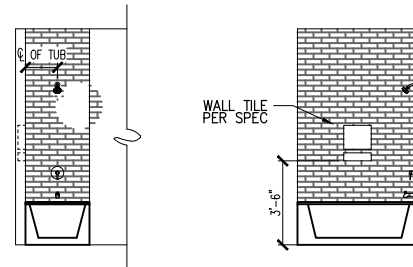


**TYPICAL SHOWER NICHE AT TUB SHOWER DETAIL**  
3/16"=1'-0"

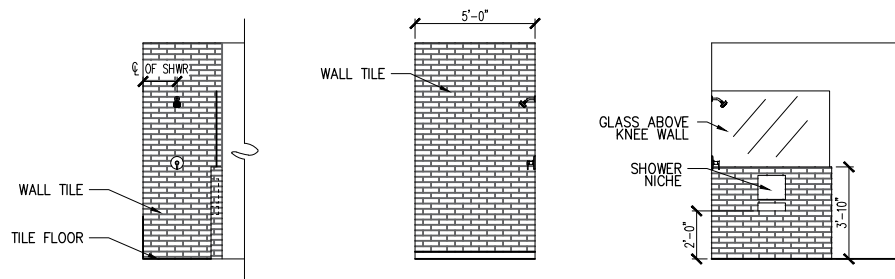

**TYPICAL SHOWER DETAIL W/ SHOWER NICHE IN KNEE WALL**  
3/16"=1'-0"

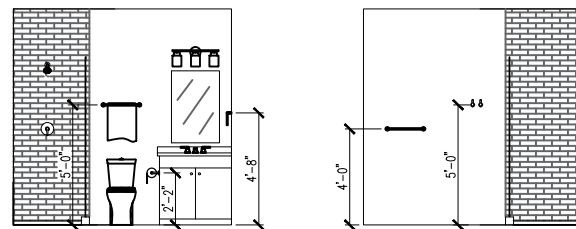

**TYPICAL HEIGHTS FOR BATH FIXTURES DETAIL**  
3/16"=1'-0"

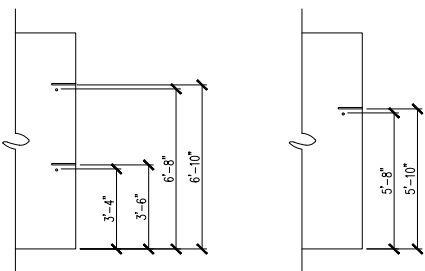

**TYPICAL CLOSET RODS & SHELVES DETAIL**  
3/16"=1'-0"

**tri pointe**  
H O M E S  
5440 WADE PARK BLVD, SUITE 400, RALEIGH, NC 27607

Business Operations  
5440 Wade Park Blvd  
Suite 400  
Raleigh, NC 27607  
© 2022

DETAILS

SUBDIVISION: ALTIS @ SERENITY  
ADDRESS: 137 FIREFLY LN  
LOT: 341


Issue Date: 10-01-24  
Drawn By: ACC

PLAN #:  
5921-07

PLAN NAME:  
ASPEN CREEK

SHEET #:  
D1.0



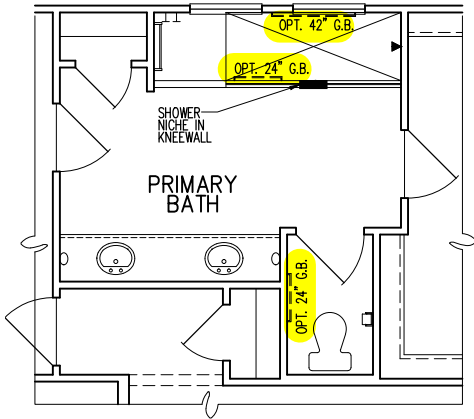

**OPT. PRIMARY BATH 3  
PARTIAL FLOOR PLAN**

1/8"=1'-0"

PRTL FLR PLNS – OPT. GRAB BARS

SUBDIVISION: ALTIS @ SERENITY

ADDRESS: 137 FIREFLY LN

LOT: 341

Issue Date: 10-01-24  
Drawn By: ACC

PLAN #:  
5921-07

PLAN NAME:  
ASPEN CREEK

SHEET #:  
D2.0

Business Operations  
5440 Wade Park Blvd  
Suite 400  
Raleigh, NC 27607

© 2022

tri pointe  
HOMES

5440 WADE PARK BLVD, SUITE 400, RALEIGH, NC 27607

GENERAL STRUCTURAL NOTES
FLOOR FRAMING
<ul style="list-style-type: none"><li>• I-JOISTS/TRUSSES SHALL BE DESIGNED BY MANUF. TO MEET OR EXCEED L/480 LIVE LOAD DEFLECTION CRITERIA. (EXCLUDES STONE/MARBLE OR NET BED CONSTRUCTED FLOORS - CONTACT MKK FOR EXCLUDED FLOOR DESIGNS)</li><li>• PER THE GUIDELINES OF THE TILE COUNCIL OF NORTH AMERICA (TCNA HANDBOOK), IT SHALL BE THE FLOOR FINISH INSTALLER'S RESPONSIBILITY TO VERIFY THAT THE FINISHES TO BE INSTALLED MATCH THE DESIGN CRITERIA NOTED ABOVE (UNDER "DESIGN LOADS").</li><li>• FLOOR SYSTEMS &amp; SHEATHING HAVE BEEN DESIGNED TO SUPPORT ADDITIONAL DEAD LOAD FROM CERAMIC TILE (EXCLUDING MARBLE OR STONE). HOWEVER, IT SHALL BE THE FLOOR FINISH INSTALLER'S RESPONSIBILITY TO PROVIDE PROPER UNDERLAYMENT, UNCOUPLING MEMBRANE AND MORTAR/GROUT PER THE ASSEMBLY DESIGNATIONS IN THE TCNA HANDBOOK (TILE COUNCIL OF NORTH AMERICA).</li><li>• AT I-JOIST FLOORS, PROVIDE 1 1/8" MIN. OSB RIM BOARD.</li><li>• METAL HANGERS SHALL BE SPECIFIED BY MANUFACTURER, U.N.O.</li><li>• I-JOIST/TRUSS SHOP DWGS. SHALL BE SUBMITTED TO ARCH. &amp; ENG. FOR REVIEW AND APPROVAL PRIOR TO FABRICATION OR DELIVERY.</li><li>• FLOOR SHEATHING SHALL BE 23/32" A.P.A. RATED "STURD-I-FLOOR" 24" O.C., EXPOSURE 1 (OR APPROVED EQUAL) WITH TONGUE AND GROOVE EDGES. FASTEN TO FRAMING MEMBERS W/ GLUE AND<ul style="list-style-type: none"><li>- 2 1/2" x 0.131" NAILS @ 6" O.C. @ PANEL EDGES @ 12" O.C. FIELD.</li><li>- 2 3/8" x 0.120" NAILS @ 4" O.C. @ PANEL EDGES @ 8" O.C. FIELD.</li><li>- 2 3/8" x 0.113" NAILS @ 3" O.C. @ PANEL EDGES @ 6" O.C. IN FIELD.</li></ul></li></ul>
ROOF FRAMING
<ul style="list-style-type: none"><li>• ROOF SHEATHING SHALL BE 7/16" A.P.A. RATED SHEATHING 24/16 EXPOSURE 1 (OR APPROVED EQUAL). FASTEN TO FRAMING MEMBERS<ul style="list-style-type: none"><li>- W/ 2 1/2" x 0.131" NAILS @ 6" O.C. @ PANEL EDGES @ 12" O.C. FIELD.</li><li>- W/ 2 3/8" x 0.120" NAILS @ 4" O.C. @ PANEL EDGES @ 8" O.C. FIELD.</li><li>- W/ 2 3/8" x 0.113" NAILS @ 3" O.C. @ PANEL EDGES @ 6" O.C. FIELD.</li></ul></li><li>• WITHIN 48" OF ALL ROOF EDGES, RIDGES, &amp; HIPs FASTEN ROOF SHEATHING FIELDS PER EDGE NAILING SPEC.</li><li>• FASTEN EACH ROOF TRUSS TO TOP PLATE W/ SIMPSON H2.5T CLIP (OR APPROVED EQUAL) @ ALL BEARING POINTS. PROVIDE (2) H2.5T CLIPS AT 2-PLY GIRDER TRUSSES, (3) H2.5T CLIPS AT 3-PLY GIRDER TRUSSES &amp; ROOF BEAMS - AT ALL BEARING POINTS.</li><li>• METAL HANGERS SHALL BE SPECIFIED BY THE MANUFACTURER, U.N.O.</li><li>• ROOF TRUSS SHOP DWGS. SHALL BE SUBMITTED TO ARCH &amp; ENG. FOR REVIEW AND APPROVAL PRIOR TO FABRICATION OR DELIVERY.</li><li>• ERECT AND INSTALL ROOF TRUSSES PER ITCA &amp; TP1'S BC51 I "GUIDE TO GOOD PRACTICE FOR HANDLING, INSTALLING &amp; BRACING OF METAL PLATE CONNECTED WOOD TRUSSES."</li><li>• SUPPORT SHORT SPAN ROOF TRUSSES W/2x4 LEDGER FASTENED TO FRAMING W/ (2) 3" x 0.120" NAILS @ 16" O.C. (UP TO 1" SPAN).</li></ul>

MMK STD. - MAR 2016

#### CONNECTION SPECIFICATIONS (TYP. U.N.O.)

DESCRIPTION OF BLDG. ELEMENT	3"x0.131" NAILS	3"x0.120" NAILS
JOIST TO SOLE PLATE	(3) TOENAILS	(3) TOENAILS*
SOLE PL. TO JOIST/RIM OR BLK'G STUD TO PLATE	NAILS @ 4" O.C.	NAILS @ 4" O.C.
RIM TO TOP PLATE	(4) TOENAILS/ (3) END NAILS	(4) TOENAILS/ (4) END NAILS*
BLK'G. BTWN. JOISTS TO TOP PL.	TOENAILS @ 6" O.C.	TOENAILS @ 4" O.C.*
DOUBLE STUD	(3) TOENAILS EA. END	(3) TOENAILS EA. END*
DOUBLE TOP PLATE	NAILS @ 16" O.C.	NAILS @ 16" O.C.
DOUBLE TOP PLATE LAP SPLICE	NAILS @ 12" O.C.	NAILS @ 8" O.C.
TOP PLATE LAP @ CORNERS & INTERSECTING WALLS	(12) NAILS IN LAPPED AREA (24" MIN.)	(15) NAILS IN LAPPED AREA (24" MIN.)
RAFTER/TRUSS TO TOP PLATE	(3) NAILS	(3) NAILS
GAB. END TRUSS TO DBL. TOP PL.	(4) TOENAILS + (1) SIMPSON H2.5T TOENAILS @ 8" O.C.	(4) TOENAILS + (1) SIMPSON H2.5T TOENAILS @ 6" O.C.
R.T. w/ HEEL HT. 9 1/4" TO 12"	2x10 BLK EVERY 3RD BAY FASTENED TO DBL. TOP PLATE W/ TOENAILS @ 6" O.C.	2x10 BLK EVERY 3RD BAY FASTENED TO DBL. TOP PLATE W/ TOENAILS @ 4" O.C.
R.T. w/ HEEL HT. 12" TO 16"	2x12 BLK EVERY 3RD BAY FASTENED TO DBL. TOP PLATE W/ TOENAILS @ 6" O.C.	2x12 BLK EVERY 3RD BAY FASTENED TO DBL. TOP PLATE W/ TOENAILS @ 4" O.C.
R.T. w/ HEEL HT. UP TO 24"	LAP WALL SHTG. w/ DBL. TOP PL. & INSTALL ON TRUSS VERT. - FASTEN W/ NAILS @ 6" O.C.	LAP WALL SHTG. w/ DBL. TOP PL. & INSTALL ON TRUSS VERT. - FASTEN W/ NAILS @ 6" O.C.*
R.T. w/ HEEL HT. 24" TO 48"	LAP WALL SHTG. w/ DBL. TOP PL. & INSTALL ON TRUSS VERT. - FASTEN W/ NAILS @ 6" O.C. PROVIDE 2x BLK @ EA. BAY AT TOP OF HEEL	LAP WALL SHTG. w/ DBL. TOP PL. & INSTALL ON TRUSS VERT. - FASTEN W/ NAILS @ 6" O.C. PROVIDE 2x BLK @ EA. BAY AT TOP OF HEEL.*
WALL TO FOUNDATION	WALL SHTG. LAP W/ SILL PL. & FASTENED PER SHEAR WALL FASTENING SPEC.	

\* 2 1/2"x0.113 IS AN ACCEPTABLE ALTERNATIVE TO A 3"x0.120", SAME SPACING OR NUMBER OF NAILS. (ONLY ACCEPTABLE WHERE \* ARE SHOWN)

GENERAL STRUCTURAL NOTES
DESIGN LOADING
<ul style="list-style-type: none"><li>• DESIGN IS BASED ON 2018 NORTH CAROLINA STATE BUILDING CODE: RESIDENTIAL CODE.</li><li>• WOOD FRAME ENGINEERING IS BASED ON NDS, "NATIONAL DESIGN SPECIFICATION FOR WOOD CONSTRUCTION" - LATEST EDITION.</li><li>• DESIGN LOADS:<ul style="list-style-type: none"><li>ROOF<ul style="list-style-type: none"><li>SNOW = 15 PSF (12 PSF GROUND SNOW, TRUSSES)</li><li>LIVE = 20 PSF (REDUCIBLE BASED ON ROOF PITCH)</li><li>DEAD = 1 PSF T.C., 10 PSF B.C.</li><li>LOAD DURATION FACTOR = 1.25</li></ul></li><li>FLOOR<ul style="list-style-type: none"><li>LIVE = 40 PSF (30 PSF @ SLEEPING AREAS)</li><li>DEAD = 10 PSF (1-JOISTS), 15 PSF (FLOOR TRUSSES)</li><li>ADDL 10 PSF @ CERAMIC TILE IN KITCHEN, SUNROOMS, BATHS, FOYER, LAUND. &amp; MUDRM'S</li></ul></li><li>SOIL 2,000 PSF ASSUMED ALLOWABLE BEARING PRESSURE (TO BE VERIFIED BY BUILDER)</li><li>WIND 115 MPH, EXPOSURE B</li></ul></li></ul>

#### GENERAL FRAMING

- ALL TYP. NAIL FASTENER REQUIREMENTS ARE NOTED IN STANDARD CONNECTIONS TABLE (IRC TABLE R602.3.11) OR ON PLANS. ALL NAILS SPECIFIED ARE MIN DIAMETER AND LENGTH REQUIRED FOR CONNECTION. ALL HANGER NAILS SHALL BE INSTALLED PER MANUFACTURER'S REQUIREMENTS FOR MAX CHARTED CAPACITY. NOTE: HANGERS USE COMMON NAIL DIAMETERS NOT TYPICAL FRAMING GUN NAILS.
- EXT. & INT. BEARING WALLS SHALL BE 2x4 OR 2x6 (AS SHOWN ON PLANS) @ 16" O.C. SPP/SP #2 GRADE LUMBER, OR BETTER, U.N.O..
  - WALLS OVER 12' TALL SHALL BE PER PLAN.
- ALL INTERIOR BEARING WALLS ARE ASSUMED TO BE SHEATHED W/ GYP WALL BOARD (ONE SIDE MIN.) OR PROVIDE MID HT. BLOCKING.
- ALL HEADERS, BEAMS & OTHER STRUCTURAL MEMBERS SHALL BE SPRUCE-PINE-FIR #2 (SPF) OR SOUTHERN PINE #2 (SP) LUMBER, OR BETTER. SUPPORT ALL HEADERS/ BEAMS W/ (1)2x JACK STUD & (1)2x KING STUD, MINIMUM.
  - THE NUMBER OF STUDS SPECIFIED AT A SUPPORT INDICATES THE NUMBER OF JACK STUDS REQUIRED, U.N.O..
- ALL NON-BEARING INTERIOR STUD WALLS SHALL BE CONSTRUCTED WITH 2x STUD/ GRADE MEMBERS SPACED @ 24" O.C. (MAX., U.N.O.)
  - HEADERS IN NON-LOAD BEARING WALLS SHALL BE: (1)2x4/6 FLAT @ OPENINGS UP TO 4'; (2)2x4/6 FLAT UP TO 8'.
- ALL FRAMING LUMBER SHALL BE DRIED TO 15% MC (KD-15).
- ENGINEERED LUMBER BEAMS TO MEET OR EXCEED THE FOLLOWING:
  - LVL' - Fb=2600 psi; Fv=285 psi; E=2.0x10<sup>6</sup> psi
- ENGINEERED LUMBER POSTS TO MEET OR EXCEED THE FOLLOWING:
  - LVL' - Fb=2400 psi; FcII=2500 psi; E=1.8x10<sup>6</sup> psi
- FOR 2 & 3 PLY BEAMS OF EQUAL 1 3/4" MAX. WIDTH, FASTEN PLIES TOGETHER WITH 3 ROWS OF 3"x0.120" NAILS @ 8" O/C OR 2 ROWS 1/2"x9/8". SIMPSON SDS SCREWS (OR 3/4" TRUSSLOK SCREWS) @ 16" O/C. USE A MINIMUM OF 4 ROWS FOR BEAM DEPTHS OF 14" OR GREATER. APPLY FASTENING AT BOTH FACES FOR 3-PLY CONDITION. LOCATE TOP & BOTTOM NAILS/SCREWS 2" FROM EDGE. SOLID 3 1/2" OR 5 1/4" BEAMS ARE ACCEPTABLE. USE 2 ROWS OF NAILS FOR 2x6 & 2x8 MEMBERS.
- FOR 4 PLY BEAMS OF EQUAL 1 3/4" MAX. WIDTH, FASTEN PLIES TOGETHER WITH 3 ROWS OF 1/2"x6" SIMPSON SDS SCREWS (OR 6 3/4" TRUSSLOK SCREWS) @ 16" O/C. USE A MINIMUM OF 4 ROWS FOR BEAM DEPTHS OF 14" OR GREATER. APPLY FASTENING AT BOTH FACES (ONE SIDE ONLY FOR TRUSSLOK SCREWS). LOCATE TOP AND BOTTOM SCREWS 2" FROM EDGE. A SOLID 1" BEAM IS ACCEPTABLE.
- PROVIDE SOLID BLOCKING IN FLOOR SYSTEM UNDER ALL POSTS CONTINUOUS TO FND/BEARINGS. BLOCKING TO MATCH POST ABOVE.
- ALL EXTERIOR 4x4 WOOD POSTS SHALL HAVE SIMPSON BC52-2/4 CAP & ABW44 BASE, U.N.O.
- CORROSION NOTES:
  - BUILDER RESPONSIBLE TO DETERMINE CORROSION-RESISTANCE REQUIREMENTS AND COMPATIBILITY OF HARDWARE, FASTENERS AND CONNECTORS FOR ENVIRONMENTAL EXPOSURE AND IN CONTACT W/ PRESERVATIVE-TREATED WOOD OF ACTUAL FINAL CONDITIONS AND SOURCED MATERIALS. CONTACT LUMBER & HARDWARE SUPPLIERS TO COORD.

#### GENERAL STRUCTURAL NOTES

##### FOUNDATION

- DESIGN IS BASED ON 2018 NORTH CAROLINA STATE BUILDING CODE: RESIDENTIAL CODE.
- FOOTING DESIGN - 2,000 PSF ALLOWABLE SOIL BEARING PRESSURE IS ASSUMED. BUILDER/CONTRACTOR MUST VERIFY.
- FASTEN 2x4/6 SILL PLATES TO CONC FND WITH A MINIMUM OF 2 ANCHORS PER PLATE, 12" MAX. FROM PLATE ENDS - UTILIZING:
  - 1/2" DIA. ANCHOR BOLTS @ 6'-0" O.C., 1" MIN. EMBEDMENT
  - 1/2" DIA. x 6" LONG SIMPSON TITEN HD @ 6'-0" O.C.
  - SIMPSON MASA ANCHOR STRAPS @ 6'-0" O.C. (CONCRETE)
- ALL LUMBER EXPOSED TO WEATHER OR IN CONTACT W/ PERIMETER FOUNDATION SHALL BE PRESERVATIVE TREATED SOUTHERN PINE #2.
- BUILDER TO VERIFY CORROSION-RESISTANCE COMPATIBILITY OF HARDWARE & FASTENERS IN CONTACT W/ PRESERVATIVE-TREATED WOOD. CONTACT LUMBER & HARDWARE SUPPLIERS TO COORD.
- FOOTINGS SHALL BE PLAIN CONCRETE, U.N.O.
- CONCRETE DESIGN BASED ON ACI 318. CONCRETE SHALL ATTAIN THE FOLLOWING MIN. COMPRESSIVE STRENGTHS IN 28 DAYS, U.N.O.:
  - Fc = 3,000 psi: ..... FOOTINGS & INTERIOR SLABS ON GRADE
  - 3,500 psi: ..... GARAGE & EXTERIOR SLABS ON GRADE
  - fy = 60,000 psi

- ALL CONCRETE EXPOSED TO THE WEATHER SHALL NOT HAVE LESS THAN 5% OR MORE THAN 1% AIR ENTRAINMENT.
- ALL FOOTINGS SHALL BEAR BELOW FROST LINE (TYP.) OR 12" MIN IN REGIONS WHERE CODE FROST DEPTH IS NOT APPLICABLE. CONSULT SOILS REPORT OR BUILDING DEPT. FOR MINIMUM DEPTH BELOW GRADE.
- FOOTINGS AND SLABS ON GRADE SHALL BEAR ON VIRGIN SOIL OR 95% COMPACTED FILL.
- PROVIDE CONTROL JOINTS AT ALL INSIDE CORNERS OF SLAB EDGES, AND OTHER LOCATIONS WHERE SLAB CRACKS ARE LIKELY TO DEVELOP.
  - JOINTS SHALL BE LOCATED @ 10'-0" O.C. (RECOMMENDED) OR 15'-0" O.C. (MAXIMUM)
  - JOINT GRID PATTERN SHALL BE AS CLOSE TO SQUARES AS POSSIBLE (1:1 RATIO), WITH A MAXIMUM OF 1:1.5 RATIO
  - CONTROL JOINTS SHALL NOT BE INSTALLED IN STRUCTURAL SLABS
- DIMENSIONS BY OTHERS, BUILDER TO VERIFY.

MMK STD. - MAY 2002

## LOT 341 5921-07 ASPEN CREEK ELEVATION C REVERSE PLAN LEFT-HAND GARAGE

OVER 9000 FT<sup>2</sup> -  
NO FIRE RATED  
WALL REQUIRED

#### MEANS & METHODS NOTES

THE STRUCTURE IS DESIGNED TO BE SELF SUPPORTING AND STABLE AFTER THE BUILDING IS FINISHED AND ALL PLAN, DETAIL, AND NOTE SPECIFICATIONS HAVE BEEN COMPLETED. IT IS THE CONTRACTOR'S SOLE RESPONSIBILITY TO DETERMINE THE ERECTION PROCEDURES AND SEQUENCE TO INSURE THE SAFETY OF THE BUILDING AND ITS COMPONENTS DURING CONSTRUCTION. THIS INCLUDES, BUT IS NOT LIMITED TO, THE ADDITION OF NECESSARY SHORING, SHEETING, TEMPORARY BRACING, GUYS, AND TIE-DOWNS. CONTRACTOR SHALL BE RESPONSIBLE FOR ALL SHORING AND BRACING REQUIRED TO STABILIZE AND PROTECT EXISTING AND ADJACENT STRUCTURES AND SYSTEMS DURING COURSE OF DEMOLITION AND CONSTRUCTION OF THE PROJECT.

STRUCTURAL DESIGN AND SPECIFICATIONS ASSUME THAT ALL SUPPORTING AND NON-SUPPORTING ELEMENTS IN CONTACT WITH FLOOR FRAMING ARE LEVEL, INCLUDING, BUT NOT LIMITED TO: FOUNDATIONS, SLABS ON GRADE, BEAMS, WALLS, AND NON-BEARING ELEMENTS. IT IS THE CONTRACTOR'S RESPONSIBILITY TO VERIFY LEVELNESS AND MAKE ADJUSTMENTS AS NECESSARY, INCLUDING CONSIDERATION OF THOSE AREAS THAT MAY BE WITHIN CONTRACTUAL, INDUSTRY, OR WARRANTY TOLERANCES.

#### VENEER LINTEL SCHEDULE

SPAN (MAX)	HEIGHT OF VENEER ABOVE LINTEL	STEEL ANGLE SIZE
3'-0"	20 FT. MAX	L3"x3"x1/4"
6'-0"	3 FT. MAX	L3"x3"x1/4"
	12 FT. MAX	L4"x3"x1/4"
8'-0"	20 FT. MAX	L5"x3 1/2"x3/8"
	12 FT. MAX	L4"x4"x1/4" **
9'-6"	12 FT. MAX	L5"x3 1/2"x3/8"
	16 FT. MAX	L6"x3 1/2"x3/8"
16'-0"	12 FT. MAX	L6"x3 1/2"x3/8"
	2 FT. MAX	L7"x4"x1/2" **
16'-0"	3 FT. MAX	L8"x4"x1/2" **

ALL LINTELS:  
- SHALL SUPPORT 2 3/8" - 3 1/2" VENEER w/ 40 psf MAXIMUM HEIGHT.  
- 1/8" SHALL HAVE 4" MIN BEARING  
- 1/2" SHALL HAVE 8" MIN BEARING  
- 1/2" SHALL NOT BE FASTENED BACK TO HEADER  
- 1/2" SHALL BE FASTENED BACK TO WOOD HEADER IN WALL @ 48" O.C. W/ 1/2" DIA. x 3 1/2" LONG LAG SCREWS IN 2" LONG VERTICALLY SLOTTED HOLES.  
- MAX. VENEER HT. APPLIES TO ANY PORTION OF BRICK OVER THE OPENING.  
- ALL LINTELS SHALL BE LONG LESS VERTICAL  
- WHEN SUPPORTING VENEER < 3" WIDE THE EXTERIOR TOE OF THE HORIZONTAL LEG MAY BE CUT IN THE FIELD TO BE 3 1/2" WIDE OVER THE BEARING LENGTH ONLY. THIS IS TO ALLOW FOR MORTAR JOINT FINISHING.  
- SEE STRUCTURAL PLANS FOR ANY LINTEL CONDITION NOT ENCOMPASSED BY THE ABOVE PARAMETERS.  
\*\* FOR GREEN VENEER USE 1/4x3/4".  
\*\* FOR 3 1/2" VENEER ONLY, SEE PLAN FOR VENEER SUPPORT IF VENEER < 3/8" THICK.

MMK STD. - MAY 2016

#### ADDITIONAL NOTES FOR TRUSS & I-JOIST MANUFACTURER

ROOF TRUSS, FLOOR TRUSS AND ENGINEERED JOISTS SHALL BE DESIGNED TO MEET THE DEFLECTION CRITERIA BELOW, UNLESS NOTED OTHERWISE ON PLAN. MULHERN & KULP CANNOT BE HELD RESPONSIBLE FOR ANY STRUCTURAL ISSUES RELATED TO ANY BUILDING COMPONENT IF COMPONENT SHOP DRAWINGS ARE NOT SUBMITTED TO MKK FOR REVIEW PRIOR TO FABRICATION, DELIVERY, OR INSTALLATION.

TRUSSES/JOISTS SHALL BE DESIGNED SO THAT DIFFERENTIAL DEFLECTION BETWEEN ADJACENT PARALLEL TRUSSES/JOISTS OR GIRDER TRUSSES/FLUSH BEAMS DO NOT EXCEED THE FOLLOWING:

A. ROOF TRUSSES:  
1/4" DEAD LOAD  
B. FLOOR TRUSSES, ATTIC TRUSSES, & I-JOISTS:  
1/8" DEAD LOAD

ABSOLUTE DEAD LOAD DEFLECTION OF FLOOR TRUSSES/ATTIC TRUSSES WHEN ADJACENT TO FLOOR FRAMING BY OTHERS SHALL BE LIMITED TO 3/16". (NOT DIFFERENTIAL DEFLECTION)

#### FLOOR JOIST NOTES

- ALL FLOOR JOISTS SHALL BE THE DEPTH SPECIFIED ON PLAN
- FLOOR JOISTS SERIES & SPACING IS PER THE FLOOR JOIST MANUF.
  - SPACING SHALL NOT EXCEED 19.2" O.C. (MAX.)
  - @ LOCATION OF TILE: SPACING SHALL NOT EXCEED 16" O.C. (MAX.)

#### LATERAL/WALL BRACING & WALL SHEATHING SPECIFICATIONS

THIS MODEL HAS BEEN DESIGNED TO RESIST LATERAL FORCES RESULTING FROM:  
**115 MPH WIND IN 2018 NCSEBG:RC**  
(115 MPH WIND SPEED IN ASCE 7-10 WIND MAP, PER IRC R301.2.1.1) EXP. B, RISK CAT. 2 & SEISMIC CAT. A/B.

THE DESIGN WAS COMPLETED PER 2015 IBC (SECTION 1609) & ASCE 7-10, AS PERMITTED BY R301.1.3 OF THE 2018 NCSEBG:RC. ACCORDINGLY, THIS MODEL, AS DOCUMENTED AND DETAILED HEREIN, IS ADEQUATE TO RESIST THE CODE REQUIRED LATERAL FORCES.

DESIGN WIND UPLIFT LOADS HAVE BEEN CALCULATED UTILIZING ASCE 7-10 (ACCEPTED ENGINEERING PRACTICE) AS ALLOWED PER 2018 NCSEBG:RC SECTION R802.11.1.1. THIS MODEL HAS BEEN DETAILED WHERE REQUIRED & ENGINEERED TO RESIST THE WIND UPLIFT LOAD PATH PER SECTIONS R602.3.5 & R802.11.

#### EXT. WALL SHEATHING SPECIFICATION

- 7/16" OSB OR 15/32" PLYWOOD:
  - FASTEN SHEATHING W/ 2 3/8"x0.113 NAILS @ 6" O.C. AT EDGES & @ 12" O.C. IN THE PANEL FIELD. (TYP, U.N.O.)
- ALL SHEATHING PANELS SHALL BE ORIENTED VERTICALLY (LONG DIRECTION PARALLEL TO STUDS) AND INSTALLED FULL HEIGHT OF SHEAR WALL - OR - 2x HORIZONTAL BLOCKING SHALL BE PROVIDED TO SUPPORT ALL UNSUPPORTED PANEL EDGES & EDGE FASTENING.
- ALL EXT. WALLS SHALL BE CONTINUOUSLY SHEATHED AND ARE CONSIDERED SHEAR WALLS.
- ALT. STAPLE CONNECTION SPEC: 1 3/4" 16 GA STAPLES (1/6" CROWN) @ 3" O.C. AT EDGES & @ 6" O.C. IN FIELD.

#### 3" O.C. EDGE NAILING

- AT DESIGNATED AREAS - FASTEN PANEL EDGES OF WOOD STRUCTURAL WALL SHEATHING TO FRAMING W/ 2 3/8" x 0.113" NAILS @ 3" O.C. AND 12" O.C. IN THE PANEL FIELD NO STAPLE ALTERNATIVE AVAILABLE AT THIS SPEC. ALL SHEATHING PANELS SHALL BE ORIENTED VERTICALLY (LONG DIRECTION PARALLEL TO STUD) AND INSTALLED FULL HEIGHT OF SHEAR WALL - OR - 2x HORIZONTAL BLOCKING SHALL BE PROVIDED TO SUPPORT UNSUPPORTED PANEL EDGES AND 3" O.C. EDGE FASTENING.

#### TYP. UNIT SEPARATION WALL SHEATHING SPECIFICATION

- 1/2" OR 5/8" GYPSUM WALL BOARD:
  - FASTEN GWB SHEATHING TO FRAMING W/ 1 5/8"x0.086" COOLER NAILS OR 1 1/4" DRYWALL SCREWS @ 7" O.C. TO PANEL EDGES & PANEL FIELD (INCLUDING T&B PLATES).

#### NOTES

- SEE CONNECTION SPECIFICATIONS CHART FOR STANDARD SHEAR TRANSFER DETAILING. IF ADDITIONAL CAPACITY IS REQUIRED BY DESIGN, IT WILL BE SPECIFICALLY NOTED ON PLAN.
- DESIGN ASSUMES 16" O.C. MAX. STUD SPACING, U.N.O.
- ALL STRUCTURAL PANELS ARE TO BE DIRECTLY APPLIED TO STUD FRAMING.
- PRE-MANUFACTURED PANELIZED WALLS:
  - FASTEN TOGETHER END STUDS OF WALL PANELS SHEATHED W/ OSB OR PLYWOOD W/ 3" x 0.120" NAILS @ 4" O.C. (THRU ONE SIDE ONLY)

--- INDICATES EXTENT OF INT. OSB SHEARWALL, BLOCKED PANEL EDGES, AND/OR 3" O.C. EDGE NAILING  
▶ INDICATES HOLDOWN

MMK STD. - MAR 2016

seal: 5/19/25  
NORTH CAROLINA  
REGISTERED PROFESSIONAL  
SEAL  
017622  
ENGINEER  
STALAN KREIDEL  
© COPYRIGHT: MULHERN & KULP  
Structural Engineering, Inc.

**MULHERN+KULP**  
RESIDENTIAL STRUCTURAL ENGINEERING  
3605 Bonaventure Parkway, Suite 250 • Alpharetta, GA 30022  
970-777-4874 • mulhern+kulp.com  
NC License # C-3625



Mulhern+Kulp project number:

243-24033

project mgr:

SMK

drawn by:

KMV

issue date:

08-16-2024

REVISIONS:

date:	initial:
11-08-2024	SMK
UPDATED MODEL NAME, OPT. EXT. COVD. PORCH	
05-28-2025	JPP
MSG. ARCH. UPDATE	

**tri pointe**  
HOMES

GENERAL NOTES

5921-07 MODEL

SERENITY


MASTER SET

RALEIGH, NC

sheet:

S0.0

LOT 341  
5921-07  
ASPEN CREEK  
ELEVATION C  
REVERSE PLAN  
LEFT-HAND  
GARAGE

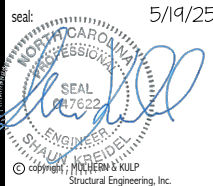

**MULHERN+KULP**  
RESIDENTIAL STRUCTURAL ENGINEERING  
3805 Bonaventure Parkway, Suite 250 • Alpharetta, GA 30022  
970-777-4074 • mulhern+kulp.com  
NC License # C-3625


Mulhern+Kulp project number:  
**243-24033**  
project mgr: **SMK**  
drawn by: **KMV**  
issue date: **08-16-2024**

REVISIONS:	
date:	initial:
11-08-2024	SMM
UPDATED MODEL NAME, OPT, EXT, COVD, PORCH	
05-28-2025	JJPP
MSG, ARCH, UPDATE	



FOUNDATION PLAN  
**5921-07 MODEL**  
SERENITY  
MASTER SET  
RALEIGH, NC

sheet:  
**S1.0**

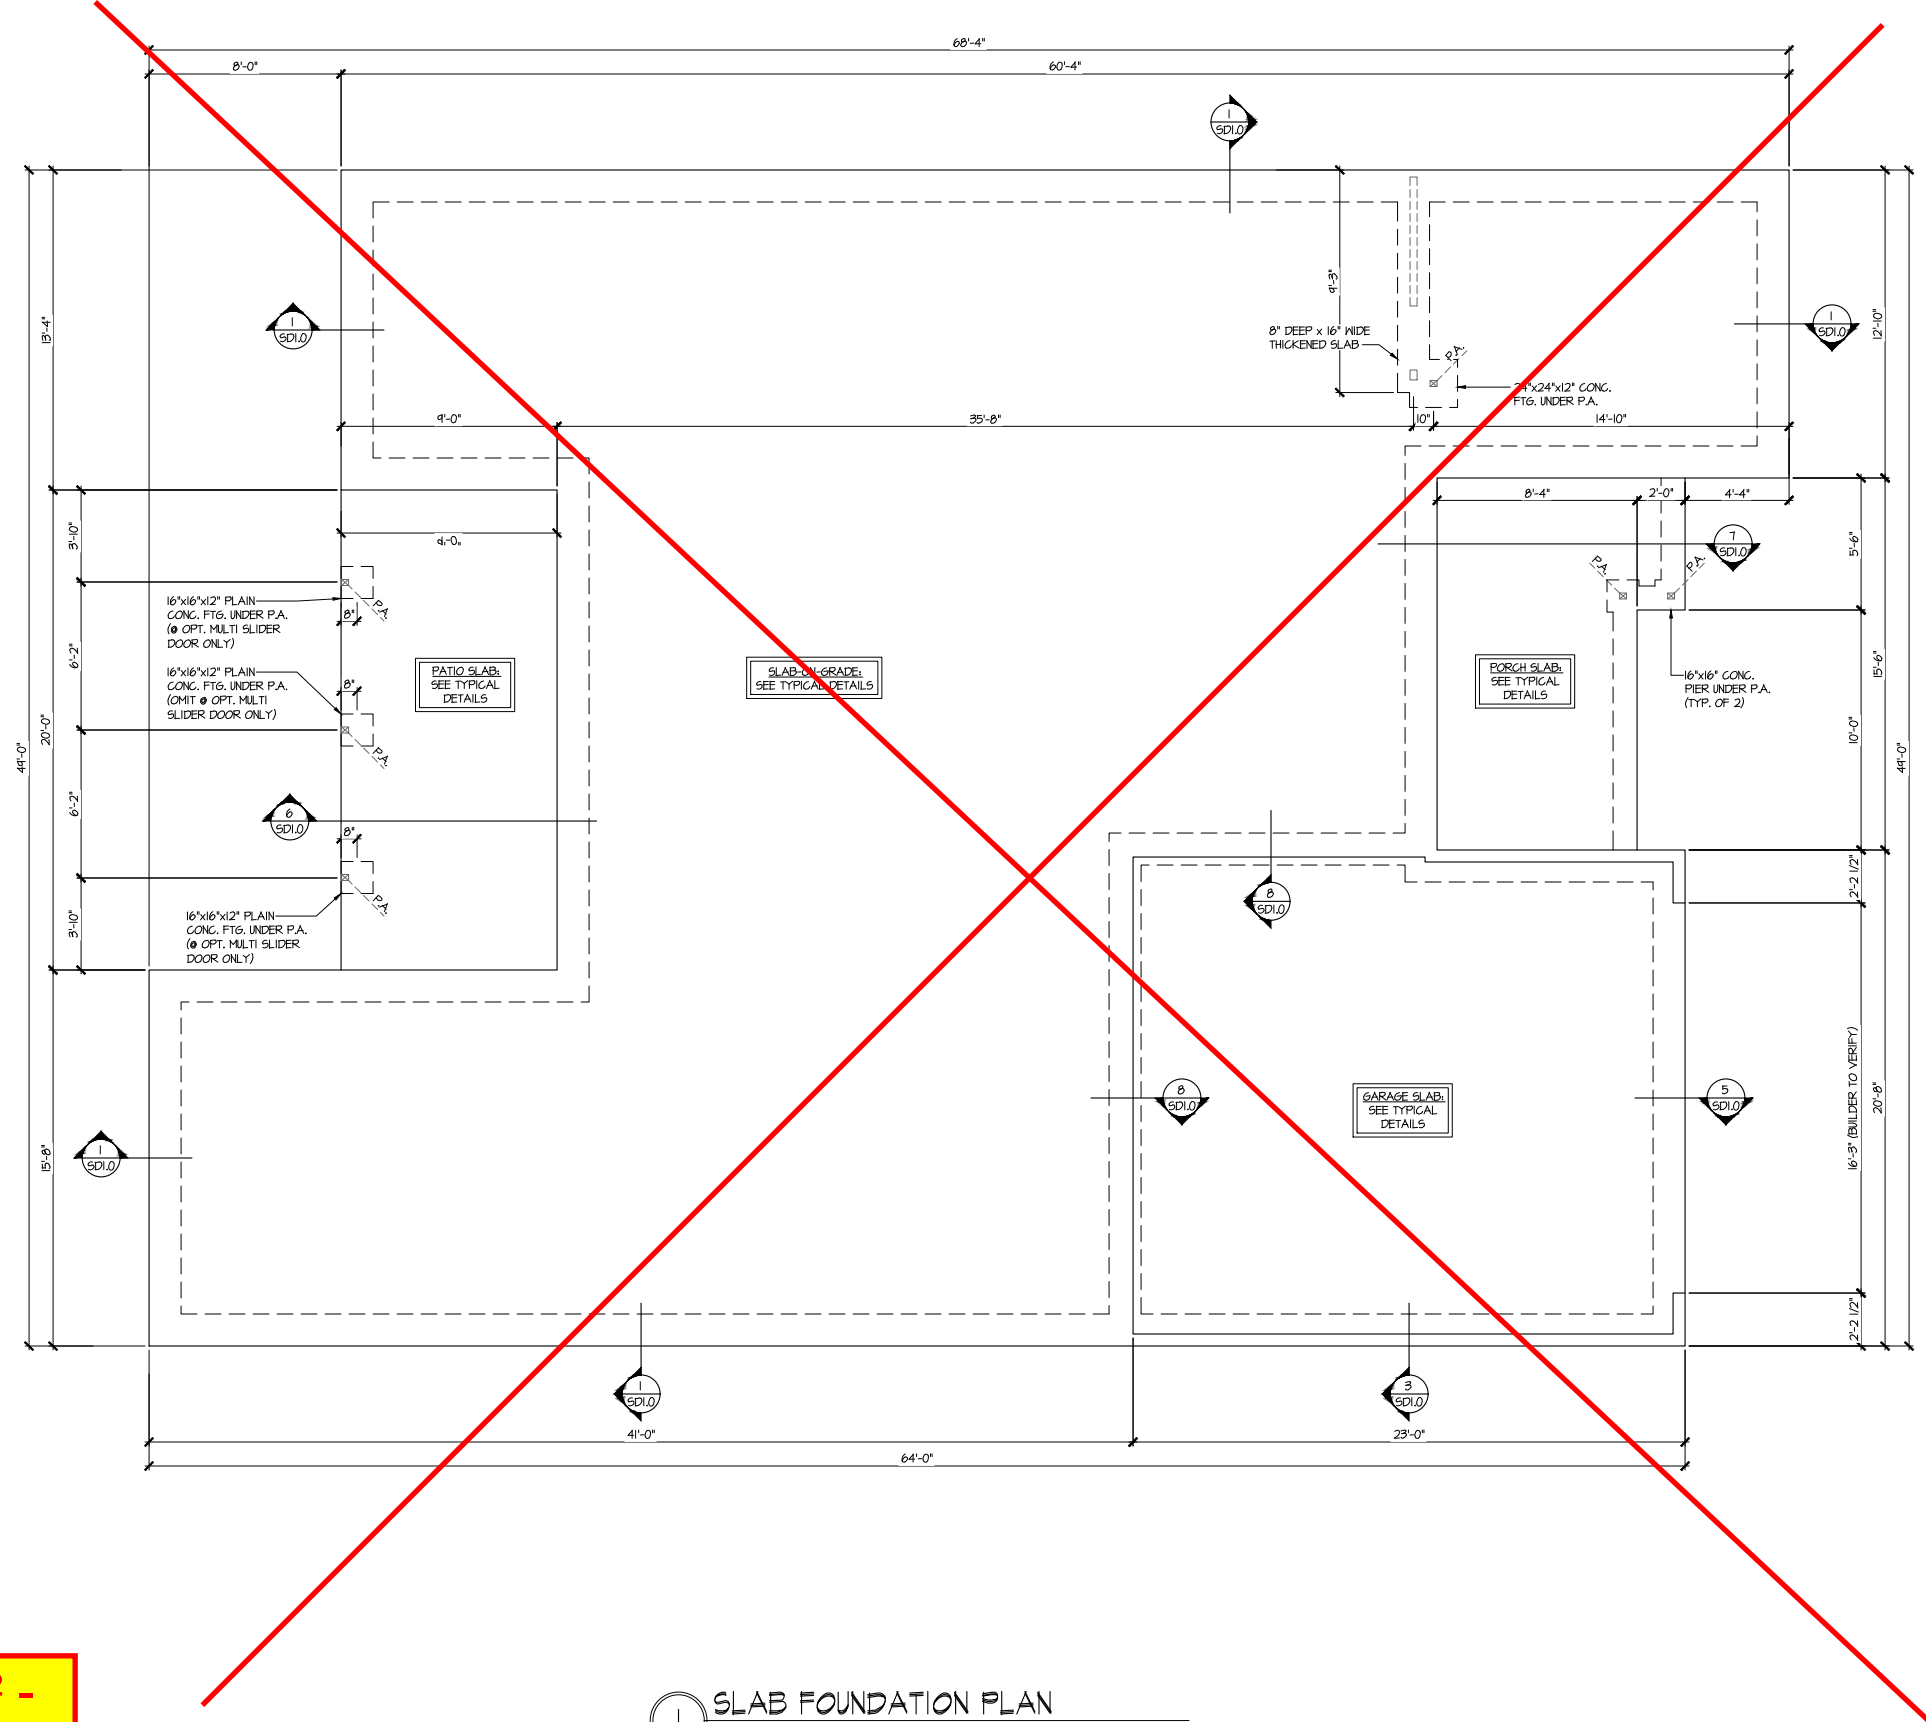

**SLAB FOUNDATION PLAN**  
SCALE: 1/4"=1'-0" (22x24 SHEET)  
1/8"=1'-0" (11x17 SHEET)  
ELEV. A

LEGEND	
• [Symbol]	INTERIOR BEARING WALL
• [Symbol]	BEARING WALL ABOVE (B.W.A.)
• [Symbol]	BEAM / HEADER
• [Symbol]	INDICATES EXTENT OF INT. OSB SHEARWALL AND/OR 3" O.C. EDGE NAILING
• [Symbol]	EXTENT OF VALLEY TRUSS OVERFRAMING @ 24" O.C. (MAX.)
• [Symbol]	EXTENT OF FLOOR SYSTEM TO BE DESIGNED FOR TILE
▶ [Symbol]	INDICATES HOLDDOWN
⊥ [Symbol]	METAL HANGER
* [Symbol]	INDICATES POST ABOVE. PROVIDE SOLID BLOCKING UNDER POST OR JAMB ABOVE.

REFER TO S.O. FOR  
TYPICAL STRUCTURAL NOTES  
& SCHEDULES

OVER 9000 FT<sup>2</sup> -  
NO FIRE RATED  
WALL REQUIRED

LOT 341  
5921-07  
ASPEN CREEK  
ELEVATION C  
REVERSE PLAN  
LEFT-HAND  
GARAGE

seal: 5/19/25  
NORTH CAROLINA  
REGISTERED PROFESSIONAL  
ENGINEER  
SEAL 017622  
STALIN KREIDEL  
© MULHERN + KULP  
Structural Engineering, Inc.

**MULHERN+KULP**  
RESIDENTIAL STRUCTURAL ENGINEERING  
3905 Riverside Parkway, Suite 250 • Alpharetta, GA 30022  
9776-777-4074 • mulhern+kulp.com  
NC License # C-3625


Mulhern+Kulp project number:  
243-24033  
project mgr: SMK  
drawn by: KMV  
issue date: 08-16-2024

REVISIONS:  
date: 11-08-2024 initial: SMK  
updated model name, opt, ext, cov'd, porch  
05-28-2025 JJP  
misc. arch. update


tri pointe  
HOMES

FOUNDATION PLAN  
5921-07 MODEL  
SERENITY  
MASTER SET  
RALEIGH, NC

sheet:  
S1.1

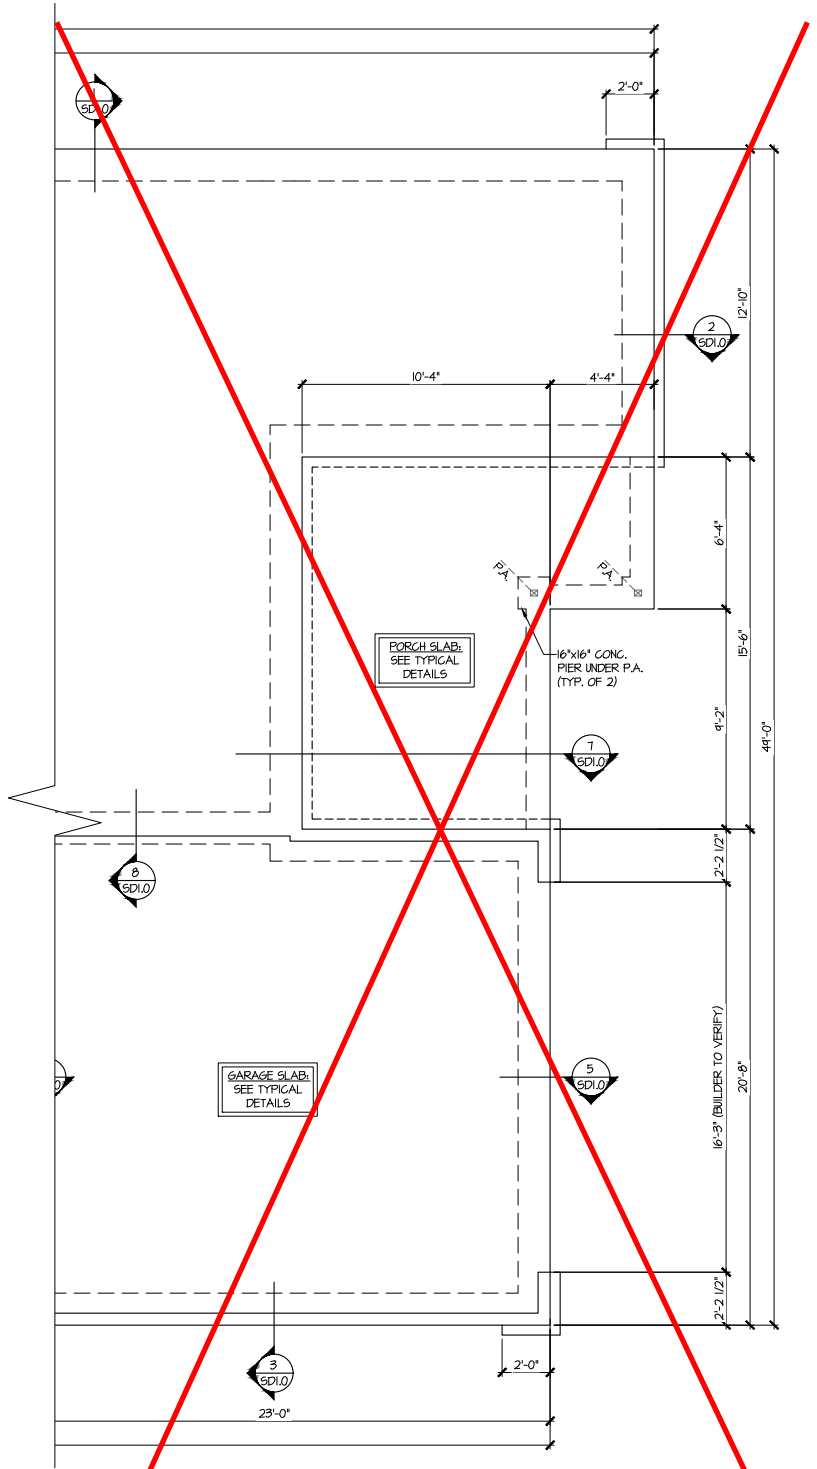

1 PARTIAL SLAB FOUNDATION PLAN  
SCALE: 1/4"=1'-0" (22x24 SHEET)  
1/8"=1'-0" (11x17 SHEET)  
ELEV. B  
SEE ELEV. A FOR MORE INFO

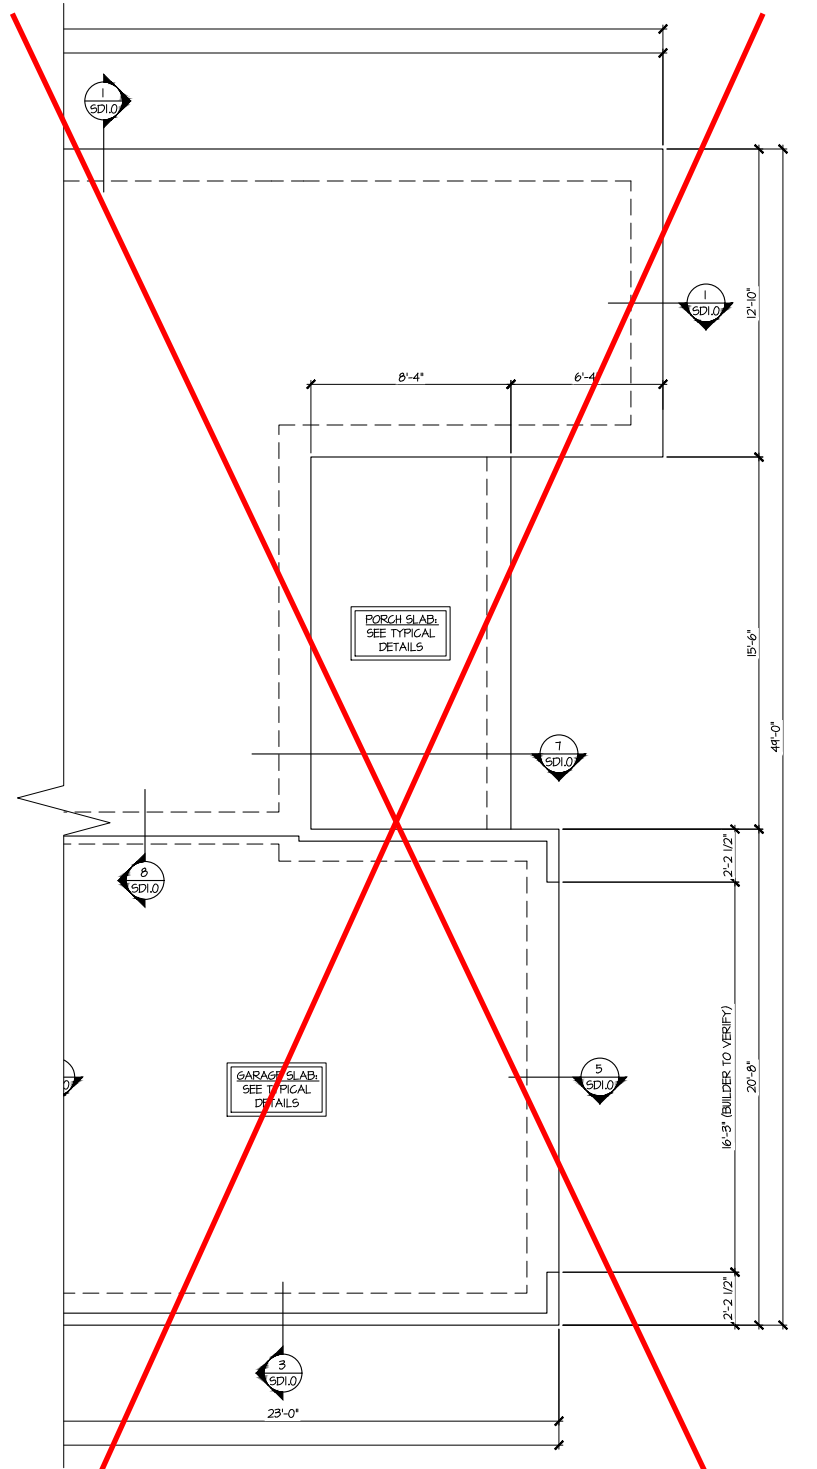

2 PARTIAL SLAB FOUNDATION PLAN  
SCALE: 1/4"=1'-0" (22x24 SHEET)  
1/8"=1'-0" (11x17 SHEET)  
ELEV. C  
SEE ELEV. A FOR MORE INFO


REFER TO S.O. FOR  
TYPICAL STRUCTURAL NOTES  
& SCHEDULES

LEGEND	
•	INTERIOR BEARING WALL
•	BEARING WALL ABOVE (B.W.A.)
•	BEAM / HEADER
•	INDICATES EXTENT OF INT. OSB SHEARWALL AND/OR 3" O.C. EDGE NAILING
•	EXTENT OF VALLEY TRUSS OVERFRAMING @ 24" O.C. (MAX)
•	EXTENT OF FLOOR SYSTEM TO BE DESIGNED FOR TILE
▶	INDICATES HOLDDOWN
⊥	METAL HANGER
*	INDICATES POST ABOVE. PROVIDE SOLID BLOCKING UNDER POST OR JAMB ABOVE.

OVER 9000 FT<sup>2</sup> -  
NO FIRE RATED  
WALL REQUIRED



LOT 341  
5921-07  
ASPEN CREEK  
ELEVATION C  
REVERSE PLAN  
LEFT-HAND  
GARAGE

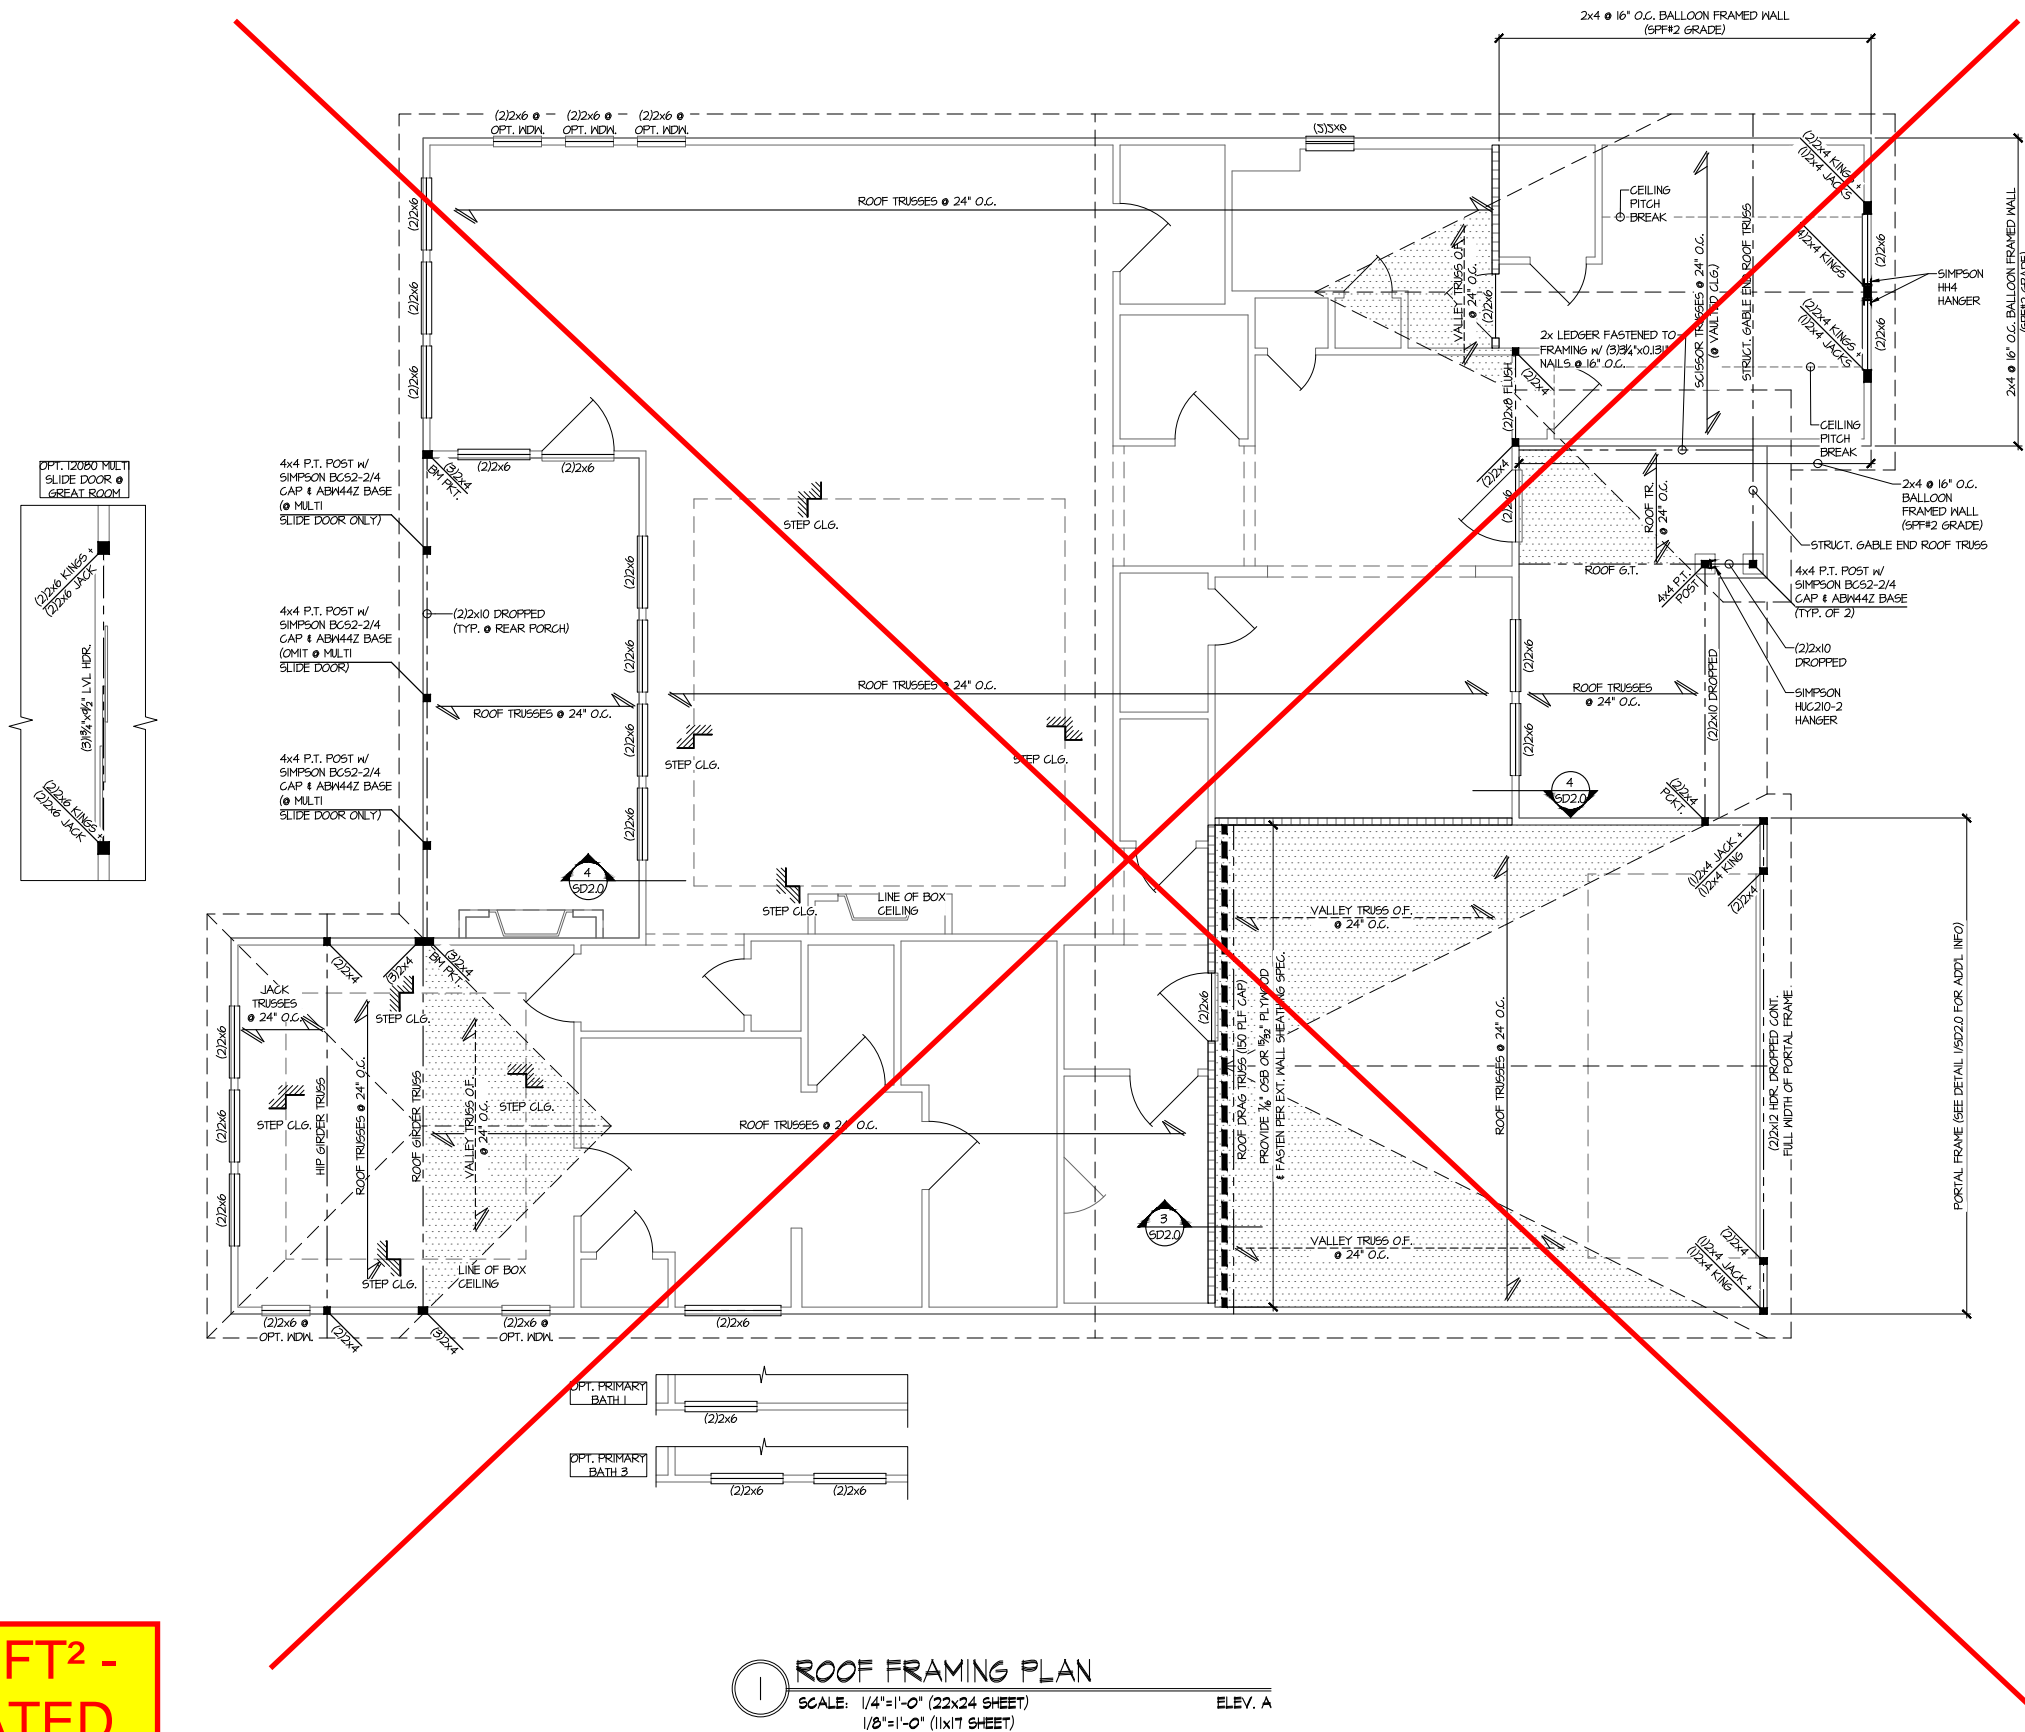

OVER 9000 FT<sup>2</sup> -  
NO FIRE RATED  
WALL REQUIRED

1 ROOF FRAMING PLAN  
SCALE: 1/4"=1'-0" (22x24 SHEET)  
1/8"=1'-0" (11x17 SHEET)  
ELEV. A

THIS LEVEL HAS BEEN DESIGNED FOR 9'-1" PLATE HEIGHT

LEGEND

- INTERIOR BEARING WALL
- BEARING WALL ABOVE (B.W.A.)
- BEAM / HEADER
- INDICATES EXTENT OF INT. OSB SHEARWALL AND/OR 3" O.C. EDGE NAILING
- EXTENT OF VALLEY TRUSS OVERFRAMING 24" O.C. (MAX.)
- EXTENT OF FLOOR SYSTEM TO BE DESIGNED FOR TILE
- INDICATES HOLDDOWN
- METAL HANGER
- INDICATES POST ABOVE. PROVIDE SOLID BLOCKING UNDER POST OR JAMB ABOVE.

REFER TO S.O. FOR  
TYPICAL STRUCTURAL NOTES  
& SCHEDULES

seal: 5/19/25  
NORTH CAROLINA  
REGISTERED PROFESSIONAL  
SEAL  
017622  
ENGINEER  
STALIN KREIDEL  
© COPYRIGHT: MULHERN + KULP  
Structural Engineering, Inc.

**MULHERN+KULP**  
RESIDENTIAL STRUCTURAL ENGINEERING  
3605 Bonaventure Parkway, Suite 250 • Alpharetta, GA 30022  
970-777-4074 • mulhernkulp.com  
NC License # C-3625

Mulhern+Kulp project number:  
243-24033

project mgr: SMK  
drawn by: KMV  
issue date: 08-16-2024

REVISIONS:  
date: 11-08-2024 initial: SMK  
description: UPDATED MODEL NAME, OPT. EXT. CONV. PORCH  
date: 05-28-2025 initial: JJP  
description: MSG. ARCH. UPDATE



**tri pointe**  
HOMES

ROOF FRAMING PLAN  
5921-07 MODEL  
SERENITY  
MASTER SET  
RALEIGH, NC

sheet:  
**S2.0**




**OVER 9000 FT<sup>2</sup> -  
NO FIRE RATED  
WALL REQUIRED**

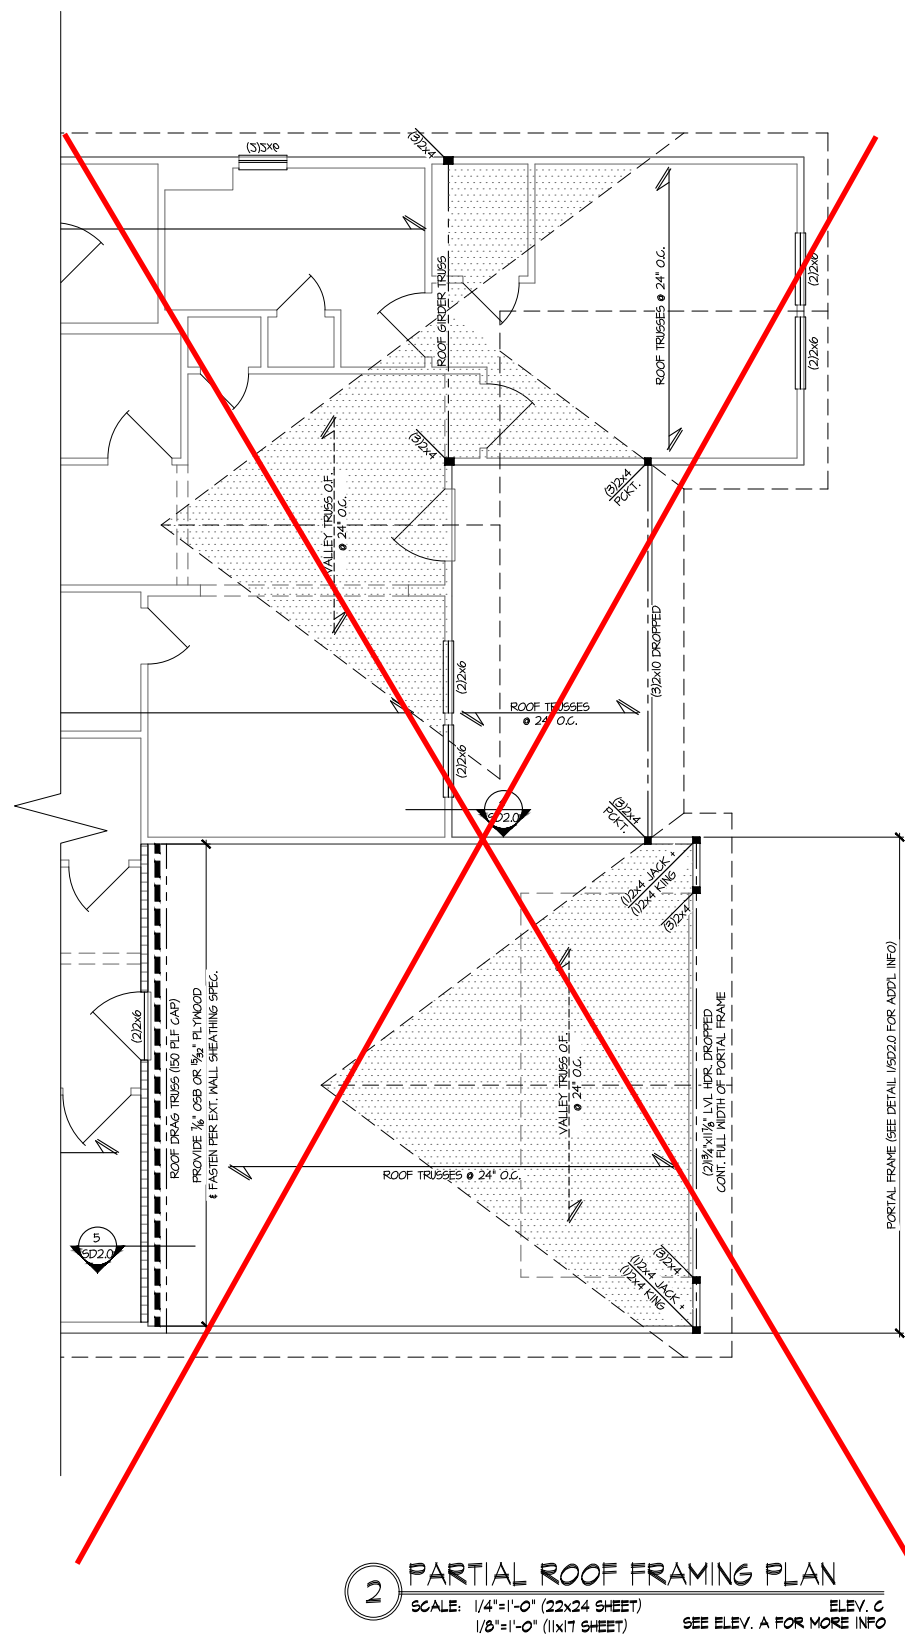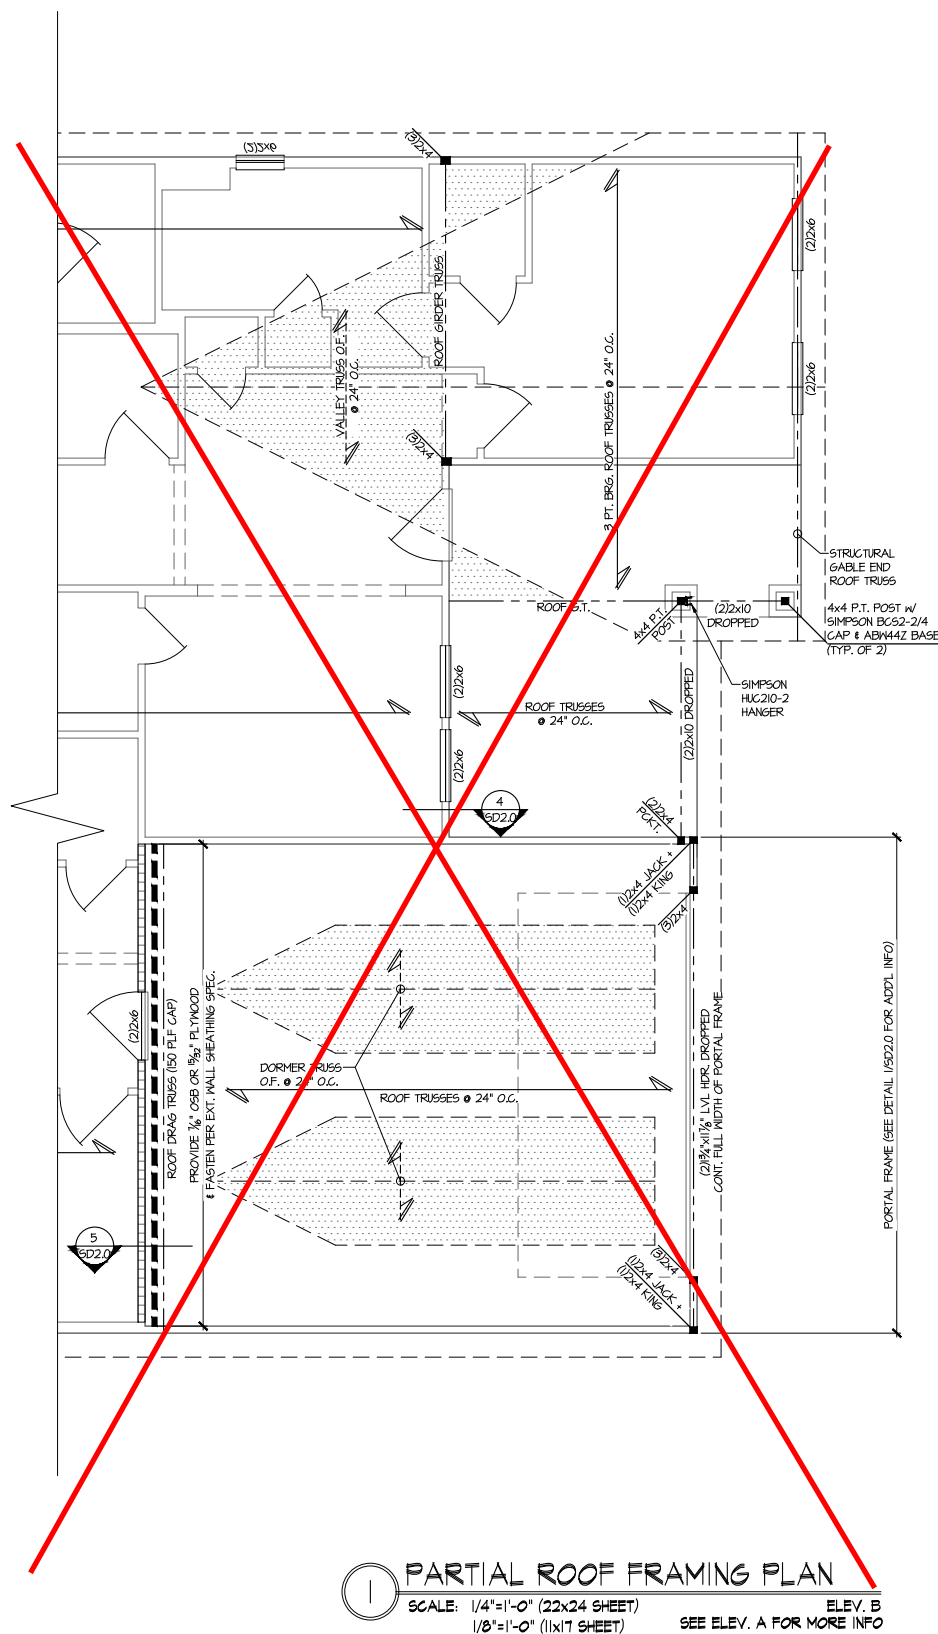

THIS LEVEL HAS BEEN DESIGNED  
FOR 9'-1" PLATE HEIGHT

REFER TO 50.0 FOR  
TYPICAL STRUCTURAL NOTES  
& SCHEDULES

**LOT 341**  
**5921-07**  
**ASPEN CREEK**  
**ELEVATION C**  
**REVERSE PLAN**  
**LEFT-HAND**  
**GARAGE**

seal:  5/19/25

**MULHERN+KULP**  
RESIDENTIAL STRUCTURAL ENGINEERING

3065 Buckleada Parkway, Suite 250 • Alpharetta, GA 30022  
p 770-777-0074 • [info@mulhernkulp.com](mailto:info@mulhernkulp.com)

NC License # C-3025



Mulhern+Kulp project number:  
243-24033

project mgr:	SMK
drawn by:	KMV
issue date:	08-16-2024

REVISIONS:	
date:	initial:
11-08-2024	SMM
UPDATED MODEL NAME, OPT. EXT. COVD, PORCH	
05-28-2025	JPP
MISC. ARCH. UPDATE	

tri pointe  
HOMES

ROOF FRAMING PLAN  
5921-07 MODEL  
SERENITY  
MASTER SET  
RALEIGH, NC


sheet:

## S2.1

SEE OPT.  
OUTDOOR  
LIVING PATIO 2  
SLAB  
FOUNDATION  
PARTIAL ON  
SHEET S4.1

SEE OPT.  
EXTENDED  
COVERED  
PORCH SLAB  
FOUNDATION  
PARTIAL ON  
SHEET S4.0

OVER 9000 FT<sup>2</sup> -  
NO FIRE RATED  
WALL REQUIRED

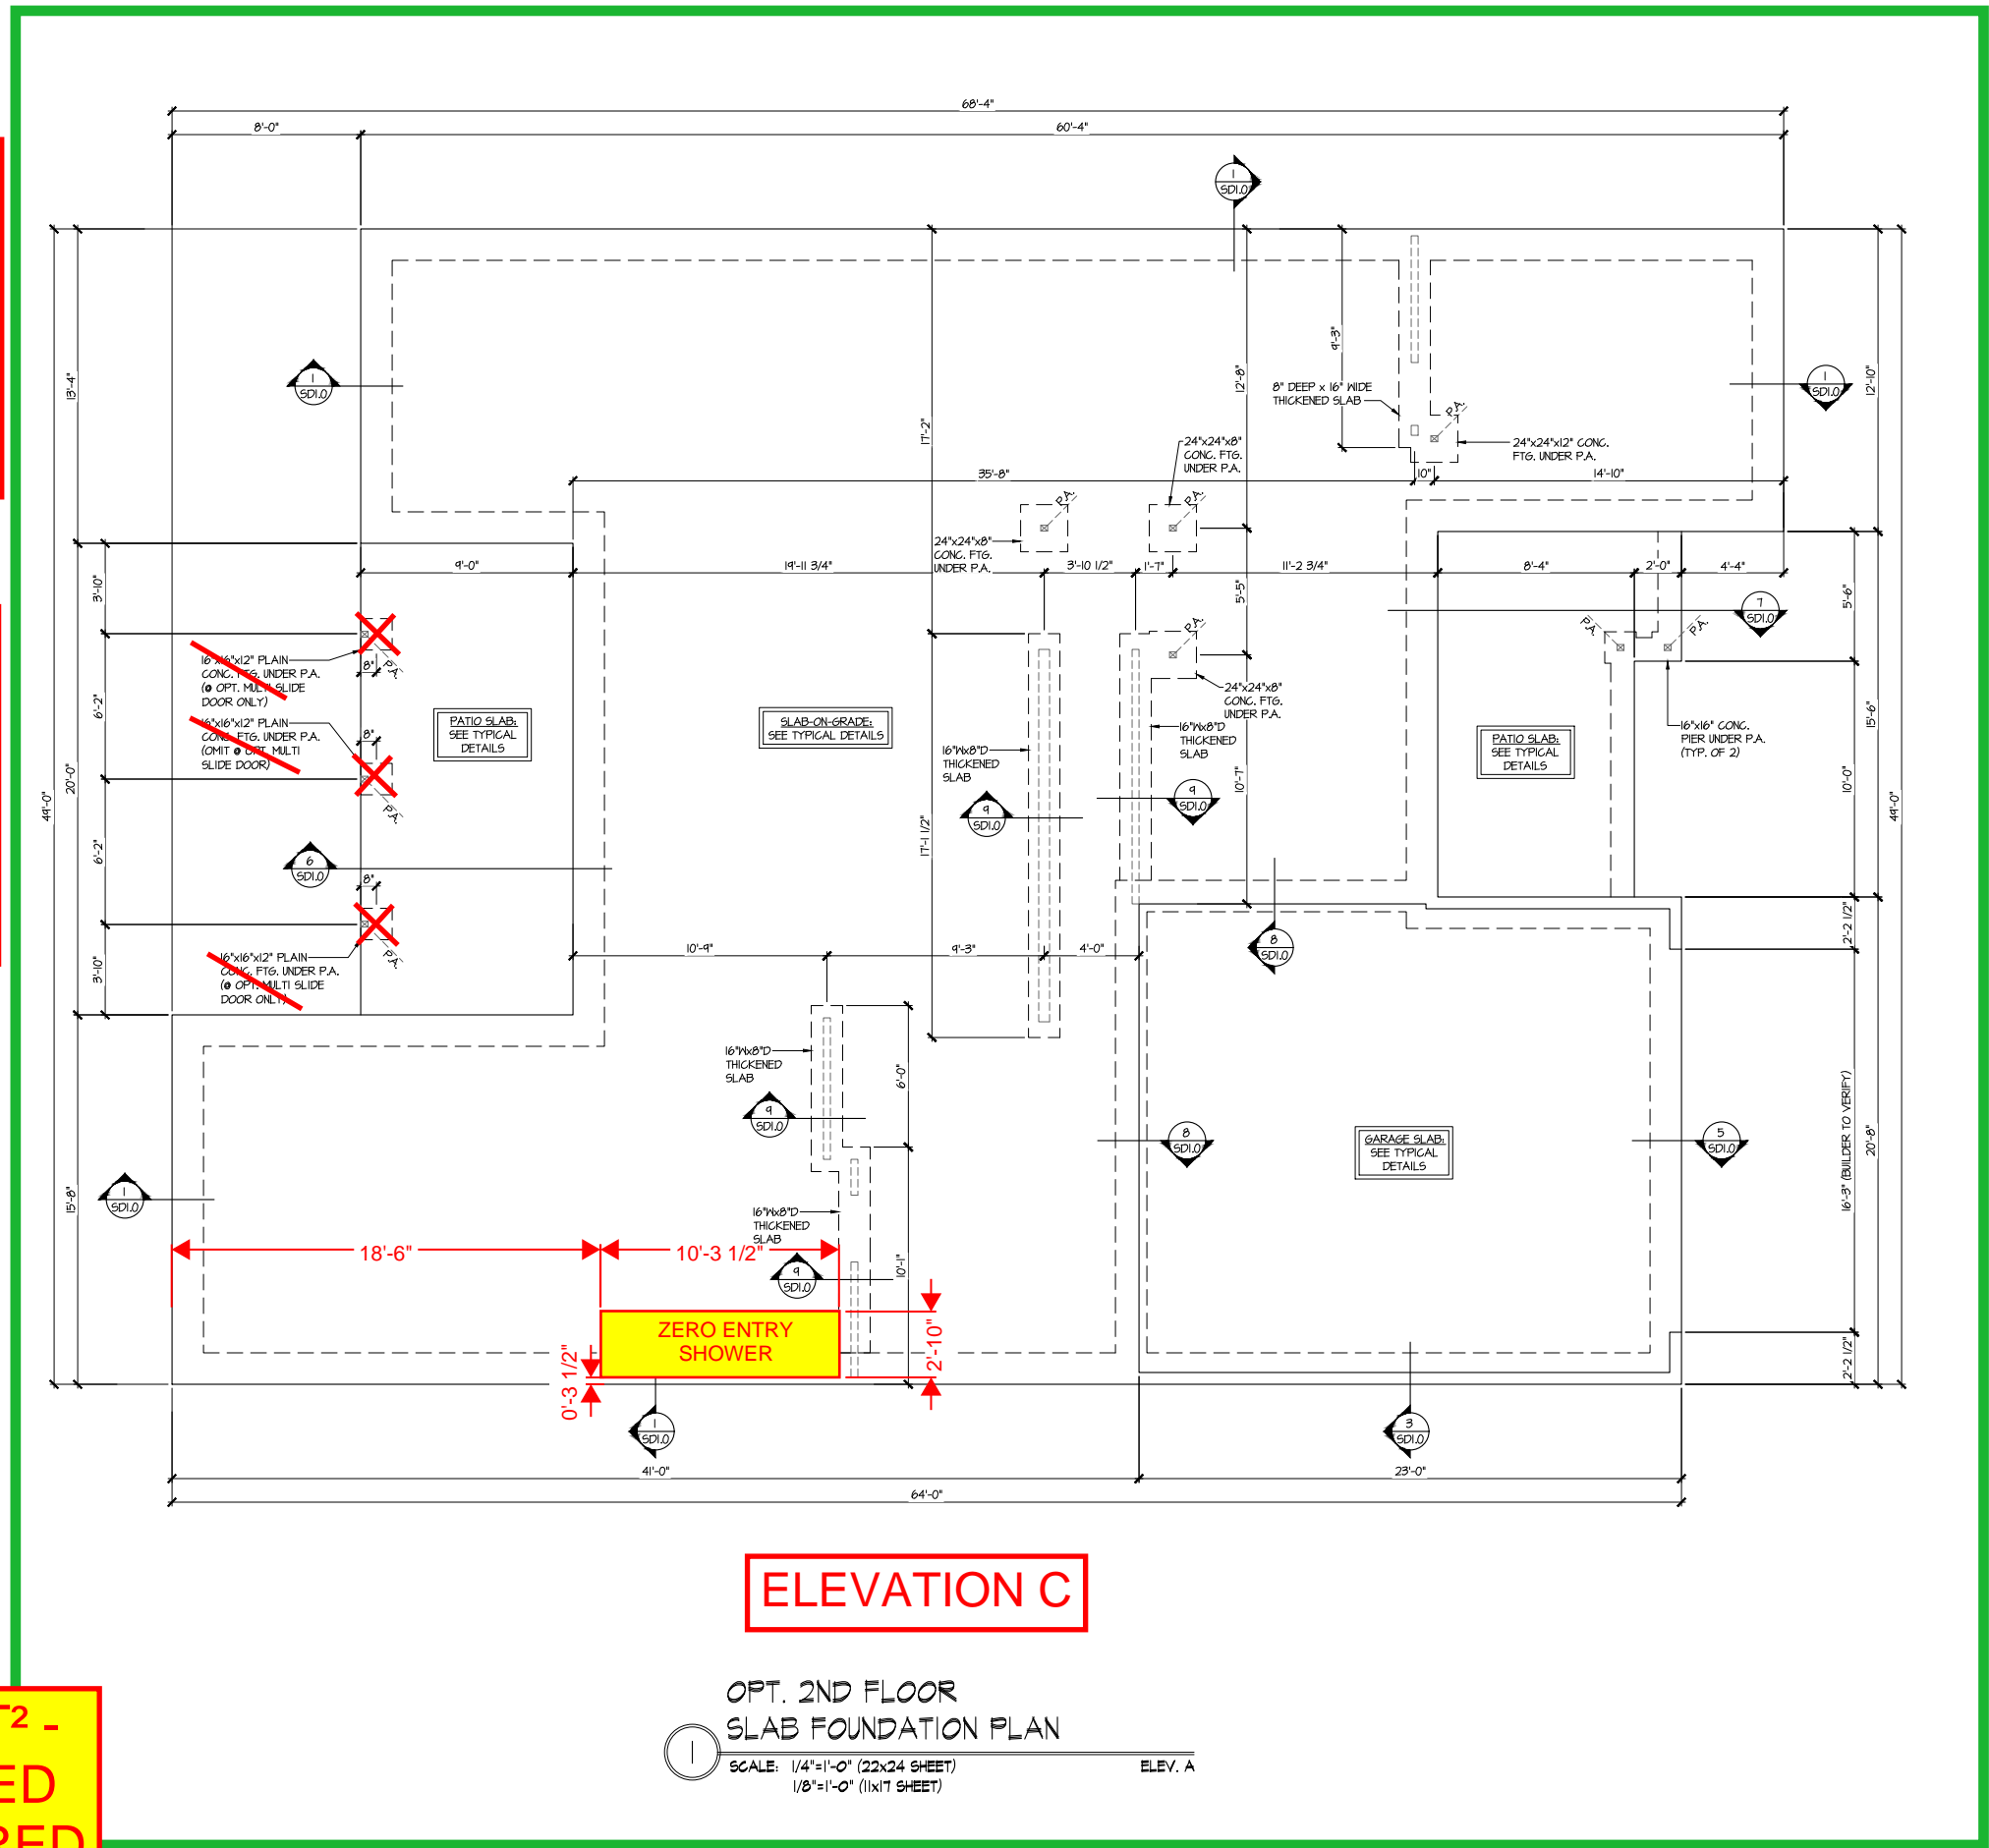

**LOT 341**  
**5921-07**  
**ASPEN CREEK**  
**ELEVATION C**  
**REVERSE PLAN**  
**LEFT-HAND**  
**GARAGE**

SEE ELEVATION C  
FOUNDATION  
PLAN PARTIAL ON  
SHEET S3.1

**LEGEND**

- INTERIOR BEARING WALL
- BEARING WALL ABOVE (B.W.A.)
- BEAM / HEADER
- INDICATES EXTENT OF INT. OSB SHEARWALL AND/OR 3" O.C. EDGE NAILING
- EXTENT OF VALLEY TRUSS OVERFRAMING @ 24" O.C. (MAX.)
- EXTENT OF FLOOR SYSTEM TO BE DESIGNED FOR TILE
- INDICATES HOLDDOWN
- METAL HANGER
- INDICATES POST ABOVE. PROVIDE SOLID BLOCKING UNDER POST OR JAMB ABOVE.

REFER TO S.O. FOR  
TYPICAL STRUCTURAL NOTES  
& SCHEDULES

seal: 5/19/25

MULHERN+KULP  
RESIDENTIAL STRUCTURAL ENGINEERING

3805 Bonaventure Parkway, Suite 250 - Alpharetta, GA 30022  
978-777-4074 • mulhern+kulp.com  
NC License # C-3625

Mulhern+Kulp project number:  
243-24033

project mgr: SMK  
drawn by: KMV  
issue date: 08-16-2024

REVISIONS:

date:	initial:
11-08-2024	SMK
UPDATED MODEL NAME, OPT. EXT. COVD. PORCH	
05-28-2025	JJPP
MSG. ARCH. UPDATE	

tri pointe  
HOMES

STRUCTURAL OPTIONS

5921-07 MODEL

SERENITY  
MASTER SET

RALEIGH, NC

sheet:

**S3.0**

LOT 341  
5921-07  
ASPEN CREEK  
ELEVATION C  
REVERSE PLAN  
LEFT-HAND  
GARAGE

seal: 5/19/25

**MULHERN+KULP**  
RESIDENTIAL STRUCTURAL ENGINEERING  
3905 Riverside Parkway, Suite 250 • Alpharetta, GA 30022  
970-777-4074 • mulhern+kulp.com  
NC License # C-3625


Mulhern+Kulp project number:  
**243-24033**

project mgr: **SMK**  
drawn by: **KMV**  
issue date: **08-16-2024**


REVISIONS:  
date: 11-08-2024 initial: SMK  
updated model name, opt, ext, covd, porch: SMM  
05-28-2025 JJP  
MSG, ARCH, UPDATE

STRUCTURAL OPTIONS  
5921-07 MODEL  
SERENITY  
MASTER SET  
RALEIGH, NC

sheet:  
**S3.1**

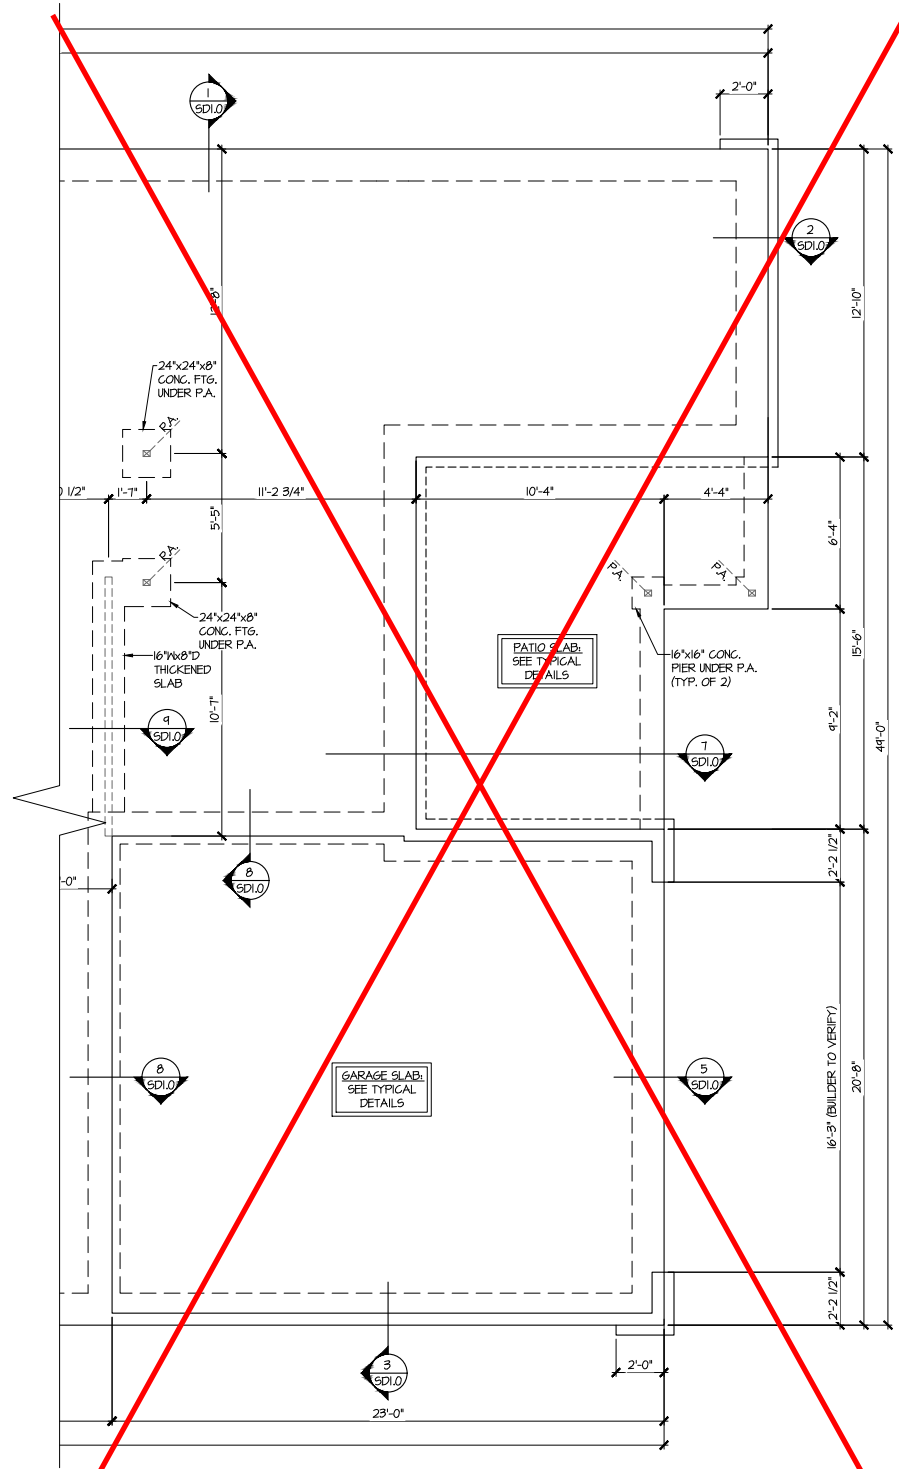

1 OPT. 2ND FLOOR  
PARTIAL SLAB FOUNDATION PLAN  
SCALE: 1/4"=1'-0" (22x24 SHEET)  
1/8"=1'-0" (11x17 SHEET)  
ELEV. B  
SEE ELEV. A FOR MORE INFO

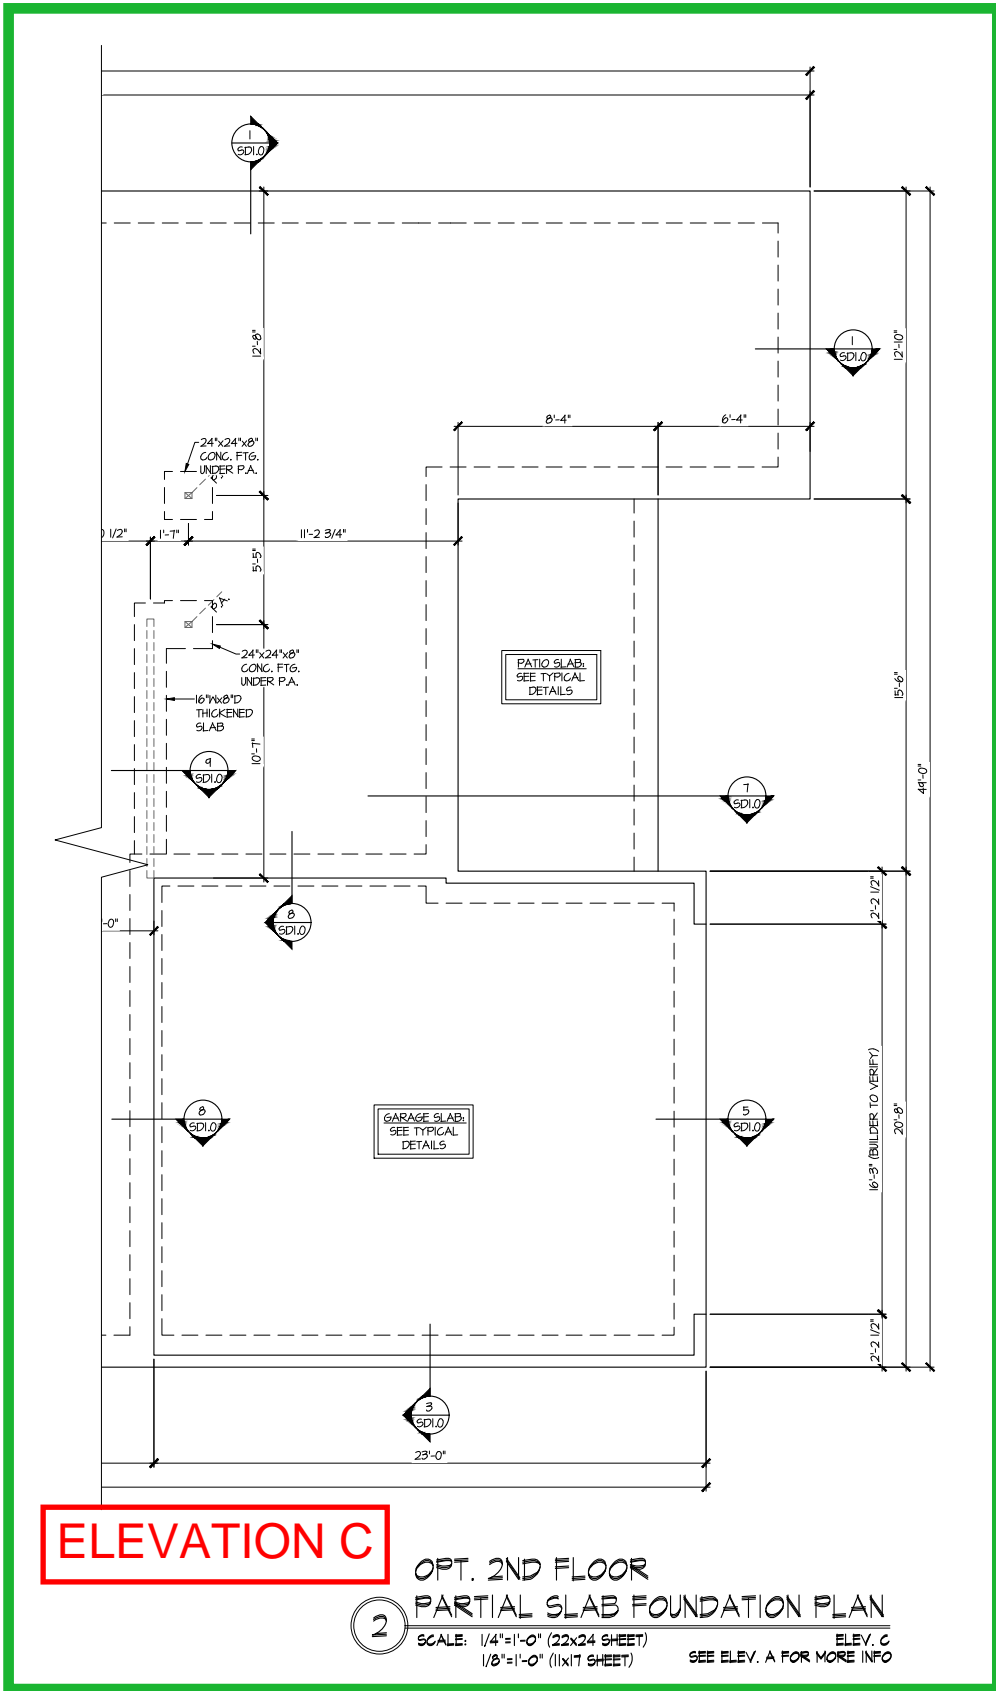

2 ELEVATION C  
OPT. 2ND FLOOR  
PARTIAL SLAB FOUNDATION PLAN  
SCALE: 1/4"=1'-0" (22x24 SHEET)  
1/8"=1'-0" (11x17 SHEET)  
ELEV. C  
SEE ELEV. A FOR MORE INFO

LEGEND	
	INTERIOR BEARING WALL
	BEARING WALL ABOVE (B.W.A.)
	BEAM / HEADER
	INDICATES EXTENT OF INT. OSB SHEARWALL AND/OR 3" O.C. EDGE NAILING
	EXTENT OF VALLEY TRUSS OVERFRAMING @ 24" O.C. (MAX.)
	EXTENT OF FLOOR SYSTEM TO BE DESIGNED FOR TILE
	INDICATES HOLDDOWN
	METAL HANGER
	INDICATES POST ABOVE. PROVIDE SOLID BLOCKING UNDER POST OR JAMB ABOVE.

REFER TO S.O. FOR  
TYPICAL STRUCTURAL NOTES  
& SCHEDULES


OVER 9000 FT<sup>2</sup> -  
NO FIRE RATED  
WALL REQUIRED

[illegible]

~~4x1 P.T. POST w/  
SIMPSON EC52-2/4  
CAP & 1/2" W44Z BASE  
(@ MULTI  
SLIDE DOOR ONLY)~~

~~4x4 MT. POST W/  
SIMPSON B52-2/4  
CAP & ADV 4Z BASE  
(OMIT 6 MULTI  
SLIDE DOOR)~~

~~4x4 RT. POST W/  
SIMPSON BBS2-2/4  
CAP & BBS 44Z BASE  
(● MULTI  
SLIDE DOOR ONLY)~~



5x5x24 Q.C.

5x5x24 Q.C.

5x5x24 Q.C.

~~Opt. KWL~~ ~~1~~ ~~2~~ ~~3~~

---

The diagram illustrates the removal of an existing primary bath (labeled 'OPT. PRIMARY BATH 1') and the addition of a new primary bath (labeled 'OPT. PRIMARY BATH 3'). The new bath is shown with two separate (2'2"x6') sections. The entire diagram is enclosed in a green border.

### ELEVATION C

OPT. 2ND FLOOR  
LOW ROOF FRAMING PLAN







SCALE: 1/4"=1'-0" (22x24 SHEET)  
1/8"=1'-0" (11x17 SHEET)

ELEV. A

SEE ELEVATION C  
ROOF PLAN  
PARTIAL ON  
SHEET S3.3

THIS LEVEL HAS BEEN DESIGNED  
FOR 9'-1" PLATE HEIGHT

## LEGEND

-  INTERIOR BEARING WALL
-  BEARING WALL ABOVE (B/W.A.)
-  BEAM / HEADER
-  INDICATES EXTENT OF INT. OSB SHEARWALL AND/OR 3" O.C. EDGE NAILING
-  EXTENT OF VALLEY TRUSS OVERFRAMING @ 24" O.C. (MAX.)
-  EXTENT OF FLOOR SYSTEM TO BE DESIGNED FOR TILE
- ▶ INDICATES HOLDDOWN
- ⌋ METAL HANGER
- \* INDICATES POST ABOVE. PROVIDE SOLID BLOCKING UNDER POST OR JAMB ABOVE.

REFER TO SO.0 FOR  
TYPICAL STRUCTURAL NOTES  
& SCHEDULES

**OVER 9000 FT<sup>2</sup> -  
NO FIRE RATED  
WALL REQUIRED**

seal: 5/19/25	
	
<b>MULHERN+KULP</b> RESIDENTIAL STRUCTURAL ENGINEERING 3855 Riverside Parkway, Suite 250 - Alpharetta, GA 30022 P 770-777-4807 > mulhern+kulp.com NC License # C-3825	
	
Mulhern+Kulp project number: 243-24033	
project mgr:	SMK
drawn by:	KMV
issue date:	08-16-2024
REVISIONS:	
date:	initial:
11-08-2024	SMM
UPDATED MODEL NAME, OPT, EXT, GOVD, PORCH	
05-28-2025	JIPP
MISC, ARCH, UPDATE	
	
STRUCTURAL OPTIONS	
5921-07 MODEL	
SERENITY MASTER SET RALEIGH, NC	
sheet: S3.2	

LOT 341  
5921-07  
ASPEN CREEK  
ELEVATION C  
REVERSE PLAN  
LEFT-HAND  
GARAGE

seal

5/19/25



MULHERN+KULP

RESIDENTIAL STRUCTURAL ENGINEERING



3955 Riverside Parkway, Suite 250 • Alpharetta, GA 30022  
970-777-4074 • mulhern+kulp.com  
NC License # C-3625

Mulhern+Kulp project number:

243-24033

project mgr:

SMK

drawn by:

KMV

issue date:

08-16-2024

REVISIONS:

date:	initial:
11-08-2024	SMK
UPDATED MODEL NAME, OPT. EXT. CONV. PORCH	
05-28-2025	JJPP
MSG. ARCH. UPDATE	

STRUCTURAL OPTIONS



5921-07 MODEL

SERENITY MASTER SET

RALEIGH, NC

sheet:

S3.3

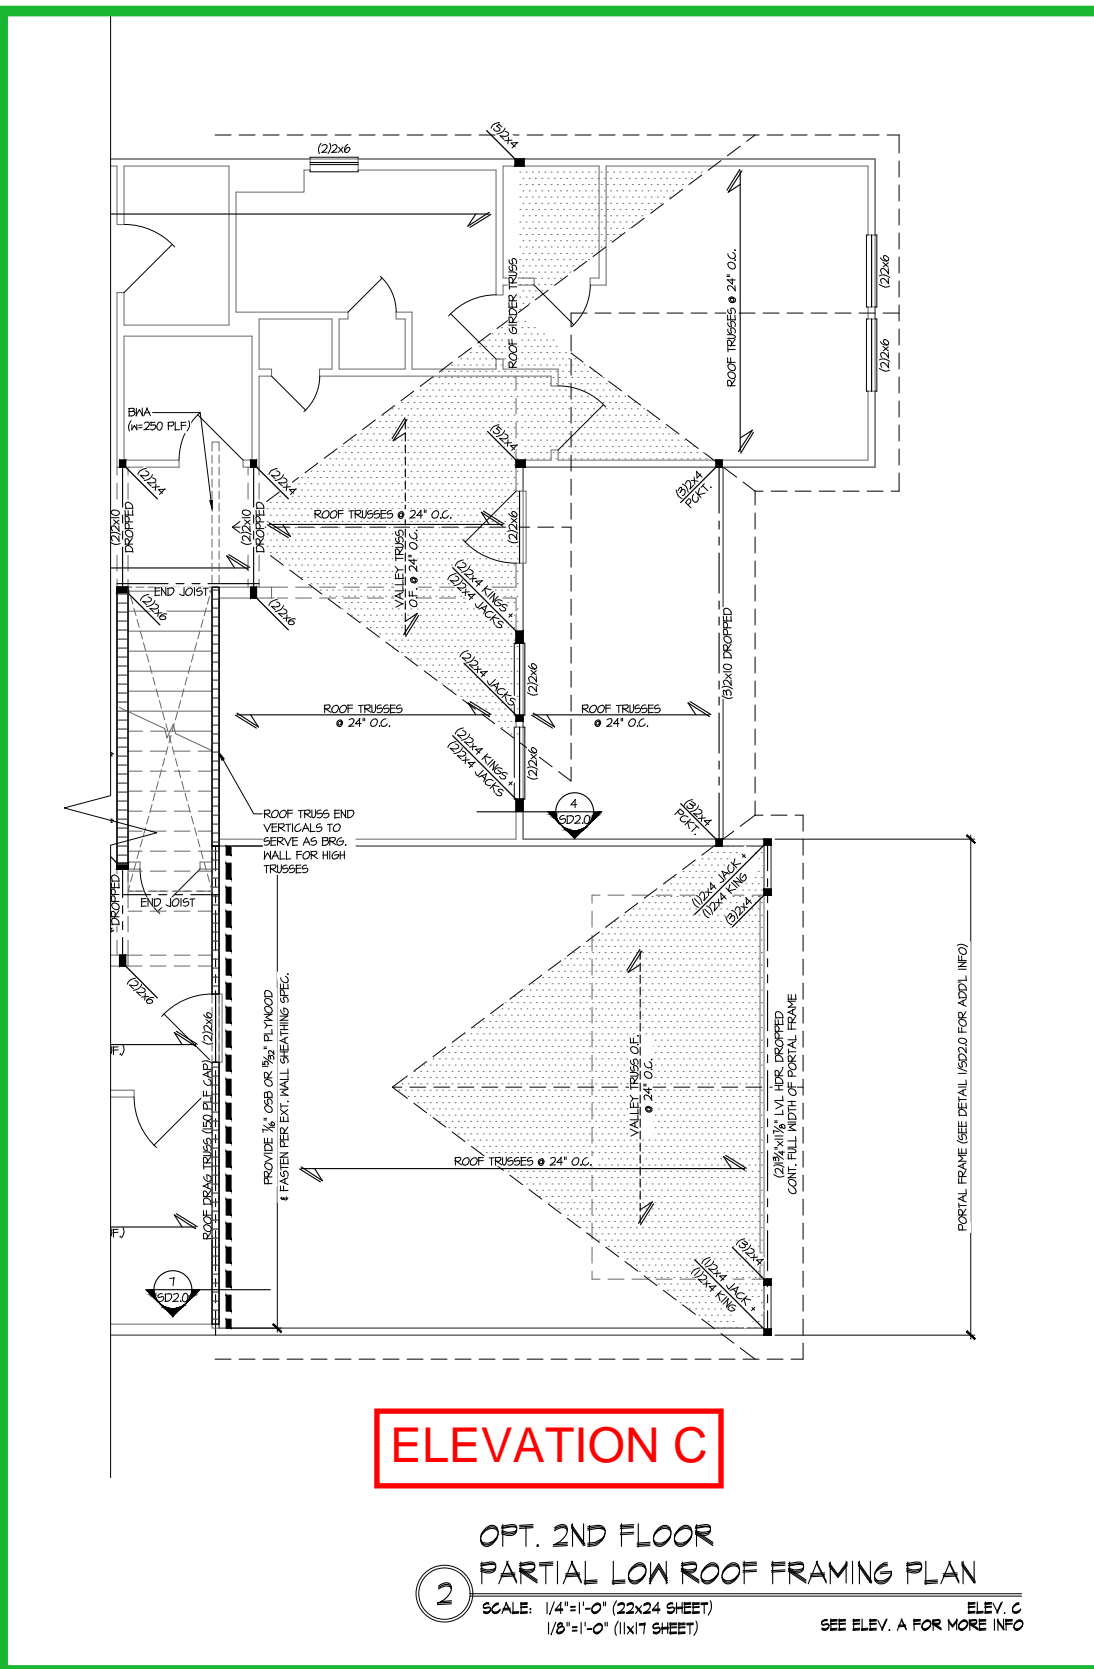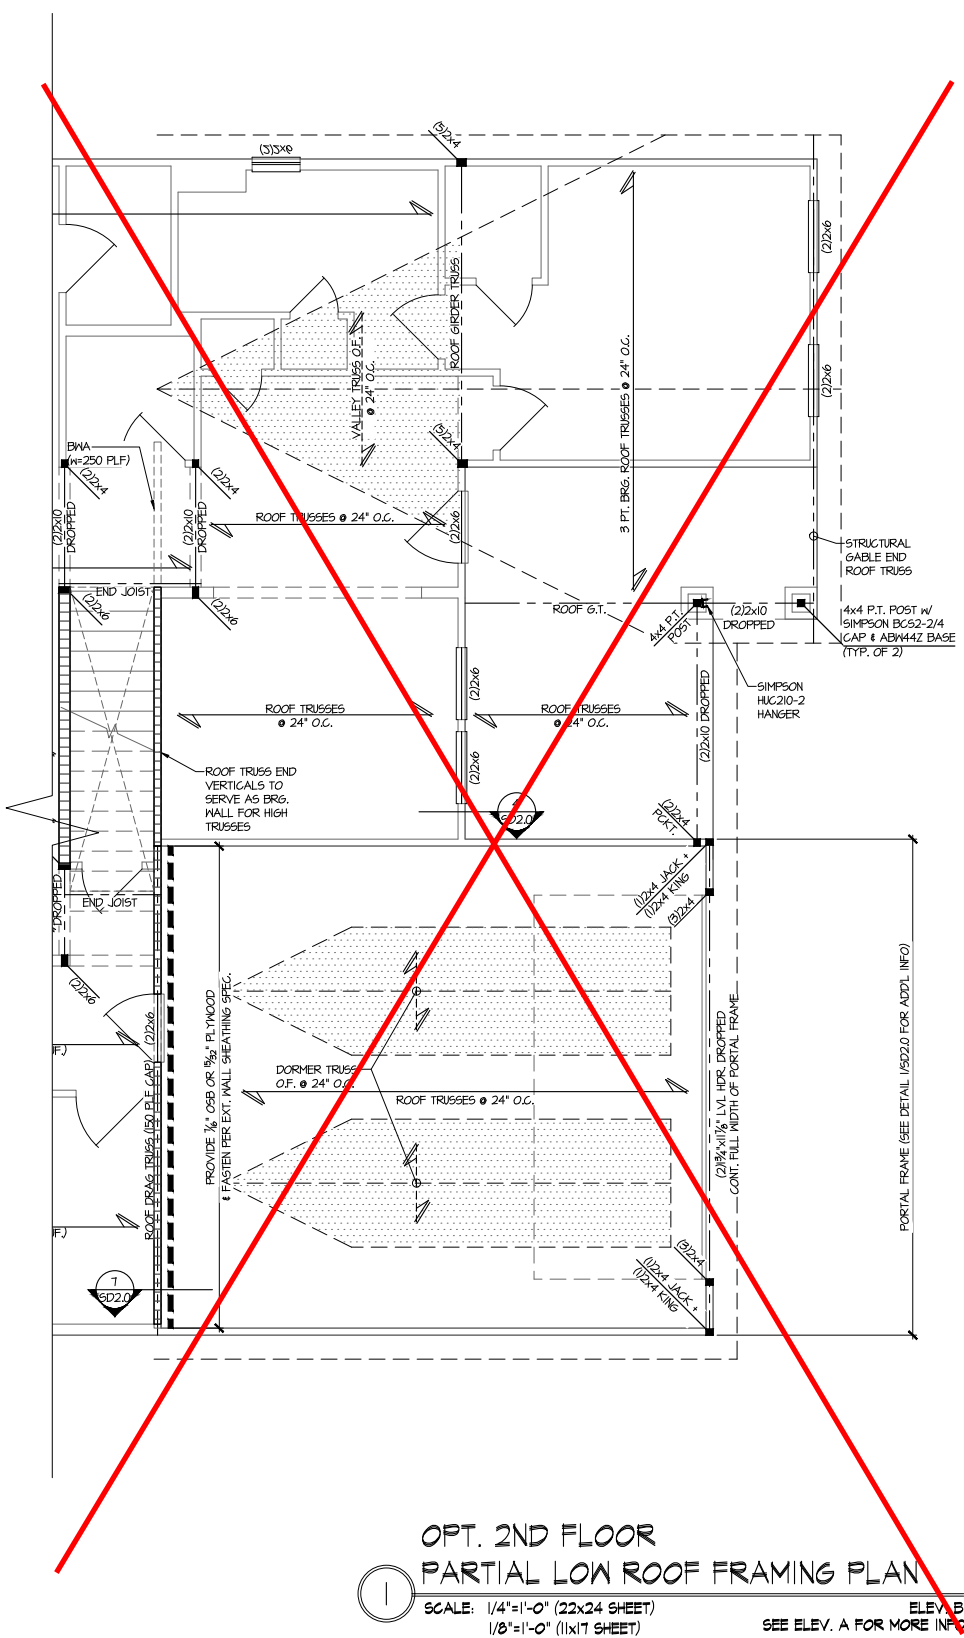

ELEVATION C

LEGEND	
	INTERIOR BEARING WALL
	BEARING WALL ABOVE (BWA)
	BEAM / HEADER
	INDICATES EXTENT OF INT. OSB SHEARWALL AND/OR 3" O.C. EDGE NAILING
	EXTENT OF VALLEY TRUSS OVERFRAMING @ 24" O.C. (MAX)
	EXTENT OF FLOOR SYSTEM TO BE DESIGNED FOR TILE
	INDICATES HOLDDOWN
	METAL HANGER
	INDICATES POST ABOVE. PROVIDE SOLID BLOCKING UNDER POST OR JAMB ABOVE.


THIS LEVEL HAS BEEN DESIGNED FOR 9'-1" PLATE HEIGHT

REFER TO SO.O FOR TYPICAL STRUCTURAL NOTES & SCHEDULES

OVER 9000 FT<sup>2</sup> - NO FIRE RATED WALL REQUIRED



LOT 341  
5921-07  
ASPEN CREEK  
ELEVATION C  
REVERSE PLAN  
LEFT-HAND  
GARAGE

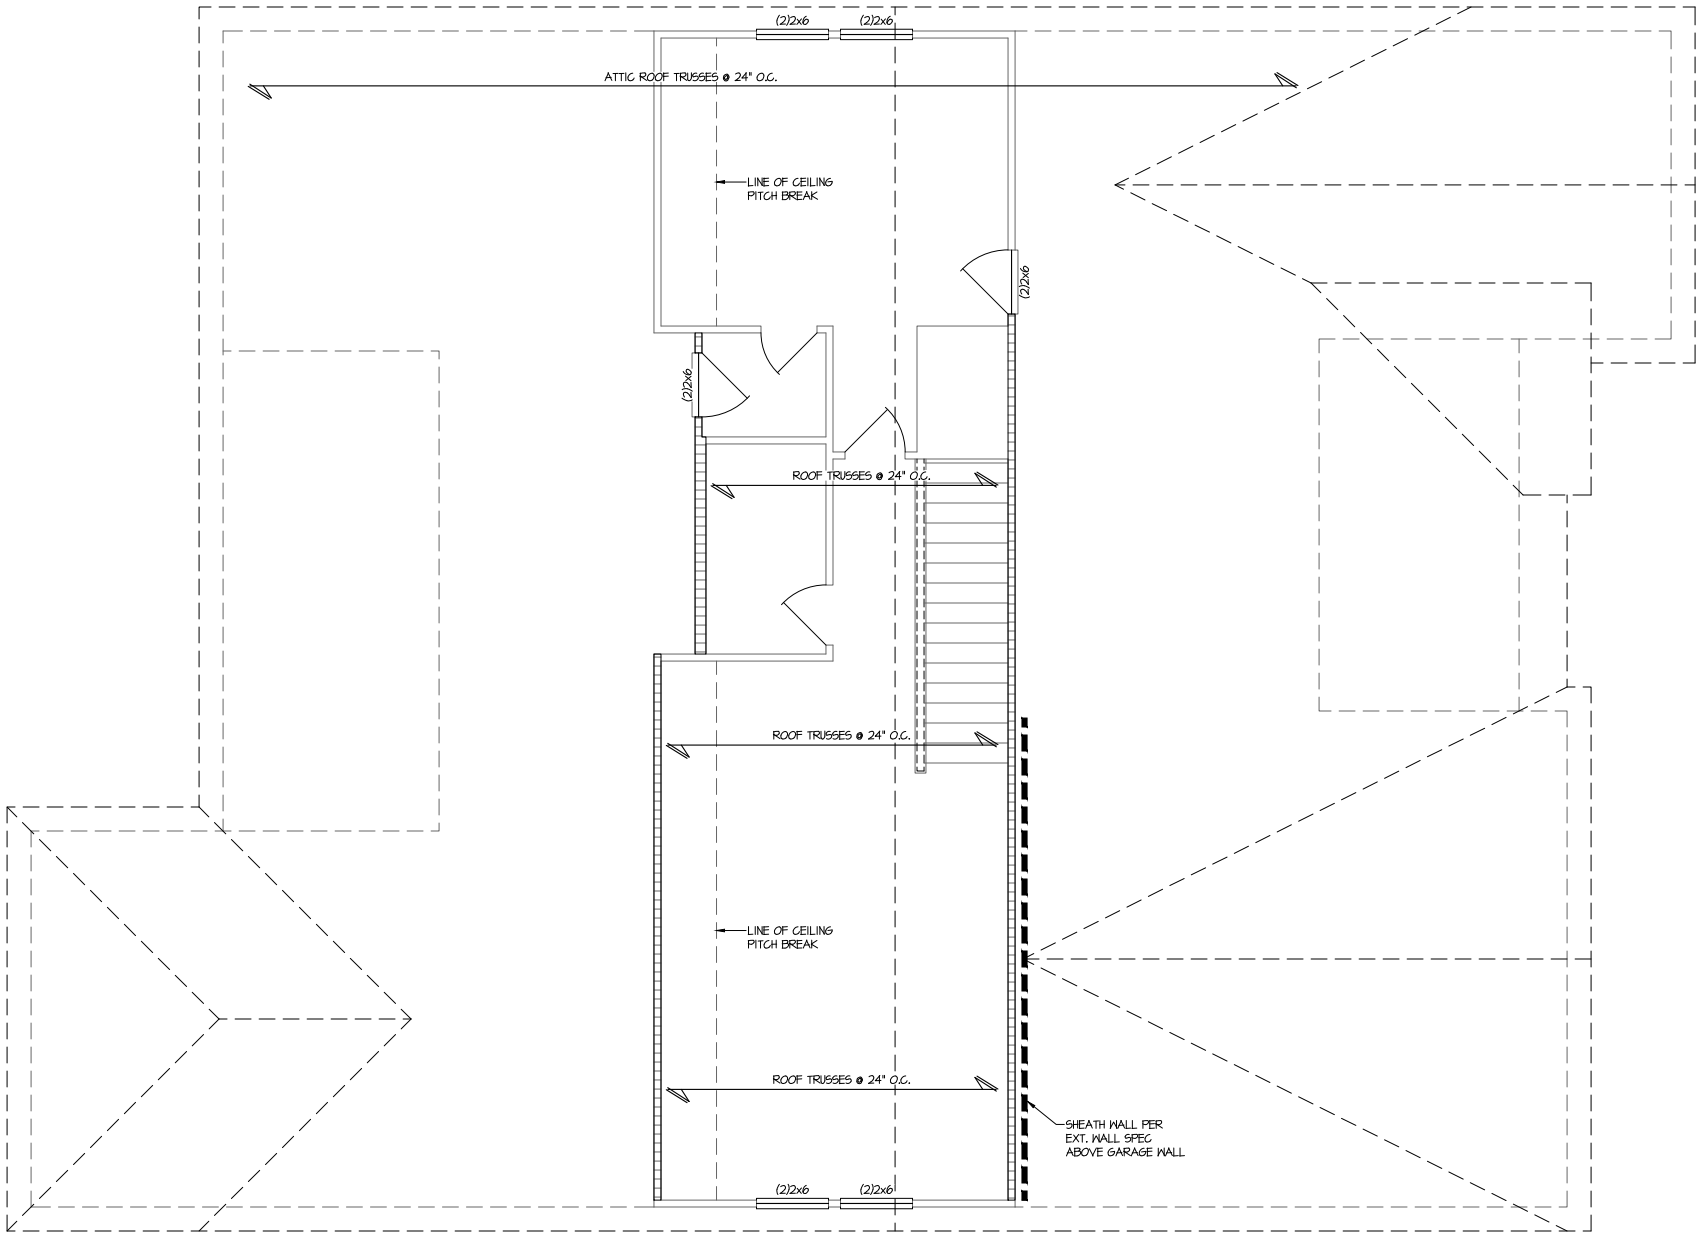

ELEVATION C

OPT. 2ND FLOOR  
HIGH ROOF FRAMING PLAN  
SCALE: 1/4"=1'-0" (22x24 SHEET)  
1/8"=1'-0" (11x17 SHEET)  
ELEV. A  
ALL ELEV. SIM.

OVER 9000 FT<sup>2</sup> -  
NO FIRE RATED  
WALL REQUIRED

THIS LEVEL HAS BEEN DESIGNED FOR 9'-1" PLATE HEIGHT

LEGEND

- INTERIOR BEARING WALL
- BEARING WALL ABOVE (B.W.A.)
- BEAM / HEADER
- INDICATES EXTENT OF INT. OSB SHEARWALL AND/OR 3" O.C. EDGE NAILING
- EXTENT OF VALLEY TRUSS OVERFRAMING @ 24" O.C. (MAX.)
- EXTENT OF FLOOR SYSTEM TO BE DESIGNED FOR TILE
- INDICATES HOLDOWN
- METAL HANGER
- INDICATES POST ABOVE. PROVIDE SOLID BLOCKING UNDER POST OR JAMB ABOVE.

REFER TO S.O. FOR TYPICAL STRUCTURAL NOTES & SCHEDULES

seal: 5/19/25  
NORTH CAROLINA PROFESSIONAL ENGINEER  
SEAL 017622  
STALIN KREIDEL  
© COPYRIGHT: MULHERN & KULP  
Structural Engineering, Inc.

**MULHERN+KULP**  
RESIDENTIAL STRUCTURAL ENGINEERING  
3905 Riverside Parkway, Suite 250 • Alpharetta, GA 30022  
970-777-4074 • mulhern+kulp.com  
NC License # C-3625

Mulhern+Kulp project number:  
243-24033

project mgr: SMK  
drawn by: KMV  
issue date: 08-16-2024

REVISIONS:  
date: initial:  
11-08-2024 SMK  
UPDATED MODEL NAME, OPT, EXT, COVD, PORCH  
05-28-2025 JPP  
MSG, ARCH, UPDATE


**tri pointe**  
HOMES

STRUCTURAL OPTIONS  
5921-07 MODEL  
SERENITY  
MASTER SET  
RALEIGH, NC

sheet:  
**S3.4**

OVER 9000 FT<sup>2</sup> -  
NO FIRE RATED  
WALL REQUIRED


## ELEVATION C

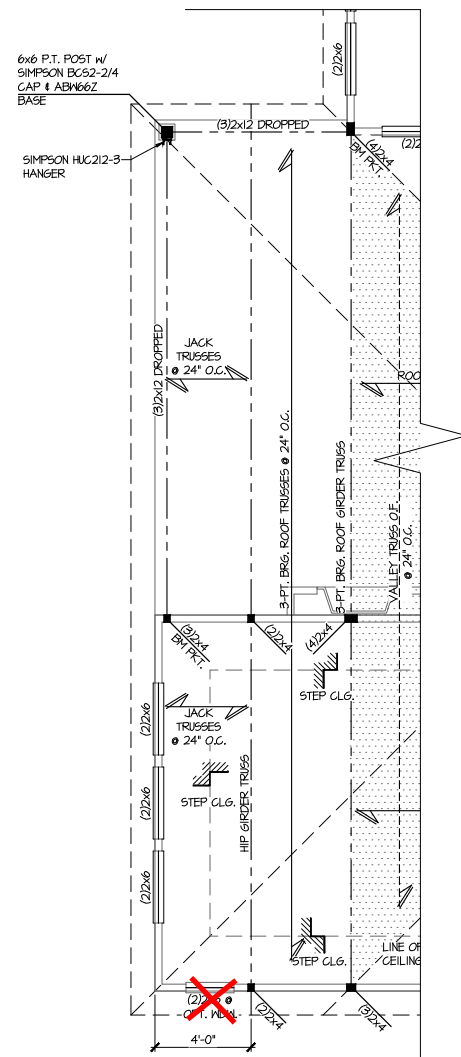

OPT. EXTENDED COVERED PORCH  
PARTIAL ROOF FRAMING PLAN

SCALE: 1/4"=1'-0" (22x24 SHEET)  
1/8"=1'-0" (11x17 SHEET)

ELEV. A  
ALL ELEV. SIM.

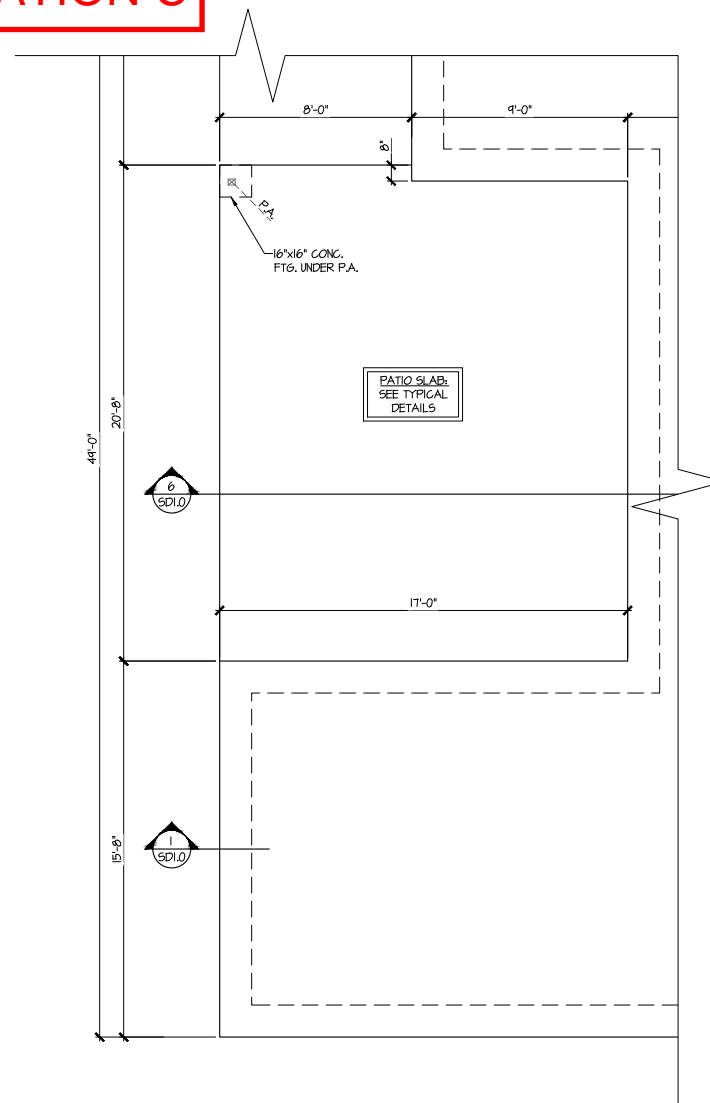

OPT. EXTENDED COVERED PORCH  
PARTIAL SLAB FOUNDATION PLAN

2

SCALE: 1/4"=1'-0" (22x24 SHEET)  
1/8"=1'-0" (11x17 SHEET)







ELEV. A  
ALL ELEV. SIM.

THIS LEVEL HAS BEEN DESIGNED  
FOR 9'-1" PLATE HEIGHT

REFER TO 50.0 FOR  
TYPICAL STRUCTURAL NOTES  
& SCHEDULES

## LEGEND

---

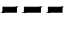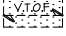-  INTERIOR BEARING WALL.
-  BEARING WALL ABOVE (B.W.A.)
-  BEAM / HEADER
-  INDICATES EXTENT OF INT. OSB SHEARWALL AND/OR 3" O.C. EDGE NAILING
-  EXTENT OF VALLEY TRUSS OVERFRAMING @ 24" O.C. (MAX.)
-  EXTENT OF FLOOR SYSTEM TO BE DESIGNED FOR TILE
- ▶ INDICATES HOLDDOWN
- ⌋ METAL HANGER
- \* INDICATES POST ABOVE. PROVIDE SOLID BLOCKING UNDER POST OR JAMB ABOVE.

**LOT 341**  
**5921-07**  
**ASPEN CREEK**  
**ELEVATION C**  
**REVERSE PLAN**  
**LEFT-HAND**  
**GARAGE**

seal:  5/19/25

**MULHERN+KULP**  
RESIDENTIAL STRUCTURAL ENGINEERING  
3665 Riverside Parkway, Suite 250 • Alpharetta, GA 30022  
p 770-777-9874 • [m+k@mulhernkulp.com](mailto:m+k@mulhernkulp.com)  
NC License # C-3825

Mulhern+Kulp project number:  
243-24033

project mgr:	SMK
drawn by:	KMV
issue date:	08-16-2024

REVISIONS:	
date:	initial:
11-08-2024	SMM
UPDATED MODEL NAME, OPT. EXT. COVD. PORCH	
05-28-2025	JPP
MISC. ARCH. UPDATE	

tri pointe.  
HOMES

STRUCTURAL OPTIONS



5921-07 MODEL

SERENITY  
MASTER SET  
RALEIGH, NC

sheet:

**S4.0**

OVER 9000 FT<sup>2</sup> -  
NO FIRE RATED  
WALL REQUIRED

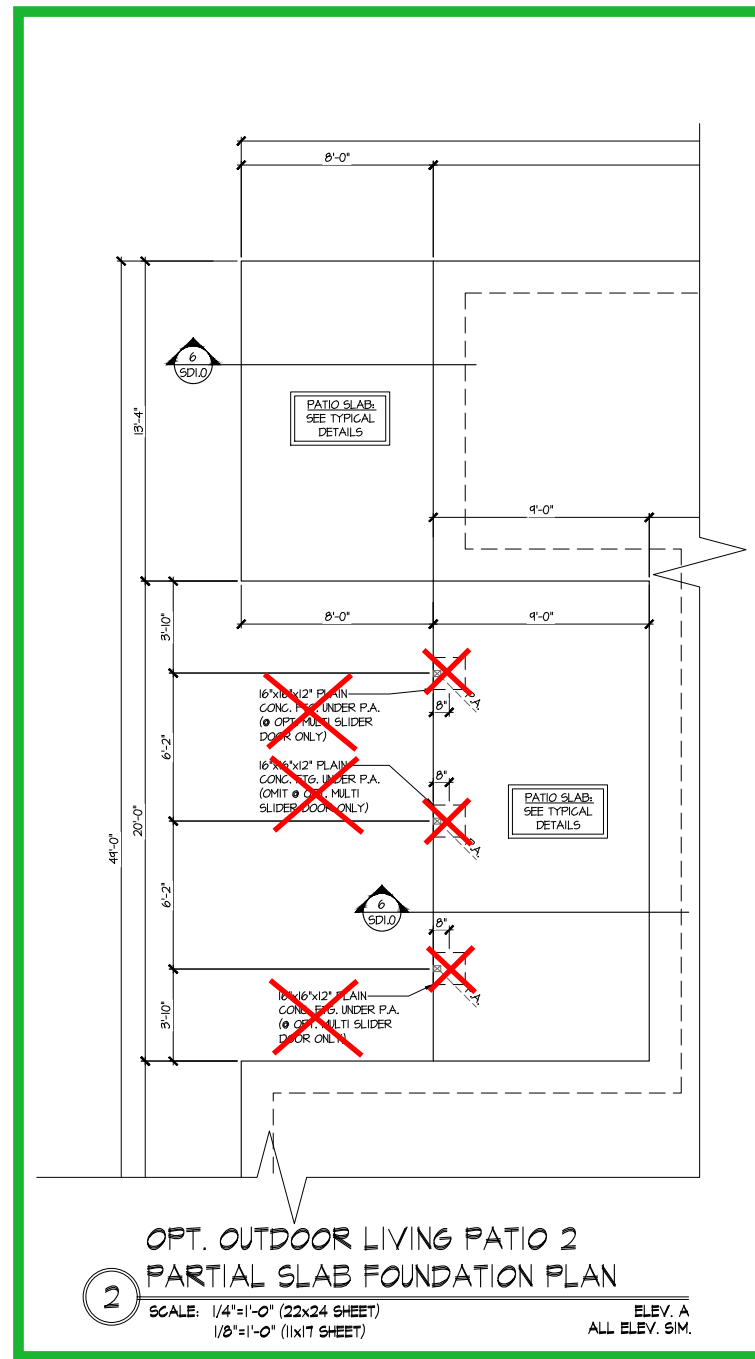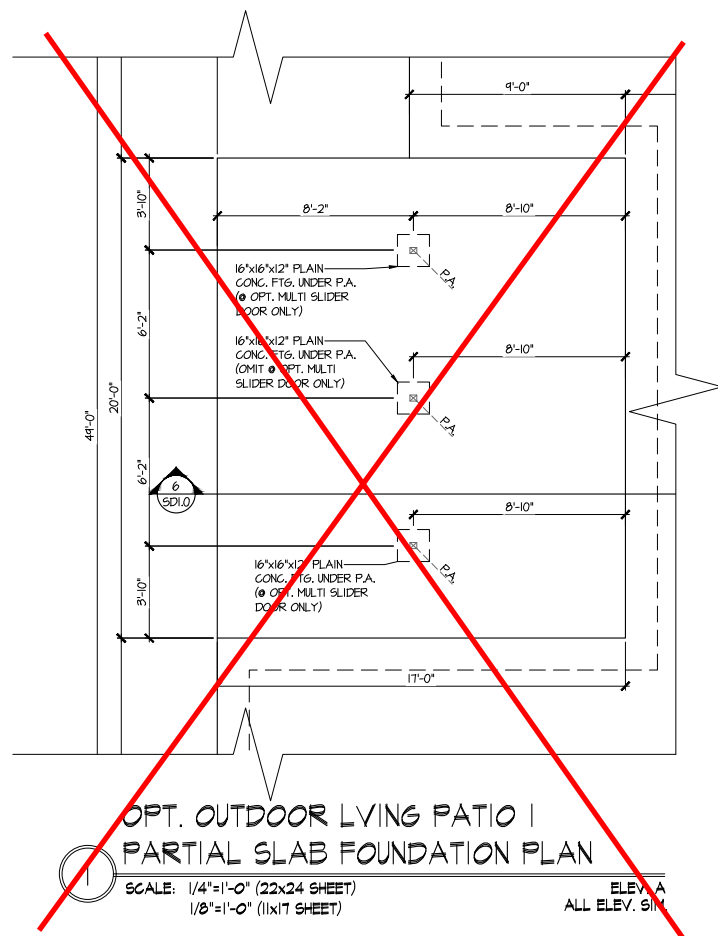

ELEVATION C

THIS LEVEL HAS BEEN DESIGNED  
FOR 9'-1" PLATE HEIGHT

REFER TO S.O. FOR  
TYPICAL STRUCTURAL NOTES  
& SCHEDULES

LEGEND	
•	INTERIOR BEARING WALL
•	BEARING WALL ABOVE (B.W.A.)
•	BEAM / HEADER
•	INDICATES EXTENT OF INT. OSB SHEARWALL AND/OR 3" O.C. EDGE NAILING
•	EXTENT OF VALLEY TRUSS OVERFRAMING @ 24" O.C. (MAX.)
•	EXTENT OF FLOOR SYSTEM TO BE DESIGNED FOR TILE
▶	INDICATES HOLDDOWN
⌈	METAL HANGER
*	INDICATES POST ABOVE. PROVIDE SOLID BLOCKING UNDER POST OR JAMB ABOVE.

LOT 341  
5921-07  
ASPEN CREEK  
ELEVATION C  
REVERSE PLAN  
LEFT-HAND  
GARAGE

seal: 5/19/25  
MULHERN+KULP  
RESIDENTIAL STRUCTURAL ENGINEERING  
SEAL 087622  
STALIN KREIDEL  
© MULHERN+KULP  
Structural Engineering, Inc.

MULHERN+KULP  
RESIDENTIAL STRUCTURAL ENGINEERING  
3955 Breville Parkway, Suite 250 - Alpharetta, GA 30022  
9776-777-4074 - mulhern+kulp.com  
NC License # C-3625

Mulhern+Kulp project number:  
243-24033  
project mgr: SMK  
drawn by: KMV  
issue date: 08-16-2024

REVISIONS:  
date: 11-08-2024 initial: SMK  
updated model name, opt, ext, cov'd, porch  
05-28-2025 JJP  
MSG, ARCH, UPDATE

tri pointe  
HOMES




STRUCTURAL OPTIONS  
5921-07 MODEL  
SERENITY  
MASTER SET  
RALEIGH, NC

sheet:

S4.1






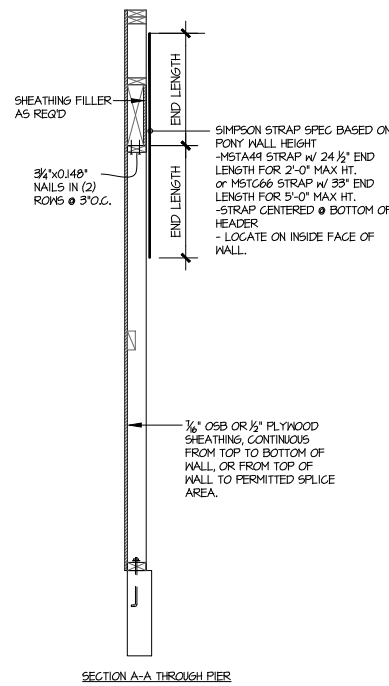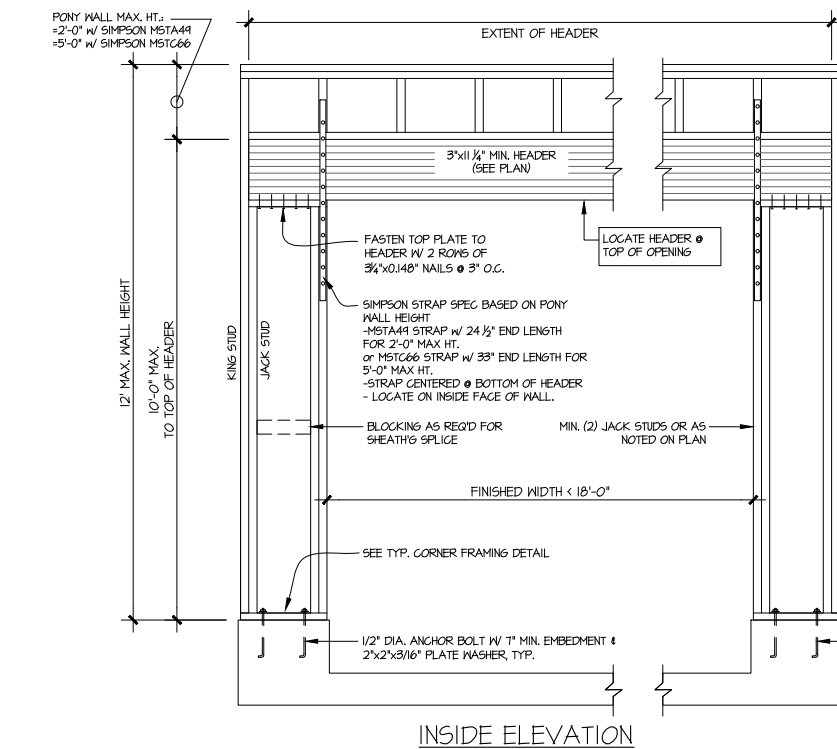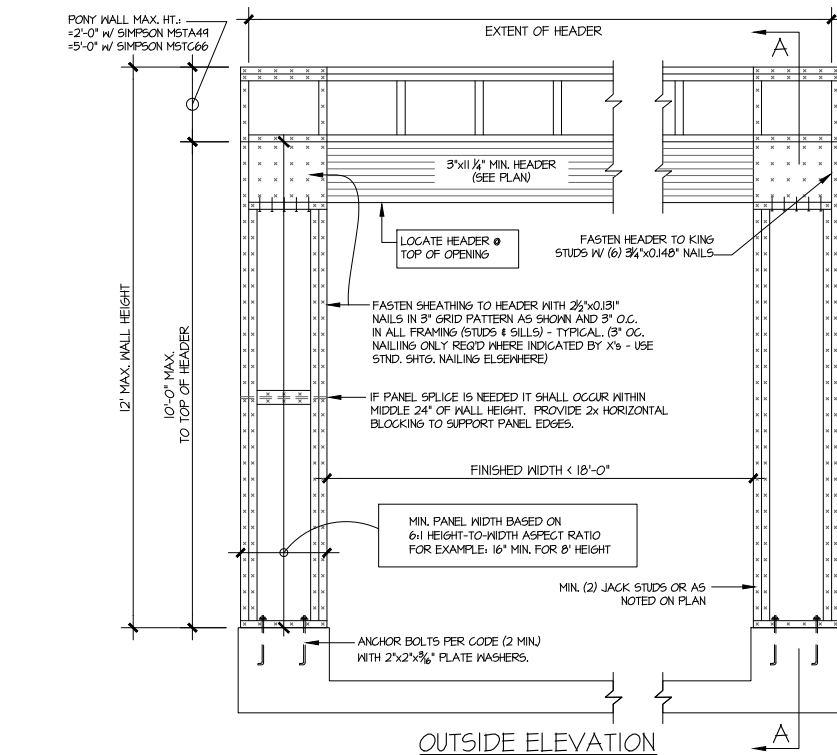


NOTE: ALL SHEATHABLE AREAS OF EXTERIOR WALL SHALL BE FULLY SHEATHED WITH 1/2" PLYWOOD OR 3/8" OSB


WALL FRAMING SPECIFICATION: USE SPP/SYP STUD GRADE STUDS (OR BETTER)

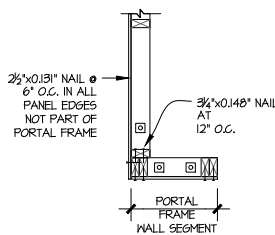


ALTERNATIVES TO 1/2" DIA. ANCHOR BOLT:  
1) 1/2" DIA. x 6" LONG SIMPSON TITEN HD  
2) 1/2" DIA. THREADED ROD EPOXY SET w/4 1/2" EMBED. (MIN) UTILIZING HILTI HY200 EPOXY ANCHORING SYSTEM (OR EQUAL)

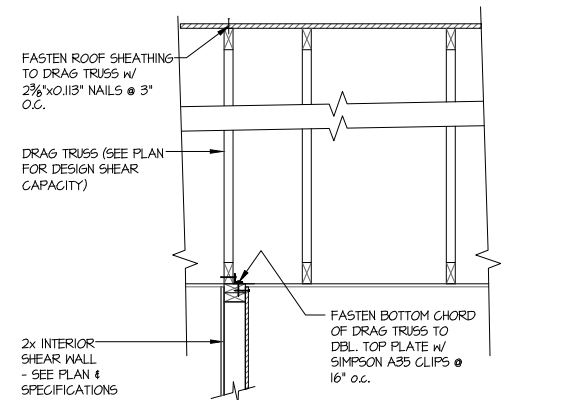


2 INTERIOR DRAG TRUSS DETAIL  
SCALE: 3/4"=1'-0"

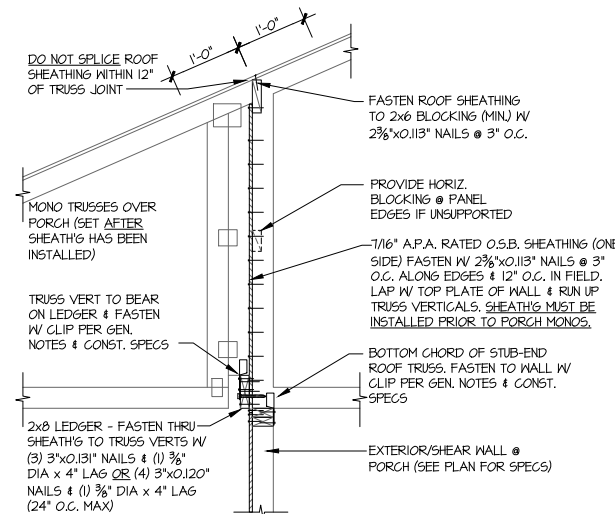


4 SHEAR TRANSFER DETAIL @ BREAK IN TRUSSES OVER SHEAR WALL  
SCALE: 3/4"=1'-0" - 22:34  
3/8"=1'-0" - 11x17

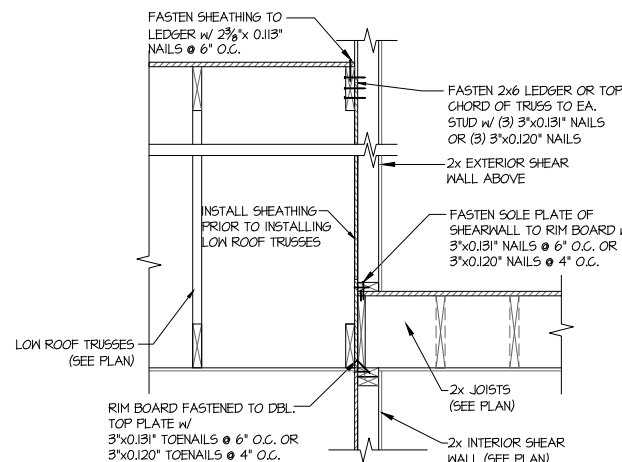


6 TYPICAL SHEAR TRANSFER DETAIL BETWEEN FLOORS @ INTERIOR WALL  
SCALE: 3/4"=1'-0"

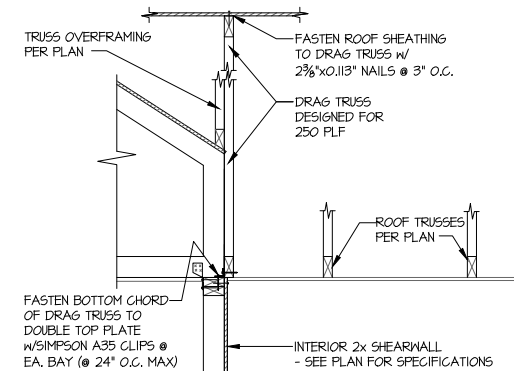

3 SHEAR TRANSFER DETAIL AT INTERIOR SHEARWALL BELOW  
SCALE: 3/4"=1'-0"

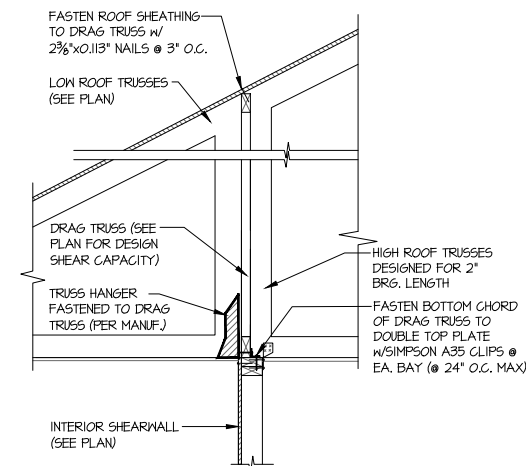




5 SHEAR TRANSFER DETAIL AT INTERIOR SHEARWALL BELOW  
SCALE: 3/4"=1'-0"

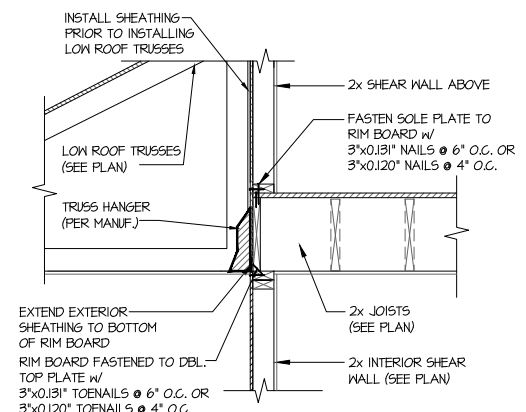

7 TYPICAL SHEAR TRANSFER DETAIL BETWEEN FLOORS @ INTERIOR WALL  
SCALE: 3/4"=1'-0"


1 GARAGE PORTAL FRAME BRACING ELEVATION  
SCALE: N.T.S.

BOTH SIDES OF GARAGE DOOR  
115 MPH WIND SPEED (ULT)

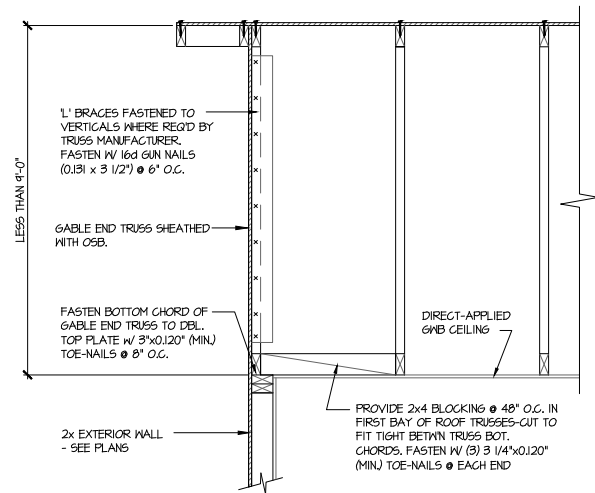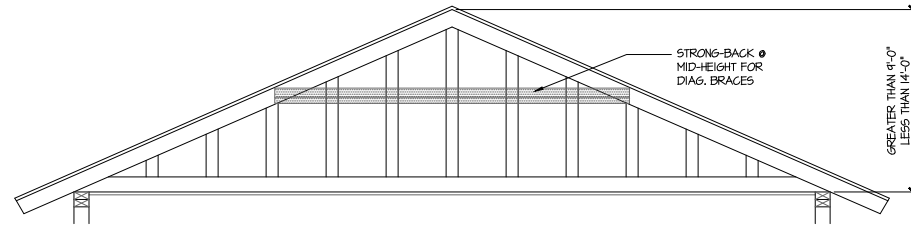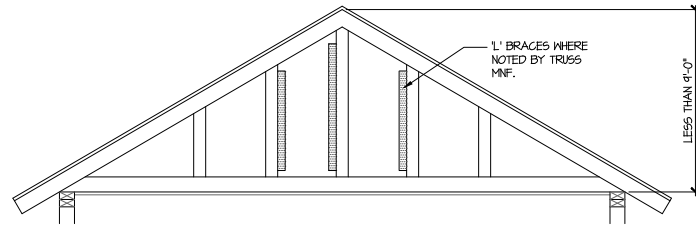


**A** TYPICAL GABLE END BRACING DETAIL  
SCALE: NONE  
REQ'D @ GABLE END TRUSS  
HEIGHT UP TO 9'-0"

BRACE GABLE END TRUSSES PER ABOVE DETAIL WHEN GABLE HEIGHT IS LESS THAN 9'-0". 1" BRACES REQUIRED WHERE NOTED BY TRUSS MANUFACTURER.

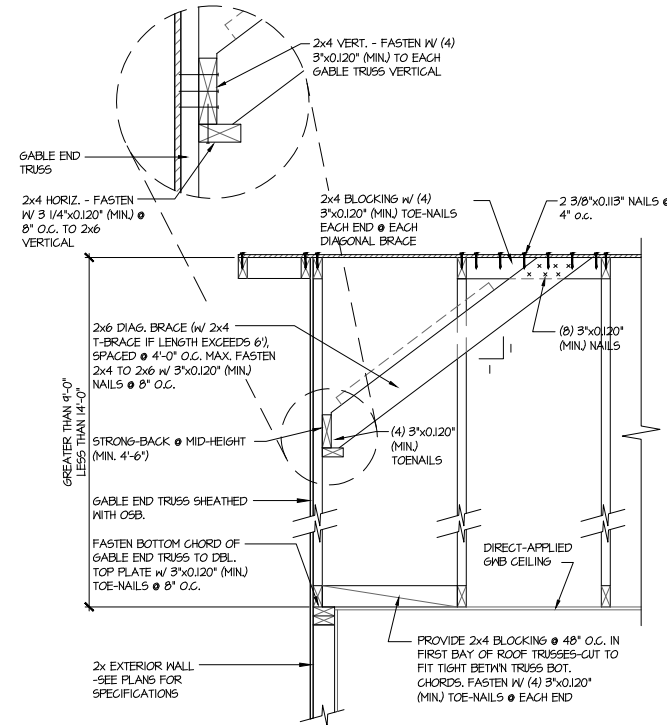

**B** TYPICAL GABLE END BRACING DETAIL  
SCALE: NONE  
REQ'D @ GABLE END TRUSS  
HEIGHT BETWEEN 9'-0" TO 14'-0"

BRACE GABLE END TRUSSES PER ABOVE DETAIL WHEN GABLE HEIGHT EXCEEDS 9'-0". 1" BRACES NOT REQUIRED.

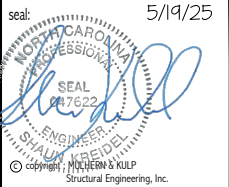

**MULHERN+KULP**  
RESIDENTIAL STRUCTURAL ENGINEERING

3905 Bonaventure Parkway, Suite 250 • Alpharetta, GA 30022  
970-777-4074 • mulhern+kulp.com  
NC License # C-3625

Mulhern+Kulp project number:  
**243-24033**

project mgr: **SMK**  
drawn by: **KMV**  
issue date: **08-16-2024**

REVISIONS:	
date:	initial:
11-08-2024	SMK
05-28-2025	JJPP
MSG. ARCH. UPDATE	



**FRAMING DETAILS**

**5921-07 MODEL**  
SERENITY  
MASTER SET  
RALEIGH, NC

sheet:  
**SD2.1**