



## Planning Services Sign Permit Review Form

PO Box 65  
108 E. Front Street  
Lillington, NC 27546  
Ph: (910) 893- 7525 opt. 4  
Fax: (910) 814-6459

Date of Submittal	Application Number	Applicant	Landowner
8/07/2020	SIGN2008-0002	Allen Industries	Boddie Noell Enterprises

Contact Person	Contact Number
Heather English	(336) 799-4670
Sign Location	PIN Number
2471 NC 87 S. Cameron	9575-95-4454.000


Proposed Sign			
Type	Dimensions	Location / Setbacks	Illumination
<input type="checkbox"/> Wall <input checked="" type="checkbox"/> Ground <input type="checkbox"/> Monument <input type="checkbox"/> Directory <input type="checkbox"/> Outdoor Advertising	<p><b>Ground:</b>            Length: 4' 4" &amp; 6' 0"            Width 14' 11.5" &amp; 10' 1"            Height :15' 2"            Total Sq. Ft. : 130.43'</p> <p>Wall Front Elevation:            Total Square footage: 30.875            Wall Length: 40' 7"</p> <p>Wall Right Elevation:            Total Square footage: 30.875            Wall Length: 76' 0"</p> <p>Vinyl Window Sign:            Front Elevation Vinyl Sq. Feet: 145.28            Right Elevation Vinyl Sq. Feet: 119.45            Total Window Sq. Feet Front: -            Total Window Sq. Feet Right:-</p>		<input type="checkbox"/> None <input type="checkbox"/> External <input checked="" type="checkbox"/> Internal <input type="checkbox"/> Electronic Message
Total Length of Wall		Total Size of Project / Parcel	<input type="checkbox"/> Less Than 1 Acre <input checked="" type="checkbox"/> Greater Than 1 Acre
Total Sq. Ft. Electronic Message Display	<b>0</b>	Pole Style Ground Sign Encasement	Material Aluminum Width 3'

Current Signage			
Current Wall Signs	Current Ground Signs	Distance Between Signs On Property	Distance Between Outdoor Advertising Signs
<b>0</b>	<b>0</b>	<b>N/A</b>	<b>N/A</b>


Reviewed By:	Date of Review	Review Results
<b>Sarah Arbour</b>	<b>8/19/2020</b>	<input type="checkbox"/> Approved <input checked="" type="checkbox"/> Disapproved

Comments	<ol style="list-style-type: none"> <li>1. Ground sign exceeds maximum height permitted. Please reduce height of ground sign by 2".</li> <li>2. Please label distance of ground sign to the front and side property lines. 20' from each property line is required.</li> <li>3. Please provide size of the vinyl window graphics in square feet.</li> </ol>
----------	--

# Planning Services Sign Permit Review Form

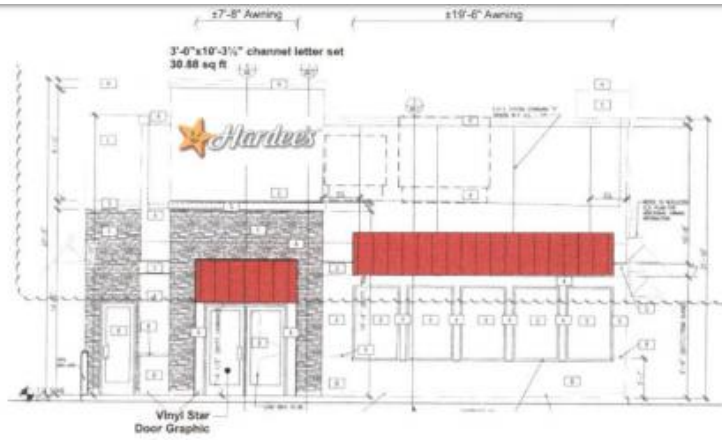


**FRONT ELEVATION**  
Scale: 1/8" = 1'-0"

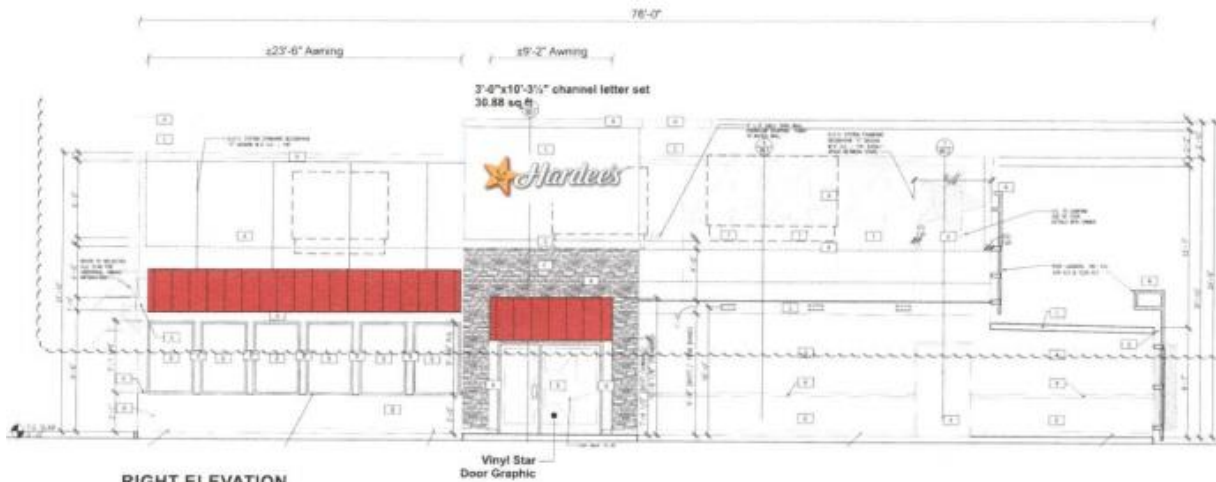


**RIGHT ELEVATION**  
Scale: 1/8" = 1'-0"

# Planning Services Sign Permit Review Form

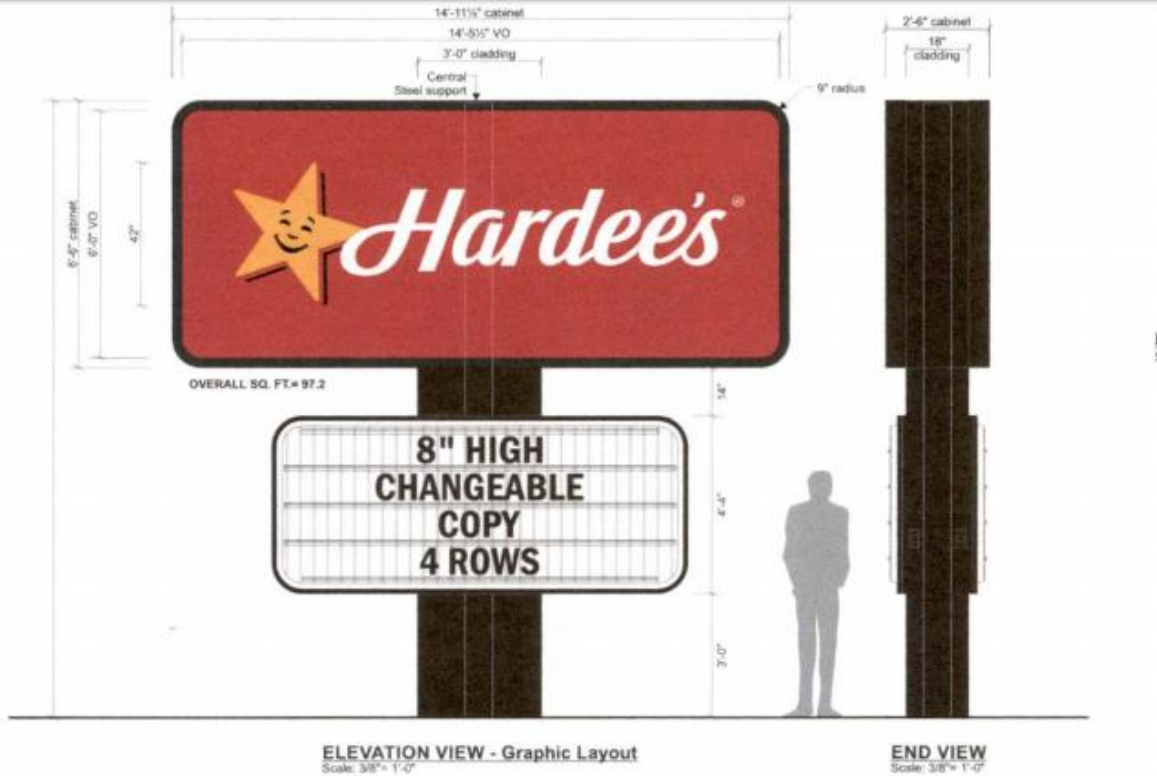

**2 REQUIRED**

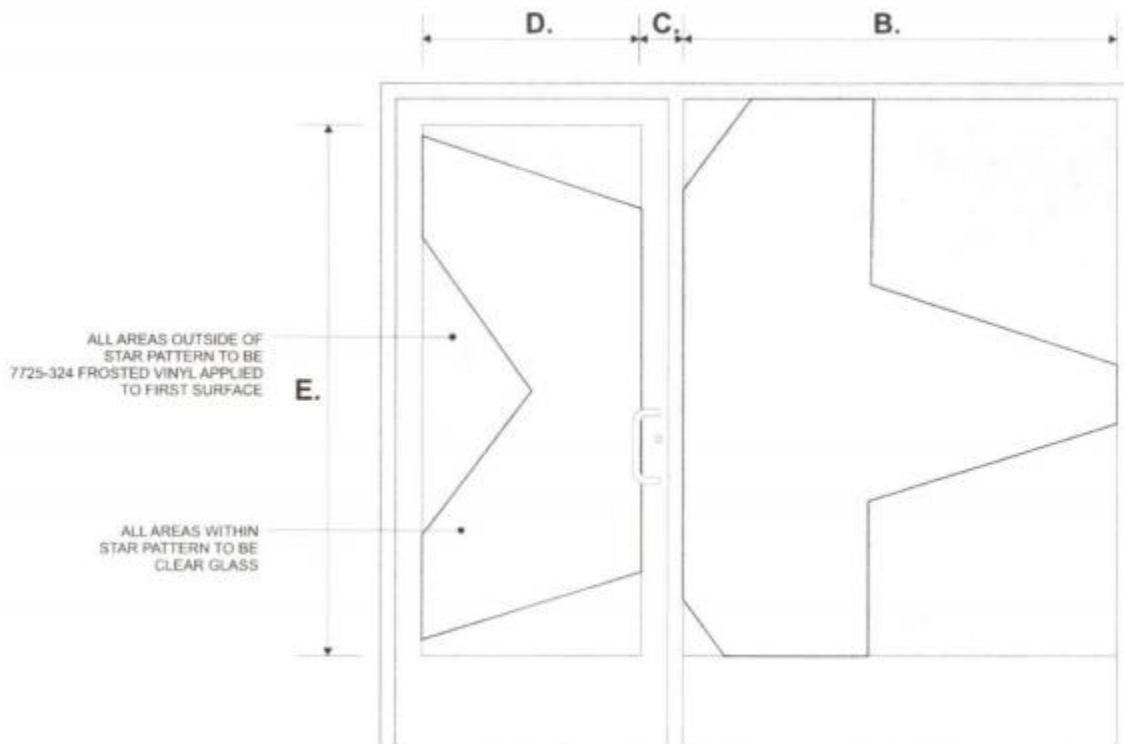

**VINYL LAYOUT FOR SINGLE DOOR w/ WINDOW**  
N.T.S.