



Planning Services Sign Permit Review Form

PO Box 65
108 E. Front Street
Lillington, NC 27546
Ph: (910) 893- 7525 opt. 4
Fax: (910) 814-6459

Date of Submittal	Application Number	Applicant	Landowner
10/26/2023	SIGN2310-0005	TMTLA Associates	DRB Group North Carolina LLC.

Contact Person	Contact Number	PIN Number	
Robin@tmtia.com	919-484-8880		
Sign Location	2 Signs Corner of Sheriff Johnson Rd. and Bronze Leaf Dr.; Lots 88 and 89.		0680-38-7921.000 0680-38-8753.000

Proposed Sign			
Type	Dimensions	Location / Setbacks	Illumination
<input type="checkbox"/> Wall <input checked="" type="checkbox"/> Ground <input type="checkbox"/> Monument <input type="checkbox"/> Directory <input type="checkbox"/> Outdoor Advertising	Height 5'-6" Width 8'-10" Total Sq. Ft.: 48.58	Setbacks from the ROW: Less than 20' Bronze Leaf and Sheriff Johnson	<input checked="" type="checkbox"/> None <input type="checkbox"/> External <input type="checkbox"/> Internal <input type="checkbox"/> Electronic Message
Total Length of Wall	Not Provided	Total Size of Project / Parcel	<input type="checkbox"/> Less Than 1 Acre <input checked="" type="checkbox"/> Greater Than 1 Acre
Total Sq. Ft. Electronic Message Display	NA	Pole Style Ground Sign Encasement	Material – Width --



Current Signage			
Current Wall Signs	Current Ground Signs	Distance Between Signs On Property	Distance Between Outdoor Advertising Signs
0	0	NA	0

Reviewed By:	Date of Review	Review Results
Sarah Arbour	11/2/2023	<input type="checkbox"/> Approved <input checked="" type="checkbox"/> Denied <input type="checkbox"/> More information needed

Comments	
	1. When signs are constructed at an intersection, the minimum setback is 20' from each ROW. Please revise the location of the sign on the site plan.

Planning Services Sign Permit Review Form

Sign Rendering

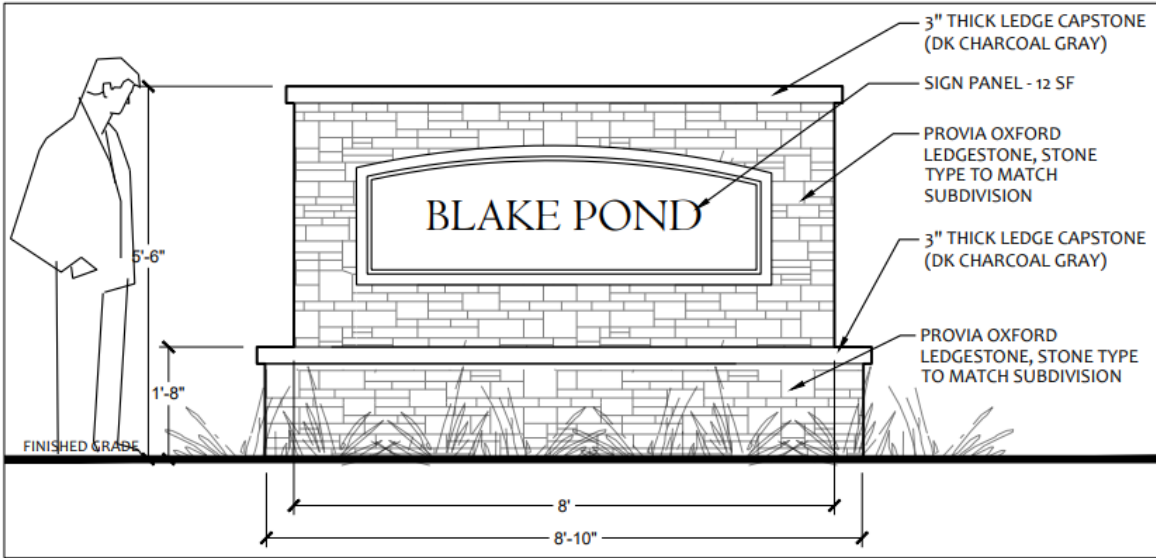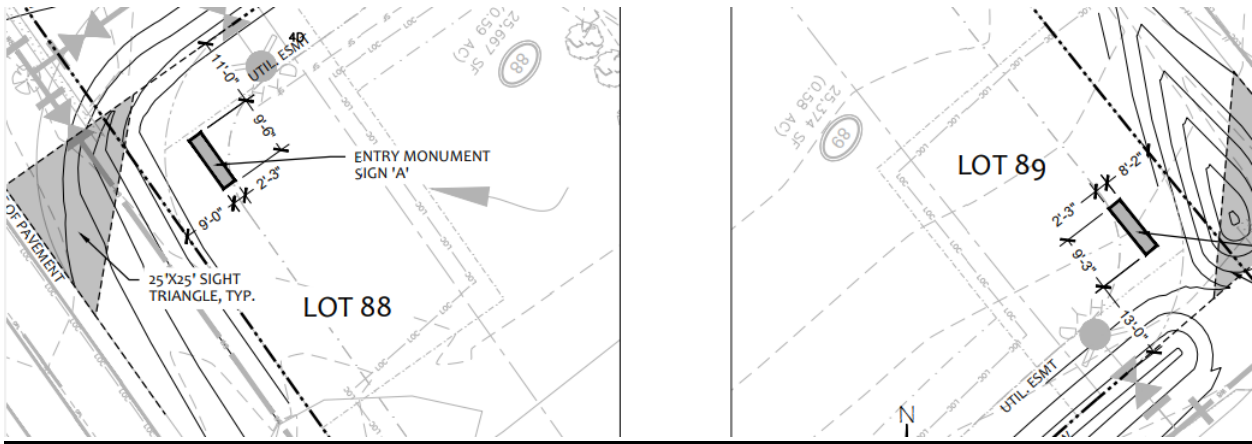

1 MONUMENT SIGN -A ELEVATION
SCALE: 1/2"=1'