


3363 Olivia Rd  
 Olivia NE

**1022976-1b-s Photo real graphic**

Dimensions: 12.125" x 91.875"

With bleed: 12.625" x 92.375"

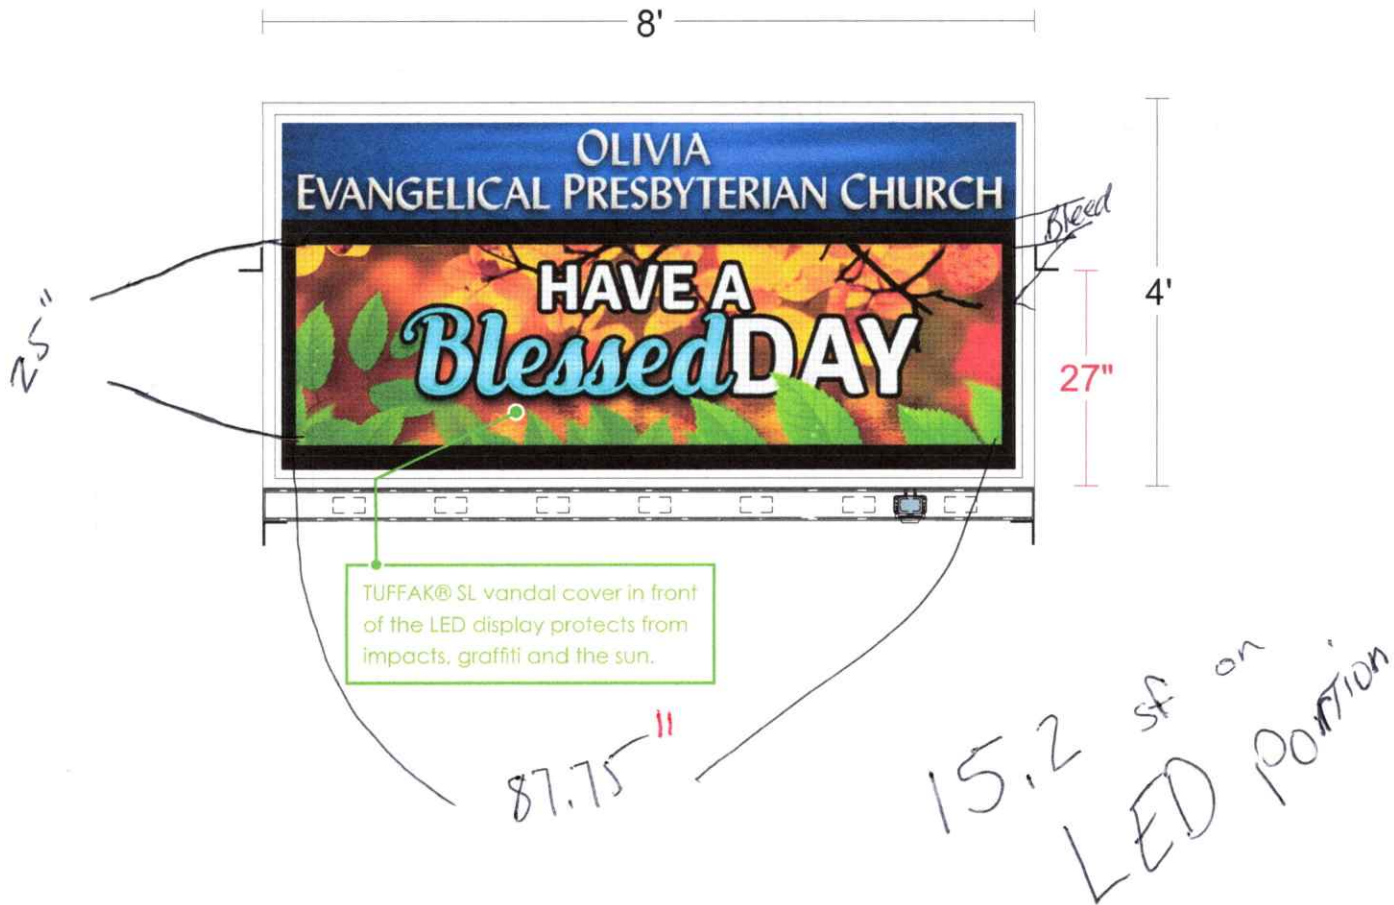

**Stewart Signs**  
 ONE SIGN. ONE COMPANY

**TekStar Color 16mm 40x140**  
 Cabinet Size: 4'x8'  
 Sk: 1022976-1b-s Cust: 1459341  
 10/17/2023 F/bSchmid SOLD  
 Scale: 1/2"=1' Cabinet Color: White  
**SIGN DESIGN 301728**

Signature \_\_\_\_\_  
 Date \_\_\_\_\_


1-800-237-3928 [stewartsigns.com](http://stewartsigns.com)

Please confirm that all lettering, colors and graphics are correct before signing. Changes to artwork after signature is received will incur a \$200 art change fee.



Please provide the following information to ensure that your new sign will fit within your existing structure.

Please provide exact measurements in feet and inches.

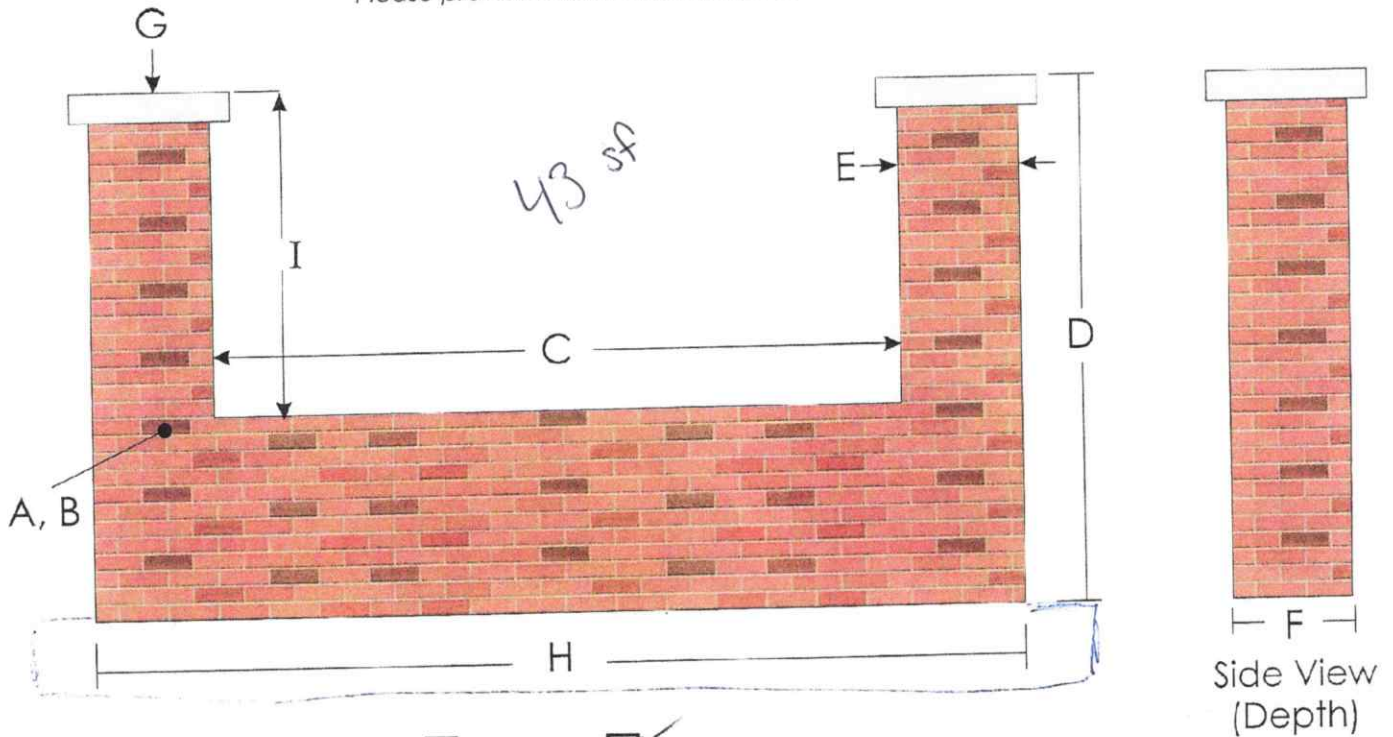

A. Pillar and base is:  Hollow  Solid

B. If solid, the pillar and base are filled with:  Concrete  Other: Brick

C. Available space between pillars: 8' 1"

D. Total height of pillar and base: 55 1/2"

E. Width of pillar: 7 1/2"

F. Depth of pillar: 15 3/4"

G. Cap on pillar:  No  Yes: Height \_\_\_\_\_, Width \_\_\_\_\_, Depth \_\_\_\_\_

H. Width of base: 9' 3 1/4"

I. Height from top of base to top of pillar: 35"

Customer Signature: Christina Preece

Organization Name: Diana Preece Terian

Date: 10-16-2023