Initial Application Date: Dec 29, 04 Application # 1501100
813310

COUNTY OF HARNETT LAND USE APPLICATION

Central Permitting 102 E. Front Street, Lillington, NC 27546 Phone: (910) 893-4759 Fax: (910) 893-2793

LANDOWNER: ~~Cawiness Land Dev~~ Woodshire Partners LLC Mailing Address: 2818 Raeford Road, Ste 300
City: Fayetteville State: NC Zip: 28303 Phone #: 481-0503

APPLICANT: ~~SAME AS ABOVE~~ Cawiness Land Dev Mailing Address:
City: State: Zip: Phone #:

PROPERTY LOCATION: SR #: 1117 SR Name: Nursery Road
Parcel: 0503-00-0056-01 (portion of) PIN:
Zoning: RA20R Subdivision: Woodshire Ph 3 Lot #: 92 Lot Size: .35
Flood Plain: X Panel: 155 Watershed: n/a Deed Book/Page: OTP Plat Book/Page:

DIRECTIONS TO THE PROPERTY FROM LILLINGTON: Hwy 27 to Nursery Rd, Woodshire subdivision will be on the left, turn left on Woodshire. turn left on Silver Oaks. turn Right on Union Circle.

PROPOSED USE:
- [x] Sg. Family Dwelling (Size 36 x 54) # of Bedrooms 3 # Baths 3 Basement (w/wo bath) WO Garage 1 Deck 1
- [ ] Multi-Family Dwelling No. Units ____ No. Bedrooms/Unit ____
- [ ] Manufactured Home (Size ____ x ____) # of Bedrooms ____ Garage ____ Deck ____
- Comments: ____
- [x] Number of persons per household Spec
- [ ] Business Sq. Ft. Retail Space ____ Type ____
- [ ] Industry Sq. Ft. ____ Type ____
- [ ] Home Occupation (Size ____ x ____) # Rooms ____ Use ____
- [ ] Accessory Building (Size ____ x ____) Use ____
- [ ] Addition to Existing Building (Size ____ x ____) Use ____
- [ ] Other ____

Water Supply: (✓) County ( ) Well (No. dwellings ____) ( ) Other
Sewage Supply: (✓) New Septic Tank ( ) Existing Septic Tank ( ) County Sewer ( ) Other
Erosion & Sedimentation Control Plan Required? YES (NO)
Structures on this tract of land: Single family dwellings 10 POP Manufactured homes — Other (specify) —
Property owner of this tract of land own land that contains a manufactured home w/in five hundred feet (500') of tract listed above? YES (NO)

Required Property Line Setbacks:	Minimum	Actual		Minimum	Actual
Front	35	36'	Rear	25	45'
Side	10	11'	Corner	—	—
Nearest Building	10	+			

permits are granted I agree to conform to all ordinances and the laws of the State of North Carolina regulating such work and the specifications or plans submitted. I hereby swear that the foregoing statements are accurate and correct to the best of my knowledge.

Signature of Owner or Owner's Agent

12-8-04
Date

This application expires 6 months from the date issued if no permits have been issued

A RECORDED SURVEY PLAT AND RECORDED DEED ARE REQUIRED WHEN APPLYING FOR A LAND USE PERMIT

1/4 S

SITE PLAN APPROVAL

DISTRICT RA20R USE SFD

#BEDROOMS 3

Bilal A. Dicko

Date Zoning Administrator

1"=20'

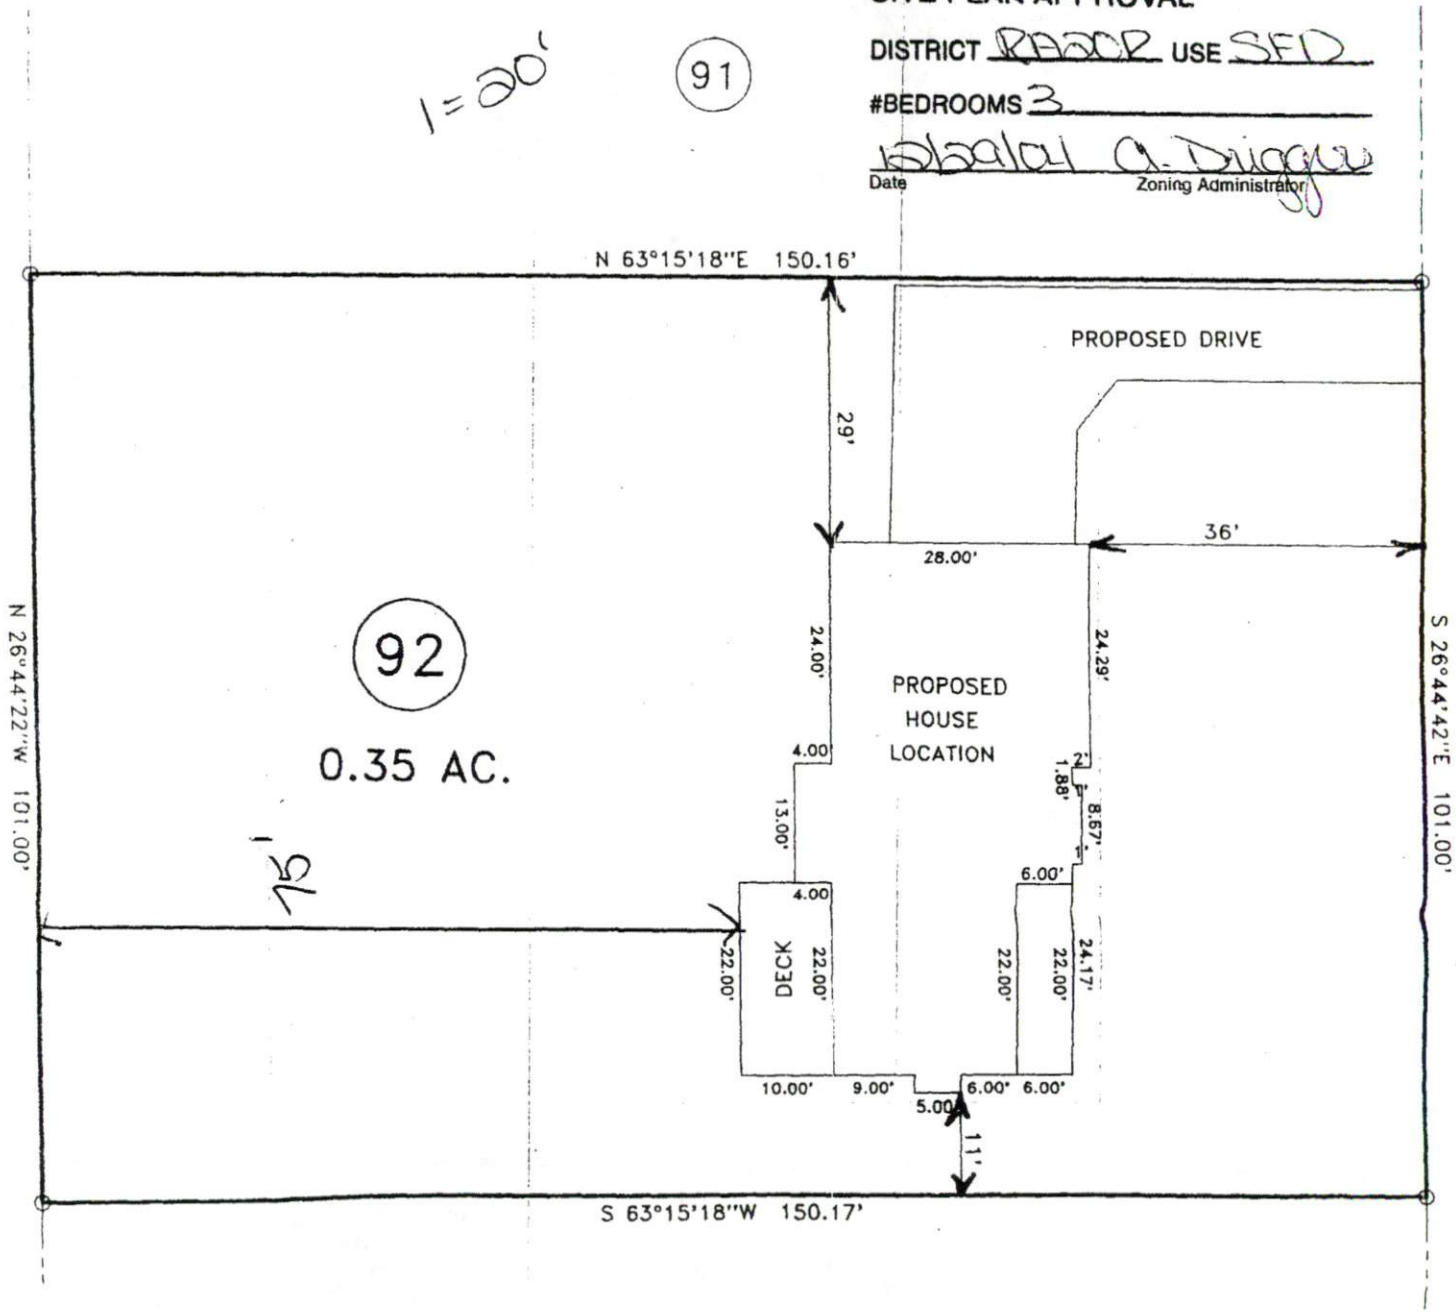

"UNION CIRCLE" 50' R/W