HTE# 09-5-21788

Harnett County Department of Public Health

20468

PERMIT # 25147

Operation Permit

☑ New Installation ☑ Septic Tank ☐ Repair ☑ Nitrification Line ☐ Expansion

PROPERTY LOCATION: SR 1415 FRANKS CH RD

Name: (owner) ADAM JACKSON SUBDIVISION Woodland RIDGE LOT # 15

System Installer: RON WALL Registration # _____

Basement with plumbing: ☐ Garage ☑ Number of Bedrooms 3

Type of Water Supply: ☐ Community ☑ Public ☐ Well Distance from well _____ feet

System Type: 25% REDUCTION System Types V and VI Systems expire in 5 years.

(In accordance with Table V a) Owner must contact Health Department 6 months prior to expiration for permit renewal.

This system has been installed in compliance with applicable North Carolina General Statutes, Rules for Sewage Treatment and Disposal, and all conditions of the Improvement Permit and Construction Authorization.

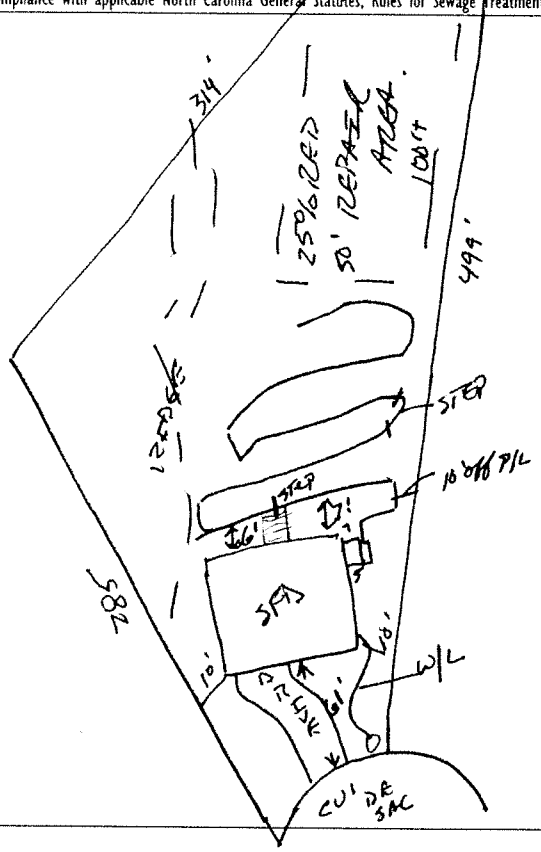

*System WAS INSTALLED Before ANY PART of HOME was STARTED.

* DITCHES ARE NOT SOLID 30" DEEP THROUGHOUT LINE. DITCHES ARE VARYING DEPTHS.

PERMIT CONDITIONS:

I. Performance: System shall perform in accordance with Rule .1961.

II. Monitoring: As required by Rule .1961.

III. Maintenance: As required by Rule .1961. Other: _____

Subsurface system operator required? Yes ☐ No ☐

If yes, see attached sheet for additional operation conditions, maintenance and reporting.

IV. Operation: _____

V. Other: _____

Following are the specifications for the sewage disposal system on the above captioned property.

Type of system: ☐ Conventional ☑ Other 25% REDUCTION System Type III Septic Tank: 1000 gallons Pump Tank: _____ gallons

Subsurface Drainage Field: No. of ditches 1 exact length of each ditch 240 feet width of ditches 3 feet depth of ditches 30" inches

French Drain Required: _____ Linear feet

Authorized State Agent James E Mauldin Date 7-22-09