ADDRESS . : 641 DUKE RD SUBDIV:
CONTRACTOR : A C LEE CONSTRUCTION LLC PHONE : (919) 795-9813
OWNER . . : CAULDER BARRY J & TONYA J PHONE :
PARCEL . . : 07-0598- - -0126- -01-
APPL NUMBER: 12-50029662 CP NEW RESIDENTIAL (SFD)
APPL NOTES : BPMN 8/31/12 XXXXXXXXXXXXXXXXXXXXXXXXXXXXXXXXXXXXXX
PERMIT INCLUDES BLDG,ELEC,MECH,PLUMB
INSULATION AND LAND USE.
XXXXXXXXXXXXXXXXXXXXXXXXXXXXXXXXXXXXXX
Work must conform and comply with the
STATE BUILDING CODE and all other State
and local laws, ordinances & regulations
T/S: 09/10/2012 11:30 AM VBROWN ----
641 DUKE RD. NO DIRECTION GIVEN.

**STRUCTURE: 000 000 72X79 3BDR 2.5BATH SFD W DECK CRAWL**
FLOOD ZONE . . . . : FLOOD ZONE X
# BEDROOMS . . . . . : 3.00 PROPOSED USE . . . . . : SFD
SEPTIC - EXISTING? . . . . : NEW TANK WATER SUPPLY . . . . . : NEW WELL

**PERMIT: CPSF 00 CP * SFD**

| TYP/SQ | REQUESTED COMPLETED | INSP RESULT | DESCRIPTION RESULTS/COMMENTS |
|---|---|---|---|
| B101 01 | 12/14/12 | KS | R*BLDG FOOTING / TEMP SVC POLE TIME: 17:00 VRU #: 002316065 |
| | 12/14/12 | AP | T/S: 12/12/2012 03:58 PM VBROWN ---------- |
| | | | T/S: 12/12/2012 03:59 PM VBROWN ---------- |
| | | | T/S: 12/14/2012 09:31 AM KSLATTUM ---------- |
| A814 01 | 12/27/12 | TW | ADDRESS CONFIRMATION TIME: 17:00 VRU #: 002319952 |
| | 12/21/12 | AP | 641 DUKE RD DUNN 28334---------- |
| | | | # ON HOME AND BY LONG DRIVE |
| | | | T/S: 12/21/2012 12:36 PM TWARD ---------- |
| B103 01 | 12/27/12 | BS | R*BLDG FOUND & TEMP SVC POLE TIME: 17:00 VRU #: 002319945 |
| | 12/27/12 | AP | T/S: December 27, 2012 11:45 AM BSUTTON ---------- |
| | | | Check damproof at open floor |
| B105 01 | 12/31/12 | KS | R*OPEN FLOOR TIME: 17:00 VRU #: 002321537 |
| | 12/31/12 | AP | T/S: 12/31/2012 08:40 AM DJOHNSON ---------- |
| | | | T/S: 12/31/2012 01:06 PM KSLATTUM ---------- |
| R425 01 | 2/18/13 | TI | FOUR TRADE ROUGH IN TIME: 17:00 VRU #: 002339422 |
| | 2-18 | DH | T/S: 02/14/2013 02:11 PM VBROWN ---------- |

---------- COMMENTS AND NOTES ----------

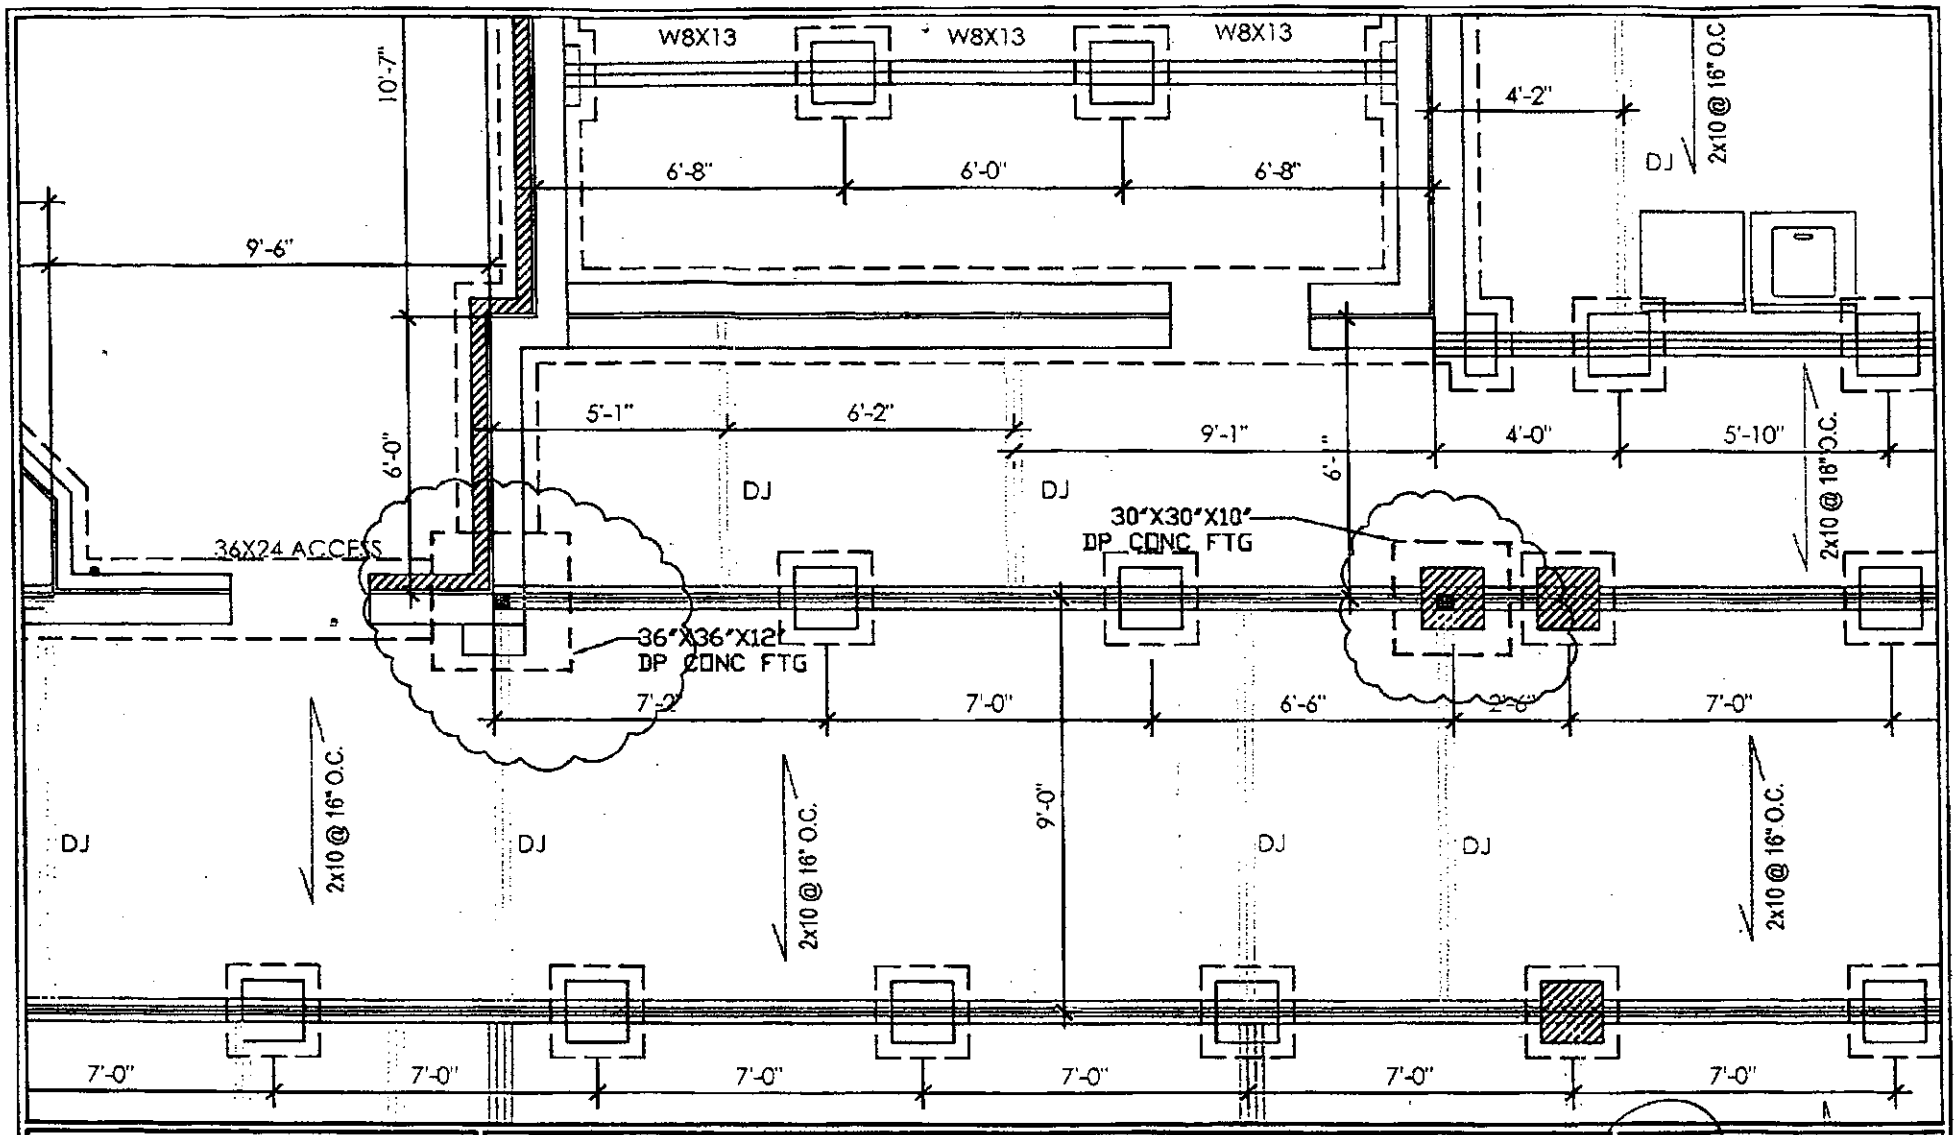


TYNDALL
ENGINEERING & DESIGN, P.A.

T 919 773-1200 • F 919 773-9658
69 Shipwash Drive • Garner • North Carolina • 27529
www.tyndallengineering.com

| NO | DATE | REVISIONS AND RELEASE RECORD | CHK |
|---|---|---|---|
| | | | |
| | | | |
| | | | |
| | | | |

| DRAWN BY | CHECKED BY | DATE | PROJECT NO. |
|---|---|---|---|
| ACS | PAT | 12/13/10 | 1201-010360 |

CLIENT: MATTHEW LEE
880 STICKLANDS CROSSROADS RD
FOUR OAKS, NC 27524

PROJECT: CAULDER RESIDENCE
HARNETTT COUNTY, NC
BRACED WALL LINE LAYOUT

PROJECT NUMBER: 2 of 2

REV: A

NORTH CAROLINA PROFESSIONAL SEAL 025080 ENGINEER PRENTICE A. TYNDALL, JR.
12/13/12

TYNDALL
ENGINEERING & DESIGN, P.A.

t 919 773-1200 • f 919 773-9658
69 Shipwash Drive • Garner • North Carolina • 27529
www.tyndallengineering.com

December 13, 2012

Matthew Lee
880 Sticklands Crossroads Road
Four Oaks, NC 27524
Ph: 919-820-1054

Re.: Foundation
Plan: Caulder Residence
Project No.: 1201-010360

To Whom It May Concern:

As requested, a representative of Tyndall Engineering and Design, PA (TE&D) has reviewed the approved plans for the above referenced project. Specifically, the following items listed were modified:

1) Footings under Great Room Beam plan

The following conclusions and recommendations were presented for the above-mentioned items:

1) Based on our supplemental plan review and analysis, the W8x67 beam above the Great Room shall be supported by a 30"x30"x10" deep concrete footing on the right side and a 36"x36"x12" deep concrete footing on the left side. The reader is referred to the attached sheet.

We appreciate being able to assist you with this project. If you need further assistance or require additional information please do not hesitate to contact us.

Sincerely,
Tyndall Engineering & Design

Arthur Simmons, EI
1201-010360

Prentice Tyndall, Jr. P.E.

NORTH CAROLINA PROFESSIONAL SEAL 024880 ENGINEER PRENTICE A. TYNDALL, JR.
12/13/12