HTE# EH1908-0009

PERMIT # NA

25709

Operation Permit

☐ New Installation ☒ Septic Tank ☐ Nitrification Line ☒ Repair ☐ Expansion

PROPERTY LOCATION: 87 Surfwind Dr. (Elliot Bridge Rd)

Name: (owner) Team Harris Real Estate   SUBDIVISION Tradewinds   LOT # 133

System Installer: Jones Septic   Registration # _____
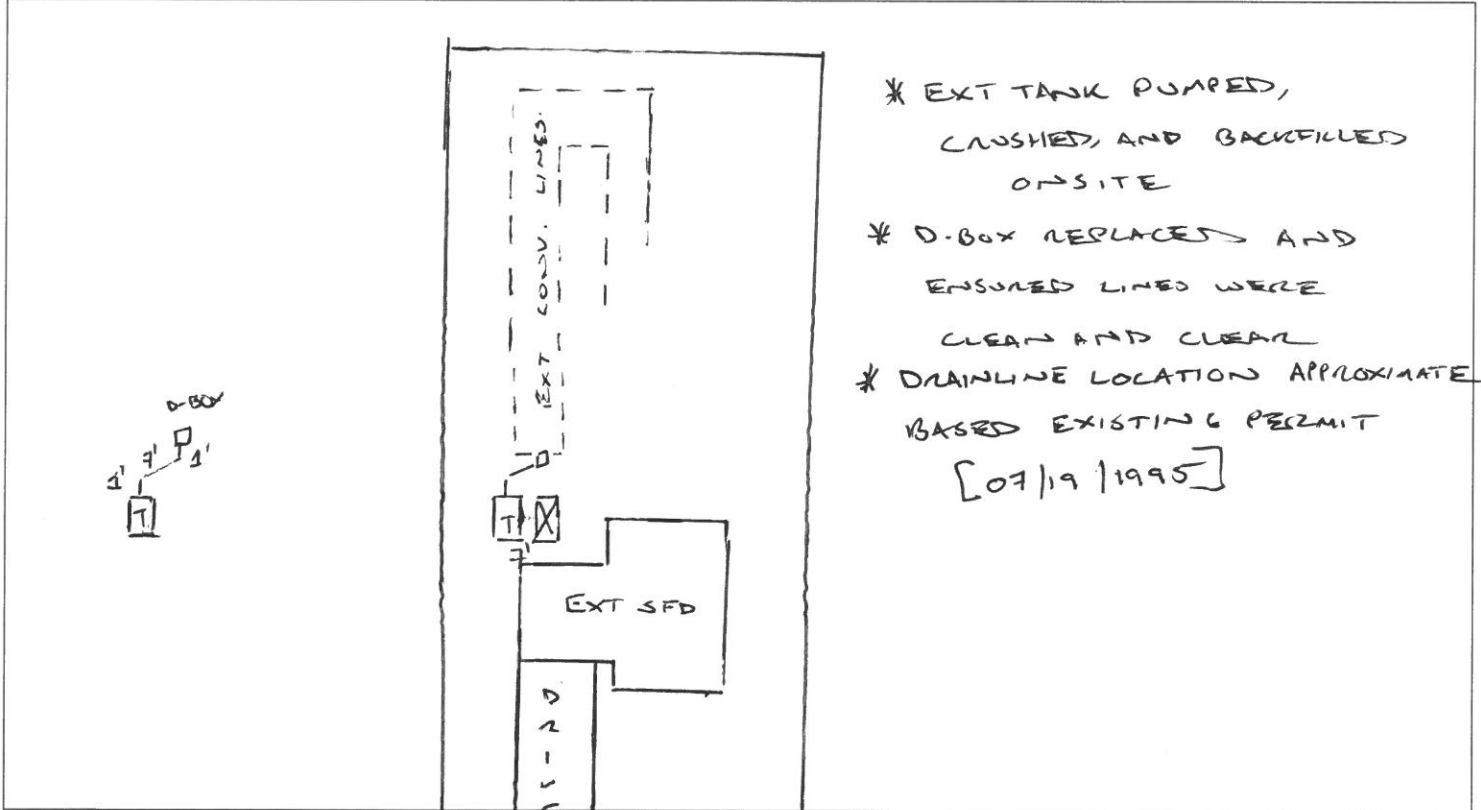
Basement with plumbing: ☐   Garage ☒ Number of Bedrooms 3

Type of Water Supply: ☐ Community ☒ Public ☐ Well   Distance from well NA feet

System Type: 25% reduction System   Types V and VI Systems expire in 5 years.

(In accordance with Table V a)   Owner must contact Health Department 6 months prior to expiration for permit renewal.

This system has been installed in compliance with applicable North Carolina General Statutes, Rules for Sewage Treatment and Disposal, and all conditions of the Improvement Permit and Construction Authorization.

※ EXT TANK PUMPED, CRUSHED, AND BACKFILLED ON SITE

※ D-BOX REPLACED AND ENSURED LINES WERE CLEAN AND CLEAR

※ DRAINLINE LOCATION APPROXIMATE BASED EXISTING PERMIT [07/19/1995]

EXT SFD

SURFWIND DR.

PERMIT CONDITIONS:

I.   Performance: System shall perform in accordance with Rule .1961.

II. Monitoring: As required by Rule .1961.

III. Maintenance: As required by Rule .1961. Other: _____

Subsurface system operator required? Yes ☐ No ☒

If yes, see attached sheet for additional operation conditions, maintenance and reporting.

IV. Operation: _____

V.   Other: _____

☐ _____ D-Box   ☐ _____ Pump   ☐ _____ Alarm   ☐ _____ H20Line   ☐ _____ PWR Line

Following are the specifications for the sewage disposal system on the above captioned property.

Type of system: ☒ Conventional   ☐ Other _____   Septic Tank: 1000 [NEW] gallons   Pump Tank: _____ gallons

Subsurface Drainage Field   No. of ditches 2 [EXT]   exact length of each ditch 120 [EXT] feet   width of ditches 3 [EXT] feet   depth of ditches 32 [EXT] inches

French Drain Required: _____   Linear feet

Authorized State Agent _____ 1645   Date 08/27/2019