

SCOPE OF WORK

TO INSTALL A SOLAR PHOTOVOLTAIC (PV) SYSTEM AT THE OSTERHOUT RESIDENCE, LOCATED AT 42 OAKLAND DRIVE, SANFORD, NORTH CAROLINA. THE POWER GENERATED BY THE PV SYSTEM WILL BE INTERCONNECTED WITH THE UTILITY GRID THROUGH THE NEW ELECTRICAL SERVICE EQUIPMENT. THE PV SYSTEM DOES INCLUDE STORAGE BATTERIES.

SYSTEM RATING

9.480 kW DC STC
7.800 kW AC

EQUIPMENT SUMMARY

(24) MISSION SOLAR MSE395SX9R (395W) PV MODULES
(24) ENPHASE IQ8M-72-M-US [240V] PV INVERTERS



SHEET INDEX


PV-0 COVER
PV-1 SITE MAP AND PV LAYOUT
PV1A RACKING PLAN
PV-2 STRING MAP AND MONITORING LAYOUT
PV-3 ELECTRICAL DIAGRAM
PV-4 EQ WALL
PV-5 MOUNTING DETAIL
PV-6 SYSTEM LABELING DETAIL
PV-7 SITE DIRECTORY PLACARD
PV-8 SAFETY PLAN

GOVERNING CODES


2017 NATIONAL ELECTRICAL CODE
2018 INTERNATIONAL RESIDENTIAL CODE
2018 INTERNATIONAL FIRE CODE
UNDERWRITERS LABORATORIES (UL) STANDARDS
OSHA 29 CFR 1910.269

REVISION B

AS-BUILT INSTALLED IN A DIFFERENT ELECTRICAL CONFIGURATION THAN THE ORIGINAL DESIGN.

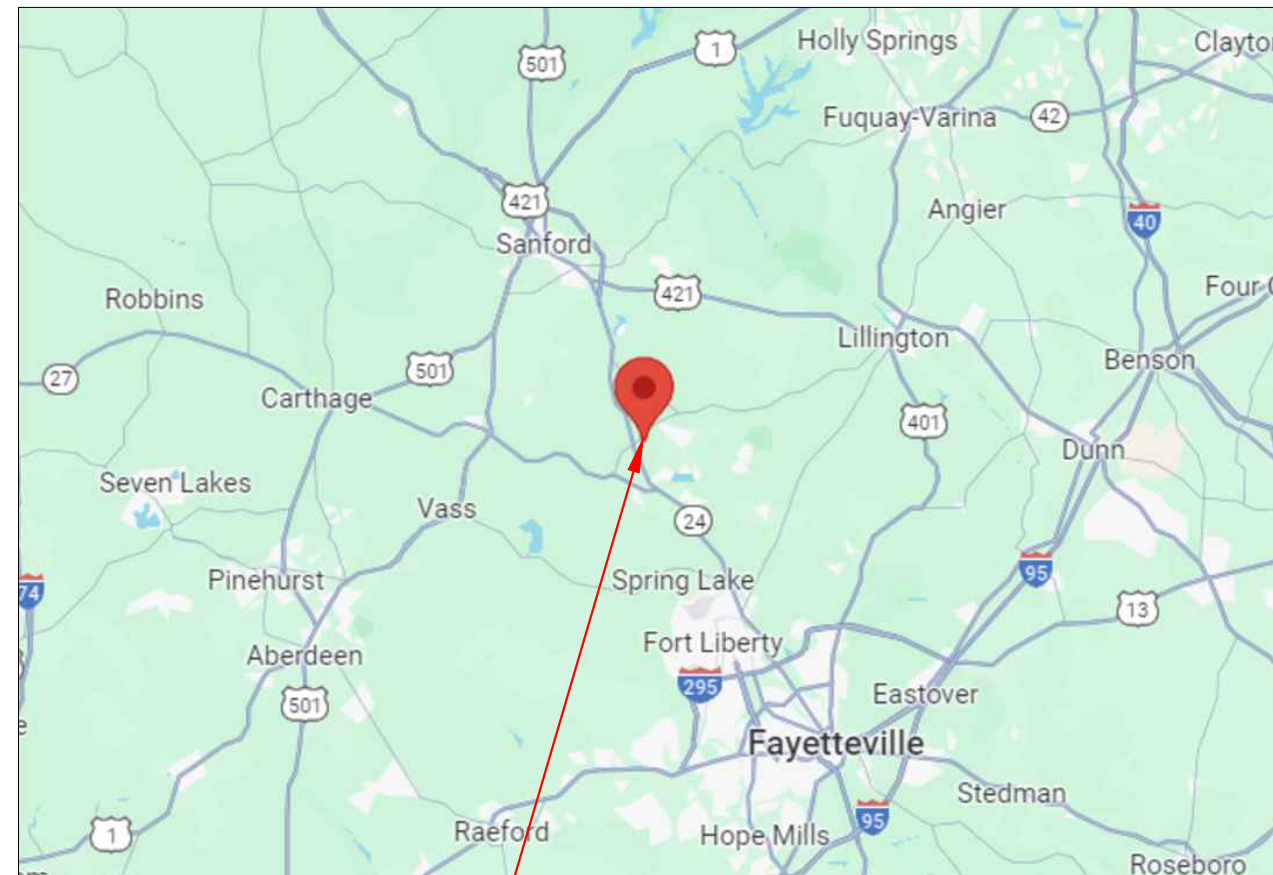

PROJECT LOCATION

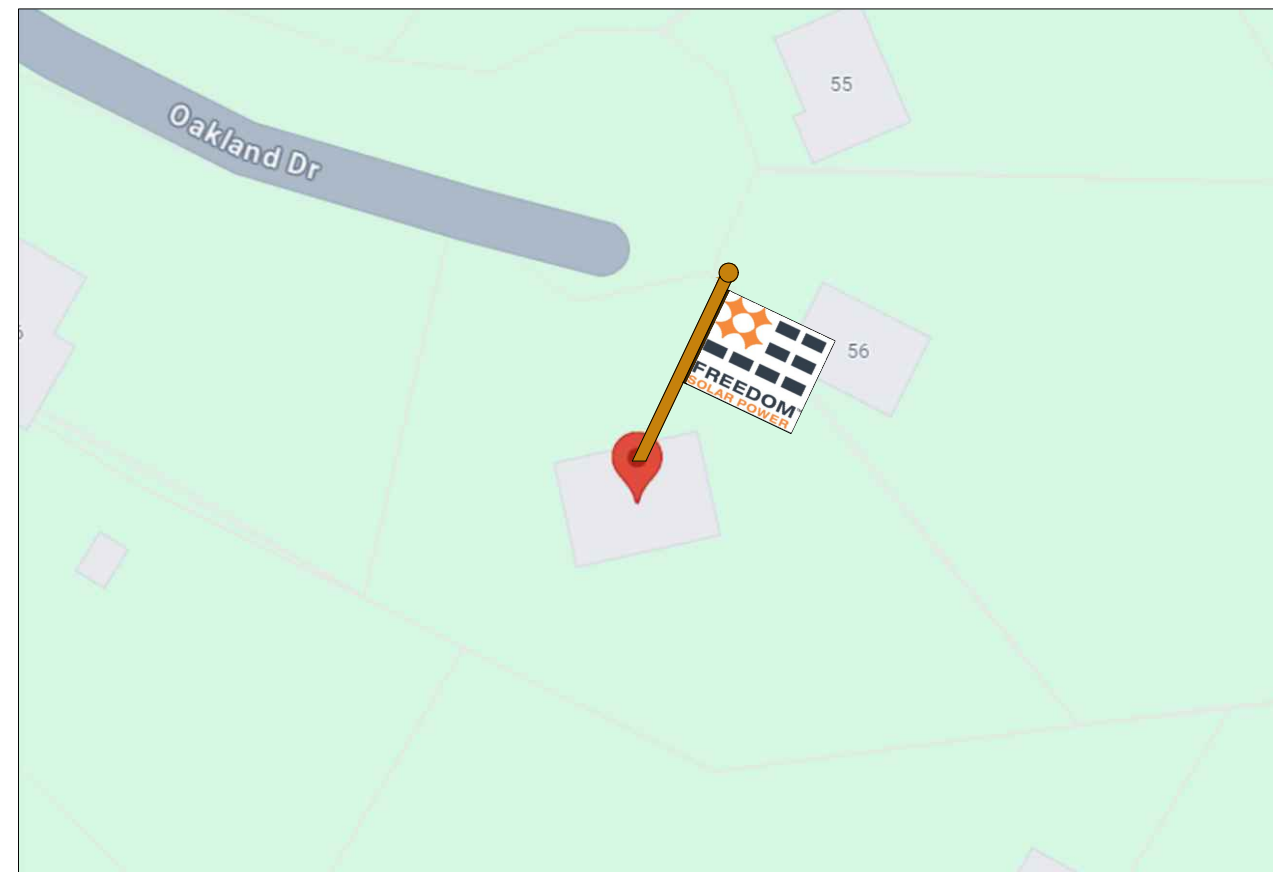

VICINITY MAP

CONTRACTOR

FREEDOM SOLAR POWER
FREEDOM SOLAR LLC
4801 FREDRICH LN, STE 100
AUSTIN, TX 78744
512-759-8313
TECL # 28621

REVISIONS		
DESCRIPTION	DATE	REV
DESIGN PACKET	05/31/2024	-
REVISION	06/03/2024	A
REVISION	11/11/2024	B

PE STAMP

PROJECT NAME

LEE T OSTERHOUT
42 OAKLAND DRIVE
SANFORD, NORTH CAROLINA,
27332
(910) 885-2872
PROJECT ID: 114630

SHEET NAME

COVER

SHEET SIZE

ANSI B
11" x 17"

SHEET NUMBER

PV-0

LEAD ID: 114630

CONSTRUCTION SUMMARY

- (24) (MISSION SOLAR MSE395SX9R (395W)) SOLAR MODULES, 9.480 kW DC STC
MODULE DIMENSIONS = 41.5" X 75.1" X 1.57"
- (24) ENPHASE IQ8M-72-M-US [240V] PV INVERTERS
COMBINED INVERTER OUTPUT = 7.800 kW AC.
- (01) TESLA POWERWALL 3 1707000-XX-Y [240V] PV INVERTER
- (01) TESLA ENERGY GATEWAY -2

RACKING: PEGASUS RAIL
ATTACHMENT: PEGASUS INSTAFLASH

SITE DETAILS

ROOF TYPE: ASPHALT SHINGLE
ARRAY #1 - TILT = 34°, AZIMUTH = 168°
ARRAY #2 - TILT = 34°, AZIMUTH = 168°

NOTE : PE STAMPS REQUIRED IF:
-WEIGHT OF ARRAY IS >3PSF
-MORE THAN 1-LAYER OF SHINGLE
-ROOF TYPE IS OTHER THAN COMP SHINGLES
-WIND SPEED IS GREATER THAN 140 MPH
IF DESIGN PACK IS NOT STAMPED, MUST
INCLUDE EXCEPTION STATEMENT IN RED:

-PANEL WEIGHT EQUALS 2.5 LBS PER SQ FT,
LESS THAN 3 LBS PER SQ FT.


NO CUTTING AND COVERING PLUMBING VENTS AT ALL,
PVC PIPES CAN BE RELOCATED WITH ROOF JACK.

-UTILITY SHUTDOWN NEEDED TO INSTALL TESLA
ENERGY GATEWAY-2 & SERVICE REBUILD

FALL PROTECTION REQUIRED

CONSTRUCTION NOTES

- 1.) ALL EQUIPMENT SHALL BE INSTALLED IN ACCORDANCE WITH THE MANUFACTURER'S INSTALLATION INSTRUCTIONS.
- 2.) ALL OUTDOOR EQUIPMENT SHALL BE RAIN TIGHT WITH MINIMUM NEMA 3R RATING.
- 3.) ALL LOCATIONS ARE APPROXIMATE AND REQUIRE FIELD VERIFICATION.

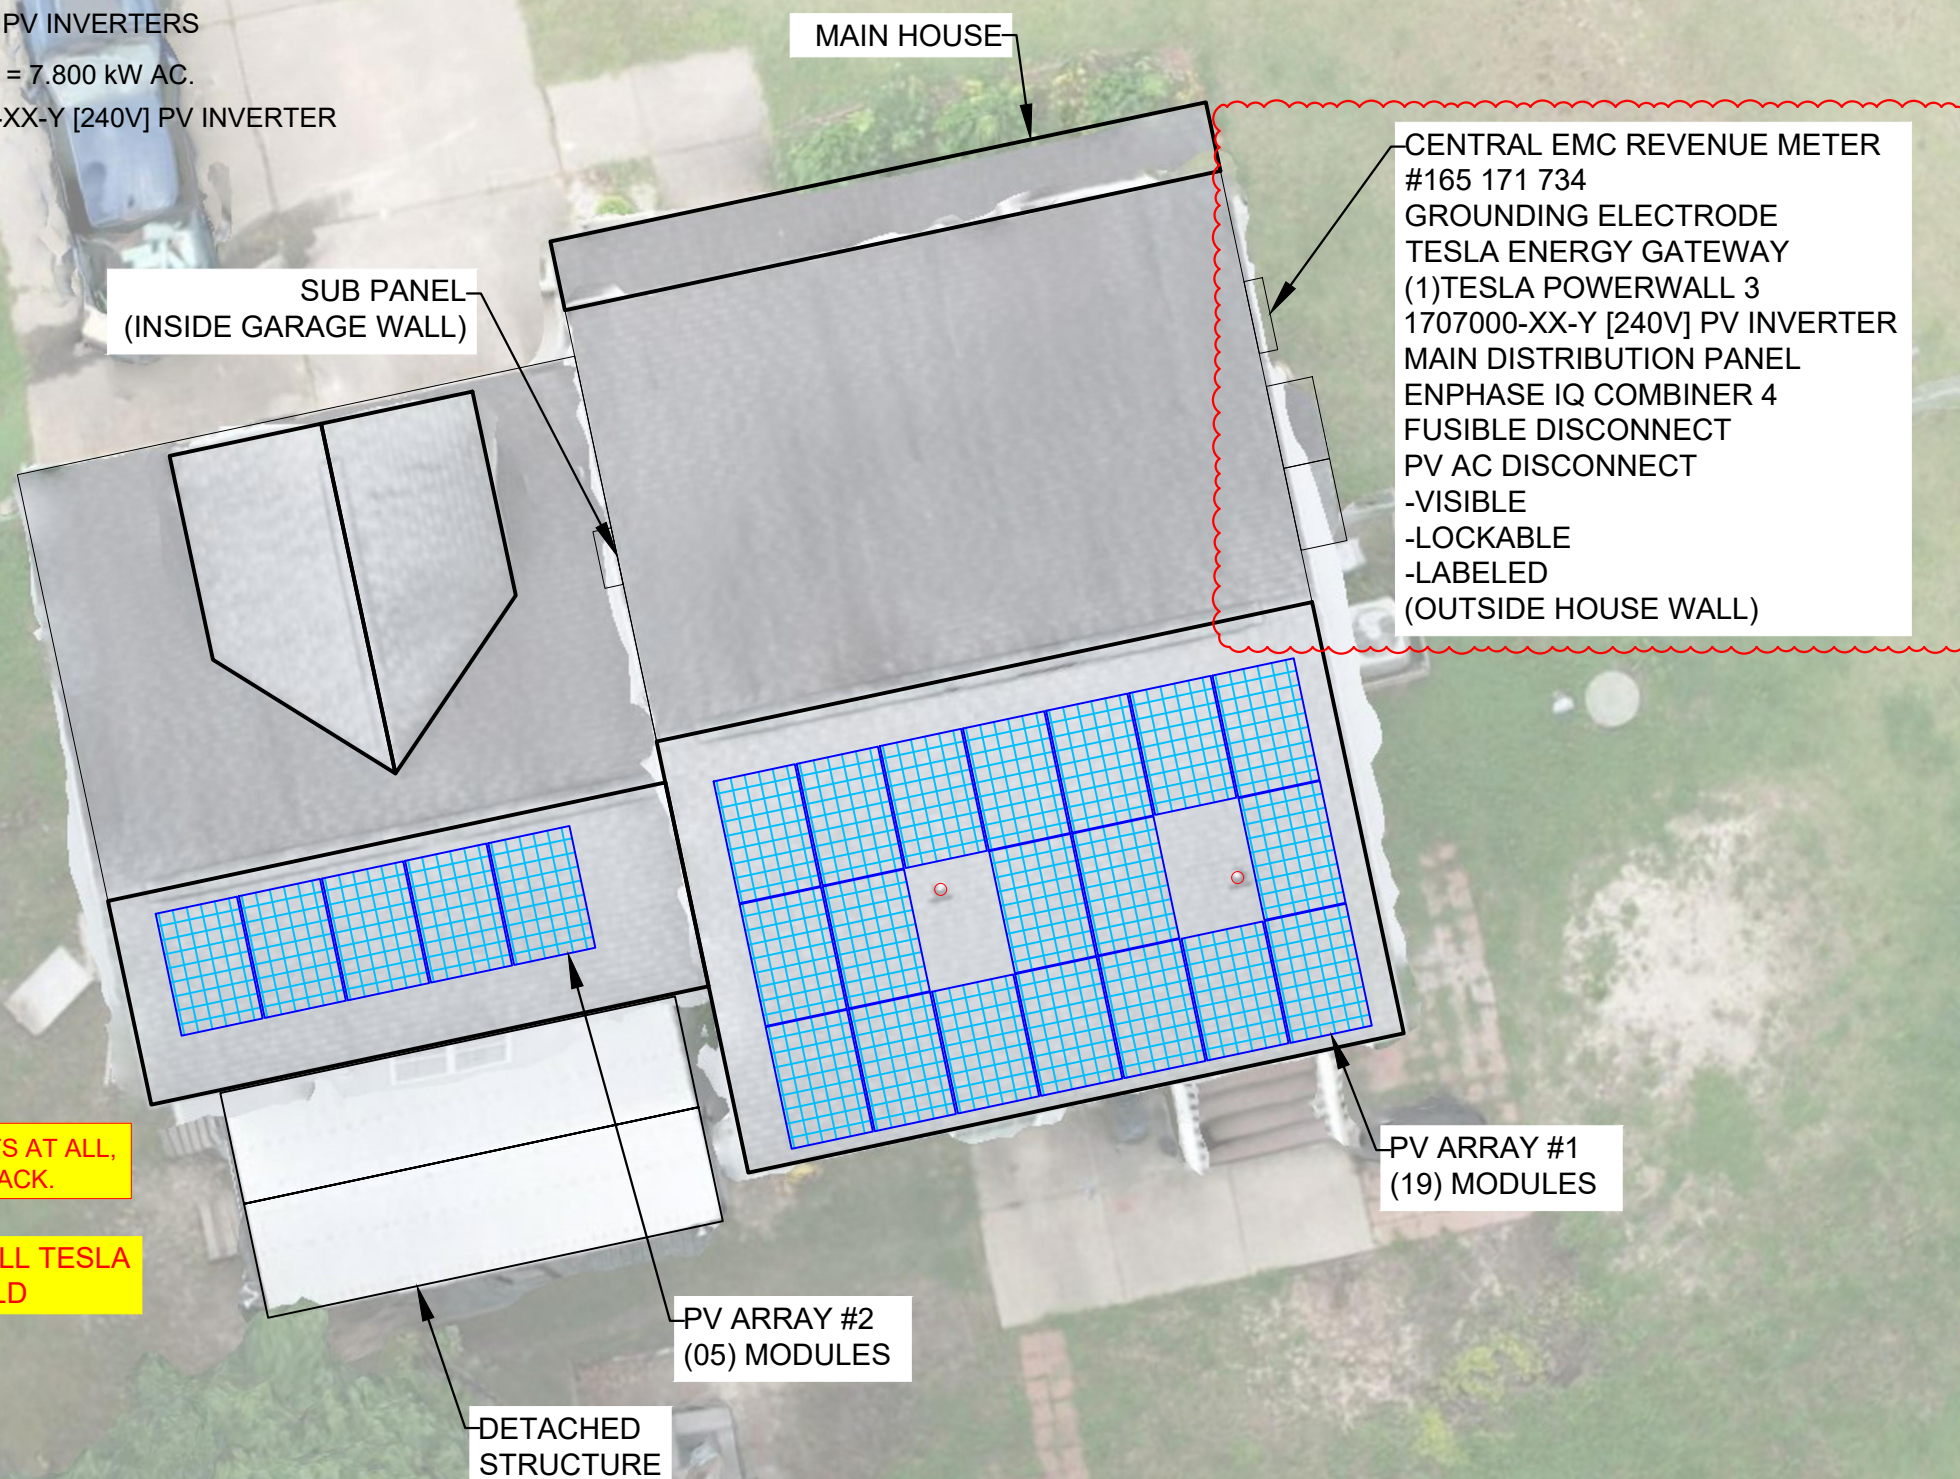

CONTRACTOR

FREEDOM SOLAR POWER
FREEDOM SOLAR LLC
4801 FREDRICH LN, STE 100
AUSTIN, TX 78744
512-759-8313
TECL # 28621

REVISIONS

DESCRIPTION	DATE	REV
DESIGN PACKET	05/31/2024	-
REVISION	06/03/2024	A
REVISION	11/11/2024	B


PE STAMP

PROJECT NAME
**LEE T OSTERHOUT
42 OAKLAND DRIVE
SANFORD, NORTH CAROLINA,
27332**
(910) 885-2872
PROJECT ID: 114630

SHEET NAME
**SITE MAP &
PV LAYOUT**

SHEET SIZE
**ANSI B
11" x 17"**

SHEET NUMBER
PV-1

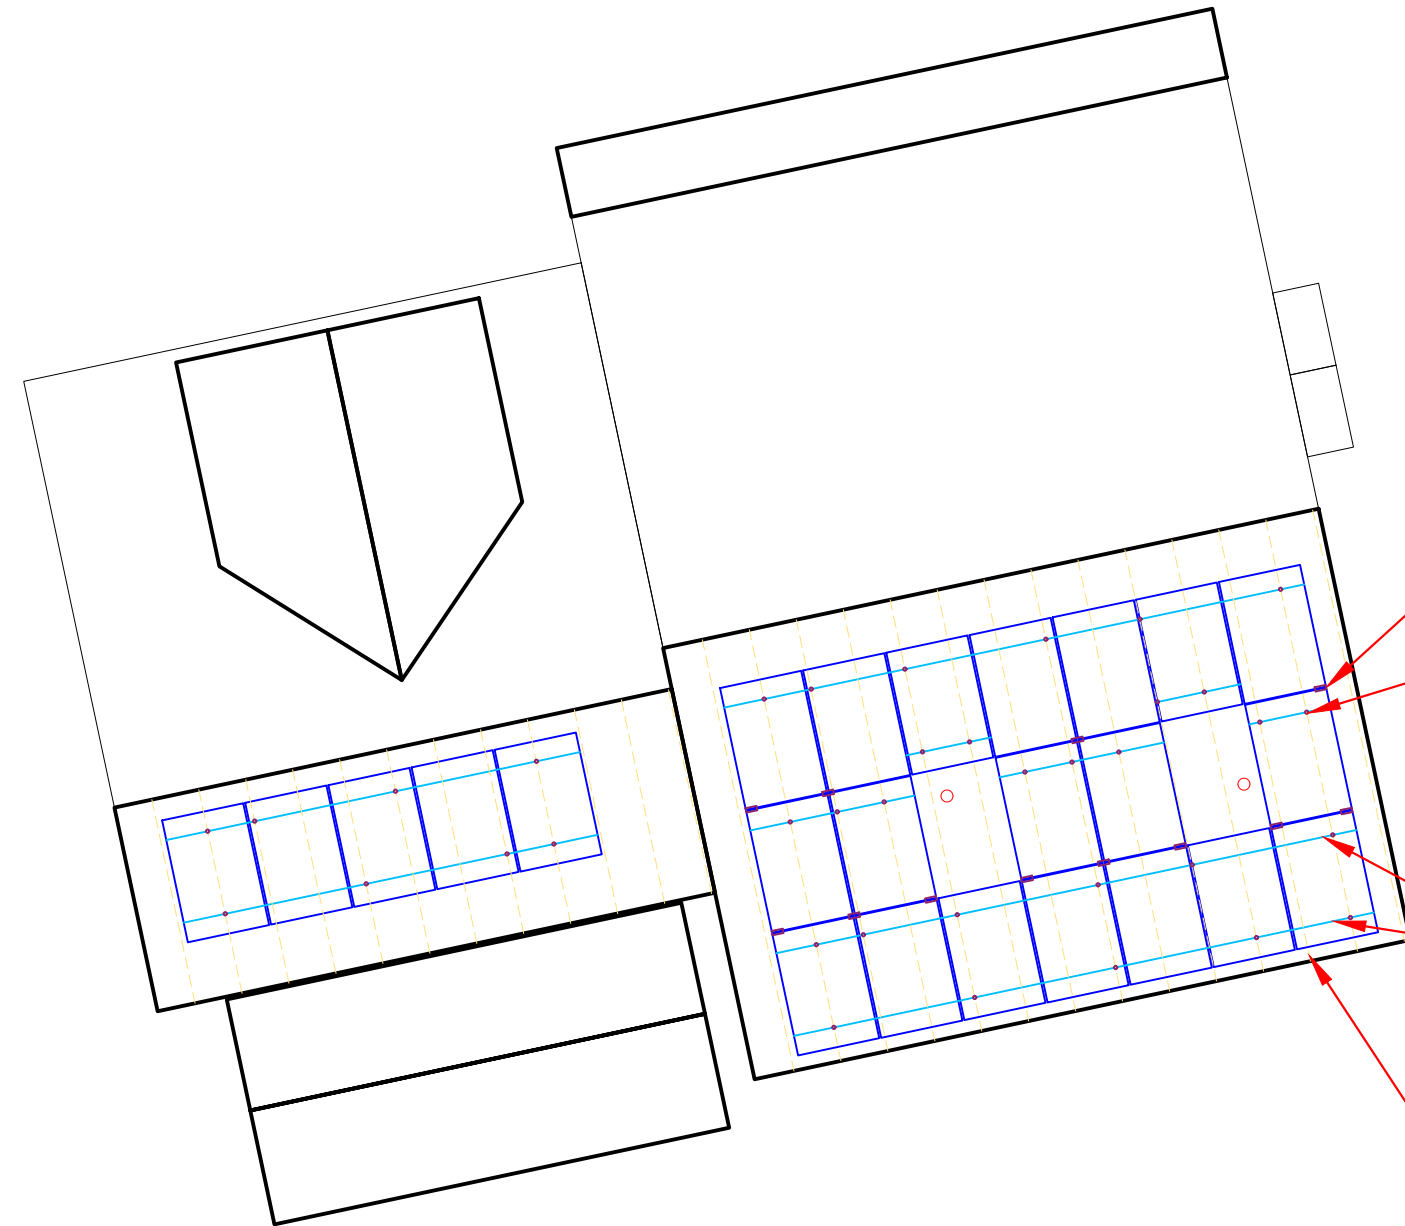

PEGASUS SKIP RAIL CLAMP

PEGASUS INSTAFLASH BLACK,
5/16" X 4.0" SS LAG WITH MIN.
2.5" EMBEDMENT INTO THE FRAMING
AT MAX 48" & 72" O.C. ALONG RAILS

(2)PEGASUS RAIL SYSTEM
REFER TO PEGASUS
ENGINEERING PACKET
FOR RAIL AND CLAMP LOCATIONS

2"X4" MANUFACTURED
TRUSSES AT 24" O.C. TYP.

CONTRACTOR

**FREEDOMTM
SOLAR POWER**

FREEDOM SOLAR LLC
4801 FREDRICH LN, STE 100
AUSTIN, TX 78744
512-759-8313
TECL # 28621

REVISIONS		
DESCRIPTION	DATE	REV
DESIGN PACKET	05/31/2024	-
REVISION	06/03/2024	A
REVISION	11/11/2024	B

PE STAMP

PROJECT NAME

LEE T OSTERHOULT
42 OAKLAND DRIVE
SANFORD, NORTH CAROLINA,
27332
(910) 885-2872
PROJECT ID: 114630

SHEET NAME

RACKING PLAN

SHEET SIZE


ANSI B
11" x 17"

SHEET NUMBER

PV-1A

CONSTRUCTION NOTES

- 1.) ALL EQUIPMENT SHALL BE INSTALLED IN ACCORDANCE WITH THE MANUFACTURER'S INSTALLATION INSTRUCTIONS.
- 2.) ALL OUTDOOR EQUIPMENT SHALL BE RAINTIGHT WITH MINIMUM NEMA 3R RATING.
- 3.) ALL LOCATIONS ARE APPROXIMATE AND REQUIRE FIELD VERIFICATION.

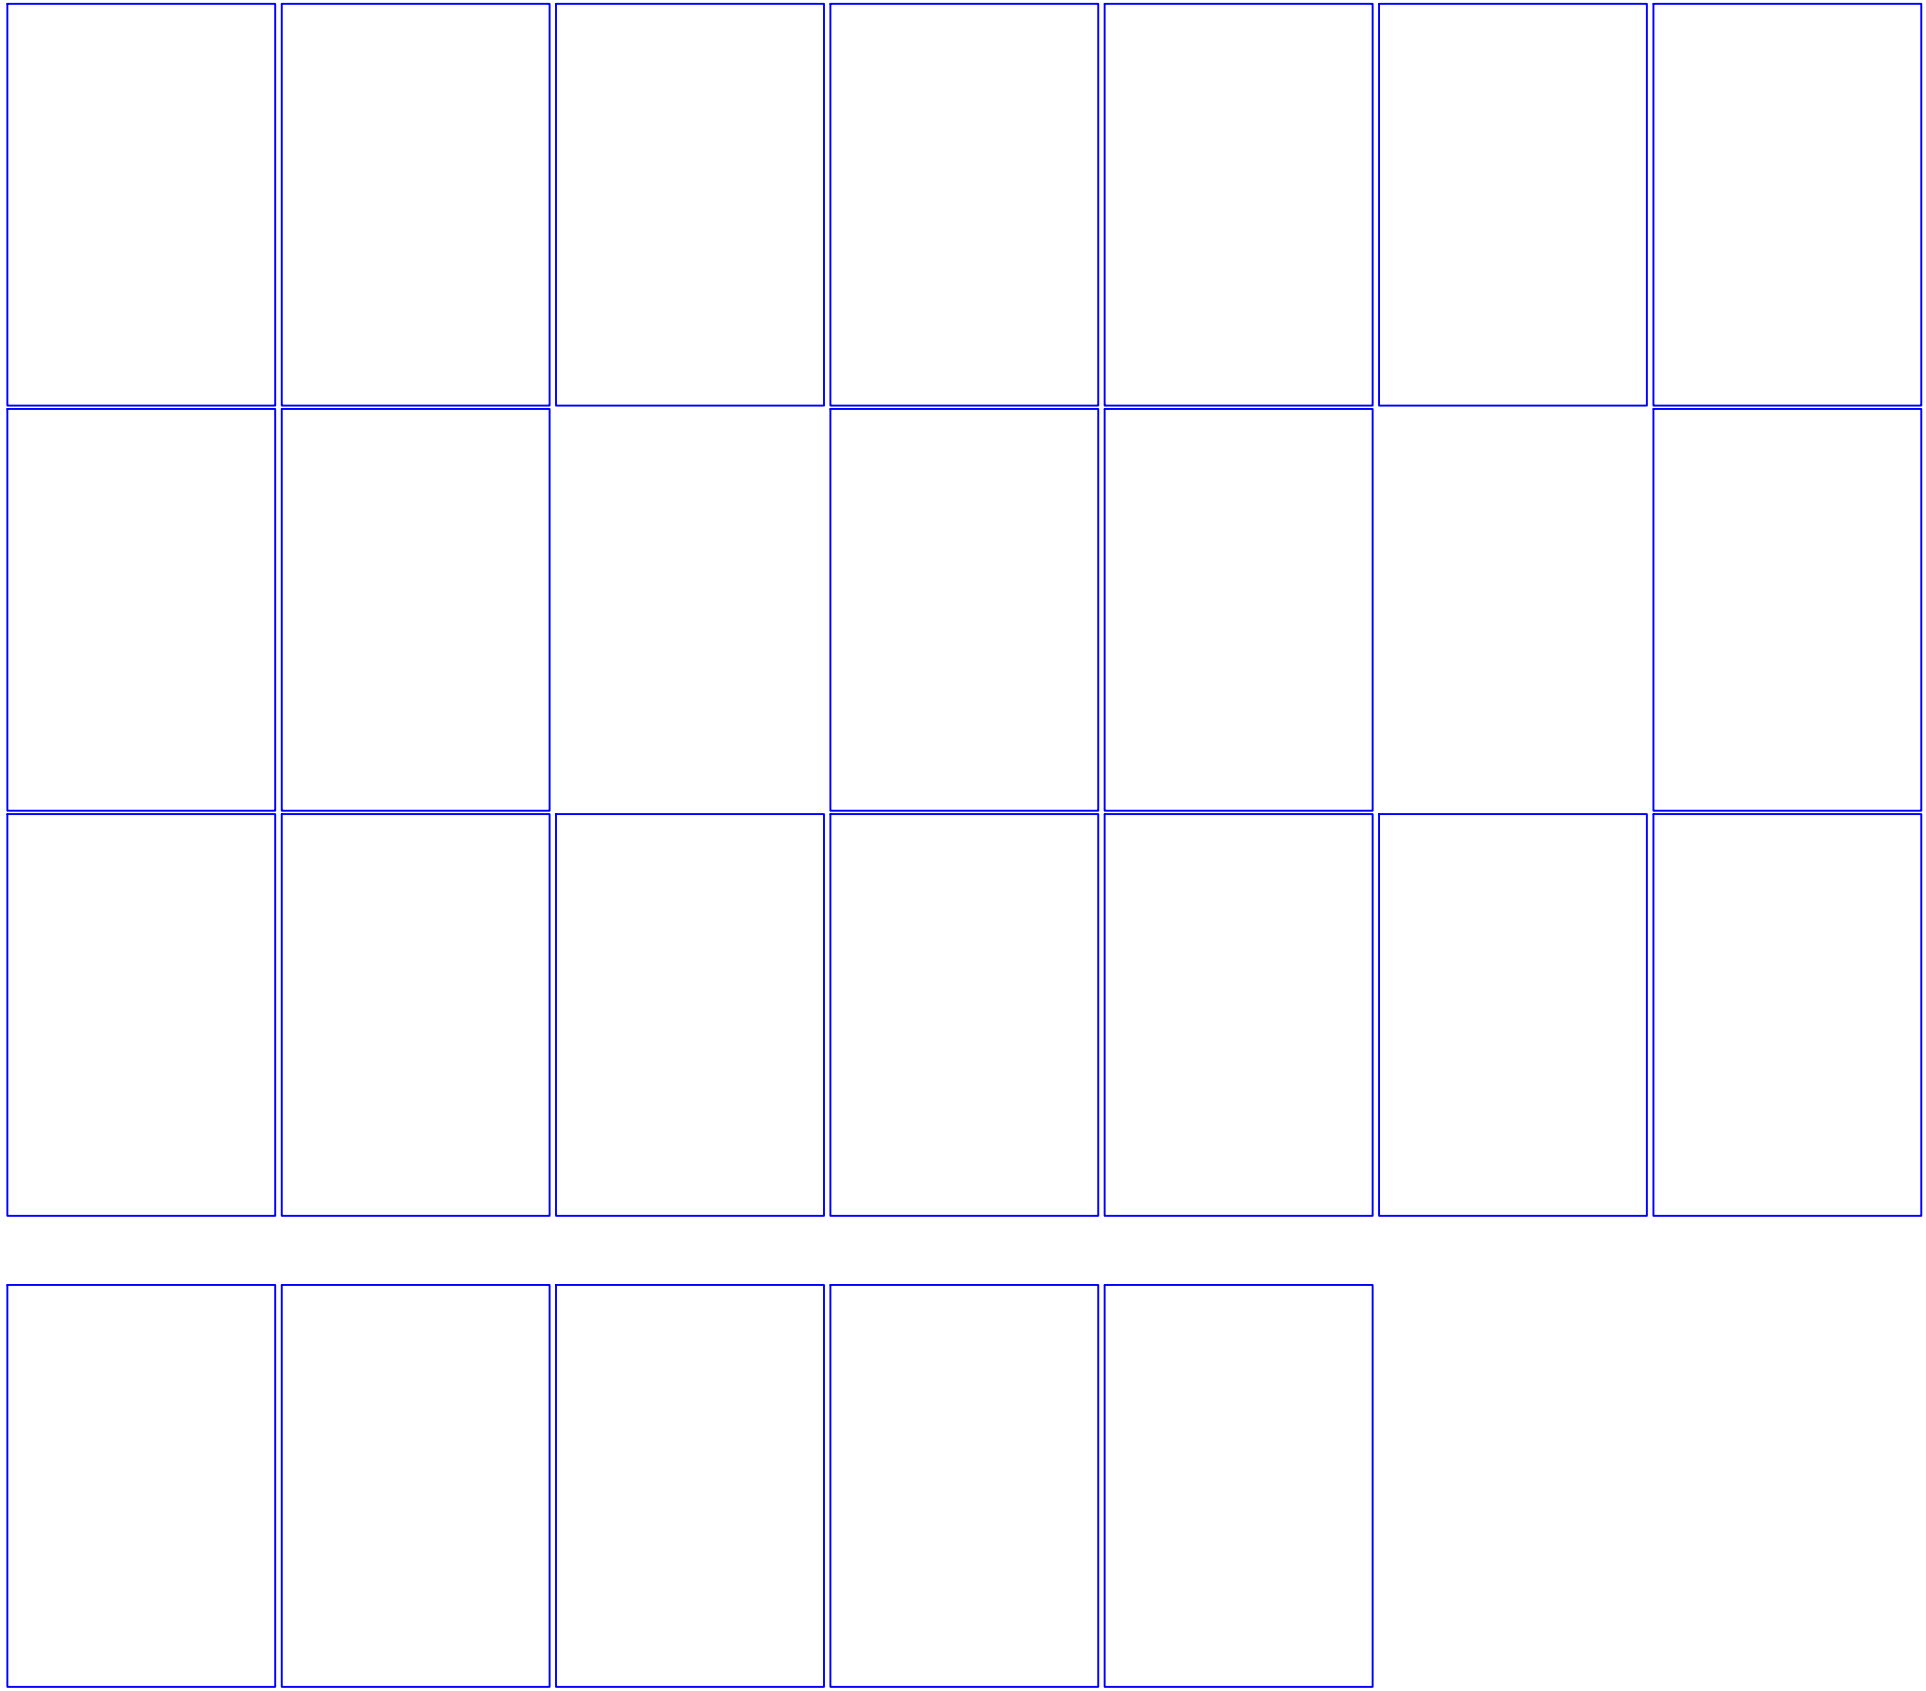

CONTRACTOR

**FREEDOM[™]
SOLAR POWER**

FREEDOM SOLAR LLC
4801 FREIDRICH LN, STE 100
AUSTIN, TX 78744
512-759-8313
TECL # 28621

REVISIONS

DESCRIPTION	DATE	REV
DESIGN PACKET	05/31/2024	-
REVISION	06/03/2024	A
REVISION	11/11/2024	B

PE STAMP

PROJECT NAME

**LEE T OSTERHOUT
42 OAKLAND DRIVE
SANFORD, NORTH CAROLINA,
27332
(910) 885-2872
PROJECT ID: 114630**

SHEET NAME

**STRING MAP &
MONITORING
LAYOUT**

SHEET SIZE


**ANSI B
11" x 17"**

SHEET NUMBER

PV-2

ENPHASE ENVOY S/N _____

SOLAR ARRAY - 9.480 KW DC STC, 7.800 KW AC, 1-PHASE
 (24) MISSION SOLAR MSE395SX9R (395W) PV MODULES
 (24) ENPHASE IQ8M-72-M-US [240V] PV INVERTERS

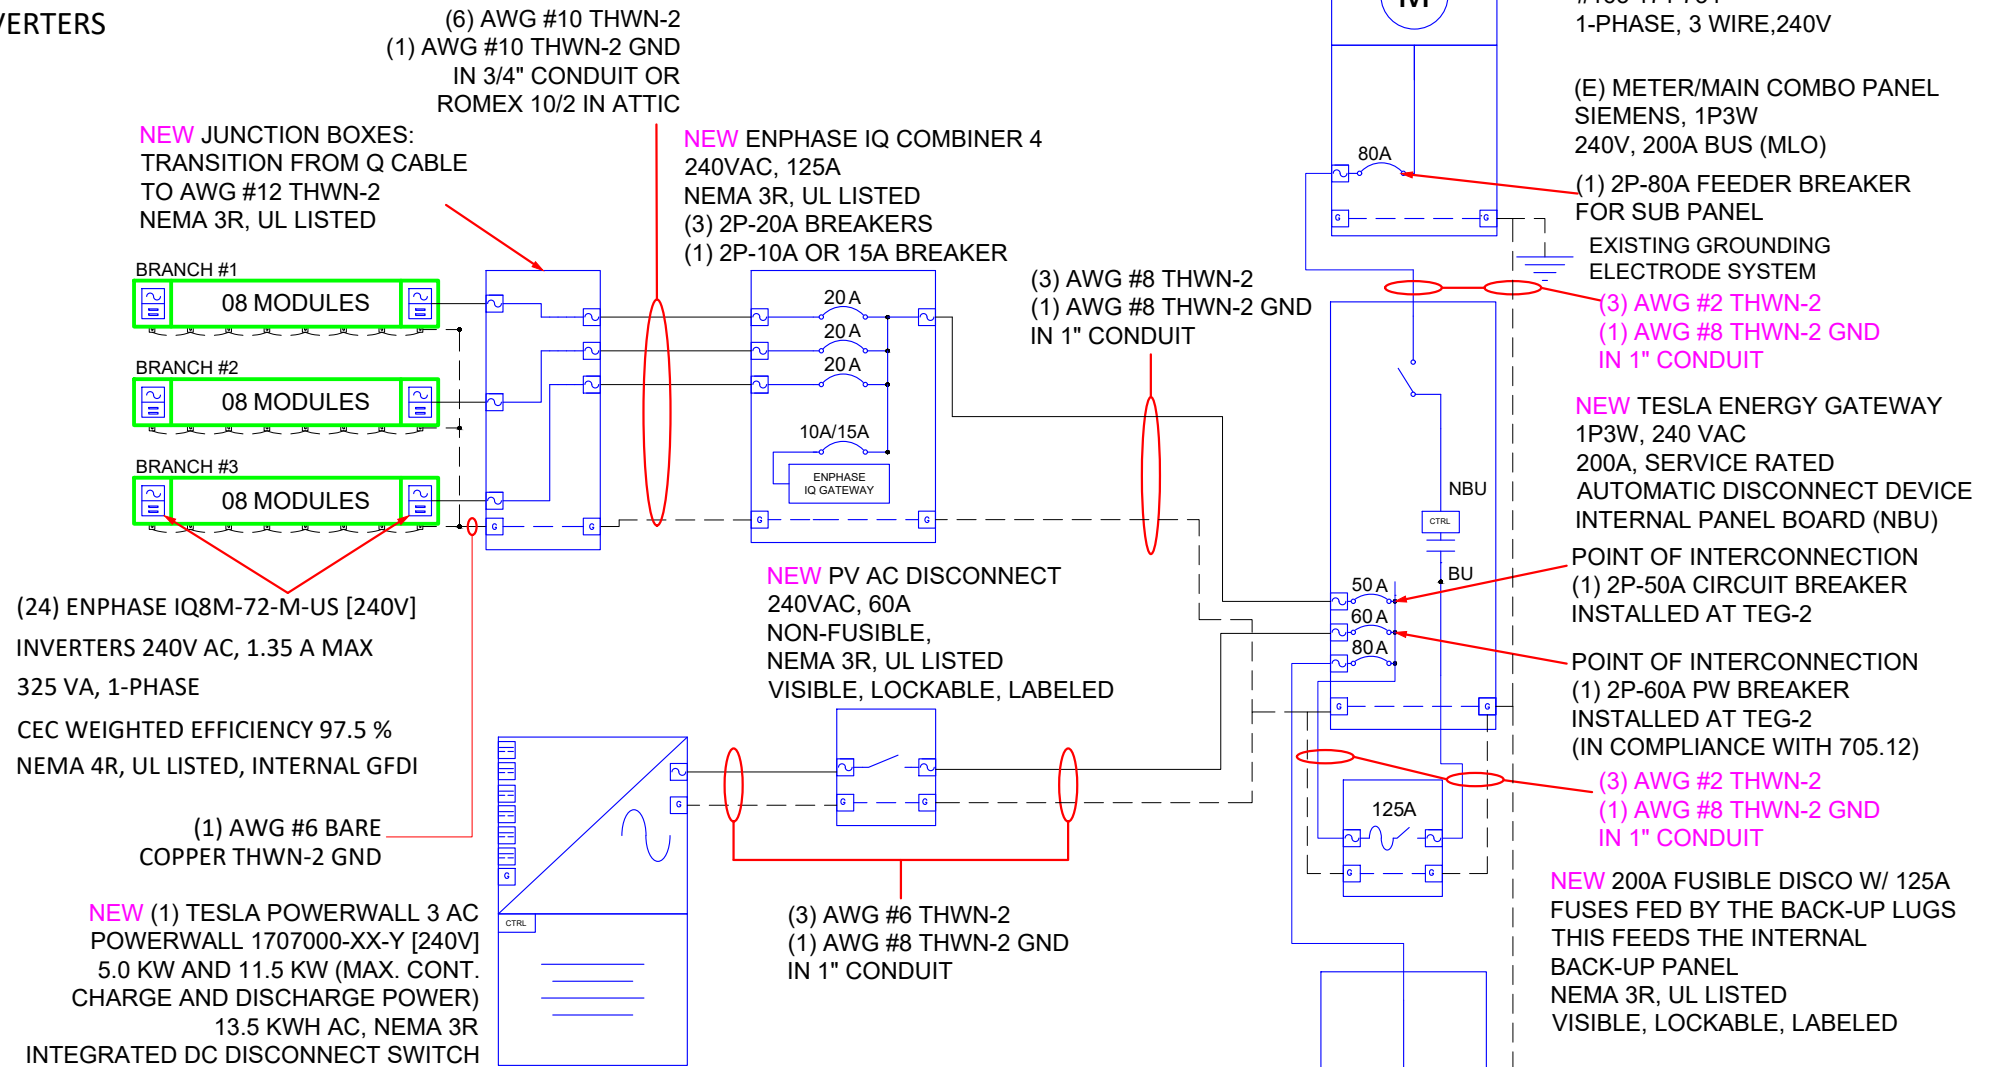

-UTILITY SHUTDOWN NEEDED TO INSTALL TESLA ENERGY GATEWAY-2 & SERVICE REBUILD

ELECTRICAL NOTES

- 1.) ALL EQUIPMENT TO BE LISTED BY UL OR OTHER NRTL, AND LABELED FOR ITS APPLICATION.
- 2.) ALL CONDUCTORS SHALL BE COPPER. ALUMINUM CONDUCTORS MAY BE USED IF CORRECTLY UPSIZED FOR AMPACITY RATING PER NEC 310.12 OR 310.16. ALL CONDUCTORS SHALL BE RATED FOR 600V AND 90°C WET ENVIRONMENT UNLESS OTHERWISE NOTED.
- 3.) WORKING CLEARANCES AROUND ALL NEW AND EXISTING ELECTRICAL EQUIPMENT SHALL COMPLY WITH NEC 110.26.
- 4.) DRAWINGS INDICATE THE GENERAL ARRANGEMENT OF SYSTEMS. CONTRACTOR SHALL FURNISH ALL NECESSARY OUTLETS, SUPPORTS, FITTINGS AND ACCESSORIES TO FULFILL APPLICABLE CODES AND STANDARDS.
- 5.) WHERE SIZES OF JUNCTION BOXES, RACEWAYS, AND CONDUITS ARE NOT SPECIFIED, THE CONTRACTOR SHALL SIZE THEM ACCORDINGLY. SPECIFIED CONDUIT AND WIRE SIZES ARE MINIMUM REQUIREMENTS AND LARGER SIZES SHALL BE PERMITTED.
- 6.) ALL WIRE TERMINATIONS SHALL BE APPROPRIATELY LABELED AND READILY VISIBLE.
- 7.) MAXIMUM MOUNTING HEIGHT FROM GRADE TO CENTER OF METER SOCKET SHALL BE 72" FOR RESIDENTIAL SINGLE PHASE METER SOCKETS 0-320 AMPS. MINIMUM MOUNTING HEIGHT IS 30" FROM FOR AUSTIN ENERGY, AND 48" FOR ALL OTHER JURISDICTIONS
- 8.) MINIMUM HORIZONTAL CLEARANCE FROM GAS REGULATOR TO ANY ELECTRICAL ENCLOSURE IS 36", EXCEPT AUSTIN ENERGY WHICH REQUIRES 48" CLEARANCE FROM GAS TO METER SOCKET
- 9.) PV DISCONNECT SHALL BE VISIBLE, LOCKABLE AND LABELED AND THE DOOR CANNOT BE OPENED WHEN HANDLE IS IN ON POSITION
- 10.) BY DEFAULT THE MONITORING DEVICE IS SHOWN CONNECTED TO A 20-AMP BREAKER IN THE SOLAR LOAD CENTER. ALTERNATIVELY, THE MONITORING DEVICE MAY BE CONNECTED TO A 20-AMP BREAKER AT THE MAIN DISTRIBUTION PANEL.
- 11.) ALL EQUIPMENT TERMINATIONS SHALL BE RATED FOR 75 DEGREES OR GREATER
- 12.) ALL CT WIRES SHALL BE CONSIDERED CLASS 1 PER NEC ARTICLE 725, AND BE MARKED AS RATED FOR 600V. PER 725.48(A) CLASS 1 CIRCUITS SHALL BE PERMITTED TO OCCUPY THE SAME RACEWAY AS OTHER CIRCUITS PROVIDED ALL CONDUCTORS ARE INSULATED FOR THE MAXIMUM VOLTAGE OF ANY CONDUCTOR IN THE RACEWAY.
- 13.) AWG #10 COPPER CONDUCTORS ARE SPECIFIED AS THE DEFAULT WIRE REQUIRED FROM THE PV ARRAY TO THE SOLAR LOAD CENTER, HOWEVER, AWG #12 COPPER CONDUCTORS MAY BE UTILIZED IF BOTH OF THE FOLLOWING CONDITIONS ARE MET: THE LENGTH OF THE CONDUCTOR IS LESS THAN 75 FT AND THERE ARE LESS THAN 8 CURRENT-CARRYING CONDUCTORS WITHIN THE RACEWAY.

CALCULATIONS FOR CURRENT CARRYING CONDUCTORS	CALCULATIONS FOR OVERCURRENT DEVICES
<p>INVERTER OUTPUT WIRE AMPACITY CALCULATION [NEC 690.8(A)(3)]: 1.35A PER INVERTER ENPHASE IQ8M-72-M-US [240V] MAXIMUM INVERTER BRANCH CURRENT = (11)(1.35A) = 14.85A CONTINUOUS USE: #10 WIRE 75°C DERATED AMPACITY = (0.80)(35.0A) = 28.0A 28.0A > 14.85A CONDITIONS OF USE: #10 WIRE 90°C DERATED AMPACITY = (0.91)(0.80)(40.0A) = 29.12A 29.12A > 14.85A</p> <p>ENPHASE IQ COMBINER 4 WIRE AMPACITY CALCULATION [NEC 690.8(A)(3)]: 1.35A PER INVERTER ENPHASE IQ8M-72-M-US [240V] 48.0A PER TESLA POWERWALL 3 BATTERY INVERTER COMBINED CURRENT = (24)(1.35A) = 32.4A CONTINUOUS USE: #8 WIRE 75°C DERATED AMPACITY = (0.80)(50A) = 40.00A 40.00A > 32.4A CONDITIONS OF USE: #8 WIRE 90°C DERATED AMPACITY = (0.91)(55A) = 50.05A 50.05A > 32.4A</p>	<p>INVERTER BRANCH AC CURRENT CALCULATION [NEC 690.8(A)(3)]: 1.35A PER INVERTER ENPHASE IQ8M-72-M-US [240V] MAXIMUM BRANCH INVERTER CURRENT = (11)(1.35A) = 14.85A MINIMUM OCPD = (14.85A)(1.25) = 18.56A USE 2P-20A BREAKERS IN ENPHASE IQ COMBINER 4 FOR INVERTER BRANCH OCPD</p> <p>SYSTEM AC CURRENT CALCULATION [NEC 690.8(A)(3)]: 1.35A PER INVERTER ENPHASE IQ8M-72-M-US [240V] 48.0A PER TESLA POWERWALL 3 BATTERY INVERTER COMBINED CURRENT = (24)(1.35A) = 32.4A MINIMUM OCPD = (32.4A)(1.25) = 40.5A USE 2P-50A BREAKER IN TEG FOR SYSTEM OCPD</p> <p>CALCULATION FOR OVERCURRENT POWERWALL DEVICES</p> <p>TESLA POWERWALL OUTPUT CURRENT CALCULATION 48.0A PER TESLA POWERWALL 3 BATTERY INVERTER COMBINED CURRENT = (1)(48.0A) = 48.0A MINIMUM OCPD = (48.0A)(1.25) = 60.0A USE (1) 2P-60A BREAKER IN TEG FOR POWERWALL OCPD</p>

CONTRACTOR

FREEDOM SOLAR POWER

FREEDOM SOLAR LLC
 4801 FREIDRICH LN, STE 100
 AUSTIN, TX 78744
 512-759-8313
 TECL # 28621

REVISIONS

DESCRIPTION	DATE	REV
DESIGN PACKET	05/31/2024	-
REVISION	06/03/2024	A
REVISION	11/11/2024	B

PE STAMP

PROJECT NAME

LEE T OSTERHOUT
 42 OAKLAND DRIVE
 SANFORD, NORTH CAROLINA,
 27332
 (910) 865-2872
 PROJECT ID: 114630

SHEET NAME

ELECTRICAL DIAGRAM

SHEET SIZE

**ANSI B
 11" x 17"**

SHEET NUMBER

PV-3

CONTRACTOR



**FREEDOMTM
SOLAR POWER**

FREEDOM SOLAR LLC
4801 FREIDRICH LN, STE 100
AUSTIN, TX 78744
512-759-8313
TECL # 28621

REVISIONS

DESCRIPTION	DATE	REV
DESIGN PACKET	05/31/2024	-
REVISION	06/03/2024	A
REVISION	11/11/2024	B

PE STAMP

PROJECT NAME

LEE T OSTERHOUT
42 OAKLAND DRIVE
SANFORD, NORTH CAROLINA,
27332
(910) 885-2872
PROJECT ID: 114630

SHEET NAME


EQ.WALL

SHEET SIZE

ANSI B
11" x 17"

SHEET NUMBER

PV-4

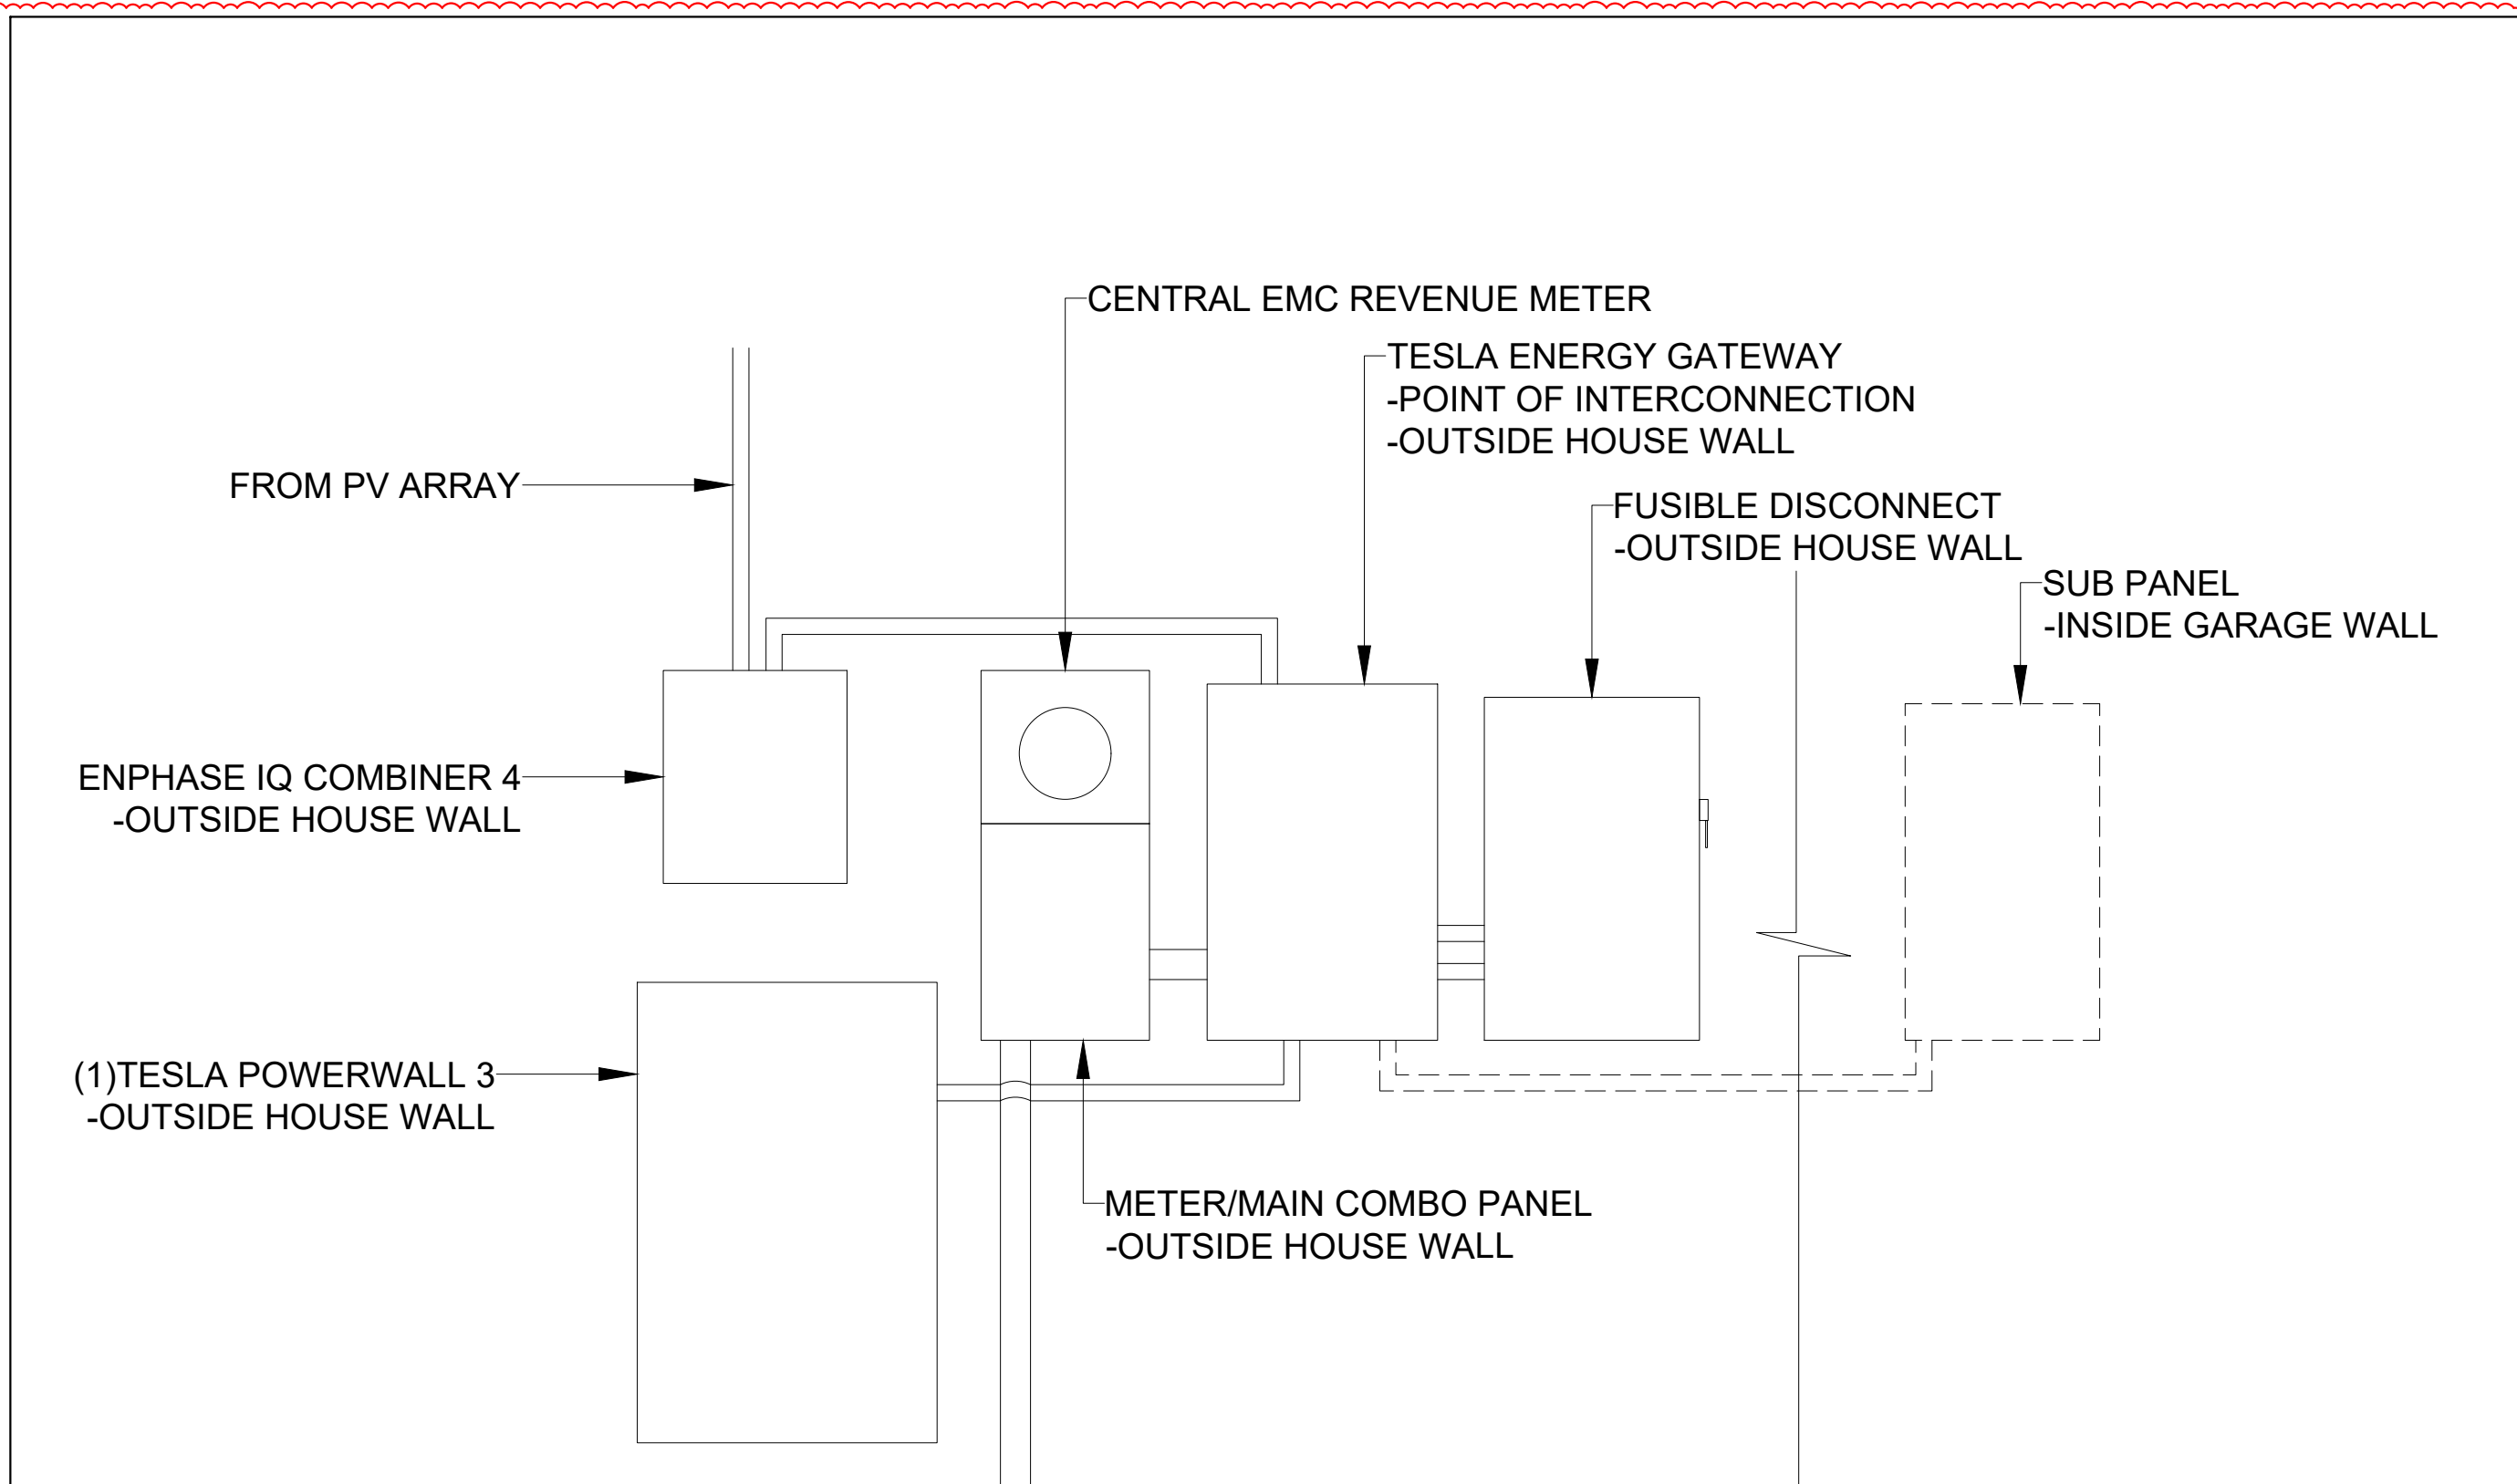

CONTRACTOR



**FREEDOM™
SOLAR POWER**

FREEDOM SOLAR LLC
4801 FREIDRICH LN, STE 100
AUSTIN, TX 78744
512-759-8313
TECL # 28621

REVISIONS		
DESCRIPTION	DATE	REV
DESIGN PACKET	05/31/2024	-
REVISION	06/03/2024	A
REVISION	11/11/2024	B

PE STAMP

PROJECT NAME

LEE T OSTERHOUT
42 OAKLAND DRIVE
SANFORD, NORTH CAROLINA,
27332
 (910) 885-2872
 PROJECT ID: 114630

SHEET NAME


MOUNTING DETAIL

SHEET SIZE

ANSI B
11" x 17"

SHEET NUMBER

PV-5

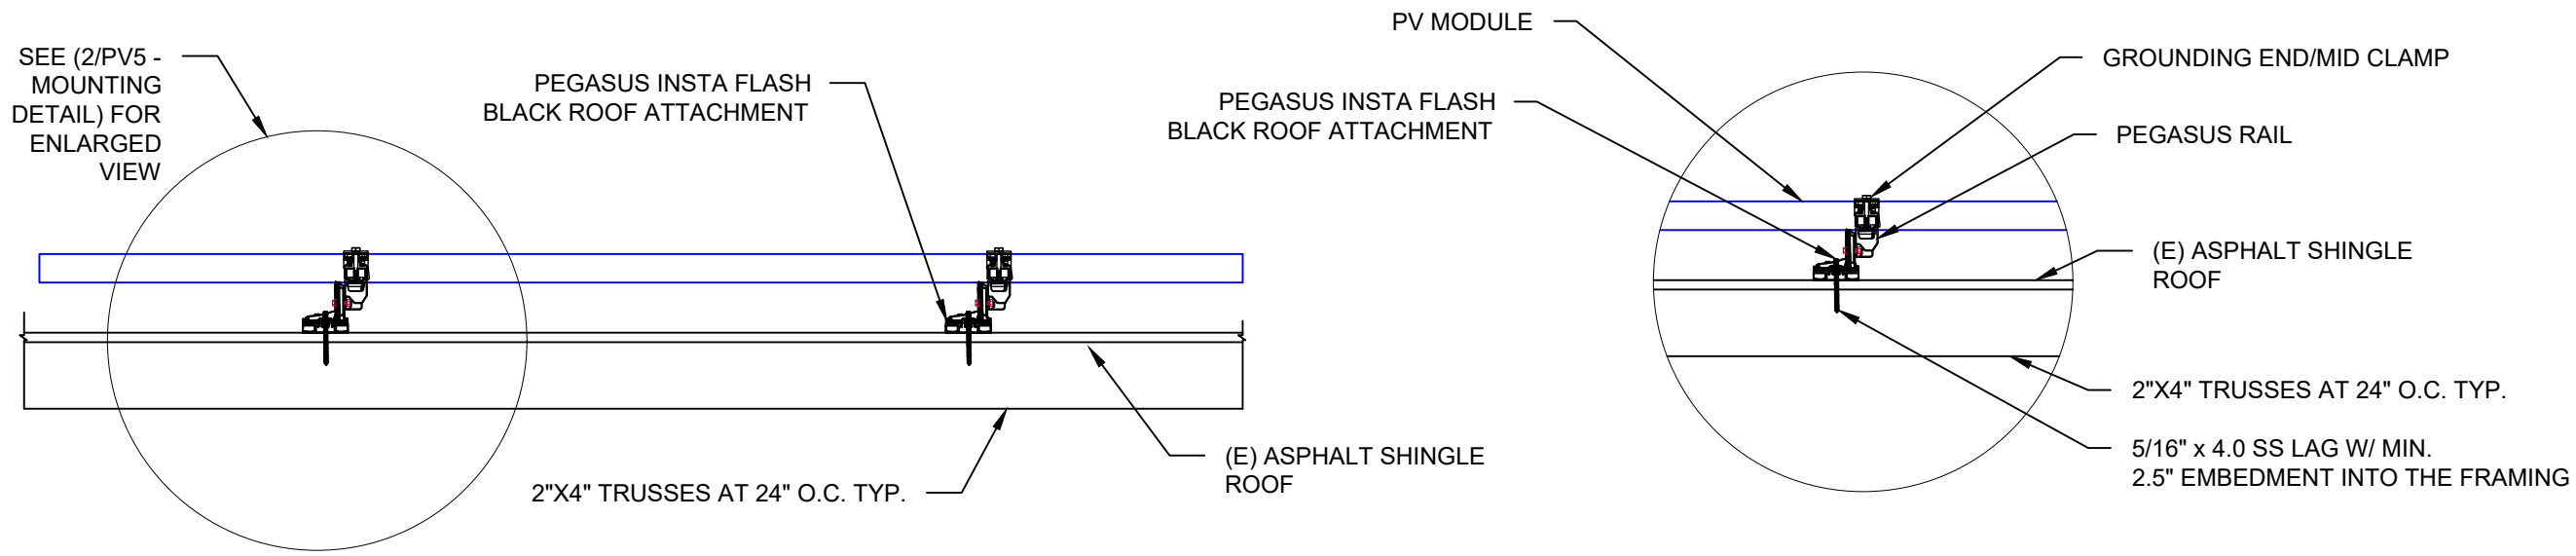

MOUNTING METHOD
NTS

1

MOUNTING DETAIL
NTS

2

NOTE: NOT ALL LABELS MAY BE APPLICABLE

SIGNAGE REQUIREMENTS

- > RED BACKGROUND
- > WHITE LETTERING
- > MIN. 3/8" LETTER HEIGHT
- > ALL CAPITAL LETTERS
- > ARIAL OR SIMILAR FONT
- > REFLECTIVE, WEATHER RESISTANT MATERIAL, UL 969

PV SYSTEM DISCONNECT

REQ'D BY: NEC 690.13(B) A
 APPLY TO:
 PV DISCONNECT

**WARNING
 ELECTRIC SHOCK HAZARD.
 DO NOT TOUCH TERMINALS.
 TERMINALS ON THE LINE AND
 LOAD SIDES MAY BE
 ENERGIZED IN THE OPEN
 POSITION.**

REQ'D BY: NEC 690.13(B) B
 APPLY TO:
 PV DISCONNECT

**WARNING: PHOTOVOLTAIC
 POWER SOURCE**

REQ'D BY: NEC 690.31(G)(3) C
 APPLY TO:
 RACEWAYS, CABLE TRAYS,
 OTHER WIRING METHODS, AND
 ENCLOSURES THAN CONTAIN
 PV SYSTEM DC CONDUCTORS

**WARNING
 POWER SOURCE OUTPUT
 CONNECTION. DO NOT
 RELOCATE THIS
 OVERCURRENT DEVICE**

REQ'D BY: NEC 705.12(B)(2)(3)(b) D
 APPLY TO:
 DISTRIBUTION EQUIPMENT
 ADJACENT TO BACK-FED BREAKER

2" ADDRESS NUMBERS

REQ' BY: AHJ E
 APPLY TO:
 REVENUE METER SOCKET
 (IF APPLICABLE)

REVENUE METER

REQ'D BY: AHJ F
 APPLY TO:
 REVENUE METER SOCKET
 (IF APPLICABLE)

MONITORING


REQ'D BY: FREEDOM SOLAR G
 APPLY TO:
 MONITORING DEVICE ENCLOSURE

**RAPID SHUTDOWN SWITCH
 FOR SOLAR PV SYSTEM**

REQ'D BY: NEC 690.56(C)(2) H
 APPLY TO:
 PV DISCONNECT

**PHOTOVOLTAIC SYSTEM
 AC DISCONNECT
 OPERATING CURRENT: 32.4A
 OPERATING VOLTAGE: 240 VAC**

REQ'D BY: 690.56(1)(a) I
 APPLY TO:
 PV DISCONNECT

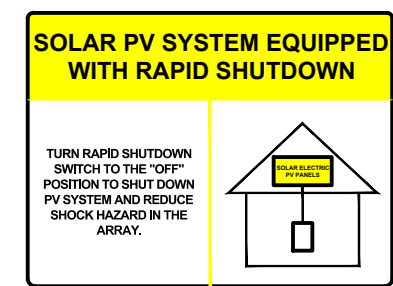

690.56(C)(1)(a) NEC BY: REQ'D J
 APPLY TO:
 MAIN DISTRIBUTION PANEL

CAUTION
 POWER TO THIS BUILDING IS ALSO SUPPLIED FROM THE FOLLOWING SOURCES WITH DISCONNECTS AS SHOWN:

UTILITY SUPPLY & CUSTOMER SERVICE PANEL

PV AC DISCONNECT

RAPID SHUTDOWN SWITCH

FRONT

REQ'D BY: 705.10 K
 APPLY TO:
 MAIN DISTRIBUTION PANEL
 (*ONLY REQUIRED IF PV SYSTEM DISCONNECT IS NOT GROUPED WITH MAIN SERVICE DISCONNECT)
SEE SHEET PV-6 FOR SITE SPECIFIC LABELS

CONTRACTOR

FREEDOM SOLAR POWER
 FREEDOM SOLAR LLC
 4801 FREDRICH LN, STE 100
 AUSTIN, TX 78744
 512-759-8313
 TECL # 28621

REVISIONS		
DESCRIPTION	DATE	REV
DESIGN PACKET	05/31/2024	-
REVISION	06/03/2024	A
REVISION	11/11/2024	B

PE STAMP

PROJECT NAME

LEE T OSTERHOUT
 42 OAKLAND DRIVE
 SANFORD, NORTH CAROLINA,
 27332
 (910) 885-2872
 PROJECT ID: 114630

SHEET NAME

SYSTEM LABELING DETAIL


SHEET SIZE

ANSI B
 11" x 17"

SHEET NUMBER

PV-6

**CAUTION:
MULTIPLE SOURCES OF POWER
LOCATION OF EACH POWER SOURCE
DISCONNECTING MEANS SHOWN BELOW**

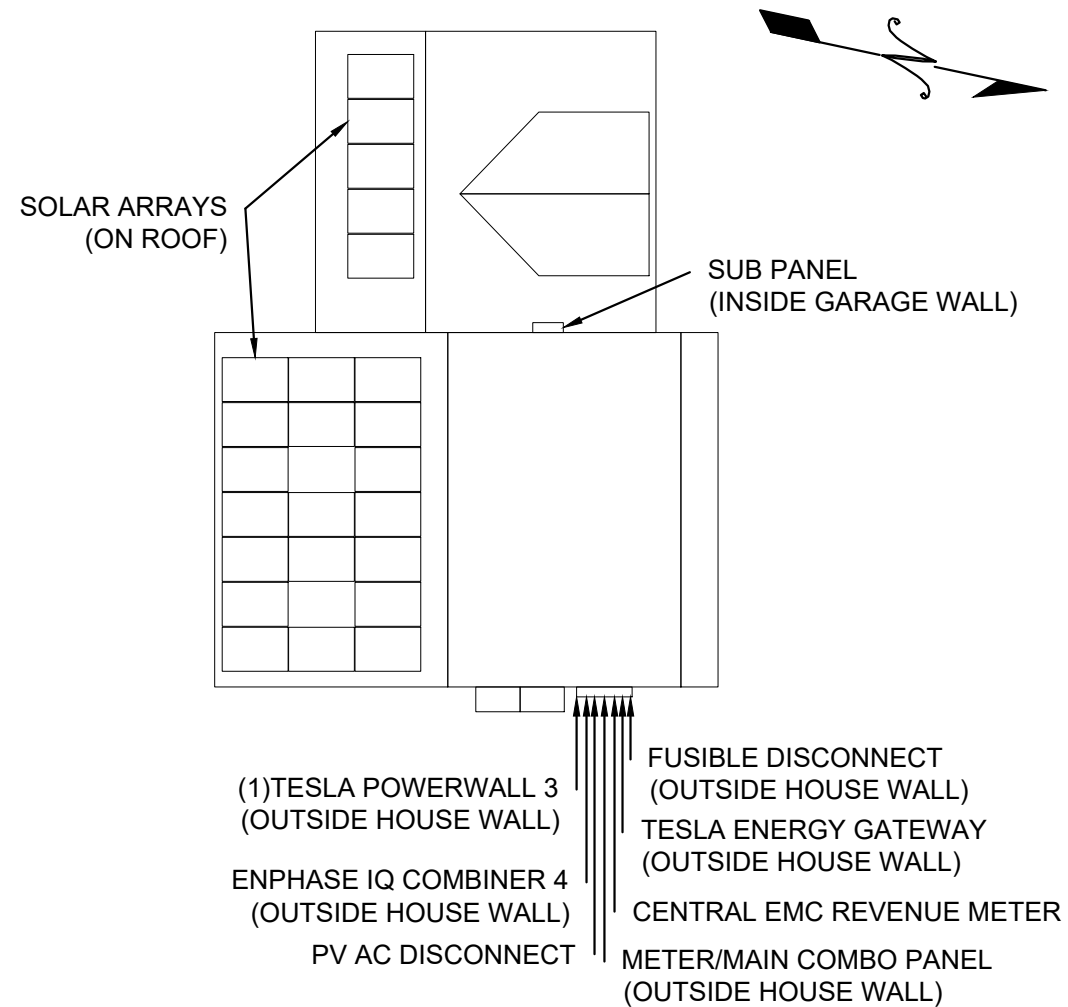

QUESTIONS, CALL:
800-504-2337
www.freedomsolarpower.com

**FREEDOM
SOLAR POWER**
42 OAKLAND DRIVE
PROJECT ID: 114630

CONTRACTOR



**FREEDOM
SOLAR POWER**

FREEDOM SOLAR LLC
4801 FREDRICH LN, STE 100
AUSTIN, TX 78744
512-759-8313
TECL # 28621

REVISIONS

DESCRIPTION	DATE	REV
DESIGN PACKET	05/31/2024	-
REVISION	06/03/2024	A
REVISION	11/11/2024	B

PE STAMP

PROJECT NAME

LEE T OSTERHOUT
42 OAKLAND DRIVE
SANFORD, NORTH CAROLINA,
27332
(910) 885-2872
PROJECT ID: 114630

SHEET NAME

SITE
DIRECTORY
PLACARD

SHEET SIZE


ANSI B
11" x 17"

SHEET NUMBER

PV-7

USE THE SAFETY SYMBOL KEY TO DRAW IN THE CONTROLLED ACCESS ZONE (CAZ), LADDER PLACEMENT, METER LOCATION, FALL PROTECTION ANCHOR POINT, AND ANY OTHER HAZARD.

HARD HAT IS REQUIRED AT ALL TIMES IN CAZ

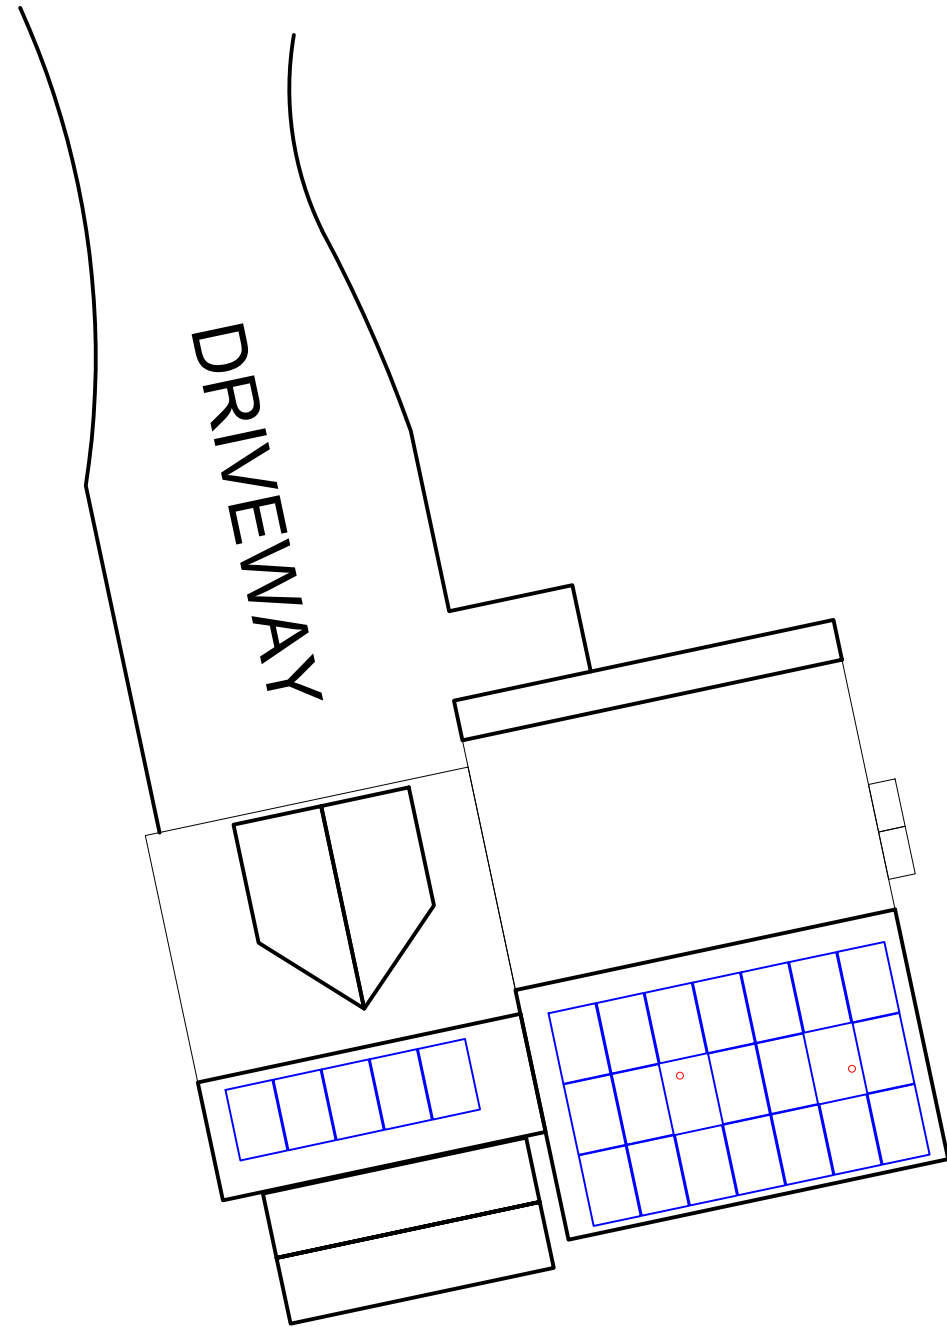

SAFETY SYMBOL KEY

- CAZ
- L LADDER
- M METER
- ==== POWER LINES
- R RESTRAINT ANCHOR
- A ARREST ANCHOR



CONTRACTOR

FREEDOM SOLAR POWER
 FREEDOM SOLAR LLC
 4801 FREDRICH LN, STE 100
 AUSTIN, TX 78744
 512-759-8313
 TECL # 28621

REVISIONS		
DESCRIPTION	DATE	REV
DESIGN PACKET	05/31/2024	-
REVISION	06/03/2024	A
REVISION	11/11/2024	B

PE STAMP

CONDUCT SAFETY MEETING WITH ALL CREW MEMBERS ON SITE AT THE BEGINNING OF EACH JOB. USE SIGN IN SHEET BELOW.

1. _____
2. _____
3. _____
4. _____
5. _____

PROJECT NAME

LEE T OSTERHOUT
 42 OAKLAND DRIVE
 SANFORD, NORTH CAROLINA,
 27332
 (910) 885-2872
 PROJECT ID: 114630

SHEET NAME

SAFETY PLAN

SHEET SIZE

ANSI B
 11" x 17"

SHEET NUMBER

PV-8

COMPETENT PERSON: _____ JOB START DATE: _____

MSE PERC 66

MISSION SOLAR ENERGY



395W

Class leading power output

Positive Power Tolerance

-0 to +3%

True American Quality True American Brand

Mission Solar Energy is headquartered in San Antonio, Texas where we manufacture our modules. We produce American, high-quality solar modules ensuring the highest-in-class power output and best-in-class reliability. Our product line is tailored for residential, commercial and utility applications. Every Mission Solar Energy solar module is certified and surpasses industry standard regulations, proving excellent performance over the long term.

Demand the best. Demand Mission Solar Energy.



Certified Reliability

- Tested to UL 61730 & IEC Standards
- PID resistant
- Resistance to salt mist corrosion



Advanced Technology

- 9 Busbar
- Passivated Emitter Rear Contact
- Ideal for all applications



Extreme Weather Resilience

- Up to 5,400 Pa front load & 3,600 Pa back load
- Tested load to UL 61730
- 40 mm frame



BAA Compliant for Government Projects

- Buy American Act
- American Recovery & Reinvestment Act

FRAME-TO-FRAME WARRANTY

Degradation guaranteed not to exceed 2% in year one and 0.58% annually from years two to 30 with 84.08% capacity guaranteed in year 25. For more information, visit www.missionsolar.com/warranty

CERTIFICATIONS

CEC



UL 61730 / IEC 61215 / IEC 61730 / IEC 61701


If you have questions or concerns about certification of our products in your area, please contact Mission Solar Energy.



Class Leading 390-400W

BASIC DIMENSIONS


[UNITS: MM/IN]

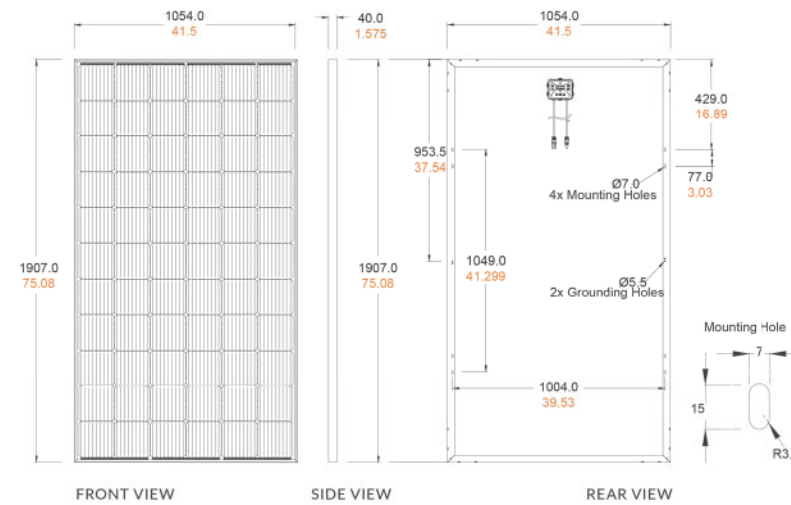

CURRENT-VOLTAGE CURVE

MSE385SX9R: 385WP, 66 CELL SOLAR MODULE

Current-voltage characteristics with dependence on irradiance and module temperature

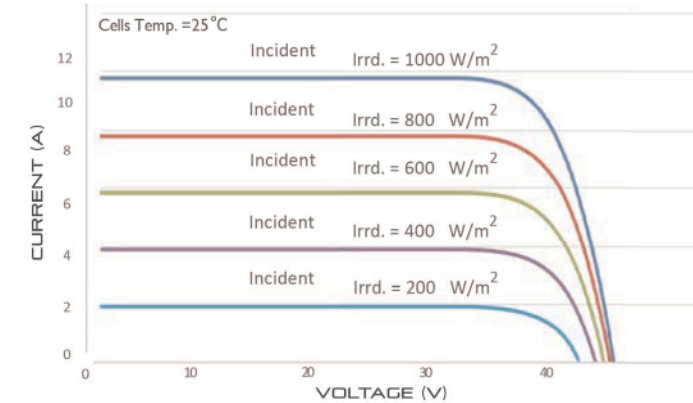

CERTIFICATIONS AND TESTS

IEC	61215, 61730, 61701
UL	61730



CEC



Mission Solar Energy

8303 S. New Braunfels Ave., San Antonio, Texas 78235
www.missionsolar.com | info@missionsolar.com

Mission Solar Energy reserves the right to make specification changes without notice.
C-SA2-MKTG-0027 REV 4 03/18/2022

MSE PERC 66

ELECTRICAL SPECIFICATION

PRODUCT TYPE	MSExxxSX9R (xxx = Pmax)				
Power Output	P _{max}	W _p	390	395	400
Module Efficiency	%		19.4	19.7	19.9
Tolerance	%		0/+3	0/+3	0/+3
Short Circuit Current	I _{sc}	A	11.19	11.24	11.31
Open Circuit Voltage	V _{oc}	V	45.04	45.18	45.33
Rated Current	I _{mp}	A	10.63	10.68	10.79
Rated Voltage	V _{mp}	V	36.68	36.99	37.07
Fuse Rating	A		20	20	20
System Voltage	V		1,000	1,000	1,000

TEMPERATURE COEFFICIENTS

Normal Operating Cell Temperature (NOCT)	43.75°C (±3.7%)
Temperature Coefficient of P _{max}	-0.367%/°C
Temperature Coefficient of V _{oc}	-0.259%/°C
Temperature Coefficient of I _{sc}	0.033%/°C

OPERATING CONDITIONS

Maximum System Voltage	1,000Vdc
Operating Temperature Range	-40°F to 185°F (-40°C to +85°C)
Maximum Series Fuse Rating	20A
Fire Safety Classification	Type 1*
Front & Back Load (UL Standard)	Up to 5,400 Pa front and 3,600 Pa back load, Tested to UL 61730
Hail Safety Impact Velocity	25mm at 23 m/s

*Mission Solar Energy uses quality sourced materials that result in a Type 1 fire rating. Please note, the 'Fire Class' Rating is designated for the fully-installed PV system, which includes, but is not limited to, the module, the type of mounting used, pitch and roof composition.

MECHANICAL DATA

Solar Cells	P-type mono-crystalline silicon
Cell Orientation	66 cells (6x11)
Module Dimension	1,907mm x 1,054mm x 40mm
Weight	48.5 lbs. (22 kg)
Front Glass	3.2mm tempered, low-iron, anti-reflective
Frame	40mm Anodized
Encapsulant	Ethylene vinyl acetate (EVA)
Junction Box	Protection class IP67 with 3 bypass-diodes
Cable	1.2m, Wire 4mm2 (12AWG)
Connector	Staubli PV-KBT4/6II-UR and PV-KST4/6II-UR, MC4, Renhe 05-8

SHIPPING INFORMATION

Container Feet	Ship To	Pallet	Panels	390W Bin
53'	Most States	30	780	304.20 kW
Double Stack	CA	26	676	263.64 kW

PALLET [26 PANELS]

Weight	Height	Width	Length
1,300 lbs. (572 kg)	47.56 in (120.80 cm)	46 in (116.84 cm)	77 in (195.58 cm)



IQ8M and IQ8A Microinverters

Our newest IQ8 Microinverters are the industry's first microgrid-forming, software-defined microinverters with split-phase power conversion capability to convert DC power to AC power efficiently. The brain of the semiconductor-based microinverter is our proprietary application-specific integrated circuit (ASIC), which enables the microinverter to operate in grid-tied or off-grid modes. This chip is built using advanced 55-nm technology with high-speed digital logic and has superfast response times to changing loads and grid events, alleviating constraints on battery sizing for home energy systems.



Part of the Enphase Energy System, IQ8 Series Microinverters integrate with the IQ Battery, IQ Gateway, and the Enphase App monitoring and analysis software.



IQ8 Series Microinverters redefine reliability standards with more than one million cumulative hours of power-on testing, enabling an industry-leading limited warranty of up to 25 years.



Connect PV modules quickly and easily to the IQ8 Series Microinverters that have integrated MC4 connectors.



IQ8 Series Microinverters are UL Listed as PV rapid shutdown equipment and conform with various regulations when installed according to the manufacturer's instructions.

Easy to install

- Lightweight and compact with plug-and-play connectors
- Power line communication (PLC) between components
- Faster installation with simple two-wire cabling

High productivity and reliability

- Produce power even when the grid is down*
- More than one million cumulative hours of testing
- Class II double-insulated enclosure
- Optimized for the latest high-powered PV modules

Microgrid-forming

- Complies with the latest advanced grid support**
- Remote automatic updates for the latest grid requirements
- Configurable to support a wide range of grid profiles
- Meets CA Rule 21 (UL 1741-SA) and IEEE 1547:2018 (UL 1741-SB 3rd Ed.)

NOTE:

- IQ8 Microinverters cannot be mixed together with previous generations of Enphase microinverters (IQ7 Series, IQ6 Series, and so on) in the same system.
- IQ Gateway is required to change the default grid profile at the time of installation to meet the local Authority Having Jurisdiction (AHJ) requirements.

IQ8M and IQ8A Microinverters

INPUT DATA (DC)	UNITS	IQ8M-72-M-US	IQ8A-72-M-US
Commonly used module pairings ¹	W	260-460	295-500
Module compatibility		To meet compatibility, PV modules must be within the following maximum input DC voltage and maximum module I_{sc} . Module compatibility can be checked at https://enphase.com/installers/microinverters/calculator	
MPPT voltage range	V	30-45	32-45
Operating range	V		16-58
Minimum/Maximum start voltage	V		22/58
Maximum input DC voltage	V		60
Maximum continuous input DC current	A		12
Maximum input DC short-circuit current	A		25
Maximum module I_{sc}	A		20
Overvoltage class DC port			II
DC port backfeed current	mA		0
PV array configuration		1 x 1 ungrounded array; no additional DC side protection required; AC side protection requires max 20 A per branch circuit	
OUTPUT DATA (AC)	UNITS	IQ8M-72-M-US	IQ8A-72-M-US
Peak output power	VA	330	366
Maximum continuous output power	VA	325	349
Nominal grid voltage (L-L)	V	240, split-phase (L-L), 180°	
Minimum and Maximum grid voltage ²	V	211-264	
Maximum continuous output current	A	1.35	1.45
Nominal frequency	Hz	60	
Extended frequency range	Hz	47-68	
AC short-circuit fault current over three cycles	Arms	2	
Maximum units per 20 A (L-L) branch circuit ³		11	
Total harmonic distortion	%	<5	
Overvoltage class AC port		III	
AC port backfeed current	mA	30	
Power factor setting		1.0	
Grid-tied power factor (adjustable)		0.85 leading ... 0.85 lagging	
Peak efficiency	%	97.8	97.7
CEC weighted efficiency	%	97.5	97
Nighttime power consumption	mW	21	22
MECHANICAL DATA			
Ambient temperature range		-40°C to 60°C (-40°F to 140°F)	
Relative humidity range		4% to 100% (condensing)	
DC connector type		Stäubli MC4	
Dimensions (H x W x D)		212 mm (8.3") x 175 mm (6.9") x 30.2 mm (1.2")	
Weight		1.1 kg (2.43 lbs)	
Cooling		Natural convection—no fans	
Approved for wet locations		Yes	
Pollution degree		PD3	
Enclosure		Class II double-insulated, corrosion-resistant polymeric enclosure	
Environmental category/UV exposure rating		NEMA Type 6/outdoor	

(1) No enforced DC/AC ratio.

(2) Nominal voltage range can be extended beyond nominal if required by the utility.

(3) Limits may vary. Refer to local requirements to define the number of microinverters per branch in your area.

* Meets UL 1741 only when installed with IQ System Controller 2.

** IQ8M and IQ8A support split-phase, 240 V installations only.

IQ8M and IQ8A Microinverters

COMPLIANCE	
Certifications	CA Rule 21 (UL 1741-SA), UL 62109-1, IEEE 1547:2018 (UL 1741-SB 3rd Ed.), FCC Part 15 Class B, ICES-0003 Class B, CAN/CSA-C22.2 NO. 107.1-01 This product is UL Listed as PV rapid shutdown equipment and conforms with NEC 2014, NEC 2017, NEC 2020, and NEC 2023 section 690.12 and C22.1-2018 Rule 64-218 rapid shutdown of PV Systems, for AC and DC conductors, when installed according to the manufacturer's instructions.

IQ8M and IQ8A Microinverters

Revision history

REVISION	DATE	DESCRIPTION
DSH-00205-2.0	November 2023	Updated the nighttime power consumption values. Included NEC 2023 specification in the "Compliance" section.
DSH-00205-1.0	September 2023	Updated the module compatibility specification.
Previous releases.		

Enphase Q Cable and Accessories

The **Enphase Q Cable™** and accessories are part of the sixth generation Enphase IQ System™. These products provide simplicity, reliability, and faster installation times.



Enphase Q Cable

- Two-wire, double-insulated Enphase Q Cable is 50% lighter than the previous generation Enphase cable
- Four-wire (three-phase) option also available
- New cable numbering and plug and play connectors speed up installation and simplify wire management
- Link connectors eliminate cable waste



Field-Wireable Connectors



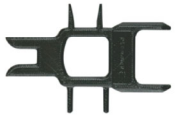
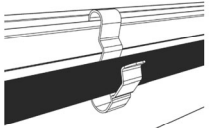
- Easily connect Q cables on the roof without complex wiring
- Make connections from any open connector and center feed any section of cable within branch limits
- Available in male and female connector types

Enphase Q Cable Accessories

Q CABLE SPECIFICATIONS	
Voltage rating	600V (connector rating up to 250 V)
Cable temperature rating	90° C wet/dry
UV exposure rating	EN ISO 492-2
Environmental protection rating	IEC 60529 IP67
Compliance	RoHS, OIL RES I, CE, UV resistant
Cable insulator rating	H07BQ-F
Flame rating	IEC 60332-1-2

Q CABLE TYPES / ORDERING OPTIONS					
Model Number	Max Nominal Voltage	Ampacity Rating	Connector Spacing	PV Module Orientation	Connector Count per Box
Q-25-10-240 (single-phase)	250 VAC	25 A	1.3 m	Portrait	240
Q-25-17-240 (single-phase)	250 VAC	25 A	2.0 m	Landscape (60-cell)	240
Q-25-20-200 (single-phase)	250 VAC	25 A	2.3 m	Landscape (72-cell)	200
Q-25-10-3P-200 (three-phase)	250 VAC	25 A	1.3 m	Portrait	200
Q-25-17-3P-160 (three-phase)	250 VAC	25 A	2.0 m	Landscape (60-cell)	160
Q-25-20-3P-160 (three-phase)	250 VAC	25 A	2.3 m	Landscape (72-cell)	160

ENPHASE Q CABLE ACCESSORIES		
Name	Model Number	Description
Raw Q Cable (single-phase)	Q-25-RAW-300	300 meters cable with no connectors
Raw Q Cable (three-phase)	Q-25-RAW-3P-300	300 meters cable with no connectors
Field-wireable connector (male)	Q-CONN-R-10M	Make connections using single-phase cable
Field-wireable connector (male)	Q-CONN-3P-10M	Make connections using three-phase cable
Field-wireable connector (female)	Q-CONN-R-10F	Make connections from any Q Cable (single-phase) open connector
Field-wireable connector (female)	Q-CONN-3P-10F	Make connections from any Q Cable (three-phase) open connector
Cable Clip	ET-CLIP-100	Used to fasten cabling to the racking or to secure looped cabling
Disconnect tool	Q-DISC-10	Disconnect tool for Q Cable connectors, DC connectors, and AC module mount
Disconnect tool	Q-DISC-3P-10	Disconnect tool for three-phase Field wireable connectors
Q Cable sealing caps (female)	Q-SEAL-10	One needed to cover each unused connector on the cabling
Terminator (single-phase)	Q-TERM-R-10	Terminator cap for unused single-phase cable ends
Terminator (three-phase)	Q-TERM-3P-10	Terminator cap for unused three-phase cable ends
Replacement DC Adaptor (MC4)	Q-DCC-2-INT	DC adaptor to MC4 (max voltage 100 VDC)

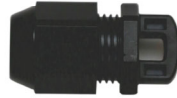	TERMINATOR Terminator cap for unused cable ends, sold in packs of ten (Q-TERM-R-10 / Q-TERM-3P-10)		SEALING CAPS Sealing caps for unused cable connections, sold in packs of ten (Q-SEAL-10)
	DISCONNECT TOOL Plan to use at least one per installation, sold in packs of ten (Q-DISC-10) Three-phase model (Q-DISC-3P-10)		CABLE CLIP Used to fasten cabling to the racking or to secure looped cabling, sold in packs of one hundred (ET-CLIP-100)

IQ Combiner 4/4C



The **IQ Combiner 4/4C** with IQ Gateway and integrated LTE-M1 cell modem (included only with IQ Combiner 4C) consolidates interconnection equipment into a single enclosure. It streamlines IQ Microinverters and storage installations by providing a consistent, pre-wired solution for residential applications. It offers up to four 2-pole input circuits and Eaton BR series busbar assembly.

Smart

- Includes IQ Gateway for communication and control
- Includes Mobile Connect cellular modem (CELLMODEM-M1-06-SP-05), included only with IQ Combiner 4C
- Includes solar shield to match Enphase IQ Battery aesthetics and deflect heat
- Supports Wi-Fi, Ethernet, or cellular connectivity
- Optional AC receptacle available for PLC bridge
- Provides production metering and consumption monitoring

Simple

- Mounts on single stud with centered brackets
- Supports bottom, back and side conduit entry
- Allows up to four 2-pole branch circuits for 240VAC plug-in breakers (not included)
- 80A total PV or storage branch circuits

Reliable

- Durable NRTL-certified NEMA type 3R enclosure
- Five-year limited warranty
- Two years labor reimbursement program coverage included for both the IQ Combiner SKU's
- UL listed
- X2-IQ-AM1-240-4 and X2-IQ-AM1-240-4C comply with IEEE 1547:2018 (UL 1741-SB, 3rd Ed.)

IQ Combiner 4/4C

MODEL NUMBER

IQ Combiner 4 X-IQ-AM1-240-4 X2-IQ-AM1-240-4 (IEEE 1547:2018)	IQ Combiner 4 with IQ Gateway printed circuit board for integrated revenue grade PV production metering (ANSI C12.20 ± 0.5%) and consumption monitoring (± 2.5%). Includes a silver solar shield to match the IQ Battery and IQ System Controller 2 and to deflect heat.
IQ Combiner 4C X-IQ-AM1-240-4C X2-IQ-AM1-240-4C (IEEE 1547:2018)	IQ Combiner 4C with IQ Gateway printed circuit board for integrated revenue grade PV production metering (ANSI C12.20 ± 0.5%) and consumption monitoring (± 2.5%). Includes Mobile Connect cellular modem (CELLMODEM-M1-06-SP-05), a plug-and-play industrial-grade cell modem for systems up to 60 microinverters. (Available in the US, Canada, Mexico, Puerto Rico, and the US Virgin Islands, where there is adequate cellular service in the installation area.) Includes a silver solar shield to match the IQ Battery and IQ System Controller and to deflect heat.

ACCESSORIES AND REPLACEMENT PARTS (not included, order separately)

Supported microinverters	IQ6, IQ7, and IQ8. (Do not mix IQ6/7 Microinverters with IQ8)
Communications Kit COMMS-CELLMODEM-M1-06 CELLMODEM-M1-06-SP-05 CELLMODEM-M1-06-AT-05	- Includes COMMS-KIT-01 and CELLMODEM-M1-06-SP-05 with 5-year Sprint data plan - 4G based LTE-M1 cellular modem with 5-year Sprint data plan - 4G based LTE-M1 cellular modem with 5-year AT&T data plan
Circuit Breakers BRK-10A-2-240V BRK-15A-2-240V BRK-20A-2P-240V BRK-15A-2P-240V-B BRK-20A-2P-240V-B	Supports Eaton BR210, BR215, BR220, BR230, BR240, BR250, and BR260 circuit breakers. Circuit breaker, 2 pole, 10A, Eaton BR210 Circuit breaker, 2 pole, 15A, Eaton BR215 Circuit breaker, 2 pole, 20A, Eaton BR220 Circuit breaker, 2 pole, 15A, Eaton BR215B with hold down kit support Circuit breaker, 2 pole, 20A, Eaton BR220B with hold down kit support
XA-SOLARSHIELD-ES	Replacement solar shield for IQ Combiner 4/4C
XA-PLUG-120-3	Accessory receptacle for Power Line Carrier in IQ Combiner 4/4C (required for EPLC-01)
X-IQ-NA-HD-125A	Hold-down kit for Eaton circuit breaker with screws
Consumption monitoring CT (CT-200-SPLIT/CT-200-CLAMP)	A pair of 200A split core current transformers

ELECTRICAL SPECIFICATIONS

Rating	Continuous duty
System voltage	120/240VAC, 60 Hz
Eaton BR series busbar rating	125A
Max. continuous current rating	65A
Max. continuous current rating (input from PV/storage)	64A
Max. fuse/circuit rating (output)	90A
Branch circuits (solar and/or storage)	Up to four 2-pole Eaton BR series Distributed Generation (DG) breakers only (not included)
Max. total branch circuit breaker rating (input)	80A of distributed generation/95A with IQ Gateway breaker included
IQ Gateway breaker	10A or 15A rating GE/Siemens/Eaton included
Production metering CT	200A solid core pre-installed and wired to IQ Gateway

MECHANICAL DATA

Dimensions (WxHxD)	37.5 cm x 49.5 cm x 16.8 cm (14.75 in x 19.5 in x 6.63 in). Height is 53.5 cm (21.06 in) with mounting brackets.
Weight	7.5 kg (16.5 lbs)
Ambient temperature range	-40°C to +46°C (-40°F to 115°F)
Cooling	Natural convection, plus heat shield
Enclosure environmental rating	Outdoor, NRTL-certified, NEMA type 3R, polycarbonate construction
Wire sizes	• 20A to 50A breaker inputs: 14 to 4 AWG copper conductors • 60A breaker branch input: 4 to 1/0 AWG copper conductors • Main lug combined output: 10 to 2/0 AWG copper conductors • Neutral and ground: 14 to 1/0 copper conductors • Always follow local code requirements for conductor sizing.
Altitude	Up to 3,000 meters (9,842 feet)

INTERNET CONNECTION OPTIONS

Integrated Wi-Fi	IEEE 802.11b/g/n
Cellular	CELLMODEM-M1-06-SP-05, CELLMODEM-M1-06-AT-05 (4G based LTE-M1 cellular modem). Note that an Mobile Connect cellular modem is required for all Enphase Energy System installations.
Ethernet	Optional, IEEE 802.3, Cat5E (or Cat6) UTP Ethernet cable (not included)

COMPLIANCE

Compliance, IQ Combiner	CA Rule 21 (UL 1741-SA) IEEE 1547:2018 - UL 1741-SB, 3 rd Ed. (X2-IQ-AM1-240-4 and X2-IQ-AM1-240-4C) CAN/CSA C22.2 No. 107.1, Title 47 CFR, Part 15, Class B, ICES 003 Production metering: ANSI C12.20 accuracy class 0.5 (PV production) Consumption metering: accuracy class 2.5
Compliance, IQ Gateway	UL 60601-1/CANCSA 22.2 No. 61010-1



IQ Gateway



IQ Gateway

The IQ Gateway delivers solar production and energy consumption data to Enphase Installer Portal monitoring and analysis software for comprehensive, remote maintenance, and management of Enphase systems.

With integrated production metering and optional consumption monitoring, the IQ Gateway is the platform for total energy management. It integrates with the IQ System Controller and IQ Battery.



IQ Series Microinverters
The high-powered smart grid-ready IQ Series Microinverters (IQ6, IQ7, and IQ8 Series) dramatically simplify the installation process.



IQ System Controller
Provides microgrid interconnect device (MID) functionality by automatically detecting grid failures and seamlessly transitioning the home energy system from grid power to backup power.



IQ Battery
All-in-one AC coupled storage system that is reliable, smart, simple, and safe. It provides backup capability and installers can quickly design the right system size to meet the needs of both new and retrofit solar customers.



IQ Load Controller
Helps prioritize essential appliances during a grid outage to optimize energy consumption and prolong battery life.

Smart

- Enables web-based monitoring and control
- Provides bidirectional communications for remote upgrades
- Supports power export limiting and zero-export applications

Simple

- Easy system configuration using Enphase Installer App
- Flexible networking with Wi-Fi, Ethernet, or cellular

Reliable

- Designed for installation indoors or outdoors in a NEMA 3R rated enclosure
- 5-year limited warranty
- ENV2-IQ-AM1-240 complies with IEEE 1547:2018 (UL 1741-SB, 3rd Ed.)

MODEL NUMBER		ENV-IQ-AM1-240, ENV2-IQ-AM1-240
IQ Gateway ENV-IQ-AM1-240 ENV2-IQ-AM1-240 (IEEE 1547:2018)	IQ Gateway integrates revenue grade PV production metering (ANSI C12.20 ±0.5%), consumption metering (±2.5%), and battery metering (±2.5%) with IQ Battery 5P. Includes one 200 A continuous rated Production current transformer (CT).	
ACCESSORIES - ORDER SEPARATELY		
Mobile Connect COMMS-CELLMODEM-M1-06 CELLMODEM-M1-06-SP-05 CELLMODEM-M1-06-AT-05	- Includes COMMS-KIT-01 and CELLMODEM-M1-06-SP-05 with 5-year Sprint data plan - 4G based LTE-M1 cellular modem with 5-year Sprint data plan - 4G based LTE-M1 cellular modem with 5-year AT&T data plan	
Consumption monitoring CT and IQ Battery 5P metering CT CT-200-SPLIT CT-200-CLAMP	Split-core and clamp style CTs with 2.5% accuracy enable whole home and IQ Battery 5P metering	
Communications Kit COMMS-KIT-01 COMMS-KIT-02	Installed at the IQ Gateway. For communications with IQ Battery and IQ System Controller. Includes USB cable for connection to IQ Gateway or IQ Combiner and allows wireless communication with IQ Battery and IQ System Controller.	
POWER REQUIREMENTS		
Power requirements	120/240 VAC split-phase maximum 20 A overcurrent protection required	
Typical power consumption	5 W	
CAPACITY		
Number of microinverters polled	Up to 300	
MECHANICAL & ELECTRICAL DATA		
Dimensions (W×H×D)	21.3 cm × 12.6 cm × 4.5 cm (8.4 in × 5 in × 1.8 in)	
Weight	1.09 lb	
Ambient temperature range	-40°C to 65°C (-40°F to 149°F) [ENV-IQ-AM1-240] -40°C to 50°C (-40°F to 122°F) [ENV2-IQ-AM1-240] -40°C to 46°C (-40°F to 115°F) if installed in an enclosure	
Environmental rating	IP30. For installation indoors or in an NRTL-certified, NEMA type 3R or better-rated enclosure, if installing outdoors.	
Altitude	Up to 2,600 meters (8,530 feet)	
COMMUNICATION INTERFACES		
Integrated Wi-Fi	802.11b/g/n (2.4 GHz, 5 GHz), for connecting the Enphase Cloud via the internet.	
Wi-Fi range (recommended)	10 m	
Ethernet	Optional, 802.3, Cat5E (or Cat 6) UTP Ethernet cable (not included), for connecting to the Enphase Cloud via the internet.	
Mobile Connect	CELLMODEM-M1-06-SP-05, CELLMODEM-M1-06-AT-05 (to be purchased separately, mandatory for sites with IQ Battery)	
Digital I/O	Digital input/output for grid operator control	
USB 2.0	For Mobile Connect and Communications Kit	
Access point (AP) mode	For a connection between the IQ Gateway and a mobile device running the Enphase Installer App	
Metering ports	Up to two Consumption CTs, one Production CT, and one battery CT (for IQ Battery 5P)	
Power line communication (PLC)	90-110 kHz (Class B), to microinverters.	
Web API	Refer to https://developer-v4.enphase.com	
Local API	Refer to guide for local API	
LED indicators	From top to bottom: Cloud connectivity, Wi-Fi access point mode, PV production state, PLC communications state	
Configured via	Enphase Installer App and Enphase Installer Platform	





POWER PRODUCTION/EXPORT LIMITING VIA THE IQ GATEWAY'S DIGITAL IQ	
Maximum relays read	4
Capabilities supported	Power production limiting (Production CT/s required), power export limiting (Production CT/s required and Consumption CT/s – "Load with Solar" configuration)
Minimum IQ Gateway version	v7.3.120
Cable configurations	18 AWG, UL-Std. 62, 600 V, 105°C, and min 0.03 inches average thickness
Signal voltage range	2.5 V–5 V (digital high), 0 V–1.9 V (digital low)
Terminal blocks	Five terminals, up to 0.002 in ²
Configuration via	Enphase Installer App, Enphase Installer Platform (site settings)

SCOPE OF DELIVERY	
Package dimensions (H x W x D)	6.3" x 10.8" x 3.9"
Package weight	2.2 lb
Aluminium DIN rail	4.9 in
Current transformers (CTs)	One CT-200-SOLID included

COMPLIANCE	
Compliance	CA Rule 21 (UL 1741-SA), IEEE 1547:2018 - UL 1741-SB, 3rd Ed.(ENV2-IQ-AM1-240), UL 61010-1 CAN/CSA C22.2 No. 61010-1 Title 47 CFR, Part 15, Class B, ICES 003 IEC/EN 61010-1:2010, EN50065-1, EN61000-4-5, EN61000-6-1, EN61000-6-2 Metering: ANSI C12.20 accuracy class 0.5 (PV production only)

COMPATABILITY	
IQ System Controller	SC200D111C240US01, SC200G111C240US01, EP200G101-M240US01, EP200G101-M240US00
IQ Battery	IQBATTERY-5P-1P-NA, ENCHARGE-3T-1P-NA, ENCHARGE-10T-1P-NA
Microinverter	IQ6, IQ7, and IQ8 Series Microinverters

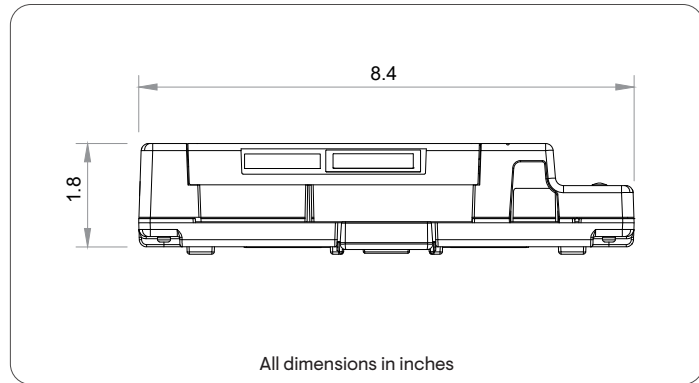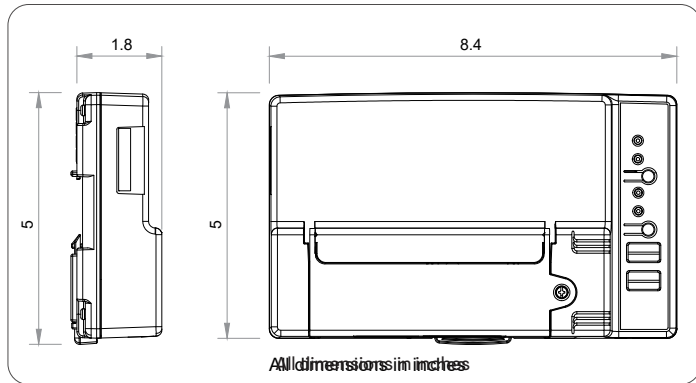

Accessories



Enphase Mobile Connect

4G-based LTE-M1 cellular modem with a 5-year data plan
(CELLMODEM-M1-06-SP-05 for Sprint and CELLMODEM-M1-06-AT-05 for AT&T)



Circuit breakers

BRK-10A-2-240V Circuit breaker, 2-pole, 10 A, Eaton BR210
BRK-15A-2-240V Circuit breaker, 2-pole, 15 A, Eaton BR215
BRK-20A-2P-240V Circuit breaker, 2-pole, 20 A, Eaton BR220
BRK-15A-2P-240V-B Circuit breaker, 2-pole, 15 A, Eaton BR215B with hold-down kit support
BRK-20A-2P-240V-B Circuit breaker, 2-pole, 20 A, Eaton BR220B with hold-down kit support



CT-200-SOLID

200 A revenue grade solid core Production CT with <0.5% error rate (replacement SKU)



CT-200-CLAMP

200 A clamp-style consumption and battery metering CT with <2.5% error rate (replacement SKU)

Revision history

REVISION	DATE	DESCRIPTION
DSH-00111-2.0	August 2023	Updated temperature specification for ENV2-IQ-AM1-240
DSH-00111-1.0	June 2023	Updated altitude and recommended maximum microinverters on a site.



INSTAFLASH™

Never Deal With Caulking Again!

Factory-installed, non-hardening sealant



Before InstaFlash Installed:
Sealant is contained above roof surface by a protective cage.



After InstaFlash Installed:
Sealant is compressed to fill all holes and voids.

Protective Cage

Prevents sealant from getting on hands or roof. Collapses upon lag installation.

Effortless Lifetime Roof Protection

The non-hardening sealant completely fills any missed pilot holes, shingle rips, voids, or other potential water ingress points under the entire footprint of the 4.6" wide base.



25-Year Warranty

Manufactured with advanced materials and coatings to outlast the roof itself



Code Compliant

Fully IBC/CBC Code Compliant Exceeds ASCE 7-16 Standards FL Cert of Approval FL41396 UL2703 Certified



Self-Healing

The proprietary non-hardening sealant will flex and reseal over years of thermal expansion and contraction



Larger Spans

The extra-large L-foot and proprietary lag screw result in larger spans between mounts



INSTAFLASH™

1

Drill pilot hole in the center of the rafter using a 7/32" bit.



2

Place the InstaFlash over the pilot hole. **Note:** the direction of the InstaFlash Down arrows should point down the roof.






3

Insert the lag screw through the center hole into the pilot hole.



4

Drive the lag until the InstaFlash is fully seated to the roof.

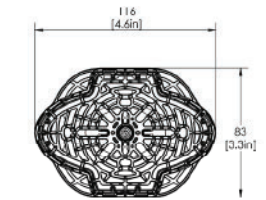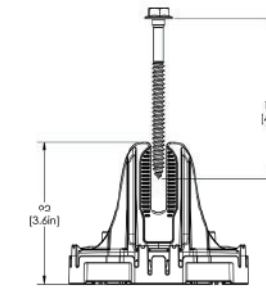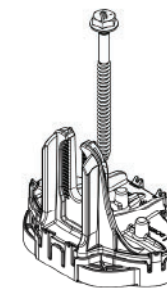

SPECIFICATIONS	INSTAFLASH KITS				
	PIF-RB0	PIF-RBDT	PIF-RBSH	PIF-RM0	PIF-RMDT
Finish	Black			Mill	
Kit Contents	Black InstaFlash, 5/16" x 4.0" SS Lag	Black InstaFlash, 5/16" x 4.0" SS Lag, Dovetail T-bolt w/ Nut	Black InstaFlash, 5/16" x 4.0" SS Lag, M10 Hex Bolt w/ Nut	Mill Insta-Flash, 5/16" x 4.0" SS Lag	Mill InstaFlash, 5/16" x 4.0" SS Lag, Dovetail T-bolt w/ Nut
Attachment Type	Rafter Attached				
Roof Type	Sloped Roof: Composition Shingle, Rolled Asphalt Flat roof: Modified Bitumen Roof, Built-Up Roof				
Sealant Application	Factory Installed				
Installation Temperature	0°F to 170° F				
Cure Time	Instantly Waterproof; Non-hardening				
Service Temperature	-40°F to 195° F				
Certifications	IBC, ASCE/SEI 7-16, FL Cert of Approval FL41396, TAS 100(A), UL2703				
Install Application	Most Railed Systems, Pegasus Tilt Leg Kit				
Kit Quantity	24				
Boxes per Pallet	36				

US Patents Pending. All rights reserved. ©2023 Pegasus Solar Inc.



SCAN FOR INSTALLATION VIDEO



SCAN FOR FREE TRIAL



RAIL SYSTEM

Instant Bonding

The N-S Bonding Jumper bonds row to row with no tools.



One Clamp Anywhere

The Multi-Clamp works as mid- or end-clamp, and fits standard 30-40mm frames.



Lifetime Wire Management

Open rail channel holds and protects wires. Clamps won't pinch wires after tightening.



Bonding Structural Splice

Connect rails instantly, without tools, interference or limitations.

Next-Level Solar Mounting

A complete system for hassle-free rooftop installation, from watertight mounts to lifetime wire management.



Simplicity

1/2" socket for everything.
One clamp for mid or end.
No tool splicing and bonding.
Easy wire management.



Code Compliant

UL 2703 listed
LTR-AE-001-2012 listed
Class A fire rating for any slope
ASCE 7-16 PE Certified
FL Cert of Approval FL41396



Premium Aesthetics

The narrowest panel gap available. Optional Hidden End Clamps and End Caps provide a flush look on the edge of the array.



Watertight for Life

Secured on industry-leading Pegasus Mounts, for composite shingle and tile roofs. Backed by a 25-year warranty.



RAIL SYSTEM



Pegasus Rail	Pegasus Max Rail	Splice and Max Splice	Dovetail T-bolt
--------------	------------------	-----------------------	-----------------

Available in 14' and 7' lengths for easy layout and shipping.
Open-channel design holds MC4 connectors, PV wire and trunk cables.
Black and Mill finish

Maximum-strength design.
Meets specifications for high snow-load and hurricane zones.
Black and Mill finish

Installs by hand.
Works over mounts.
Structurally connects and bonds rails automatically; UL2703 listed as reusable.

Dovetail shape for extra strength.
Uses 1/2" socket.





Multi-Clamp	Hidden End Clamp	Ground Lug	N-S Bonding Jumper
-------------	------------------	------------	--------------------

Fits 30-40mm PV frames, as mid- or end-clamp.
Twist-locks into position; doesn't pinch wires in rail.
Bonds modules to rail; UL2703 listed as reusable

Offers premium edge appearance.
Preinstalled pull-tab grips rail edge, allowing easy, one-hand installation.
Tucks away for reuse.

Holds 6 or 8 AWG wire.
Mounts on top or side of rail.
Assembled on MLPE Mount.
UL2703 listed as reusable.

Installs by hand, eliminates row-to-row copper wire.
UL2703 listed as reusable only with Pegasus Rail.

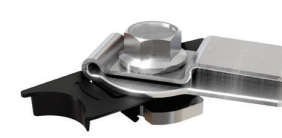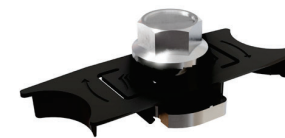

MLPE Mount	Cable Grip	Wire Clip	End Cap and Max End Cap
------------	------------	-----------	-------------------------

Secures and bonds most micro-inverters and optimizers to rail.
Connectors and wires easily route underneath after installation.
UL2703 listed as reusable.

Secures four PV wires or two trunk cables.
Stainless-steel backing provides durable grip.
Eliminates sagging wires.

Hand operable.
Holds wires in channel.
Won't slip.

Fits flush to PV module and hides raw or angled cuts.
Hidden drain quickly clears water from rail.

Certifications:

- UL 2703, Edition 1
- LTR-AE-001-2012
- ASCE 7-16 PE certified
- Class A fire rating for any slope roof
- FL Cert of Approval FL41396



Quickly calculate the most efficient layout, spans and materials needed to suit your job. Visit the Pegasus Customer Portal. pegasussolar.com/portal

Patents pending. All rights reserved. ©2023 Pegasus Solar Inc.

LOAD		SPAN				
SNOW (psf)	WIND (MPH)	32"	48"	72"	96"	120"
0	100	Pegasus Rail	Pegasus Rail	Pegasus Rail	Pegasus Rail	Pegasus Rail
	130					
10	140	Pegasus Rail	Pegasus Rail	Pegasus Rail	Pegasus Rail	Pegasus Max Rail
	190					
30	190	Pegasus Rail	Pegasus Rail	Pegasus Rail	Pegasus Rail	Pegasus Max Rail
50						
100						
120		Pegasus Rail	Pegasus Rail	Pegasus Rail	Pegasus Rail	Pegasus Max Rail


For reference only. Spans above are calculated using 7-16 for a Gable Roof, Exposure Category B, 0-20deg roof angle, 30ft mean roof height with non-exposed modules. For PE certified span tables, visit www.pegasussolar.com/spans.



SK'PRAIL

Skip Rows!

Eliminate entire rows of mounts, rails and clamps by adding just one SKU!

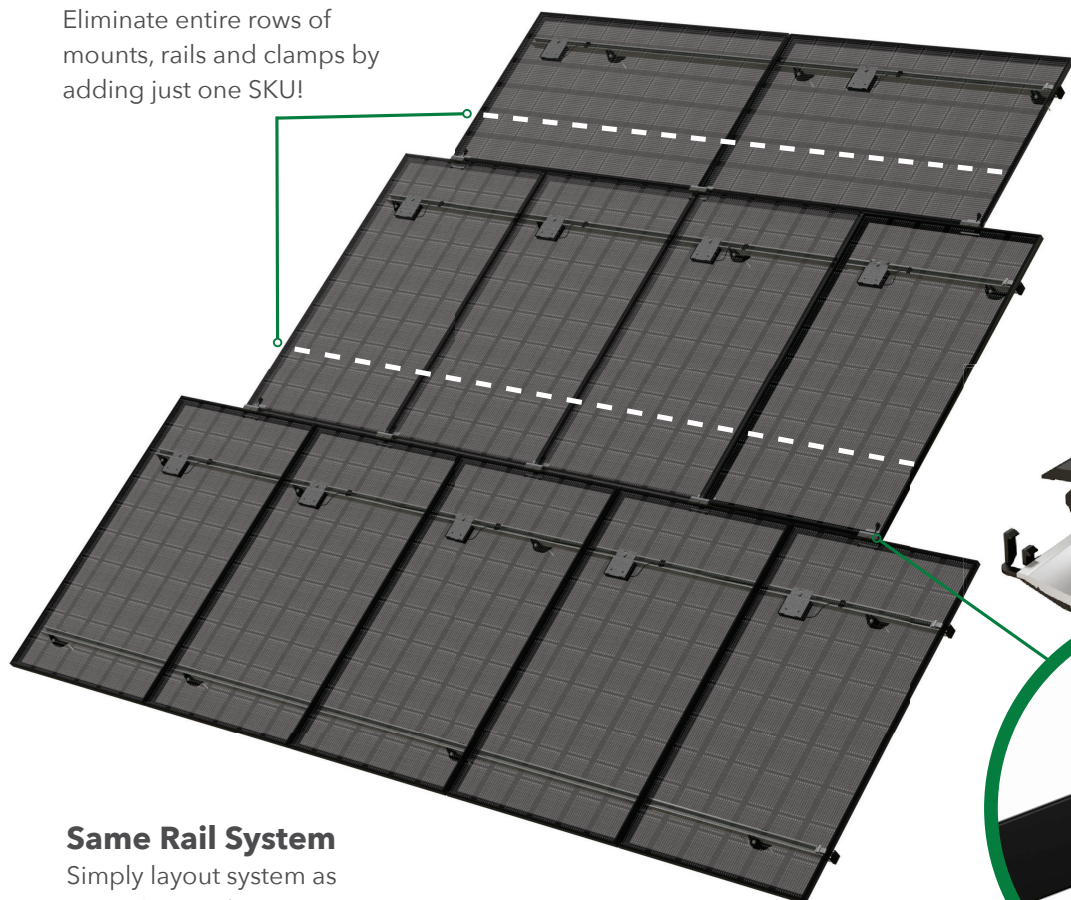

SkipRail Clamp

Structurally connects and bonds modules row-to-row
Eliminate leveling rails:
aligns module rows to be in-plane



Same Rail System

Simply layout system as normal, just "skip" rows 3,5,7,etc. of attachments, rails, and clamps

A Revolution in Solar Installations

Lower your costs and provide your crews a faster system by eliminating entire rows of mounts, rails and clamps with just one SKU.



Dramatically Lower Costs

25% fewer rails and clamps
15% fewer roof penetrations
3500 lbs less per MW to ship, warehouse, pack, and load



Recruit the Best Crews

Less work = happier crews
300 lbs less per week to haul
Faster install
Auto-levels modules



Easy to Implement

Minimal to no training
Same layout as standard rail
Same open-channel wire management



Universal to Any Roof


Comp, Tile, Metal, other.
Low slope, steep slopes
Easily work around roof obstructions
Mixed portrait / landscape




SK'PRAIL

SkipRail SAVINGS | 18% fewer attachments • 32% fewer feet of rails
22% fewer pounds to ship & warehouse

SkipRail SAVINGS | 21% fewer attachments • 30% fewer feet of rails
21% fewer pounds to ship & warehouse

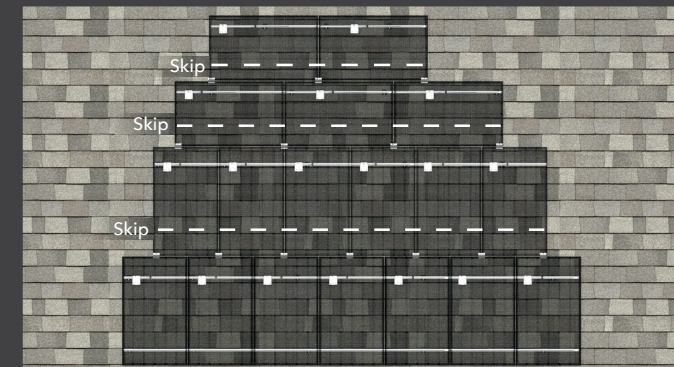


Example of Comp Roof Array

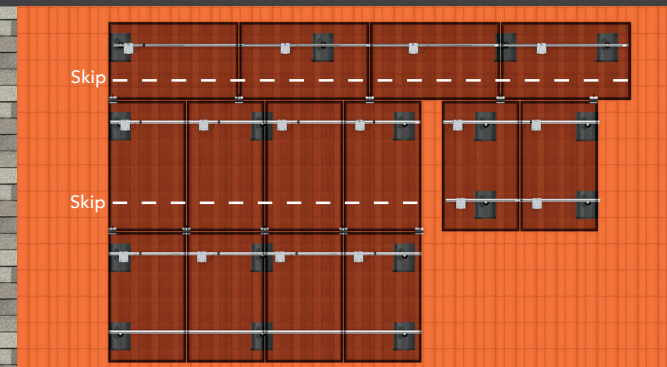


Example of Tile Roof Array

Free Design Tool:

pegasussolar.com/portal

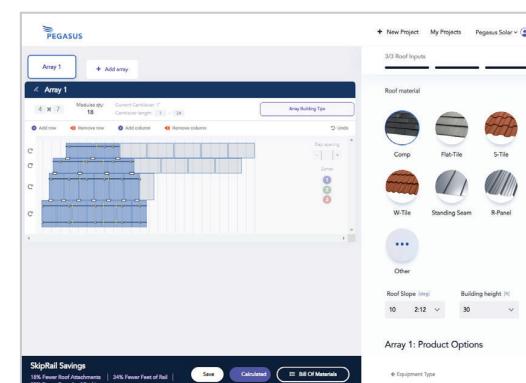

Where SkipRail Works

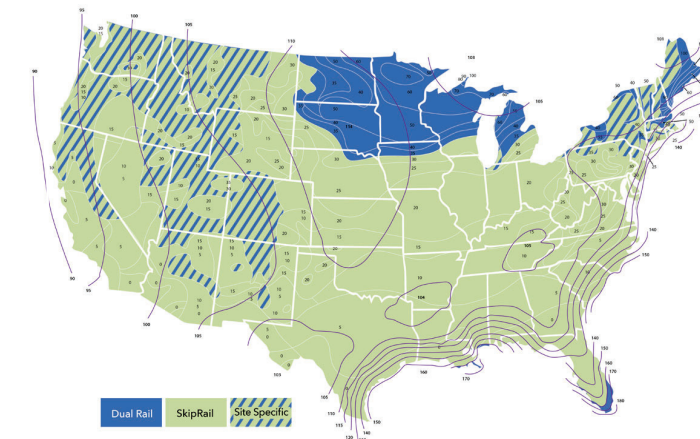

Specifications

	PSR-SRC	PSR-SRCK
SKU	PSR-SRC	PSR-SRCK
Type	Floating Clamp	Extra support with Kickstand
Finish	Black	
PV module frames	30, 32, 35, 40mm	
Certifications	ASCE 7-16, IBC, CBC, UL2703	
Applicable Roof Types	Any	
Compatible Rail Systems	Pegasus Rail System	
Kit Contents	Pegasus SkipRail Clamp	Pegasus SkipRail Clamp with Kickstand
Kit Quantity	20	30

Patents pending. All rights reserved. ©2023 Pegasus Solar Inc.




SCAN FOR VIDEO



SCAN FOR FREE TRIAL

Pegasus Rail System - Bond Path to Ground

Ground Lug & N-S Bonding Jumper

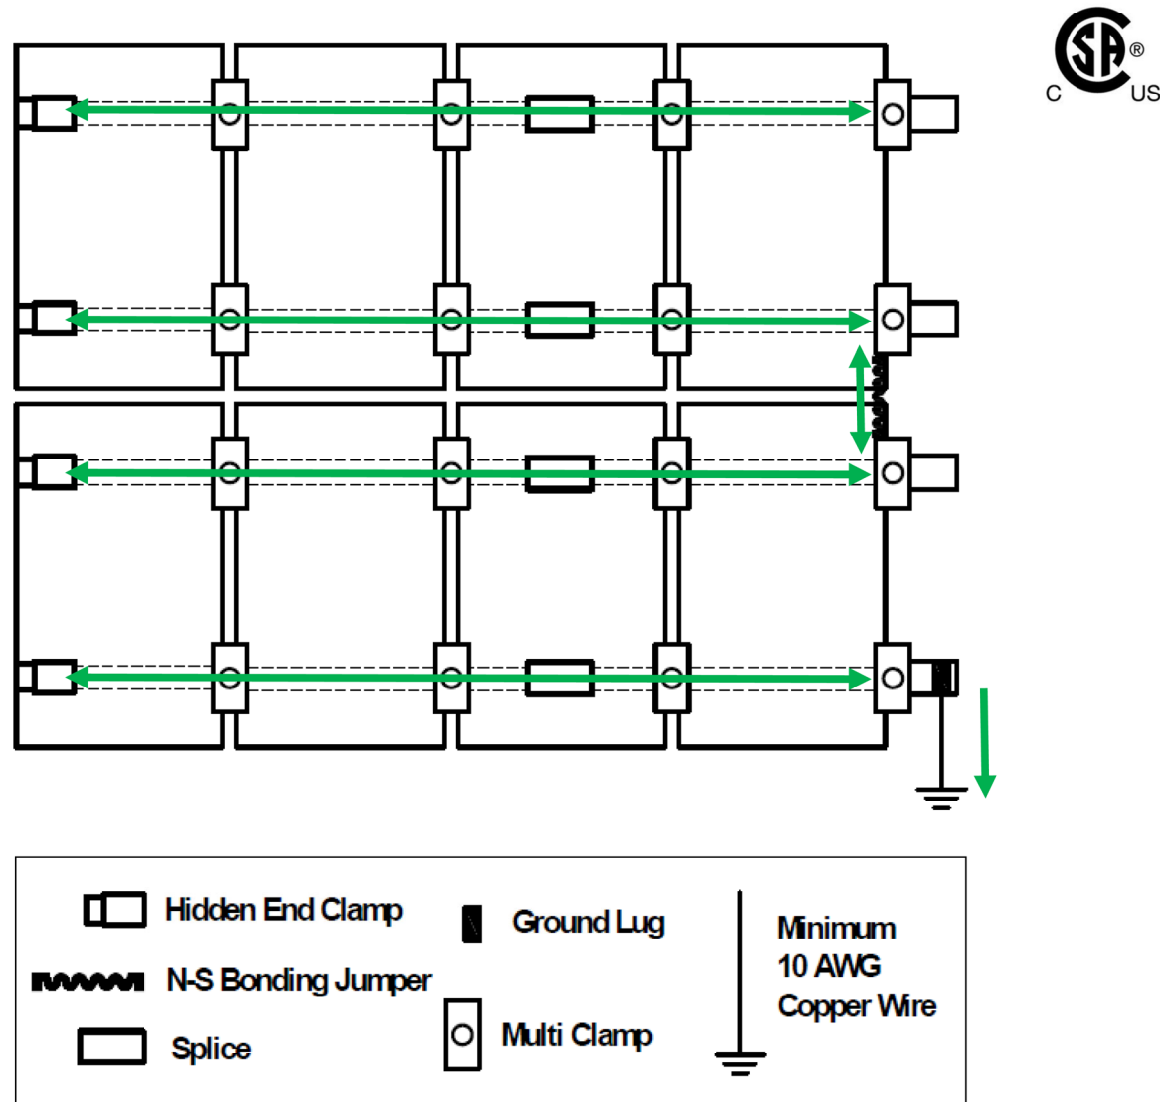

Multi-Clamps bond adjacent PV modules to one another and to the Rail. The Splice provides a bond connection between two Rail sections, including when a 1" thermal gap is utilized. The N-S Bonding Jumper will provide a bonding path between rows of PV modules, so that one Ground Lug per array is necessary for earth ground. If a thermal break is left between two sections or Rail, the Multi-Clamps will provide a bond path across the two Rails through the PV module frame.


The N-S Bonding Jumper may only be used with the Pegasus Rail System, and is not certified for use with any other mounting system.

If the N-S Bonding Jumper needs to be removed during maintenance, a second N-S Bonding Jumper shall first be



Pegasus Rail System - Bond Path to Ground

Ground Lug for each PV Module Row

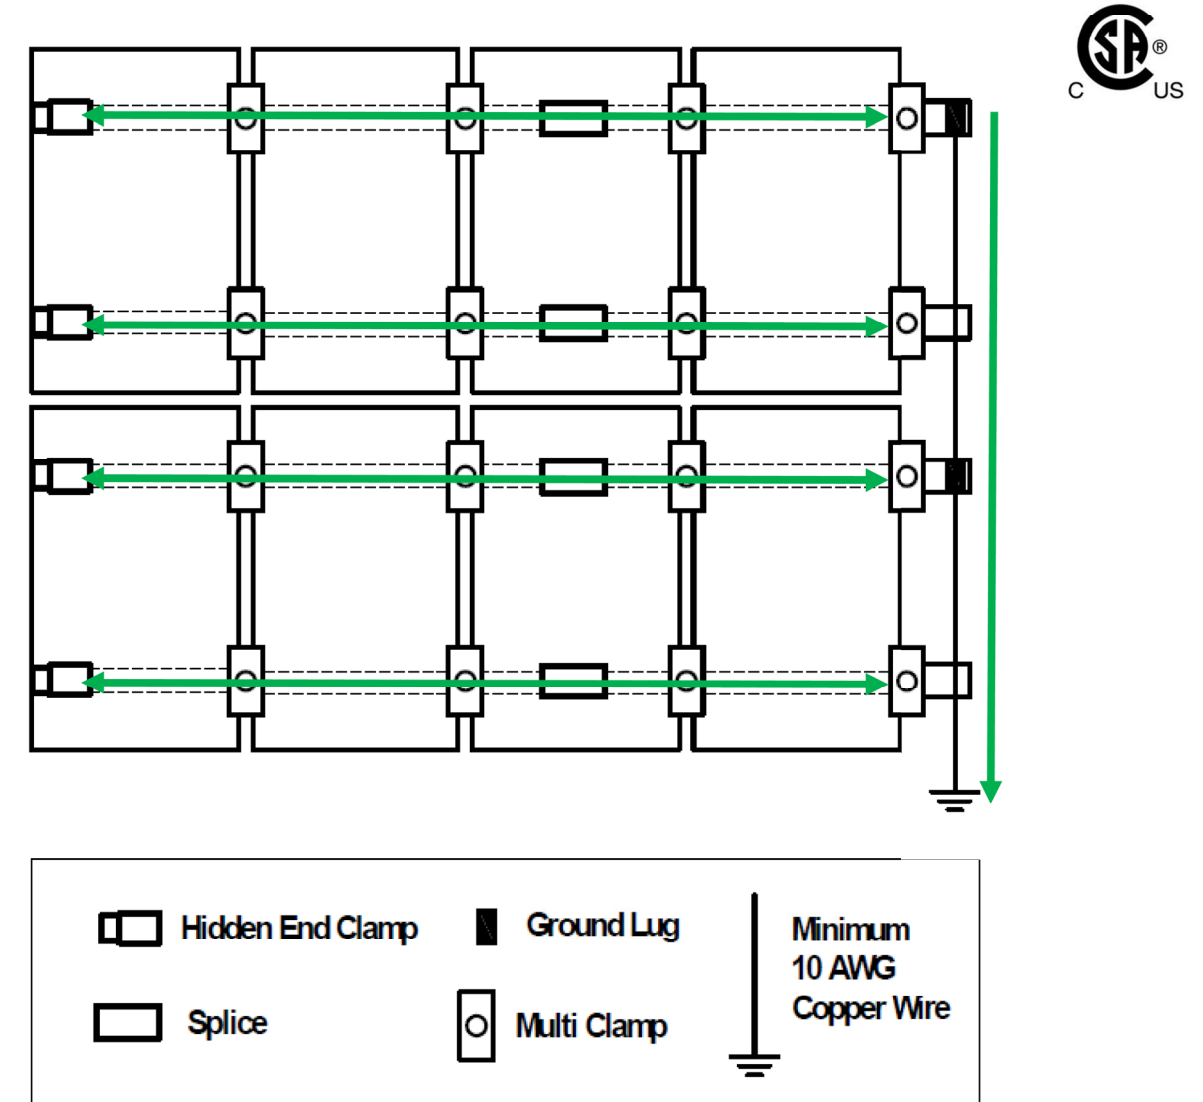


Multi-Clamps bond adjacent PV modules to one another and to the Rail. The Splice provides a bond connection between two Rail sections, including when a 1" thermal gap is utilized. One Ground Lug is required per row of PV Modules, with a final earth ground connection at the terminal end of the ground wire. If a thermal break is left between two sections or Rail, the Multi-Clamps will provide a bond path across the two Rails through the PV module frame.



Pegasus Rail System - Bond Path to Ground

SkipRail System

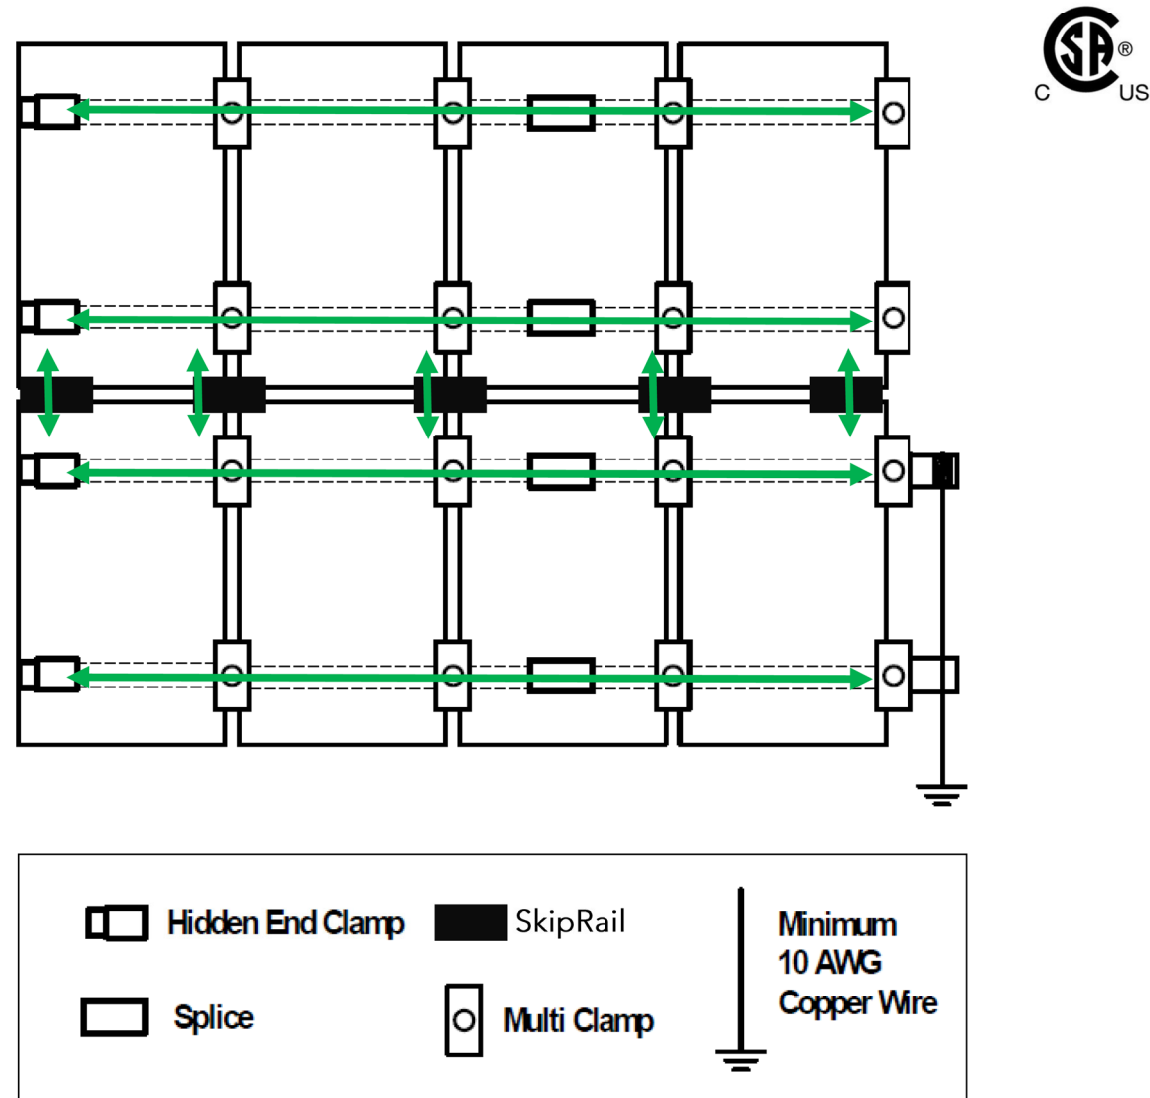


Multi-Clamps bond adjacent PV modules to one another and to the Rail. The Splice provides a bond connection between two Rail sections, including when a 1" thermal gap is utilized. The SkipRail Splices will provide a bonding path between rows of PV modules, so that one Ground Lug per array is necessary for earth ground. If a thermal break is left between two sections or Rail, the Multi-Clamps will provide a bond path across the two Rails through the PV module frame.



Pegasus Rail System - Bond Path to Ground

Using Enphase Products

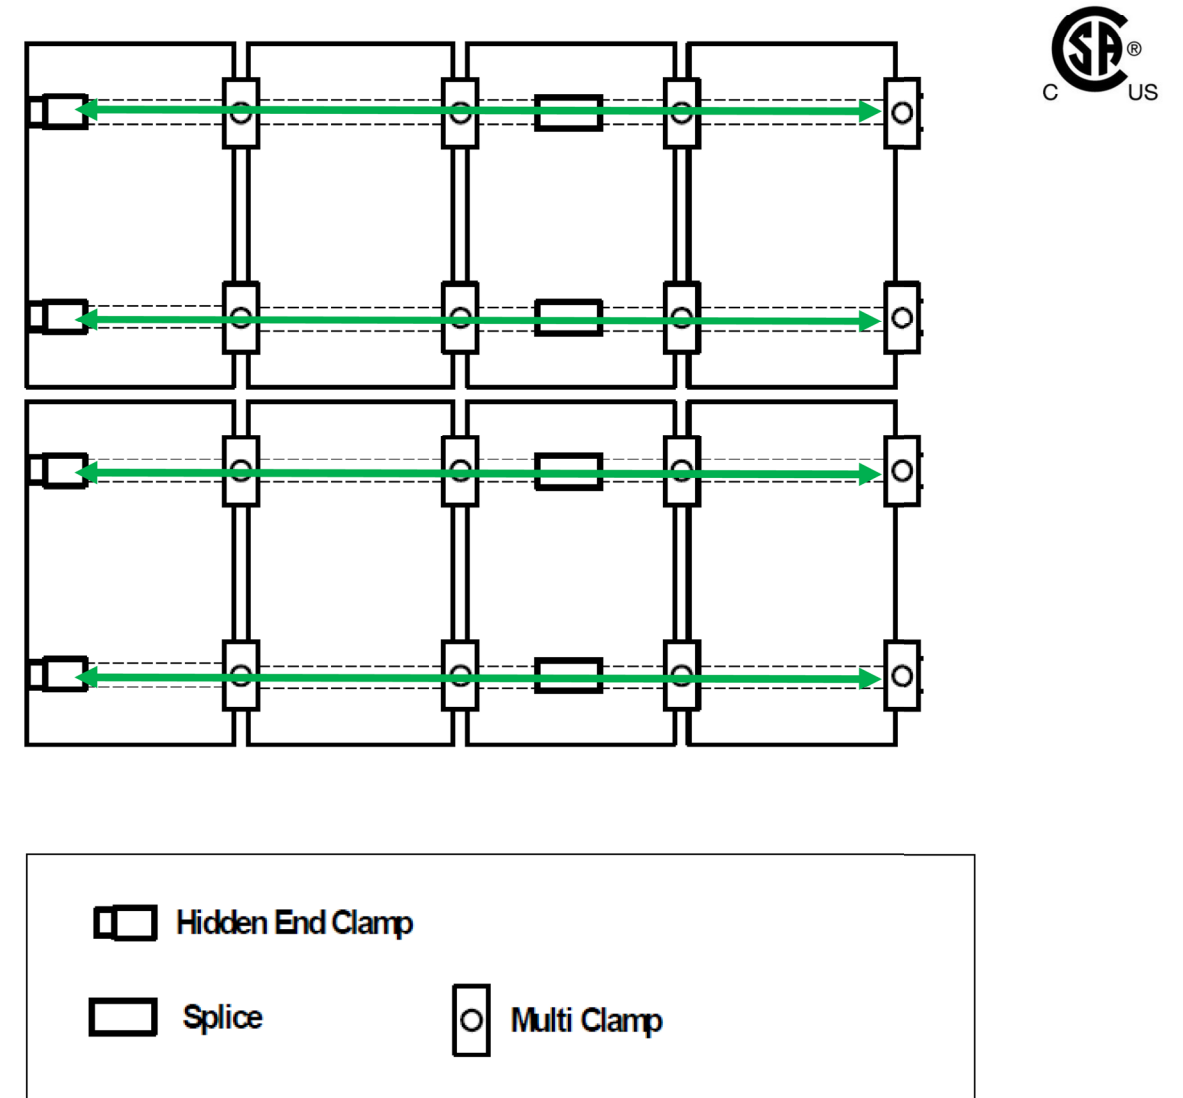

Multi-Clamps bond adjacent PV modules to one another and to the Rail. The Splice provides a bond connection between two Rail sections, including when a 1" thermal gap is utilized. The MLPE Mount creates a bond connection to the MLPE. When using Enphase products, Ground Lug, N-S Bonding Jumpers, or other equipment ground conductors (EGC) are not required, and the use of the Enphase products satisfies the UL2703 bonding and grounding requirements.

Compatible Enphase products:

- Microinverters M250-72, M250-60, M215-60, C250-72; with Engage cables ETXX-240, ETXX-208, ETXX-277



Appendix A - Compatible PV Mod-

Pegasus Rail System may be used to ground a PV module complying with UL 2703 only when the specific module has been evaluated for grounding and/or mounting in compliance with this installation manual. Unless otherwise specified, "xxx" refers to the power rating of the PV module. Both black & silver frames are included in the UL2703 listing.



Manufacturer	Model
Auxin	AXN6M61Z1-xxx
Aptos	DNA-144-BF26-xxxW; DNA-144-MF26-xxxW; DNA-120-BF26-xxxW; DNA-120-MF26-xxxW; DNA-120-MF10-xxxW; DNA-120-BF10-xxxW; DNA-108-BF10-xxxW; DNA-108-MF10-xxxW
Axitec	AC-xxxM/156-60S; AC-xxxM/60S; AC-xxxMH/120S; AC-xxxMH/144S
Boviet	BVM6610M-xxx; BVM6610P-xxx
Canadian Solar	CS1H-xxxMS; CS1K-xxxMS; CS1Y-xxxMS; CS3K-xxxMS; CS3U-xxxMS; CS6K-xxxM; CS6K-xxxMS; CS6K-xxxP; CS6U-xxxM; CS6U-xxxP; CS6X-xxxM; CS6X-xxxP; BiHiKu CS3W-xxxMB-AG; CS3L-xxxMS; CS6R-xxxMS; CS3W-xxxPB-AG; CS3W-xxxP; CS3W-xxxMS; CS3L-xxxP; CS3L-xxxMS; CS3N-xxxMS; CS6W-xxxMB-AG; CS7N-xxxMB-AG
CertainTeed	CTxxxHC11-04; CTxxxM10-02; CTxxxM11-02; CTxxxM11-03; CTxxxHC00-04; CTxxxHC12-06; CTxxxHC11-06
Chint Solar	CHSM6612M-xxx
Freedom Forever	FF-MP-BBB-xxx
Hansol	HSxxxTD-AN3
Heliene	Heliene20M xxx; Heliene36M xxx; Heliene36P xxx; Heliene60M xxx; Heliene60P xxx; Heliene72M Bifacial xxx; Heliene72P xxx; Heliene96M xxx Bifacial; Heliene96M xxx; Heliene 96P xxx; HSPE-144M M6 HC Bifacial xxx; HSPE 120M M6 HC Monofacial xxx; 144HC-M10-Bifacial; 460-144M-HC-M6
Hyundai	HiD-SxxxRG(BK); HiS-MxxxRG; HiS-SxxxKI; HiS-SxxxRG; HiS-SxxxRG(BK); HiS-SxxxHI; HiS-SxxxHI; HIA-SxxxHI
JA Solar	JAM72S01-xxx/PR; JAP72S01-xxx/SC; JAM72D20-xxx/MB
Jinko	JKMxxxM-60; JKMxxxM-60B; JKMxxxM-60BL; JKMxxxM-60HBL; JKMxxxM-60HL; JKMxxxM-60L; JKMxxxM-60V; JKMxxxM-72; JKMxxxM-72HL-V; JKMxxxM-72H-V; JKMxxxM-72-V; JKMxxxP-60; JKMxxxPP-60; JKMxxxN-6RL3; JKMxxxM-6RL3-B; JKMxxxM-7RL3-TV
LG	LGN1K-G4; LG51C-A5; LGxxxA1C-A5; LGxxxE1C-A5; LGxxxE1K-A5; LGxxxN1C-A3; LGxxxN1C-A5; LGxxxN1C-B3; LGxxxN1C-G3; LGxxxN1C-G4; LGxxxN1C-V5; LGxxxN1C-Z4; LGxxxN1K-A5; LGxxxN1K-G4; LGxxxN1K-V5; LGxxxN1K-Z4; LGxxxN2T-A5; LGxxxN2W-A5; LGxxxN2W-L5; LGxxxN2W-V5; LGxxxQ1C-A5; LGxxxQ1C-V5; LGxxxQ1K-A5; LGxxxQ1K-V5; LGxxxS1C-A5; LGxxxS1C-G4; LGxxxS2W-A5; LGxxxN1K-L5; LGxxxNIC-N5; LGxxxM1K-A6; LGxxxN1K-B6; LGxxxQ1C-A6; LGxxxQAC-A6; LGxxxQAK-A6; LGxxxM1C-A6; LGxxxN2W-E6; LGxxxN2T-E6; LGxxxN1K-E6; LGxxxN3K-V6; LGxxxN1C-A6
Longi	LR6-60BP-xxx; LR6-60HPB-xxx; LR6-60HPH-xxx; LR6-60PB-xxx; LR6-60PE-xxx; LR6-60-xxx; LR4-60HPH-xxxM; LR4-HPB-xxxM; LR4-72HPH-xxxM; LR4-72HBD-xxxM; LR5-54HPH-xxxM; LR5-72HBD-xxxM
Maxeon	SPR-MAX3-xxx-COM; SPR-MAX3-xxx-BLK; SPR-MAX5-xxx-COM; SPR-MAX6-xxx-COM; SPR-X21/22-xxx-COM; SPR-MAX3-XXX-BLK-R;
Mission Solar	MSE60Axxx; MSExxxSB1A; MSExxxSO6J; MSExxxSQ5K; MSExxxSQ5T; MSExxxSQ8K; MSExxxSQ8T; MSExxxSQ9S; MSExxxSQ9S; MSExxxSX6S; MSExxxSX6W; MSExxxSX5T; MSExxxSX5K; MSExxxSX5R; MSExxxSX6Z; MSExxxSX9R; MSExxxSX9Z
Mitrex	Mxxx-L3H; Mxxx-I3H; Mxxx-H1H; Mxxx-B1F; Mxxx-A1F
Panasonic	VBHNxxxKA01; VBHNxxxKA03; VBHNxxxSA16; VBHNxxxSA16B; VBHNxxxSA17; VEHNxxxSA17E; EVPVxxx; EVPVxxxK; EVPVxxxPK; EVPVxxxH
Philadelphia Solar	PS-M60(BF)-xxx; PS-M72(BF)-xxx
QCells	Q.Peak 265; Q.PEAK BLK-G3.1 xxx; Q.PEAK BLK-G4.1 xxx; Q.PEAK DUO BLK-G5 xxx; Q.PEAK DUO BLK-G5/SC xxx; Q.PEAK DUO BLK-G6+ xxx; Q.PEAK DUO G6+ xxx AC ENP IQ7+; Q.PEAK DUO BLK G9+ xxx; Q.PEAK DUO L-G5.2 xxx; Q.PEAK DUO L-G5.3 xxx; Q.PEAK DUO-G5 xxx; Q.PEAK DUO-G5/SC xxx; Q.PEAK DUO-G7 xxx; Q.PEAK G4.1 xxx; Q.PEAK G4.1/ Max xxx; Q.PEAK G4.1/SC xxx; Q.PEAK G4.1/TAA xxx; Q.PEAK L-G4.2 xxx; Q.PLUS BFR G4.1 xxx; Q.PLUS BFR-G4.1/TAA xxx; Q.PLUS L-G4.1 xxx; Q.PLUS L-G4.2 xxx; Q.PLUS L-G4.2/TAA xxx; Q.PRO BFR-G4.1 xxx; Q.PEAK DUO L-G8.2 xxx; Q.PEAK DUO BLK-G8 xxx; Q.PEAK DUO BLK-G8+ xxx; Q.PEAK DUO BLK ML G9 xxx; Q.PEAK DUO BLK ML G9+ xxx; Q.PEAK DUO BLK-G10 xxx; Q.PEAK DUO BLK-G10+ xxx; Q.PEAK DUO ML-G10+; Q.PEAK DUO BLK ML-G10.a+; Q.PEAK Duo XL 10.d/BFG; Q.PEAK DUO-G10 xxx; Q.PEAK DUO-G10+ xxx; Q.PEAK DUO-G10.a xxx; Q.PEAK DUO-G10.a+ xxx; Q.PEAK DUO BLK-G10.a xxx; Q.PEAK DUO BLK-G10.a+ xxx; Q.PEAK DUO ML-G10 xxx; Q.PEAK DUO ML-G10.a xxx; Q.PEAK DUO ML-G10.a+ xxx; Q.PEAK DUO BLK ML-G10 xxx; Q.PEAK DUO BLK ML-G10+ xxx; Q.PEAK DUO BLK ML-G10.a xxx; Q.PEAK Duo ML-G10+/t xxx; Q.Tron BLK M-G2+ xxx; Q.Tron M-G2+ xxx;
REC	RECxxxNP; RECxxxNP Black; RECxxxPE; RECxxxPE 72; RECxxxPE(BLK); RECxxxTP; RECxxxTP BLK; RECxxxTP2; RECxxxTP2 BLK; RECxxxTP2 BLK Q2; RECxxxTP2 BLK Q2; RECxxxTP2 BLK Q2; RECxxxTP2M; RECxxxTP2S 72; RECxxxAA; RECxxxAA Black; RECxxxAA 72; RECxxxNP3; RECxxxNP3 Black; RECxxxNP2; RECxxxNP2 Black; RECxxxAA Pure; RECxxxAA Pure-R
S-Energy	SNxxxM-10; SNxxxM-10(B); SNxxxM-10T; SC20-60MBE-xxxM
SEG	SEG-xxx-BMA-HV; SEG-xxx-BMA-TB; SEG-xxx-BMA-BG; SEG-xxx-BMB-HV; SEG-xxx-BMA-BG; SEG-xxx-BMD-HV; SEG-xxx-BMD-TB; SEG-xxx-BMB-BG; SEG-xxx-BMC-HV; SEG-xxx-BMC-TB; SEG-xxx-BMC-BG
Silfab	SILxxxBL; SILxxxNL; SLAxxxM; SLAxxxM; SLGxxxM; SSAxxxM; SIL-xxxNX; SIL-xxxHL; SIL-xxxNX; SIL-xxxBK; SIL-xxxHC; SIL-xxxHC+; SIL-xxxBG; SIL-xxxHN; SIL-xxxHM
Solar4America	S4A410 72MH5BB, S4A33 60MH5BB



Appendix B - SkipRail Compatible PV Modules

The following PV modules are structurally compatible with the SkipRail installation method.

Manufacturer	Model
Aptos	DNA-144-BF26-xxxW; DNA-144-MF26-xxxW; DNA-120-BF26-xxxW; DNA-120-MF26-xxxW; DNA-120-MF10-xxxW; DNA-120-BF10-xxxW; DNA-108-BF10-xxxW; DNA-108-MF10-xxxW
Jinko	JKMxxxM-72HL-V; JKMxxxM-72HBL-V; JKMxxxM-6RL3-V; JKMxxxM-6RL3-B
Longi	LR6-60BP-xxx; LR6-60HPB-xxx; LR6-60HPH-xxx; LR6-60PB-xxx; LR6-60PE-xxx; LR6-60-xxx; LR4-60I IPI I-xxxM; LR4-60HPB-xxxM; LR4-72HPH- xxxM; LR4-72HBD-xxxM; LRS-54HPH-xxxM; LRS-54HPB-xxxM; LRS-54HABB-xxxM; LRS-54HABD-xxxM; LRS-66HPH-xxxM
QCells	Q.PEAK DUO BLK-G10 xxx; Q.PEAK DUO BLK-G10+ xxx; Q.PEAK DUO ML-G10+; Q.PEAK DUO BLK ML-G10.a+; Q.PEAK Duo XL 10.d/BFG; Q.PEAK DUO-G10 xxx; Q.PEAK DUO-G10+ xxx; Q.PEAK DUO-G10.a xxx; Q.PEAK DUO-G10.a+ xxx; Q.PEAK DUO BLK ML-G10 xxx; Q.PEAK DUO ML-G10.a xxx; Q.PEAK DUO ML-G10.a+ xxx; Q.PEAK DUO BLK ML-G10 xxx; Q.PEAK DUO BLK ML-G10+ xxx; Q.PEAK DUO BLK ML-G10.a xxx; Q.PEAK Duo ML-G10+/t xxx
Mission Solar	MSExxxSX6W; MSExxxSX5T; MSExxxSX5K; MSExxxSX6Z; MSExxxSX6S; MSExxxSX9R; MSExxxSX9Z
REC	RECxxxNP; RECxxxNP Black; RECxxxPE; RECxxxPE 72; RECxxxPE(BLK); RECxxxTP; RECxxxTP BLK; RECxxxTP2; RECxxxTP2 BLK; RECxxxTP2 BLK Q2; RECxxxTP2 BLK Q2; RECxxxTP2M; RECxxxTP2S 72; RECxxxAA; RECxxxAA Black; RECxxxAA 72; RECxxxNP3; RECxxxNP3 Black; RECxxxNP2; RECxxxNP2 Black; RECxxxAA Pure; RECxxxAA Pure-R
SEG Solar	SEG-xxx-BTB-BG; SEG-xxx-BTD-BG; SEG-xxx-BMB-HV; SEG-xxx-BMD-HV; SEG-xxx-BMB-BG; SEG-xxx-BMD-BG; SEG-xxx-BMB-TB; SEG-xxx-BMD-TB
Silfab	SIL-xxxHC
URE Co.	FBMxxxMFG; FBMxxxMFG-BB
Waaree	WSMDi-xxx
ZN Shine	ZXM7-UHLDD144-xxx/N; ZXM7-SHLDD144-xxx/M; ZXM6-NHLDD144xxx/M



Non-Fusible Switching Devices & Safety Switches

Product Selection

UL listed File No. E5239

1

DG321NRB

120/240 Vac General-Duty, Fusible, Single-Throw, continued



System	Ampere Rating	Fuse Type Provision	Maximum Horsepower Ratings ^①			DC 250V	NEMA 1 Enclosure Indoor Catalog Number	NEMA 3R Enclosure Rainproof Catalog Number
			Single-Phase AC 120V	240V	Three-Phase AC 240V			
Cartridge Type—Three-Pole, Three-Wire (Three Blades, Three Fuses)—240 Vac								
	30	—	—	—	—	—	②	②
	60	—	—	—	—	—	②	②
	100	—	—	—	—	—	②	②
	200	H	—	15	25-60	—	DG324FGK ^{③④}	②
	400	H	—	—	50-125	—	DG325FGK ^{③④}	DG325FRK ^{③④}
	600	H	—	—	75-200	—	DG326FGK ^{③④}	DG326FRK ^{③④}
Cartridge Type—Four-Wire (Three Blades, Three Fuses, S/N)—120/240 Vac								
	30	H	—	1-1/2-3	3-7-1/2	—	DG321NGB	DG321NRB
	60	H	—	3-10	7-1/2-15	—	DG322NGB	DG322NRB
	100	H	—	7-1/2-15	15-30	—	DG323NGB	DG323NRB
	200	H	—	15	25-60	—	DG324NGK	DG324NRK
	400	H	—	—	50-125	—	DG325NGK	DG325NRK
	600	H	—	—	75-200	—	DG326NGK	DG326NRK

DG322URB

120/240 Vac General-Duty, Non-Fusible, Single-Throw



System	Ampere Rating	Maximum Horsepower Ratings			DC 250V	NEMA 1 Enclosure Indoor Catalog Number	NEMA 3R Enclosure Rainproof Catalog Number
		Single-Phase AC 120V	240V	Three-Phase AC 240V			
Two-Pole, Two-Wire (Two Blades)—240 Vac							
	30	2	3	—	—	DG221UGB ^④	DG221URB ^④
	60	3	10	—	—	DG222UGB ^④	DG222URB ^④
	100	—	15	—	—	DG223UGB ^④	DG223URB ^④
	200	—	15	—	—	④⑤	DG224URK ^④
Three-Pole, Three-Wire (Three Blades)—240 Vac							
	30	2	3	7-1/2	—	DG321UGB ^④	DG321URB ^④
	60	3	10	15	—	DG322UGB ^④	DG322URB ^④
	100	—	15	30	—	DG323UGB ^④	DG323URB ^④
	200	—	15	60	—	DG324UGK ^④	DG324URK ^④
	400	—	—	125	—	DG325UGK ^④	DG325URK ^④
	600	—	—	200	—	DG326UGK ^④	DG326URK ^④

Notes

- ① Maximum hp ratings apply only when dual element time delay fuses are used.
 - ② Use four-wire catalog numbers below.
 - ③ Solid neutral bars are not included. Order separately from table on Page V2-T1-13.
 - ④ **WARNING!** Switch is not approved for service entrance unless a neutral kit is installed.
 - ⑤ Use three-wire catalog numbers below.
- All general-duty safety switches are individually packaged.
- Accessories are limited in scope on general-duty safety switches. See Page V2-T1-13 for availability. In addition, clear line shields are available as an accessory on 200-600A general-duty switches. Catalog Numbers: 200A = 70-7759-11, 400A = 70-8063-8, 600A = 70-8064-8.

Fusible Switching Devices & Safety Switches

Product Selection

120/240 Vac General-Duty, Fusible, Single Throw

Specifications

- 30 – 600 amperes.
- Suitable for service entrance applications unless otherwise noted.
- Horsepower rated.
- Bolt-on hub provision. Provided for general-duty switches in a NEMA 3R enclosure. See Page 8-7 for selection.
- UL listed File No. E5239. Meets UL 98 for enclosed switches and NEMA Std. KS-1.
- 200 – 600 ampere switches incorporate K-Series design.



DP221NGB



DG321NRB

2

Table 8-40. 120/240 Vac General-Duty, Fusible, Single Throw

System	Ampere Rating	Fuse Type Provision	Maximum Horsepower Ratings ^①				NEMA 1 Enclosure Indoor		NEMA 3R Enclosure Rainproof	
			Single-Phase ac		3-Phase ac	dc	Catalog Number	Price U.S. \$	Catalog Number	Price U.S. \$
			120 Volt	240 Volt	240 Volt	250 Volt				

Fusible — Plug Type^②

2-Wire (One Blade, One Fuse, S/N) — 120 Vac

	30	Plug (Type S, T or W)	1/2-2	—	—	—	—	DP111NGB	—	—
--	----	-----------------------	-------	---	---	---	---	----------	---	---

3-Wire (Two Blades, Two Fuses, S/N) — 120/240 Vac

	30	Plug (Type S, T or W)	1/2-2	1-1/2-3	—	—	—	DP221NGB	—	Use cartridge-type fuse catalog number DG221NRB
--	----	-----------------------	-------	---------	---	---	---	----------	---	---

Fusible — Cartridge Type

2-Pole 2-Wire (Two Blades, Two Fuses) — 240 Vac

	30	—	—	1-1/2-3	3-7-1/2	—	③	—	③	—
	60	—	—	3-10	7-1/2-15	—	③	—	③	—
	100	—	—	7-1/2-15	15-30	—	③	—	③	—
	200	—	—	15	25-60	—	③	—	③	—
	400	H	—	—	50-125	—	—	DG225FGK ^{④⑤}	—	DG225FRK ^{④⑤}
	600	H	—	—	75-200	—	—	DG226FGK ^{④⑤}	—	DG226FRK ^{④⑤}







3-Wire (Two Blades, Two Fuses, S/N) — 120/240 Vac

	30	H	—	1-1/2-3	3-7-1/2 ^⑥	—	—	DG221NGB	—	DG221NRB
	60	H	—	3-10	7-1/2-15 ^⑥	—	—	DG222NGB	—	DG222NRB
	100	H	—	7-1/2-15	15-30 ^⑥	—	—	DG223NGB	—	DG223NRB
	200	H	—	15	25-60 ^⑥	—	—	DG224NGK	—	DG224NRK
	400	H	—	—	50-125 ^⑥	50	—	DG225NGK	—	DG225NRK
	600	H	—	—	75-200 ^⑥	—	—	DG226NGK	—	DG226NRK


- ① Maximum hp ratings apply only when dual element time delay fuses are used.
- ② These switches do not have an interlock which prevents door from being opened when switch is in the ON position.
- ③ Use 3-wire catalog numbers below.
- ④ Solid neutral bars are not included. Order separately from Table 8-1 on Page 8-5.
- ⑤ **WARNING!** Switch is not approved for service entrance unless a neutral kit is installed.
- ⑥ Grounded B phase rating, UL listed.

Note: All general-duty safety switches are individually packaged.

Note: Accessories are limited in scope on general-duty safety switches. See Page 8-5 for availability. In addition, clear line shields are available as an accessory on 200 – 600 ampere general-duty switches. Catalog Numbers: 200 A = 70-7759-11, 400 A = 70-8063-8, 600 A = 70-8064-8.

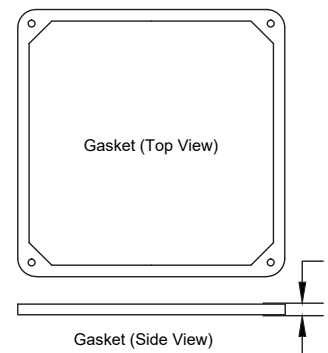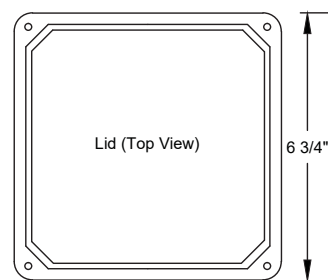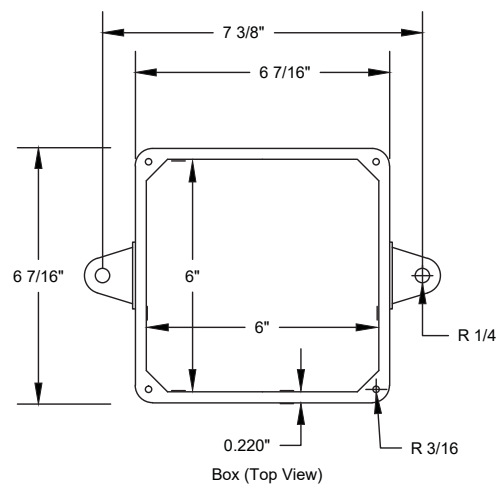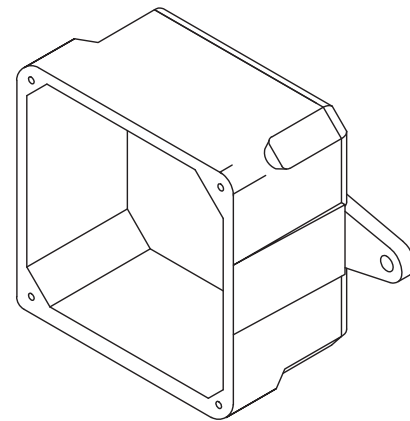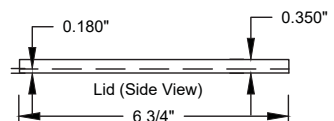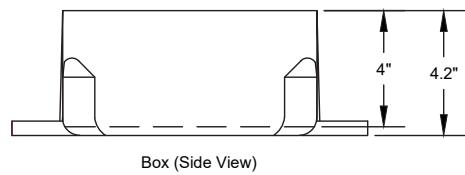

UL Listed
 Marine Listed
 UL File # E205935 (QCUP)
 UL Control # 92CM
 Material is Rigid PVC
 132 cu in Volume (2163 cu cm)
 Screws are Zinc Plated Steel
 Gasket is neoprene

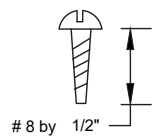

CANTEX INC. Fort Worth, TEXAS		
Junction Box 6 x 6 x 4		
Drawn By: O.M.	Date: 6/19/17	5133710

Powerwall 3

Power Everything

Powerwall 3 is a fully integrated solar and battery system, designed to accelerate the transition to sustainable energy. Customers can receive whole home backup, cost savings, and energy independence by producing and consuming their own energy while participating in grid services. Once installed, customers can manage their system using the Tesla App to customize system behavior to meet their energy goals.

Powerwall 3 achieves this by supporting up to 20 kW DC of solar and providing 11.5 kW AC of continuous power per unit. It has the ability to start heavy loads up to 185 A LRA, meaning a single unit can support the power needs of most homes. Powerwall 3 is designed for mass production, fast and efficient installations, easy system expansion, and simple connection to any electrical service.



Powerwall 3 Technical Specifications

System Technical Specifications	
Model Number	1707000-xx-y
Nominal Grid Voltage (Input & Output)	120/240 VAC
Grid Type	Split phase
Frequency	60 Hz
Overcurrent Protection Device	Configurable up to 60 A
Solar to Battery to Home/Grid Efficiency	89% ^{1,2}
Solar to Home/Grid Efficiency	97.5% ³
Supported Islanding Devices	Backup Gateway 2, Backup Switch
Connectivity	Wi-Fi (2.4 and 5 GHz), Dual-port switched Ethernet, Cellular (LTE/4G ⁴)
Hardware Interface	Dry contact relay, Rapid Shutdown (RSD) certified switch and 2-pin connector, RS-485 for meters
AC Metering	Revenue Grade (+/- 0.5%)
Protections	Integrated arc fault circuit interrupter (AFCI), Isolation Monitor Interrupter (IMI), PV Rapid Shutdown (RSD) using Tesla Mid-Circuit Interrupters
Customer Interface	Tesla Mobile App
Warranty	10 years

Solar Technical Specifications	
Maximum Solar STC Input	20 kW
Withstand Voltage	600 V DC
PV DC Input Voltage Range	60 – 550 V DC
PV DC MPPT Voltage Range	150 – 480 V DC
MPPTs	6
Maximum Current per MPPT (I_{mp})	13 A ⁵
Maximum Short Circuit Current per MPPT (I_{sc})	15 A ⁵

Battery Technical Specifications	
Nominal Battery Energy	13.5 kWh AC ²
Maximum Continuous Discharge Power	11.5 kW AC
Maximum Continuous Charge Power	5 kW AC
Output Power Factor Rating	0 - 1 (Grid Code configurable)
Maximum Continuous Current	48 A
Maximum Output Fault Current	10 kA
Load Start Capability (1 s)	185 A LRA
Power Scalability	Up to 4 Powerwall 3 units supported

¹ Typical solar shifting use case.

² Values provided for 25°C (77°F), at beginning of life. 3.3 kW charge/discharge power.

³ Tested using CEC weighted efficiency methodology.

⁴ Cellular connectivity subject to network service coverage and signal strength.

⁵ Where the DC input current exceeds the MPPT rating, a jumper can be used to combine two MPPTs into a single input to intake DC current up to 26 A I_{MP} / 30 A I_{SC} .

Powerwall 3 Technical Specifications

Environmental Specifications

Operating Temperature	-20°C to 50°C (-4°F to 122°F) ⁶
Operating Humidity (RH)	Up to 100%, condensing
Storage Temperature	-20°C to 30°C (-4°F to 86°F), up to 95% RH, non-condensing, State of Energy (SOE): 25% initial
Maximum Elevation	3000 m (9843 ft)
Environment	Indoor and outdoor rated
Enclosure Rating	NEMA 3R
Ingress Rating	IP67 (Battery & Power Electronics) IP45 (Wiring Compartment)
Pollution Rating	PD3
Operating Noise @ 1 m	< 50 db(A) typical < 62 db(A) maximum


⁶ Performance may be de-rated at operating temperatures above 40°C (104°F).

Compliance Information

Certifications	UL 1642, UL 1699B, UL 1741, UL 1741 SA, UL 1741 SB, UL 1741 PCS, UL 3741, UL 1973, UL 1998, UL 9540, IEEE 1547-2018, IEEE 1547.1, UN 38.3
Grid Connection	United States
Emissions	FCC Part 15 Class B
Environmental	RoHS Directive 2011/65/EU
Seismic	AC156, IEEE 693-2005 (high)
Fire Testing	Meets the unit level performance criteria of UL 9540A

Mechanical Specifications

Dimensions	1099 x 609 x 193 mm (43.25 x 24 x 7.6 in)
Weight	130 kg (287 lb)
Mounting Options	Floor or wall mount

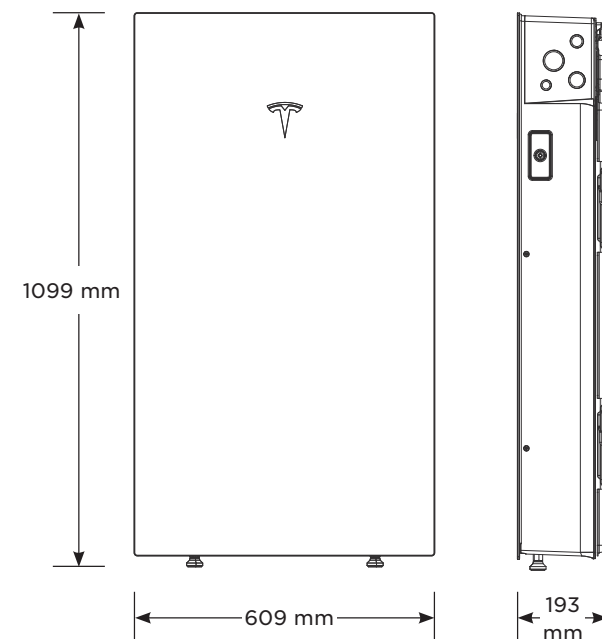

Solar Shutdown Device Technical Specifications

The Solar Shutdown Device is a Mid-Circuit Interrupter (MCI) and is part of the PV system rapid shutdown (RSD) function in accordance with Article 690 of the applicable NEC. When paired with Powerwall 3, solar array shutdown is initiated by any loss of AC power.

Electrical Specifications

Model	MCI-1	MCI-2
Nominal Input DC Current Rating (I_{MP})	13 A	13 A
Maximum Input Short Circuit Current (I_{SC})	19 A	17 A
Maximum System Voltage (PVHCS)	600 V DC	1000 V DC ⁷

⁷ Maximum System Voltage is limited by Powerwall to 600 V DC.

RSD Module Performance

Maximum Number of Devices per String	5	5
Control	Power Line Excitation	Power Line Excitation
Passive State	Normally Open	Normally Open
Maximum Power Consumption	7 W	7 W
Warranty	25 years	25 years

Environmental Specifications

Operating Temperature	-40°C to 50°C (-40°F to 122°F)	-45°C to 70°C (-49°F to 158°F)
Storage Temperature	-30°C to 70°C (-22°F to 158°F)	-30°C to 70°C (-22°F to 158°F)
Enclosure Rating	NEMA 4X / IP65	NEMA 4X / IP65

Mechanical Specifications

Electrical Connections	MC4 Connector	MC4 Connector
Housing	Plastic	Plastic
Dimensions	125 x 150 x 22 mm (5 x 6 x 1 in)	173 x 45 x 22 mm (6.8 x 1.8 x 1 in)
Weight	350 g (0.77 lb)	120 g (0.26 lb)
Mounting Options	ZEP Home Run Clip M4 Screw (#10) M8 Bolt (5/16") Nail / Wood screw	Wire Clip

Compliance Information

Certifications	UL 1741 PVRSE, UL 3741, PVRSA (Photovoltaic Rapid Shutdown Array)
RSD Initiation Method	External System Shutdown Switch or Powerwall 3 Enable Switch

UL 3741 PV Hazard Control (and PVRSA) Compatibility

See Powerwall 3 Installation Manual

Backup Gateway 2

Backup Gateway 2 controls connection to the grid when paired with Powerwall 3, automatically detecting outages and providing seamless transition to backup power. Backup Gateway 2 also provides energy metering for solar self-consumption, time-based control, and backup operation.

In this system configuration, Powerwall 3 acts as the Site Controller, with the Backup Gateway 2 Site Controller disabled.

Performance Specifications	Model Number	1232100-xx-y	User Interface	Tesla App
	AC Voltage (Nominal)	120/240 V	Operating Modes	Support for solar self-consumption, time-based control, and backup
	Feed-in Type	Split phase	Backup Transition	Automatic disconnect for seamless backup
	Grid Frequency	60 Hz	Modularity	Supports up to 10 AC-coupled Powerwalls
	Current Rating	200 A	Optional Internal Panelboard	200 A 6-space / 12 circuit breakers Siemens QP or Square D HOM breakers rated 10 - 80A or Eaton BR breakers rated 10 - 125A
	Maximum Supply Short Circuit Current	10 kA ⁸	Warranty	10 years
	Overcurrent Protection Device	100 - 200 A, Service entrance rated ⁹	¹⁰ When protected by Class J fuses, Backup Gateway 2 is suitable for use in circuits capable of delivering not more than 22kA symmetrical amperes.	
	Overvoltage Category	Category IV	¹¹ The customer is expected to provide internet connectivity for Backup Gateway 2; cellular should not be used as the primary mode of connectivity. Cellular connectivity subject to network operator service coverage and signal strength.	
	Internal Primary AC Meter	Revenue accurate (+/- 0.2%)		
	Internal Auxiliary AC Meter	Revenue accurate (+/- 2%)		
Primary Connectivity	Ethernet, Wi-Fi			
Secondary Connectivity	Cellular (3G, LTE/4G) ¹⁰			

Environmental Specifications	Operating Temperature	-20°C to 50°C (-4°F to 122°F)
	Operating Humidity (RH)	Up to 100%, condensing
	Maximum Elevation	3000 m (9843 ft)
	Environment	Indoor and outdoor rated
	Enclosure Type	NEMA 3R

Compliance Information	Certifications	UL 67, UL 869A, UL 916, UL 1741 PCS, CSA 22.2 0.19, CSA 22.2 205
	Emissions	FCC Part 15, ICES 003

Mechanical Specifications	Dimensions	660 x 411 x 149 mm (26 x 16 x 6 in)
	Weight	20.4 kg (45 lb)
	Mounting options	Wall mount, Semi-flush mount

