Note:
Foundation Location based upon nails set in concrete footing for brick masons on March 11, 2020. As-built dimensions of foundation confirmed on this date.

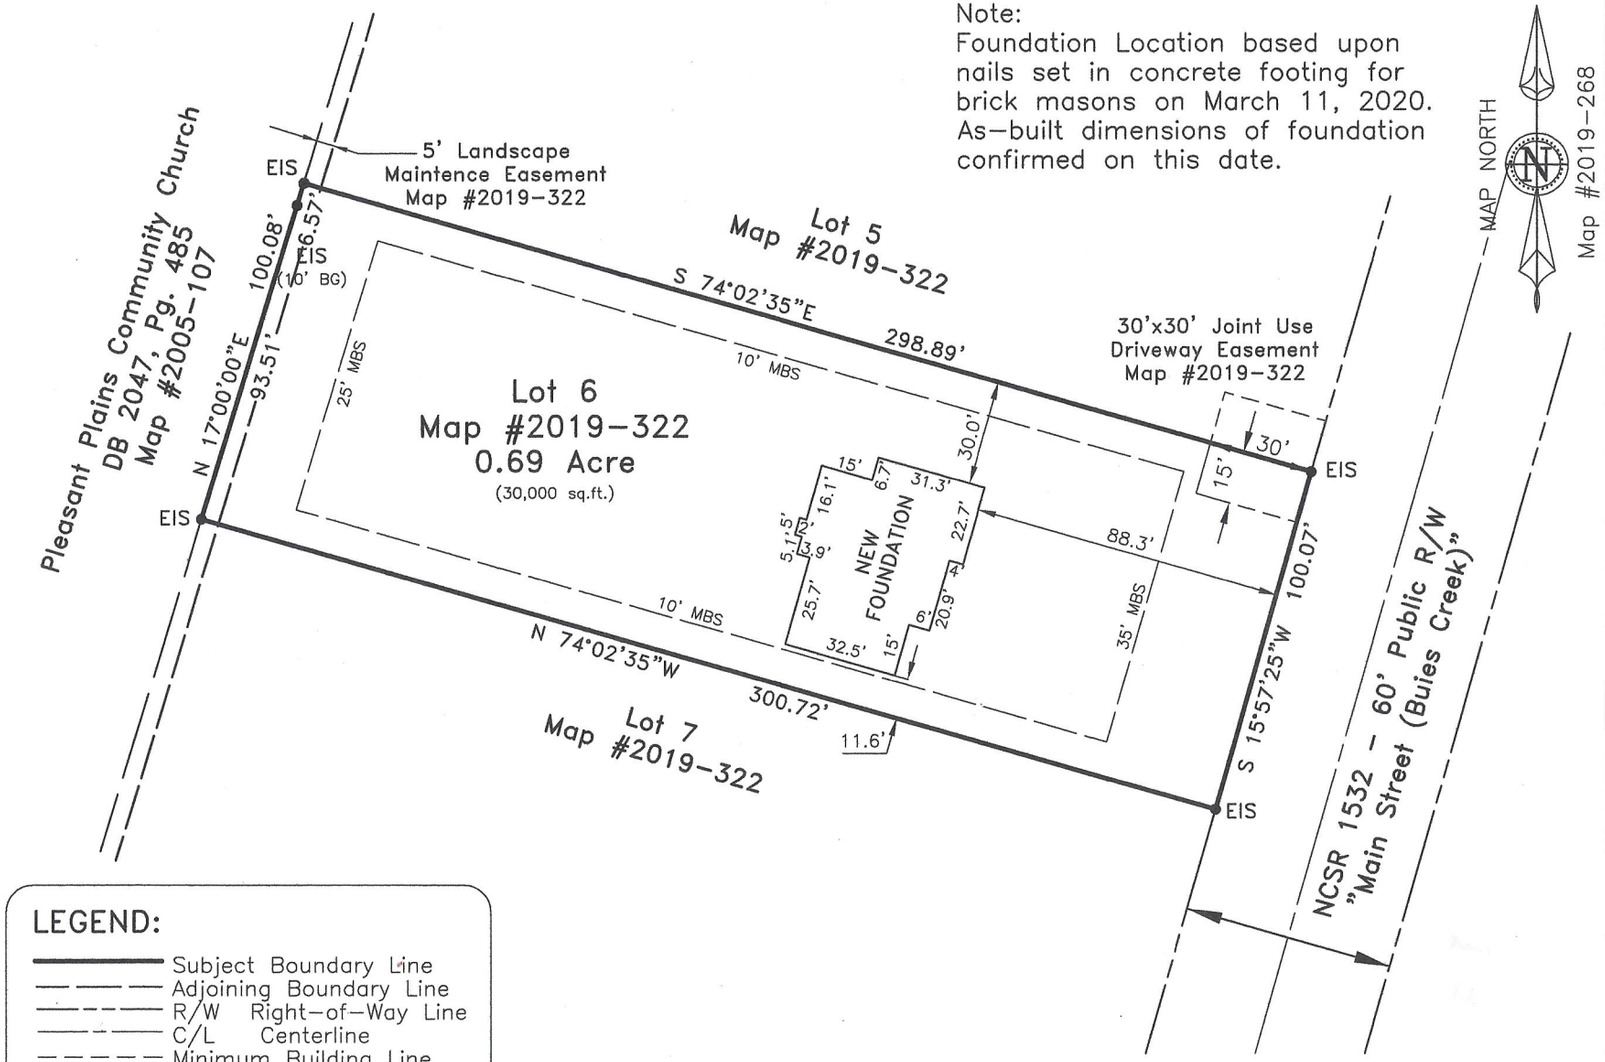

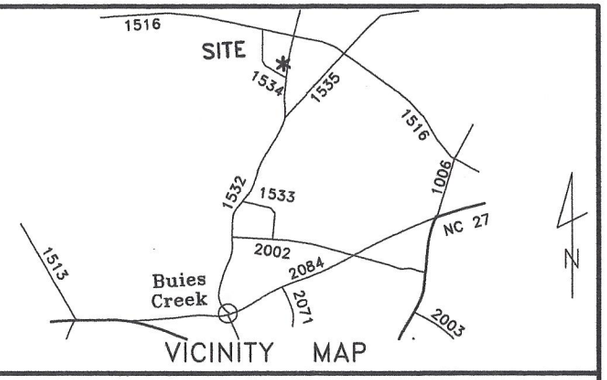

VICINITY MAP

~ 1631 Main Street, Lillington ~
Lot 6, Map #2019-322
NC PIN 0681-01-6007.000

~ Foundation Survey ~

Signature Home Builders, Inc.

Current Owner: Properties of B C LLC

Neill's Creek Twsp.	Harnett County
Scale: 1" = 50'	Date: Mar. 24, 2020

Surveyed & Mapped By

STREAMLINE
LAND SURVEYING, Inc.
NC FIRM C-1898
870 NC 55 W, Coats, N.C. 27521
Phone: 910-897-7715

I hereby certify that the foundation location shown hereon is correct in relation to property lines of record.

NOTE: The purpose of this survey is to locate the newley constructed foundation.
Other features, fixtures, encumberances and indications of use may be revealed by a complete site survey.

NORTH CAROLINA PROFESSIONAL SEAL L-3790 LAND SURVEYOR
Robert E. Godwin, Jr.
3-24-20

NOT FOR RECORDATION

LEGEND:

———	Subject Boundary Line
— — —	Adjoining Boundary Line
———	R/W Right-of-Way Line
—— - ——	C/L Centerline
- - - - -	Minimum Building Line
--------	Survey tie lines
▲ CP	Calculated Point
EIS	Existing Iron Stake
BG/AG	Below/Above Grade
FH	Fire Hydrant
WM	Water Meter
WV	Water Valve
SS	Sanitary Sewer Clean-Out
TP	Telephone Pedestal

FEMA FLOOD HAZARD STATEMENT

The subject property shown on this plat is NOT located within the FEMA 1% Annual Chance Flood Hazard Area "Zone A" or "Zone AE" as shown on FIRM Number: 3720068000J
Effective date: 10/3/2006

0 25' 50' 100'
GRAPHIC SCALE

DATA\0681\200115SI (L6-Foundation)