ABBREVIATIONS	INDEX		
ACC ARCONDITIONING AD. AREADRAN AD. AUSTRANE AD. ALISTANE B. ALISTOM B. B. BASCOOR B. BASCOOR B.	A1.1 1ST FLOOR PLAN A1.1.1 1ST FLOOR PLAN A1.1.2 1ST FLOOR PLAN OPTIONS A1.1.3 FIRST FLOOR PLAN OPTIONS A1.1.4 FIRST FLOOR PLAN OPTIONS A1.1.4 FIRST FLOOR PLAN OPTIONS A1.2 2ND FLOOR PLAN A1.2.1 2ND FLOOR PLAN A1.3 3RD FLOOR PLAN A1.3 3RD FLOOR PLAN A1.3.1 3RD FLOOR PLAN A1.3.1 3RD FLOOR PLAN A1.4.1 BUILDING SECTIONS A1.4.1 BUILDING SECTIONS A1.4.2 BUILDING SECTIONS A1.5.0 COASTAL EXTERIOR ELEVATION OPTIONS A1.5.1 COASTAL EXTERIOR ELEVATION OPTIONS A1.5.2 COASTAL EXTERIOR ELEVATION OPTIONS A1.5.3 COASTAL EXTERIOR ELEVATION OPTIONS A1.5.4 COASTAL EXTERIOR ELEVATION OPTIONS A1.5.5 COASTAL EXTERIOR ELEVATION OPTIONS A1.6.1 CRAFTSMAN EXTERIOR ELEVATION OPTIONS A1.6.2 CRAFTSMAN EXTERIOR ELEVATION OPTIONS A1.6.3 CRAFTSMAN EXTERIOR ELEVATION OPTIONS A1.6.4 CRAFTSMAN EXTERIOR ELEVATION OPTIONS A1.6.5 CRAFTSMAN EXTERIOR ELEVATION OPTIONS A1.6.6 CRAFTSMAN EXTERIOR ELEVATION OPTIONS A1.6.7 CRAFTSMAN EXTERIOR ELEVATION OPTIONS A1.6.9 CRAFTSMAN EXTERIOR ELEVATION OPTIONS A1.6.1 CRAFTSMAN EXTERIOR ELEVATION OPTIONS A1.6.2 CRAFTSMAN EXTERIOR ELEVATION OPTIONS A1.6.3 CRAFTSMAN EXTERIOR ELEVATION OPTIONS A1.6.4 CRAFTSMAN EXTERIOR ELEVATION OPTIONS A1.6.5 CRAFTSMAN EXTERIOR ELEVATION OPTIONS A1.6.6 CRAFTSMAN EXTERIOR ELEVATION OPTIONS A1.7.1 TRADITIONAL EXTERIOR ELEVATION OPTIONS A1.7.2 TRADITIONAL EXTERIOR ELEVATION OPTIONS A1.7.3 TRADITIONAL EXTERIOR ELEVATION OPTIONS A1.7.4 TRADITIONAL EXTERIOR ELEVATION OPTIONS A1.8.1 EURO EXTERIOR ELEVATION OPTIONS A1.8.2 EURO EXTERIOR ELEVATION OPTIONS A1.8.3 EURO EXTERIOR ELEVATION OPTIONS A1.8.4 EURO EXTERIOR ELEVATION OPTIONS A1.8.5 EURO EXTERIOR ELEVATION OPTIONS A1.8.6 EURO EXTERIOR ELEVATION OPTIONS A1.8.7 EURO EXTERIOR ELEVATION OPTIONS A1.8.9 EURO EXTERIOR ELEVATION OPTIONS A1.9.1 CLASSIC EXTERIOR ELEVATION OPTIONS A1.9.2 CLASSIC EXTERIOR ELEVATION OPTIONS A1.9.3 CLASSIC EXTERIOR ELEVATION OPTIONS A1.9.4 CLASSIC EXTERIOR ELEVATION OPTIONS A1.9.5 CLASSIC EXTERIOR ELEVATION OPTIONS A1.9.6 CLASSIC EXTERIOR ELEVATION OPTIONS A1.9.7 CLASSIC EXTERIOR ELEVATION OPTIONS A1.9.8 CLASSIC EXTE	E3.0 E3.1	3RD FLOOR UTILITY PLAN 3RD FLOOR UTILITY PLAN OPTIONS
CONSTRUCTION TYPE: TYPE VB (2HOUR DMELLING SEPARATION BETWEEN UNITS.)	ALL CONSULTANT DRAWINGS ACCOMPANYING THESE GIND DESIGN GROUP DRAWINGS HAVE NOT BEEN PREPARED BY OR UNDER THE DIRECTION OF GIND DESIGN GROUP, INC. GIND DESIGN GROUP INC. THEREFORE ASSUMES NO LIABILITY FOR THE COMPLETENESS OR CORRECTNESS OF THESE DRAWINGS.		

# THE FINLEY REVERSE

FINIL EVA	CE IELIDOI
FINLEY	SF - 'EURO'
Name	Area
1ST FLOOR	1034 SF
2ND FLOOR	1276 SF
Heated	2309 SF
GARAGE	414 SF
OPT. 3RD CAR	247 SF
GARAGE	
OPT. FLUSH	43 SF
PORCH	
PATIO	157 SF
PORCH	78 SF
Unheated	939 SF

NORTH CAROLINA OFFICE 108 B NORTH SALEM STREET

SUITE 203 APEX, NC 27502

PHONE: (919) 320-3022

THESE PLANS AND SPECIFICATIONS ARE PROTECTED UNDER FEDERAL COPYRIGHT UNDER FEDERAL COPYRIGHT LAWS, GMD DESIGN GROUP, INC. MAINTAINS OWNERSHIP OF SUCH AND ALL RIGHTS AND PRIVILEGES.

NO:	DATE:	REVISION:

PROFESSIONAL SEAL:

LOT 1129 -ANDERSON CREEK **ACADEMY** 01.22.2021

PROJECTITI F

THE FINLEY

CONSTRUCTION SET



PROJECTNO: GMD14038RAL

SHEETTITLE:

TITLE

SHEET

PRINT DATE: 01.22.2021

SHEET NO

T-1

## GENERAL NOTES:

THESE DOCUMENTS ARE THE PROPERTY OF THE DESIGNER AND SHALL NOT BE COPIED, DUPLICATED, ALTERED, MODIFIED OR REVISED IN ANY WAY WITHOUT THE EXPRESSED WRITTEN APPROVAL OF THE DESIGNER. CONTRACTOR SHALL VERIFY ALL CONDITIONS AND DIMENSIONS AT THE SITE AND ALL INCONSISTENCES SHALL BE BROUGHT TO THE ATTENTION OF THE DEVELOPER AND THE DESIGNER BEFORE PROCEEDING WITH WORK.

ANY ERRORS OR OMISSIONS FOUND IN THESE DRAWINGS SHALL BE BROUGHT TO DEVELOPERS AND DESIGNERS ATTENTION IMMEDIATELY.

DO NOT SCALE DRAWINGS. WRITTEN DIMENSIONS TAKE PRECEDENCE OVER SCALED

ALL DIMENSIONS ARE TO FACE OF STUD OR TO FACE OF FRAMING UNLESS OTHERWISE NOTED. ALL TRUSS DRAWINGS TO BE REVIEWED AND APPROVED BY THE STRUCTURAL

ENGINEER PRIOR TO ISSUANCE OF BUILDING PERMIT ALL OR FOLIAL SUBSTITUTIONS MUST BE SUBMITTED TO AND APPROVED BY CITY BUILDING OFFICIAL PRIOR TO INSTALLATION.

ALL ANGLED PARTITIONS ARE 45 DEGREES UNLESS OTHERWISE NOTED

PROVIDE FIREBLOCKING. (PER LOCAL CODES.) ALL ELECTRICAL AND MECHANICAL EQUIPMENT AND METERS ARE SUBJECT TO RELOCATION DUE TO FIELD CONDITIONS, CONTRACTOR TO VERIES

PROVIDE BLOCKING AND/OR BACKING AT ALL TOWEL BAR, TOWEL RING AND/OR TOILET PAPER HOLDER LOCATIONS, AS SHOWN PER PLAN, TYPICAL AT ALL BATHROOMS AND POWDER ROOMS, VERIFY LOCATIONS AT FRAMING WALK.

ELASTOMERIC SHEET WATERPROOFING; FURNISH AND INSTALL ALL WATERPROOFING EUSTIONED STEEL INTERPROTORING TOWARTHAN INSTALL INVITATION OF THE COMPLETE AND MESTADLERNS MEMBRANE OF RUBBERZED ASPHALT INTEGRALLY SOLDED TO POLYETHICADE STEETING, OR ROUAL INSTALL PER INAUPACTURES AND TRADE ASSOCIATIONS PRIVILED INSTALLATION INSTRUCTIONS, 6" MINIMUM LAP AT ALL ADJACENT WALL SURFACES.

TO THE BEST OF THE DESIGNERS KNOWLEDGE THESE DOCUMENTS ARE IN CONFORMANCE WITH THE REQUIREMENTS OF THE BUILDING AUTHORITIES HAVING JURISDICTION OVER THIS TYPE OF CONSTRUCTION AND OCCUPANCY.

SHOP DRAWING REVIEW AND DISTRIBUSTION, ALONG WITH PRODUCT SUBMITTALS, REQUESTED IN THE CONSTRUCTION DOCUMENTS SHALL BE THE SOLE. RESPONSIBILITY OF THE GENERAL CONTRACTOR UNLESS DIRECTED OTHERWISE UNDER A SEPARATE AGREEMENT.

DEVATIONS FROM THESE DOCUMENTS IN THE CONSTRUCTION PHASE SHALL BE REVENUED BY THE DESIGNER AND THE CONNEX PRIOR TO THE START OF WORK IN QUESTION, ANY EVALUATIONS FROM THESE DOCUMENTS WITHOUT PROOR REVIEW, SHALL BE THE SOLE RESPONSIBILITY OF THE GENERAL CONTRACTOR.

THE GENERAL CONTRACTOR SHALL BE RESPONSIBLE FOR ALL WORK AND MATERIALS REPRESENTED ON THESE DOCUMENTS NOLUDING THE WORK AND MATERIALS FURNISHED BY SUBCONTRACTORS AND VENDORS.

GEOTECHNICAL ENGINEER (SOILS REPORT), ON THE STUDY OF THE PROPOSED SITE TO THE DESIGNER STRUCTURAL ENGINEER AND GENERAL CONTRACTOR IN THE EVENT THE GEOTECHNICAL REPORTS DO NOT EXIST. THE SOILS CONDITION SHALL EVENT IN THE CEDITION THAT REPORTS DATE OF THE SOLES CONTINUES HER SEASUMED TO BE AMMINUMDESCONSOL PRESSURE STATED BY THE STRUCTURAL ENGINEER OF RECORD FOR THE PURPOSE OF STRUCTURAL DESIGN. GENERAL CONTRACTOR SHALL ASSURE THE SOLL CONDITIONS MEET OR EXCEED THE CONTRACT. THE CRITERIA

ALL WORK PERFORMED BY THE GENERAL CONTRACTOR SHALL COMPLY AND CONFORM WITH LOCAL AND STATE BUILDING CODES, ORDINANCES AND REGULATIONS, A CONSWITH ALL OTHER AUTHORITIES HAVING, JURISDICTION THE GENERAL CONTRACTOR SEES FOR AND GOVERNING REGULATIONS.

PROVIDE AN APPROVED WASHER DRAIN PAN AT SECOND FLOOR ONLY THAT DRAINS TO EXTERIOR.

WINDOW SUPPLIER TO VERIFY AT LEAST ONE WINDOW IN ALL BEDROOMS TO HAVE A CLEAR OPENABLE AREA OF 4 (SQPT, THE MINIMUM IN ET CLEAR OPENING HEIGHT SHALL BE 22" AND THE MINIMUM NET CLEAR OPENING WIDTH SHALL BE 20". GLAZING TOTAL AREA OF NOT LESS THAN 5.0 SQ FT IN THE CASE OF A GROUND WINDOW AND NOT LESS THAN 5.7 SQ FT IN THE CASE OF AN UPPER STORY WINDOW. (PER NCRC SECTION R310.1.1) ALL HANDRAIL BALLUSTERS TO BE SPACED SUCH THAT A 4" SPHERE CANNOT PASS BETWEENBALLUSTERS. (PERLOCAL CODES.)

PROVIDE STAIR HANDRAILS AND GUARDRAILS PER LOCAL CODES.

## BUILDER SET:

THE SCOPE OF THIS SET OF PLANS IS TO PROVIDE A 'BUILDERS SET'
OF CONSTRUCTION DOCUMENTS AND GENERAL NOTES HERBURAFTER REFERRED TO AS 'PLANS'.
THIS SET OF PLANS'S SLFFICIENT TO OBTIAN A BUILDING PERMIT, HOMEVER, ALL MATERIALS
AND METHODS OF CONSTRUCTION NECESSARY TO COMPLETE THE PROJECT ARE NOT ANDMETHOUS OF CONSTRUCTION NECESSARY TO COMPILE THE PROJECT ARE NOT NECESSARY USES OF BEEN THE PLANS CELLIFICATION DESCRIBE ONLY LOCATIONS, DIMENSIONS, TYPES OF MATERIALS, AND GENERAL METHOUS OF ASSEMBLING OR FRASTENING, THEY ARE NOT INTENDED TO SPECIFY PARTICLAR PRODUCTS OR OTHER METHODOS OF ANY SPECIFIC MATERIALS, PRODUCT OR METHOD. THE METERORITATION OF THE FLANS REQUIRES A LIENT (CONTRACTOR THO FLOOL ANY WOMEN DESCRIBE WITH THE APPLICABLE BUILDING CODES AND METHODS OF CONSTRUCTION SPECIFIC TO THIS PRODUCT TYPE AND TYPE OF CONSTRUCTION.

CONSTRUCTION REQUIREMENTS AND QUALITY. PROVIDE WORK OF THE SPECIFIC QUALITY. WHERE QUALITY LEVEL IS NOT INDICATED PROVIDE WORK OF QUALITY CUSTOMARY IN SIMILAR TYPES OF WORK WHERE THE PLANS AND SPECIFICATIONS, COOSES LAWS, REQUIRE WORK OF HIGHER QUALITY OR PERFORMANCE PROVIDE WORK COMPLYING WITH THOSE REQUIREMENTS AND QUALITY. WHERE TWO KINNOW CENTROL WORK COMPLYING WITH THOSE REQUIREMENTS AND QUALITY. WHERE TWO KINNOW COUNTY WHERE TWO KINNOW COUNTY WHERE TWO KINNE COUNTY WHERE THE WORK TRANSCRIPT TREQUIREMENTS WHERE THE MOST STRINGENT REQUIREMENTS WHERE THE MOST STRINGENT REQUIREMENT WHERE THE COUNTY THE THE THIN THE THIN THE PROVIDE WORK OF THE WORK OF THE


	FLOOR PLAN KEYNOTE LEGEND
KEY VALUE	KEYNOTE TEXT
1	HOUSE TO GARAGE FIRE SEPARATION, GARAGE/HOUSE SEPARATION AT VERTICAL SURFACES SHALL BE PROTECTED WITH ONE (1) LAYER 1/2" GYPSUM BOARD, GARAGE/HOUSE SEPARATION AT HORIZONTAL SURFACES SHALL BE PROTECTED WITH ONE (1) LAYER 5/8" TYPE "X" GYPSUM BOARD
2	HOUSE TO GARAGE DOOR SEPARATION. PROVIDE 1 3/8" SOLID CORE DOOR OR APPROVED 20 MINUTE RATED DOOR
3	BENEATH STAIRS AND LANDINGS. 1/2" GYPSUM BOARD ON WALLS AND CEILING OF ENCLOSED ACCESSIBLE AREAS
7	PRE-FABRICATED METAL FIREPLACE, INSTALL PER MANUFACTURER WRITTEN INSTRUCTIONS
8	ATTIC ACCESS LARGE ENOUGH TO REMOVE LARGEST PIECE OF EQUIPMENT BUT NOT LESS THAN 30"X22". FIRE RATED ACCESS AS NOTED. ATTIC ACCESS LADDER, VERIEY LOCATION AND SIZE WITH TRUSSES (25 1/2"X54" SIZE)
9	TEMPERED SAFETY GLASS
11	HALF WALL, HEIGHT AS NOTED
12	INTERIOR SOFFITS: FFL = 8'-1" U.N.O. SFL = 7'-6" U.N.O.
14	TUB-SHOWER COMBO
16	SLIDE-IN ELECTRICAL RANGE W/ HOOD AND MICRO ABV. VENT PER

FULL HEIGHT
2X4 WOOD STUD PARTITION 2X6 WOOD STUD PARTITION


DRYWALL OPENING HEIGHT AS NOTED ON PLAN

BRICK VENEER

STUD WALL BELOW HEIGHT AND STUD SIZE AS NOTED

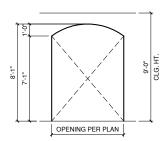

TYP. ARCHED OPENING DETAIL

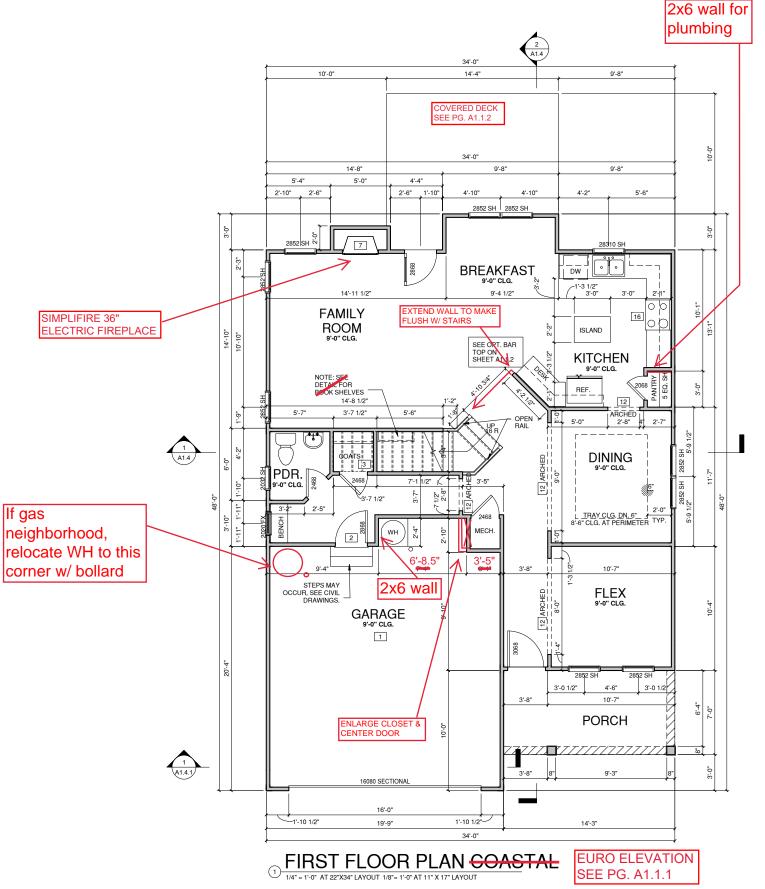



NORTH CAROLINA OFFICE 108 B NORTH SALEM STREET

SUITE 203 APEX, NC 27502 PHONE: (919) 320-3022

THESE PLANS AND SPECIFICATIONS ARE PROTECTED UNDER FEDERAL COPYRIGHT LAWS. GMD DESIGN GROUP CAROLINAS MAINTAINS OWNERSHIP OF SUCH AND ALL RIGHTS AND PRIVILEGES.

0:	DATE:	REVISION:	

PROFESSIONAL SEAL:



PROJECT TITLE:

THE FINLEY

CONSTRUCTION SET

CLIENTS NAME: MCKEE HOMES



PROJECT NO:

GMD14038RAL SHEET TITLE:

**1ST FLOOR PLAN** 

PRINT DATE: 01.22.2021

SHEET NO:

A1.1

VALUE KEYNOTE TEXT  1 HOUSE TO GARAGE FIRE SEPARATION, GARAGE-HOUSE SEPARATION AT VERTICAL SURFACES SHALL BE PROTECTED WITH ONE (1) LAYER 1/2" GYPSUM BOARD, GARAGE-HOUSE SEPARATION AT HORIZONTAL SURFACES SHALL BE PROTECTED WITH ONE (1) LAYER 1/2" GYPSUM BOARD TO GARAGE DOOR SEPARATION, PROVIDE 1 3/8" SOLID CORE DOOR OR APPROVED 20 MINUTE RATED DOOR  3 BENEATH STAIRS AND LANDINGS, 1/2" GYPSUM BOARD ON WALLS AND CEILING OF ENCLOSED ACCESSIBLE AREAS  7 PRE-FABRICATED METAL FIREPLACE, INSTALL PER MANUFACTURER WRITTEN INSTRUCTIONS  8 ATTIC ACCESS LARGE ENOUGH TO REMOVE LARGEST PIECE OF EQUIPMENT BU'NOT LESS THAN 30"X22". FIRE RATED ACCESS AS NOTED, ATTIC ACCESS LADDER VERIFY LOCATION AND SIZE WITH TRUSSES (25 1/2"X54" SIZE)  9 TEMPERED SAFETY GLASS  11 HALF WALL, HEIGHT AS NOTED  12 INTERIOR SOFFITS: FFL = 8"-1" U.N.O. SFL = 7"-6" U.N.O.  14 TUB-SHOWER COMBO  16 SLIDE-IN ELECTRICAL RANGE W/HOOD AND MICRO ABV. VENT PER		FLOOR PLAN KEYNOTE LEGEND	
VERTICAL SURFACES SHALL BE PROTECTED WITH ONE (1) LAYER 1/2" GYPSUM BOARD. GARAGE/HOUSE SEPARATION AT HORIZONTAL SURFACES SHALL BE PROTECTED WITH ONE (1) LAYER 5/8" TYPE "X" GYPSUM BOARD  1 HOUSE TO GARAGE DOOR SEPARATION. PROVIDE 1 3/8" SOLID CORE DOOR OR APPROVED 20 MINUTE RATED DOOR  3 BENEATH STAIRS AND LANDINGS. 1/2" GYPSUM BOARD ON WALLS AND CEILING OF ENCLOSED ACCESSIBLE AREAS  7 PRE-FABRICATED METAL FIREPLACE, INSTALL PER MANUFACTURER WRITTEN INSTRUCTIONS  8 ATTIC ACCESS LARGE ENOUGH TO REMOVE LARGEST PIECE OF EQUIPMENT BU'NOT LESS THAN 30"X22". FIRE RATED ACCESS AS NOTED. ATTIC ACCESS LADDER VERIFY LOCATION AND SIZE WITH TRUSSES (25 1/2"X54" SIZE)  9 TEMPERED SAFETY GLASS  11 HALF WALL, HEIGHT AS NOTED  12 INTERIOR SOFFITS: FFL = 8"-1" U.N.O. SFL = 7"-6" U.N.O.  14 TUB-SINDER COMBO  16 SLIDE-IN ELECTRICAL RANGE W/HOOD AND MICRO ABV. VENT PER		KEYNOTE TEXT	
APPROVED 20 MINUTE RATED DOOR  BENEATH STAIRS AND LANDINGS. 1/2" GYPSUM BOARD ON WALLS AND CEILING OF ENCLOSED ACCESSIBLE AREAS  PRE-FABRICATED METAL FIREPLACE, INSTALL PER MANUFACTURER WRITTEN INSTRUCTIONS  ATTIC ACCESS LARGE ENOUGH TO REMOVE LARGEST PIECE OF EQUIPMENT BU'NOT LESS THAN 30" X22". FIRE RATED ACCESS AS NOTED. ATTIC ACCESS LADDER VERIFY LOCATION AND SIZE WITH TRUSSES (25 1/2" X54" SIZE)  TEMPERED SAFETY GLASS  HALF WALL, HEIGHT AS NOTED  INTERIOR SOFFITS: FFL = 8"-1" U.N.O. SFL = 7"-6" U.N.O.  TUB-SHOWER COMBO  SLIDE-IN ELECTRICAL RANGE W/ HOOD AND MICRO ABV. VENT PER	1	VERTICAL SURFACES SHALL BE PROTECTED WITH ONE (1) LAYER 1/2" GYPSUM BOARD. GARAGE/HOUSE SEPARATION AT HORIZONTAL SURFACES SHALL BE	
OF ENCLOSED ACCESSIBLE AREAS  PRE-FABRICATED METAL FIREPLACE, INSTALL PER MANUFACTURER WRITTEN INSTRUCTIONS  ATTIC ACCESS LARGE ENOUGH TO REMOVE LARGEST PIECE OF EQUIPMENT BU'NOT LESS THAN 30°X22". FIRE RATED ACCESS AS NOTED. ATTIC ACCESS LADDER VERIEY LOCATION AND SIZE WITH TRUSSES (25 1/2"X54" SIZE)  TEMPERED SAFETY GLASS  HALF WALL, HEIGHT AS NOTED  INTERIOR SOFFITS: FFL = 8"-1" U.N.O. SFL = 7"-6" U.N.O.  TUB-SHOWER COMBO  SLIDE-IN ELECTRICAL RANGE W/ HOOD AND MICRO ABV. VENT PER	2		
INSTRUCTIONS  8 ATTIC ACCESS LARGE ENOUGH TO REMOVE LARGEST PIECE OF EQUIPMENT BU'NOT LESS THAN 30"X22". FIRE RATED ACCESS AS NOTED. ATTIC ACCESS LADDER VERIFY LOCATION AND SIZE WITH TRUSSES (25 1/2"X54" SIZE)  9 TEMPERED SAFETY GLASS  11 HALF WALL, HEIGHT AS NOTED  12 INTERIOR SOFFITS: FFL = 8"-1" U.N.O. SFL = 7"-6" U.N.O.  14 TUB-SHOWER COMBO  16 SLIDE-IN ELECTRICAL RANGE W/ HOOD AND MICRO ABV. VENT PER	3		
NOT LESS THAN 30"X22". FIRE RATED ACCESS AS NOTEO. ATTIC ACCESS LADDER VERIFY LOCATION AND SIZE WITH TRUSSES (25 1/2"X54" SIZE)  TEMPERED SAFETY GLASS  HALF WALL, HEIGHT AS NOTED  INTERIOR SOFFITS: FFL = 8"-1" U.N.O. SFL = 7"-6" U.N.O.  TUB-SHOWER COMBO  SLIDE-IN ELECTRICAL RANGE W/ HOOD AND MICRO ABV. VENT PER	7		
11	8	ATTIC ACCESS LARGE ENOUGH TO REMOVE LARGEST PIECE OF EQUIPMENT BUT NOT LESS THAN 30"X22". FIRE RATED ACCESS AS NOTED. ATTIC ACCESS LADDER VERIFY LOCATION AND SIZE WITH TRUSSES (25 1/2"X54" SIZE)	
12 INTERIOR SOFFITS: FFL = 8'-1" U.N.O. SFL = 7'-6" U.N.O. 14 TUB-SHOWER COMBO 16 SLIDE-IN ELECTRICAL RANGE W/ HOOD AND MICRO ABV. VENT PER	9	TEMPERED SAFETY GLASS	
14 TUB-SHOWER COMBO 16 SLIDE-IN ELECTRICAL RANGE W/ HOOD AND MICRO ABV. VENT PER	11	HALF WALL, HEIGHT AS NOTED	
16 SLIDE-IN ELECTRICAL RANGE W/ HOOD AND MICRO ABV. VENT PER	12	INTERIOR SOFFITS: FFL = 8'-1" U.N.O. SFL = 7'-6" U.N.O.	
	14	TUB-SHOWER COMBO	
	16		


FULL HEIGHT 2X4 WOOD STUD PART

FULL HEIGHT DN 2X6 WOOD STUD PARTITION DRYWALL OPENING HEIGHT AS NOTED ON PLAN

STONE VENEER

BRICK VENEER

STUD WALL BELOW
HEIGHT AND STUD SIZE AS NOTED

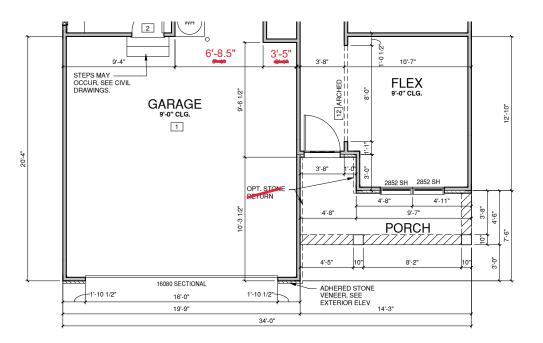





NORTH CAROLINA OFFICE 108 B NORTH SALEM STREET

SUITE 203 APEX, NC 27502 PHONE: (919) 320-3022

THESE PLANS AND SPECIFICATIONS ARE PROTECTED UNDER FEDERAL COPYRIGHT LAWS. GMD DESIGN GROUP CAROLINAS MAINTAINS OWNERSHIP OF SUCH AND ALL RIGHTS AND PRIVILEGES.

NO:	DATE:	REVISION:

PROFESSIONAL SEAL:

LOT 1129 -ANDERSON CREEK ACADEMY 01.22.2021

PROJECT TITLE:

THE FINLEY

CONSTRUCTION SET

CLIENTS NAME: MCKEE HOMES



PROJECT NO:

GMD14038RAL SHEET TITLE:

1ST FLOOR PLAN

PRINT DATE: 01.22.2021

SHEET NO: A1.1.1

	FLOOR PLAN KEYNOTE LEGEND		
KEY VALUE	KEYNOTE TEXT		
1	HOUSE TO GARAGE FIRE SEPARATION, GARAGE/HOUSE SEPARATION AT VERTICAL SURFACES SHALL BE PROTECTED WITH ONE (1) LAYER 1/2" GYPSUM BOARD, GARAGE/HOUSE SEPARATION AT HORIZONTAL SURFACES SHALL BE PROTECTED WITH ONE (1) LAYER 5/8" TYPE "X" GYPSUM BOARD		
2	HOUSE TO GARAGE DOOR SEPARATION. PROVIDE 1 3/8" SOLID CORE DOOR OR APPROVED 20 MINUTE RATED DOOR		
3	BENEATH STAIRS AND LANDINGS. 1/2" GYPSUM BOARD ON WALLS AND CEILING OF ENCLOSED ACCESSIBLE AREAS		
7	PRE-FABRICATED METAL FIREPLACE, INSTALL PER MANUFACTURER WRITTEN INSTRUCTIONS		
8	ATTIC ACCESS LARGE ENOUGH TO REMOVE LARGEST PIECE OF EQUIPMENT BUT NOT LESS THAN 30"X22". FIRE RATED ACCESS AS NOTED. ATTIC ACCESS LADDER, VERIFY LOCATION AND SIZE WITH TRUSSES (25 1/2"X54" SIZE)		
9	TEMPERED SAFETY GLASS		
11	HALF WALL, HEIGHT AS NOTED		
12	INTERIOR SOFFITS: FFL = 8'-1" U.N.O. SFL = 7'-6" U.N.O.		
14	TUB-SHOWER COMBO		
16	SLIDE-IN ELECTRICAL RANGE W/ HOOD AND MICRO ABV. VENT PER MANUFACTURER'S WRITTEN INSTRUCTIONS		


FULL HEIGHT
2X4 WOOD STUD PARTITION 2X6 WOOD STUD PARTITION

STONE VENEER

AS NOTED ON PLAN

BRICK VENEER

STUD WALL BELOW HEIGHT AND STUD SIZE AS NOTED

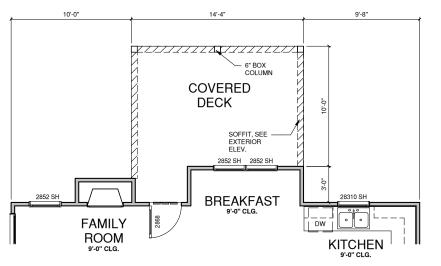

# $\bigcirc \underbrace{\mathsf{OPT.}\,\, \mathsf{COVERED}\,\, \mathsf{PORCH}}_{\mathsf{1/4"}\,\,\mathsf{1'-0"}\,\,\mathsf{AT}\,\,\mathsf{22"X34"}\,\mathsf{LAYOUT}\,\,\mathsf{1/8"}\,\mathsf{1'-0"}\,\mathsf{AT}\,\mathsf{11"}\,\mathsf{X}\,\mathsf{17"}\,\mathsf{LAYOUT}}$



NORTH CAROLINA OFFICE 108 B NORTH SALEM STREET SUITE 203 APEX, NC 27502 PHONE: (919) 320-3022

THESE PLANS AND SPECIFICATIONS ARE PROTECTED UNDER FEDERAL COPYRIGHT LAWS. GMD DESIGN GROUP CAROLINAS MAINTAINS OWNERSHIP OF SUCH AND ALL RIGHTS AND PRIVILEGES.

NO: DATE: REVISION:			
	NO:	DATE:	REVISION:

PROFESSIONAL SEAL:

LOT 1129 -ANDERSON CREEK ACADEMY 01.22.2021

PROJECT TITLE:

THE FINLEY

CONSTRUCTION SET

CLIENTS NAME: MCKEE HOMES



PROJECT NO:

GMD14038RAL SHEET TITLE:

**1ST FLOOR** PLAN OPTIONS

PRINT DATE: 01.22.2021

SHEET NO:

A1.1.2

FLOOR PLAN KEYNOTE LEGEND		
KEY VALUE	KEYNOTE TEXT	
1	HOUSE TO GARAGE FIRE SEPARATION, GARAGE/HOUSE SEPARATION AT VERTICAL SURFACES SHALL BE PROTECTED WITH ONE (1) LAYER 1/2" GYPSUM BOARD. GARAGE/HOUSE SEPARATION AT HORIZONTAL SURFACES SHALL BE PROTECTED WITH ONE (1) LAYER 5/8" TYPE "X" GYPSUM BOARD	
2	HOUSE TO GARAGE DOOR SEPARATION. PROVIDE 1 3/8" SOLID CORE DOOR OR APPROVED 20 MINUTE RATED DOOR	
3	BENEATH STAIRS AND LANDINGS. 1/2" GYPSUM BOARD ON WALLS AND CEILING OF ENCLOSED ACCESSIBLE AREAS	
7	PRE-FABRICATED METAL FIREPLACE, INSTALL PER MANUFACTURER WRITTEN INSTRUCTIONS	
8	ATTIC ACCESS LARGE ENOUGH TO REMOVE LARGEST PIECE OF EQUIPMENT BUT NOT LESS THAN 30°X22°. FIRE RATED ACCESS AS NOTED. ATTIC ACCESS LADDER, VERIFY LOCATION AND SIZE WITH TRUSSES (25 1/2°X54" SIZE)	
9	TEMPERED SAFETY GLASS	
11	HALF WALL, HEIGHT AS NOTED	
12	INTERIOR SOFFITS: FFL = 8'-1" U.N.O. SFL = 7'-6" U.N.O.	
14	TUB-SHOWER COMBO	
16	SLIDE-IN ELECTRICAL RANGE W/ HOOD AND MICRO ABV. VENT PER MANUFACTURER'S WRITTEN INSTRUCTIONS	


FULL HEIGHT 2X4 WOOD STUD PART FULL HEIGHT ON 2X6 WOOD STUD PARTITION

DRYWALL OPENING HEIGHT AS NOTED ON PLAN

STONE VENEER

BRICK VENEER

STUD WALL BELOW HEIGHT AND STUD SIZE AS NOTED

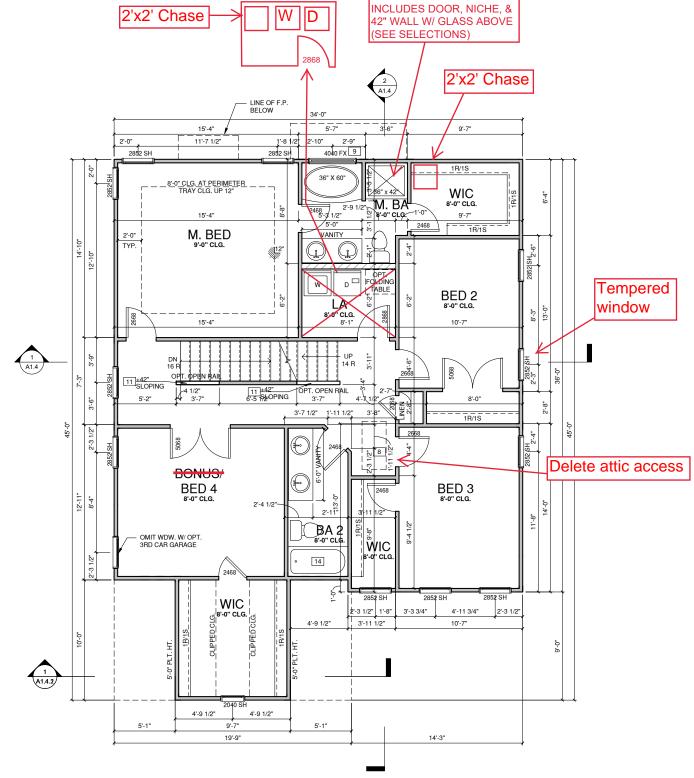

OPT. TILE SHOWER:

SECOND FLOOR PLAN COASTAL

**EURO ELEVATION** SEE PG. A1.2.1



NORTH CAROLINA OFFICE 108 B NORTH SALEM STREET

SUITE 203 APEX, NC 27502 PHONE: (919) 320-3022

THESE PLANS AND SPECIFICATIONS ARE PROTECTED UNDER FEDERAL COPYRIGHT LAWS. GMD DESIGN GROUP CAROLINAS MAINTAINS OWNERSHIP OF SUCH AND ALL RIGHTS AND PRIVILEGES.

NO:	DATE:	REVISION:

PROFESSIONAL SEAL:

LOT 1129 -ANDERSON CREEK ACADEMY 01.22.2021

PROJECT TITLE:

THE FINLEY

CONSTRUCTION SET

CLIENTS NAME: MCKEE HOMES



PROJECT NO: GMD14038RAL

SHEET TITLE:

2ND FLOOR **PLAN** 

PRINT DATE: 01.22.2021

SHEET NO:


A1.2

	FLOOR PLAN KEYNOTE LEGEND		
KEY VALUE	KEYNOTE TEXT		
1	HOUSE TO GARAGE FIRE SEPARATION, GARAGE/HOUSE SEPARATION AT VERTICAL SURFACES SHALL BE PROTECTED WITH ONE (1) LAYER 1/2" GYPSUM BOARD, GAAGE/HOUSE SEPARATION AT HORIZONTAL SURFACES SHALL BE PROTECTED WITH ONE (1) LAYER 5/8" TYPE "X" GYPSUM BOARD		
2	HOUSE TO GARAGE DOOR SEPARATION. PROVIDE 1 3/8" SOLID CORE DOOR OR APPROVED 20 MINUTE RATED DOOR		
3	BENEATH STAIRS AND LANDINGS. 1/2" GYPSUM BOARD ON WALLS AND CEILING OF ENCLOSED ACCESSIBLE AREAS		
7	PRE-FABRICATED METAL FIREPLACE, INSTALL PER MANUFACTURER WRITTEN INSTRUCTIONS		
8	ATTIC ACCESS LARGE ENOUGH TO REMOVE LARGEST PIECE OF EQUIPMENT BUT NOT LESS THAN 30°X22°. FIRE RATED ACCESS AS NOTED. ATTIC ACCESS LADDER, VERIFY LOCATION AND SIZE WITH TRUSSES (25 1/2°X54° SIZE)		
9	TEMPERED SAFETY GLASS		
11	HALF WALL, HEIGHT AS NOTED		
12	INTERIOR SOFFITS: FFL = 8'-1" U.N.O. SFL = 7'-6" U.N.O.		
14	TUB-SHOWER COMBO		
16	SLIDE-IN ELECTRICAL RANGE W/ HOOD AND MICRO ABV. VENT PER		

FULL HEIGHT
2X4 WOOD STUD PARTITION 2X6 WOOD STUD PARTITION
2X5 WOOD STUD PARTITION
2X6 WOOD STUD PARTITION
2X7 WOOD STUD PARTITION
2X8 WOOD STUD PARTITION
2X8 WOOD STUD PARTITION
2X9 WOOD STUD PART

BRICK VENEER

STUD WALL BELOW HEIGHT AND STUD SIZE AS NOTED

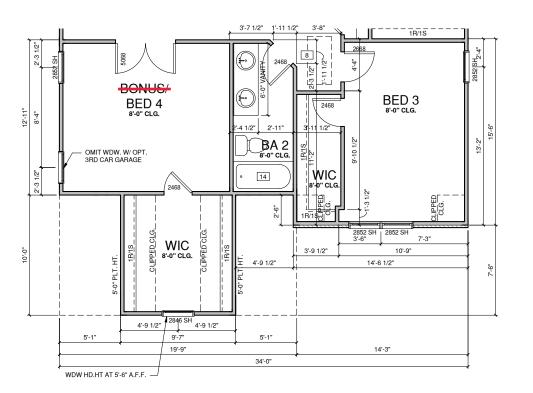

# SECOND FLOOR PLAN EURO

PROFESSIONAL SEAL:

group

NORTH CAROLINA OFFICE 108 B NORTH SALEM STREET

THESE PLANS AND SPECIFICATIONS ARE PROTECTED UNDER FEDERAL COPYRIGHT LAWS. GMD DESIGN GROUP CAROLINAS MAINTAINS OWNERSHIP OF SUCH AND ALL RIGHTS AND PRIVILEGES.

NO: DATE: REVISION:

SUITE 203 APEX, NC 27502 PHONE: (919) 320-3022

LOT 1129 -ANDERSON CREEK ACADEMY 01.22.2021

PROJECT TITLE:

THE FINLEY

CONSTRUCTION SET

CLIENTS NAME: MCKEE HOMES



PROJECT NO: GMD14038RAL

SHEET TITLE:

2ND FLOOR PLAN

PRINT DATE: 01.22.2021

SHEET NO:

A1.2.1


	FLOOR PLAN KEYNOTE LEGEND		
KEY VALUE	KEYNOTE TEXT		
1	HOUSE TO GARAGE FIRE SEPARATION, GARAGE/HOUSE SEPARATION AT VERTICAL SURFACES SHALL BE PROTECTED WITH ONE (1) LAYER 1/2" GYPSUM BOARD, GARAGE/HOUSE SEPARATION AT HORIZONTAL SURFACES SHALL BE PROTECTED WITH ONE (1) LAYER 5/8" TYPE "X" GYPSUM BOARD		
2	HOUSE TO GARAGE DOOR SEPARATION. PROVIDE 1 3/8" SOLID CORE DOOR OR APPROVED 20 MINUTE RATED DOOR		
3	BENEATH STAIRS AND LANDINGS. 1/2" GYPSUM BOARD ON WALLS AND CEILING OF ENCLOSED ACCESSIBLE AREAS		
7	PRE-FABRICATED METAL FIREPLACE, INSTALL PER MANUFACTURER WRITTEN INSTRUCTIONS		
8	ATTIC ACCESS LARGE ENOUGH TO REMOVE LARGEST PIECE OF EQUIPMENT BUT NOT LESS THAN 30"X22". FIRE RATED ACCESS AS NOTED. ATTIC ACCESS LADDER, VERIFY LOCATION AND SIZE WITH TRUSSES (25 1/2"X54" SIZE)		
9	TEMPERED SAFETY GLASS		
11	HALF WALL, HEIGHT AS NOTED		
12	INTERIOR SOFFITS: FFL = 8'-1" U.N.O. SFL = 7'-6" U.N.O.		
14	TUB-SHOWER COMBO		
16	SLIDE-IN ELECTRICAL RANGE W/ HOOD AND MICRO ABV. VENT PER MANUFACTURER'S WRITTEN INSTRUCTIONS		

FULL HEIGHT
2X4 WOOD STUD PARTITION 2X6 WOOD STUD PARTITION
STONE VENEER

AS NOTED ON PLAN

BRICK VENEER

STUD WALL BELOW HEIGHT AND STUD SIZE AS NOTED

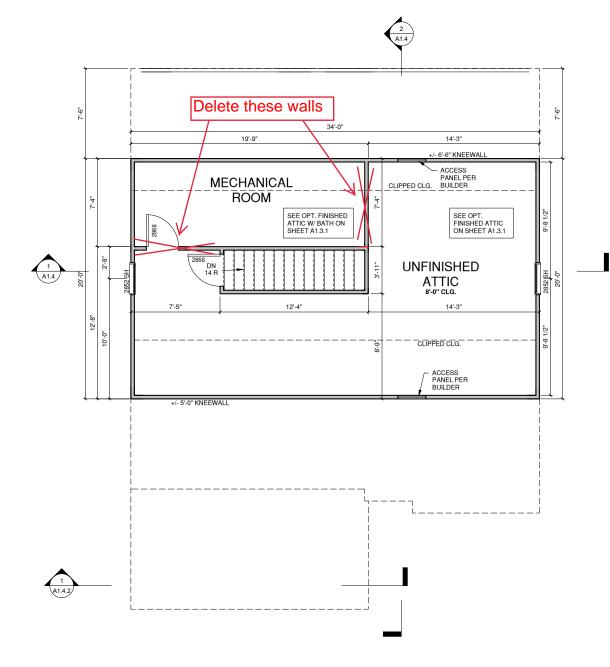

# $\bigcirc \frac{\mathsf{THIRD}\;\mathsf{FLR}.\;\mathsf{WALK}\text{-}\mathsf{UP}\;\mathsf{ATTIC}}{{}^{\mathsf{1/4"}}\,{}^{\mathsf{-}}\,{}^{\mathsf{1'-0"}}\;\mathsf{AT}\;\mathsf{22"X34"}\mathsf{LAYOUT}\;\mathsf{1/8"}\text{=}\,1^{\mathsf{-}0"}\;\mathsf{AT}\;\mathsf{11"}\;\mathsf{X}\;\mathsf{17"}\mathsf{LAYOUT}}$



NORTH CAROLINA OFFICE 108 B NORTH SALEM STREET SUITE 203 APEX, NC 27502 PHONE: (919) 320-3022

THESE PLANS AND SPECIFICATIONS ARE PROTECTED UNDER FEDERAL COPYRIGHT LAWS. GMD DESIGN GROUP CAROLINAS MAINTAINS OWNERSHIP OF SUCH AND ALL RIGHTS AND PRIVILEGES.

NO:	DATE:	REVISION:

PROFESSIONAL SEAL:



PROJECT TITLE:

THE FINLEY

CONSTRUCTION SET

CLIENTS NAME: MCKEE HOMES



PROJECT NO:


GMD14038RAL SHEET TITLE:

**3RD FLOOR** PLAN


PRINT DATE: 01.22.2021

SHEET NO:

A1.3

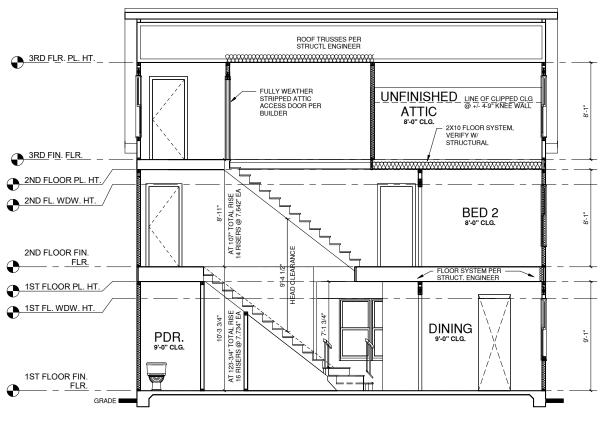

# $\underbrace{1}_{1/4^*=1^*0^*\text{ AT 22"X34" LAYOUT }1/8^*=1^*0^*\text{ AT 11" X 17" LAYOUT}}^{\text{BUILDING SECTION 1}}$

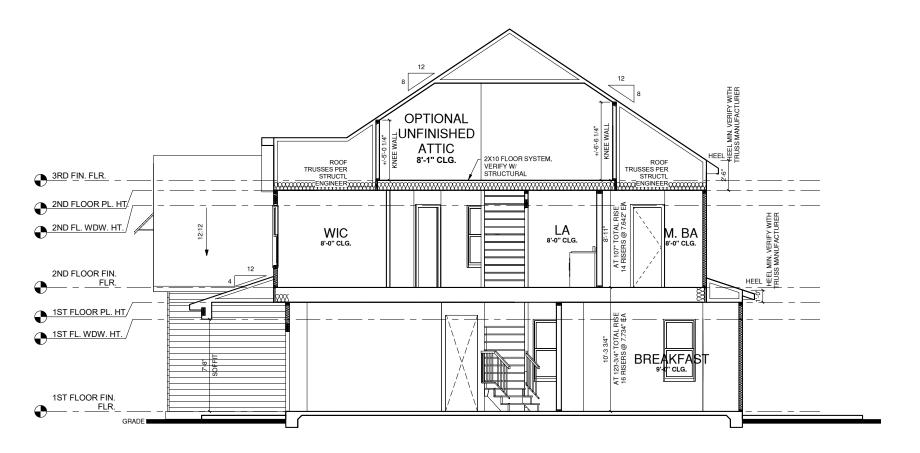





NORTH CAROLINA OFFICE

108 B NORTH SALEM STREET

108 B NORTH SALEM ST SUITE 203 APEX, NC 27502 PHONE: (919) 320-3022

THESE PLANS AND SPECIFICATIONS ARE PROTECTED UNDER FEDERAL COPYRIGHT LAWS. GMD DESIGN GROUP CAROLINAS MAINTAINS OWNERSHIP OF SUCH AND ALL RIGHTS AND PRIVILEGES.

NO:	DATE:	REVISION:

PROFESSIONAL SEAL:

LOT 1129 -ANDERSON CREEK ACADEMY 01.22.2021

PROJECT TITLE:

#### THE FINLEY

CONSTRUCTION SET

CLIENTS NAME: MCKEE HOMES



PROJECT NO: GMD14038RAL


SHEET TITLE:

#### BUILDING SECTIONS

PRINT DATE: 01.22.2021

SHEET NO:

**A**1.4

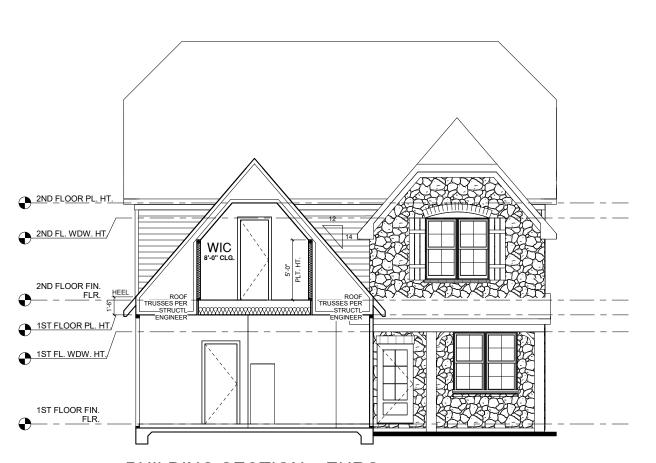

 ${\tiny \textcircled{3} \frac{\mathsf{BUILDING} \ \mathsf{SECTION} \ \mathsf{3} \ \mathsf{EURO}}{{}_{\mathsf{1/4^*} = 1^*0^*} \ \mathsf{AT} \ \mathsf{22^*X34^*} \ \mathsf{LAYOUT} \ \mathsf{1/8^*} = 1^*0^* \ \mathsf{AT} \ \mathsf{11^*X} \ \mathsf{17^*} \ \mathsf{LAYOUT}}}$ 



NORTH CAROLINA OFFICE 108 B NORTH SALEM STREET SUITE 203 APEX, NC 27502 PHONE: (919) 320-3022

THESE PLANS AND SPECIFICATIONS ARE PROTECTED UNDER FEDERAL COPYRIGHT LAWS. GMD DESIGN GROUP CAROLINAS MAINTAINS OWNERSHIP OF SUCH AND ALL RIGHTS AND PRIVILEGES.

NO:	DATE:	REVISION:

PROFESSIONAL SEAL:

LOT 1129 -ANDERSON CREEK ACADEMY 01.22.2021

PROJECT TITLE:

**THE FINLEY** 

CONSTRUCTION SET

CLIENTS NAME: MCKEE HOMES



PROJECT NO: GMD14038RAL

SHEET TITLE:

BUILDING SECTIONS

PRINT DATE: 01.22.2021

SHEET NO:

A1.4.1

	ELEVATION KEYNOTE LEGEND		
KEY VALUE	VALUE KEYNOTE TEXT		
E1	ADHERED STONE VENEER AS SELECTED BY DEVELOPER, HEIGHT AS NOTED		
E5	ROWLOCK COURSE		
E9	CORROSION RESISTANT ROOF TO WALL FLASHING, CODE COMPLIANT FLASHING MUST BE INSTALLED AT ALL ROOF/WALL INTERSECTIONS		
E12	FIBER CEMENT SHAKE SIDING PER DEVELOPER W/ 5/4x4 CORNER TRIM BOARDS		
E13	FIBER CEMENT LAP SIDING PER DEVELOPER W/ 5/4x4 CORNER TRIM BOARDS		
E15	FIBER CEMENT PANEL SIDING W/ 1X3 BATTS AT 12" O.C. (VINYL BOARD AND BATTEN SIDING)		
E16	5/4X FIBER CEMENT TRIM OR 5/4X WOOD TRIM W/ VINYL CAP OR COIL STOCK, SIZE AS NOTED (SIZES SHOWN ARE NOMINAL WIDTHS)		
E17	FALSE WOOD SHUTTERS, TYPE AS SHOWN, SIZE AS NOTED		
E18	1X6 FIBER CEMENT BOARD FASCIA OVER 2X4 SUB-FASCIA OR 2X6 FASCIA W/ VINYL CAP OR		

ALL WINDOWS WHOSE OPENING IS LESS THAN 24" ABOVE THE FINISH FLOOR AND WHOSE OPENING IS GREATER THAN 72" ABOVE THE OUTSIDE WALKING SURFACE MUST HAVE WINDOW OPENING LIMITING DEVICES COMPLYING WITH THE 2012 IRC SECTION R312.2.

#### NOTES:

-GRADE CONDITIONS MAY VARY FOR INDIVIDUAL SITE FROM THAT SHOWN. BUILDER SHALL VERIFY AND COORDINATE PER ACTUAL SITE CONDITIONS

WINDOW HEAD HEIGHTS: 1ST FLOOR = 8'-0" U.N.O. ON ELEVATIONS 2ND FLOOR = 7'-0" U.N.O. ON ELEVATIONS 3RD FLOOR = 7'-0" U.N.O. ON ELEVATIONS.


ROOFING: PITCHED SHINGLES PER BUILDER.


WINDOWS: MANUFACTURER PER BUILDER, DIVIDED LITES AS SHOWN ON THE EXTERIOR ELEVATIONS

ENTRY DOOR: AS SELECTED BY BUILDER


CHIMNEY AS OCCURS: TOP OF CHIMNEYS TO BE A MINIMUM OF 24" ABOVE ANY ROOF WITHIN 10'-0" OF CHIMNEY.

-ALL EXTERIOR MATERIALS TO BE INSTALLED PER MANUFACTURER'S WRITTEN INSTRUCTIONS.

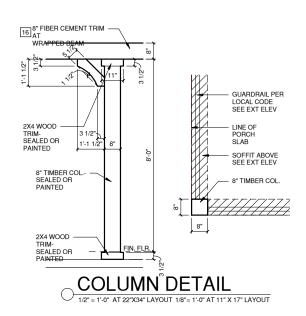

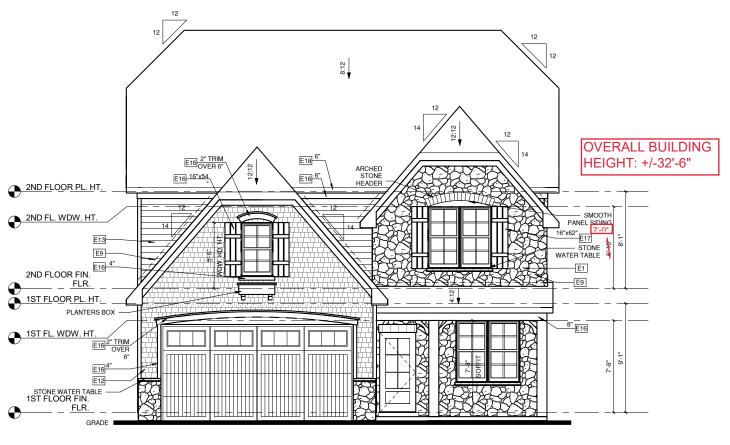

# ① FRONT ELEVATION 1/4" = 1'-0" AT 22"X34" LAYOUT 1/8" = 1'-0" AT 11" X 17" LAYOUT

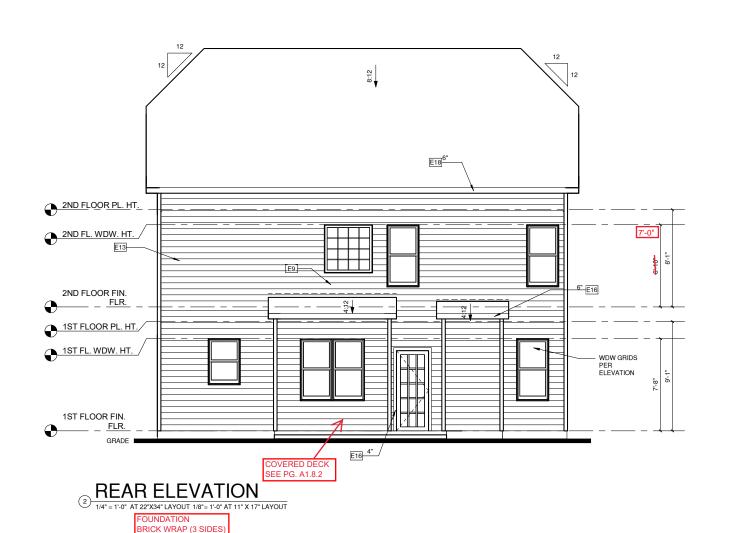



NORTH CAROLINA OFFICE 108 B NORTH SALEM STREET

APEX, NC 27502 PHONE: (919) 320-3022

THESE PLANS AND SPECIFICATIONS ARE PROTECTED UNDER FEDERAL COPYRIGHT LAWS. GMD DESIGN GROUP CAROLINAS MAINTAINS OWNERSHIP OF SUCH AND ALL RIGHTS AND PRIVILEGES.

NO:	DATE:	REVISION:

PROFESSIONAL SEAL:



PROJECT TITLE:

THE FINLEY

CONSTRUCTION SET

CLIENTS NAME: MCKEE HOMES



PROJECT NO:

GMD14038RAL SHEET TITLE:

**EURO EXTERIOR ELEVATIONS** 

PRINT DATE: 01.22.2021

SHEET NO: A1.8.0

ELEVATION KEYNOTE LEGEND		
KEY VALUE	KEYNOTE TEXT	
E1	ADHERED STONE VENEER AS SELECTED BY DEVELOPER, HEIGHT AS NOTED	
E5	ROWLOCK COURSE	
E9	CORROSION RESISTANT ROOF TO WALL FLASHING, CODE COMPLIANT FLASHING MUST BE INSTALLED AT ALL ROOF/WALL INTERSECTIONS	
E12	FIBER CEMENT SHAKE SIDING PER DEVELOPER W/ 5/4x4 CORNER TRIM BOARDS	
E13	FIBER CEMENT LAP SIDING PER DEVELOPER W/ 5/4x4 CORNER TRIM BOARDS	
E15	FIBER CEMENT PANEL SIDING W/ 1X3 BATTS AT 12" O.C. (VINYL BOARD AND BATTEN SIDING)	
E16	5/4X FIBER CEMENT TRIM OR 5/4X WOOD TRIM W/ VINYL CAP OR COIL STOCK, SIZE AS NOTED (SIZES SHOWN ARE NOMINAL WIDTHS)	
E17	FALSE WOOD SHUTTERS, TYPE AS SHOWN, SIZE AS NOTED	
E18	1X6 FIBER CEMENT BOARD FASCIA OVER 2X4 SUB-FASCIA OR 2X6 FASCIA W/ VINYL CAP OR COIL STOCK	

ALL WINDOWS WHOSE OPENING IS LESS THAN 24" ABOVE THE FINISH FLOOR AND WHOSE OPENING IS GREATER THAN 72" ABOVE THE OUTSIDE WALKING SURFACE MUST HAVE WINDOW OPENING LIMITING DEVICES COMPLYING WITH THE 2012 IRC SECTION R312.2.

#### NOTES:

-GRADE CONDITIONS MAY VARY FOR INDIVIDUAL SITE FROM THAT SHOWN. BUILDER SHALL VERIFY AND COORDINATE PER ACTUAL SITE CONDITIONS.

-WINDOW HEAD HEIGHTS: 1ST FLOOR = 8'-0" U.N.O. ON ELEVATIONS 2ND FLOOR = 7'-0" U.N.O. ON ELEVATIONS 3RD FLOOR = 7'-0" U.N.O. ON ELEVATIONS.


ROOFING: PITCHED SHINGLES PER BUILDER.

-WINDOWS: MANUFACTURER PER BUILDER. DIVIDED LITES AS SHOWN ON THE EXTERIOR ELEVATIONS

-ENTRY DOOR: AS SELECTED BY BUILDER

-CHIMNEY AS OCCURS: TOP OF CHIMNEYS TO BE A MINIMUM OF 24" ABOVE ANY ROOF WITHIN 10"-0" OF CHIMNEY.

-ALL EXTERIOR MATERIALS TO BE INSTALLED PER MANUFACTURER'S WRITTEN INSTRUCTIONS.

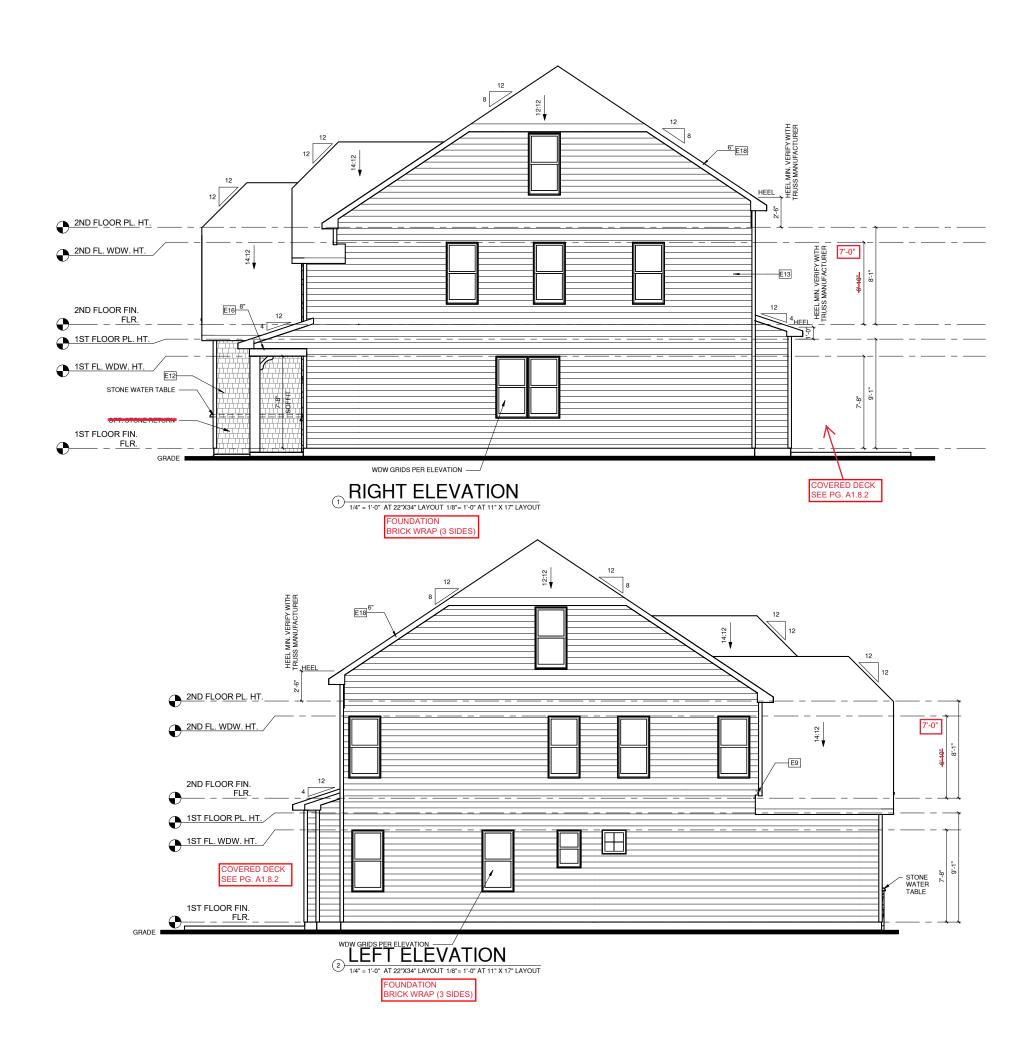



NORTH CAROLINA OFFICE 108 B NORTH SALEM STREET SUITE 203 APEX, NC 27502 PHONE: (919) 320-3022

THESE PLANS AND SPECIFICATIONS ARE PROTECTED UNDER FEDERAL COPYRIGHT LAWS. GMD DESIGN GROUP CAROLINAS MAINTAINS OWNERSHIP OF SUCH AND ALL RIGHTS AND PRIVILEGES.

NO:	DATE:	REVISION:

PROFESSIONAL SEAL:

LOT 1129 -ANDERSON CREEK ACADEMY 01.22.2021

PROJECT TITLE:

THE FINLEY

CONSTRUCTION SET

CLIENTS NAME: MCKEE HOMES



PROJECT NO:

GMD14038RAL SHEET TITLE:

**EURO EXTERIOR ELEVATIONS** 

PRINT DATE: 01.22.2021

SHEET NO:

A1.8.1

ELEVATION KEYNOTE LEGEND		
KEY VALUE	KEYNOTE TEXT	
E1	ADHERED STONE VENEER AS SELECTED BY DEVELOPER, HEIGHT AS NOTED	
E5	ROWLOCK COURSE	
E9	CORROSION RESISTANT ROOF TO WALL FLASHING, CODE COMPLIANT FLASHING MUST BE INSTALLED AT ALL ROOF, WALL INTERSECTIONS	
E12	FIBER CEMENT SHAKE SIDING PER DEVELOPER W/ 5/4x4 CORNER TRIM BOARDS	
E13	FIBER CEMENT LAP SIDING PER DEVELOPER W/ 5/4x4 CORNER TRIM BOARDS	
E15	FIBER CEMENT PANEL SIDING W/ 1X3 BATTS AT 12" O.C. (VINYL BOARD AND BATTEN SIDING)	
E16	5/4X FIBER CEMENT TRIM OR 5/4X WOOD TRIM W/ VINYL CAP OR COIL STOCK, SIZE AS NOTED (SIZES SHOWN ARE NOMINAL WIDTHS)	
E17	FALSE WOOD SHUTTERS, TYPE AS SHOWN, SIZE AS NOTED	
E18	1X6 FIBER CEMENT BOARD FASCIA OVER 2X4 SUB-FASCIA OR 2X6 FASCIA W/ VINYL CAP OR COIL STOCK	

ALL WINDOWS WHOSE OPENING IS LESS THAN 24" ABOVE THE FINISH FLOOR AND WHOSE OPENING IS GREATER THAN 72" ABOVE THE OUTSIDE WALKING SURFACE MUST HAVE WINDOW OPENING LIMITING DEVICES COMPLYING WITH THE 2012 IRC SECTION R312.2.

#### NOTES:

-GRADE CONDITIONS MAY VARY FOR INDIVIDUAL SITE FROM THAT SHOWN BUILDER SHALL VERIFY AND COORDINATE PER ACTUAL SITE CONDITIONS

-WINDOW HEAD HEIGHTS: 1ST FLOOR = 8'-0" U.N.O. ON ELEVATIONS 2ND FLOOR = 7'-0" U.N.O. ON ELEVATIONS 3RD FLOOR = 7'-0" U.N.O. ON ELEVATIONS.


ROOFING: PITCHED SHINGLES PER BUILDER.


-WINDOWS: MANUFACTURER PER BUILDER. DIVIDED LITES AS SHOWN ON THE EXTERIOR ELEVATIONS

ENTRY DOOR: AS SELECTED BY BUILDER

-CHIMNEY AS OCCURS: TOP OF CHIMNEYS TO BE A MINIMUM OF 24" ABOVE ANY ROOF WITHIN 10'-0" OF CHIMNEY.

-ALL EXTERIOR MATERIALS TO BE INSTALLED PER MANUFACTURER'S WRITTEN INSTRUCTIONS.

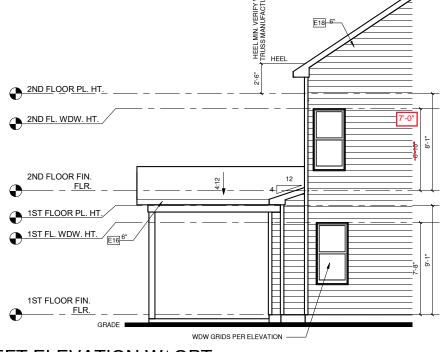

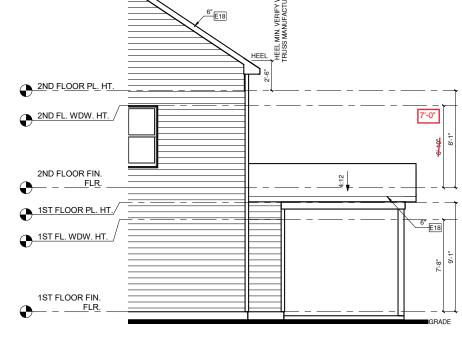

## LEFT ELEVATION W/ OPT. () COVERED PORCH 1/4" = 1'-0" AT 22"X34" LAYOUT 1/8" = 1'-0" AT 11" X 17" LAYOUT





group

NORTH CAROLINA OFFICE 108 B NORTH SALEM STREET

SUITE 203 APEX, NC 27502 PHONE: (919) 320-3022

THESE PLANS AND SPECIFICATIONS ARE PROTECTED UNDER FEDERAL COPYRIGHT LAWS. GMD DESIGN GROUP CAROLINAS MAINTAINS OWNERSHIP OF SUCH AND ALL RIGHTS AND PRIVILEGES.

IIGITIO AND THIVIEEGES.			
0:	DATE:	REVISION:	

PROFESSIONAL SEAL:

LOT 1129 -ANDERSON CREEK ACADEMY 01.22.2021

PROJECT TITLE:

THE FINLEY

CONSTRUCTION SET

CLIENTS NAME: MCKEE HOMES



PROJECT NO:

GMD14038RAL SHEET TITLE:

**EURO** EXTERIOR **ELEVATION** OPTIONS

PRINT DATE: 01.22.2021

SHEET NO:

A1.8.2

#### 1/150

CENERACEON RACTOR SHALL VERIFY THE NEW THEOLOGY OWNER. VERIFY WITH MANUFACTURER OF HIGH AND LOW VENTS TO BE USED FOR MINIMUM CALCULATED VENTS REQUIRED. THE REQUIRED VENTIATION SHALL BE MAINTAINED. PROVIDE INSULATION STOP SUCH THAT INSULATION DOES NOT OBSTRUCT FREE AIR MOVEMENT AS REQUIRED BY THE BUILDING OFFICIAL.

ALL OVERLAP FRAMED ROOF AREAS SHALL HAVE OPENINGS BETWEEN THE ADJACENT ATTICS IN THE ROOF SHEATHING (AS ALLOWED BY THE STRUCTURAL ENGINEER) TO ALLOW PASSAGE AND ATTIC VENTILATION BETWEEN THE TWO OR ISOLATED ATTIC SPACES SHALL BE VENTED INDEPENDENTLY TO CBC REQUIREMENTS.

PER DEVELOPER, AT ALL CANTILEVERED FLOORS, CANTILEVERED ARCHITECTURAL POPOUTS, AND ANY DOUBLE FRAMING PROJECTIONS THAT ARE SEPARATED FROM THE VENTING CALCULATIONS SHOWN ABOVE, PROVIDE A CONTINUOUS 2° CORROSION RESISTANT SOFFIT VENT AT UNDERSIDE OF FRAMED ELEMENT.

#### 1/300

AS DALLER OF TO THE 1/150 RATIO LISTED, THE NET FREGORDS LEATHLATION AREA MAY BE REDUCED TO 1/300 WHEN A VAPOR BARRIER IS HAVING A TRANSMISSION RATE NOT EXCEEDING I-PERM INSTALLED ON THE WARM-IN-WINTER SIDE OF THE CEILING.

GENERAL CONTRACTOR SHALL VERIFY THE NET FREE VENTILATION OF THE VENT PRODUCT SELECTED BY OWNER. VERIFY WITH MANUFACTURER OF HIGH AND LOW VENTS TO BE USED FOR MINIMUM CALCULATED VENTS REQUIRED. THE REQUIRED VENTILATION SHALL BE MAINTAINED, PROVIDE INSULATION STOP SUCH THAT INSULATION DOES NOT OBSTRUCT FREE AIR MOVEMENT AS REQUIRED BY THE


ALL OVERLAP FRAMED ROOF AREAS SHALL HAVE OPENINGS BETWEEN THE ADJACENT ATTICS IN THE ROOF SHEATHING (AS ALLOWED BY THE STRUCTURAL ENGINEER) TO ALLOW PASSAGE AND ATTIC VENTILATION BETWEEN THE TWO OR ISOLATED ATTIC SPACES SHALL BE VENTED INDEPENDENTLY TO CBC REQUIREMENTS.

PER DEVELOPER, AT ALL CANTILEVERED FLOORS, CANTILEVERED ARCHITECTURAL POP-OUTS, AND ANY DOUBLE FRAMING PROJECTIONS THAT ARE SEPARATED FROM THE VENTING CALCULATIONS SHOWN ABOVE, PROVIDE A CONTINUOUS 2" CORROSION RESISTANT SOFFIT VENT AT UNDERSIDE OF FRAMED ELEMENT.

#### NOTES:

- ALL ROOF DRAINAGE SHALL BE PIPED TO STREET OR APPROVED DRAINAGE FACILITY.
  DASHED LINES INDICATE WALL BELOW.
  LOCATE GUTTER AND DOWNSPOUTS PER BUILDER.
  PITCHED ROOFS AS NOTED.
- TRUSS MANUFACTURER SHALL SUBMIT STRUCTURAL CALCS AND SHOP DRAWING TO THE BUILDER'S GENERAL CONTRACTOR AND BUILDING DEPARTMENT FOR REVIEW PRIOR TO FABRICATIONS.
  ALL PLUMBING VENTS SHALL BE COMBINED INTO A MINIMUM AMOUNT OF ROOF PENETRATIONS. ALL ROOF PENETRATION SHALL OCCUR TO THE REAR OF THE MAIN RIDGE.

	ROOF VENT CALC ELEV 'D'		
Name	Area	1/300 RATIO FOR HIGH & LOW	1/150 RATIO FOR HIGH & LOW
AREA 3	29 SF	7 in <sup>2</sup>	14 in²
AREA 1	1423 SF	342 in <sup>2</sup>	683 in <sup>2</sup>
AREA 2	64 SF	15 in²	31 in <sup>2</sup>
AREA 4	196 SF	47 in <sup>2</sup>	94 in <sup>2</sup>
AREA 5	247 SF	59 in <sup>2</sup>	118 in²

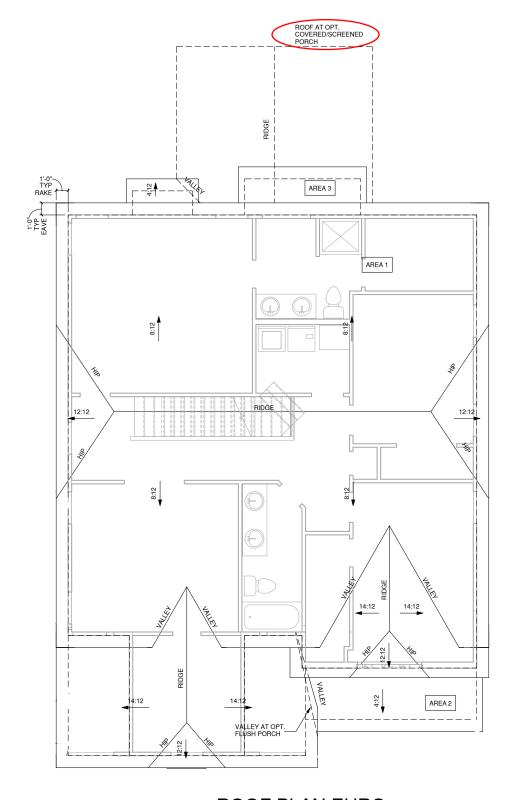

**ROOF PLAN EURO** 



NORTH CAROLINA OFFICE 108 B NORTH SALEM STREET

SUITE 203 APEX, NC 27502 PHONE: (919) 320-3022

THESE PLANS AND SPECIFICATIONS ARE PROTECTED UNDER FEDERAL COPYRIGHT LAWS. GMD DESIGN GROUP CAROLINAS MAINTAINS OWNERSHIP OF SUCH AND ALL RIGHTS AND PRIVILEGES.

NO:	DATE:	REVISION:

PROFESSIONAL SEAL:



PROJECT TITLE:

THE FINLEY

CONSTRUCTION SET

CLIENTS NAME: MCKEE HOMES



PROJECT NO:

GMD14038RAL


SHEET TITLE:

**EURO ROOF PLAN** 


PRINT DATE: 01.22.2021

SHEET NO:

A1.8.5

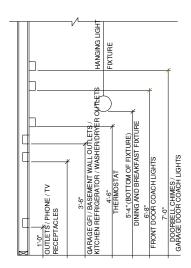

#### STANDARD ELECTRICAL BOX HEIGHTS

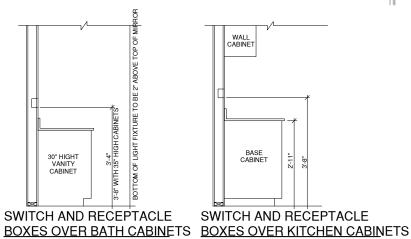

#### NOTES:

-PROVIDE GROUNDING ELECTRICAL ROD PER LOCAL CODES.

-PROVIDE AND INSTALL ARC FAULT CIRCUIT-INTERRUPTERS (AFCI) AS REQUIRED BY NATIONAL ELECTRICAL CODE (NEC) AND MEETING THE REQURIEMENTS OF ALL GOVERNING CODES.

ALL EXHAUST FANS SHALL HAVE BACKDRAFT DAMPERS

-FAN/LIGHTS IN WET/DAMP LOCATIONS SHALL BE LABLED "SUITABLE FOR WET OR DAMP LOCATIONS."

-ELECTRICAL SYSTEMS ARE SHOWN FOR INTENT ONLY. THESE SYSTEMS SHALL BE ENGINEERED BY OTHERS. THE CONTRACTOR SHALL BE RESPONSIBLE FOR PROPER INSTALLATION AND PLACEMENT

-PROVIDE AND INSTALL LOCALLY CERTIFIED SMOKE DETECTORS AND CO2 DETECTORS AS REQUIRED BY NATIONAL FIRE PROTECTION ASSOCIATION (NFPA) AND MEETING THE REQUIREMENTS OF ALL GOVERNING CODES.


PROVIDE AND INSTALL GROUND FAULT CIRCUIT-INTERRUPTERS (GFI) AS REQUIRED BY NATIONAL ELECTRICAL CODE (NEC) AND MEETING THE REQUIREMENTS OF ALL GOVERNING CODES.

-ELECTRICAL CONTRACTOR TO PROVIDE REQURIED DIRECT HOOK-UPS/CUTOFFS.

HVAC CONTRACTOR TO VERIFY THERMOSTAT LOCATIONS.

-ALL ELECTRICAL AND MECHANICAL EQUIPMENT (FURNACES, A/C UNITS, ELECTRICAL PANELS, SANITARY SUMP PITS

DRAING TILE SUMP, AND WATER HEATERS) ARE SUBJECT TO RELOCATOIN DUE TO FIELD CONDITIONS.					
-PROVIDE POWER, LIGHT AND SWITCH AS REQUIRED FOR ATTIC FURNACE PER CODE AND MANUFACTURER'S WRITTEN INSTRUCTIONS.					
LEGE	ND:				
P	DUPLEX OUTLET	$\phi$	CEILING MOUNTED INCANDESCENT LIGHT FIXTURE		
₩P/GFI	WEATHERPROOF GFI DUPLEX OUTLET	<del>-</del>	WALL MOUNTED INCANDESCENT LIGHT FIXUTRE		
Pgfi	GROUND-FAULT CIRCUIT- INTERRUPTER DUPLEX OUTLET	$\frac{\vee}{\rightarrow}$	RECESSED INCANDESCENT LIGHT FIXTURE		
ρ	HALF-SWITCHED DUPLEX OUTLET	4	(VP) = VAPOR PROOF		
₩ 220V	220 VOLT OUTLET		EXHAUST FAN (VENT TO EXTERIOR)		
(J	REINFORCED JUNCTION BOX	-	EXHAUST FAN/LIGHT COMBINATION (VENT TO EXTERIOR)		
\$	WALL SWITCH	- '	(1		
\$3	THREE-WAY SWITCH	$\sim$	FLUORESCENT LIGHT FIXTURE		
\$4	FOUR-WAY SWITCH		TECH HUB SYSTEM		
CH	CHIMES		CEILING FAN		
9	PUSHBUTTON SWITCH		(PROVIDE ADEQUATE SUPPORT)		
<b>SD</b>	110V SMOKE DETECTOR W/ BATTERY BACKUP	\\ \\ \	CEILING FAN WITH INCANDESCENT LIGHT FIXTURE		
<u> </u>	CO2 DETECTOR		(PROVIDE ADEQUATE SUPPORT)		
T	THERMOSTAT	∞	GAS SUPPLY WITH VALVE		
PH	TELEPHONE				
TV	TELEVISION	HB			
۵	ELECTRIC METER	—tcw	1/4" WATER STUB OUT		
_	ELECTRIC PANEL	-∖	WALL SCONCE		
_	DISCONNECT SWITCH	_ M			

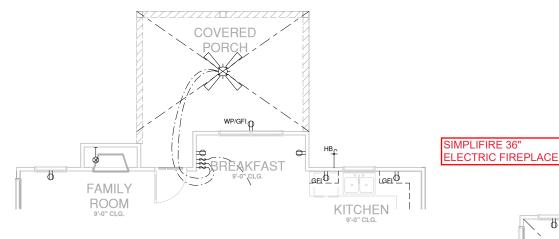


# OPT. COVERED PORCH UTILITY

SELECTIONS FOR

LECTRIC FIXTURES

1/4" = 1'-0" AT 22"X34" LAYOUT 1/8"= 1'-0" AT 11" X 17" LAYOUT

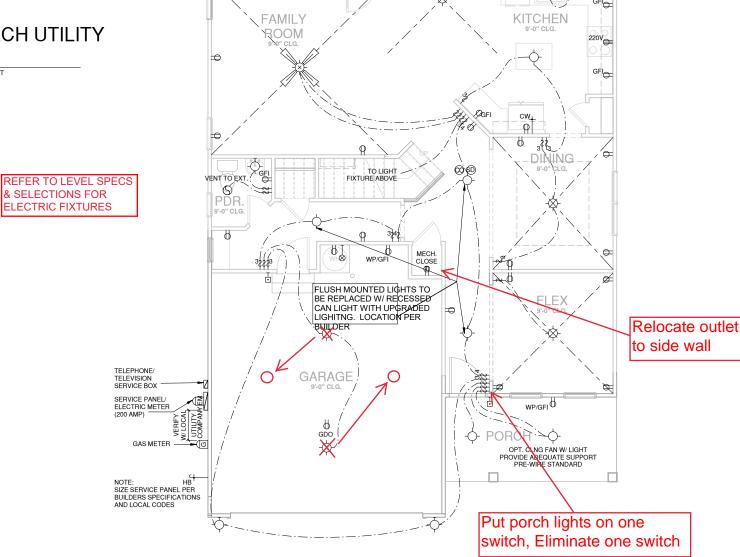

COVERED DECK SEE DETAIL TO THE LEFT

WP/GFI

# FIRST FLOOR UTILITY PLAN



NORTH CAROLINA OFFICE 108 B NORTH SALEM STREET

SUITE 203 APEX, NC 27502 PHONE: (919) 320-3022

THESE PLANS AND SPECIFICATIONS ARE PROTECTED UNDER FEDERAL COPYRIGHT LAWS. GMD DESIGN GROUP CAROLINAS MAINTAINS OWNERSHIP OF SUCH AND ALL RIGHTS AND PRIVILEGES.

NO:	DATE:	REVISION:

PROFESSIONAL SEAL:

LOT 1129 -ANDERSON CREEK ACADEMY 01.22.2021

PROJECT TITLE:

THE FINLEY

CONSTRUCTION SET

CLIENTS NAME: MCKEE HOMES



PROJECT NO:


GMD14038RAL SHEET TITLE:

**1ST FLOOR UTILITY PLAN** 


PRINT DATE:

01.22.2021


SHEET NO: E1.0

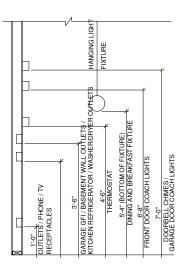


#### STANDARD ELECTRICAL BOX HEIGHTS

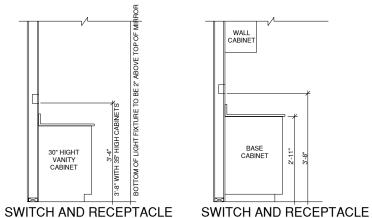

# SWITCH AND RECEPTACLE SWITCH AND RECEPTACLE BOXES OVER BATH CABINETS BOXES OVER KITCHEN CABINETS

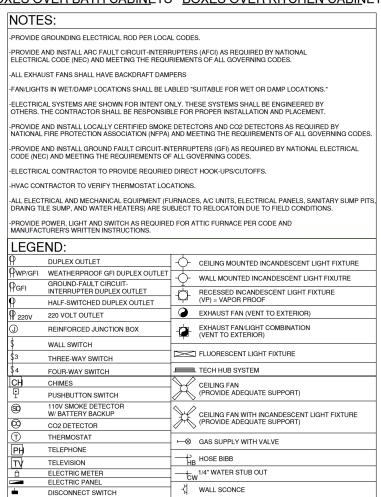

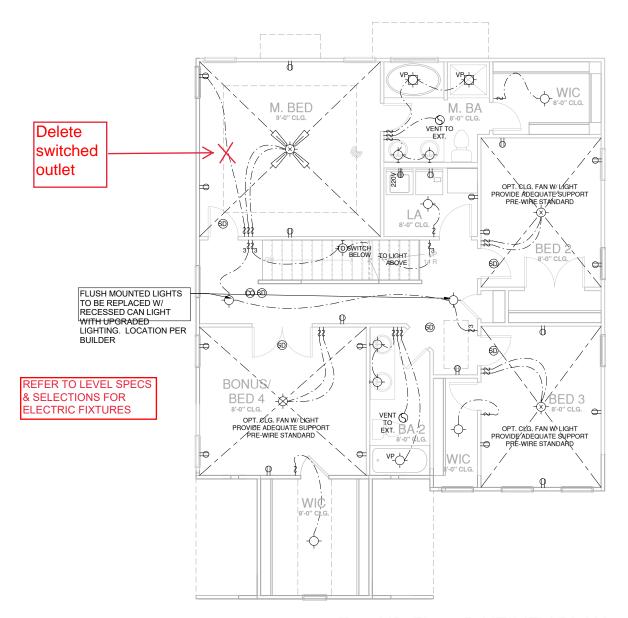

SECOND FLOOR UTILITY PLAN

1 1/4" = 1'-0" AT 22"X34" LAYOUT 1/8" = 1'-0" AT 11" X 17" LAYOUT



NORTH CAROLINA OFFICE 108 B NORTH SALEM STREET

SUITE 203 APEX, NC 27502 PHONE: (919) 320-3022

THESE PLANS AND SPECIFICATIONS ARE PROTECTED UNDER FEDERAL COPYRIGHT LAWS. GMD DESIGN GROUP CAROLINAS MAINTAINS OWNERSHIP OF SUCH AND ALL RIGHTS AND PRIVILEGES.

NO:	DATE:	REVISION:

PROFESSIONAL SEAL:



PROJECT TITLE:

THE FINLEY

CONSTRUCTION SET

CLIENTS NAME: MCKEE HOMES



PROJECT NO: GMD14038RAL


SHEET TITLE:

2ND FLOOR UTILITY PLAN


PRINT DATE: 01.22.2021

SHEET NO:

**E2.0** 

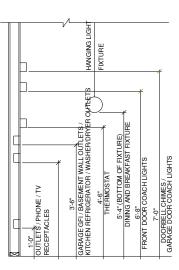

#### STANDARD ELECTRICAL BOX HEIGHTS

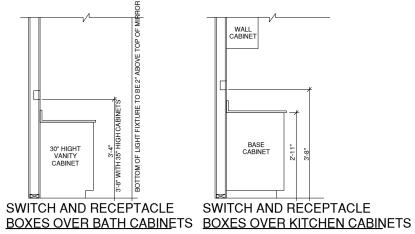

NOTES: -PROVIDE GROUNDING ELECTRICAL ROD PER LOCAL CODES. -ALL EXHAUST FANS SHALL HAVE BACKDRAFT DAMPERS

-FAN/LIGHTS IN WET/DAMP LOCATIONS SHALL BE LABLED "SUITABLE FOR WET OR DAMP LOCATIONS."

-ELECTRICAL SYSTEMS ARE SHOWN FOR INTENT ONLY. THESE SYSTEMS SHALL BE ENGINEERED BY OTHERS. THE CONTRACTOR SHALL BE RESPONSIBLE FOR PROPER INSTALLATION AND PLACEMENT.


-PROVIDE AND INSTALL GROUND FAULT CIRCUIT-INTERRUPTERS (GFI) AS REQUIRED BY NATIONAL ELECTRICAL CODE (NEC) AND MEETING THE REQUIREMENTS OF ALL GOVERNING CODES.

-ELECTRICAL CONTRACTOR TO PROVIDE REQURIED DIRECT HOOK-UPS/CUTOFFS.

-HVAC CONTRACTOR TO VERIFY THERMOSTAT LOCATIONS.

-ALL ELECTRICAL AND MECHANICAL EQUIPMENT (FURNACES, A/C UNITS, ELECTRICAL PANELS, SANITARY SUMP PITS, DRAING TILE SUMP, AND WATER HEATERS) ARE SUBJECT TO RELOCATOIN DUE TO FIELD CONDITIONS.							
,,,,,,,,,,,,,,,,,,,,,,,,,,,,,,,,,,,,,,,							
-PROVIDE POWER, LIGHT AND SWITCH AS REQUIRED FOR ATTIC FURNACE PER CODE AND MANUFACTURER'S WRITTEN INSTRUCTIONS.							
LEGE	LEGEND:						
P	DUPLEX OUTLET	-6-	CEILING MOUNTED INCANDESCENT LIGHT FIXTURE				
₩P/GFI	WEATHERPROOF GFI DUPLEX OUTLET	<del>,</del>	WALL MOUNTED INCANDESCENT LIGHT FIXUTRE				
P <sub>GFI</sub>	GROUND-FAULT CIRCUIT- INTERRUPTER DUPLEX OUTLET	Ŷ	BECESSED INCANDESCENT LIGHT FIXTURE				
φ	HALF-SWITCHED DUPLEX OUTLET	4	(VP) = VAPOR PROOF				
₩ <sub>220</sub> V	220 VOLT OUTLET	•	EXHAUST FAN (VENT TO EXTERIOR)				
<b>3</b>	REINFORCED JUNCTION BOX		EXHAUST FAN/LIGHT COMBINATION (VENT TO EXTERIOR)				
\$	WALL SWITCH		(VEIT) TO EXTERNOLLY				
\$3	THREE-WAY SWITCH		FLUORESCENT LIGHT FIXTURE				
\$4	FOUR-WAY SWITCH	_	TECH HUB SYSTEM				
СН	CHIMES		CEILING FAN				
무	PUSHBUTTON SWITCH		(PROVIDE ADEQUATE SUPPORT)				
<b>SD</b>	110V SMOKE DETECTOR W/ BATTERY BACKUP		CEILING FAN WITH INCANDESCENT LIGHT FIXTURE				
@	CO2 DETECTOR		(PROVIDE ADEQUATE SUPPORT)				
T	THERMOSTAT	<u> </u>	GAS SUPPLY WITH VALVE				
PH	TELEPHONE						
ΤV	TELEVISION	НВ	HOSE BIBB				
	ELECTRIC METER		1/4" WATER STUB OUT				
-	ELECTRIC PANEL	V.	WALL SCONCE				
-	DISCONNECT SWITCH	K	WALL SCONCE				

REFER TO LEVEL SPECS & SELECTIONS FOR ELECTRIC FIXTURES

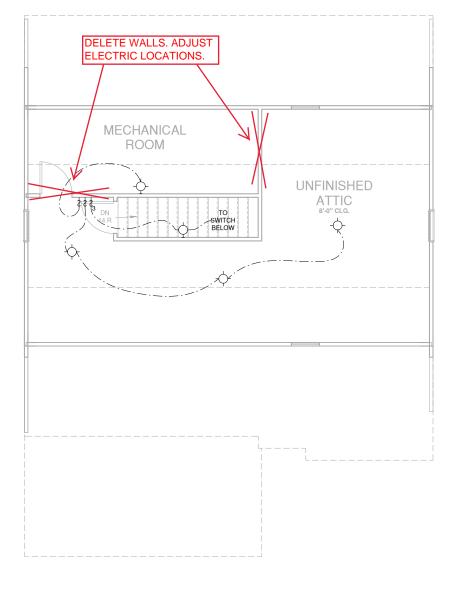

THIRD FLR. UTILITY PLAN

1/4" = 1'-0" AT 22"X34" LAYOUT 1/8" = 1'-0" AT 11" X 17" LAYOUT



NORTH CAROLINA OFFICE 108 B NORTH SALEM STREET

SUITE 203 APEX, NC 27502 PHONE: (919) 320-3022

THESE PLANS AND SPECIFICATIONS ARE PROTECTED UNDER FEDERAL COPYRIGHT LAWS. GMD DESIGN GROUP CAROLINAS MAINTAINS OWNERSHIP OF SUCH AND ALL RIGHTS AND PRIVILEGES.

DATE:	REVISION:
	DATE:

PROFESSIONAL SEAL:

LOT 1129 -ANDERSON CREEK **ACADEMY** 01.22.2021

PROJECT TITLE:

THE FINLEY

CONSTRUCTION SET

CLIENTS NAME: MCKEE HOMES



PROJECT NO: GMD14038RAL

SHEET TITLE:

3RD FLOOR

**UTILITY PLAN** 

PRINT DATE: 01.22.2021

SHEET NO:

E3.0

Construction Type: Commerical ☐ Residential ☒

Applicable Building Codes:

• 2018 North Carolina Residential Building Code with All Local Amendments ASCE 7-10: Minimum Design Loads for Buildings and Other Structures

## Design Loads:

Ĩ 1.	Roof	Live Loads	
	1.1.	Conventional 2x	20 PSF
	1.2.		20 PSF
		1.2.1. Attic Truss	60 PSF
2.	Roof	Dead Loads	
	2.1.	Conventional 2x	10 PSF
	2.2.	Truss	20 PSF
3.	Snow		15 PSF
	3.l.	Importance Factor	1.0
4.		Live Loads	
	4.1.	Typ. Dwelling	40 PSF
	4.2.	Sleeping Areas	30 PSF
	4.3.	Decks	40 PSF
		Passenger Garage	
5.		Dead Loads	
	5.1.	Conventional 2x	10 PSF
	5.2.	I-Joist	15 PSF
	5.3.	Floor Truss	15 PSF
6.	Ultima	te Design Wind Speed (3 sec. gust)	130 MPH
	6.1.	Exposure	В
	6.2.	Importance Factor	1.0
	6.3.	Wind Base Shear	

Component and Cladding (in PSF)						
MEAN ROOF HT.	UP TO 30'	3Ø'1"-35'	35'1"-4Ø'	40'1"-45'		
ZONE 1	16.7,-18.0	17.5,-18.9	18.2,-19.6	18.7,-20.2		
ZONE 2	16.7,-21.0	17.5,-22.1	18.2,-22.9	18.7,-23.5		
ZONE 3	16.7,-21.0	17.5,=22.1	18.2,-22.9	18.7,-23.5		
ZONE 4	18.2,-19.0	19.2,-20.0	19.9,-20.7	20.4,-21.3		
ZONE 5	18.2,-24.0	19.2,-25.2	19.9,-26.1	20.4,-26.9		

## 8 Seismic


C
Site Class
Design CategoryC
Importance Factor
Seismic Use Group
Spectral Response Acceleration
8.5.1. Sms = %g
8.5.2. Sml = %g
Seismic Base Shear

8.6.1. VX = 8.6.2.Vy = 8.7. Basic Structural System (check one)

6.3.1. Vx = 6.3.2.Vy =

> Bearing Wall ☐ Building Frame □ Moment Frame □ Dual w/ Special Moment Frame

☐ Dual w/ Intermediate R/C or Special Steel □ Inverted Pendulum 8.8. Arch/Mech Components Anchored ...... 8.9. Lateral Design Control: Seismic □ Wind ⊠

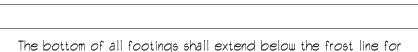

of a licensed professional engineer. 4. The resulting soil shall be compacted to a minimum of 95%

maximum dry density.

6. No concrete shall be placed against any subgrade containing water, ice, frost, or loose material.

## STRUCTURAL STEEL:

Structural steel shall be fabricated and erected in accordance with the American Institute of Steel Construction "Code of Standard Practice for Steel Buildings and Bridges" and the manual of Steel Construction "Load Resistance Factor Design" latest editions.

rust-inhibitive paint.

Welding shall conform to the latest edition of the American Welding Society's Structural Welding Code AWS D.I. Electrodes for shop and field welding shall be class ETØXX. All welding shall be performed by a certified welder per the above standards.

compressive strength (f'c) at 28 days of 3000 psi, unless

Concrete shall be proportioned, mixed, and placed in accordance with the latest editions of ACI 318: "Building Code Requirements for Reinforced Concrete" and ACI 301: "Specifications for Structural Concrete for Buildings".

target values as follows:

4. No admixtures shall be added to any structural concrete without written permission of the SER.



## STRUCTURAL PLANS PREPARED FOR:

McKee Homes 109 Hay St., Suite 301 Fayetteville, NC 28301

DESIGNER:

Planworx Architecture, P.A. 5711 Six Forks Rd. #100 Raleigh, NC 27609

PROJECT ADDRESS:

These drawings are to be coordinated with the architectural, mechanical, plumbing, electrical, and civil drawings. This coordination is not the responsibility of the structural engineering of record (SER). Should any discrepancies become apparent, the contractor shall notify SUMMIT Engineering, Laboratory & Testing, P.C. before construction begins.

#### PLAN ABBREVIATIONS:

AB	ANCHOR BOLT	PT	PRESSURE TREATED
AFF	ABOVE FINISHED FLOOR	RS	ROOF SUPPORT
CJ	CEILING JOIST	SC	STUD COLUMN
CLR	CLEAR	SJ	SINGLE JOIST
DJ	DOUBLE JOIST	SPF	SPRUCE PINE FIR
DSP	DOUBLE STUD POCKET	SST	SIMPSON STRONG-TIE
EE	EACH END	SYP	SOUTHERN YELLOW PINE
ΕW	EACH WAY	ŤJ	TRIPLE JOIST
NTS	NOT TO SCALE	TSP	TRIPLE STUD POCKET
OC	ON CENTER	TYP	TYPICAL
PSF	POUNDS PER SQUARE FOOT	UNO	UNLESS NOTED OTHERWISE
PSI	POUNDS PER SQUARE INCH	WWF	WELDED WIRE FABRIC

Roof truss and floor joist layouts, and their corresponding loading details, were not provided to SUMMIT Engineering, Laboratory & Testing, P.C. (SUMMIT) prior to the initial design. Therefore, truss and joist directions were assumed based on the information provided by MCKEE HOMES. Subsequent plan revisions based on roof truss and floor joist layouts shall be noted in the revision list, indicating the date the layouts were provided. Should any discrepancies become apparent, the contractor shall notify SUMMIT immediately.

#### SHEET LIST: Description Sheet No. CS1 Cover Sheet, Specifications, Revisions S1,Øm Monolithic Slab Foundation S1.0s Stem Wall Foundation SI.Oc Crawl Space Foundation S1.0b Basement Foundation S2.Ø Basement Framing Plan S3.Ø First Floor Framing Plan S4.Ø Second Floor Framing Plan S5.Ø Roof Framing Plan S6.0 Basement Bracing Plan S7.Ø First Floor Bracing Plan 58.Ø Second Floor Bracing Plan

#### DEVIGION LIGT

Revision No.	Date	Project No.	Description
1	1.14.19	2Ø959	2018 NCRC Code Update
2	11.11.19	2Ø959R2	Updated floor beams to floor depth and updated crawl space to 14" depth
3	1.17.20	26363	Updated based on previous arch. files (9.28.16)
4	9.30.20	26363R	Revised to change garage beam to a 4-ply LVL

The wood truss manufacturer/fabricator is responsible for the design of the wood trusses. Submit sealed shop drawings and supporting calculations to the SER for review prior to fabrication. The SER shall have a minimum of five (5) days for review. The review by the SER shall review for overall compliance with the design documents. The SER shall assume no responsibility for the correctness for the structural design for the wood trusses.

The wood trusses shall be designed for all required loadings as specified in the local building code, the ASCE Standard "Minimum Design Loads for Buildings and Other Structures." (ASCE 7-10), and the loading requirements shown on these specifications. The truss drawings shall be coordinated with all other construction documents and provisions provided for loads shown on these drawings including but not limited to HVAC equipment, piping, and architectural fixtures attached to the trusses.

The trusses shall be designed, fabricated, and erected in accordance with the latest edition of the "National Design Specification for Wood Construction." (NDS) and "Design Specification for Metal Plate Connected Wood Trusses."

The truss manufacturer shall provide adequate bracing information in accordance with "Commentary and Recommendations for Handling, Installing, and Bracing Metal Plate Connected Wood Trusses" (HIB-91). This bracing, both temporary and permanent, shall be shown on the shop drawings. Also, the shop drawings shall show the required attachments for

Any chords or truss webs shown on these drawings have been shown as a reference only. The final design of the trusses shall be per the manufacturer.

EXTERIOR WOOD FRAMED DECKS:

Decks are to be framed in accordance with local building codes and as referenced on the structural plans, either through code references or construction details.

## <u>WOOD STRUCTURAL PANELS:</u>

Fabrication and placement of structural wood sheathing shall be in accordance with the APA Design/Construction Guide "Residential and Commercial," and all other applicable APA

All structurally required wood sheathing shall bear the mark of the APA.

Wood wall sheathing shall comply with the requirements of local building codes for the appropriate state as indicated on these drawings. Refer to wall bracing notes in plan set for more information. Sheathing shall be applied with the long direction perpendicular to framing, unless noted otherwise.

Roof sheathing shall be APA rated sheathing exposure 1 or 2. Roof sheathing shall be continuous over two supports and attached to its supporting roof framing with (1)-8d CC nail at 6"o/c at panel edges and at 12"o/c in panel field unless otherwise noted on the plans. Sheathing shall be applied with the long direction perpendicular to framing. Sheathing shall have a span rating consistent with the framing spacing. Use suitable edge support by use of plywood clips or lumber blocking unless otherwise noted. Panel end joints shall occur over framing. Apply building paper over the sheathing as

required by the state Building Code. Wood floor sheathing shall be APA rated sheathing exposure 1 or 2. Attach sheathing to its supporting framing with (1)-8d CC ringshank nail at 6"o/c at panel edges and at 12"o/c in panel field unless otherwise noted on the plans. Sheathing shall be applied perpendicular to framing. Sheathing shall have a span rating consistent with the framing spacing. Use suitable edge support by use of T&G plywood or lumber blocking unless otherwise noted. Panel end joints shall occur over framing. Apply building paper over the sheathing as required by the state Building Code.

Sheathing shall have a 1/8" gap at panel ends and edges as recommended in accordance with the APA.


## TRUCTURAL FIBERBOARD PANELS:


Fabrication and placement of structural fiberboard sheathing shall be in accordance with the applicable AFA standards. All structurally required fiberboard sheathing shall bear the

mark of the AFA. Fiberboard wall sheathing shall comply with the requirements of local building codes for the appropriate state as indicated on these drawings. Refer to wall bracing notes in plan set for more information.

Sheathing shall have a 1/8" gap at panel ends and edges are recommended in accordance with the AFA.

SUMMIT 3070 HAMMOND BUSINESS PLACE, SUITE 171 RALEIGH, NC 27603 OFFICE: 919.380.9991 FAX: 919.380.9993 WWW.SUMMIT-COMPANIES.COM

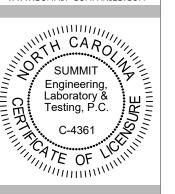

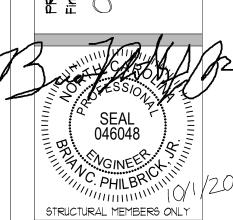

DATE: 9/30/20 PROJECT \*: 26363R

CHECKED BY: BCP ORIGINAL INFORMATION

DRAWN BY: LBY

REFER TO COVER SHEET FOR A COMPLETE LIST OF REVISIONS



## GENERAL STRUCTURAL NOTES:

The design professional whose seal appears on these drawings is the structural engineer of record (SER) for this project. The SER bears the responsibility of the primary structural elements and the performance of this structure. No other party may revise, alter, or delete any structural aspects of these construction documents without written permission of SUMMIT Engineering, Laboratory & Testing, P.C. (SUMMIT) or the SER. For the purposes of these construction documents the SER and SUMMIT shall be considered the same entity.

The structure is only stable in its completed form. The contractor shall provide all required temporary bracing during construction to stabilize the structure.

The SER is not responsible for construction sequences, methods, or techniques in connection with the construction of this structure. The SER will not be held responsible for the contractor's failure to conform to the contract documents, should any non-conformities occur.

Any structural elements or details not fully developed on the construction drawings shall be completed under the direction o a licensed professional engineer. These shop drawings shall be submitted to SUMMIT for review before any construction begins. The shop drawings will be reviewed for overall compliance as it relates to the structural design of this project. Verification of the shop drawings for dimensions, or for actual field conditions, is not the responsibility of the SER or SUMMIT.

Verification of assumed field conditions is not the responsibility of the SER. The contractor shall verify the field conditions for accuracy and report any discrepancies to SUMMIT before construction begins.

The SER is not responsible for any secondary structural elements or non-structural elements, except for the elements specifically noted on the structural drawings

This structure and all construction shall conform to all applicable sections of the international residential code.

This structure and all construction shall conform to all

applicable sections of local building codes. 9. All structural assemblies are to meet or exceed to requirements of the current local building code.

FOUNDATIONS:

The structural engineer has not performed a subsurface investigation. Verification of this assumed value is the responsibility of the owner or the contractor. Should any adverse soil condition be encountered the SER must be contacted before proceeding.

The bottom of all footings shall extend below the frost line for the region in which the structure is to be constructed. However, the bottom of all footings shall be a minimum of 12" below grade.

3. Any fill shall be placed under the direction or recommendation

5. Excavations of footings shall be lined temporarily with a 6 mil polyethylene membrane if placement of concrete does not occur within 24 hours of excavation.

Structural steel shall receive one coat of shop applied All steel shall have a minimum yield stress (F<sub>u</sub>) of 36 ksi unless

otherwise noted.

Concrete shall have a normal weight aggregate and a minimum

otherwise noted on the plan.

Air entrained concrete must be used for all structural elements exposed to freeze/thaw cycles and deicing chemicals. Air entrainment amounts (in percent) shall be within -1% to +2% of

3.1. Footings: 5% 3.2. Exterior Slabs: 5%

Concrete slabs-on-grade shall be constructed in accordance with ACI 302.IR-96: "Guide for Concrete Slab and Slab Construction".

The concrete slab-on-grade has been designed using a subgrade modulus of k=250 pci and a design loading of 200 psf. The SER is not responsible for differential settlement, slab cracking or other future defects resulting from unreported conditions not in accordance with the above assumptions.

Control or saw cut joints shall be spaced in interior slabs-on-grade at a maximum of 15'-0" O.C. and in exterior slabs-on-grade at a maximum of 10'-0" unless otherwise noted. Control or saw cut joints shall be produced using conventional process within 4 to 12 hours after the slab has been finished

9. Reinforcing steel may not extend through a control joint. Reinforcing steel may extend through a saw cut joint. 10. All welded wire fabric (W.W.F.) for concrete slabs-on-grade shall be placed at mid-depth of slab. The W.W.F. shall be securely

## CONCRETE REINFORCEMENT:

supported during the concrete pour.

Fibrous concrete reinforcement, or fibermesh, specified in concrete slabs-on-grade may be used for control of cracking due to shrinkage and thermal expansion/contraction, lowered water migration, an increase in impact capacity, increased abrasion resistance, and residual strength.

Fibermesh reinforcing to be 100% virgin polypropylene fibers containing no reprocessed olefin materials and specifically manufactured for use as concrete secondary reinforcement. Application of fibermesh per cubic yard of concrete shall equal a minimum of 0.1% by volume (1.5 pounds per cubic yard)

Fibermesh shall comply with ASTM CIII6, any local building code requirements, and shall meet or exceed the current industry 5. Steel reinforcing bars shall be new billet steel conforming to

ASTM A615, grade 60. 6. Detailing, fabrication, and placement of reinforcing steel shall be in accordance with the latest edition of ACI 315: "Manual of Standard Practice for Detailing Concrete Structures"

Horizontal footing and wall reinforcement shall be continuous

and shall have 90° bends, or corner bars with the same

size/spacing as the horizontal reinforcement with a class B tension splice. Lap reinforcement as required, a minimum of 40 bar diameters for tension or compression unless otherwise noted. Splices in masonry shall be a minimum of 48 bar diameters.

9. Where reinforcing dowels are required, they shall be equivalent in size and spacing to the vertical reinforcement. The dowel shall extend 48 bar diameters vertically and 20 bar diameters into the footing.

10. Where reinforcing steel is required vertically, dowels shall be provided unless otherwise noted.

Solid sawn wood framing members shall conform to the specifications listed in the latest edition of the "National" Design Specification for Wood Construction" (NDS). Unless otherwise noted, all wood framing members are designed to be Southern-Yellow-Pine (SYP) #2.

LVL or PSL engineered wood shall have the following minimum 2.1. E = 1,900,000 psi

2.2. Fb = 2600 psi2.3. FV = 285 psi2.4.Fc = 700 psi

Wood in contact with concrete, masonry, or earth shall be pressure treated in accordance with AWPA standard C-15. All other moisture exposed wood shall be treated in accordance with AWPA standard C-2

Nails shall be common wire nails unless otherwise noted. 5. Lag screws shall conform to ANSI/ASME standard B18.2.1-1981. Lead holes for lag screws shall be in accordance with NDS

specifications. . All beams shall have full bearing on supporting framing members unless otherwise noted.

Exterior and load bearing stud walls are to be 2x4 SYP #2 @ 16" O.C. unless otherwise noted. Studs shall be continuous from the sole plate to the double top plate. Studs shall only be discontinuous at headers for window/door openings. A minimum of one king stud shall be placed at each end of the header.

King studs shall be continuous. Individual studs forming a column shall be attached with one 10d nail @ 6" O.C. staggered. The stud column shall be continuous to the foundation or beam. The column shall be properly blocked at all floor levels to ensure proper load transfer.

Multi-ply beams shall have each ply attached with (3) 10d nails a

10. Four and five ply beams shall be bolted together with (2) rows of 1/2" diameter through bolts staggered @ 16" O.C. unless noted otherwise.

#### FOUNDATION NOTES:

- 1. FOUNDATIONS TO BE CONSTRUCTED IN ACCORDANCE WITH CHAPTER 4 OF THE 2018 NORTH CAROLINA RESIDENTIAL BUILDING CODE WITH ALL LOCAL AMENDMENTS.
- 2. STRUCTURAL CONCRETE TO BE F = 3000 PSI, PREPARED AND PLACED IN ACCORDANCE WITH ACI STANDARD 318.
- FOOTINGS TO BE PLACED ON UNDISTURBED EARTH, BEARING A MINIMUM OF 12" BELOW ADJACENT FINISHED GRADE, OR AS OTHERWISE DIRECTED BY THE CODE ENFORCEMENT OFFICIAL.
- 4. FOOTING SIZES BASED ON A PRESUMPTIVE SOIL BEARING CAPACITY OF 2000 PSF. CONTRACTOR IS SOLELY RESPONSIBLE FOR VERIFYING THE SUITABILITY OF THE SITE SOIL CONDITIONS AT THE TIME OF CONSTRUCTION.
- 5. FOOTINGS AND PIERS SHALL BE CENTERED UNDER THEIR RESPECTIVE ELEMENTS. PROVIDE 2" MINIMUM FOOTING PROJECTION FROM THE FACE OF MASONRY.
- 6. MAXIMUM DEPTH OF UNBALANCED FILL AGAINST MASONRY WALLS TO BE AS SPECIFIED IN SECTION R404.1 OF THE 2018 NORTH CAROLINA RESIDENTIAL BUILDING CODE.
- PILASTERS TO BE BONDED TO PERIMETER FOUNDATION WALL.
- PROVIDE FOUNDATION WATERPROOFING, AND DRAIN WITH POSITIVE SLOPE TO OUTLET AS REQUIRED BY SITE CONDITIONS.
- 9. PROVIDED PERIMETER INSULATION FOR ALL FOUNDATIONS PER 2018 NORTH CAROLINA RESIDENTIAL BUILDING CODE.
- 10. CORBEL FOUNDATION WALL AS REQUIRED TO ACCOMMODATE BRICK
- CRAWL SPACE TO BE GRADED LEVEL, AND CLEARED OF ALL DEBRIS.
- FOUNDATION ANCHORAGE SHALL BE CONSTRUCTED PER THE 2018 NORTH CAROLINA RESIDENTIAL CODE SECTION R403.1.6. MINIMUM 1/2" DIA. BOLTS SPACED AT 6'-0" ON CENTER WITH A 1" MINIMUM EMBEDMENT INTO MASONRY OR CONCRETE. MINIMUM (2) ANCHOR BOLTS PER PLATE SECTION AND (1) LOCATED NOT MORE THAN 12" FROM THE CORNER, ANCHOR BOLTS SHALL BE LOCATED IN THE CENTER THIRD OF THE PLATE.
- 13. ABBREVIATIONS:

DJ = DOUBLE JOIST SJ = SINGLE JOIST FT = FLOOR TRUSS GT = GIRDER TRUSS SC = STUD COLUMN DR = DOUBLE RAFTER EE = EACH END TR = TRIPLE RAFTER TJ = TRIPLE JOIST OC = ON CENTER CL = CENTER LINE PL = POINT LOAD

- 14. ALL PIERS TO BE 16"x16" MASONRY AND ALL PILASTERS TO BE 8"x16" MASONRY, TYPICAL. (UNO)
- 15. WALL FOOTINGS TO BE CONTINUOUS CONCRETE, SIZES PER STRUCTURAL PLAN. 16. A FOUNDATION EXCAYATION OBSERVATION SHOULD BE CONDUCTED BY A PROFESSIONAL GEOTECHNICAL ENGINEER, OR HIS QUALIFIED REPRESENTATIVE. IF ISOLATED AREAS OF YIELDING MATERIALS AND/OR POTENTIALLY EXPANSIVE SOILS ARE OBSERVED IN THE FOOTING
- REVIEW THE FOOTING DESIGN PRIOR TO CONCRETE PLACEMENT. 17. ALL FOOTINGS & SLABS ARE TO BEAR ON UNDISTURBED SOIL OR 95% COMPACTED FILL, VERIFIED BY ENGINEER OR CODE OFFICIAL.

EXCAVATIONS AT THE TIME OF CONSTRUCTION, SUMMIT ENGINEERING,

LABORATORY & TESTING, P.C. MUST BE PROVIDED THE OPPORTUNITY TO

REFER TO BRACED WALL PLAN FOR PANEL LOCATIONS AND ANY REQUIRED HOLD-DOWNS. ADDITIONAL INFORMATION PER SECTION R602.10.4 AND FIGURE R602.10.3(4) OF THE 2018 NCRC.

NOTE: ALL EXTERIOR FOUNDATION DIMENSIONS ARE TO FRAMING AND NOT BRICK VENEER, UNO

NOTE: A 4" CRUSHED STONE BASE COURSE IS NOT REQUIRED WHEN SLAB IS INSTALLED ON WELL-DRAINED OR SAND-GRAVEL MIXTURE SOILS CLASSIFIED AS GROUP | PER TABLE R405.1

REINFORCE GARAGE PORTAL WALLS PER FIGURE R602.10.4.3 OF THE 2018 NCRC. (TYP)

BEAM POCKETS MAY BE SUBSTITUTED FOR MASONRY PILASTERS AT GIRDER ENDS. BEAM POCKETS SHALL HAVE A MINIMUM 4" SOLID MASONRY BEARING.

NOTE: REDUCE JOIST SPACING UNDER TILE FLOORS. GRANITE COUNTERTOPS AND/OR ISLANDS.

DECK JOISTS SHALL BE SPACED AT A MAX. 12" O.C. WHEN DECK BOARDS ARE INSTALLED DIAGONALLY.

THESE PLANS ARE DESIGNED IN ACCORDANCE WITH ARCHITECTURAL PLANS PROVIDED BY MCKEE HOMES COMPLETED/REVISED ON 9/28/16. IT IS THE RESPONSIBILITY OF THE CLIENT TO NOTIFY SUMMIT ENGINEERING, LABORATORY & TESTING, P.C. IF ANY CHANGES ARE MADE TO THE ARCHITECTURAL PLANS PRIOR TO CONSTRUCTION. SUMMIT ENGINEERING, LABORATORY & TESTING, P.C. CANNOT GUARANTEE THE ADEQUACY OF THESE STRUCTURAL PLANS WHEN USED WITH ARCHITECTURAL PLANS DATED DIFFERENTLY THAN THE DATE LISTED ABOVE.

## STRUCTURAL MEMBERS ONLY


ENGINEERING SEAL APPLIES ONLY TO STRUCTURAL COMPONENTS ON THIS DOCUMENT, SEAL DOES NOT INCLUDE CONSTRUCTION MEANS, METHODS, TECHNIQUES, SEQUENCES, PROCEDURES OR SAFETY PRECAUTIONS. ANY DEVIATIONS OR DISCREPANCIES ON PLANS ARE TO BE BROUGHT TO THE IMMEDIATE ATTENTION OF SUMMIT ENGINEERING, LABORATORY & TESTING, P.C. FAILURE TO DO SO WILL VOID SUMMIT LIABILITY.

STRUCTURAL. ANALYSIS BASED ON 2018 NCRC.


CRAWL SPACE FOUNDATION PLAN

SCALE: 1/4"=1'-0" ON 22"x34" OR 1/8"=1'-0" ON 11"x17"

18"x24" MIN. CRAWL SPACE ACCESS DOOR TO BE LOCATED IN FIELD PER BUILDER. PROVIDE MIN. (2) 2×10 HEADER OVER DOOR W/MIN. 4" BEARING EACH END. AVOID SHOWN POINT LOADS.

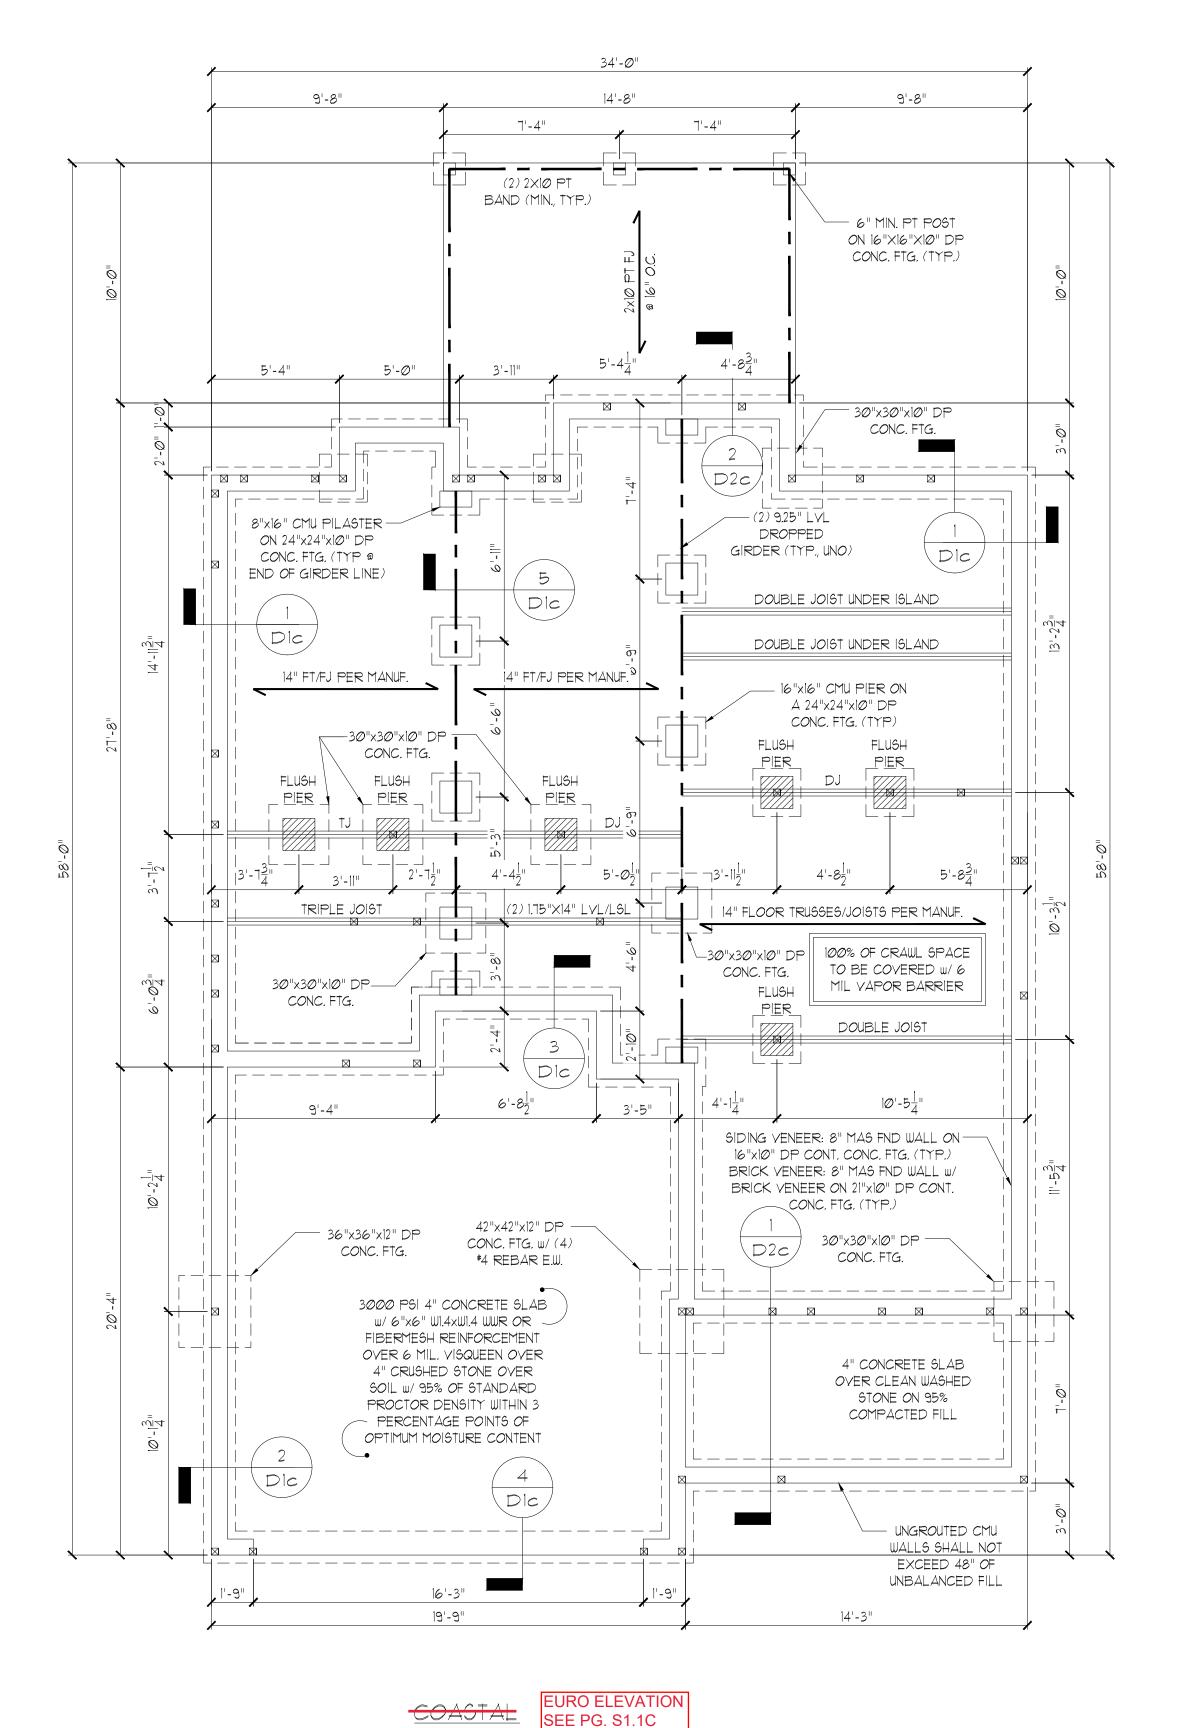

SUMMIT 3070 HAMMOND BUSINESS PLACE, SUITE 171 RALEIGH, NC 27603 OFFICE: 919.380.9991 FAX: 919.380.9993

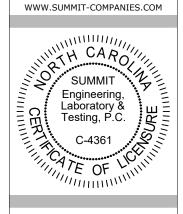


STRUCTURAL MEMBERS ONLY

DATE: 9/30/20 9CALE: 22x34 1/4"=1'-0" ||x|T ||/8"=1'-0" PROJECT \*: 26363R DRAWN BY: LBY

CHECKED BY: BCP

ORIGINAL INFORMATION

REFER TO COVER SHEET FOR A COMPLETE LIST OF REVISIONS

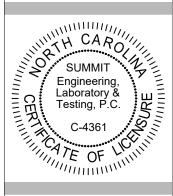

CLIENT: McKee Homes 109 Hay St., Suite 301 Fayetteville, NC 28301

PROJECT:
Finley | LH

SEAL 046048

SEAL 046048


STRUCTURAL MEMBERS ONLY

STRUCTURAL MEMBERS (

ORIGINAL INFORMATION
PROJECT \* DATE
19420 Ø9/28/2018

REFER TO COVER SHEET FOR A COMPLETE LIST OF REVISIONS

G11a

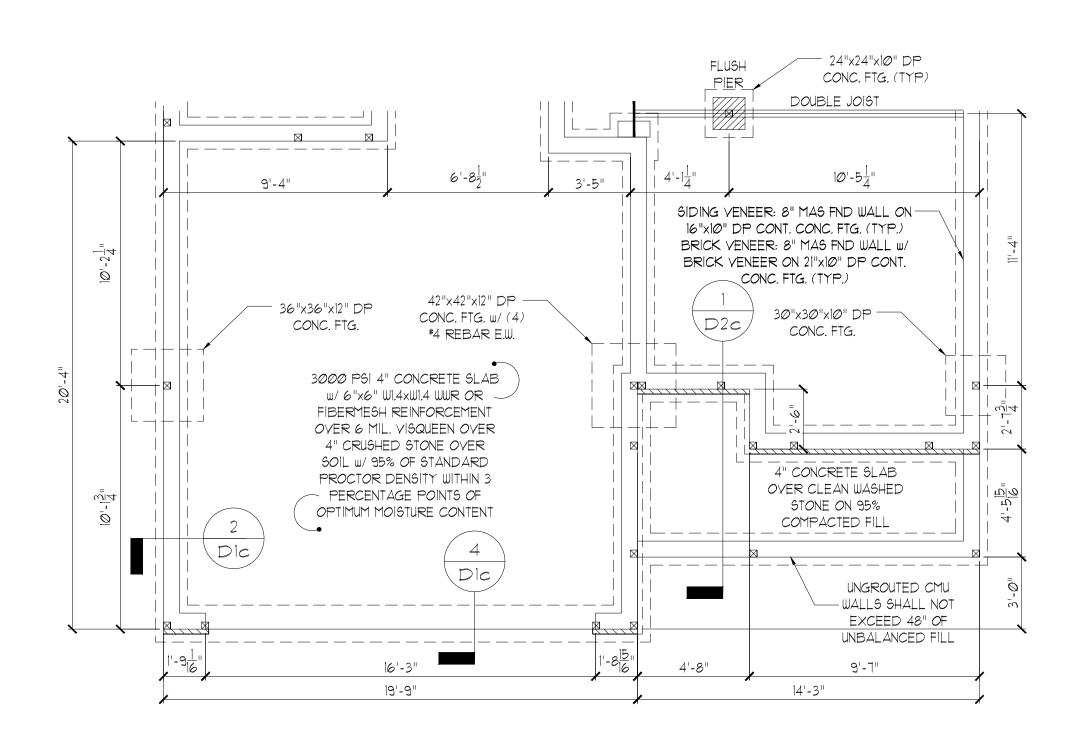

EURO

## STRUCTURAL MEMBERS ONLY

ENGINEERING SEAL APPLIES ONLY TO STRUCTURAL COMPONENTS ON THIS DOCUMENT, SEAL DOES NOT INCLUDE CONSTRUCTION MEANS, METHODS, TECHNIQUES, SEQUENCES, PROCEDURES OR SAFETY PRECAUTIONS. ANY DEVIATIONS OR DISCREPANCIES ON PLANS ARE TO BE BROUGHT TO THE IMMEDIATE ATTENTION OF SUMMIT ENGINEERING, LABORATORY & TESTING, P.C. FAILURE TO DO SO WILL VOID SUMMIT LIABILITY.

STRUCTURAL ANALYSIS BASED ON 2018 NCRC.

CRAWL SPACE FOUNDATION PLAN

SCALE: 1/4"=1'-0" ON 22"x34" OR 1/8"=1'-0" ON 11"x17"

#### GENERAL STRUCTURAL NOTES:

- CONSTRUCTION SHALL CONFORM TO 2018 NORTH CAROLINA RESIDENTIAL BUILDING CODE WITH ALL LOCAL AMENDMENTS.
- 2. CONTRACTOR SHALL VERIFY ALL DIMENSIONS, CONTRACTOR SHALL COMPLY WITH THE CONTENTS OF THE DRAWING FOR THIS SPECIFIC PROJECT. ENGINEER IS NOT RESPONSIBLE FOR ANY DEVIATIONS FROM THIS PLAN.
- 3. CONTRACTOR IS RESPONSIBLE FOR PROVIDING TEMPORARY BRACING REQUIRED TO RESIST ALL FORCES ENCOUNTERED DURING ERECTION.
- 4. PROPERTIES USED IN THE DESIGN ARE AS FOLLOWS: MICROLLAM (LVL):  $F_b = 2600$  PSI,  $F_V = 285$  PSI,  $E = 1.9 \times 10^6$  PSI PARALLAM (PSL):  $F_b = 2900$  PSI,  $F_V = 290$  PSI,  $E = 1.25 \times 10^6$  PSI
- 5. ALL WOOD MEMBERS SHALL BE #2 SYP UNLESS NOTED ON PLAN. ALL STUD COLUMNS SHALL BE #2 SYP (UNO).
- 6. ALL BEAMS SHALL BE SUPPORTED WITH A (2) 2x4 #2 SYP STUD COLUMN AT EACH END UNLESS NOTED OTHERWISE.
- 1. ALL REINFORCING STEEL SHALL BE GRADE 60 BARS CONFORMING TO ASTM A615 AND SHALL HAVE A MINIMUM COVER OF 3".
- 8. FOUNDATION ANCHORAGE SHALL BE CONSTRUCTED PER THE 2018
  NORTH CAROLINA RESIDENTIAL CODE SECTION R403.1.6. MINIMUM 1/2"
  DIA. BOLTS SPACED AT 6'-0" ON CENTER WITH A 1" MINIMUM
  EMBEDMENT INTO MASONRY OR CONCRETE. MINIMUM (2) ANCHOR BOLTS
  PER PLATE SECTION AND (1) LOCATED NOT MORE THAN 12" FROM THE
  CORNER. ANCHOR BOLTS SHALL BE LOCATED IN THE CENTER THIRD OF
  THE PLATE.
- 9. CONTRACTOR TO PROVIDED LOOKOUTS WHEN CEILING JOISTS SPAN PERPENDICULAR TO RAFTERS.
- 10. FLITCH BEAMS, 4-PLY LVLS AND 3-PLY SIDE LOADED LVLS SHALL BE BOLTED TOGETHER WITH 1/2" DIA. THRU BOLTS SPACED AT 24" O.C. (MAX) STAGGERED OR EQUIVALENT CONNECTIONS PER DETAIL 1/D3f. MIN. EDGE DISTANCE SHALL BE 2" AND (2) BOLTS SHALL BE LOCATED MINIMUM 6" FROM EACH END OF THE BEAM.
- II. ALL NON-LOAD BEARING HEADERS SHALL BE (1) FLAT 2x4 SYP #2,
  DROPPED. FOR NON-LOAD BEARING HEADERS EXCEEDING 8'-Ø" IN
  WIDTH AND/OR WITH MORE THAN 2'-Ø" OF CRIPPLE WALL ABOVE, SHALL
  BE (2) FLAT 2x4 SYB #2 DROPPED (UNI EGG NOTED OTHERWISE)
- BE (2) FLAT 2x4 SYP #2, DROPPED. (UNLESS NOTED OTHERWISE)
  12. ABBREVIATIONS:

DJ = DOUBLE JOIST
GT = GIRDER TRUSS
SC = STUD COLUMN
EE = EACH END
TJ = TRIPLE JOIST
CL = CENTER LINE

SJ = SINGLE JOIST
FT = FLOOR TRUSS
DR = DOUBLE RAFTER
TRIPLE RAFTER
OC = ON CENTER
PL = POINT LOAD

#### SHADED WALLS INDICATED LOAD BEARING WALLS

NOTE: REDUCE JOIST SPACING UNDER TILE FLOORS, GRANITE COUNTERTOPS AND/OR ISLANDS.

JOIST & BEAM SIZES SHOWN ARE MINIMUMS. BUILDER MAY INCREASE DEPTH FOR EASE OF CONSTRUCTION.

NOTE:

== DESIGNATES JOIST SUPPORTED LOAD BEARING WALL ABOVE. PROVIDE BLOCKING UNDER JOIST SUPPORTED LOAD BEARING WALL.

THESE PLANS ARE DESIGNED IN ACCORDANCE WITH ARCHITECTURAL PLANS PROVIDED BY MCKEE HOMES COMPLETED/REVISED ON 9/28/16. IT IS THE RESPONSIBILITY OF THE CLIENT TO NOTIFY SUMMIT ENGINEERING, LABORATORY & TESTING, P.C. IF ANY CHANGES ARE MADE TO THE ARCHITECTURAL PLANS PRIOR TO CONSTRUCTION. SUMMIT ENGINEERING, LABORATORY & TESTING, P.C. CANNOT GUARANTEE THE ADEQUACY OF THESE STRUCTURAL PLANS WHEN USED WITH ARCHITECTURAL PLANS DATED DIFFERENTLY THAN THE DATE LISTED ABOVE.


## STRUCTURAL MEMBERS ONLY

ENGINEERING SEAL APPLIES ONLY TO STRUCTURAL COMPONENTS ON THIS DOCUMENT, SEAL DOES NOT INCLUDE CONSTRUCTION MEANS, METHODS, TECHNIQUES, SEQUENCES, PROCEDURES OR SAFETY PRECAUTIONS. ANY DEVIATIONS OR DISCREPANCIES ON PLANS ARE TO BE BROUGHT TO THE IMMEDIATE ATTENTION OF SUMMIT ENGINEERING, LABORATORY & TESTING, P.C. FAILURE TO DO SO WILL VOID SUMMIT LIABILITY.

STRUCTURAL ANALYSIS BASED ON 2018 NCRC.

FIRST FLOOR FRAMING PLAN

SCALE: 1/4"=1'-0" ON 22"x34" OR 1/8"=1'-0" ON 11"x17"

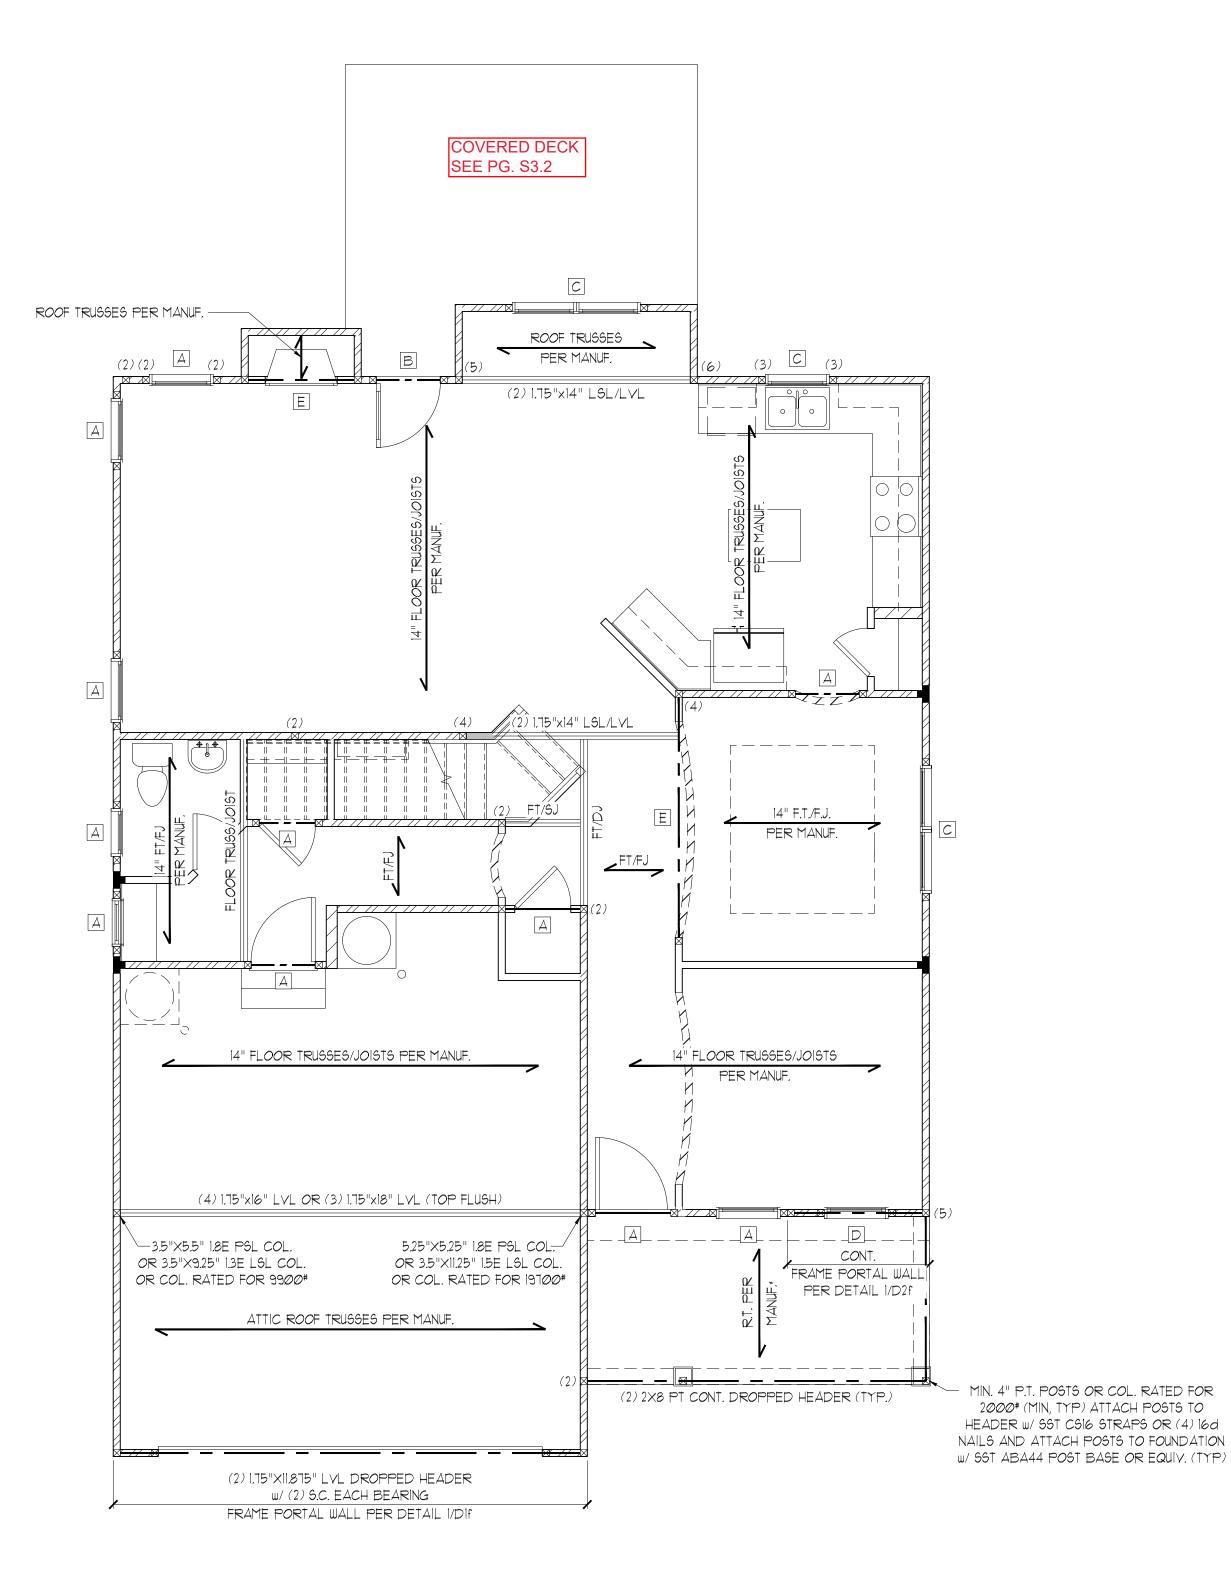

EURO ELEVATION

SEE PG. 3.0

\*ROOF COMPLETES FLOOR SYSTEM

HEADER SCHEDULE						
TAG	SIZE	JACKS (EACH END)				
А	(2) 2x6	(1)				
В	(2) 2x8	(2)				
С	(2) 2xlØ	(2)				
D	(2) 2×12	(2)				
E	(2) 9-1/4" LSL/LVL	(3)				
F	(3) 2x6	(1)				
G	(3) 2x8	(2)				
Н	(3) 2xlØ	(2)				
	(3) 2x12	(3)				

NOTES:

1. HEADER SIZES SHOWN ON PLANS ARE MINIMUMS. GREATER HEADER SIZES MAY BE USED FOR EASE OF CONSTRUCTION.

2. ALL HEADERS TO BE DROPPED (UN.O.).

3. STUD COLUMNS NOTED ON PLAN OVERRIDE STUD COLUMNS LISTED ABOVE (U.N.O.).

4. OPENINGS LESS THAN 3'-0" USE (1) KING STUD AT E.E. OPENINGS 3'-1" TO 4'-0" USE (2) KING STUDS AT E.E. OPENINGS 4'-1" TO 8'-0" USE (3) KING STUDS AT E.E. OPENINGS 8'-1" TO 12'-0" USE (6) KING STUDS AT E.E. OPENINGS 12'-1" TO 16'-0" USE (6) KING STUDS AT E.E.

ALL HEADERS WHERE BRICK IS USED, TO BE:

1 LINTEL (U.N.O.)

LINTEL SCHEDULE:

STEEL ANGLES TO HAVE MINIMUM 4" BEARING ONTO BRICK AT EACH END.

1 L3x3x1/4"

2 L5x3"x1/4"

2 L5x3"xI/4" 3 L5x3-1/2x5/16"

4 L5x3-1/2"x5/16" ROLLED OR EQUAL ARCHED COMPONENT.

SECURE LINTEL TO HEADER w/ (2) 1/2" DIAMETER LAG SCREWS STAGGERED @ 16" O.C. (TYP FOR (3))

	WALL STUD SCHEDULE (10 FT HEIGHT)						
STUD SIZE STUD SPACING (C							
		ROOF ONLY	ROOF & 1 FLOOR	ROOF & 2 FLOORS	NON-LOAD BEARING		
	2×4	24"	16"	12"	24"		
	2x6	24"	24"	16"	24"		
	NIOTEC						

NOTES:

1. BRACED WALLS STUDS SHALL BE A MAX. OF 16" O.C.

2. STUDS SUPPORTS OPTIONAL WALK-UP ATTIC SHALL BE

SPACED A MAX. OF 16" O.C.

3. TWO STORY WALLS SHALL BE FRAMED w/ 2x4 STUDS @ 12"

O.C. OR 2x6 STUDS @ 16" O.C. BALLOON FRAMED w/ CROSS

BRACING @ 6'-0" O.C. VERTICALLY.

SEAL 046048

SEAL 046048

STRUCTURAL MEMBERS ONLY

DRAWING

DATE: 9/30/20

SCALE: 22x34 |/4"=1'-0"
||x|1 |/8"=1'-0"

IkiT I/8"=1"-0
PROJECT \* 26363R
DRAILN BY: LBY
CHECKED BY: BCP

ORIGINAL INFORMATION
PROJECT DATE
19420 09/28/2018

REFER TO COVER SHEET FOR A COMPLETE LIST OF REVISIONS

S3.0


SUMMIT

ENGINEERING LABORATORY TESTING

3070 HAMMOND BUSINESS
PLACE, SUITE 171
RALEIGH, NC 27603
OFFICE: 919.380.9991
FAX: 919.380.9993
WWW.SUMMIT-COMPANIES.COM

Laboratory & Testing, P.C.

CLIENT: McKee Homes 109 Hay St., Suite 301

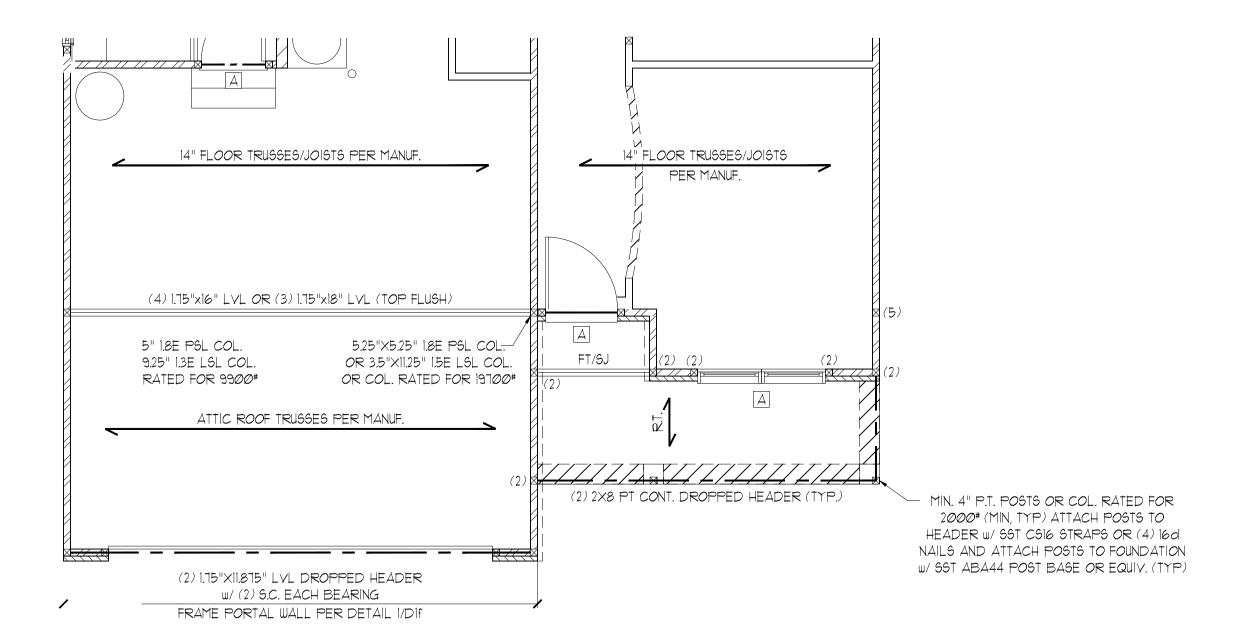

EURO

# STRUCTURAL MEMBERS ONLY


ENGINEERING SEAL APPLIES ONLY TO STRUCTURAL COMPONENTS ON THIS DOCUMENT, SEAL DOES NOT INCLUDE CONSTRUCTION MEANS, METHODS, TECHNIQUES, SEQUENCES, PROCEDURES OR SAFETY PRECAUTIONS. ANY DEVIATIONS OR DISCREPANCIES ON PLANS ARE TO BE BROUGHT TO THE IMMEDIATE ATTENTION OF SUMMIT ENGINEERING, LABORATORY & TESTING, P.C. FAILURE TO DO SO WILL VOID SUMMIT LIABILITY.


STRUCTURAL ANALYSIS BASED ON 2018 NCRC.

FIRST FLOOR FRAMING PLAN

SCALE: 1/4"=1'-0" ON 22"x34" OR 1/8"=1'-0" ON 11"x17"




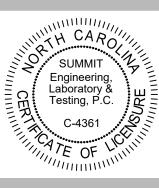

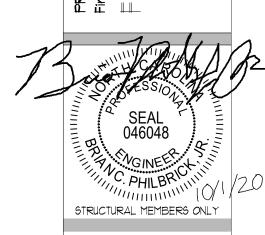

DATE: 9/30/20 9CALE: 22x34 1/4"=1'-0" 1|x17 1/8"=1'-0" PROJECT \*: 26363R DRAWN BY: LBY CHECKED BY: BCP

REFER TO COVER SHEET FOR A COMPLETE LIST OF REVISIONS

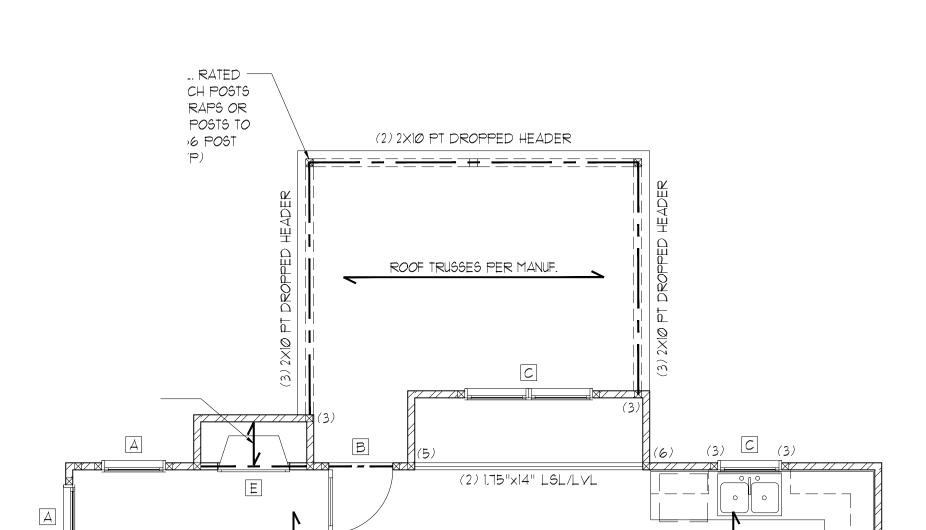

OPT. COVERED PORCH

STRUCTURAL MEMBERS ONLY

ENGINEERING SEAL APPLIES ONLY TO STRUCTURAL COMPONENTS ON THIS DOCUMENT, SEAL DOES NOT INCLUDE CONSTRUCTION MEANS, METHODS, TECHNIQUES, SEQUENCES, PROCEDURES OR SAFETY PRECAUTIONS. ANY DEVIATIONS OR DISCREPANCIES ON PLANS ARE TO BE BROUGHT TO THE IMMEDIATE ATTENTION OF SUMMIT ENGINEERING, LABORATORY & TESTING, P.C. FAILURE TO DO SO WILL VOID SUMMIT LIABILITY.

STRUCTURAL ANALYSIS BASED ON 2018 NCRC.

FIRST FLOOR FRAMING PLAN

SCALE: 1/4"=1'-0" ON 22"x34" OR 1/8"=1'-0" ON 11"x17"

SUMMIT
ENGINEERING LABORATORY TESTING

3070 HAMMOND BUSINESS
PLACE, SUITE 171
RALEIGH, NC 27603
OFFICE: 919.380.9991
FAX: 919.380.9993
WWW.SUMMIT-COMPANIES.COM



CLIENT: McKee Homes 109 Hay St., Suite 301

Finley I LH
First Floor Framing Plan

SEAL 046048

STRUCTURAL MEMBERS ONLY

DRAWING

DATE: 9/30/20

ORIGINAL INFORMATION
PROJECT DATE
19420 09/28/2018

REFER TO COVER SHEET FOR A COMPLETE LIST OF REVISIONS

53.2

HE	HEADER SCHEDULE					
TAG	SIZE	JACKS (EACH END)				
А	(2) 2×6	(1)				
В	(2) 2×8	(2)				
С	(2) 2xlØ	(2)				
D	(2) 2×12	(2)				
E	(2) 9-1/4" LSL/LVL	(3)				
F	(3) 2x6	(1)				
G	(3) 2x8	(2)				
Н	(3) 2x1Ø	(2)				
	(3) 2x12	(3)				

NOTES:

1. HEADER SIZES SHOWN ON PLANS ARE MINIMUMS. GREATER HEADER SIZES MAY BE USED FOR EASE OF CONSTRUCTION.
2. ALL HEADERS TO BE DROPPED (U.N.O.).

3. STUD COLUMNS NOTED ON PLAN OVERRIDE STUD COLUMNS LISTED ABOVE (U.N.O.).

4. OPENINGS LESS THAN 3'-0" USE (1) KING STUD AT E.E. OPENINGS 3'-1" TO 4'-0" USE (2) KING STUDS AT E.E. OPENINGS 4'-1" TO 8'-0" USE (3) KING STUDS AT E.E. OPENINGS 8'-1" TO 12'-0" USE (5) KING STUDS AT E.E. OPENINGS 12'-1" TO 16'-0" USE (6) KING STUDS AT E.E.

ALL HEADERS WHERE BRICK IS USED, TO BE:

LINTEL (U.N.O.)

LINTEL SCHEDULE:

STEEL ANGLES TO HAVE MINIMUM 4" BEARING ONTO BRICK AT EACH END.

1 L3x3x1/4"

2 L5x3"x1/4"

3 L5x3-1/2x5/16"

4) L5x3-1/2"x5/16" ROLLED OR EQUAL ARCHED COMPONENT.

SECURE LINTEL TO HEADER W/(2)1/2" DIAMETER LAG SCREWS STAGGERED @ 16" O.C. (TYP FOR (3))

WALL	WALL STUD SCHEDULE (10 FT HEIGHT)					
STUD SIZE		STUD SPACING (O.C.)				
	ROOF ONLY	ROOF & 1 FLOOR	ROOF & 2 FLOORS	NON-LOAD BEARING		
2×4	24"	16"	12"	24"		
2x6	24"	24"	16"	24"		

1. BRACED WALLS STUDS SHALL BE A MAX. OF 16" O.C.
2. STUDS SUPPORTS OPTIONAL WALK-UP ATTIC SHALL BE SPACED A MAX. OF 16" O.C.

3. TWO STORY WALLS SHALL BE FRAMED w/ 2x4 STUDS @ 12"
O.C. OR 2x6 STUDS @ 16" O.C. BALLOON FRAMED w/ CROSS
BRACING @ 6'-0" O.C. VERTICALLY.

SHADED WALLS INDICATED LOAD BEARING WALLS

JOIST & BEAM SIZES SHOWN ARE MINIMUMS. BUILDER MAY INCREASE DEPTH FOR EASE OF CONSTRUCTION.

THESE PLANS ARE DESIGNED IN ACCORDANCE WITH ARCHITECTURAL PLANS PROVIDED BY MCKEE HOMES COMPLETED/REVISED ON 9/28/16. IT IS THE RESPONSIBILITY OF THE CLIENT TO NOTIFY SUMMIT ENGINEERING, LABORATORY & TESTING, P.C. IF ANY CHANGES ARE MADE TO THE ARCHITECTURAL PLANS PRIOR TO CONSTRUCTION. SUMMIT ENGINEERING, LABORATORY & TESTING, P.C. CANNOT GUARANTEE THE ADEQUACY OF THESE STRUCTURAL PLANS WHEN USED WITH ARCHITECTURAL PLANS DATED DIFFERENTLY THAN THE DATE LISTED ABOVE.


## STRUCTURAL MEMBERS ONLY

ENGINEERING SEAL APPLIES ONLY TO STRUCTURAL COMPONENTS ON THIS DOCUMENT, SEAL DOES NOT INCLUDE CONSTRUCTION MEANS, METHODS, TECHNIQUES, SEQUENCES, PROCEDURES OR SAFETY PRECAUTIONS. ANY DEVIATIONS OR DISCREPANCIES ON PLANS ARE TO BE BROUGHT TO THE IMMEDIATE ATTENTION OF SUMMIT ENGINEERING, LABORATORY & TESTING, P.C. FAILURE TO DO SO WILL VOID SUMMIT LIABILITY.

STRUCTURAL ANALYSIS BASED ON 2018 NCRC.

SECOND FLOOR FRAMING PLAN

SCALE: 1/4"=1'-0" ON 22"x34" OR 1/8"=1'-0" ON 11"x1"

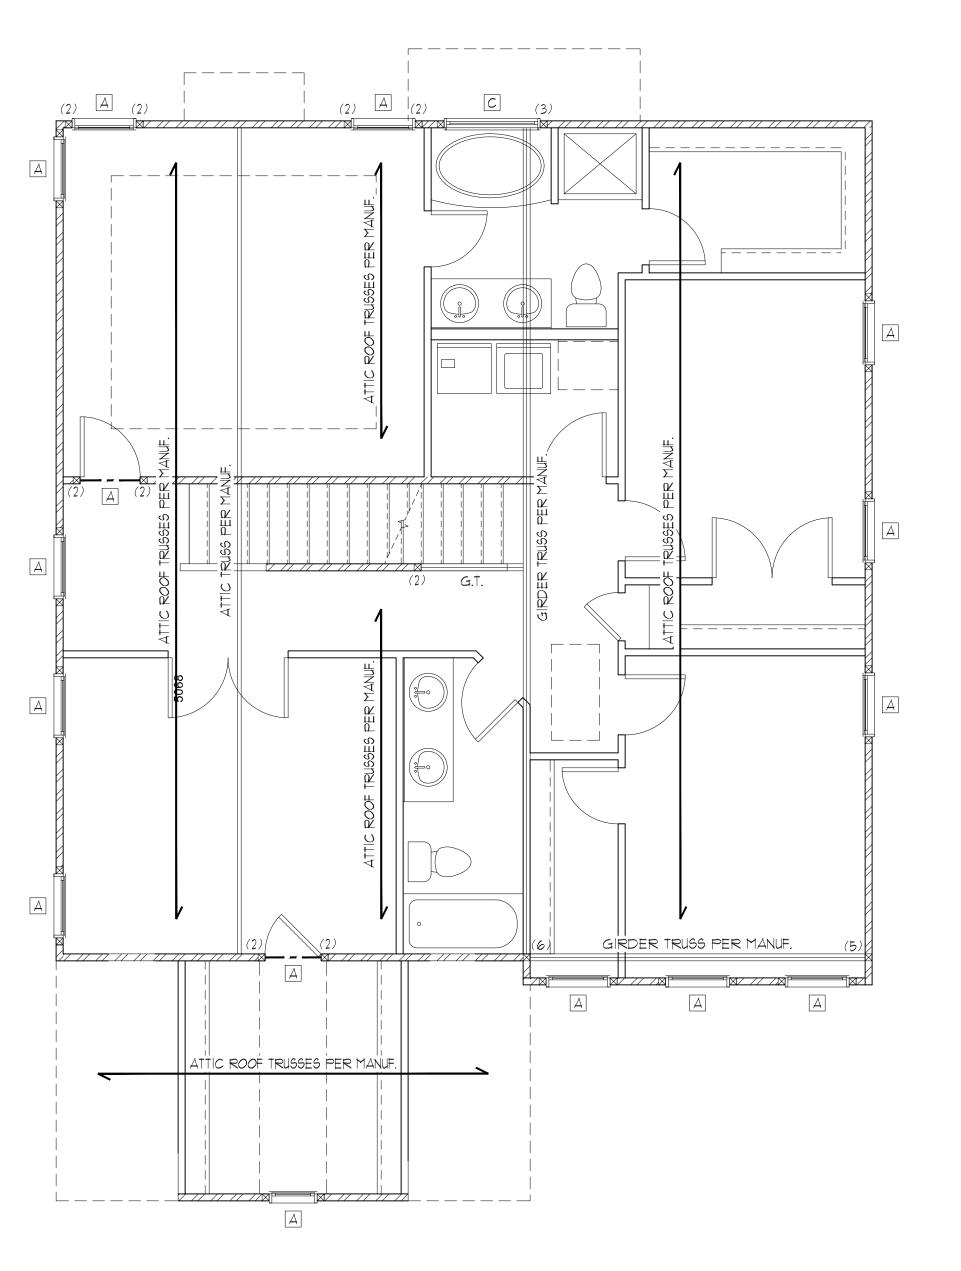

COASTAL







McKee Homes
109 Hay St., Suite 301
Equation (10 283)

Finley I LH

Second Floor Framing Plan

SEAL 046048

SEAL 046048

STRUCTURAL MEMBERS ONLY

DRAWING DATE: 9/30/20

DATE: 9/30/20

9CALE: 22x34 |/4"=1'-0"
||x|1 |/6"=1'-0"

PROJECT 4: 26363R


DRAIIN BY: LBV

CHECKED BY: BCP

ORIGINAL INFORMATION
PROJECT \* DATE
19420 0913000

REFER TO COVER SHEET FOR A
COMPLETE LIST OF REVISIONS

S40

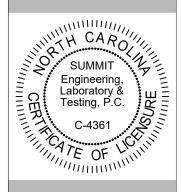


STRUCTURAL MEMBERS ONLY

DATE: 9/30/20 9CALE: 22x34 1/4"=1'-0" 1|x17 1/8"=1'-0" PROJECT \*: 26363R DRAWN BY: LBY

CHECKED BY: BCP

REFER TO COVER SHEET FOR A COMPLETE LIST OF REVISIONS

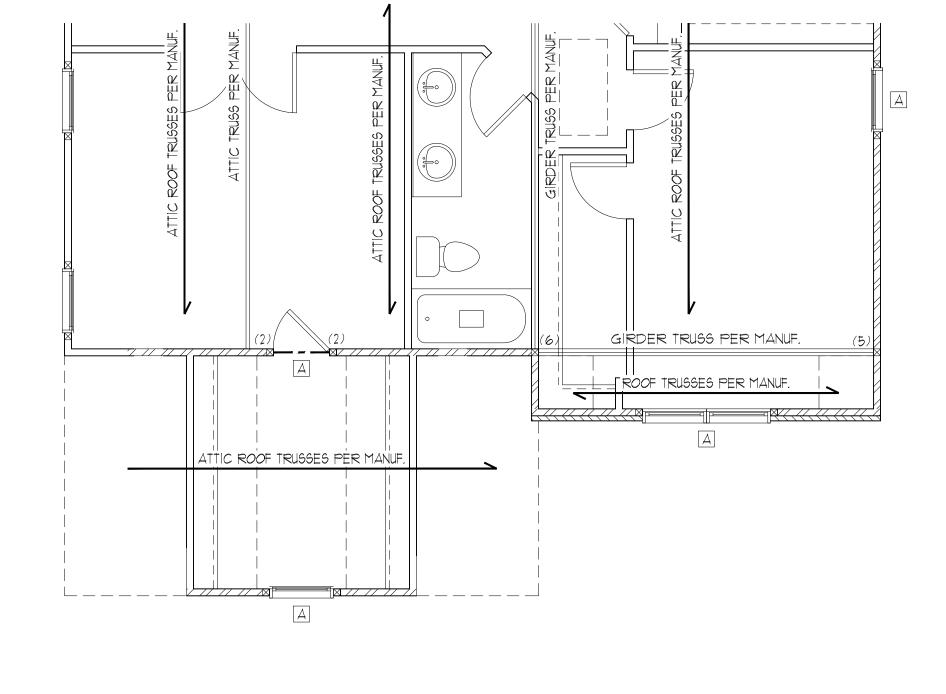

EURO

## STRUCTURAL MEMBERS ONLY

ENGINEERING SEAL APPLIES ONLY TO STRUCTURAL COMPONENTS ON THIS DOCUMENT, SEAL DOES NOT INCLUDE CONSTRUCTION MEANS, METHODS, TECHNIQUES, SEQUENCES, PROCEDURES OR SAFETY PRECAUTIONS. ANY DEVIATIONS OR DISCREPANCIES ON PLANS ARE TO BE BROUGHT TO THE IMMEDIATE ATTENTION OF SUMMIT ENGINEERING, LABORATORY & TESTING, P.C. FAILURE TO DO SO WILL VOID SUMMIT LIABILITY.

STRUCTURAL ANALYSIS BASED ON 2018 NCRC.

SECOND FLOOR FRAMING PLAN

SCALE: 1/4"=1'-0" ON 22"x34" OR 1/8"=1'-0" ON 11"x17"

HEADER SCHEDULE					
TAG	SIZE	JACKS (EACH END)			
Д	(2) 2×6	(1)			
В	(2) 2×8	(2)			
С	(2) 2x1Ø	(2)			
D	(2) 2×12	(2)			
E	(2) 9-1/4" LSL/LVL	(3)			
F	(3) 2x6	(1)			
G	(3) 2x8	(2)			
Н	(3) 2xlØ	(2)			
	(3) 2x12	(3)			

1. HEADER SIZES SHOWN ON PLANS ARE MINIMUMS. GREATER HEADER SIZES MAY BE USED FOR EASE OF CONSTRUCTION. 2. ALL HEADERS TO BE DROPPED (U.N.O.). 3. STUD COLUMNS NOTED ON PLAN OVERRIDE STUD COLUMNS LISTED ABOVE (U.N.O.). 4. OPENINGS LESS THAN 3'-O" USE (1) KING STUD AT E.E. OPENINGS 3'-1" TO 4'-0" USE (2) KING STUDS AT E.E. OPENINGS 4'-1" TO 8'-0" USE (3) KING STUDS AT E.E. OPENINGS 8'-1" TO 12'-0" USE (5) KING STUDS AT E.E.

ALL HEADERS WHERE BRICK IS USED, TO BE:

OPENINGS 12'-1" TO 16'-0" USE (6) KING STUDS AT E.E.

LINTEL (U.N.O.)

LINTEL SCHEDULE:

STEEL ANGLES TO HAVE MINIMUM 4" BEARING ONTO BRICK AT EACH END.

1 L3x3x1/4"

2 L5x3"x1/4"

3 L5x3-1/2x5/16"

4 L5x3-1/2"x5/16" ROLLED OR EQUAL ARCHED COMPONENT.

SECURE LINTEL TO HEADER w/(2)1/2" DIAMETER LAG SCREWS STAGGERED @ 16" O.C. (TYP FOR (3))

STUD SIZE		STUD SPACING (O.C.)				
	ROOF ONLY	ROOF & 1 FLOOR	ROOF & 2 FLOORS	NON-LOA BEARING		
2×4	24"	16"	12"	24"		
2x6	24"	24"	16"	24"		

1. BRACED WALLS STUDS SHALL BE A MAX. OF 16" O.C.
2. STUDS SUPPORTS OPTIONAL WALK-UP ATTIC SHALL BE SPACED A MAX. OF 16" O.C.

3. TWO STORY WALLS SHALL BE FRAMED w/ 2x4 STUDS @ 12" O.C. OR 2x6 STUDS @ 16" O.C. BALLOON FRAMED W/ CROSS BRACING @ 6'-Ø" O.C. VERTICALLY.

SHADED WALLS INDICATED LOAD BEARING WALLS

JOIST & BEAM SIZES SHOWN ARE MINIMUMS. BUILDER MAY INCREASE DEPTH FOR EASE OF CONSTRUCTION.

THESE PLANS ARE DESIGNED IN ACCORDANCE WITH ARCHITECTURAL PLANS PROVIDED BY MCKEE HOMES COMPLETED/REVISED ON 9/28/16. IT IS THE RESPONSIBILITY OF THE CLIENT TO NOTIFY SUMMIT ENGINEERING, LABORATORY & TESTING, P.C. IF ANY CHANGES ARE MADE TO THE ARCHITECTURAL PLANS PRIOR TO CONSTRUCTION. SUMMIT ENGINEERING, LABORATORY \$ TESTING, P.C. CANNOT GUARANTEE THE ADEQUACY OF THESE STRUCTURAL PLANS WHEN USED WITH ARCHITECTURAL PLANS DATED DIFFERENTLY THAN THE DATE LISTED ABOVE.


## STRUCTURAL MEMBERS ONLY

ENGINEERING SEAL APPLIES ONLY TO STRUCTURAL COMPONENTS ON THIS DOCUMENT, SEAL DOES NOT INCLUDE CONSTRUCTION MEANS, METHODS, TECHNIQUES, SEQUENCES, PROCEDURES OR SAFETY PRECAUTIONS. ANY DEVIATIONS OR DISCREPANCIES ON PLANS ARE TO BE BROUGHT TO THE IMMEDIATE ATTENTION OF SUMMIT ENGINEERING, LABORATORY & TESTING, P.C. FAILURE TO DO SO WILL VOID SUMMIT LIABILITY.

STRUCTURAL ANALYSIS BASED ON 2018 NCRC.


WALK-UP ATTIC FRAMING PLAN

SCALE: 1/4"=1'-0" ON 22"x34" OR 1/8"=1'-0" ON 11"x17"

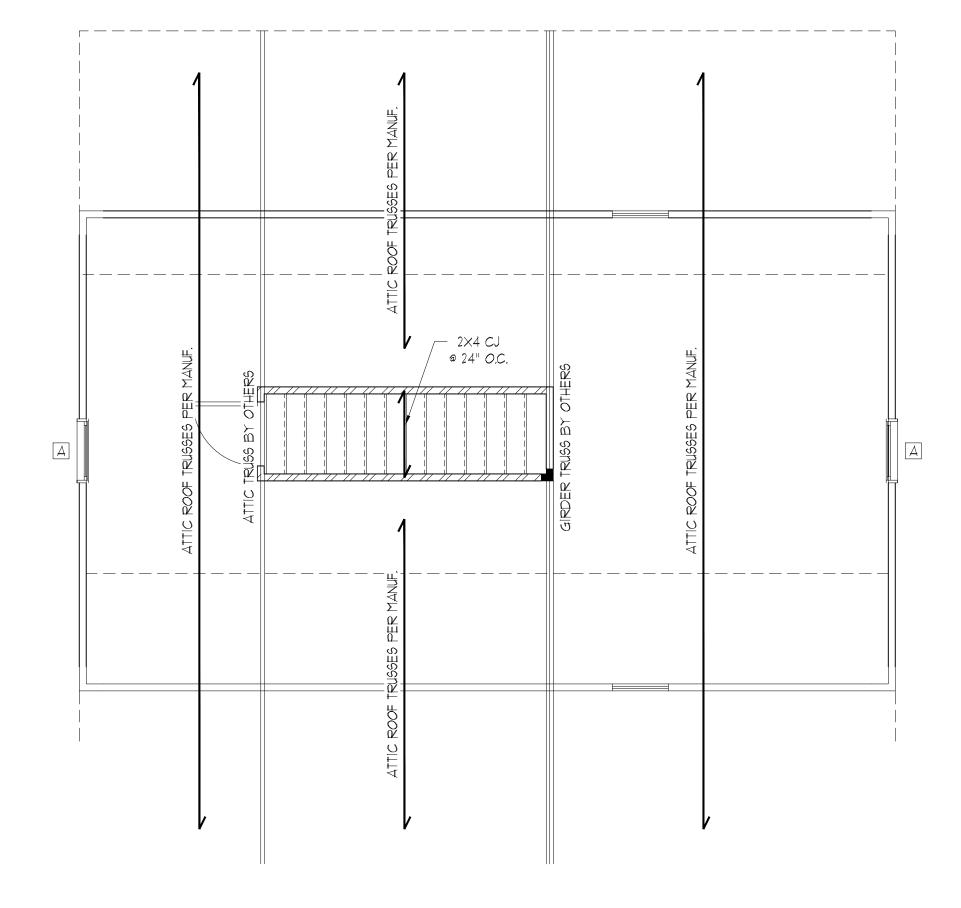

ALL ELEVATIONS

SUMMIT 3070 HAMMOND BUSINESS PLACE, SUITE 171 RALEIGH, NC 27603 OFFICE: 919.380.9991 FAX: 919.380.9993 WWW.SUMMIT-COMPANIES.COM

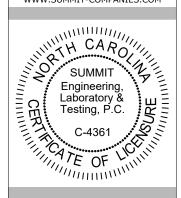

STRUCTURAL MEMBERS ONLY

DATE: 9/30/20

SCALE: 22×34 1/4"=1'-0" ||x|T 1/8"=1'-0" PROJECT \*: 26363R DRAWN BY: LBY CHECKED BY: BCP

ORIGINAL INFORMATION

REFER TO COVER SHEET FOR A COMPLETE LIST OF REVISIONS

54.2

TRUSS UPLIFT CONNECTOR SCHEDULE					
MAX. UPLIFT	ROOF TO WALL	FLOOR TO FLOOR	FLOOR TO FND		
600 LBS	H2.5A	PER WALL SHEATHIN	G & FASTENERS		
1200 LBS	(2) H2.5A	CS16 (END = 11")	DTT2Z		
1450 LBS	HTS2Ø	CS16 (END = 11")	DTT2Z		
2 <i>000</i> LBS	(2) MTS2Ø	(2) CS16 (END = 11")	DTT2Z		
2900 LBS	(2) HTS2Ø	(2) CSI6 (END = 11")	HTT4		
3685 LBS	LGT3-SDS2.5	MSTC52	HTT4		
1 ALL PROF	1 ALL PRODUCTS LISTED ARE SIMPSON STRONG. TIE FOLIVALENT				

1. ALL PRODUCTS LISTED ARE SIMPSON STRONG-TIE. EQUIVALENT PRODUCTS MAY BE USED PER MANUFACTURER'S SPECIFICATIONS.
2. UPLIFT VALUES LISTED ARE FOR SYP \*2 GRADE MEMBERS.
3. REFER TO TRUSS LAYOUT PER MANUF. FOR UPLIFT VALUES AND TRUSS TO TRUSS CONNECTIONS. CONNECTORS SPECIFIED BY TRUSS MANUFACTURER OVERRIDE THOSE LISTED ABOVE.
4. CONTACT SUMMIT FOR REQUIRED CONNECTORS WHEN LOADS EXCEED THOSE LISTED ABOVE.

NOTE: IST PLY OF ALL SHOWN GIRDER TRUSSES TO ALIGN WITH INSIDE FACE OF WALL (TYP, UNO)

NOTE: ROOF TRUSSES SHALL BE SPACED TO SUPPORT FALSE FRAMED DORMER WALLS (TYP, UNO)

REFER TO DETAIL 5/D3F FOR EYEBROW, RETURN OR SHED ROOF FRAMING REQUIREMENTS. (TYP FOR ROOFS PROTRUDING MAXIMUM 24" FROM STRUCTURE)

NOTE: TRUSS UPLIFT LOADS SHALL BE DETERMINED PER TRUSS MANUFACTURER IN ACCORDANCE WITH SECTION R802.II.I.I. WALL SHEATHING AND FASTENERS HAVE BEEN DESIGNED TO RESIST THE WIND UPLIFT LOAD PATH IN ACCORDANCE WITH METHOD 3 OF SECTION R602.3.5 OF THE 2018 NCRC. REFER TO BRACED WALL PLANS FOR SHEATHING AND FASTENER REQUIREMENTS.


THESE PLANS ARE DESIGNED IN ACCORDANCE WITH ARCHITECTURAL PLANS PROVIDED BY MCKEE HOMES COMPLETED/REVISED ON 9/28/16. IT IS THE RESPONSIBILITY OF THE CLIENT TO NOTIFY SUMMIT ENGINEERING, LABORATORY & TESTING, P.C. IF ANY CHANGES ARE MADE TO THE ARCHITECTURAL PLANS PRIOR TO CONSTRUCTION. SUMMIT ENGINEERING, LABORATORY & TESTING, P.C. CANNOT GUARANTEE THE ADEQUACY OF THESE STRUCTURAL PLANS WHEN USED WITH ARCHITECTURAL PLANS DATED DIFFERENTLY THAN THE DATE LISTED ABOVE.

## STRUCTURAL MEMBERS ONLY

ENGINEERING SEAL APPLIES ONLY TO STRUCTURAL COMPONENTS ON THIS DOCUMENT, SEAL DOES NOT INCLUDE CONSTRUCTION MEANS, METHODS, TECHNIQUES, SEQUENCES, PROCEDURES OR SAFETY PRECAUTIONS. ANY DEVIATIONS OR DISCREPANCIES ON PLANS ARE TO BE BROUGHT TO THE IMMEDIATE ATTENTION OF SUMMIT ENGINEERING, LABORATORY & TESTING, P.C. FAILURE TO DO SO WILL VOID SUMMIT LIABILITY.


STRUCTURAL ANALYSIS BASED ON 2018 NCRC.

ROOF FRAMING PLAN

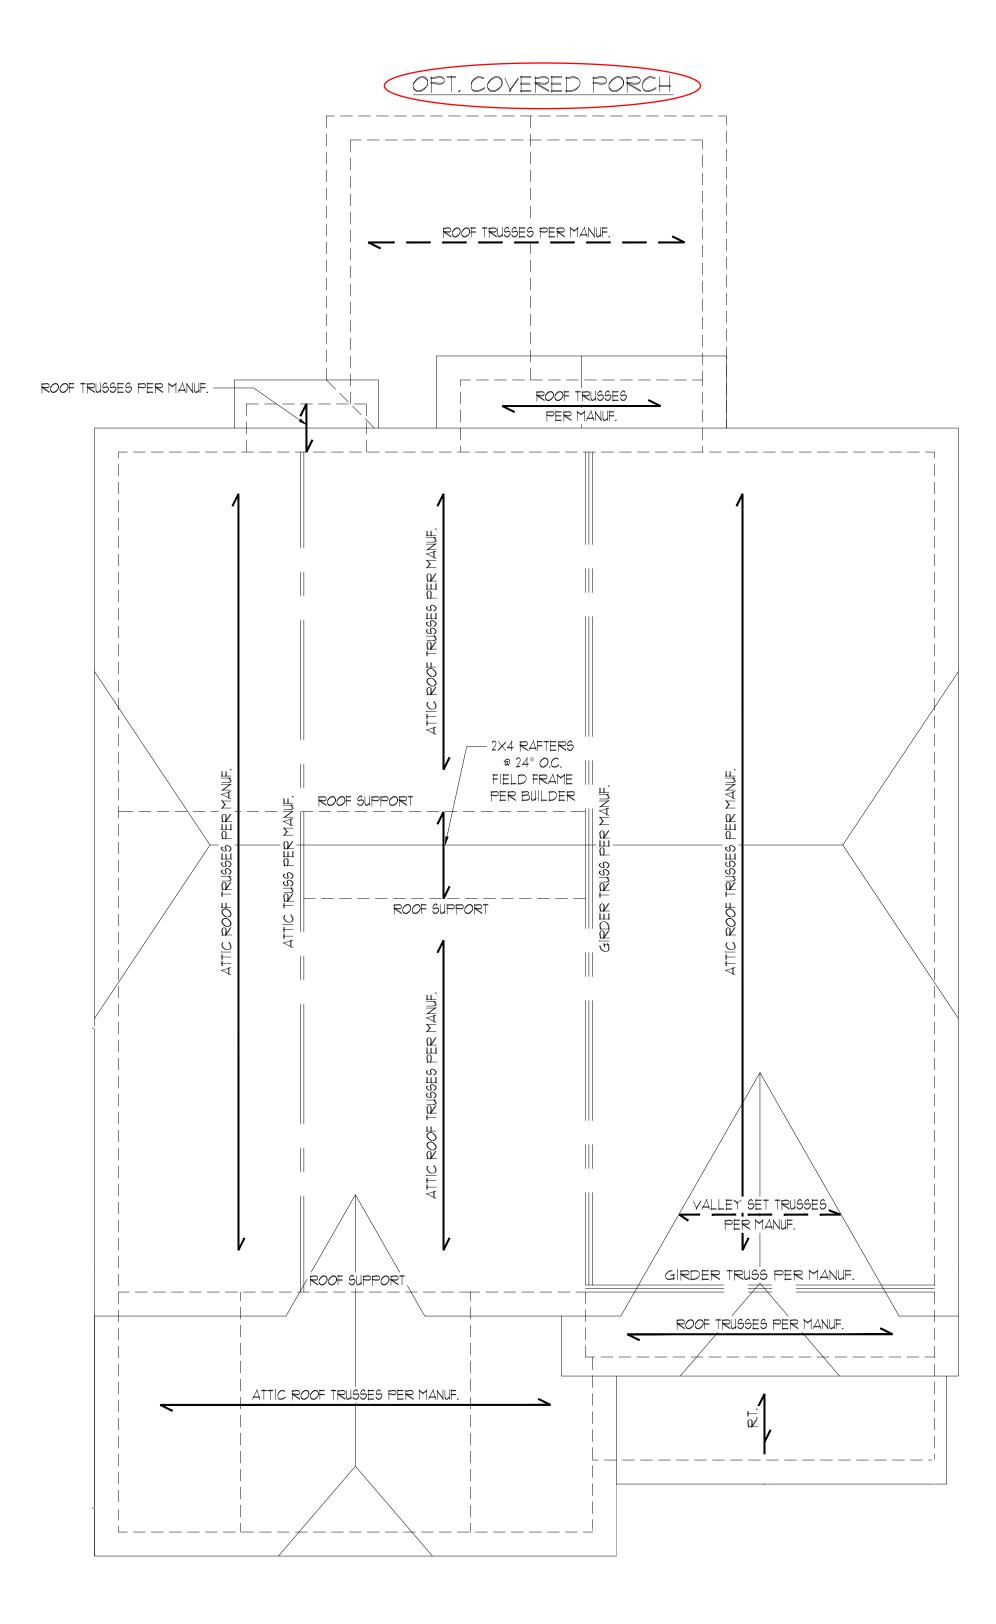





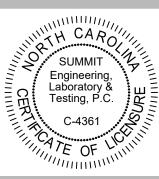

McKee Homes
109 Hay St., Suite 301

SEAL 046048

SEAL 046048

STRUCTURAL MEMBERS ONLY

PROJECT \* 26363R

DRAWN BY: LBV

CHECKED BY: BCP

ORIGINAL INFORMATION
PROJECT DATE
19420 09/28/2018

REFER TO COVER SHEET FOR A COMPLETE LIST OF REVISIONS

S5.2

SCALE: 1/4"=1'-0" ON 22"x34" OR 1/8"=1'-0" ON 11"x17"

	REQUIRED BRACED WALL PANEL CONNECTIONS					
NAME TO LOOP			REQUIRED	CONNECTION		
METHOD	MATERIAL	MIN. THICKNESS	@ PANEL EDGES	@ INTERMEDIATE SUPPORTS		
CS-WSP	WOOD STRUCTURAL PANEL	3/8"	6d COMMON NAILS @ 6" O.C.	6d COMMON NAILS		
GB	GYPSUM BOARD	1/2"	5d COOLER NAILS** @ 7" O.C.	5d COOLER NAILS** @ 7" O.C.		
WSP	WOOD STRUCTURAL PANEL	3/8"	6d COMMON NAILS @ 6" O.C.	6d COMMON NAILS		
PF	PF WOOD STRUCTURAL 7/16"		PER FIGURE R602.10.1	PER FIGURE R602.10.1		
	1			1		

REAR

HOUSE

FRONT

\*\*OR EQUIVALENT PER TABLE RT02.3.5

#### BRACED WALL NOTES:

- WALLS SHALL BE DESIGNED IN ACCORDANCE WITH SECTION R602.10 FROM THE 2018 INTERNATIONAL RESIDENTIAL CODE WITH ALL LOCAL AND STATE AMENDMENTS.
- 2. WALLS ARE DESIGNED FOR SEISMIC ZONES A-C AND ULTIMATE DESIGN WIND SPEEDS UP TO 130 MPH.
- REFER TO ARCHITECTURAL PLAN FOR DOOR/WINDOW OPENING SIZES.
- 4. BRACING MATERIALS, METHODS AND FASTENERS SHALL BE IN
- ACCORDANCE WITH TABLE R602.10.1
- 5. ALL BRACED WALL PANELS SHALL BE FULL WALL HEIGHT AND SHALL NOT EXCEED 10 FEET FOR ISOLATED PANEL METHOD AND 12 FEET FOR CONTINUOUS SHEATHING METHOD WITHOUT ADDITIONAL ENGINEERING CALCULATIONS.
- 6. MINIMUM PANEL LENGTH SHALL BE PER TABLE R602.10.1.
- 1. THE INTERIOR SIDE OF EXTERIOR WALLS AND BOTH SIDES OF INTERIOR WALLS SHALL BE SHEATHED CONTINUOUSLY WITH MINIMUM 1/2" GYPSUM BOARD (UNO).
- 8. FOR CONTINUOUS SHEATHING METHOD, EXTERIOR WALLS SHALL BE SHEATHED ON ALL SHEATHABLE SURFACES INCLUDING INFILL AREAS BETWEEN BRACED WALL PANELS, ABOVE AND BELOW WALL OPENINGS, AND ON GABLE END WALLS.
- 9. FLOORS SHALL NOT BE CANTILEVERED MORE THAN 24" BEYOND THE FOUNDATION OR BEARING WALL BELOW WITHOUT ADDITIONAL ENGINEERING CALCULATIONS.
- 10. A BRACED WALL PANEL SHALL BE LOCATED WITHIN 12 FEET OF EACH END OF A BRACED WALL LINE.
- 11. THE MAXIMUM EDGE DISTANCE BETWEEN BRACED WALL PANELS SHALL NOT EXCEED 21 FEET.
- 12. MASONRY OR CONCRETE STEM WALLS WITH A LENGTH OF 48" OR LESS
- SUPPORTING A BRACED WALL PANEL SHALL BE DESIGNED IN ACCORDANCE WITH FIGURE R602.10.4.3 OF THE 2018 IRC OR DETAIL 2/D2f.
- 13. BRACED WALL PANEL CONNECTIONS TO FLOOR/CEILING SHALL BE CONSTRUCTED IN ACCORDANCE WITH SECTION R602.10.4.4
- 14. BRACED WALL PANEL CONNECTIONS TO ROOF SHALL BE CONSTRUCTED IN ACCORDANCE WITH SECTION R602.10.4.5
- 15. CRIPPLE WALLS AND WALK OUT BASEMENT WALLS SHALL BE DESIGNED IN ACCORDANCE WITH SECTION R602.104.6
- 16. PORTAL WALLS SHALL BE DESIGNED IN ACCORDANCE WITH FIGURE
- R602.10.1 (UNO) 17. ON SCHEMATIC, SHADED WALLS INDICATE BRACED WALL PANELS.
- 18. ABBREVIATIONS:

GB = GYPSUM BOARD PF = PORTAL FRAME

WSP = WOOD STRUCTURAL PANEL CS-XXX = CONT. SHEATHED ENG = ENGINEERED SOLUTION PF-ENG = ENG. PORTAL FRAME

INSTALL HOLD-DOWNS FOR BRACED WALL END CONDITIONS PER SECTION R602.10.4 AND FIGURE R602.10.3(4) OF THE 2018 NCRC.

THESE PLANS ARE DESIGNED IN ACCORDANCE WITH ARCHITECTURAL PLANS PROVIDED BY MCKEE HOMES COMPLETED/REVISED ON 9/28/16. IT IS THE RESPONSIBILITY OF THE CLIENT TO NOTIFY SUMMIT ENGINEERING, LABORATORY & TESTING, P.C. IF ANY CHANGES ARE MADE TO THE ARCHITECTURAL PLANS PRIOR TO CONSTRUCTION. SUMMIT ENGINEERING, LABORATORY & TESTING, P.C. CANNOT GUARANTEE THE ADEQUACY OF THESE STRUCTURAL PLANS WHEN USED WITH ARCHITECTURAL PLANS DATED DIFFERENTLY THAN THE DATE LISTED ABOVE.

## STRUCTURAL MEMBERS ONLY


ENGINEERING SEAL APPLIES ONLY TO STRUCTURAL COMPONENTS ON THIS DOCUMENT, SEAL DOES NOT INCLUDE CONSTRUCTION MEANS, METHODS, TECHNIQUES, SEQUENCES, PROCEDURES OR SAFETY PRECAUTIONS. ANY DEVIATIONS OR DISCREPANCIES ON PLANS ARE TO BE BROUGHT TO THE IMMEDIATE ATTENTION OF SUMMIT ENGINEERING, LABORATORY & TESTING, P.C. FAILURE TO DO SO WILL VOID SUMMIT ELT LIABILITY.

STRUCTURAL. ANALYSIS BASED ON 2018 NCRC.

FIRST FLOOR BRACING PLAN


SCALE: 1/4"=1'-0" ON 22"x34" OR 1/8"=1'-0" ON 11"x17"



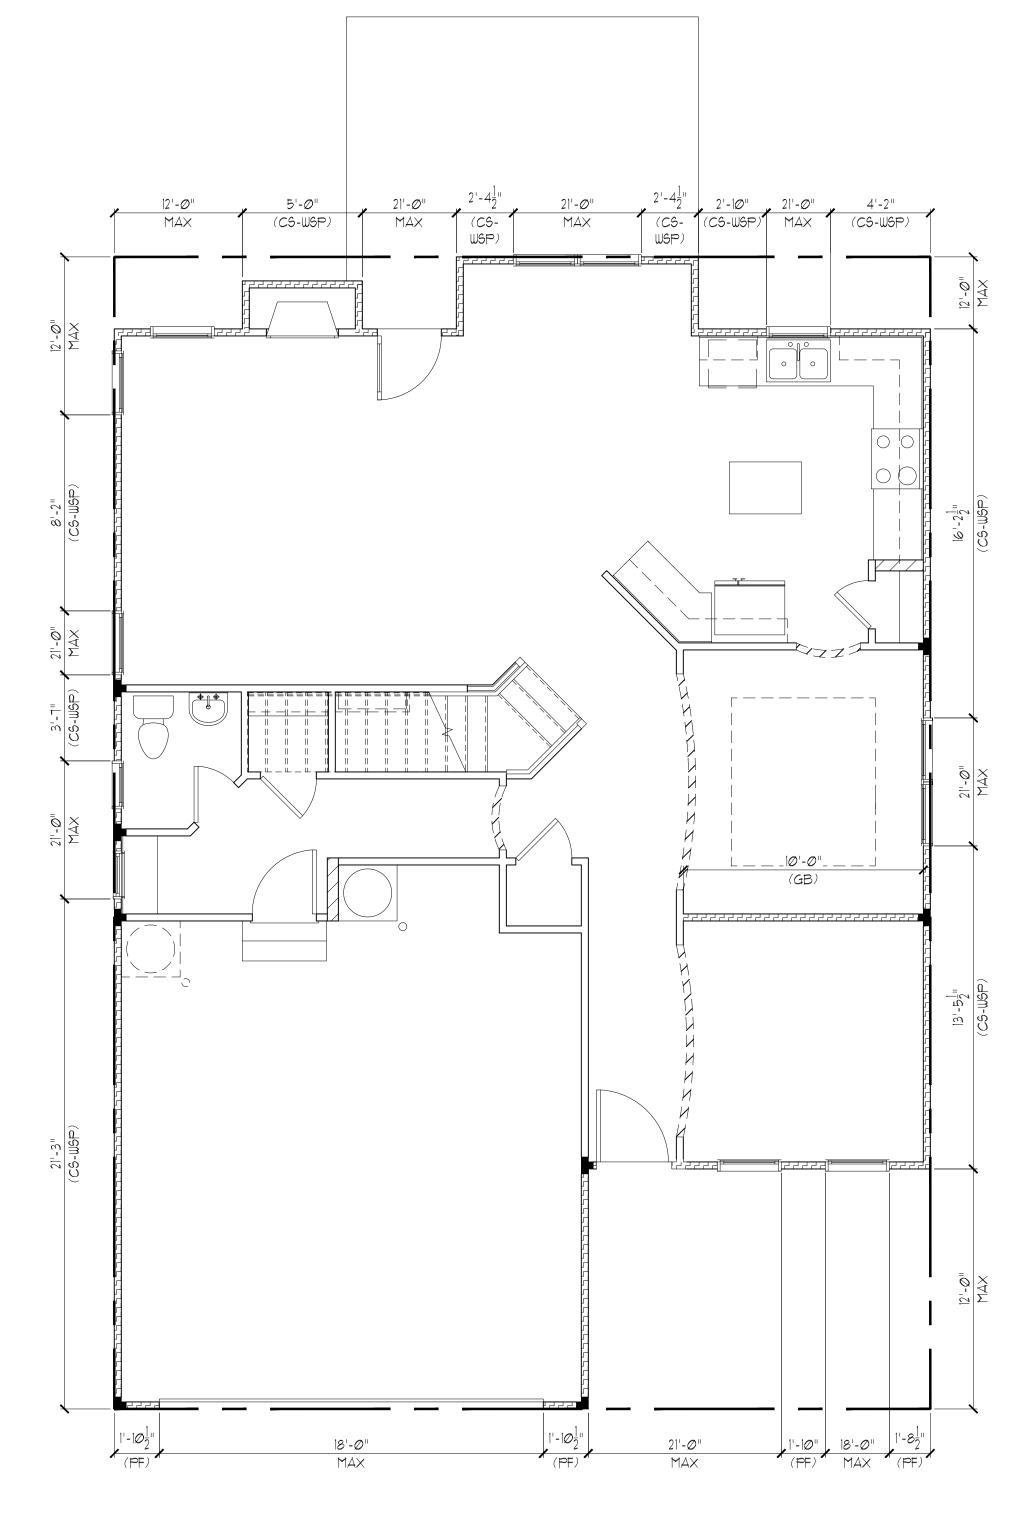

EURO ELEVATION



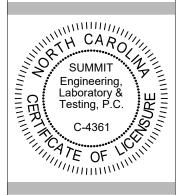


STRUCTURAL MEMBERS ONLY

DATE: 9/30/20 SCALE: 22x34 1/4"=1'-0" 11x17 1/8"=1'-0"

PROJECT \*: 26363R DRAWN BY: LBY CHECKED BY: BCP

ORIGINAL INFORMATION


REFER TO COVER SHEET FOR A COMPLETE LIST OF REVISIONS

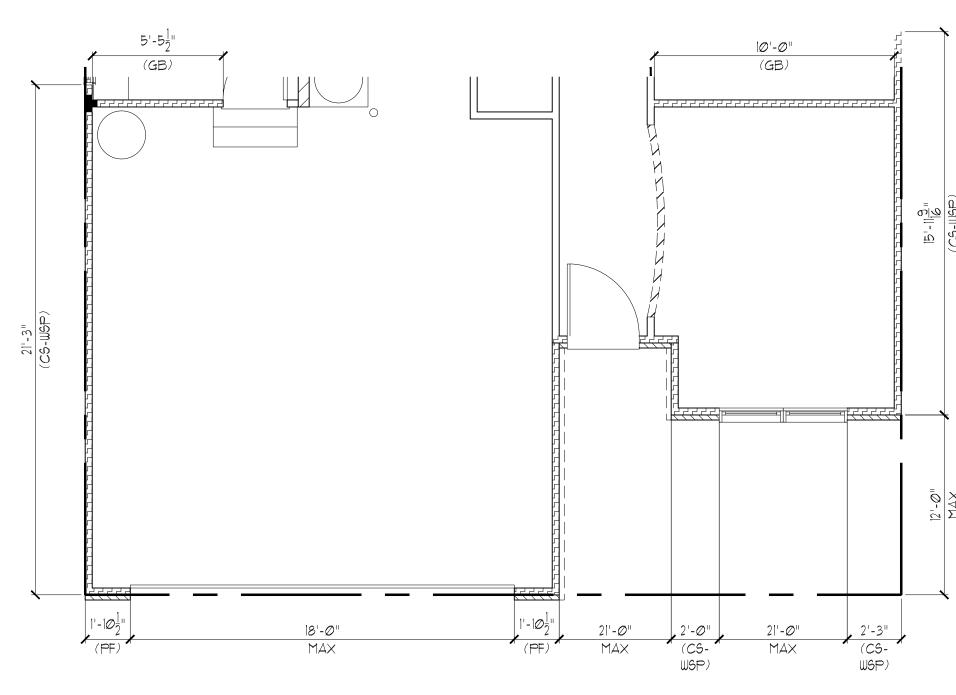

EURO

FIRST FLOOR BRACING (FT)				
CONTINUOUS SHEATHING METHOD				
REQUIRED PROVIDED				
FRONT	15.3	17.6		
LEFT	11.3	33 <i>.</i> Ø		
REAR	15.3	23.9		
RIGHT	11.3	32.1		

SUMMIT
ENGINEERING LABORATORY TESTING
3070 HAMMOND BUSINESS
PLACE, SUITE 171
RALEIGH, NC 27603
OFFICE: 919.380.9991
FAX: 919.380.9993
WWW.SUMMIT-COMPANIES.COM

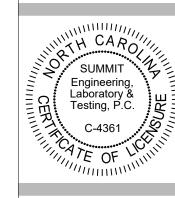

CLIENT: McKee Homes 109 Hay St., Suite 301

Finley | LH

Finley | LH

First #| Or Pracing #| 20

SEAL 046048

STRUCTURAL MEMBERS ONLY

DRAWING

DATE: 9/30/20

SCALE: 22x34 |/4"=|'-0" | ||x11 |/6"=|'-0"

9CALE: 22x34 | |/4"=|"-6 ||x|1 | |/8"=|"-6 | PROJECT \* 26363R | DRAIIN BY: LBV | CHECKED BY: BCP

RIGINAL INFORMATION
PROJECT \* DATE
19420 Ø9/28/2018

REFER TO COVER SHEET FOR A COMPLETE LIST OF REVISIONS

57,1

STRUCTURAL MEMBERS ONLY

ENGINEERING SEAL APPLIES ONLY TO STRUCTURAL COMPONENTS ON THIS DOCUMENT, SEAL DOES NOT INCLUDE CONSTRUCTION MEANS, METHODS, TECHNIQUES, SEQUENCES, PROCEDURES OR SAFETY PRECAUTIONS. ANY DEVIATIONS OR DISCREPANCIES ON PLANS ARE TO BE BROUGHT TO THE IMMEDIATE ATTENTION OF SUMMIT ENGINEERING, LABORATORY & TESTING, P.C. FAILURE TO DO SO WILL VOID SUMMIT ELT LIABILITY.

STRUCTURAL ANALYSIS BASED ON 2018 NCRC.

FIRST FLOOR BRACING PLAN

SCALE: 1/4"=1'-0" ON 22"x34" OR 1/8"=1'-0" ON 11"x17"

	REQUIRED BRACED WALL PANEL CONNECTIONS					
			REQUIRED CONNECTION			
METHOD	MATERIAL	MIN. THICKNESS	@ PANEL EDGES	@ INTERMEDIATE SUPPORTS		
CS-WSP	S-WSP WOOD STRUCTURAL PANEL 3/8"		6d COMMON NAILS @ 6" O.C.	6d COMMON NAILS @ 12" O.C.		
GB	GYPSUM BOARD	1/2"	5d COOLER NAILS** @ 7" O.C.	5d COOLER NAILS** @ 7" O.C.		
WSP	WOOD STRUCTURAL PANEL	3/8"	6d COMMON NAILS @ 6" O.C.	6d COMMON NAILS @ 12" O.C.		
PF	WOOD STRUCTURAL PANEL	7/16"	PER FIGURE R602.10.1	PER FIGURE R602.10.1		
		**OR EQUIVALEN	T PER TABLE RTØ2.3.5			

HOUSE

#### BRACED WALL NOTES:

- WALLS SHALL BE DESIGNED IN ACCORDANCE WITH SECTION R602.10 FROM THE 2018 INTERNATIONAL RESIDENTIAL CODE WITH ALL LOCAL AND STATE AMENDMENTS.
- 2. WALLS ARE DESIGNED FOR SEISMIC ZONES A-C AND ULTIMATE DESIGN WIND SPEEDS UP TO 130 MPH.
- REFER TO ARCHITECTURAL PLAN FOR DOOR/WINDOW OPENING SIZES.
- 4. BRACING MATERIALS, METHODS AND FASTENERS SHALL BE IN ACCORDANCE WITH TABLE R602.10.1
- 5. ALL BRACED WALL PANELS SHALL BE FULL WALL HEIGHT AND SHALL NOT EXCEED 10 FEET FOR ISOLATED PANEL METHOD AND 12 FEET FOR CONTINUOUS SHEATHING METHOD WITHOUT ADDITIONAL ENGINEERING CALCULATIONS.
- 6. MINIMUM PANEL LENGTH SHALL BE PER TABLE R602.10.1. 1. THE INTERIOR SIDE OF EXTERIOR WALLS AND BOTH SIDES OF INTERIOR WALLS SHALL BE SHEATHED CONTINUOUSLY WITH MINIMUM 1/2" GYPSUM BOARD (UNO).
- 8. FOR CONTINUOUS SHEATHING METHOD, EXTERIOR WALLS SHALL BE SHEATHED ON ALL SHEATHABLE SURFACES INCLUDING INFILL AREAS BETWEEN BRACED WALL PANELS, ABOVE AND BELOW WALL OPENINGS, AND ON GABLE END WALLS.
- 9. FLOORS SHALL NOT BE CANTILEVERED MORE THAN 24" BEYOND THE FOUNDATION OR BEARING WALL BELOW WITHOUT ADDITIONAL
- ENGINEERING CALCULATIONS. 10. A BRACED WALL PANEL SHALL BE LOCATED WITHIN 12 FEET OF EACH END OF A BRACED WALL LINE.
- 11. THE MAXIMUM EDGE DISTANCE BETWEEN BRACED WALL PANELS SHALL NOT EXCEED 21 FEET.
- 12. MASONRY OR CONCRETE STEM WALLS WITH A LENGTH OF 48" OR LESS SUPPORTING A BRACED WALL PANEL SHALL BE DESIGNED IN
- ACCORDANCE WITH FIGURE R602.10.4.3 OF THE 2018 IRC OR DETAIL 2/D2f. 13. BRACED WALL PANEL CONNECTIONS TO FLOOR/CEILING SHALL BE
- CONSTRUCTED IN ACCORDANCE WITH SECTION R602.10.4.4 14. BRACED WALL PANEL CONNECTIONS TO ROOF SHALL BE CONSTRUCTED
- IN ACCORDANCE WITH SECTION R602.10.4.5 15. CRIPPLE WALLS AND WALK OUT BASEMENT WALLS SHALL BE DESIGNED
- IN ACCORDANCE WITH SECTION R602.104.6 16. PORTAL WALLS SHALL BE DESIGNED IN ACCORDANCE WITH FIGURE R602.10.1 (UNO)
- 17. ON SCHEMATIC, SHADED WALLS INDICATE BRACED WALL PANELS.
- 18. ABBREVIATIONS:

GB = GYPSUM BOARD WSP = WOOD STRUCTURAL PANEL CS-XXX = CONT. SHEATHED ENG = ENGINEERED SOLUTION PF = PORTAL FRAME PF-ENG = ENG. PORTAL FRAME

INSTALL HOLD-DOWNS FOR BRACED WALL END CONDITIONS PER SECTION R602.10.4 AND FIGURE R602.10.3(4) OF THE 2018 NCRC.

THESE PLANS ARE DESIGNED IN ACCORDANCE WITH ARCHITECTURAL PLANS PROVIDED BY MCKEE HOMES COMPLETED/REVISED ON 9/28/16. IT IS THE RESPONSIBILITY OF THE CLIENT TO NOTIFY SUMMIT ENGINEERING, LABORATORY & TESTING, P.C. IF ANY CHANGES ARE MADE TO THE ARCHITECTURAL PLANS PRIOR TO CONSTRUCTION. SUMMIT ENGINEERING, LABORATORY & TESTING, P.C. CANNOT GUARANTEE THE ADEQUACY OF THESE STRUCTURAL PLANS WHEN USED WITH ARCHITECTURAL PLANS DATED DIFFERENTLY THAN THE DATE LISTED ABOVE.


## STRUCTURAL MEMBERS ONLY


ENGINEERING SEAL APPLIES ONLY TO STRUCTURAL COMPONENTS ON THIS DOCUMENT, SEAL DOES NOT INCLUDE CONSTRUCTION MEANS, METHODS, TECHNIQUES, SEQUENCES, PROCEDURES OR SAFETY PRECAUTIONS. ANY DEVIATIONS OR DISCREPANCIES ON PLANS ARE TO BE BROUGHT TO THE IMMEDIATE ATTENTION OF SUMMIT ENGINEERING, LABORATORY & TESTING, P.C. FAILURE TO DO SO WILL VOID SUMMIT ELT LIABILITY.


STRUCTURAL ANALYSIS BASED ON 2018 NCRC.

SECOND FLOOR BRACING PLAN

SCALE: 1/4"=1'-0" ON 22"x34" OR 1/8"=1'-0" ON 11"x17"

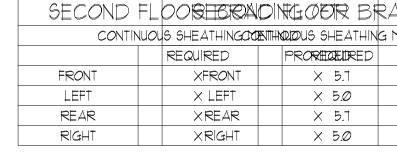

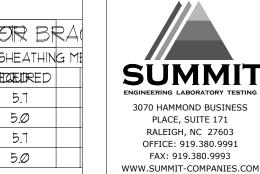

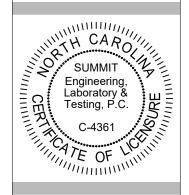

 $^{\omega}$ Ĭ.

STRUCTURAL MEMBERS ONLY


DATE: 9/30/20 SCALE: 22x34 1/4"=1'-0" 11x17 1/8"=1'-0"

PROJECT \*: 26363R DRAWN BY: LBY CHECKED BY: BCP

ORIGINAL INFORMATION

REFER TO COVER SHEET FOR A COMPLETE LIST OF REVISIONS

58.Ø

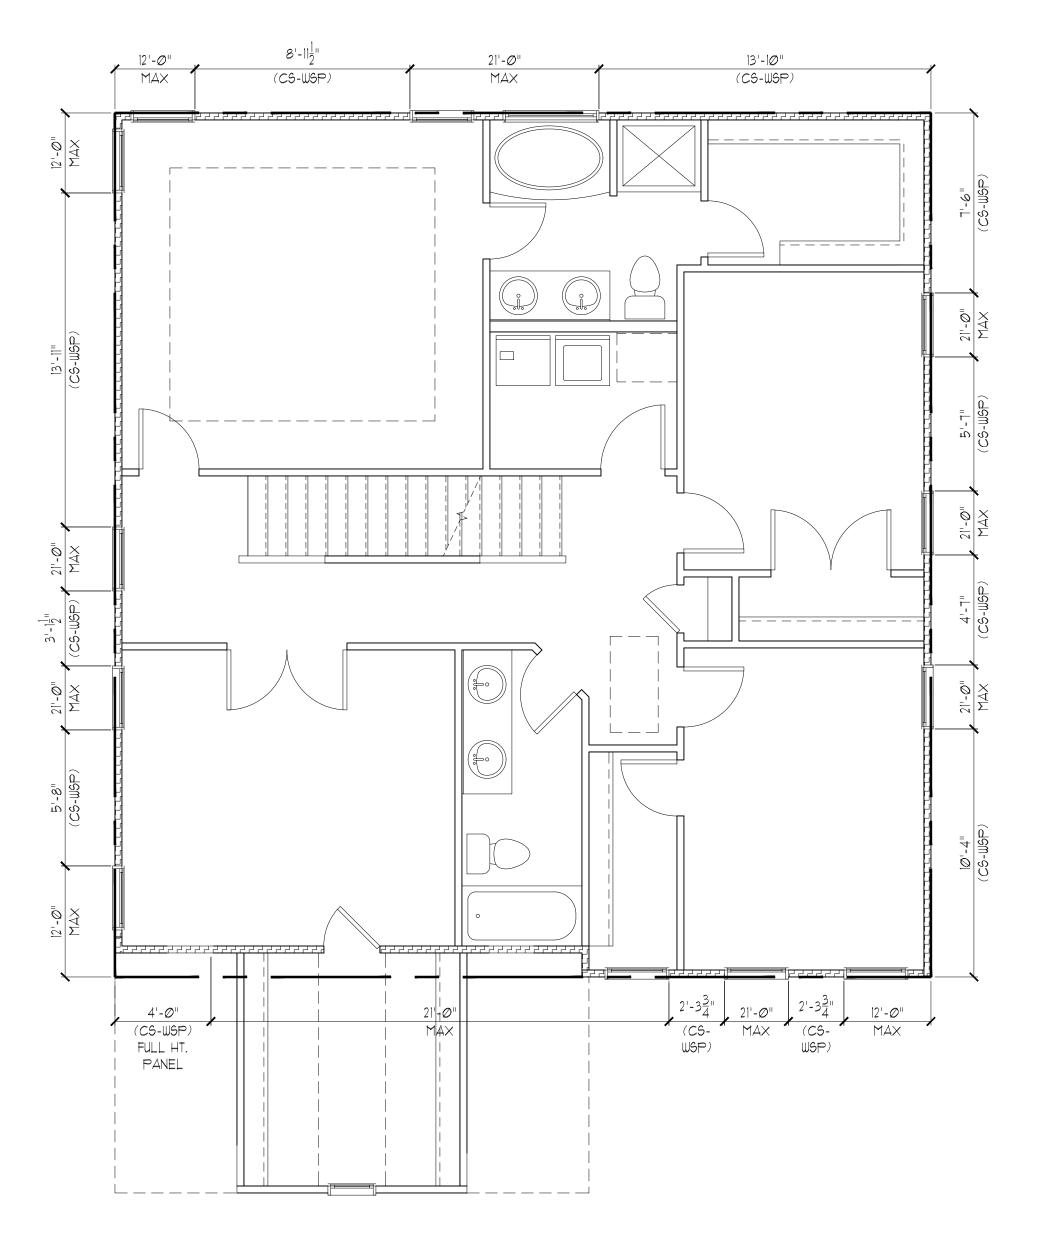

**EURO ELEVATION** COASTAL SEE PG. S8.1

	SECOND FLOOR BRACING (FT)				
	CONTINUOUS SHEATHING METHOD				
FURO		REQUIRED	PROVIDED		
	FRONT	5.9	13.2		
	LEFT	5.0	22.7		
	REAR	5.9	22.7		
	PIGHT	50	295		

STRUCTURAL MEMBERS ONLY

ENGINEERING SEAL APPLIES ONLY TO STRUCTURAL COMPONENTS ON THIS DOCUMENT, SEAL DOES NOT INCLUDE CONSTRUCTION MEANS, METHODS, TECHNIQUES, SEQUENCES, PROCEDURES OR SAFETY PRECAUTIONS. ANY DEVIATIONS OR DISCREPANCIES ON PLANS ARE TO BE BROUGHT TO THE IMMEDIATE ATTENTION OF SUMMIT ENGINEERING, LABORATORY & TESTING, P.C. FAILURE TO DO SO WILL VOID SUMMIT ELT LIABILITY.


STRUCTURAL ANALYSIS BASED ON 2018 NCRC.

SECOND FLOOR BRACING PLAN

SCALE: 1/4"=1'-0" ON 22"x34" OR 1/8"=1'-0" ON 11"x17"

SUMMIT
ENGINEERING LABORATORY TESTING

3070 HAMMOND BUSINESS
PLACE, SUITE 171
RALEIGH, NC 27603
OFFICE: 919.380.9991
FAX: 919.380.9993
WWW.SUMMIT-COMPANIES.COM

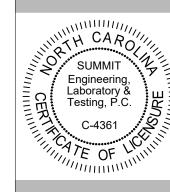

CLIENT: McKee Homes 109 Hay 9t., Suite 301

> Finley I LH Second Floor Bracing Plan

SEAL 046048

STRUCTURAL MEMBERS ONLY

STRUCTURAL MEMBERS

DRAWING

DATE: 9/30/20

DATE: 9/30/20

SCALE: 22x34 |/4"=1'-0"
||x|1 |/8"=1'-0"

PROJECT \* 26363R

DRAWN BY: LBV

CHECKED BY: BCP

ORIGINAL INFORMATION
PROJECT \* DATE
19420 09/28/2018

REFER TO COVER SHEET FOR A COMPLETE LIST OF REVISIONS

S8.1



STRUCTURAL PLANS PREPARED FOR:

#### Standard Details

McKee Homes

109 Hay St., Suite 301 Fayetteville, NC 28301

DESIGNER:

These drawings are to be coordinated with the architectural, mechanical, plumbing, electrical, and civil drawings. This coordination is not the responsibility of the structural engineering of record (SER). Should any discrepancies become apparent, the contractor shall notify SUMMIT Engineering, Laboratory 4 Testing, P.C. before construction begins.

#### PLAN ABBREVIATIONS:

AB	ANCHOR BOLT	PT	PRESSURE TREATED
AFF	ABOVE FINISHED FLOOR	R6	ROOF SUPPORT
CJ	CEILING JOIST	9C	STUD COLUMN
CLR	CLEAR	SJ	SINGLE JOIST
DJ	DOUBLE JOIST	SPF	SPRUCE PINE FIR
DSP	DOUBLE STUD POCKET	551	SIMPSON STRONG-TIE
EE	EACH END	SYP	SOUTHERN YELLOW PINE
ΕW	EACH WAY	TJ	TRIPLE JOIST
NTS	NOT TO SCALE	TSP	TRIPLE STUD POCKET
oc	ON CENTER	TYP	TYPICAL
PSF	POUNDS PER SQUARE FOOT	UNO	UNLESS NOTED OTHERWISE
PSI	POUNDS PER SQUARE INCH	WWF	WELDED WIRE FABRIC

Roof truss and floor joist layouts, and their corresponding loading details, were not provided to SUMMIT Engineering, Laboratory & Testing, P.C. (SUMMIT) prior to the initial design. Therefore, truss and joist directions were assumed based on the information provided by MERITAGE HOMES, Subsequent plan revisions based on roof truss and floor joist layouts shall be noted in the revision list, indicating the date the layouts were provided. Should any discrepancies become apparent, the contractor shall notify SUMMIT immediately.

Sheet No.	Description	
CSI	Cover Sheet, Specifications, Revisions	
Dlm	Monolithic Slab Foundation Details	_
Dis	Stem Wall Foundation Details	
Dlc	Crawl Space Foundation Details	
Dlb	Basement Foundation Details	_
DIf	Framing Details	_
		_
	·	
•		

#### REVISION LIST:

SHEET LIST:

Revision No.	Date	Project No.	Description
ı	1.11.19	-	Updated to 2018 NCRC

GENERAL STRUCTURAL NOTES:

1. The design professional whose seal appears on these drawings is the structural engineer of record (SER) for this project. The SER bears the responsibility of the primary structural elements and the performance of this structure. No other party may revise alter, or delete any structural aspects of these construction documents without written permission of SUMMIT Engineering, Laboratory 4 Testing, P.C. (SUMMIT) or the SER. For the purposes of these construction documents the SER and SUMMIT shall be considered the same entity.

The structure is only stable in its completed form The contractor hall provide all required temporary bracing during construction to stabilize the structure.

The SER is not responsible for construction sequences, methods,

or techniques in connection with the construction of this structure. The SER will not be held responsible for the contractor's failure to conform to the contract documents. should any non-conformities occur.

Any structural elements or details not fully developed on the

any structural elements or details not fully developed on the construction drawings shall be completed under the direction of a licensed professional engineer. These shop drawings shall be submitted to SUMMIT for review before any construction begins. The shop drawings will be reviewed for overall compliance as it. relates to the structural design of this project. Verification of the shop drawings for dimensions, or for actual field conditions, is not the responsibility of the SER or SUMMIT.

Verification of assumed field conditions is not the responsibility

of the SER. The contractor shall verify the field conditions for accuracy and report any discrepancies to SUMMIT before

construction begins.

The SER is not responsible for any secondary structural elements or non-structural elements, except for the elements specifically noted on the structural drawings.
This structure and all construction shall conform to all

applicable sections of the international residential code.

This structure and all construction shall conform to all applicable sections of local building codes.

All structural assemblies are to meet or exceed to requirements

of the current local building code.

#### FOUND ATIONS:

The structural engineer has not performed a subsurface investigation. Verification of this assumed value is the responsibility of the owner or the contractor. Should any contacted before proceeding.

The bottom of all footings shall extend below the frost line for the region in which the structure is to be constructed. However,

the bottom of all footings shall be a minimum of 12" below grade, the bottom of all loads under the direction or recommendation of a licensed professional engineer.

The resulting soil shall be compacted to a minimum of 95%

maximum dry density. Excavations of footings shall be lined temporarily with a 6 mil polyethylene membrane if placement of concrete does not occur within 24 hours of excavation.

No concrete shall be placed against any subgrade containing

#### STRUCTURAL STEEL

Structural steel shall be fabricated and erected in accordance with the American Institute of Steel Construction "Code of Standard Practice for Steel Buildings and Bridges" and the manual of Steel Construction "Load Resistance Factor Design" latest editions.

Structural steel shall receive one coat of shop applied rust-inhibitive paint.

All steel shall have a minimum yield stress (F  $_{\! u}\!\!$  ) of 36 ksi unless otherwise noted.

Welding shall conform to the latest edition of the American

Welding Society's Structural Welding Code AWS D.I. Electrodes for shop and field welding shall be class ETØXX. All welding shall be performed by a certified welder per the above

Concrete shall have a normal weight aggregate and a minimum compressive strength (f'c) at 28 days of 3000 psi, unless

otherwise noted on the plan.

Concrete shall be proportioned, mixed, and placed in accordance with the latest editions of ACI 318: "Building Code Requirements for Reinforced Concrete" and ACI 301: "Specifications for Structural Concrete for Buildings".

Air entrained concrete must be used for all structural elements exposed to freeze/thaw cycles and deicing chemicals. Air entrainment amounts (in percent) shall be within -1% to +2% of taraet values as follows:

3.2. Exterior Slabs: 5%

No admixtures shall be added to any structural concrete without

Concrete slabs-on-grade shall be constructed in accordance with ACI 302.IR-96: "Guide for Concrete Slab and Slab Construction".

The concrete slab-on-grade has been designed using a subgrade modulus of k=250 pci and a design loading of 200 psf. The SER is not responsible for differential settlement, slab cracking or other future defects resulting from unreported conditions not in accordance with the above assumptions.

Control or saw cut joints shall be spaced in interior slabs-on-grade at a maximum of 15'-0" O.C. and in exterior slabs-on-grade at a maximum of 10'-0" unless otherwise noted

Control or saw cut Joints shall be produced using conventional process within 4 to 12 hours after the slab has been finished Reinforcing steel may not extend through a control joint. Reinforcing steel may extend through a saw cut joint.

All welded wire fabric (WWF.) for concrete slabs-on-grade shall be placed at mid-depth of slab. The WWF, shall be securely supported during the concrete pour.

CONCRETE REINFORCEMENT:

1. Fibrous concrete reinforcement, or fibermesh, specified in concrete slabs-on-grade may be used for control of cracking due to shrinkage and thermal expansion/contraction, lowered water migration, an increase in impact capacity, increased abrasion resistance, and residual strength.
Fibermesh reinforcing to be 100% virgin polypropylene fibers

containing no reprocessed olefin materials and specifically manufactured for use as concrete secondary reinforcement.

Application of fibermesh per cubic yard of concrete shall equal

a minimum of 0.1% by volume (1.5 pounds per cubic yard)
Fibermesh shall comply with ASTM CIII6, any local building code
requirements, and shall meet or exceed the current industry

standard. Steel reinforcing bars shall be new billet steel conforming to ASTM A615, grade 60.

ASITI Abib, grade 60.

Detailing, fabrication, and placement of reinforcing steel shall be in accordance with the latest edition of ACI 315: "Manual of Standard Practice for Detailing Concrete Structures" Horizontal footing and wall reinforcement shall be continuous and shall have 90° bends, or corner bars with the same size/spacing as the horizontal reinforcement with a class B

Lap reinforcement as required, a minimum of 40 bar diameters for tension or compression unless otherwise noted. Splices in masonry shall be a minimum of 48 bar diameters.

Where reinforcing dowels are required, they shall be equivalent in size and spacing to the vertical reinforcement. The dowel shall extend 48 bar diameters vertically and 20 bar diameters into the footing.

Where reinforcing steel is required vertically, dowels shall be

provided unless otherwise noted

#### WOOD FRAMING:

Solid sawn wood framing members shall conform to the specifications listed in the latest edition of the "National Design Specification for Wood Construction" (NDS) Unless otherwise noted, all wood framing members are designed to be Southern-Yellow-Pine (SYP) 2.

LVL or PSL engineered wood shall have the following minimum

design values: 2.1. E = 1,900,000 psi

2.2. Fb = 2600 psi 2.4.Fc = 700 psi

Wood in contact with concrete, masonry, or earth shall be pressure treated in accordance with AWPA standard C-15. All . other moisture exposed wood shall be treated in accordance with AWPA standard C-2

Nails shall be common wire nails unless otherwise noted.

Lag screws shall conform to ANSI/ASME standard B182.1-1981. Lead holes for lag screws shall be in accordance with NDS

specifications. All beams shall have full bearing on supporting framing members

unless otherwise noted.

Exterior and load bearing stud walls are to be 2x4 SYP \*2 \* 16" OC. unless otherwise noted. Studs shall be continuous from the sole plate to the double top plate. Studs shall only be discontinuous at headers for window/door openings. A minimum of one king stud shall be placed at each end of the header.

Kina studs shall be continuous. king stude shall be continuous.

Individual stude forming a column shall be attached with one lod nail @ 6" O.C. staggered. The stud column shall be continuous to the foundation or beam. The column shall be properly blocked at all floor levels to ensure proper load transfer. Multi-ply beams shall have each ply attached with (3) 10d nails \$\frac{1}{2}\$

Four and five ply beams shall be bolted together with (2) rows of 1/2" diameter through bolts staggered © 16" O.C. unless noted otherwise.

#### WOOD TRUSSES:

The wood truss manufacturer/fabricator is responsible for the design of the wood trusses. Submit sealed shop drawings and supporting calculations to the SER for review prior to fabrication. The SER shall have a minimum of five (5) days for review. The review by the SER shall review for overall compliance with the design documents. The SER shall assume no responsibility for the correctness for the structural design for

the wood trusses.

The wood trusses shall be designed for all required loadings as specified in the local building code, the ASCE Standard "Minimum Design Loads for Buildings and Other Structures." (ASCE 1-10), and the loading requirements shown on these specifications. The truss drawings shall be coordinated with all other construction documents and provisions provided for loads shown on these drawings including but not limited to HVAC equipment, piping, and architectural fixtures attached to

The trusses shall be designed, fabricated, and erected in specification for Metal Plate Connected Wood Trusses."

information in accordance with "Commentary and Recommendations for Handling, Installing, and Bracing Metal Plate Connected Wood Trusses" (HIB-91). This bracing, both temporary and permanent, shall be shown on the shop drawings. Also, the shop drawings shall show the required attachments for the trusses.

Any chords or truss webs shown on these drawings have been shown as a reference only. The final design of the trusses shall be per the manufacturer.

#### EXTERIOR WOOD FRAMED DECKS:

Decks are to be framed in accordance with local building codes and as referenced on the structural plans, either through

UDOD STRUCTURAL PANELS:

I. Fabrication and placement of structural wood sheathing shall be in accordance with the APA Design/Construction Guide
"Residential and Commercial," and all other applicable APA

All structurally required wood sheathing shall bear the mark of

Wood wall sheathing shall comply with the requirements of local building codes for the appropriate state as indicated on these drawings. Refer to wall bracing notes in plan set for more information. Sheathing shall be applied with the long direction

perpendicular to framing, unless noted otherwise.

Roof sheathing shall be APA rated sheathing exposure 1 or 2.

Roof sheathing shall be continuous over two supports and attached to its supporting roof framing with (1)-8d CC nail at 6"o/c at panel edges and at 12"o/c in panel field unless otherwise noted on the plans. Sheathing shall be applied with the long direction perpendicular to framing Sheathing shall have a span rating consistent with the framing spacing. Use suitable edge support by use of plywood clips or lumber blocking unless otherwise noted. Panel end joints shall occur over framing. Apply building paper over the sheathing as required by the state Building Code.

Wood floor sheathing shall be APA rated sheathing exposure I or 2. Attach sheathing to its supporting framing with (I)-8d CC ringshank nail at 6°o/c at panel edges and at 12°o/c in panel field unless otherwise noted on the plans. Sheathing shall be applied perpendicular to framing, Sheathing shall have a span rating consistent with the framing spacing. Use suitable edge support by use of T4G plywood or lumber blocking unless otherwise noted. Panel and joints shall occur over framing. Apply building paper over the sheathing as required by the state Building Code.
Sheathing shall have a 1/8" gap at panel ends and edges as

#### TRUCTURAL FIBERBOARD PANELS:

Fabrication and placement of structural fiberboard sheathing shall be in accordance with the applicable AFA standards. All structurally required fiberboard sheathing shall bear the

Fiberboard wall sheathing shall comply with the requirements of local building codes for the appropriate state as indicated on these drawings. Refer to wall bracing notes in plan set for more

Sheathing shall have a 1/8" gap at panel ends and edges are

SUMMIT





DATE: ØVII/2Ø19 SCALE: 22x34 1/4"+1"-@" ||x|T 1/8"+1"-@" DRAWN BY: EMB CHECKED BY: WAJ

ORIGINAL INFORMATION
PROJECT P DATE

REFER TO COVER SHEET FOR A

TYP. FOUNDATION WALL DETAIL

FTG. WIDTH CHARTS

STANDARD - BRICK


SLAB AT GARAGE DOOR


FTG. WIDTH CHARTS

STANDARD - SIDING

HOUSE/GARAGE WALL DETAIL

TYP. GARAGE CURB DETAIL

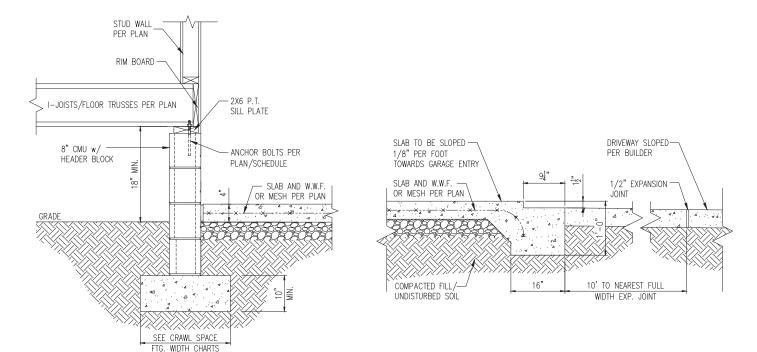

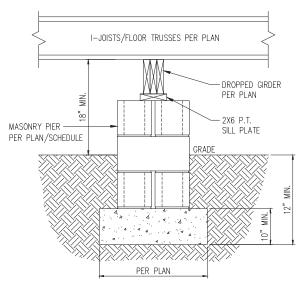

STANDARD - SIDING

TYP. PIER & GIRDER DETAIL

#### PIER SIZE AND HEIGHT SCHEDULE

	HOLLOW	SOLID	
8"X16"	UP TO 32" HEIGHT	UP TO 5'-0" HEIGHT	
12"X16"	UP TO 48" HEIGHT	UP TO 9'-0" HEIGHT	
16"X16"	UP TO 64" HEIGHT	UP TO 12'-0" HEIGHT*	
24"X24"	UP TO 96" HEIGHT	UP TO 12'-0" HEIGHT*	
*(4) #4 CONT. REBAR w/ #3 STIRRUPS @ 16" O.C.			
AND 24" MIN. LAP JOINTS			

STANDARD - BRICK

#### CRAWL SPACE FOOTING WIDTH

CITAME SI ACE I COTINO	MIDITI		
# OF STORIES WIDTH BASED ON SOIL BEARING CAPAC			IG CAPACITY
	1500 PSF	2000 PSF	2500 PSF
1 STORY - STD.	16"	16"	16"
1 STORY - BRICK VENEER	21"*	21"*	21"*
2 STORY - STD.	16"	16"	16"
2 STORY - BRICK VENEER	21"*	21"*	21"*
3 STORY - STD.	23"	18"	18"
3 STORY - BRICK VENEER	32"*	24"*	24"*
*5" BRICK LEDGE HAS BEEN ADDED TO THE CRAWL SPACE FOOTING WIDTH FOR BRICK SUPPORT			

#### WALL ANCHOR SCHEDULE

11/ALL	ANOHOR SCHEDULE				
TYPE	OF ANCHOR	MIN. CONC.	SPACING	INTERIOR	EXTERIOR
		EMBEDMENT	EMBEDMENT	WALL	WALL
1/2"ø	A307 BOLTS w/	7"	6'-0"	YES	YES
STD. 9	0° BEND				
SST -	MAS	4"	5'-0"	NO	YES
HILTI Ł	(WIK BOLT KBI 1/2-2-3/4	2-1/4"	6'-0"	YES	NO
1/2"ø	HILTI THREADED ROD	7"	6'-0"	YES	YES
w/ HI	F HY150 ADHESIVE				

NOTE: INSTALL ALL ANCHORS 12" MAX. FROM ALL BOTTOM PLATE ENDS AND JOINTS.

- NOTES:


  1. REFER TO GENERAL NOTES & SPECIFICATIONS ON COVERSHEET FOR ADDITIONAL INFORMATION.
- 2. PROVIDE 6 MIL VAPOR BARRIER UNDER ALL SLABS-ON-GRADE.
- 3. SEE ARCH. DWGS. FOR ALL TOP OF THE SLAB ELEVATIONS, SLOPES AND DEPRESSIONS.

  4. REFER TO STRUCTURAL PLANS AND FRAMING DETAILS FOR
- BRACED WALL PANEL LAYOUT, DIMENSIONS, ATTACHMENT AND CONNECTIONS
- 5. REFER TO LOCAL AND STATEWIDE CODES FOR ADDITIONAL AMENDMENTS AND REQUIREMENTS NOT SHOWN
- 6. PERIMETER INSULATION SHOWN AS REQUIRED BY LOCAL CLIMATE ZONE. INSTALL PER TABLE N1102.2.10 OF THE 2018 NCRC

SUMMIT 3070 HAMMOND BUSINES: PLACE; SUITE 171 RALEIGH, NC 27603 OFFICE: 919.380.9991 FAX: 919.380.9993 WWW.SUMMIT-COMPANIES.0

TH CAR SUMMIT

tails Det PROJECT: Standard D Crawl

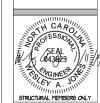


DATE: ØVII/2Ø19 SCALE: 22x34 1/4"+1"-@" llxi1 1/8"+1"-@" PROJECT \*: 424@5@@ DRAWN BY: EMB CHECKED BY: WAJ

PROJECT DATE

REFER TO COVER SHEET FOR A

Dic

## TYP. FRONT PORCH DETAIL

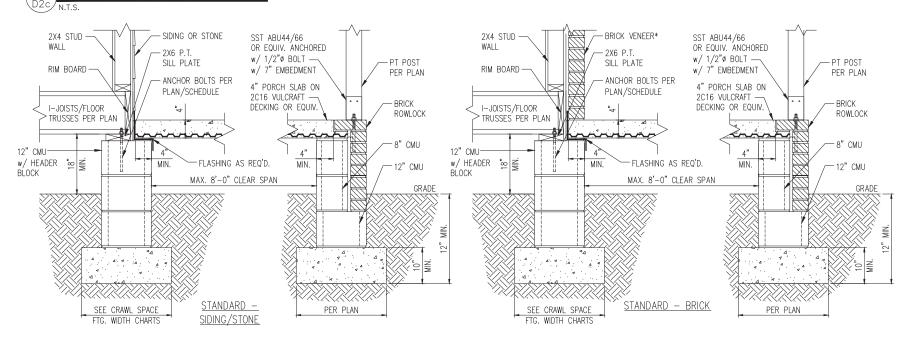

## FRONT PORCH DETAIL w/ SUSPENDED SLAB

#### DECK ATTACHMENT SCHEDULE (ALL STRUCTURES EXCEPT BRICK)

		/
FASTENERS	MAX. 8'-0" JOIST	MAX. 16'-0" JOIST
	SPAN	SPAN
5/8" GALV. BOLTS w/ NUT & WASHER <sup>b</sup>	(1) @ 3'-6" O.C.	(1) @ 1'-8" O.C.
AND	AND	AND
12d COMMON GALV. NAILS <sup>c</sup>	(2) @ 8" O.C.	(3) @ 6" O.C.

- a. ATTACHMENT INTERPOLATION BETWEEN 8' AND 16' JOIST SPANS IS ALLOWED.
- b. MINIMUM EDGE DISTANCE FOR BOLTS IS  $2\frac{1}{2}$ ".
- c. NAILS MUST PENETRATE THE SUPPORTING STRUCTURE BAND A MINIMUM OF  $1\frac{1}{2}^{\circ}$

#### DECK ATTACHMENT SCHEDULE (BRICK STRUCTURES)

FASTENERS	MAX. 8'-0" JOIST	MAX. 16'-0" JOIST	
	SPAN	SPAN	
5/8" GALV. BOLTS w/ NUT & WASHER <sup>b</sup>	(1) @ 2'-4" O.C.	(1) @ 1'-4" O.C.	


- a. ATTACHMENT INTERPOLATION BETWEEN 8' AND 16' JOIST SPANS IS ALLOWED.
- b. MINIMUM EDGE DISTANCE FOR BOLTS IS  $2\frac{1}{2}$ ".

#### CRAWL SPACE FOOTING WIDTH

FOOTING WIDTH FOR BRICK SUPPORT


# OF STORIES	WIDTH BASED ON SOIL BEARING CAPACITY		
	1500 PSF	2000 PSF	2500 PSF
1 STORY - STD.	16"	16"	16"
1 STORY - BRICK VENEER	21"*	21"*	21"*
2 STORY - STD.	16"	16"	16"
2 STORY - BRICK VENEER	21"*	21"*	21"*
3 STORY - STD.	23"	18"	18"
3 STORY - BRICK VENEER	32"*	24"*	24"*
*5" BRICK LEDGE HAS BEEN A	ADDED TO THE	CRAWI SPACE	

\*BRICK TIES SPACED @ 24" O.C. HORIZ. & 16" O.C. VERT. AND 3/16"Ø WEEP HOLES @ 33" O.C. LOCATED A MINIMUM OF 4" ABOVE THE EARTH

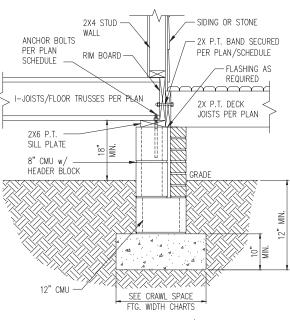

STANDARD - SIDING/STONE

## DECK ATTACHMENT DETAIL

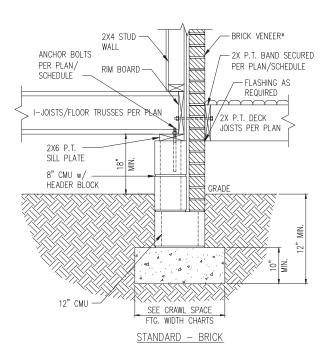


DECK ATTACHMENT DETAIL W/ BRICK

- NOTES:
  1. REFER TO GENERAL NOTES & SPECIFICATIONS ON COVERSHEET FOR ADDITIONAL INFORMATION.
- 2. PROVIDE 6 MIL VAPOR BARRIER UNDER ALL SLABS-ON-GRADE. 3. SEE ARCH. DWGS. FOR ALL TOP OF THE SLAB ELEVATIONS,
- SLOPES AND DEPRESSIONS.
  4. REFER TO STRUCTURAL PLANS AND FRAMING DETAILS FOR BRACED WALL PANEL LAYOUT, DIMENSIONS, ATTACHMENT AND
- CONNECTIONS 5. REFER TO LOCAL AND STATEWIDE CODES FOR ADDITIONAL AMENDMENTS AND REQUIREMENTS NOT SHOWN
- 6. PERIMETER INSULATION SHOWN AS REQUIRED BY LOCAL CLIMATE ZONE. INSTALL PER TABLE N1102.2.10 OF THE 2018 NCRC

SUMMIT 3070 HAMMOND BUSINE: PLACE; SUITE 171 RALEIGH, NC 27603 OFFICE: 919.380.9991 FAX: 919.380.9993 WW.SUMMIT-COMPANIES



Ω PROJECT: Standard Details Crawl Space F

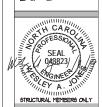

DATE: ØVII/2Ø19 SCALE: 22x34 1/4"+1"-@" llxi1 1/8"+1"-@" PROJECT \* 424@5@@ DRAWN BY: EMB CHECKED BY: WAJ

PROJECT DATE

REFER TO COVER SHEET FOR A COMPLETE LIST OF REVISIONS

D2c







CLIENT:
MCKee Homes LLC
MOS Hay Street, Suite 30
Fayetteville, NC 2830

PROJECT: Standard Details Frâming Details



DATE: OVINONS

DATE: OVINONS

SCALE: 22:34 | 14\*1"-0\*

Bit1 | 16\*1"-0\*

PROJECT 4:440560

DRAWN BY: E\*B

CHECKED BY: WAJ

ORIGINAL INFORMATION
PROJECT DATE

REFER TO COVER SHEET FOR A COMPLETE LIST OF REVISIONS

Dlf