HTE 04-5-8839R

HARNETT COUNTY HEALTH DEPARTMENT
ENVIRONMENTAL HEALTH SECTION

17066

OPERATIONS PERMIT

Name: (owner) Wayne Mangum - Douglas J. Mangum

☒ New Installation ☒ Septic Tank

Property Location: SR# 1265

☐ Repairs ☒ Nitrification Line

Subdivision —

Lot # —

Tax ID #

Quadrant #

Contractor: Mike Ray

Registration #

Basement with Plumbing: ☐ Garage: ☐

Water Supply: ☐ Well ☒ Public ☐ Community

Distance From Well: 50 ft.

Following are the specifications for the sewage disposal system on above captioned property.

Type of system: ☒ Conventional ☐ Other

Size of tank: Septic Tank: 1000 gallons Pump Tank: gallons

Subsurface Drainage Field: No. of ditches 1; exact length of each ditch 400 ft.; width of ditches 3 ft.; depth of ditches 18 in.

French Drain Required: Linear feet

Date: 5-17-04

Inspected by: Jon Ward
Environmental Health Specialist

PERMIT NO. 20442

SR 1265 421 →

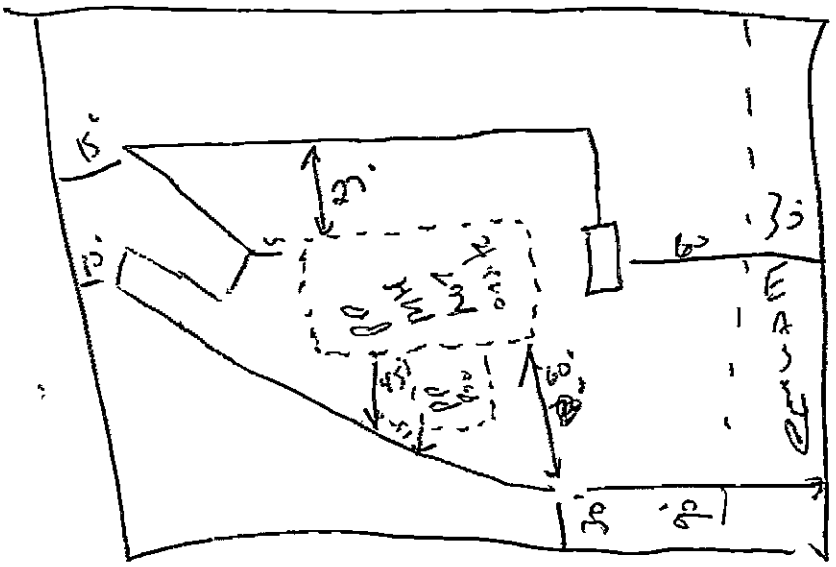

HARNETT COUNTY HEALTH DEPARTMENT

HTE 04-S-8839R

IMPROVEMENT PERMIT

20442

Be it ordained by the Harnett County Board of Health as follows: Section III, Item B. "No Person shall begin construction of any building at which a septic tank system is to be used for disposal of sewage without first obtaining a written permit from the Harnett County Health Department."

Name: (owner) Douglas F Mansum ☒ New Installation ☒ Septic Tank

Property Location: SR# 1265 ☐ Repairs ☒ Nitrification Line

Subdivision — Lot # —

Tax ID # Quadrant #

Number of Bedrooms Proposed: 3 (28 x 64) Lot Size: 1.00 AC

Basement with Plumbing: ☐ Garage: ☐

Water Supply: ☐ Well ☒ Public ☐ Community

Distance From Well: 50 ft.

Following is the minimum specifications for sewage disposal system on above captioned property. Subject to final approval.

Type of system: ☒ Conventional ☐ Other

Size of tank: Septic Tank: 1000 gallons Pump Tank: gallons

Subsurface Drainage Field: No. of ditches 1 exact length of each ditch 400 ft. width of ditches 3 ft. depth of ditches 18 in.

French Drain Required: Linear feet

Date: 04-21-04

This permit is subject to revocation if site plans or intended use change.

Signed: [illegible]

Environmental Health Specialist

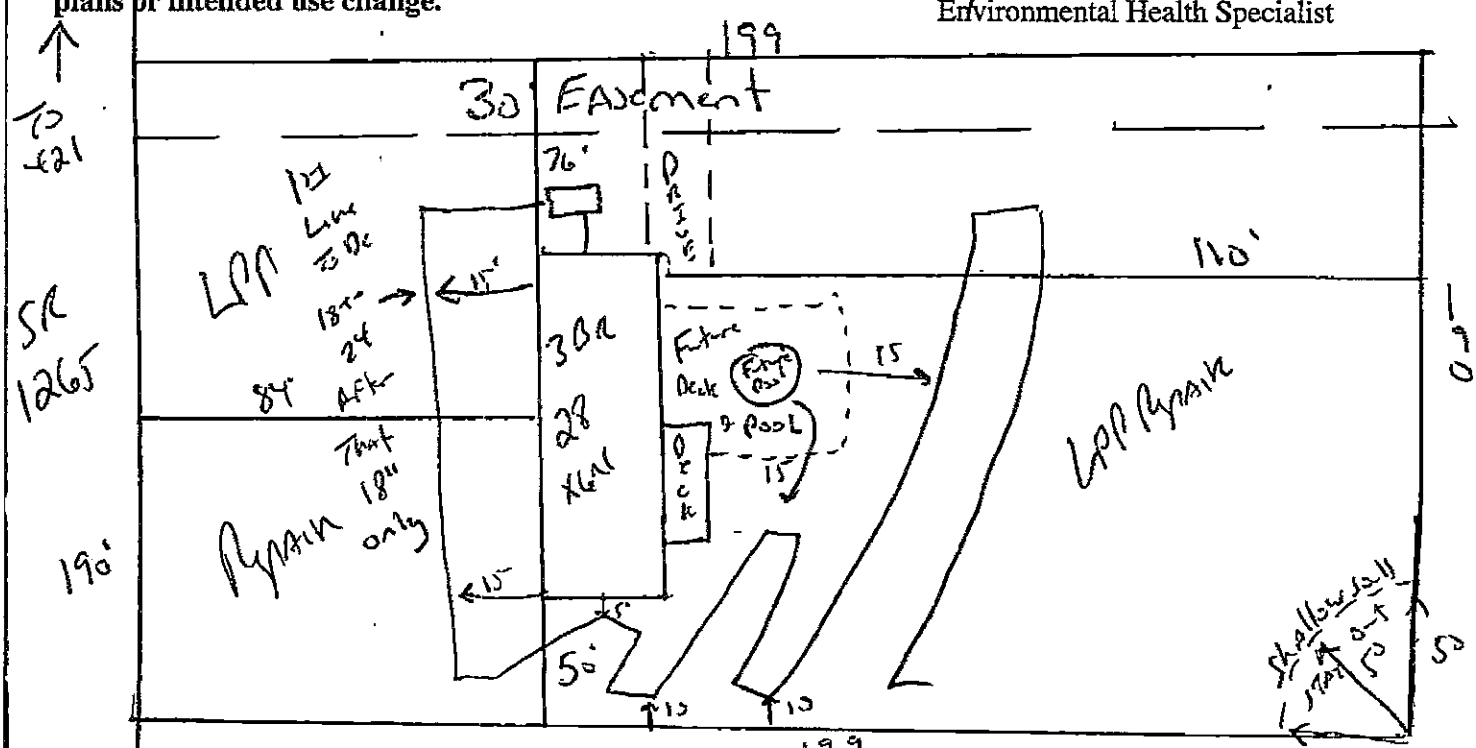

Meet onsite Maintain All set Backs
Keep Drain Line 15' from Future Pool Area