LEGEND:

- Subject Boundary Line
- Adjoining Boundary Line
- R/W Right-of-Way Line
- C/L Centerline
- Minimum Building Line
- Survey tie lines
- △ CP Calculated Point
- ERB Existing Iron Re-Bar
- BG/AG Below/Above Grade
- FH Fire Hydrant
- WM Water Meter
- WV Water Valve
- SS Sanitary Sewer Clean-Out
- TP Telephone Pedestal

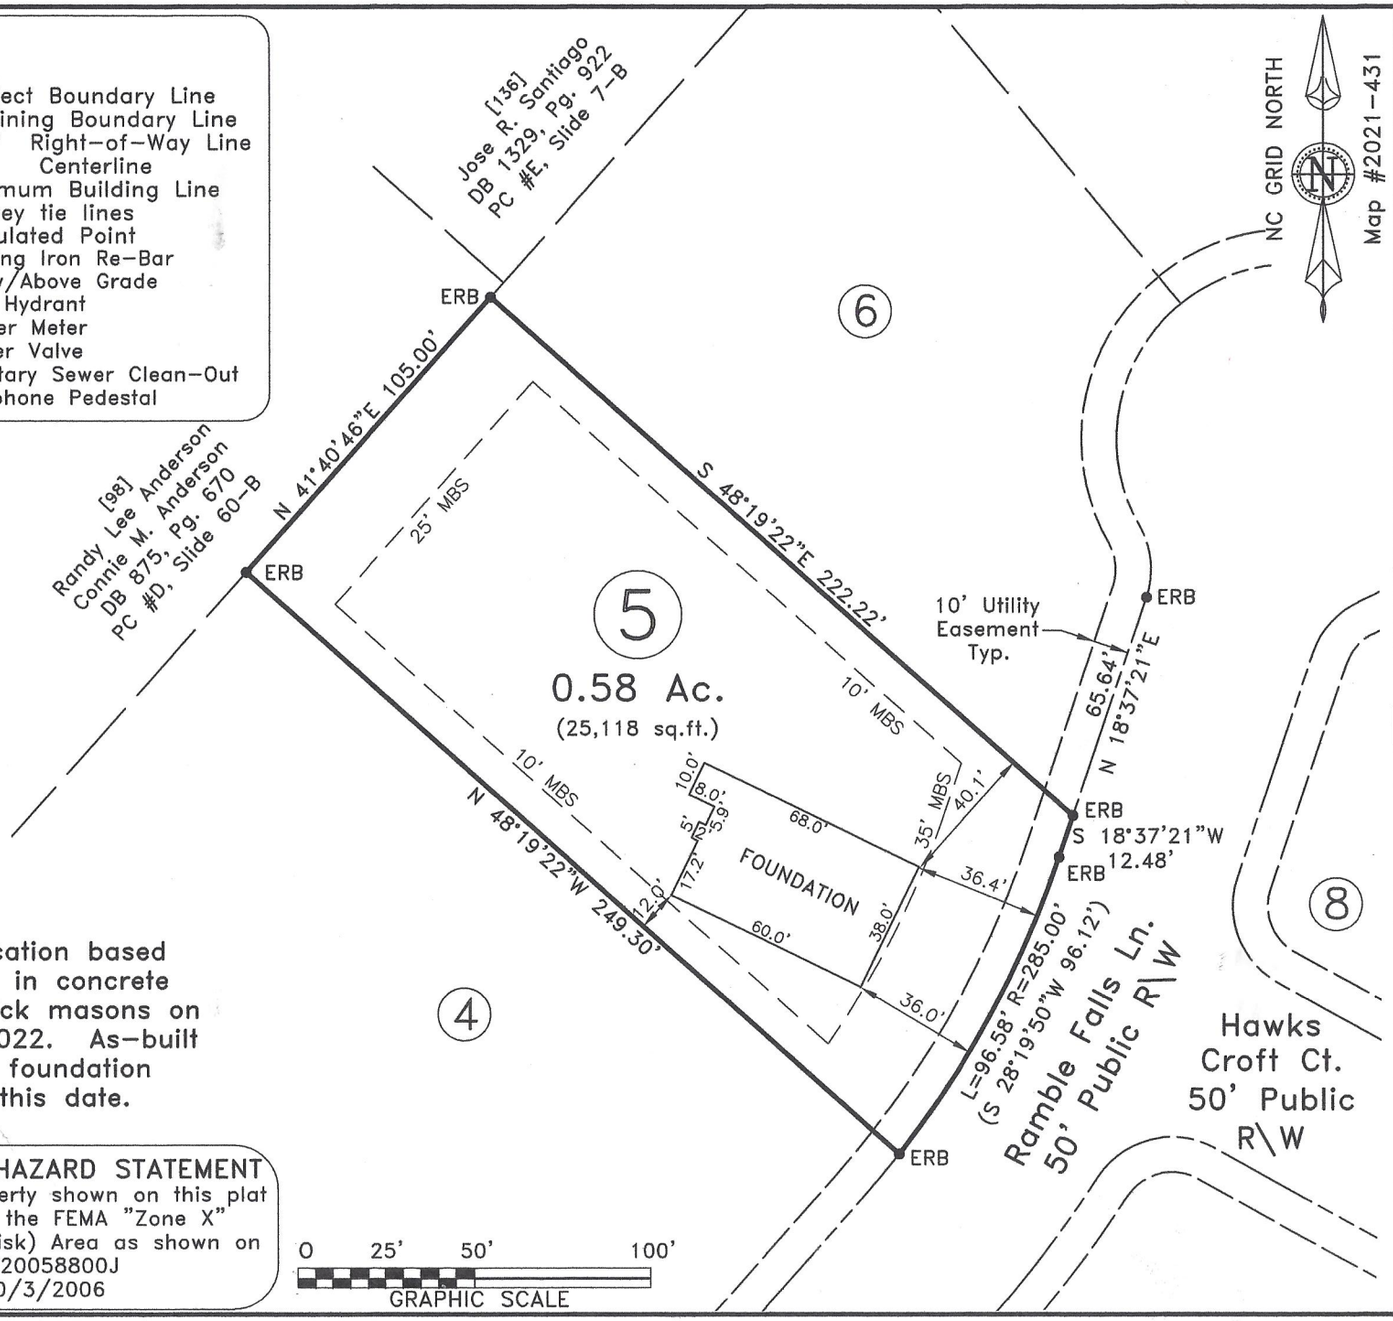

Note:
Foundation Location based upon nails set in concrete footing for brick masons on March 18th, 2022. As-built dimensions of foundation confirmed on this date.

FEMA FLOOD HAZARD STATEMENT
The subject property shown on this plat is located within the FEMA "Zone X" (Minimal Flood Risk) Area as shown on FIRM Number: 3720058800J
Effective date: 10/3/2006

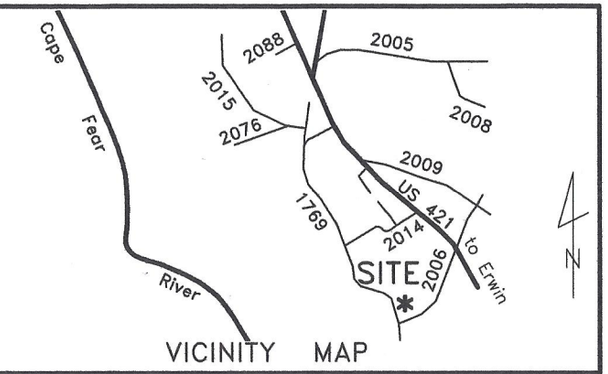

VICINITY MAP

~ 137 Ramble Falls Ln., Erwin ~
Lot 5, Wildwood Subdivision
Map #2021-431 thru 432

~ Foundation Survey ~

Signature Home Builders, Inc.

Grove Township	Harnett County
Scale: 1" = 50'	Date: 5-13-2022

Surveyed & Mapped By
STREAMLINE LAND SURVEYING, Inc.
NC FIRM C-1898
870 NC 55 W, Coats, N.C. 27521
Phone: 910-897-7715

I hereby certify that the foundation location shown hereon is correct in relation to property lines of record.
NOTE: The purpose of this survey is to locate the newley constructed foundation.
Other features, fixtures, encumberances and indications of use may be revealed by a complete site survey.

NORTH CAROLINA PROFESSIONAL SEAL L-3790 LAND SURVEYOR Robert E. Godwin, Jr. 5-19-22

NOT FOR RECORDATION

DATA\0588\211018Sl.dwg (L5Found)