AS-BUILT IMPROVEMENTS FOR
MATTAMY HOMES, LLC.
37 BERING CIRCLE
LOT 6, RIVERFALL SUBDIVISION, PHASE ONE
BLACK RIVER TOWNSHIP, HARNETT COUNTY, NORTH CAROLINA

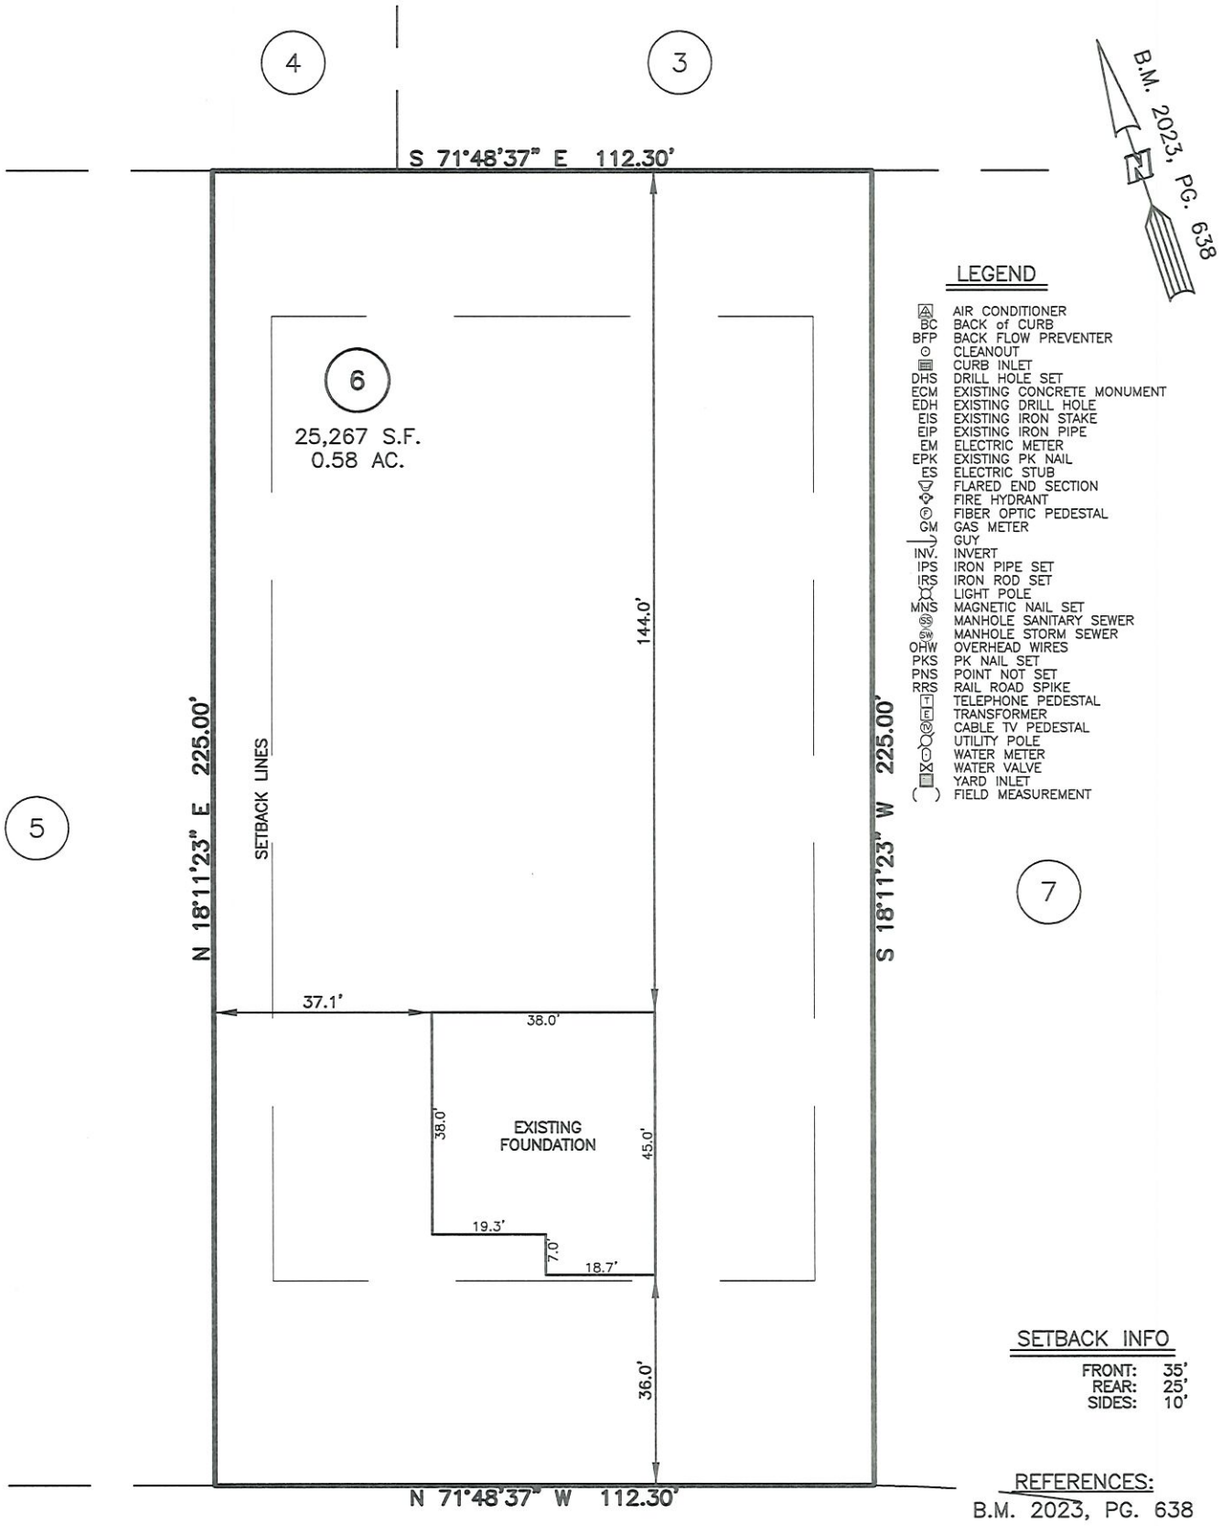

LEGEND

A	AIR CONDITIONER
BC	BACK of CURB
BFP	BACK FLOW PREVENTER
	CLEANOUT
	CURB INLET
DHS	DRILL HOLE SET
ECM	EXISTING CONCRETE MONUMENT
EDH	EXISTING DRILL HOLE
EIS	EXISTING IRON STAKE
EIP	EXISTING IRON PIPE
EM	ELECTRIC METER
EPK	EXISTING PK NAIL
ES	ELECTRIC STUB
	FLARED END SECTION
	FIRE HYDRANT
F	FIBER OPTIC PEDESTAL
GM	GAS METER
	GUY
INV.	INVERT
IPS	IRON PIPE SET
IRS	IRON ROD SET
	LIGHT POLE
MNS	MAGNETIC NAIL SET
SS	MANHOLE SANITARY SEWER
SW	MANHOLE STORM SEWER
OHW	OVERHEAD WIRES
PKS	PK NAIL SET
PNS	POINT NOT SET
RRS	RAIL ROAD SPIKE
T	TELEPHONE PEDESTAL
E	TRANSFORMER
TV	CABLE TV PEDESTAL
	UTILITY POLE
	WATER METER
	WATER VALVE
	YARD INLET
( )	FIELD MEASUREMENT

SETBACK INFO

FRONT: 35'
REAR: 25'
SIDES: 10'

REFERENCES:

B.M. 2023, PG. 638

30 0 30

SCALE: 1" = 30

WAKE COUNTY, NORTH CAROLINA

I CERTIFY THAT THIS MAP WAS DRAWN UNDER MY SUPERVISION FROM FIELDWORK DONE UNDER MY SUPERVISION; THAT THE IMPROVEMENTS LIE WHOLLY UPON THE LOT AND THAT THE PROPERTY SHOWN IS AN EXISTING PARCEL OR PARCELS OF LAND.

THIS AS-BUILT IS FOR CODE COMPLIANCE. NOT FOR SALES OR CONVEYANCE

NOTES

1. THIS SURVEY SUBJECT TO ANY FACTS THAT MAY BE DISCLOSED BY A FULL AND ACCURATE TITLE SEARCH.
2. THIS MAP MAY NOT BE A CERTIFIED SURVEY AND HAS NOT BEEN REVIEWED BY A LOCAL GOVERNMENT AGENCY FOR COMPLIANCE WITH ANY APPLICABLE LAND DEVELOPMENT REGULATIONS AND HAS NOT BEEN REVIEWED FOR COMPLIANCE WITH RECORDING REQUIREMENTS FOR PLATS.

10·18·24

CHARLES R. PIRATZKY, P.L.S. L-2813 — DATE

NORTH CAROLINA PROFESSIONAL SEAL L-2813 LAND SURVEYOR CHARLES R. PIRATZKY

DATE: OCT. 9, 2024

O:...\RVFL6\FIELDWORK\RVFL_6_FND.txt

RWK, PA
ENGINEERING ~ SURVEYING
CORPORATE LICENSE: C-1771
101 W. MAIN ST., SUITE 202
GARNER, NC 27529
PHONE (919) 779-4854
FAX (919) 779-4056

O:\RIVERFALL\RVFL6\RVFL6.DWG